

MAD

PROJECT ID: 1002-04-71
WITH:

MAR 07
ORDER OF SHEETS

Section No. 1	Title
Section No. 2	Typical Sections and Details
Section No. 3	Estimate of Quantities
Section No. 3	Miscellaneous Quantities
Section No. 4	Right of Way Plat
Section No. 5	Plan and Profile
Section No. 6	Standard Detail Drawings
Section No. 7	Sign Plates
Section No. 8	Structure Plans
Section No. 9	Computer Earthwork Data
Section No. 9	Cross Sections

TOTAL SHEETS = 328

STATE OF WISCONSIN
DEPARTMENT OF TRANSPORTATION

PLAN OF PROPOSED IMPROVEMENT

ILLINOIS STATE LINE - MADISON ROAD
(BELOIT SAFETY & WEIGHT FACILITY #19)
I.H. 39/90
ROCK COUNTY


STATE PROJECT	FEDERAL PROJECT	
	PROJECT	CONTRACT
1002-04-71	IM 2007151	1

AS BUILT CONSTRUCTION PLAN

WORK TYPE Grading, Building, Weight in Motion
CONTRACTOR Zisnago Company
PROJECT MANAGER Tara Weiss / Tom Wickus
WORK START-COMPLETED April 30, 2007 - May 1, 2008

STATE PROJECT NUMBER
1002-04-71

BEGIN PROJECT 1002-04-71
STA 468+30.00, 24' LT=
STA 468+30.00 (RAMP R/L)
Y = 242263.51
X = 504283.58

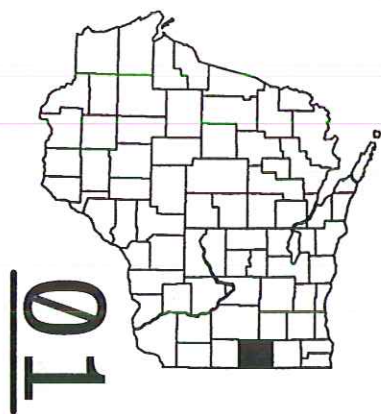


DESIGN DESIGNATION

	I.H. 39-90 (WB)	SWEF
A.A.D.T. 2003	= 23700	5119
A.A.D.T. 2023	= 33600	7258
D.H.V.	= 3998	864
D.D.	= 60/40	-
T.	= 21.6%	100%
DESIGN SPEED	= 70 MPH	30-70 MPH
ESALS	= -	49, 150, 900

CONVENTIONAL SYMBOLS

PLAN		PROFILE	
CORPORATE LIMITS		GRADE LINE	
PROPERTY LINE		ORIGINAL GROUND	
LOT LINE		MARSH OR ROCK PROFILE (To be noted as such)	
LIMITED HIGHWAY EASEMENT		SPECIAL DITCH	
EXISTING RIGHT OF WAY		GRADE ELEVATION	
PROPOSED OR NEW R/W LINE		CULVERT (Profile View)	
SLOPE INTERCEPT		UTILITIES	
REFERENCE LINE		ELECTRIC	
EXISTING CULVERT		FIBER OPTIC	
PROPOSED CULVERT (Box or Pipe)		GAS	
COMBUSTIBLE FLUIDS		SANITARY SEWER	
		STORM SEWER	
		TELEPHONE	
		WATER	
		UTILITY PEDESTAL	
		POWER POLE	
		TELEPHONE POLE	
MARSH AREA			
WOODED OR SHRUB AREA			

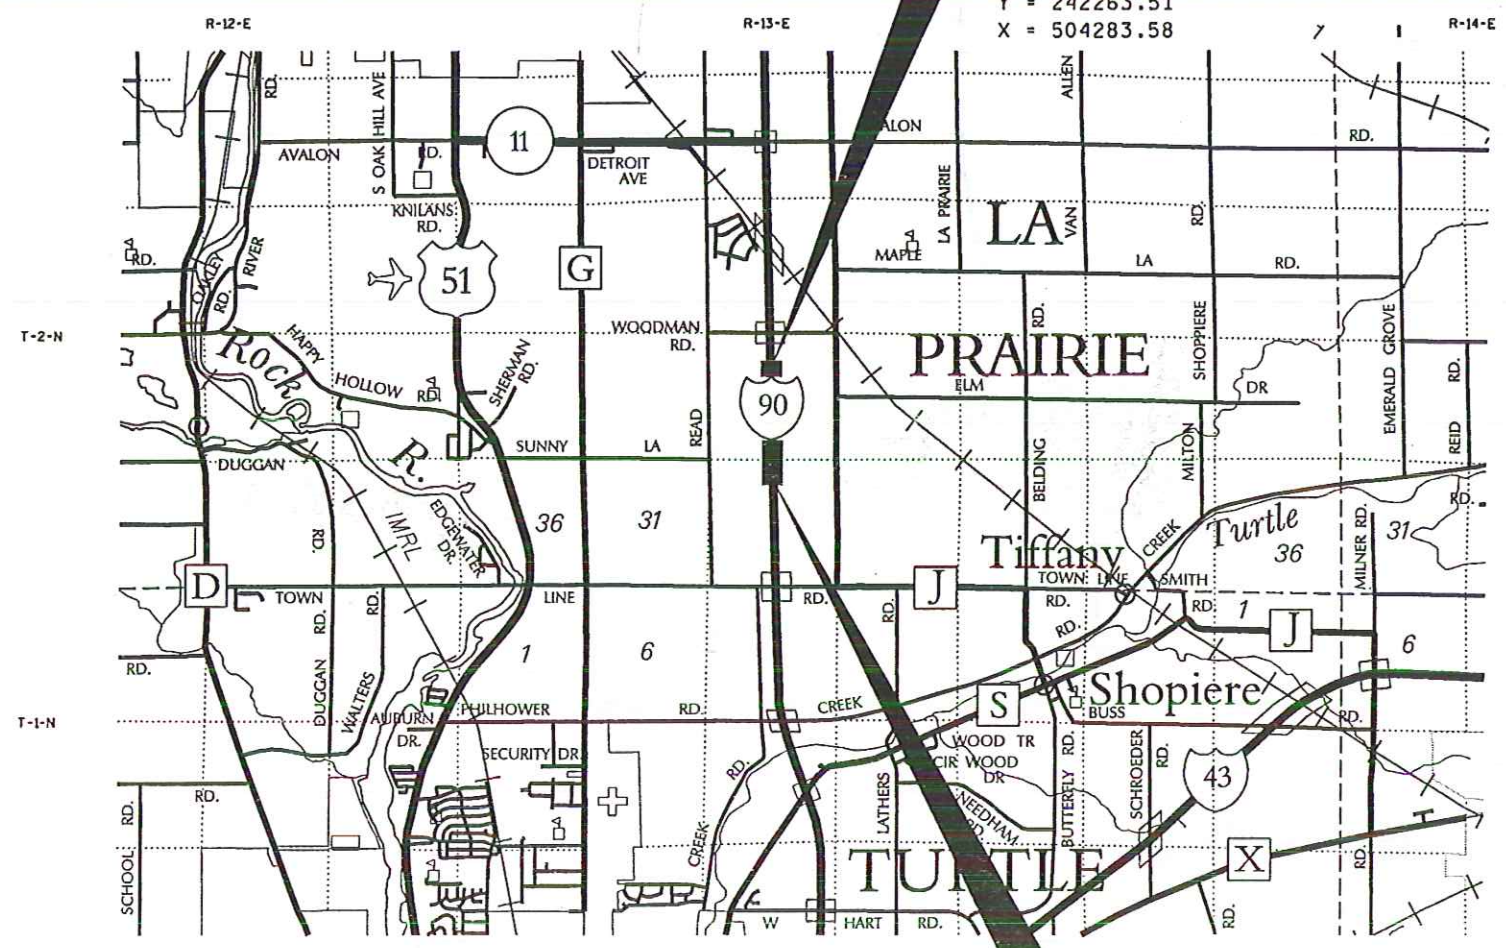

LAYOUT
SCALE 0 1.0 MI.

TOTAL NET LENGTH OF CENTERLINE = 0.000 MI.

Coordinates on this plan are referenced to the Wisconsin County Coordinate System (WCCS), Rock County.

Elevations are based on NGVD 29.

ORIGINAL PLANS PREPARED BY
KL Engineering
Transportation - Municipal - Environmental Survey/CIS



11/2/06 Aaron Steger
Date Signature

STATE OF WISCONSIN
DEPARTMENT OF TRANSPORTATION

PREPARED BY	
Surveyor	KL ENGINEERING, INC.
Designer	KL ENGINEERING, INC.
Project Manager	ROBERT SPOERL
District Examiner	
District Supervisor	JOHN KINAR
C.O. Examiner	Jane E. Englebert

APPROVED FOR BUREAU OF HIGHWAY OPERATIONS
DATE: 11/02/06 Robert E. Sporel
(Signature)