

GRE NOV 09

PROJECT ID: 1440-16-60
WITH: N/A

COUNTY: SHEBOYGAN

ORDER OF SHEETS

Section No. 1	Title
Section No. 2	Typical Sections and Details
Section No. 3	Estimate of Quantities
Section No. 3	Miscellaneous Quantities
Section No. 5	Plan
Section No. 6	Standard Detail Drawings
Section No. 7	Sign Plates

TOTAL SHEETS = 234



DESIGN DESIGNATION

A.A.D.T. 2010	=	24,000
A.A.D.T. 2030	=	31,300
D.H.V. 2030	=	4,695
D.O.	=	55/45
T.	=	13.9
DESIGN SPEED	=	65 MPH
ESALS	=	13,687,500

CONVENTIONAL SYMBOLS

PLAN	
CORPORATE LIMITS	////
REFERENCE LINE	—
COMBUSTIBLE FLUIDS	CAUTION
UTILITIES	
ELECTRIC	— E —
FIBER OPTIC	— FO —
GAS	— G —
SANITARY SEWER	— SAN —
STORM SEWER	— SS —
TELEPHONE	— T —
WATER	— W —
UTILITY PEDESTAL	⊕
POWER POLE	⊕
TELEPHONE POLE	⊕

STATE OF WISCONSIN
DEPARTMENT OF TRANSPORTATION

STATE HIGHWAY REHABILITATION-MAINTENANCE PROJECT

PLYMOUTH - SHEBOYGAN

(CTH P - STH 32)

STH 23

SHEBOYGAN COUNTY

STATE PROJECT NUMBER


1440-16-60

BEGIN PROJECT 1440-16-60

STA 1142+00.00

N 181603.618

E 137416.526

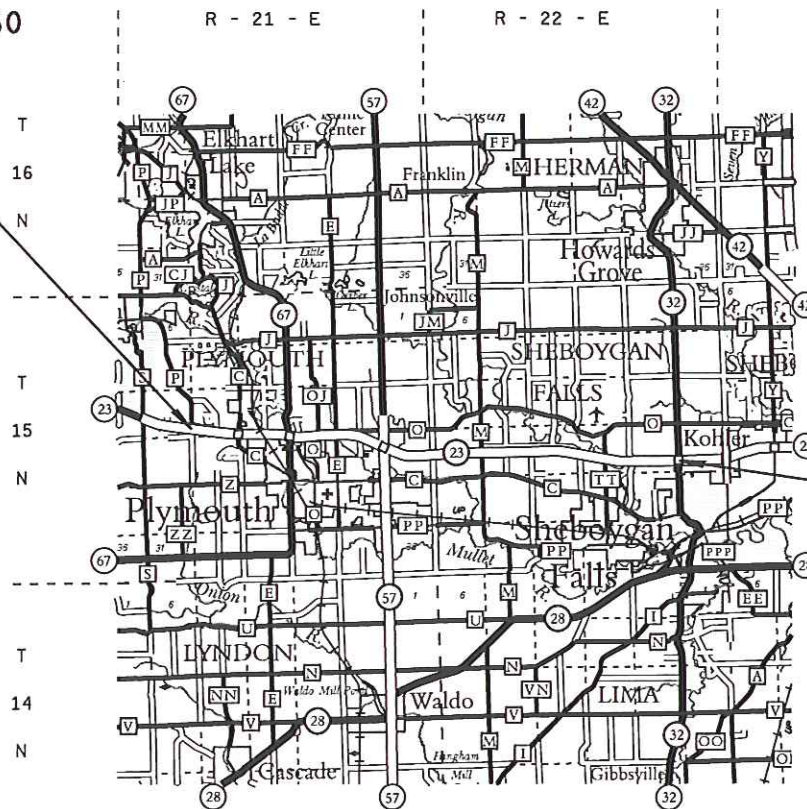

LAYOUT

SCALE 0 2 MI.

TOTAL NET LENGTH OF CENTERLINE = 10.043 MI.

STATE PROJECT

1440-16-60

FEDERAL PROJECT

PROJECT

WISCONSIN 2009755

CONTRACT

11

ADDENDUM
ATTACHED
TO BACK

Contractor - Lalonde Inc
(Concrete Pavement)

Sub Contractors -

Century Fence - (Pavement Marking)

Warning lights - (Traffic Control)

TNT - (Land Surveyors)

Theo-Minn Trucking (Precast Bridge Wall)

Safety Grooving and Grinding (Diamond grinding)

NE Asphalt - (Asphalt Paving)

Highway Landscapers - (Landscaping : Signs)

Ed Gerzek - (Culvert Pipes : Endwalls)

CPR Inc - (Dowel Bar Retrofit)

AS BUILT PLAN

NO.

SUPERVISOR

RESIDENT

CONTRACTOR Lalonde

COMPLETED

Date Started - 3-29-10

Date Completed - 8-6-10

END PROJECT 1440-16-60

STA 1685+00.00

N 176489.802

E 190939.809

Contract Amount
\$4,950,000

EXCEPTION TO NET & LENGTH

B-59-97	STA 1219+39.01 - 1222+15.99
B-59-91	STA 1248+45.74 - 1252+38.26
B-59-92	STA 1356+65.22 - 1359+22.85
B-59-88	STA 1606+37.67 - 1608+30.33
B-59-83	STA 1681+68.56 - 1683+37.22

ALIGNMENT DATA IS BASED ON ASBUILTS WITHOUT ANY FIELD SURVEY DATA AND IS TO BE USED FOR REFERENCE ONLY.

STATE OF WISCONSIN
DEPARTMENT OF TRANSPORTATION

PREPARED BY

Surveyor	NE REGION
Designer	L. ASHAUER
Project Manager	P. BRAUER
Regional Examiner	
Regional Supervisor	J. THOMPSON
C.O. Examiner	

APPROVED FOR THE DEPARTMENT

DATE: 09/13/09

(Signature)

E