

GRE MAY 10

PROJECT ID: 4125-07-71
WITH: N/A

COUNTY: BROWN

ORDER OF SHEETS

Section No.	Title
1	Typical Sections and Details
2	Estimate of Quantities
3	Miscellaneous Quantities
4	Right of Way Plat
5	Plan and Profile
6	Standard Detail Drawings
7	Sign Plates
8	Structure Plans
9	Computer Earthwork Data
10	Cross Sections

TOTAL SHEETS = 378



STATE OF WISCONSIN DEPARTMENT OF TRANSPORTATION

PLAN OF PROPOSED IMPROVEMENT

MAIN STREET, VILLAGE OF BELLEVUE

USH 141/STH 29 & CTH JJ INTERSECTION


USH 141

BROWN COUNTY

STATE PROJECT	FEDERAL PROJECT	
	PROJECT	CONTRACT
4125-07-71	WISC 2010475	1

ADDENDUM
ATTACHED
TO BACK

STATE PROJECT NUMBER
4125-07-71

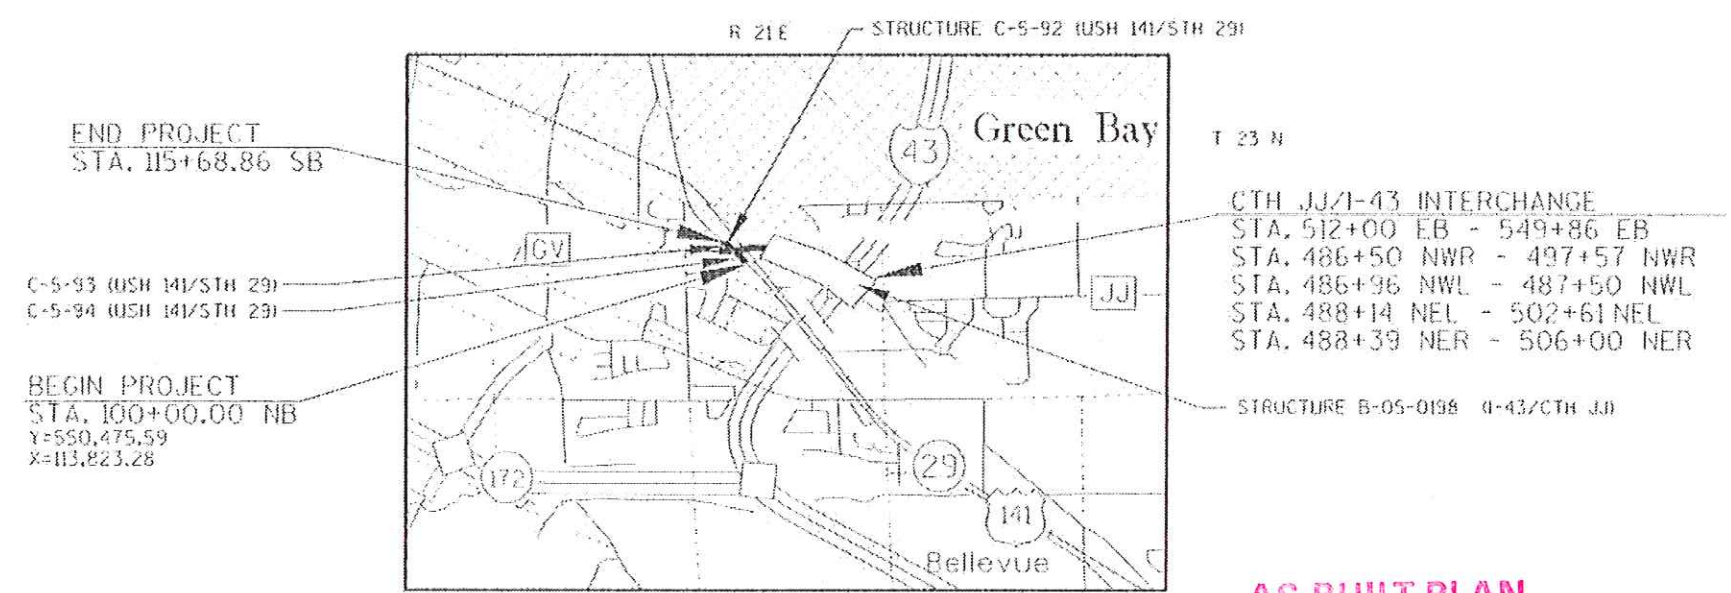

DESIGN DESIGNATION

A.A.D.T. (2010)	= 20,700
A.A.D.T. (2030)	= 24,500
D.H.V.	= 4.3
D.D.	= 58/42
T.	= 2.4%
DESIGN SPEED	= 50 MPH
ESALS	= 4,431,000

CONVENTIONAL SYMBOLS

PLAN		UTILITIES	
CORPORATE LIMITS		ELECTRIC	
PROPERTY LINE		FIBER OPTIC	
LOT LINE		GAS	
LIMITED HIGHWAY EASEMENT		OVERHEAD UTILITY	
EXISTING RIGHT OF WAY		SANITARY SEWER	
PROPOSED OR NEW R/W LINE		SANITARY SEWER ABANDONED	
SLOPE INTERCEPT		STORM SEWER	
REFERENCE LINE		TELEPHONE	
EXISTING CULVERT		WATER	
PROPOSED CULVERT (Box or Pipe)		UTILITY PEDESTAL	
COMBUSTIBLE FLUIDS		POWER POLE	
MARSH AREA		TELEPHONE POLE	
WOODED OR SHRUB AREA		MANHOLE	
		GUY POLE	
		RAMP GATE	

AS BUILT PLAN
NO.
SUPERVISOR Steve Noel
RESIDENT Kristin VanHout
CONTRACTOR Trierweiler Construction
COMPLETED 10/18/2010

ORIGINAL PLANS PREPARED BY

GRÄEF

1150 Springhurst Drive,
Suite 201
Green Bay, WI 54304-5690
920.7.692.9440
920.7.692.9445 fax
www.graef-usa.com

SANDRA D. CARPENTER
E-35024
APPLETON, WI
PROFESSIONAL ENGINEER

STATE OF WISCONSIN
DEPARTMENT OF TRANSPORTATION

PREPARED BY: GRÄEF
Surveyor: GRÄEF
Designer: GRÄEF
Project Manager: GARY SEVERINCHAK, P.E.
Regional Examiner: STEVEN NOEL, P.E.
Regional Supervisor: GRÄEF
C.O. Examiner: GRÄEF

APPROVED FOR THE BOARD: GRÄEF
DATE: 2/1/2010
Signature: GRÄEF

COORDINATES ON THIS PLAN ARE REFERENCED TO THE WISCONSIN COUNTY
Coordinate System (NAD83), BROWN COUNTY.

FILE NAME: I:\J0052006\2006\02\26\06-0111\141\2010\00051010141.dgn
PLOT DATE: 1/21/2010
PLOT BY: J. P. SEVERINCHAK
PLOT SCALE: 1"=100.00 FEET
WISDOT/CADD SHEET 10