

GRE

MAR 10

ORDER OF SHEETS

|           |   |                              |
|-----------|---|------------------------------|
| Sheet No. | 1 | Title                        |
| Sheet No. | 2 | Typical Sections and Details |
| Sheet No. | 3 | Estimate of Quantities       |
| Sheet No. | 3 | Miscellaneous Quantities     |
| Sheet No. |   | <del>Right of Way Plat</del> |
| Sheet No. | 5 | Plan and Profile             |
| Sheet No. | 6 | Standard Detail Drawings     |
| Sheet No. | 7 | Sign Plates                  |
| Sheet No. |   | <del>Structure Plans</del>   |
| Sheet No. | 9 | Computer Earthwork Data      |
| Sheet No. | 9 | Cross Sections               |

TOTAL SHEETS = 186



DESIGN DESIGNATION

|              |      |   |             |
|--------------|------|---|-------------|
| A.D.T.       | 2009 | = | 22,025      |
| A.D.T.       | 2029 | = | 28,525      |
| D.H.V.       |      | = | 3.5         |
| D.           |      | = | 55          |
| T.           |      | = | 5.2         |
| DESIGN SPEED |      | = | 30-55       |
| ESALS        |      | = | 124,542,562 |

CONVENTIONAL SYMBOLS

|                                |  |
|--------------------------------|--|
| PLAN                           |  |
| CORPORATE LIMITS               |  |
| PROPERTY LINE                  |  |
| LOT LINE                       |  |
| LIMITED HIGHWAY EASEMENT       |  |
| EXISTING RIGHT OF WAY          |  |
| PROPOSED OR NEW R/W LINE       |  |
| SLOPE INTERCEPT                |  |
| REFERENCE LINE                 |  |
| EXISTING CULVERT               |  |
| PROPOSED CULVERT (Box or Pipe) |  |
| COMBUSTIBLE FLUIDS             |  |
| MARSH AREA                     |  |
| WOODED OR SHRUB AREA           |  |

|   |  |
|---|--|
| PROFILE                                     |  |
| GRADE LINE                                  |  |
| ORIGINAL GROUND                             |  |
| MARSH OR ROCK PROFILE (To be noted as such) |  |
| SPECIAL DITCH                               |  |
| GRADE ELEVATION                             |  |
| CULVERT (Profile View)                      |  |
| UTILITIES                                   |  |
| ELECTRIC                                    |  |
| FIBER OPTIC                                 |  |
| GAS   |  |
| SANITARY SEWER                              |  |
| STORM SEWER                                 |  |
| TELEPHONE                                   |  |
| WATER                                       |  |
| UTILITY PEDESTAL                            |  |
| POWER POLE                                  |  |
| TELEPHONE POLE                              |  |

STATE OF WISCONSIN  
DEPARTMENT OF TRANSPORTATION

PLAN OF PROPOSED IMPROVEMENT

JACKSON ST CITY OF OSHKOSH

MURDOCK AVE - INDIAN POINT ROAD

STH 76


WINNEBAGO COUNTY

STATE PROJECT NUMBER  
6430-08-71

ADDENDUM  
ATTACHED  
TO BACK

AS BUILT PLAN

SUPERVISOR Steve Noel  
RESIDENT Jeff Spaeth  
CONTRACTOR Northeast Asphalt, Inc  
COMPLETED July 28, 2010

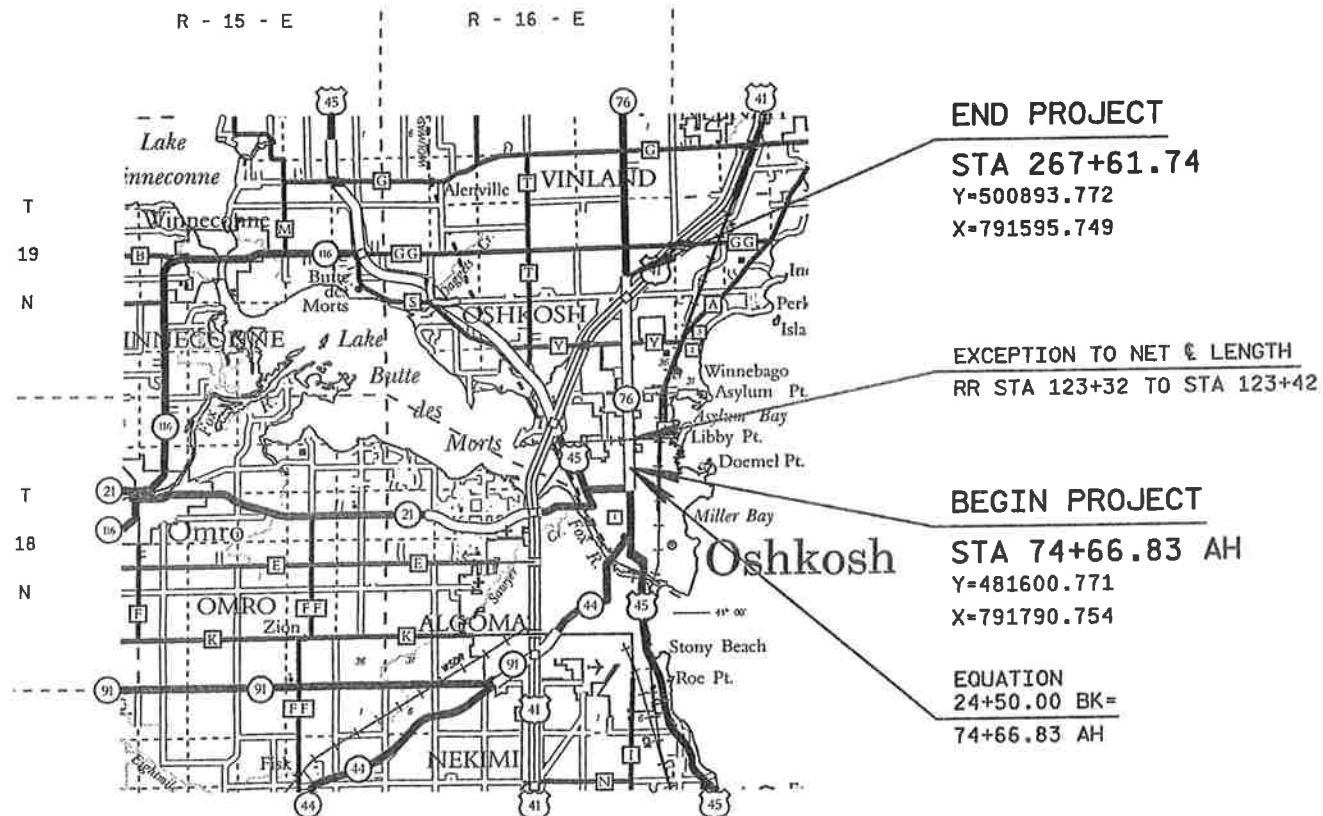

LAYOUT  
SCALE 0 2 MI.

TOTAL NET LENGTH OF CENTERLINE = 3.65 MI.

COORDINATES ON THIS PLAN ARE REFERENCED TO THE WISCONSIN  
COUNTY COORDINATE SYSTEM (WCCS), (WINNEBAGO COUNTY) NAD83 (91).

STATE OF WISCONSIN  
DEPARTMENT OF TRANSPORTATION

|                     |                    |
|---------------------|--------------------|
| PREPARED BY         | WDOT NE REGION     |
| Surveyor            | CRYSTAL KLOSTERMAN |
| Designer            | BILL BERTRAND      |
| Project Manager     |                    |
| Regional Examiner   | JIM THOMPSON       |
| Regional Supervisor |                    |
| C.O. Examiner       |                    |

APPROVED FOR THE DEPARTMENT  
DATE: 11-02-09 William R. Bertrand  
(Signature)

E