




Changed to LED B

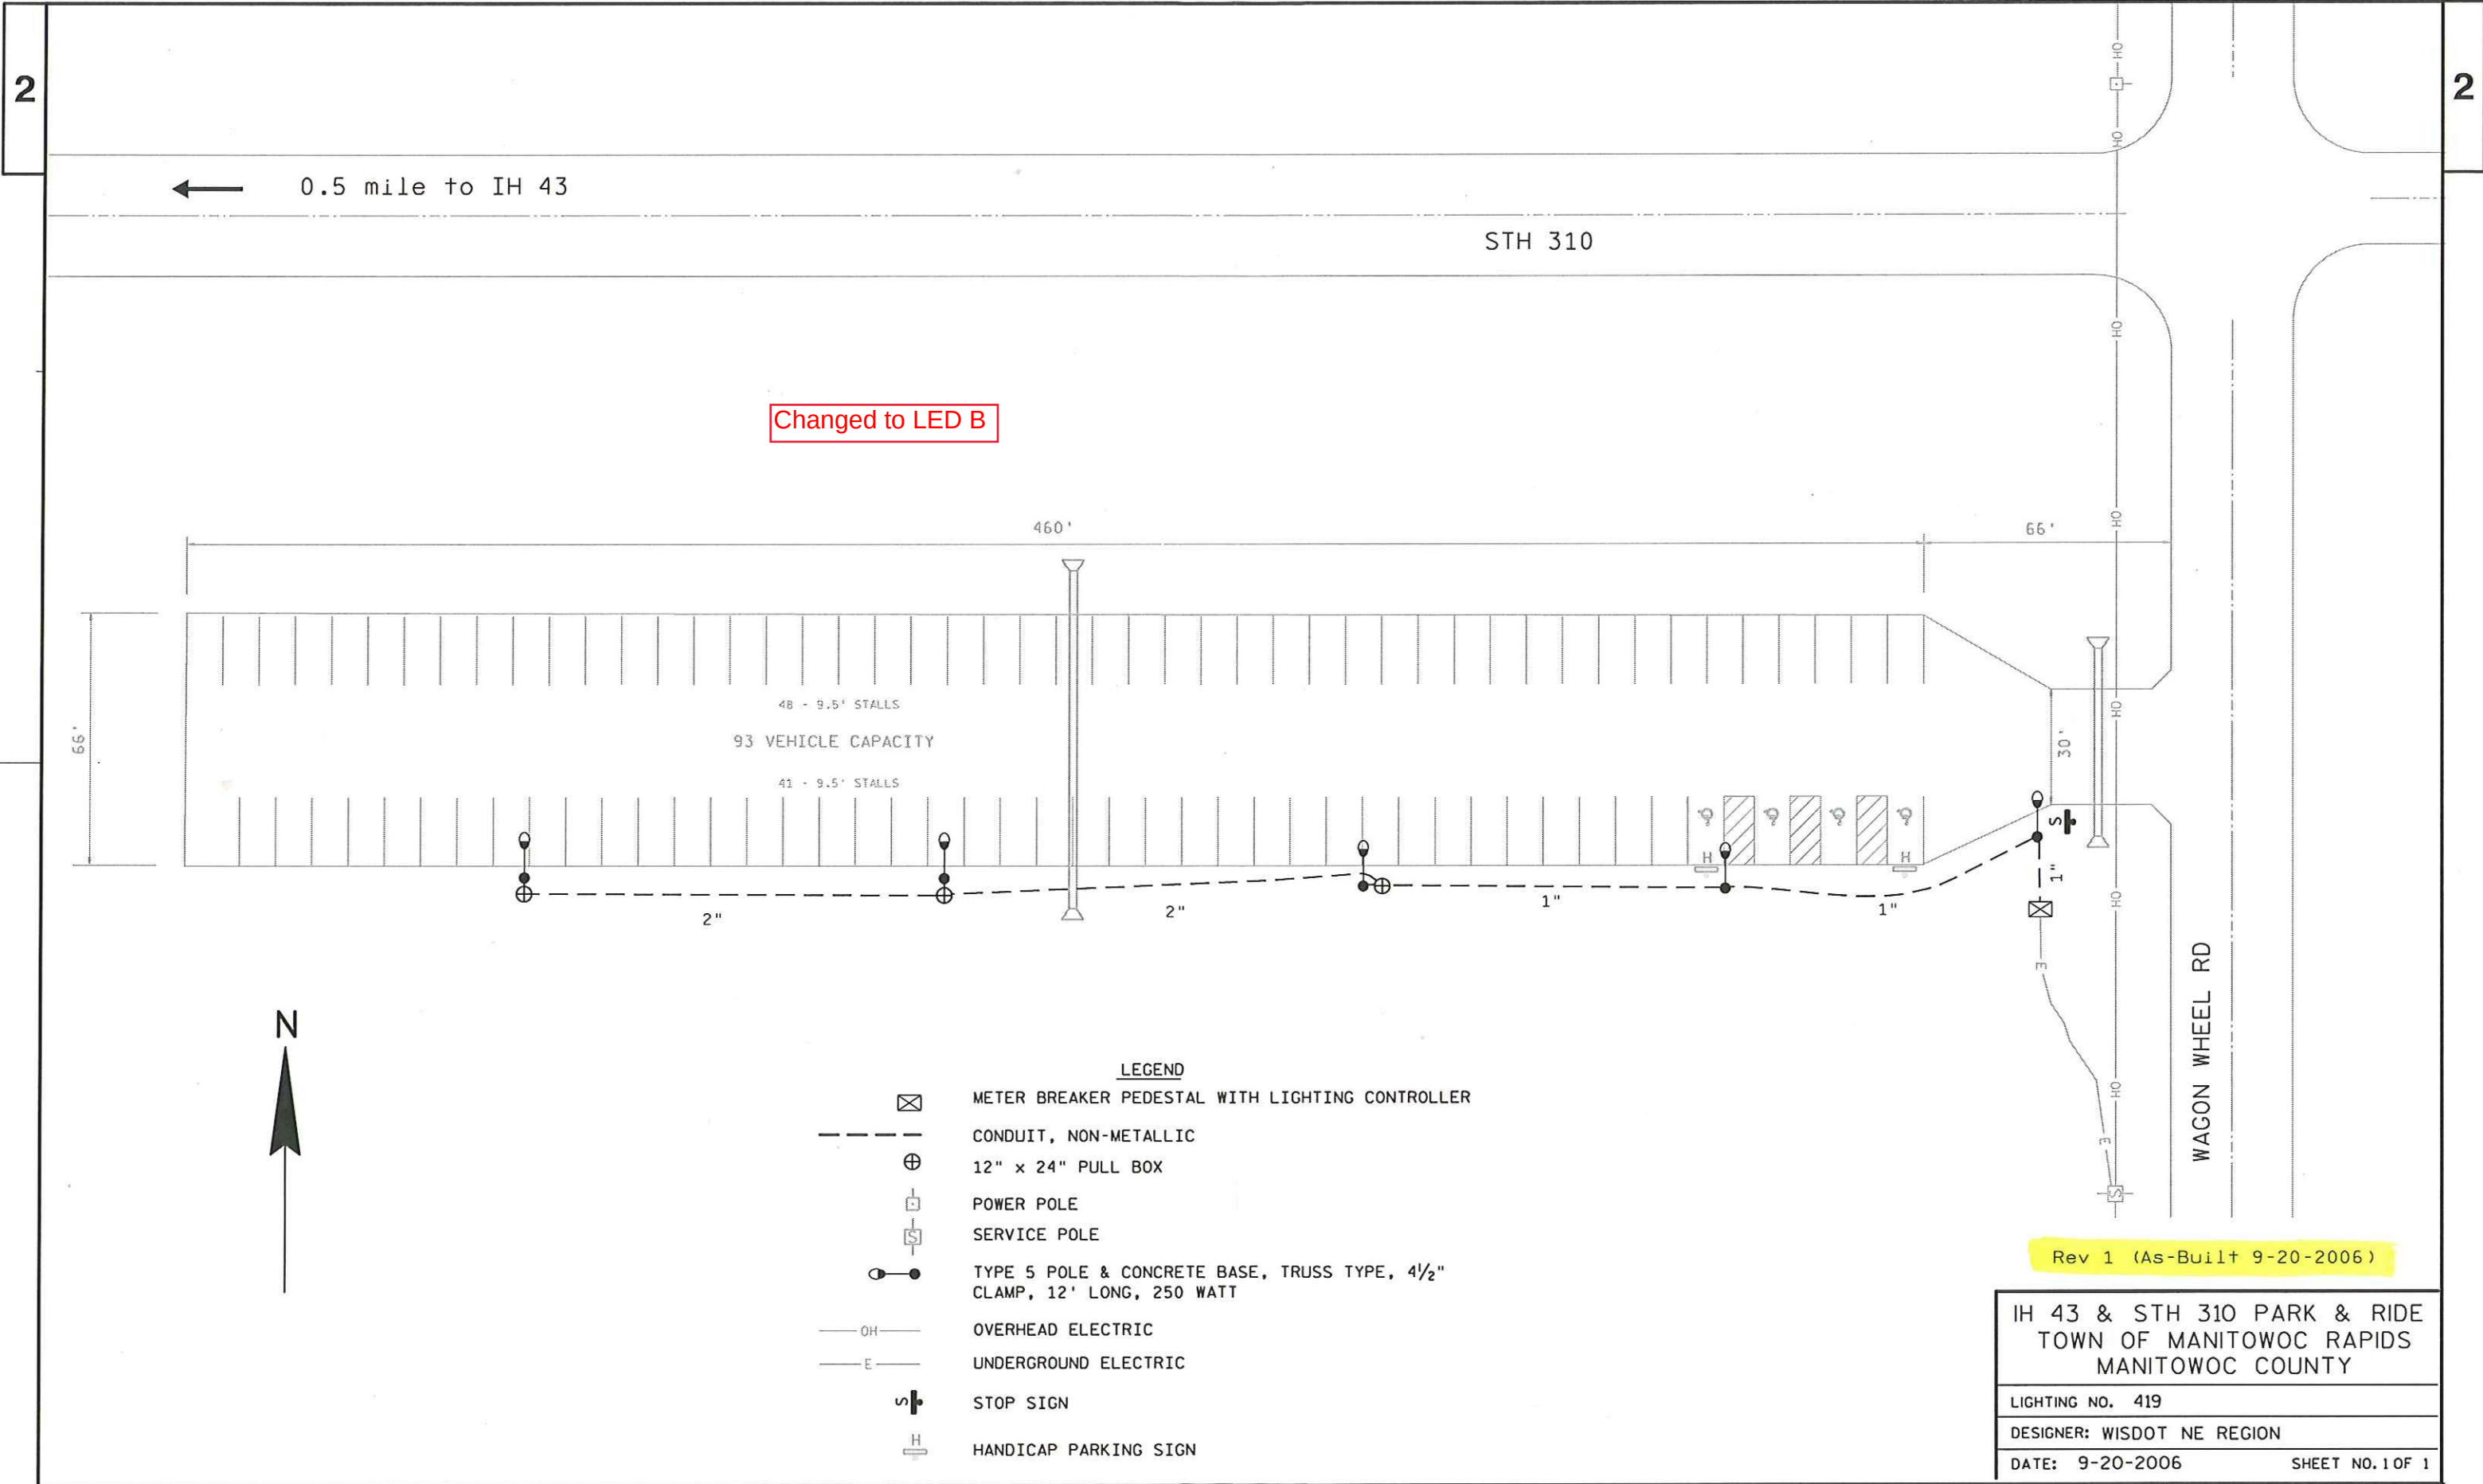

- LEGEND**
- METER BREAKER PEDESTAL WITH LIGHTING CONTROLLER
 - CONDUIT, NON-METALLIC
 -

Rev 1 (As-Built 9-20-2006)

IH 43 & STH 310 PARK & RIDE TOWN OF MANITOWOC RAPIDS MANITOWOC COUNTY	
LIGHTING NO. 419	
DESIGNER: WISDOT NE REGION	
DATE: 9-20-2006	SHEET NO. 1 OF 1