


LEVELS ON - 1, 2, 3, 62, 63

CTH D

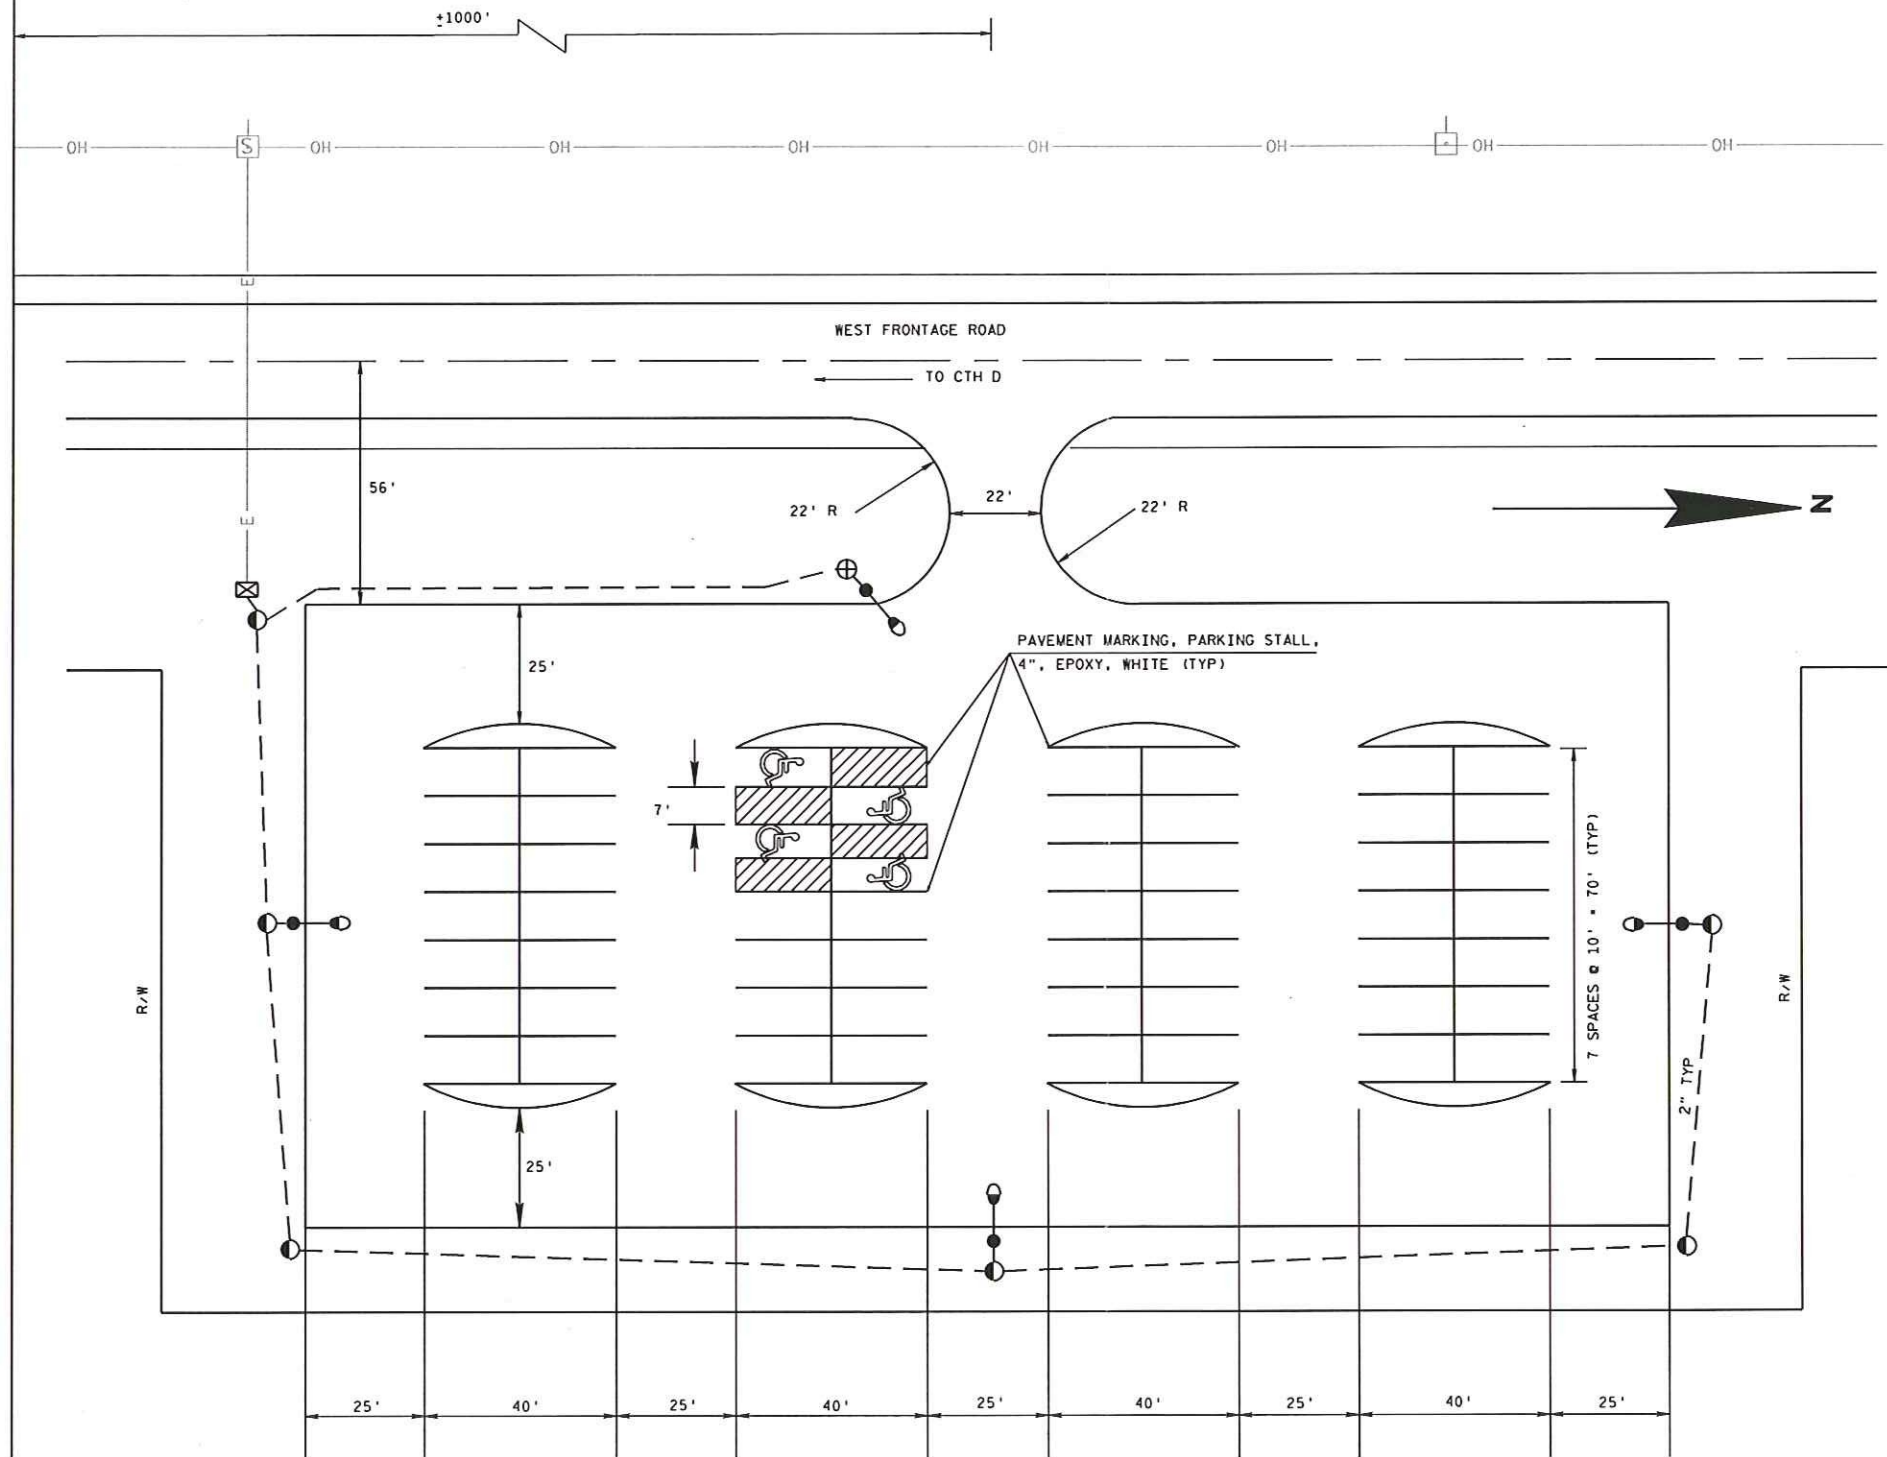

LEGEND

- ⊠ METER BREAKER PEDESTAL WITH LIGHTING CONTROLLER
- - - 2" PVC CONDUIT
- ⊞ POWER POLE
- ⊞ SERVICE POLE
- ⊞ TYPE 5 POLE & CONCRETE BASE, TRUSS TYPE, 4 1/2" CLAMP, 12' LONG, 250 WATTS
- HO - OVERHEAD ELECTRIC
- ⊞ 12" X 24" PULLBOX
- ⊞ 24" X 36" PULLBOX
- E - UNDERGROUND ELECTRIC

Changed to LED B

AS-BUILT 12-30-2002

SOUTH ABRAMS PARK & RIDE
USH 41/141 & CTH D
OCONTO COUNTY

LIGHTING NO. L-577

DESIGNED BY RJS

DATE 12-4-01

STATE PROJECT NUMBER:1152-07-75

HWY:USH 41

COUNTY:OCONTO

PARK AND RIDE - L-577

SCALE, FEET

SHEET NO:

E

FILE NAME : F:\d3_traffic\1\PARK41.DGN

PLOT DATE : 13-JAN-2003 10:15

ORG DATE :

PLOT NAME : PARK41

Originator : d3

PLOT SCALE : 40.121212:1.000000

WISDOT/CADDs SHEET 42