


LEVELS ON - 1, 2, 3, 62, 63

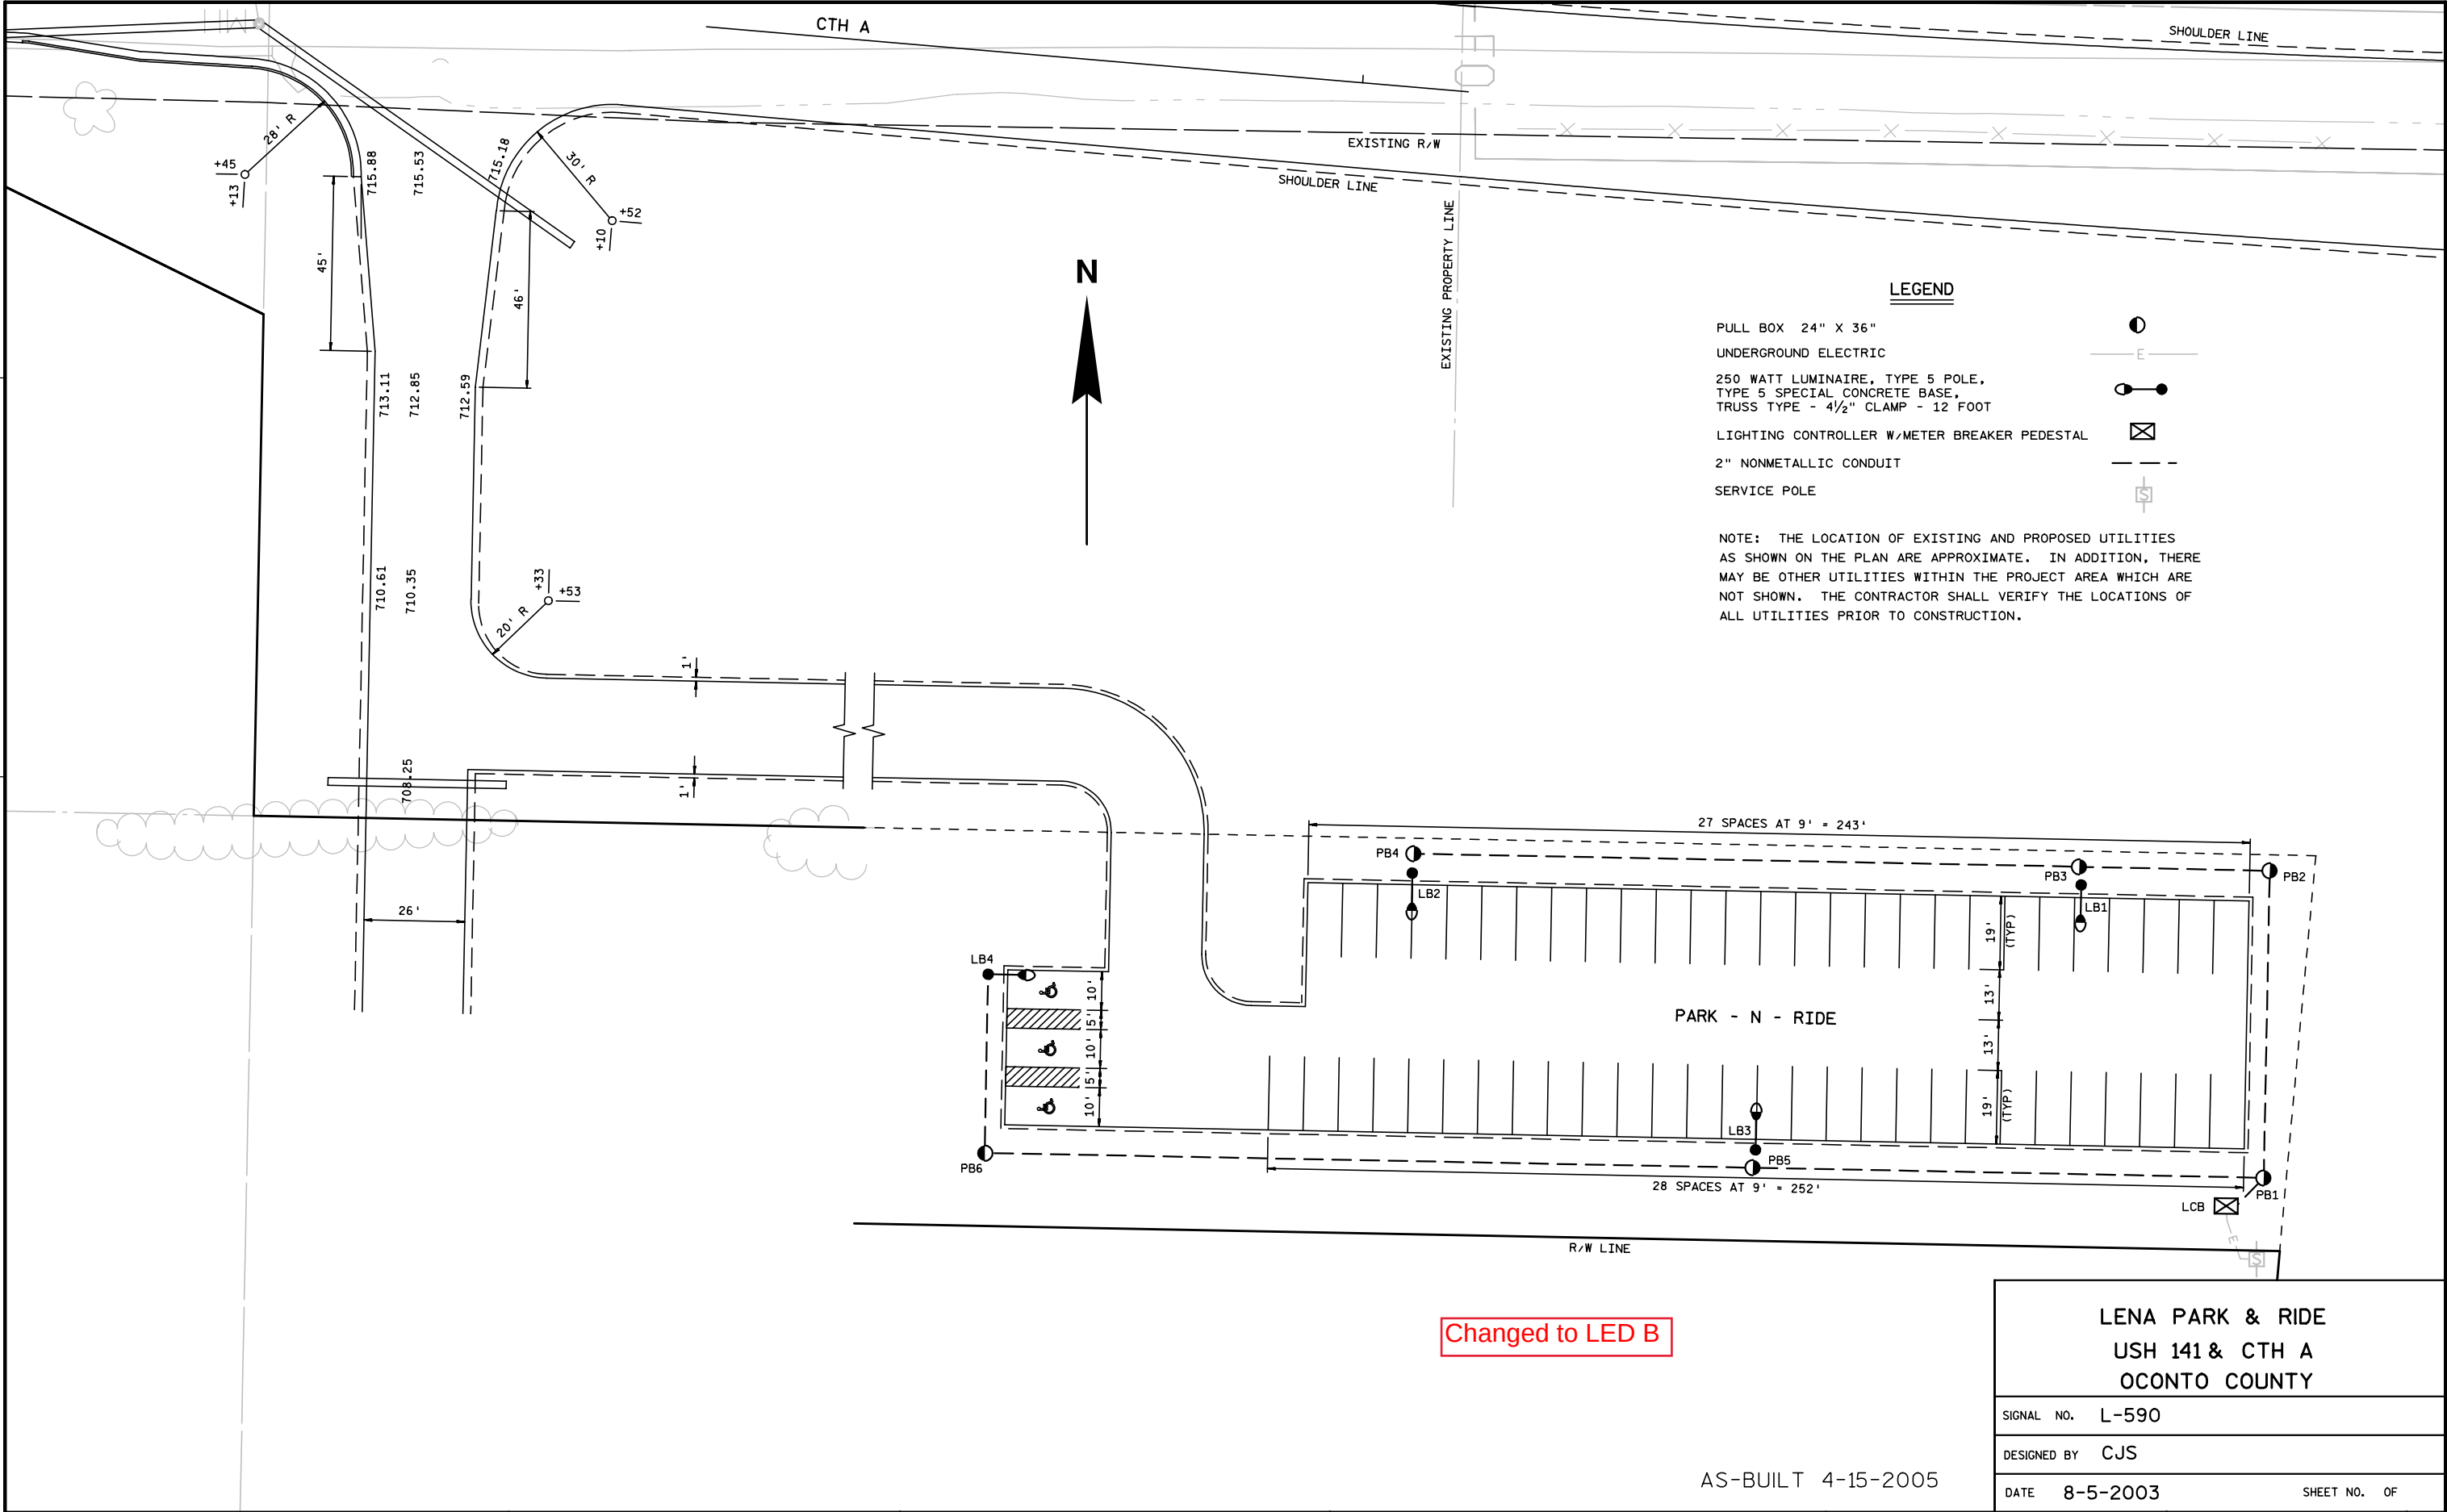

Changed to LED B

LENA PARK & RIDE USH 141 & CTH A OCONTO COUNTY	
SIGNAL NO.	L-590
DESIGNED BY	CJS
DATE	8-5-2003
SHEET NO.	OF

AS-BUILT 4-15-2005

STATE PROJECT NUMBER:1490-14-71

HWY: USH 141

COUNTY: OCONTO

CONSTRUCTION DETAIL (PARK - N - RIDE)

SCALE, FEET 0 20 40

SHEET NO:

E

FILE NAME : F:\D3_1490140\+slg205s.dgn

PLOT DATE : 10-MAY-2005 09:10

ORG DATE : 8-15-02

PLOT NAME : +slg205s-a

Originator : DIST 3

PLOT SCALE : 40.000000:1.000000

WISDOT/CADDs SHEET 42