


LEVELS ON - 1, 2, 3, 58, 60, 61, 62, 63

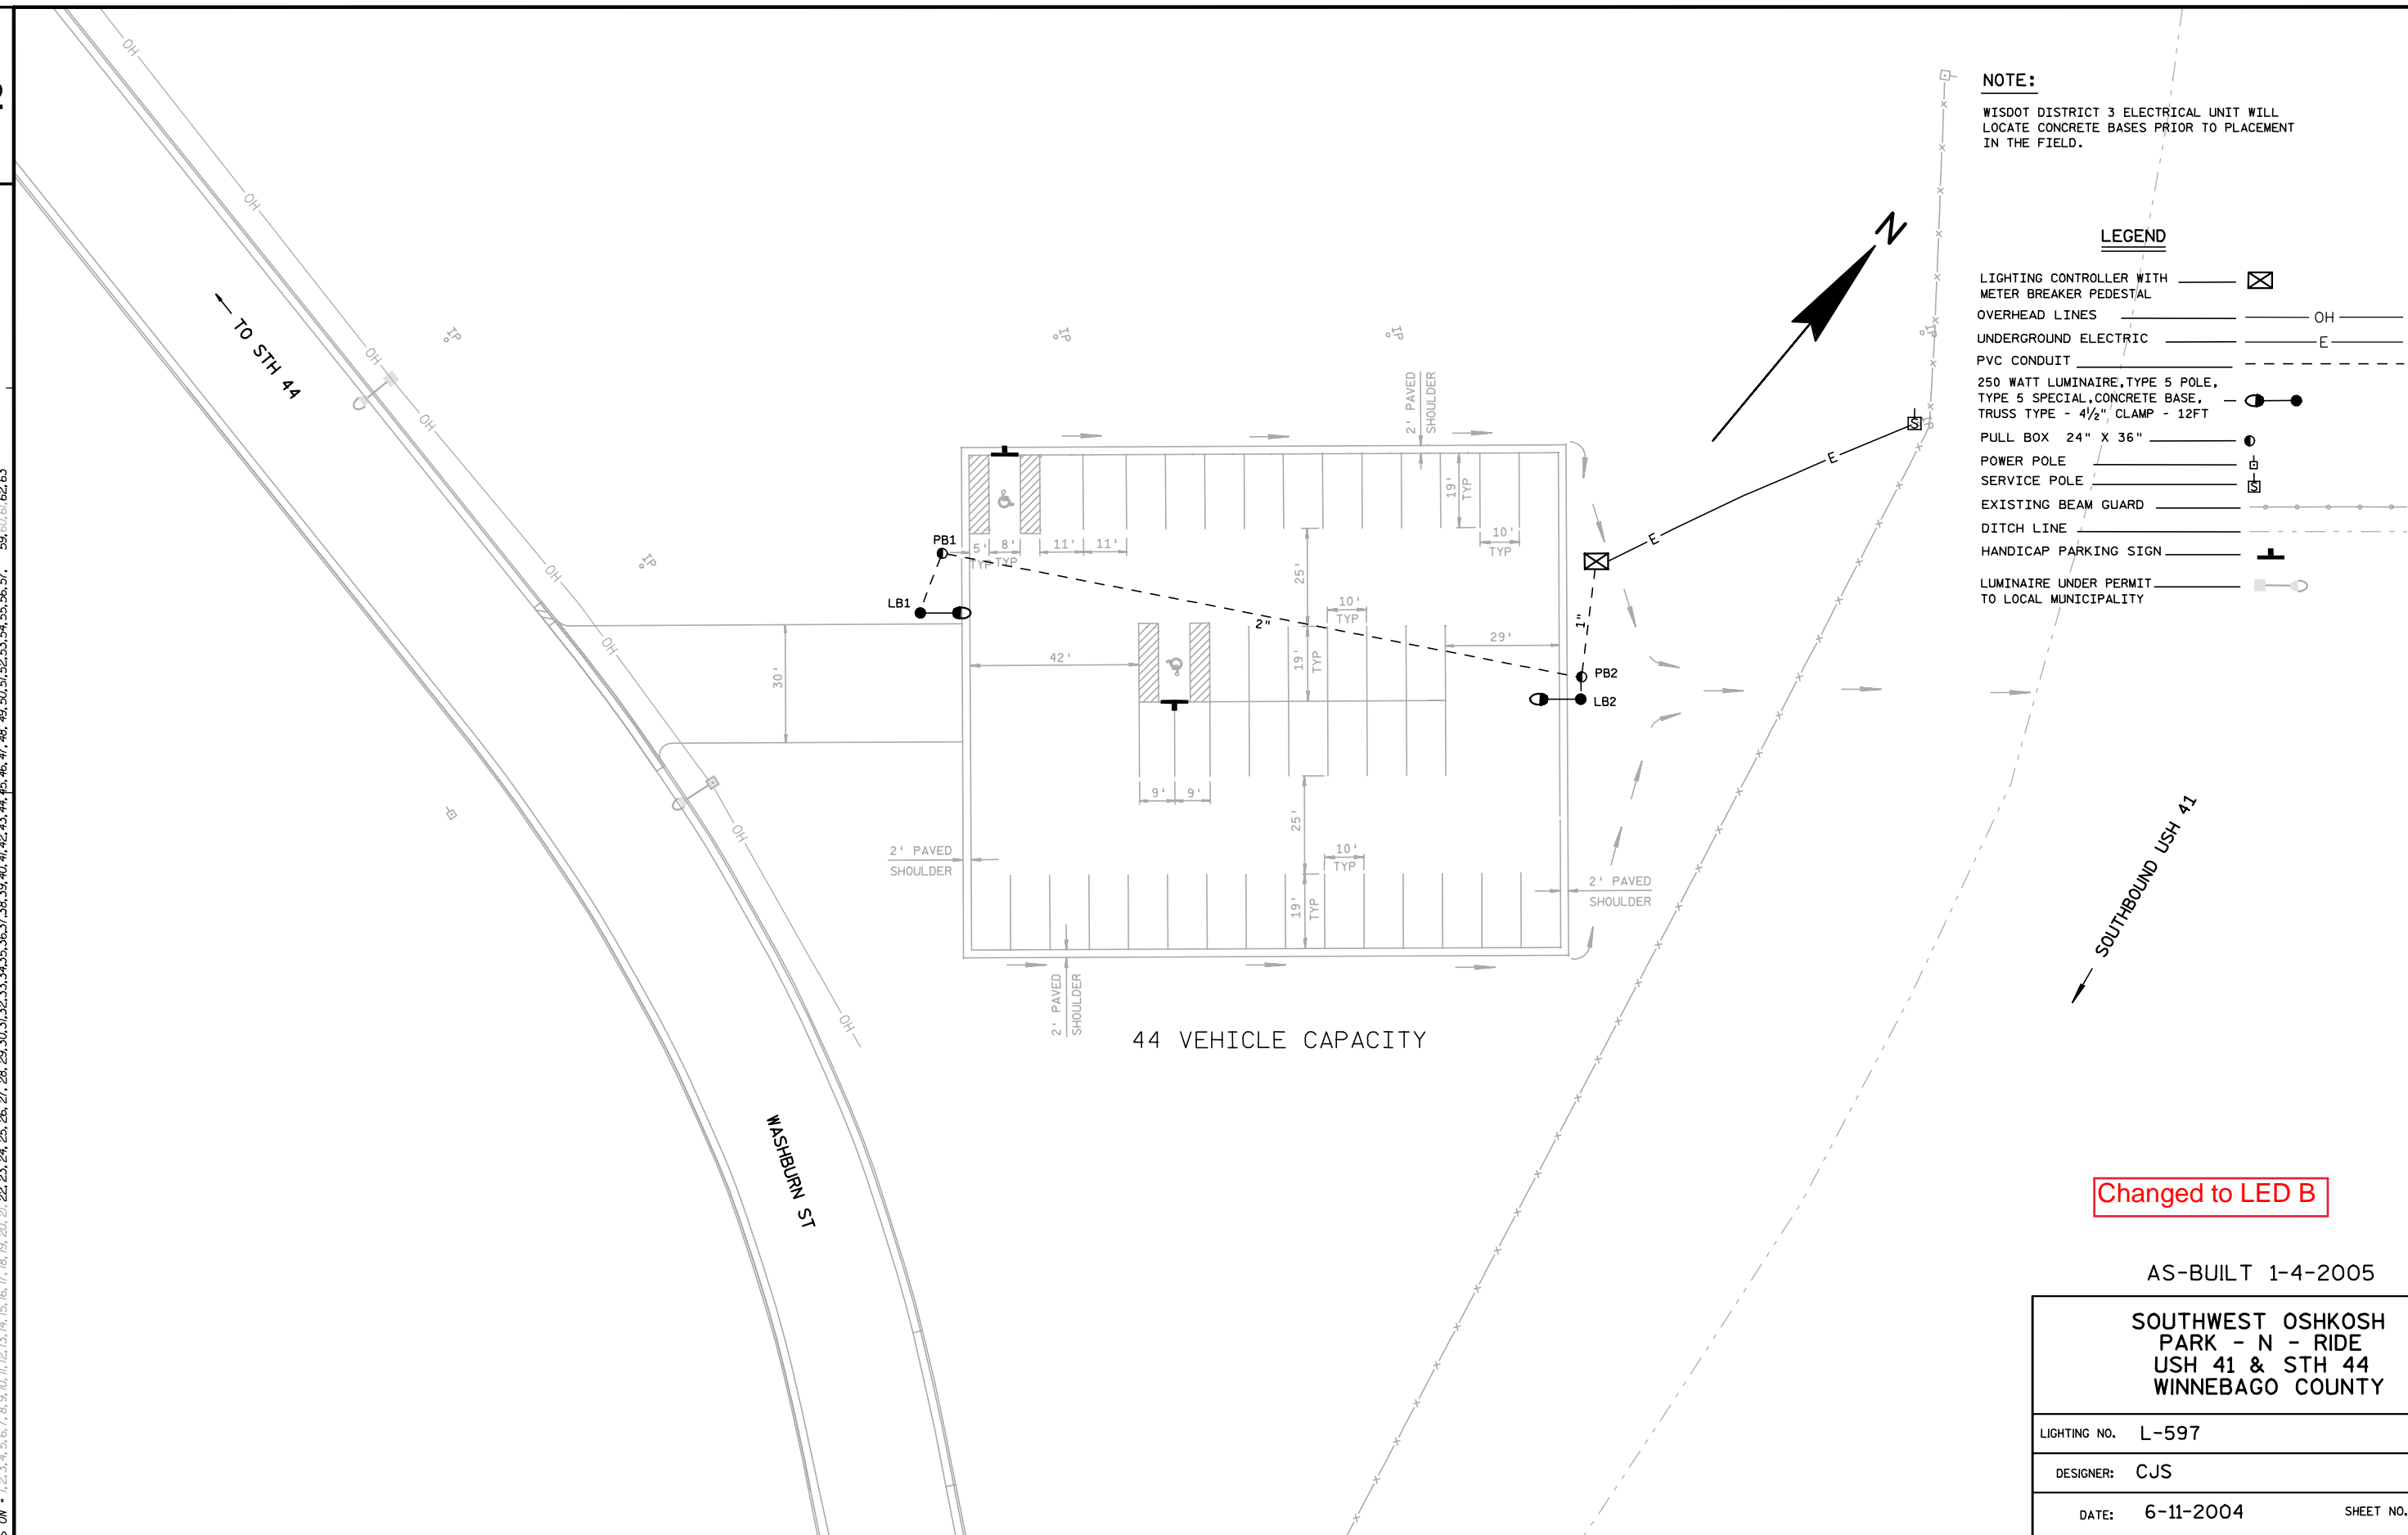

Changed to LED B

AS-BUILT 1-4-2005

SOUTHWEST OSHKOSH  
PARK - N - RIDE  
USH 41 & STH 44  
WINNEBAGO COUNTY

LIGHTING NO. L-597

DESIGNER: CJS

DATE: 6-11-2004

SHEET NO. 1 OF 1

STATE PROJECT NUMBER: 6496-02-71

HWY: STH 91

COUNTY: WINNEBAGO

SOUTHWEST OSHKOSH PARK &amp; RIDE (L-597)

SCALE, FEET

SHEET NO:

E