

LIGHTING CONTROL CABINET WITH _____

METER BREAKER PEDESTAL _____

CONDUIT, NON-METALLIC _____ - - - - -

150 WATT LUMINAIRE, TYPE 5 POLE,
TYPE 5 CONCRETE BASE, _____

TRUSS TYPE - 4½" CLAMP - 12FT


PULL BOX 24" X 42" _____

POWER POLE _____

SERVICE POLE _____

ELECTRIC, UNDERGROUND _____ — E —

YIELD SIGN _____

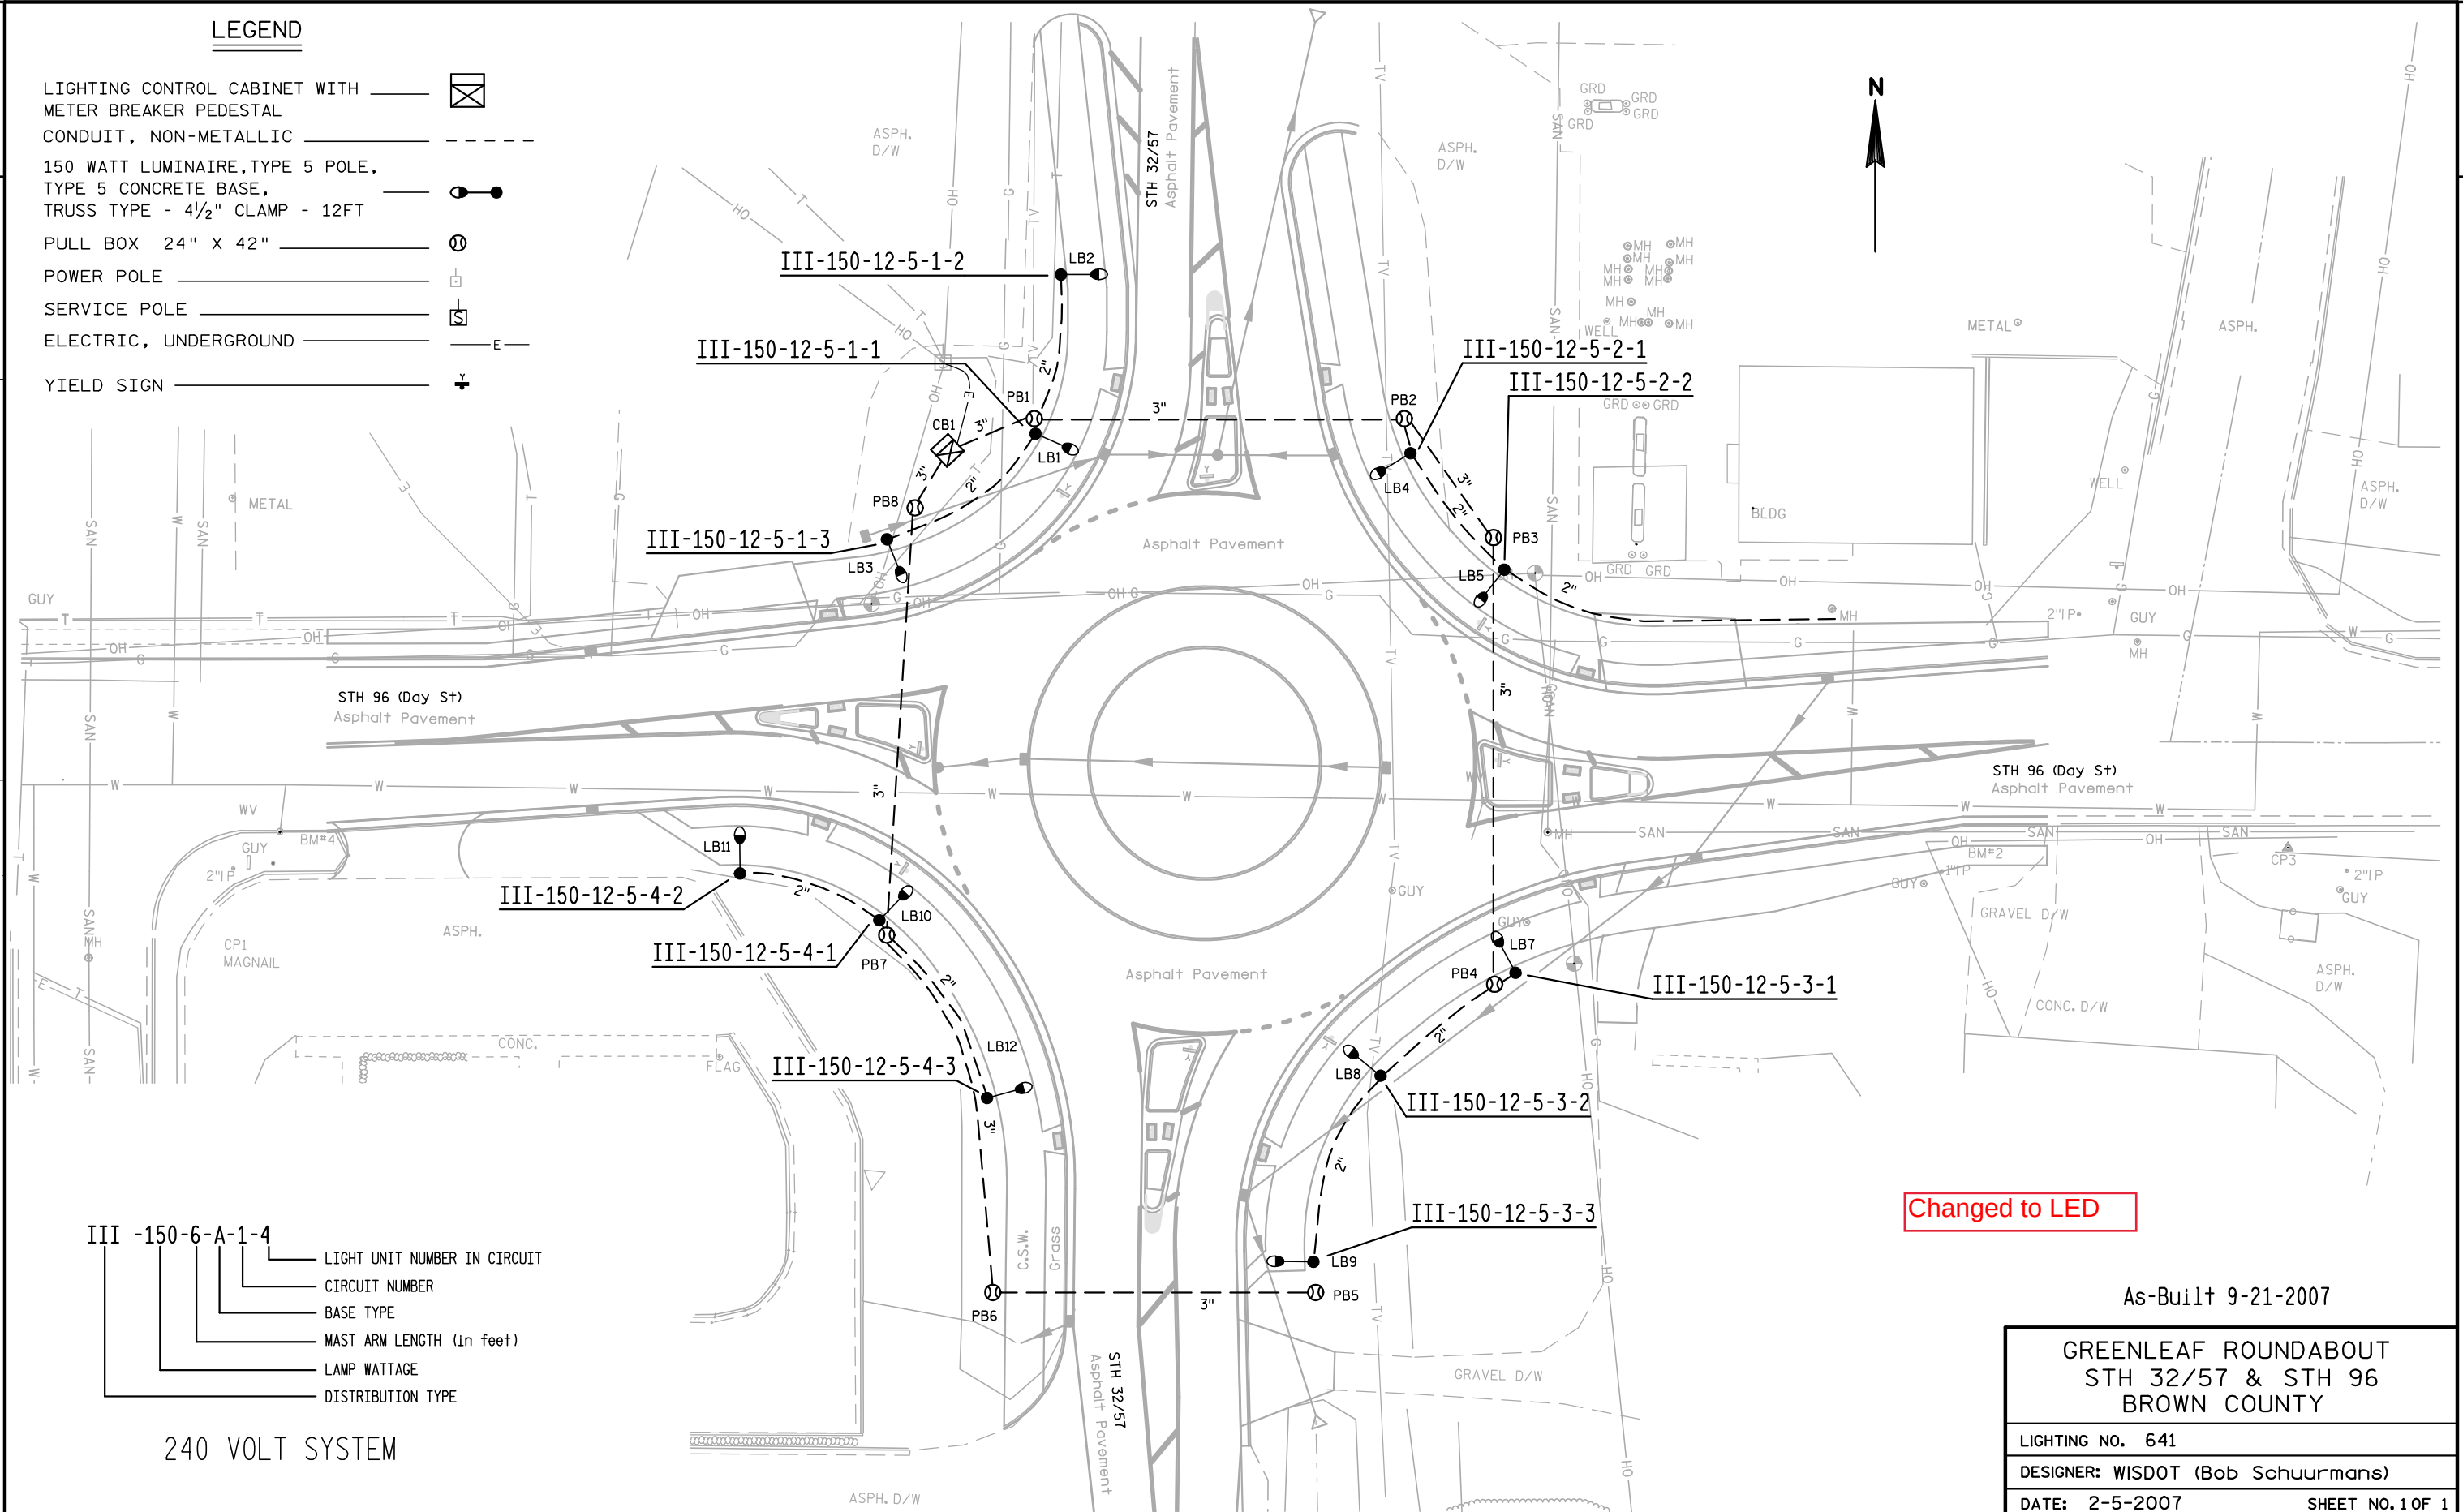

Changed to LED

As-Built 9-21-2007

GREENLEAF ROUNDABOUT
STH 32/57 & STH 96
BROWN COUNTY

LIGHTING NO. 641

DESIGNER: WISDOT (Bob Schuurmans)

DATE: 2-5-2007

SHEET NO. 1 OF 1

PROJECT NO: 4085-23-71

HWY: STH 32/57

COUNTY: BROWN

ROUNDABOUT LIGHTING L-641

SHEET

E