


NOTE:
THE LOCATION OF EXISTING AND PROPOSED UTILITIES AS SHOWN ON THE PLANS ARE APPROXIMATE. IN ADDITION, THERE MAY BE OTHER UTILITIES WITHIN THE PROJECT AREA WHICH ARE NOT SHOWN. THE CONTRACTOR SHALL VERIFY THE LOCATIONS OF ALL UTILITIES PRIOR TO CONSTRUCTION.

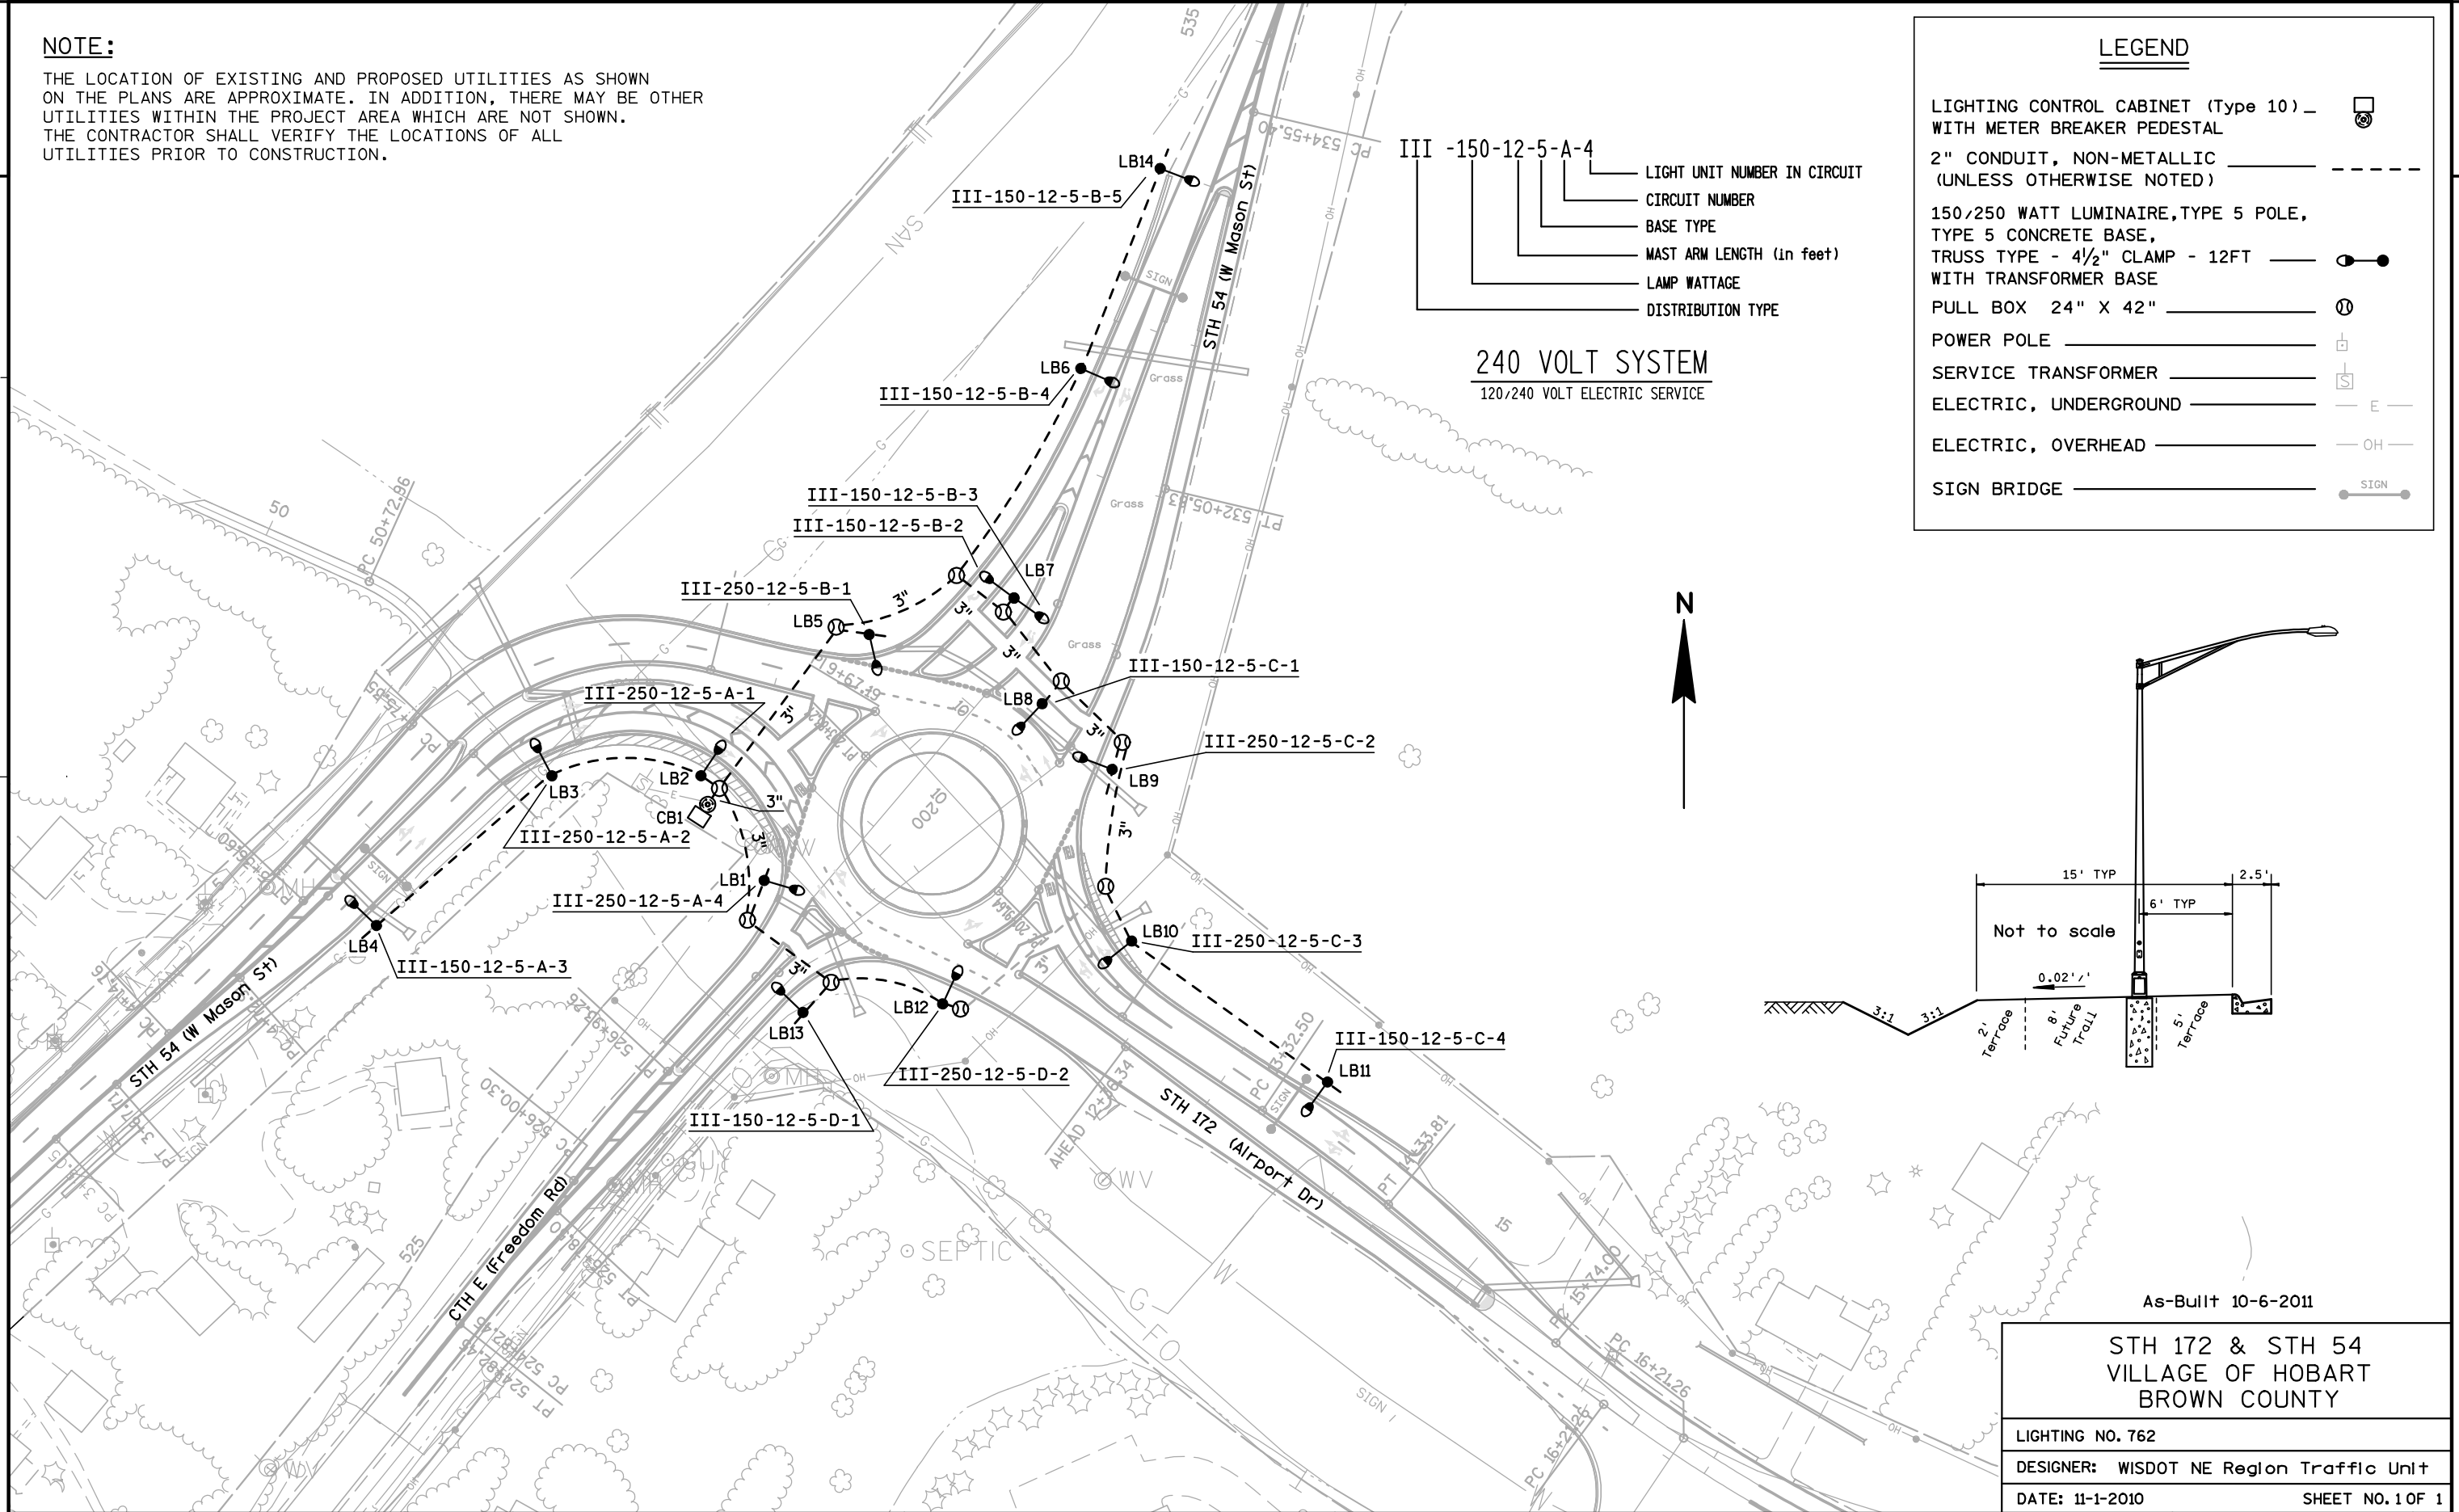


III -150-12-5-A-4
— LIGHT UNIT NUMBER IN CIRCUIT
— CIRCUIT NUMBER
— BASE TYPE
— MAST ARM LENGTH (in feet)
— LAMP WATTAGE
— DISTRIBUTION TYPE

240 VOLT SYSTEM
120/240 VOLT ELECTRIC SERVICE

LEGEND

- LIGHTING CONTROL CABINET (Type 10) — WITH METER BREAKER PEDESTAL
- 2" CONDUIT, NON-METALLIC (UNLESS OTHERWISE NOTED)
- 150/250 WATT LUMINAIRE, TYPE 5 POLE, TYPE 5 CONCRETE BASE, TRUSS TYPE - 4 1/2" CLAMP - 12FT WITH TRANSFORMER BASE
- PULL BOX 24" X 42"
- POWER POLE
- SERVICE TRANSFORMER
- ELECTRIC, UNDERGROUND — E —
- ELECTRIC, OVERHEAD — OH —
- SIGN BRIDGE — SIGN —

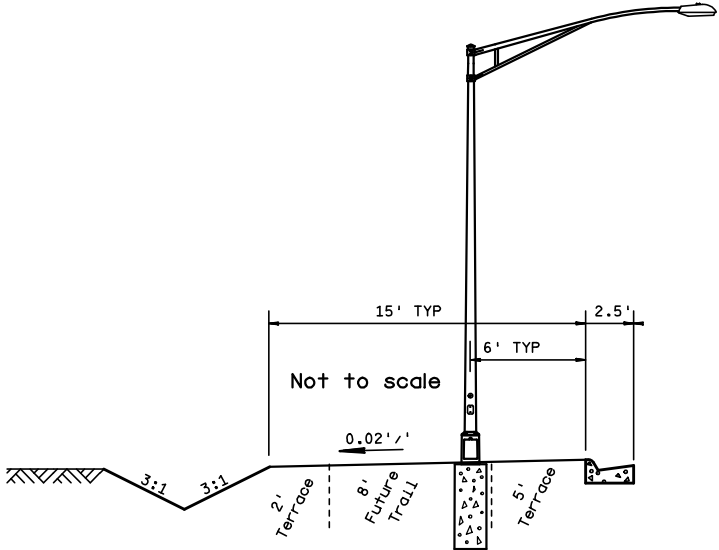

As-Built 10-6-2011

**STH 172 & STH 54
VILLAGE OF HOBART
BROWN COUNTY**

LIGHTING NO. 762
DESIGNER: WISDOT NE Region Traffic Unit
DATE: 11-1-2010 SHEET NO. 1 OF 1