


III -150-12-5-A-4
LIGHT UNIT NUMBER IN CIRCUIT
CIRCUIT
BASE TYPE
MAST ARM LENGTH (in feet)
LAMP WATTAGE
DISTRIBUTION TYPE

240 VOLT SYSTEM
120/240 VOLT ELECTRIC SERVICE

NOTE:

THE LOCATION OF EXISTING AND PROPOSED UTILITIES AS SHOWN ON THE PLANS ARE APPROXIMATE. IN ADDITION, THERE MAY BE OTHER UTILITIES WITHIN THE PROJECT AREA WHICH ARE NOT SHOWN. THE CONTRACTOR SHALL VERIFY THE LOCATIONS OF ALL UTILITIES PRIOR TO CONSTRUCTION.

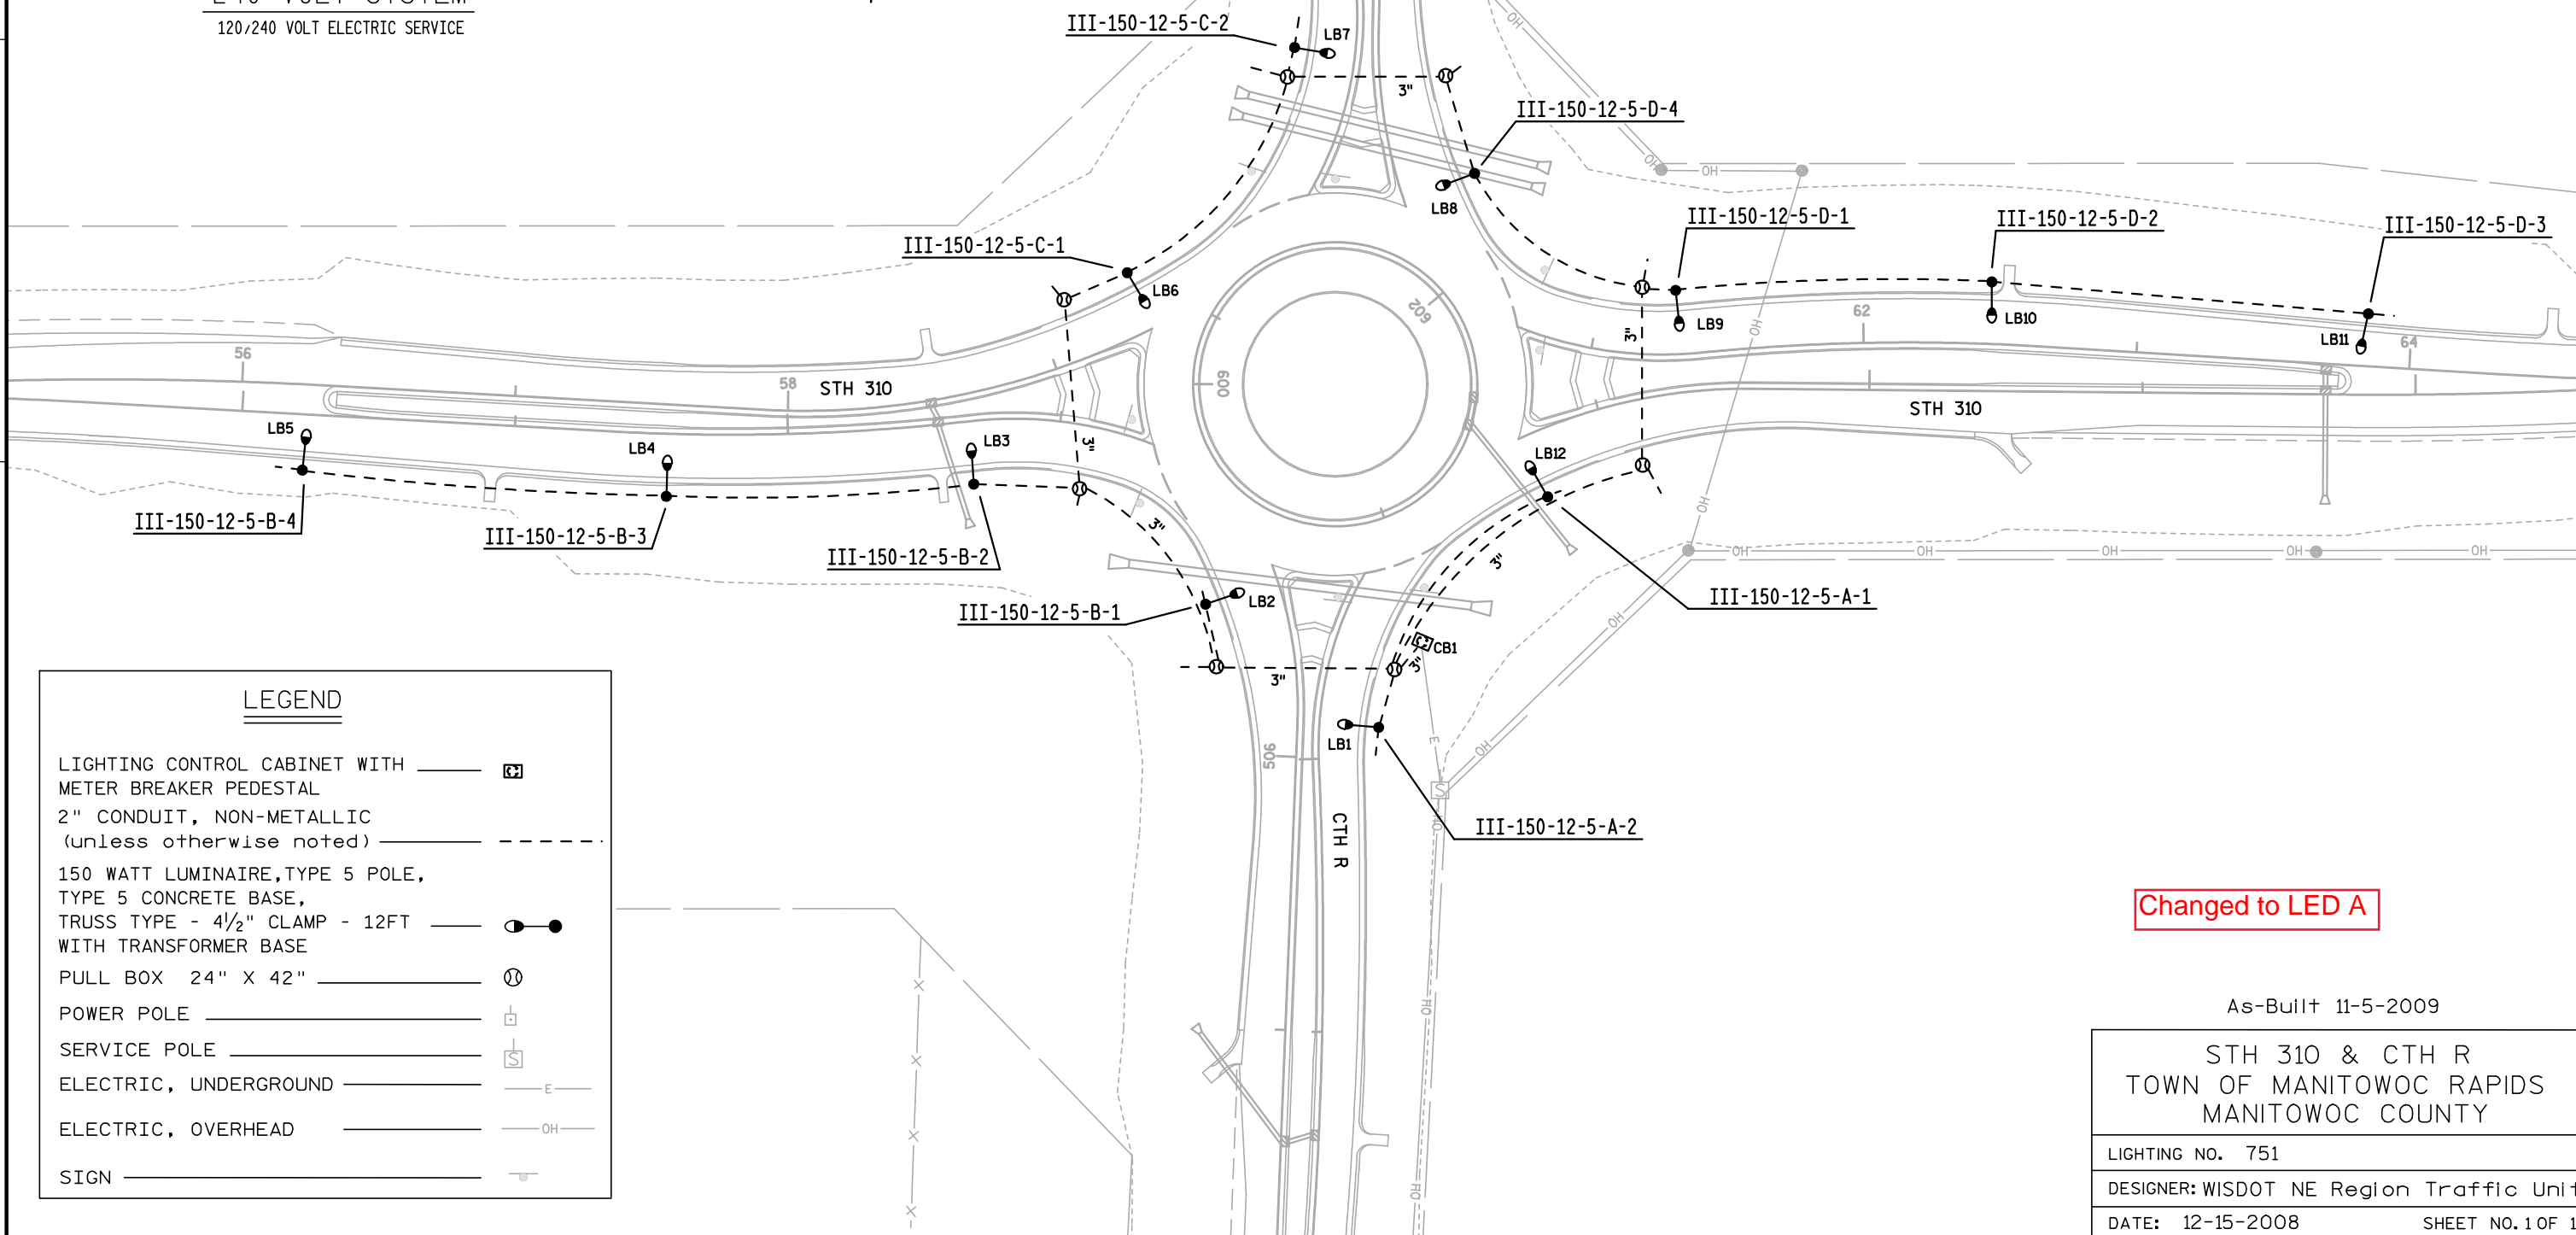

LEGEND

LIGHTING CONTROL CABINET WITH METER BREAKER PEDESTAL
2" CONDUIT, NON-METALLIC (unless otherwise noted)
150 WATT LUMINAIRE, TYPE 5 POLE, TYPE 5 CONCRETE BASE, TRUSS TYPE - 4 1/2" CLAMP - 12FT WITH TRANSFORMER BASE
PULL BOX 24" X 42"
POWER POLE
SERVICE POLE
ELECTRIC, UNDERGROUND
ELECTRIC, OVERHEAD
SIGN

Changed to LED A

As-Built 11-5-2009

STH 310 & CTH R
TOWN OF MANITOWOC RAPIDS
MANITOWOC COUNTY

LIGHTING NO. 751

DESIGNER: WISDOT NE Region Traffic Unit

DATE: 12-15-2008

SHEET NO. 1 OF 1

PROJECT NO: 4337-17-71

HWY: STH 310

COUNTY: MANITOWOC

ROUNDABOUT LIGHTING L-751

SHEET

E