


III -150-12-5-A-4
LIGHT UNIT NUMBER IN CIRCUIT
CIRCUIT
BASE TYPE
MAST ARM LENGTH (in feet)
LAMP WATTAGE
DISTRIBUTION TYPE

240 VOLT SYSTEM
120/240 VOLT ELECTRIC SERVICE

NOTE:

THE LOCATION OF EXISTING AND PROPOSED UTILITIES AS SHOWN ON THE PLANS ARE APPROXIMATE. IN ADDITION, THERE MAY BE OTHER UTILITIES WITHIN THE PROJECT AREA WHICH ARE NOT SHOWN. THE CONTRACTOR SHALL VERIFY THE LOCATIONS OF ALL UTILITIES PRIOR TO CONSTRUCTION.

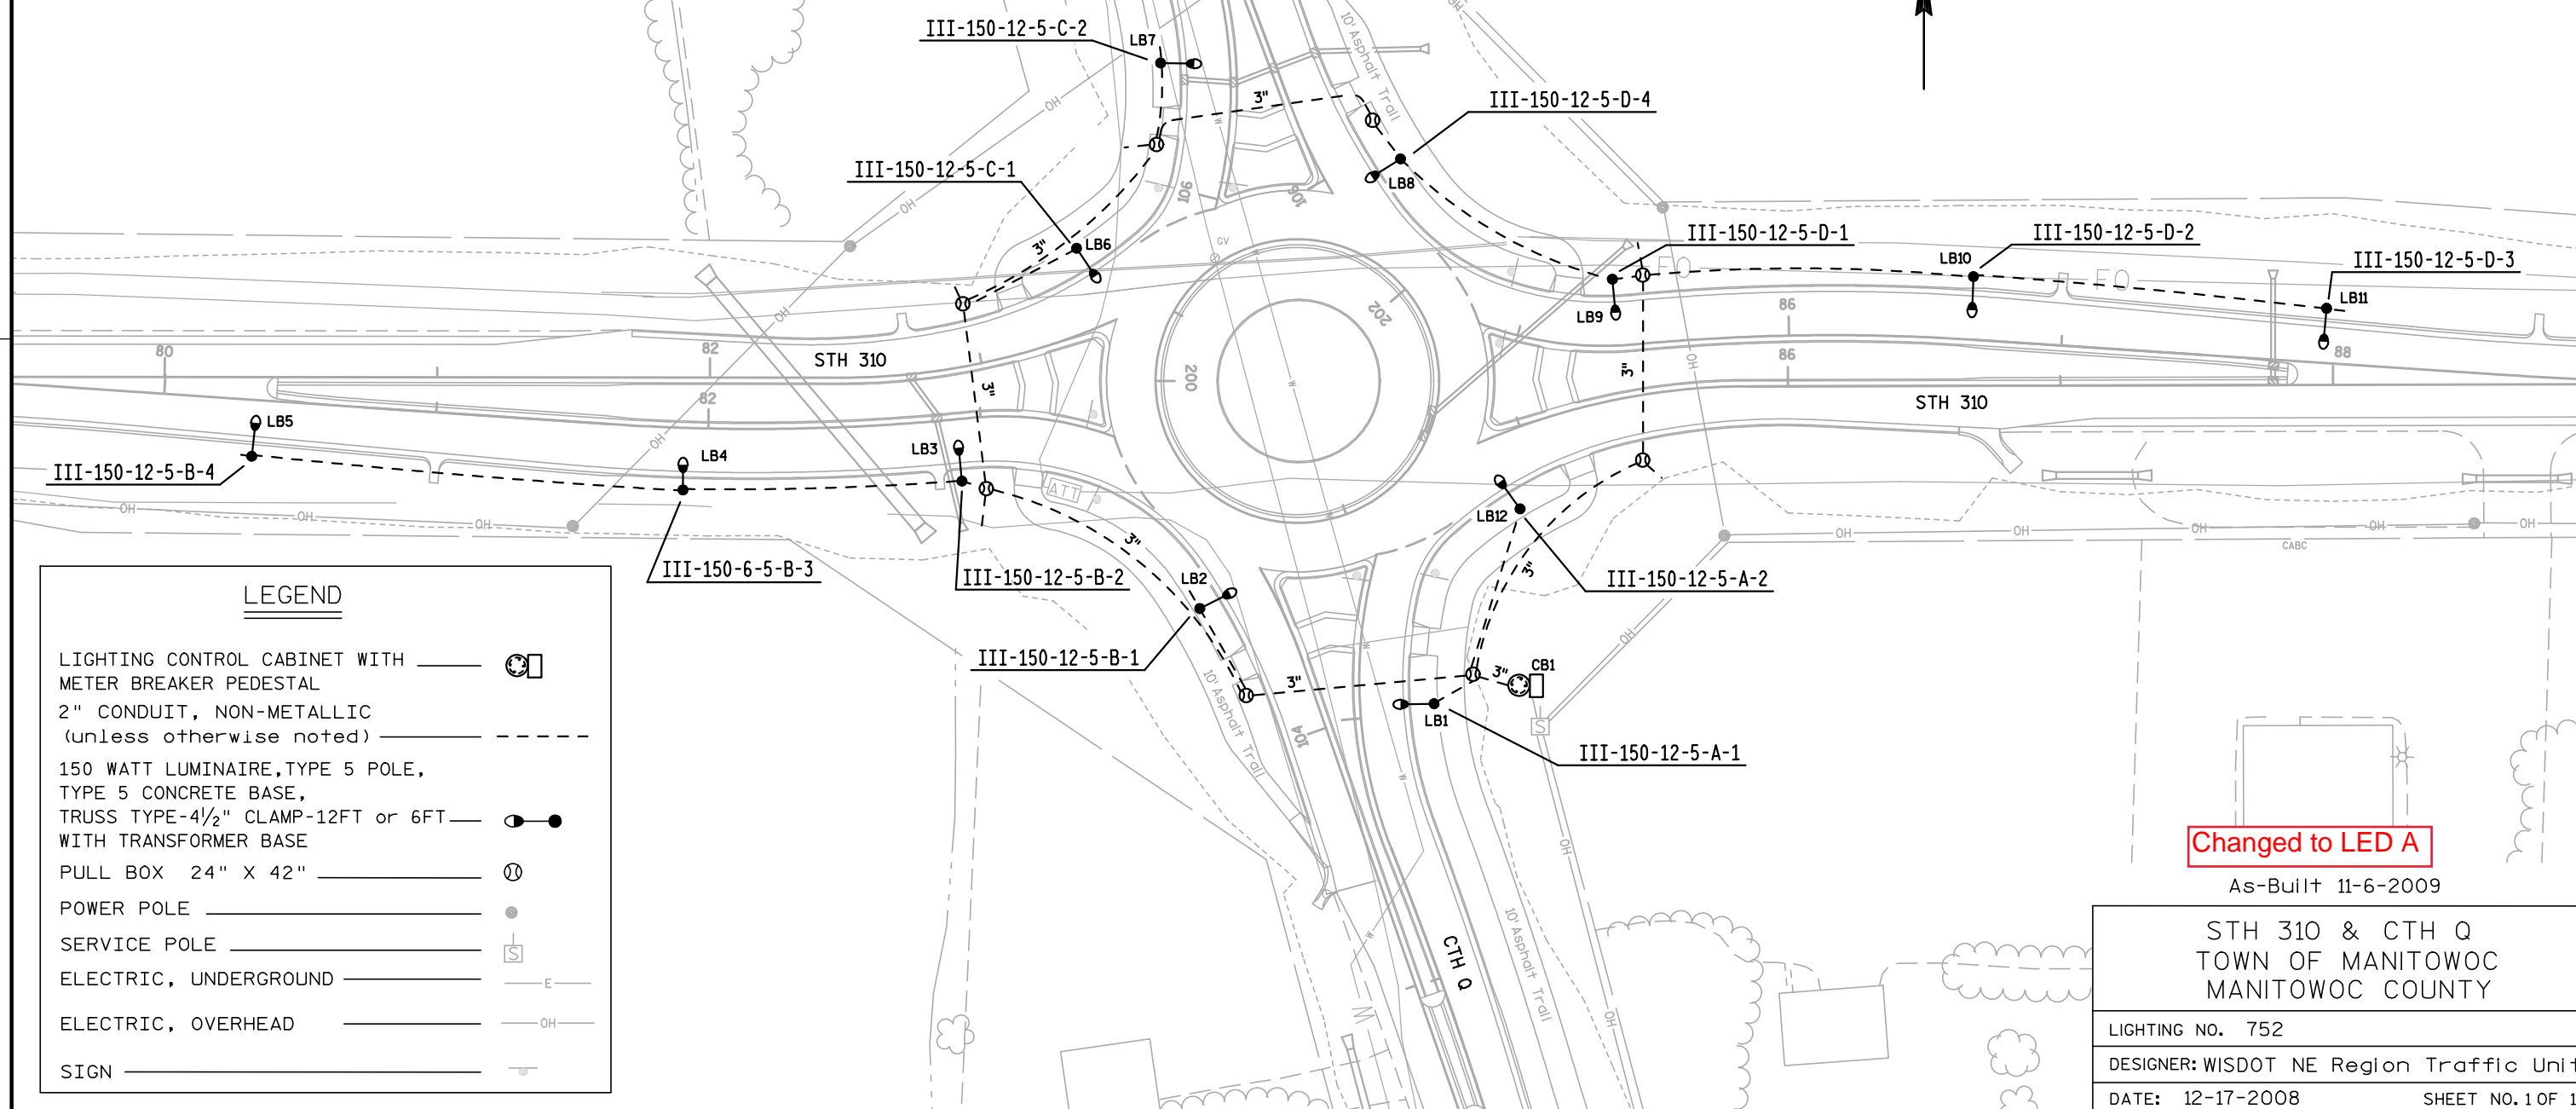

Changed to LED A

As-Built 11-6-2009

STH 310 & CTH Q
TOWN OF MANITOWOC
MANITOWOC COUNTY

LIGHTING NO. 752

DESIGNER: WISDOT NE Region Traffic Unit

DATE: 12-17-2008

SHEET NO. 1 OF 1

PROJECT NO: 4337-18-71

HWY: STH 310

COUNTY: MANITOWOC

ROUNDABOUT LIGHTING DETAIL L-752

SHEET

E