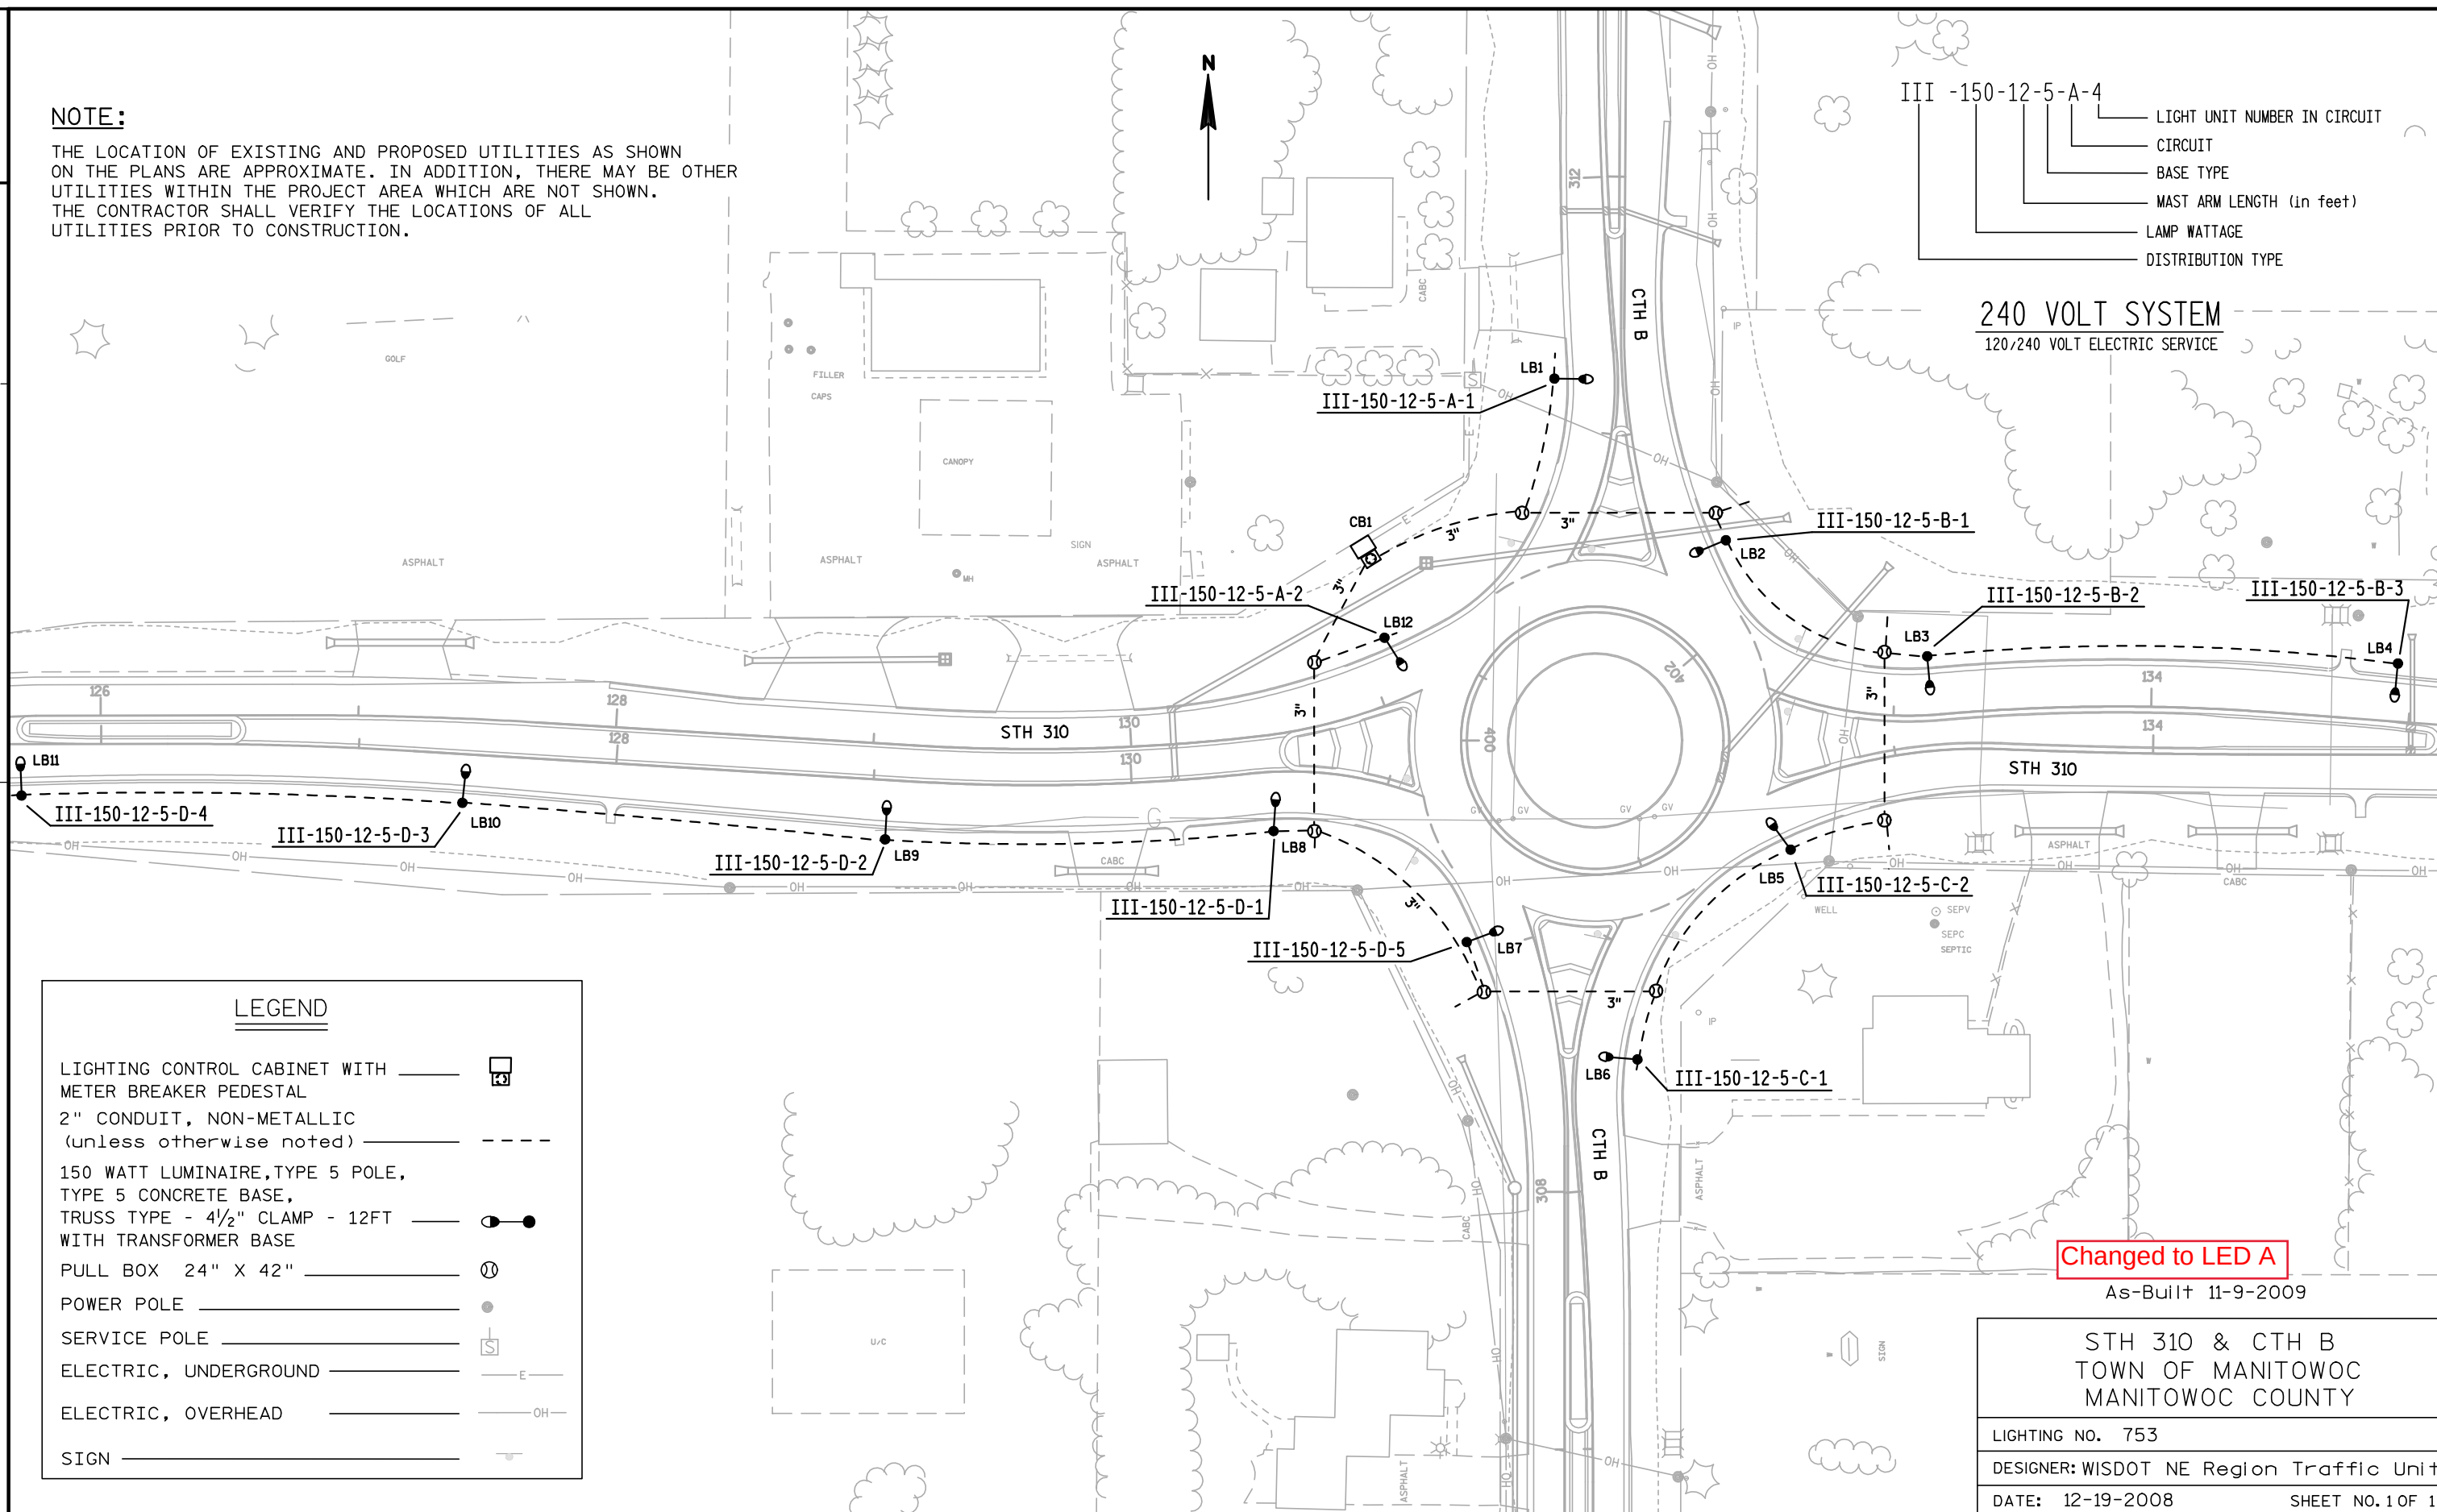


**NOTE:**

THE LOCATION OF EXISTING AND PROPOSED UTILITIES AS SHOWN ON THE PLANS ARE APPROXIMATE. IN ADDITION, THERE MAY BE OTHER UTILITIES WITHIN THE PROJECT AREA WHICH ARE NOT SHOWN. THE CONTRACTOR SHALL VERIFY THE LOCATIONS OF ALL UTILITIES PRIOR TO CONSTRUCTION.

III -150-12-5-A-4  
LIGHT UNIT NUMBER IN CIRCUIT  
CIRCUIT  
BASE TYPE  
MAST ARM LENGTH (in feet)  
LAMP WATTAGE  
DISTRIBUTION TYPE

**240 VOLT SYSTEM**  
120/240 VOLT ELECTRIC SERVICE

**LEGEND**

LIGHTING CONTROL CABINET WITH METER BREAKER PEDESTAL   
2" CONDUIT, NON-METALLIC (unless otherwise noted)   
150 WATT LUMINAIRE, TYPE 5 POLE, TYPE 5 CONCRETE BASE, TRUSS TYPE - 4 1/2" CLAMP - 12FT WITH TRANSFORMER BASE   
PULL BOX 24" X 42"   
POWER POLE   
SERVICE POLE   
ELECTRIC, UNDERGROUND   
ELECTRIC, OVERHEAD   
SIGN 

**Changed to LED A**

As-Built 11-9-2009

STH 310 & CTH B  
TOWN OF MANITOWOC  
MANITOWOC COUNTY

LIGHTING NO. 753

DESIGNER: WISDOT NE Region Traffic Unit

DATE: 12-19-2008

SHEET NO. 1 OF 1