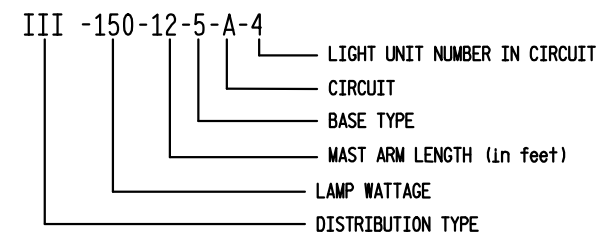
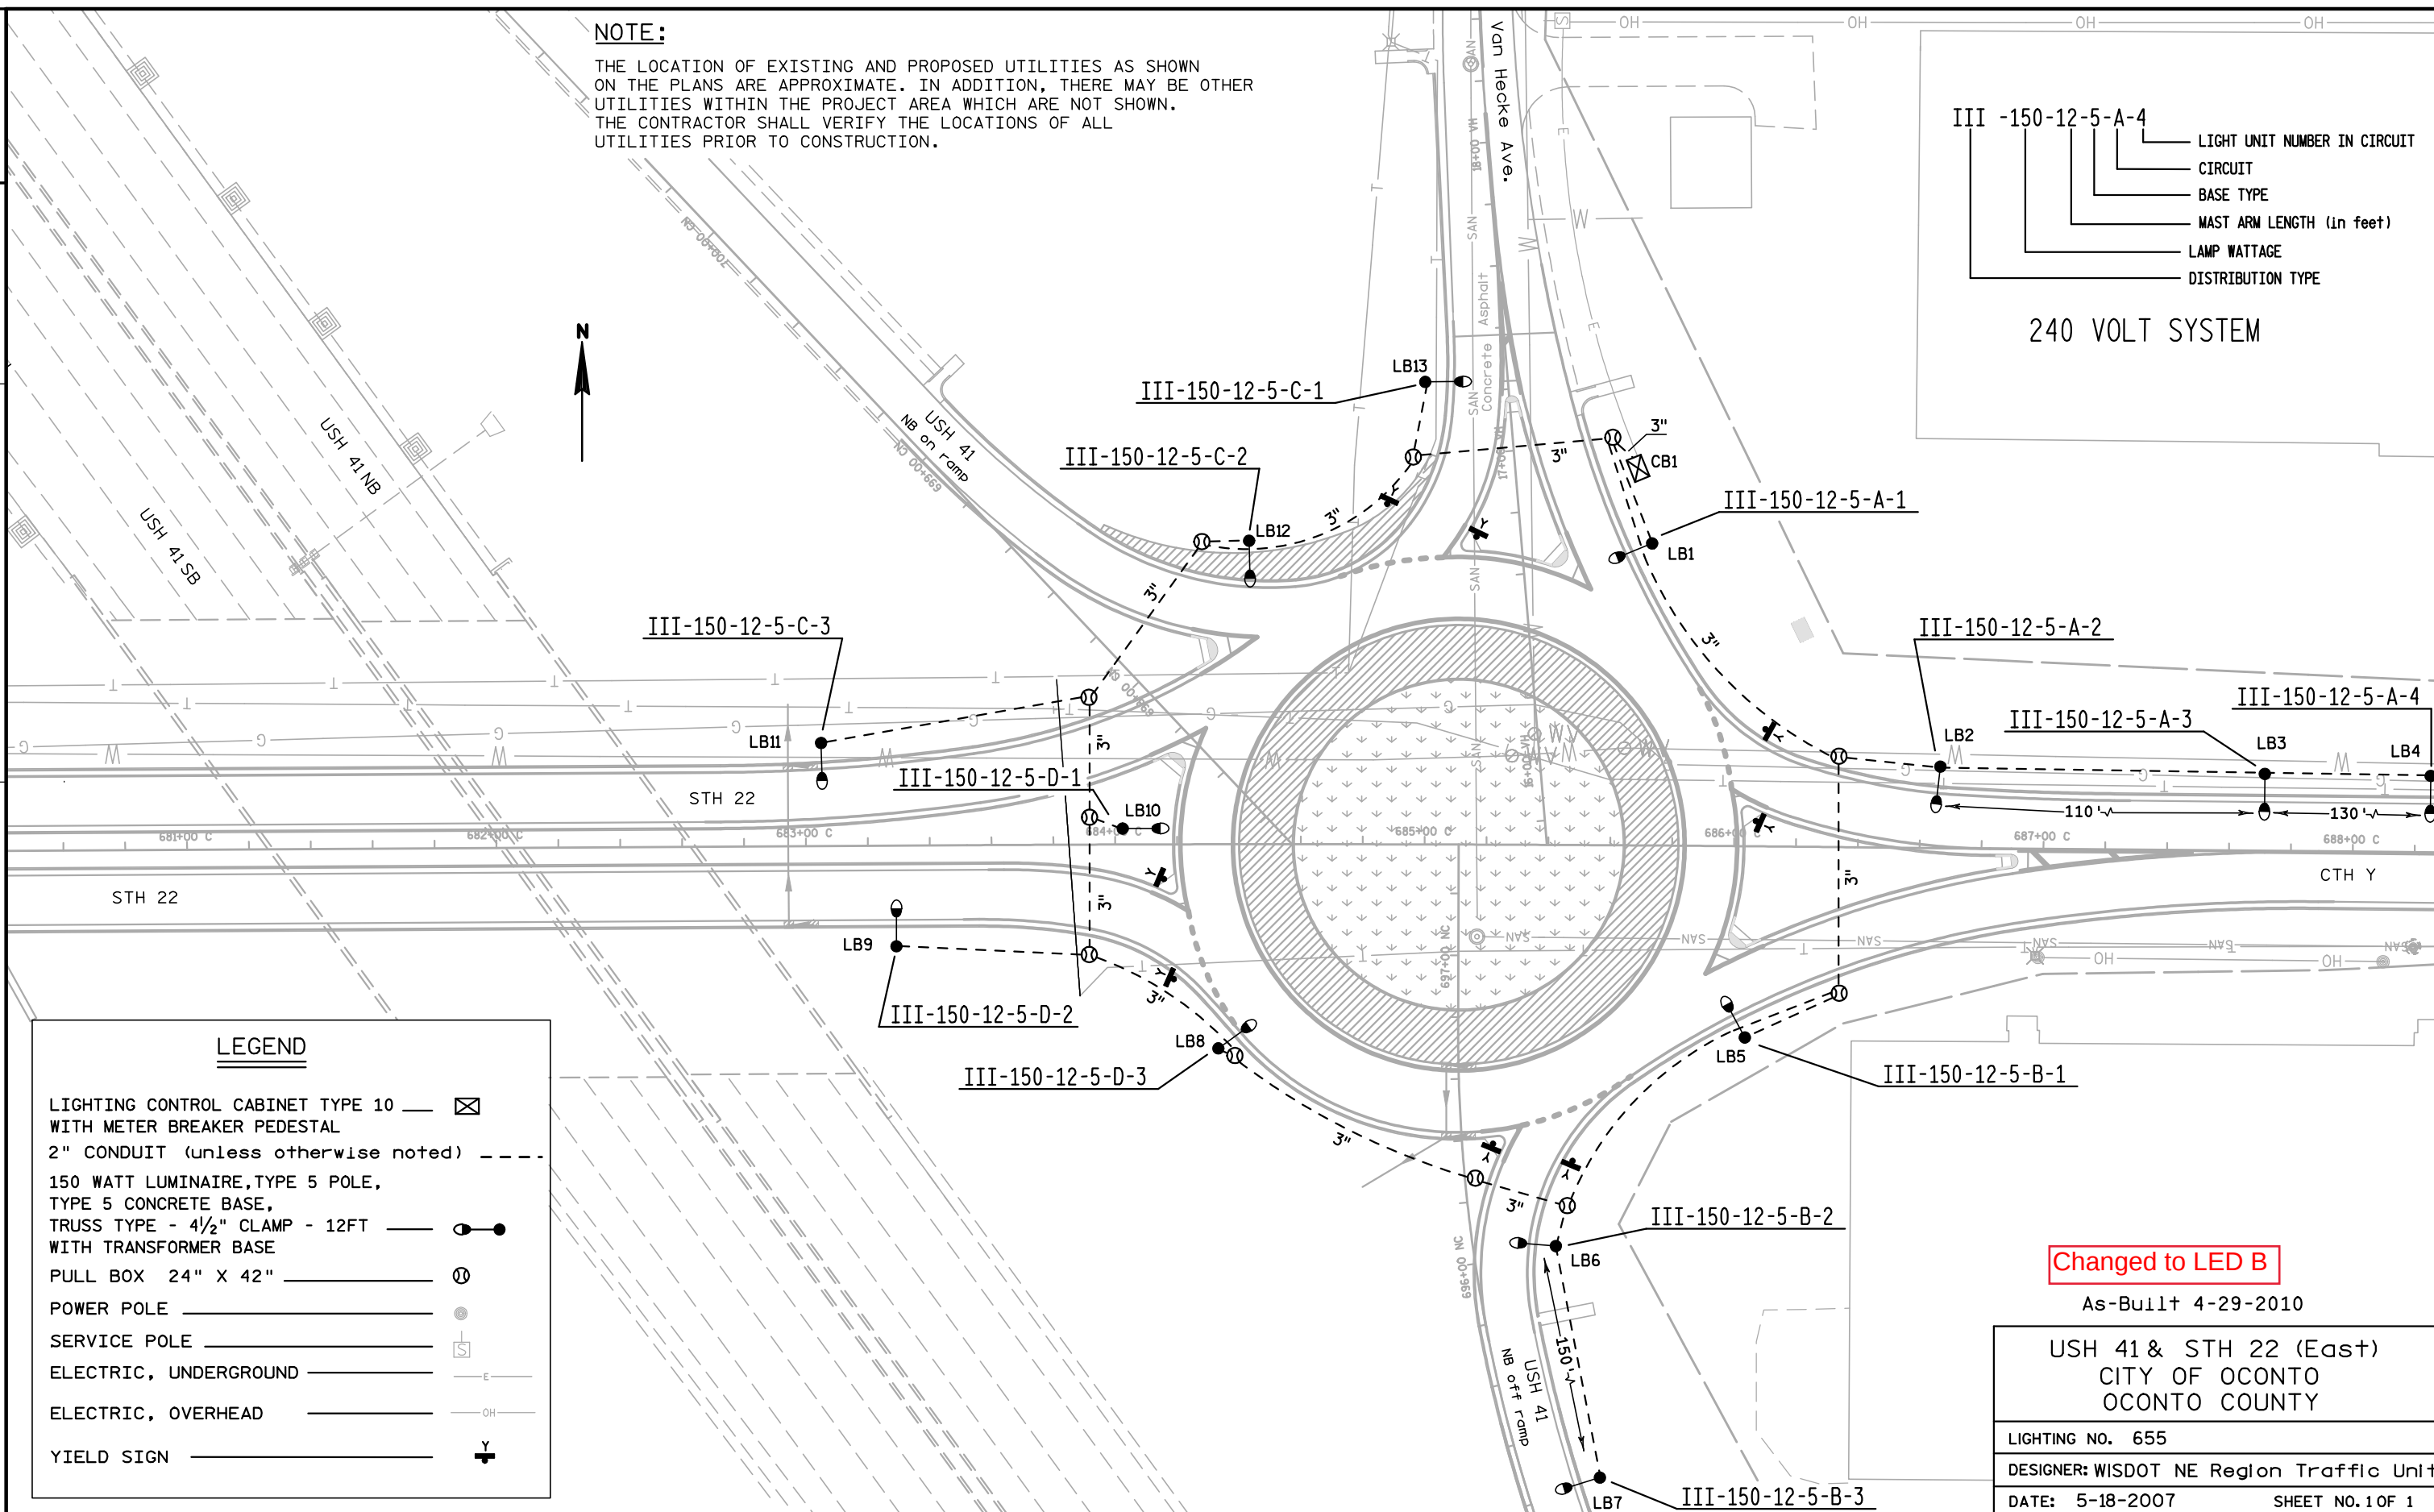


NOTE:

THE LOCATION OF EXISTING AND PROPOSED UTILITIES AS SHOWN ON THE PLANS ARE APPROXIMATE. IN ADDITION, THERE MAY BE OTHER UTILITIES WITHIN THE PROJECT AREA WHICH ARE NOT SHOWN. THE CONTRACTOR SHALL VERIFY THE LOCATIONS OF ALL UTILITIES PRIOR TO CONSTRUCTION.

**240 VOLT SYSTEM**

LEGEND	
LIGHTING CONTROL CABINET TYPE 10 WITH METER BREAKER PEDESTAL	☒
2" CONDUIT (unless otherwise noted)	---
150 WATT LUMINAIRE, TYPE 5 POLE, TYPE 5 CONCRETE BASE, TRUSS TYPE - 4 1/2" CLAMP - 12FT WITH TRANSFORMER BASE	●—●
PULL BOX 24" X 42"	⊙
POWER POLE	●
SERVICE POLE	⊞
ELECTRIC, UNDERGROUND	—E—
ELECTRIC, OVERHEAD	—OH—
YIELD SIGN	Y

**Changed to LED B**

As-Built 4-29-2010

USH 41 & STH 22 (East)
CITY OF OCONTO
OCONTO COUNTY

LIGHTING NO. 655

DESIGNER: WISDOT NE Region Traffic Unit

DATE: 5-18-2007

SHEET NO. 1 OF 1

PROJECT NO: 1154-01-76

HWY: STH 22

COUNTY: OCONTO

ROUNDAABOUT LIGHTING L-655

SHEET

E