


III -150-12-5-A-4
LIGHT UNIT NUMBER IN CIRCUIT
CIRCUIT NUMBER
BASE TYPE
MAST ARM LENGTH (in feet)
LAMP WATTAGE
DISTRIBUTION TYPE

240 VOLT SYSTEM
120/240 VOLT ELECTRIC SERVICE

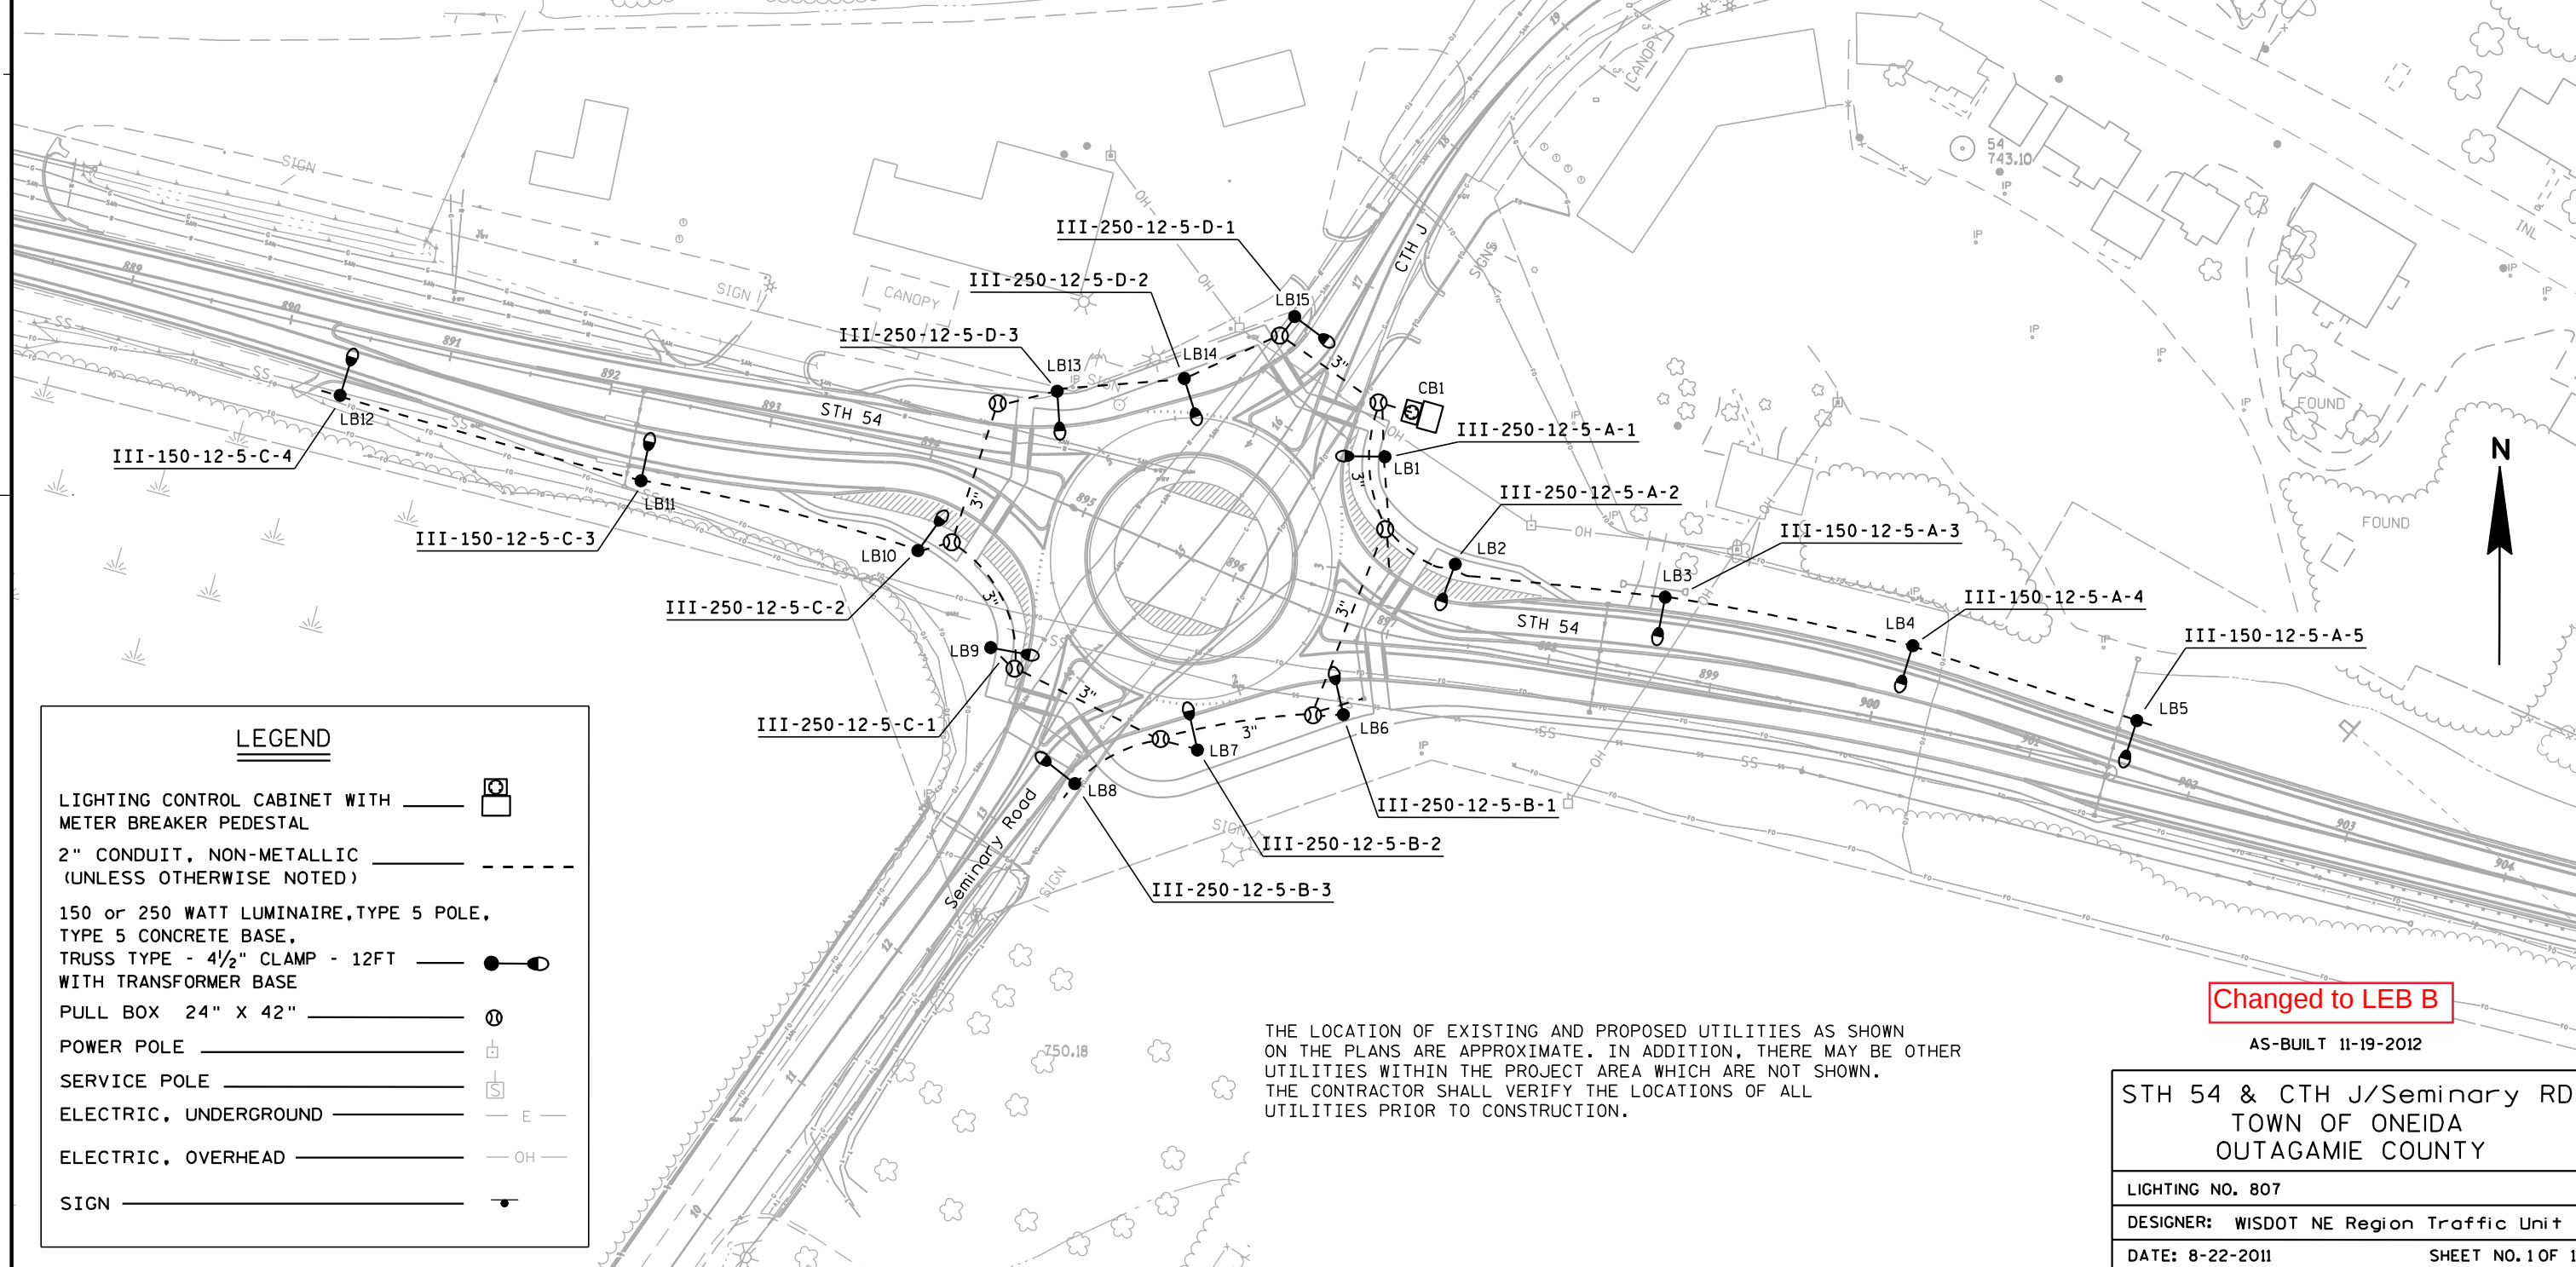

LEGEND

LIGHTING CONTROL CABINET WITH METER BREAKER PEDESTAL 

2" CONDUIT, NON-METALLIC (UNLESS OTHERWISE NOTED) 

150 or 250 WATT LUMINAIRE, TYPE 5 POLE, TYPE 5 CONCRETE BASE, TRUSS TYPE - 4 1/2" CLAMP - 12FT WITH TRANSFORMER BASE 

PULL BOX 24" X 42" 

POWER POLE 

SERVICE POLE 

ELECTRIC, UNDERGROUND  E

ELECTRIC, OVERHEAD  OH

SIGN 

THE LOCATION OF EXISTING AND PROPOSED UTILITIES AS SHOWN ON THE PLANS ARE APPROXIMATE. IN ADDITION, THERE MAY BE OTHER UTILITIES WITHIN THE PROJECT AREA WHICH ARE NOT SHOWN. THE CONTRACTOR SHALL VERIFY THE LOCATIONS OF ALL UTILITIES PRIOR TO CONSTRUCTION.

Changed to LEB B

AS-BUILT 11-19-2012

STH 54 & CTH J/Seminary RD
TOWN OF ONEIDA
OUTAGAMIE COUNTY

LIGHTING NO. 807

DESIGNER: WISDOT NE Region Traffic Unit

DATE: 8-22-2011

SHEET NO. 1 OF 1

PROJECT NO: 9210-11-71

HWY: STH 54

COUNTY: OUTAGAMIE

ROUNDABOUT LIGHTING L-807

SHEET

E