
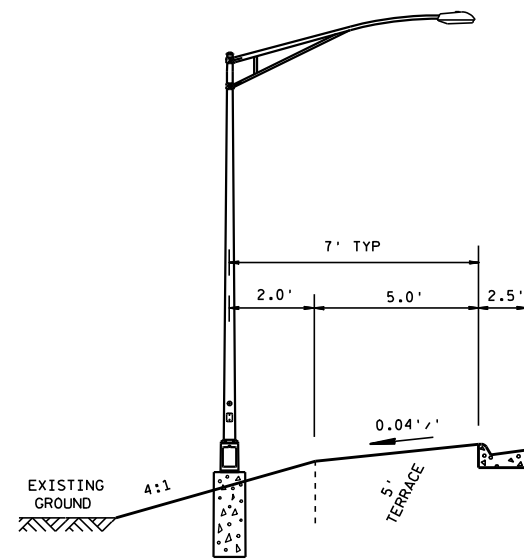


NOTE:

THE LOCATION OF EXISTING AND PROPOSED UTILITIES AS SHOWN ON THE PLANS ARE APPROXIMATE. IN ADDITION, THERE MAY BE OTHER UTILITIES WITHIN THE PROJECT AREA WHICH ARE NOT SHOWN. THE CONTRACTOR SHALL VERIFY THE LOCATIONS OF ALL UTILITIES PRIOR TO CONSTRUCTION.

**LEGEND**

LIGHTING CONTROL CABINET WITH METER BREAKER PEDESTAL	
2" CONDUIT, NON-METALLIC (UNLESS OTHERWISE NOTED)	
250 WATT LUMINAIRE (unless otherwise noted), TYPE 5 POLE, TYPE 5 CONCRETE BASE, TRUSS TYPE - 4 1/2" CLAMP - 12FT WITH TRANSFORMER BASE	
PULL BOX 24" X 42"	
POWER POLE	
SERVICE POLE	
ELECTRIC, UNDERGROUND	
ELECTRIC, OVERHEAD	
SIGN BRIDGE	
LUMINAIRE, under permit	

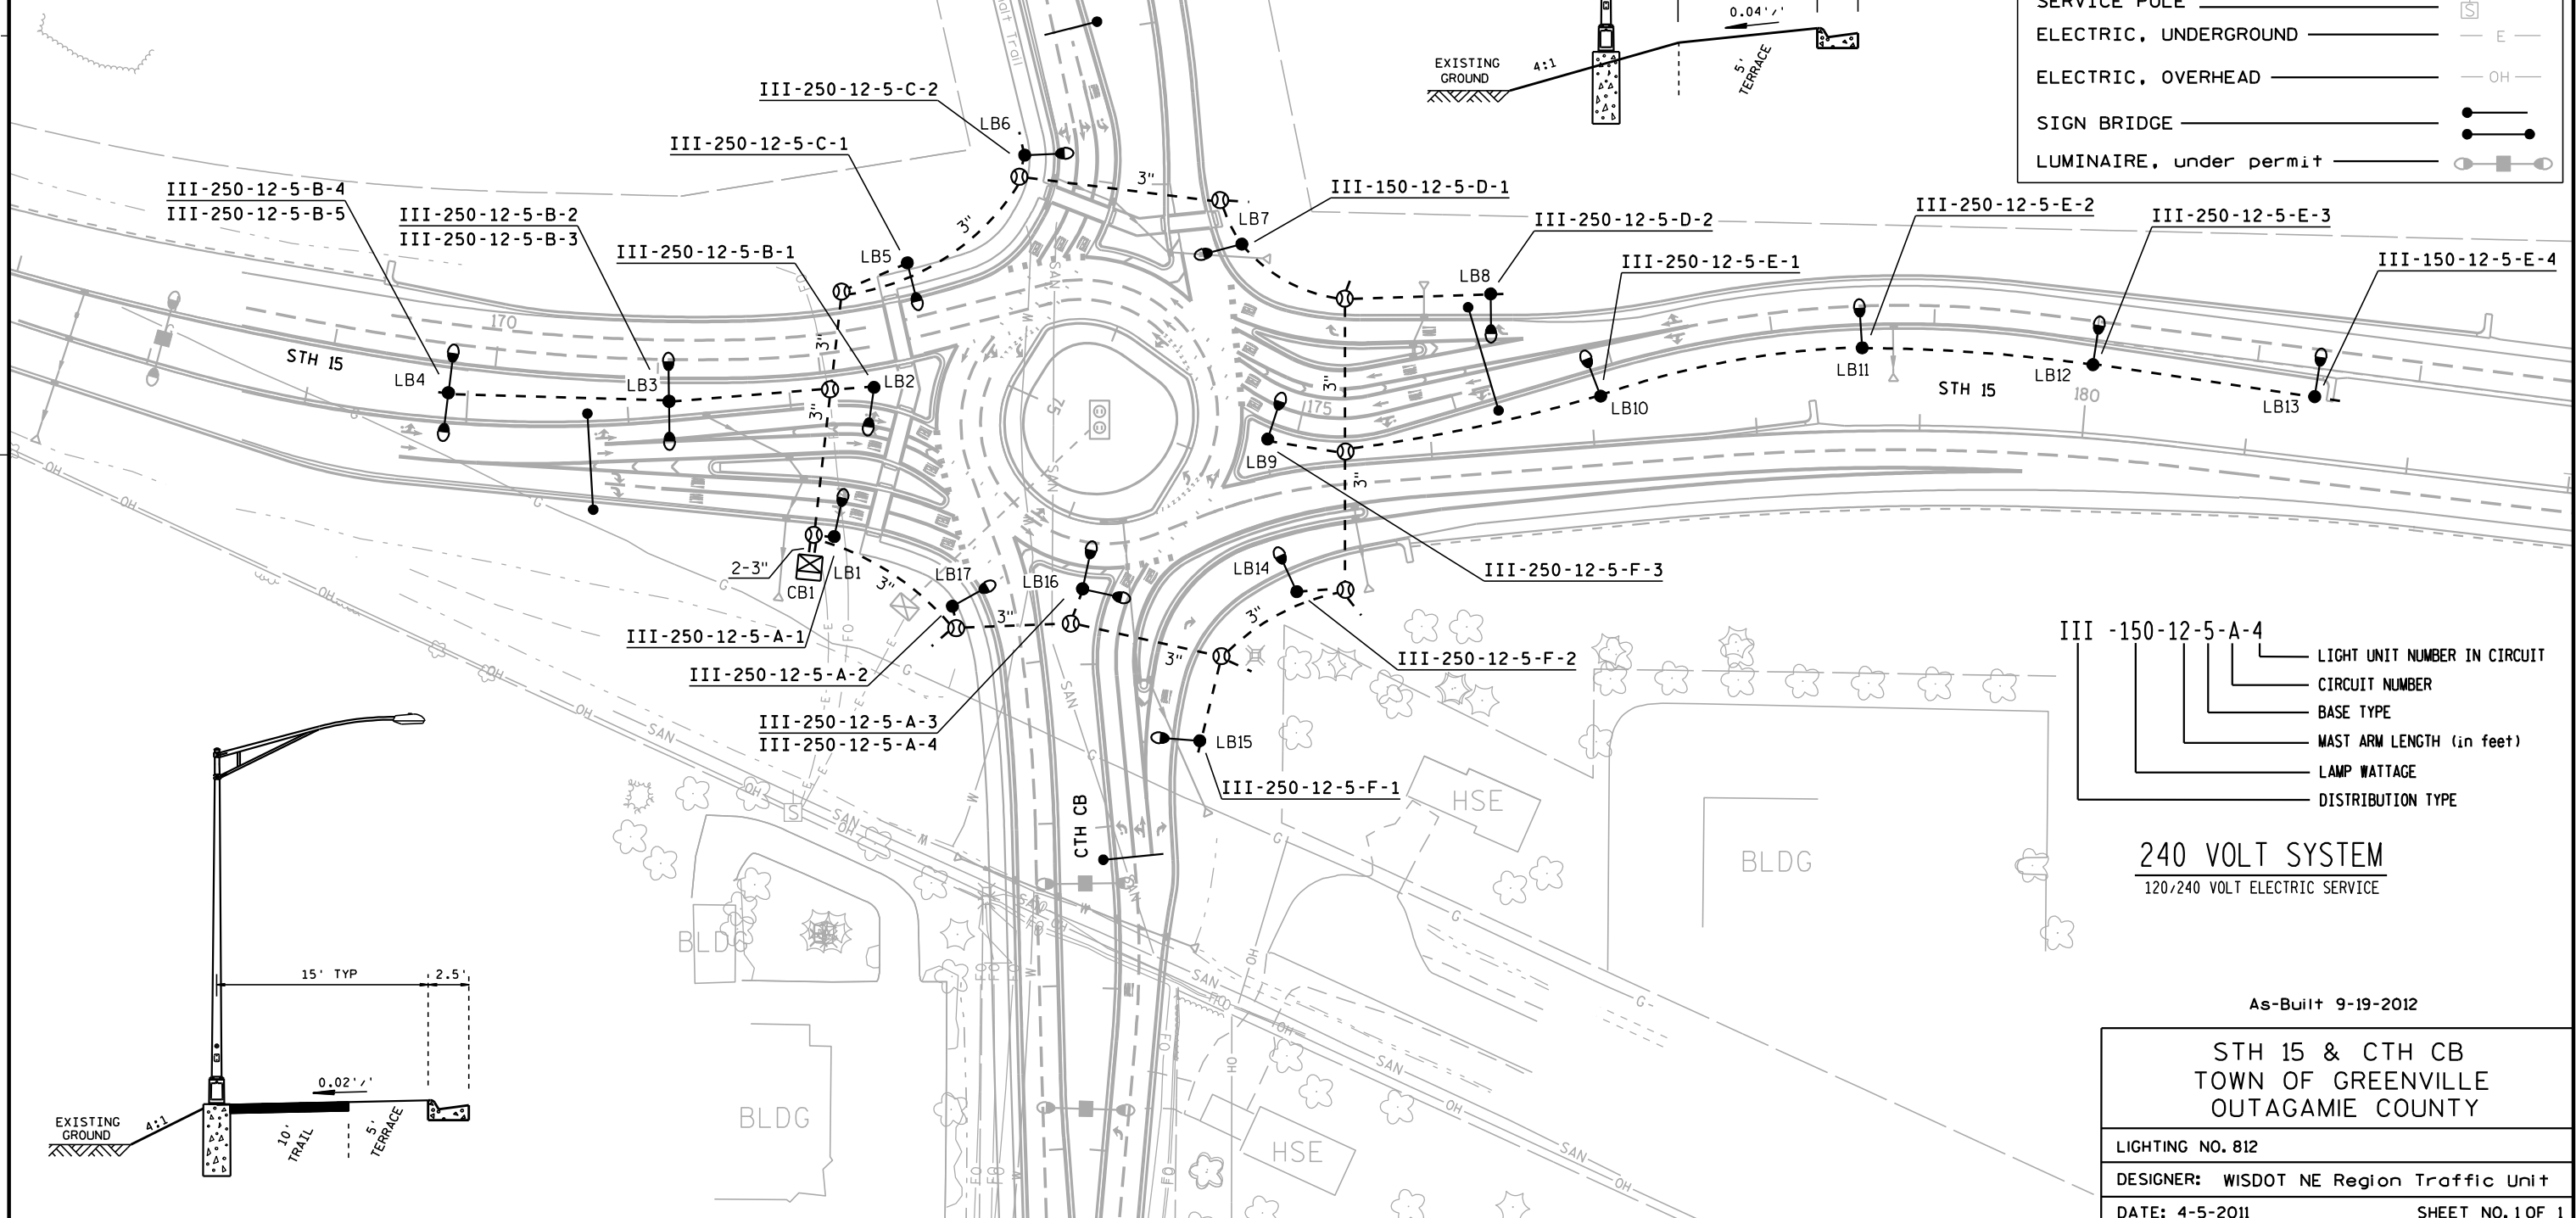

III -150-12-5-A-4	LIGHT UNIT NUMBER IN CIRCUIT
	CIRCUIT NUMBER
	BASE TYPE
	MAST ARM LENGTH (in feet)
	LAMP WATTAGE
	DISTRIBUTION TYPE

240 VOLT SYSTEM
120/240 VOLT ELECTRIC SERVICE

As-Built 9-19-2012

**STH 15 & CTH CB
TOWN OF GREENVILLE
OUTAGAMIE COUNTY**

LIGHTING NO. 812
DESIGNER: WISDOT NE Region Traffic Unit
DATE: 4-5-2011
SHEET NO. 1 OF 1

PROJECT NO: 1146-39-71

HWY: STH 15

COUNTY: OUTAGAMIE

ROUNDAABOUT LIGHTING L-812

SHEET

E

FILE NAME : F:\d3_traffic\NL812.dgn

PLOT DATE : 21-SEP-2012 08:18

PLOT BY : dotc5s

PLOT NAME : L812.ob

PLOT SCALE : 100:1

WISDOT/CADDs SHEET 42