


III -150-12-5-1-4
LIGHT UNIT NUMBER IN CIRCUIT
CIRCUIT NUMBER
BASE TYPE
MAST ARM LENGTH (In feet)
LAMP WATTAGE
DISTRIBUTION TYPE

240 VOLT SYSTEM

NOTE:

THE LOCATION OF EXISTING AND PROPOSED UTILITIES AS SHOWN ON THE PLANS ARE APPROXIMATE. IN ADDITION, THERE MAY BE OTHER UTILITIES WITHIN THE PROJECT AREA WHICH ARE NOT SHOWN. THE CONTRACTOR SHALL VERIFY THE LOCATIONS OF ALL UTILITIES PRIOR TO CONSTRUCTION.

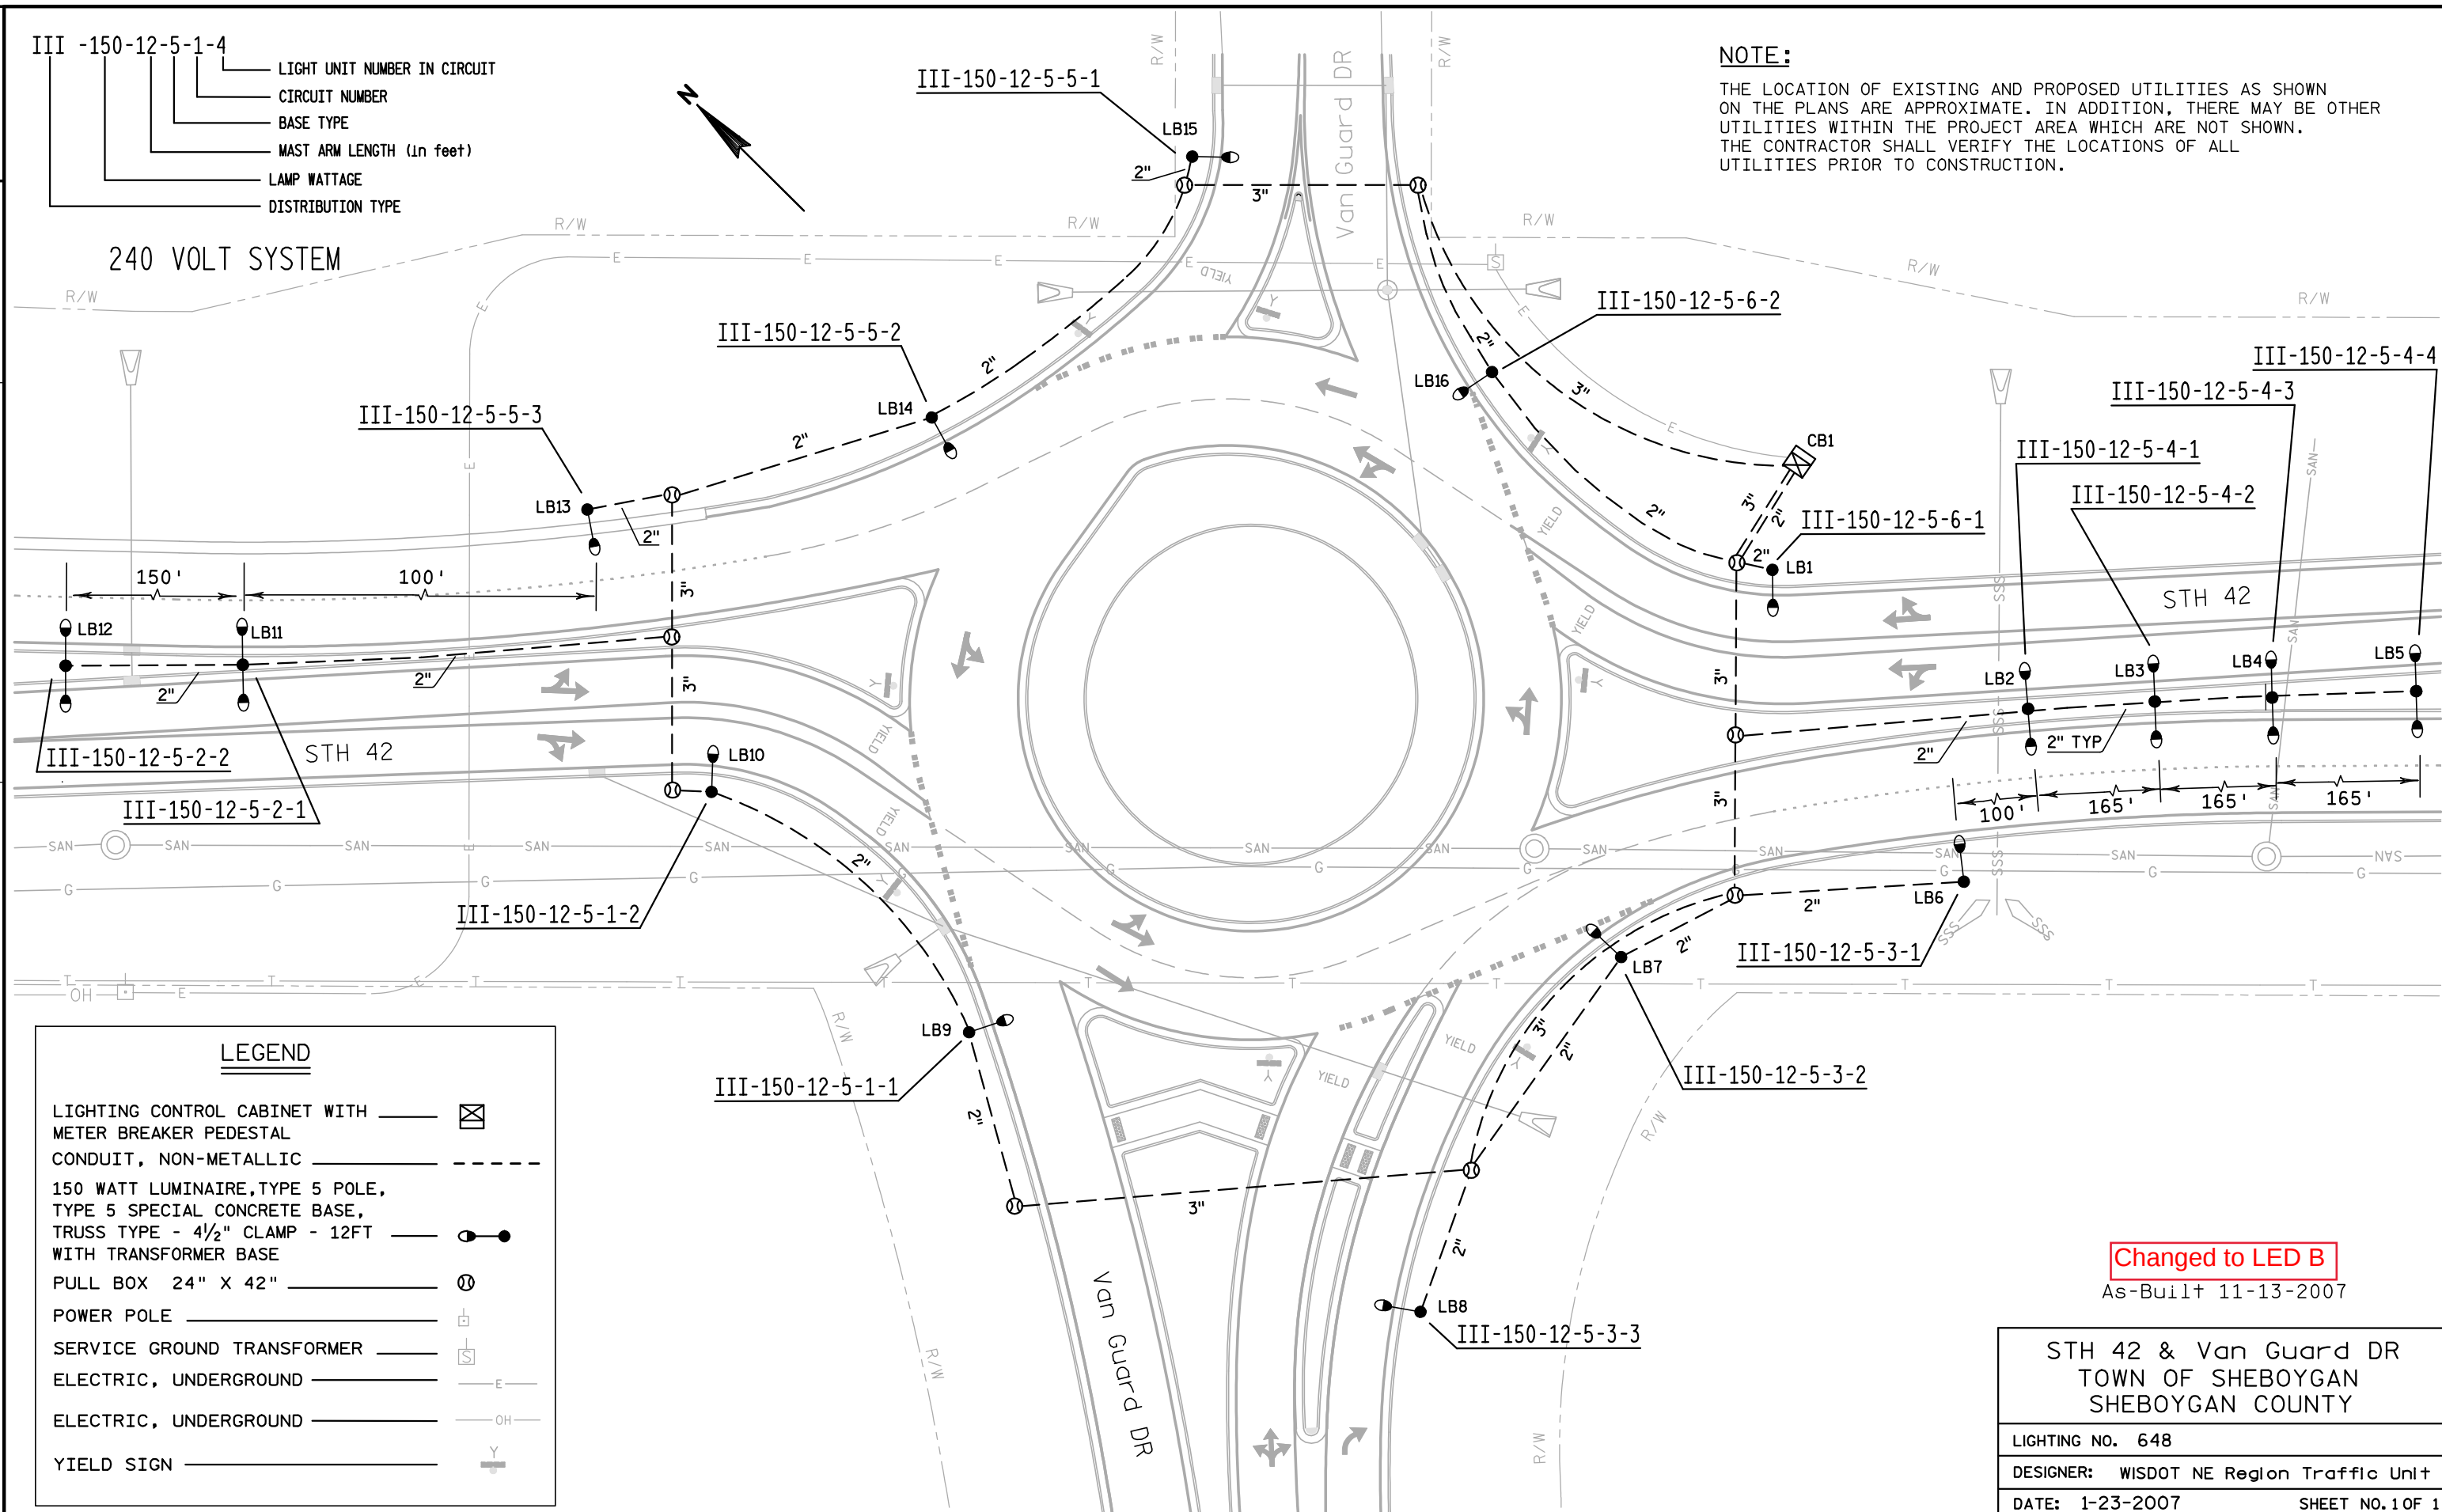

LEGEND

LIGHTING CONTROL CABINET WITH METER BREAKER PEDESTAL CONDUIT, NON-METALLIC

150 WATT LUMINAIRE, TYPE 5 POLE, TYPE 5 SPECIAL CONCRETE BASE, TRUSS TYPE - 4 1/2" CLAMP - 12FT WITH TRANSFORMER BASE

PULL BOX 24" X 42"

POWER POLE

SERVICE GROUND TRANSFORMER

ELECTRIC, UNDERGROUND

ELECTRIC, UNDERGROUND

YIELD SIGN

Changed to LED B

As-Built 11-13-2007

STH 42 & Van Guard DR
TOWN OF SHEBOYGAN
SHEBOYGAN COUNTY

LIGHTING NO. 648

DESIGNER: WISDOT NE Region Traffic Unit

DATE: 1-23-2007

SHEET NO. 1 OF 1

PROJECT NO: 0664-03-42

HWY: STH 42

COUNTY: SHEBOYGAN

CONSTRUCTION DETAIL - ROUNDABOUT LIGHTING L-648

SHEET

E