

FILE NAME: F:\d3_traffi\S-511,rev2.dgn

PLOT DATE: 09-DEC-2016 07:57

PLOT BY: dotc5s

PLOT NAME: S-511,rev2.dp

PLOT SCALE: 40:1

WISDOT/CADDS SHEET 42

HEAD

NUMBERS

4, 5

1, 2, 3

9, 10, 11

6, 7, 8

12, 13

4,5

01

02

Ø3

04

Ø5 Ø6


Ø7 Ø8

|Ø2P|

Ø4P

Ø6P Ø8P

OLB

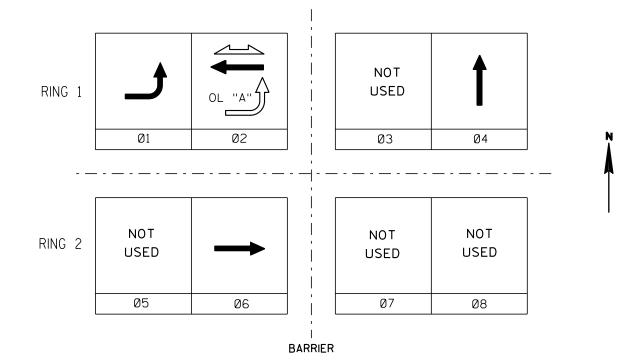

CONTROLLER LOGIC

PHASE NUMBER	PHASE LOCKING	DUAL ENTRY W / Ø	PHASE RECALL	PHASE ACTIVE
1				YES
2			MIN/PED	YES
3				
4				YES
5				
6			MIN	YES
7	·			
8				

TYPE OF INTERCONNECT/COMMUNICATION CELL MODEM CLOSED LOOP TWISTED PAIR* FIBER OPTIC* FIBER OPTIC (ETHERNET) x RADIO

TYPE OF COORDINATION	
NONE	
TBC	х
TRAFFIC RESPONSIVE	
ADAPTIVE	
*LOCATION OF MASTER	
CONTROLLER NO: S44-05	511
SIGNAL SYSTEM *: SS-0100)

	TYPE OF LIGHTING	
	BY OTHER AGENCY	
ı	IN TRAFFIC SIGNAL CABINET	x
1	IN SEPARATE DOT LIGHTING CABINET	

TYPE OF PRE-EMPT	
NONE	×
RAILROAD	
EMERGENCY VEHICLE	
GTT	
TOMAR	
HARDWIRE	
3M	
LIFT BRIDGE	
QUEUE DETECTOR	

OVERLAP SPECIAL

	Protected	Permissive
OL "A"	1	2
OL "B"		
OL "C"		
OL "D"		

DETECTOR LOGIC

	RACK # 1							
DETECTOR CHANNEL	3	1	7	5	11	9	15	13
PLAN LOOP DETECTOR *(S)	11	21	41	42		61		
ASSIGNED PHASE	1	2	4	4		6		
OPERATION MODE	Veh	Veh	Veh	Veh		Veh		
SWITCH TO PHASE						 		! !
EXTEND		! !						
DELAY	Yes	! ! !	Yes					
DETECTOR CHANNEL	4	2	8	6	12	10	16	14
PLAN LOOP DETECTOR *(S)		22		43		62		
ASSIGNED PHASE		2		4		6		
OPERATION MODE		Veh		Veh		Veh		
SWITCH TO PHASE		! !						
EXTEND		1 1 1						
DELAY		1 1 1		I				! !

	RACK # 2							
DETECTOR CHANNEL	19	17	23	21	27	25	31	29
PLAN LOOP DETECTOR *(S)								
ASSIGNED PHASE								
OPERATION MODE								
SWITCH TO PHASE	į							
EXTEND								
DELAY						l I		
DETECTOR CHANNEL	20	18	24	22	28	26	32	30
PLAN LOOP DETECTOR *(S)								
ASSIGNED PHASE								
OPERATION MODE								! !
SWITCH TO PHASE								! !
EXTEND								
DELAY								
טבביי ן			'		'			1

GENERAL NOTES:

1. PROVIDE FOR HAND CONTROL.

As-Built 8-4-2016

STH 441 NB & CTH CE CITY OF APPLETON OUTAGAMIE COUNTY

SIGNAL NO. 44-0511

CABINET: TS2 CONTROLLER: EPAC

DATE: PAGE NO. 2 OF 2

PROJECT NO: 4685-19-60 HWY: STH 441 COUNTY: OUTAGAMIE SEQUENCE OF OPERATIONS S44-0511 SHEET **E**

FILE NAME: F:\d3_traffi\S-511,rev2.dgn

PLOT DATE: 09-DEC-2016 07:57

PLOT BY: dotc5s

PLOT NAME: S511,seq,rev2,ab

PLOT SCALE: 40:1

WISDOT/CADDS SHEET 42