

1483

OFFICE COPY

59

BROWN, OUT, WIN
0083-09-15, 16
(0653-03-00)

INDEX OF SHEETS

Sheet No. 1	Title
Sheet No. 2 & 2.1	Typical Sections and Details
Sheet No. 3	Estimate of Quantities
Sheet No. 3A	Miscellaneous Quantities
Sheet No. 4	Right of Way Plat
Sheet No. 5-5.22	Plan and Profile
Sheet No. 6-6.3	Standard Detail Drawings
Sheet No. 7	Sign Plates
Sheet No. 8	Structure Plans
Sheet No. 9	Computer Earthwork Data
Sheet No. 10	Cross Sections

TOTAL SHEETS = 32



DESIGN DESIGNATION

A.D.T.	=
A.D.T.	=
D.H.V.	=
D.	=
T.	=
V.	=
ESALS	=

CONVENTIONAL SIGNS

COUNTY LINE	---
CORPORATE LIMITS	----
PROPERTY LINE	----
LOT LINE	----
LIMITED EASEMENT	----
EXISTING RIGHT OF WAY	----
NEW RIGHT OF WAY	----
REFERENCE LINE	----
SLOPE INTERCEPT	----
ORIGINAL GROUND	----
MARSH OR ROCK PROFILE	----
CULVERT IN PLACE	----
CULVERT REQUIRED	----
CULVERT REQUIRED (Profile)	----

STATE OF WISCONSIN
DEPARTMENT OF TRANSPORTATION
PLAN OF PROPOSED IMPROVEMENT



ASHLAND AVE-USH 41 VARIOUS HIGHWAYS

STH 32
BROWN COUNTY

STH 125 & STH 47
OUTAGAMIE & WINNEBAGO COUNTIES

STATE PROJECT NUMBER
0083-09-15

STATE PROJECT NUMBER
0083-09-16

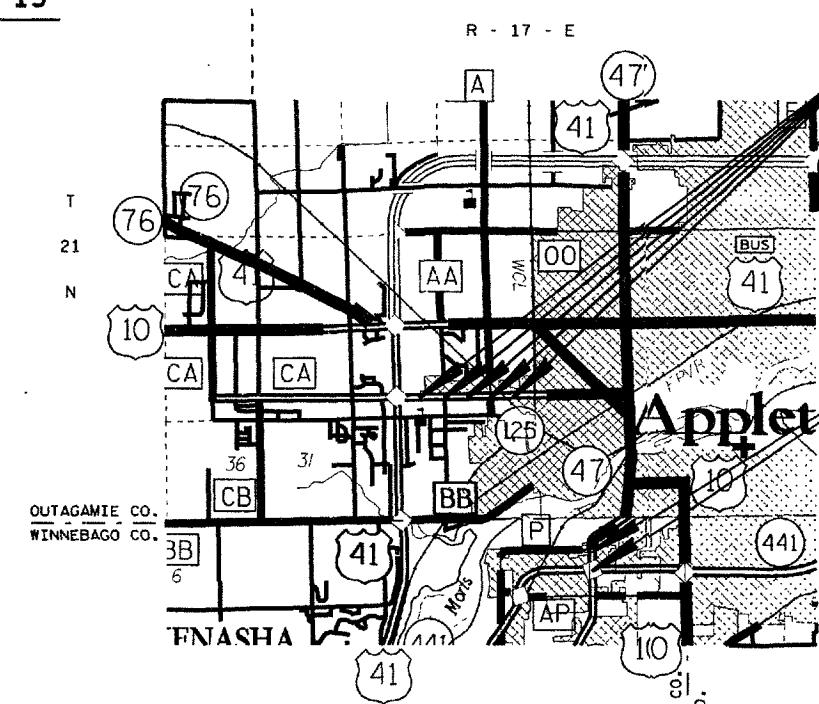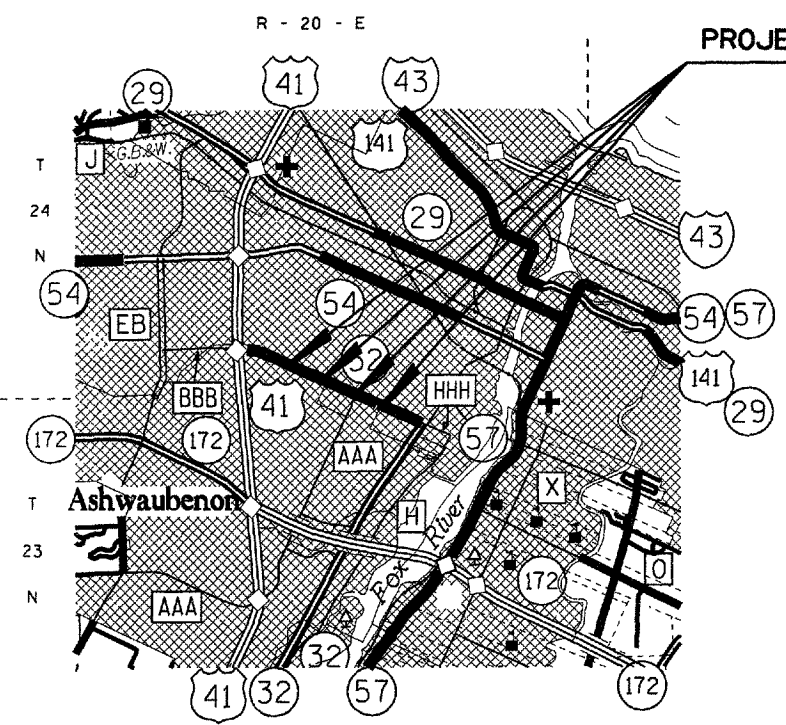

AS BUILT PLAN
NO. Michael J. Berg
SUPERVISOR James J. Berg
RESIDENT James J. Berg
CONTRACTOR James J. Berg
COMPLETED 8/5/96

LAYOUT
SCALE 0 1 MI.
TOTAL NET LENGTH OF CENTERLINE = 0.00 MI.

LOOP DETECTORS

STATE OF WISCONSIN
DEPARTMENT OF TRANSPORTATION

PREPARED BY
Surveyor _____
Designer R. J. SCHUURMANS
District Examiner D. J. KIPP
District Supervisor D. L. HARP
Proj. Dev. Engineer _____
C.O. Examiner N.R. AFFELDT

APPROVED FOR DISTRICT OFFICE
DATE: 1/23/96 [Signature]
(Signature)

AUTHORIZED FOR CENTRAL OFFICE TRAFFIC
DATE: 2-29-96 Christa J. Spang
(Signature)