







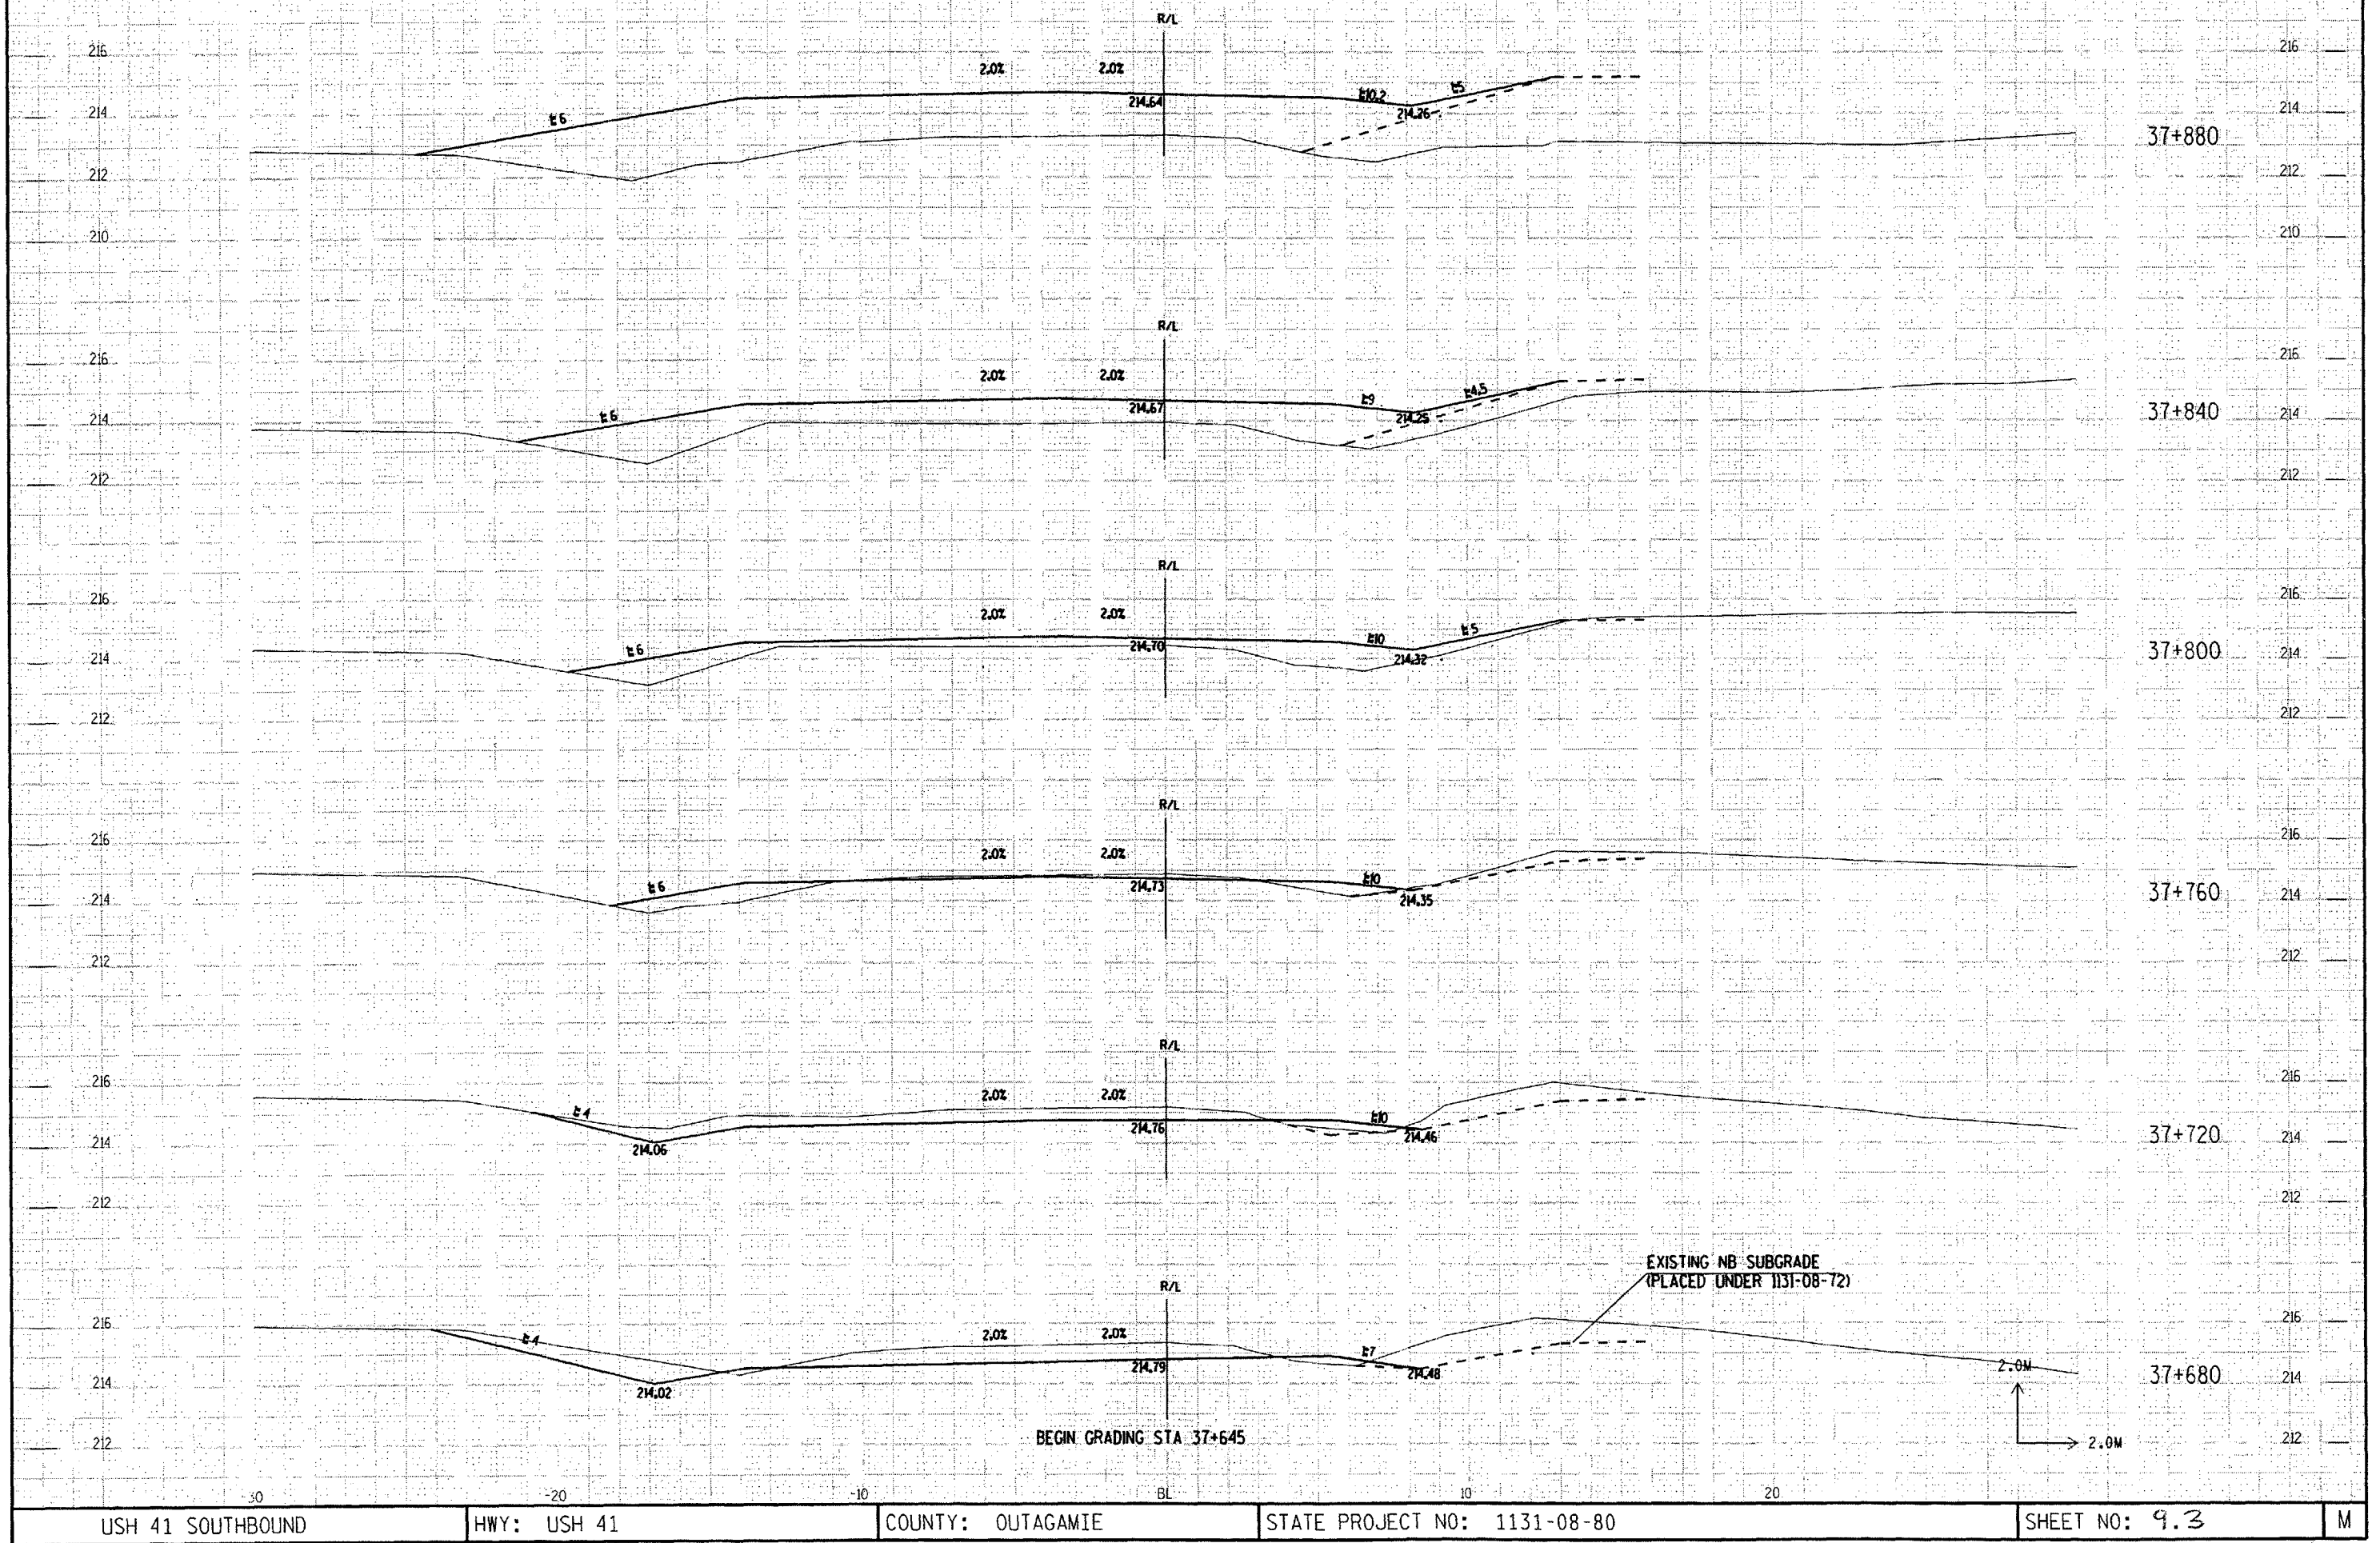

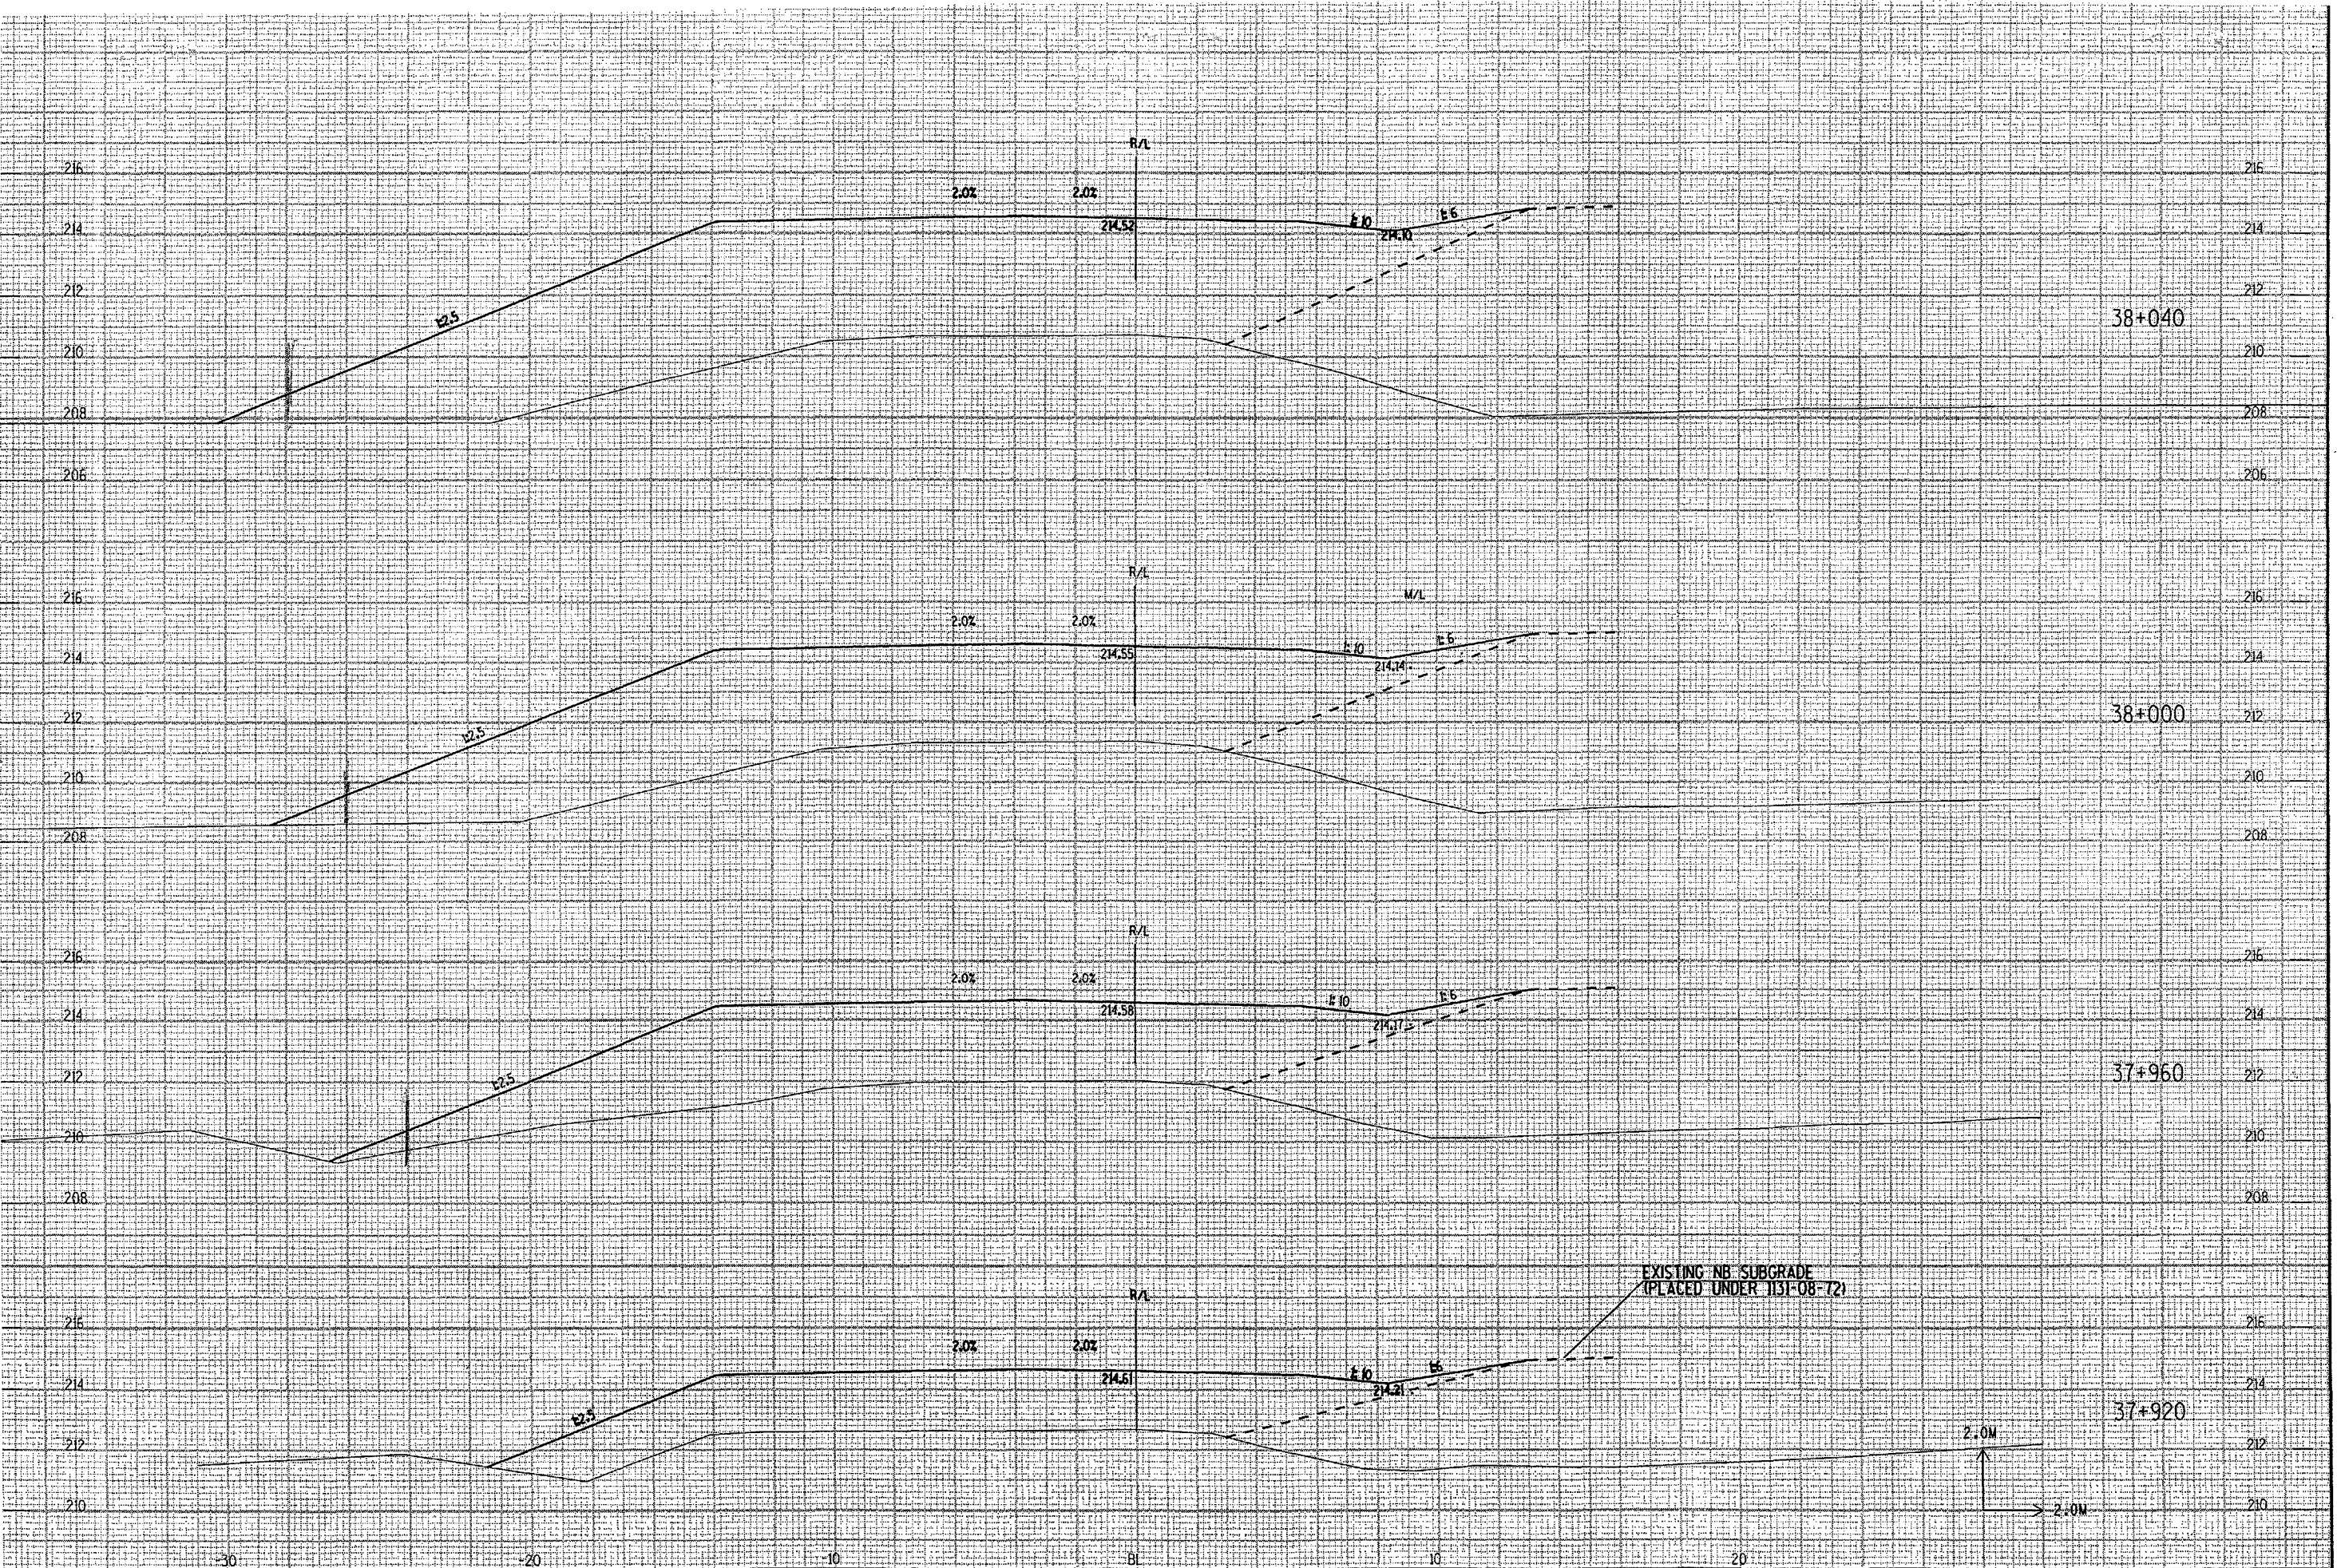

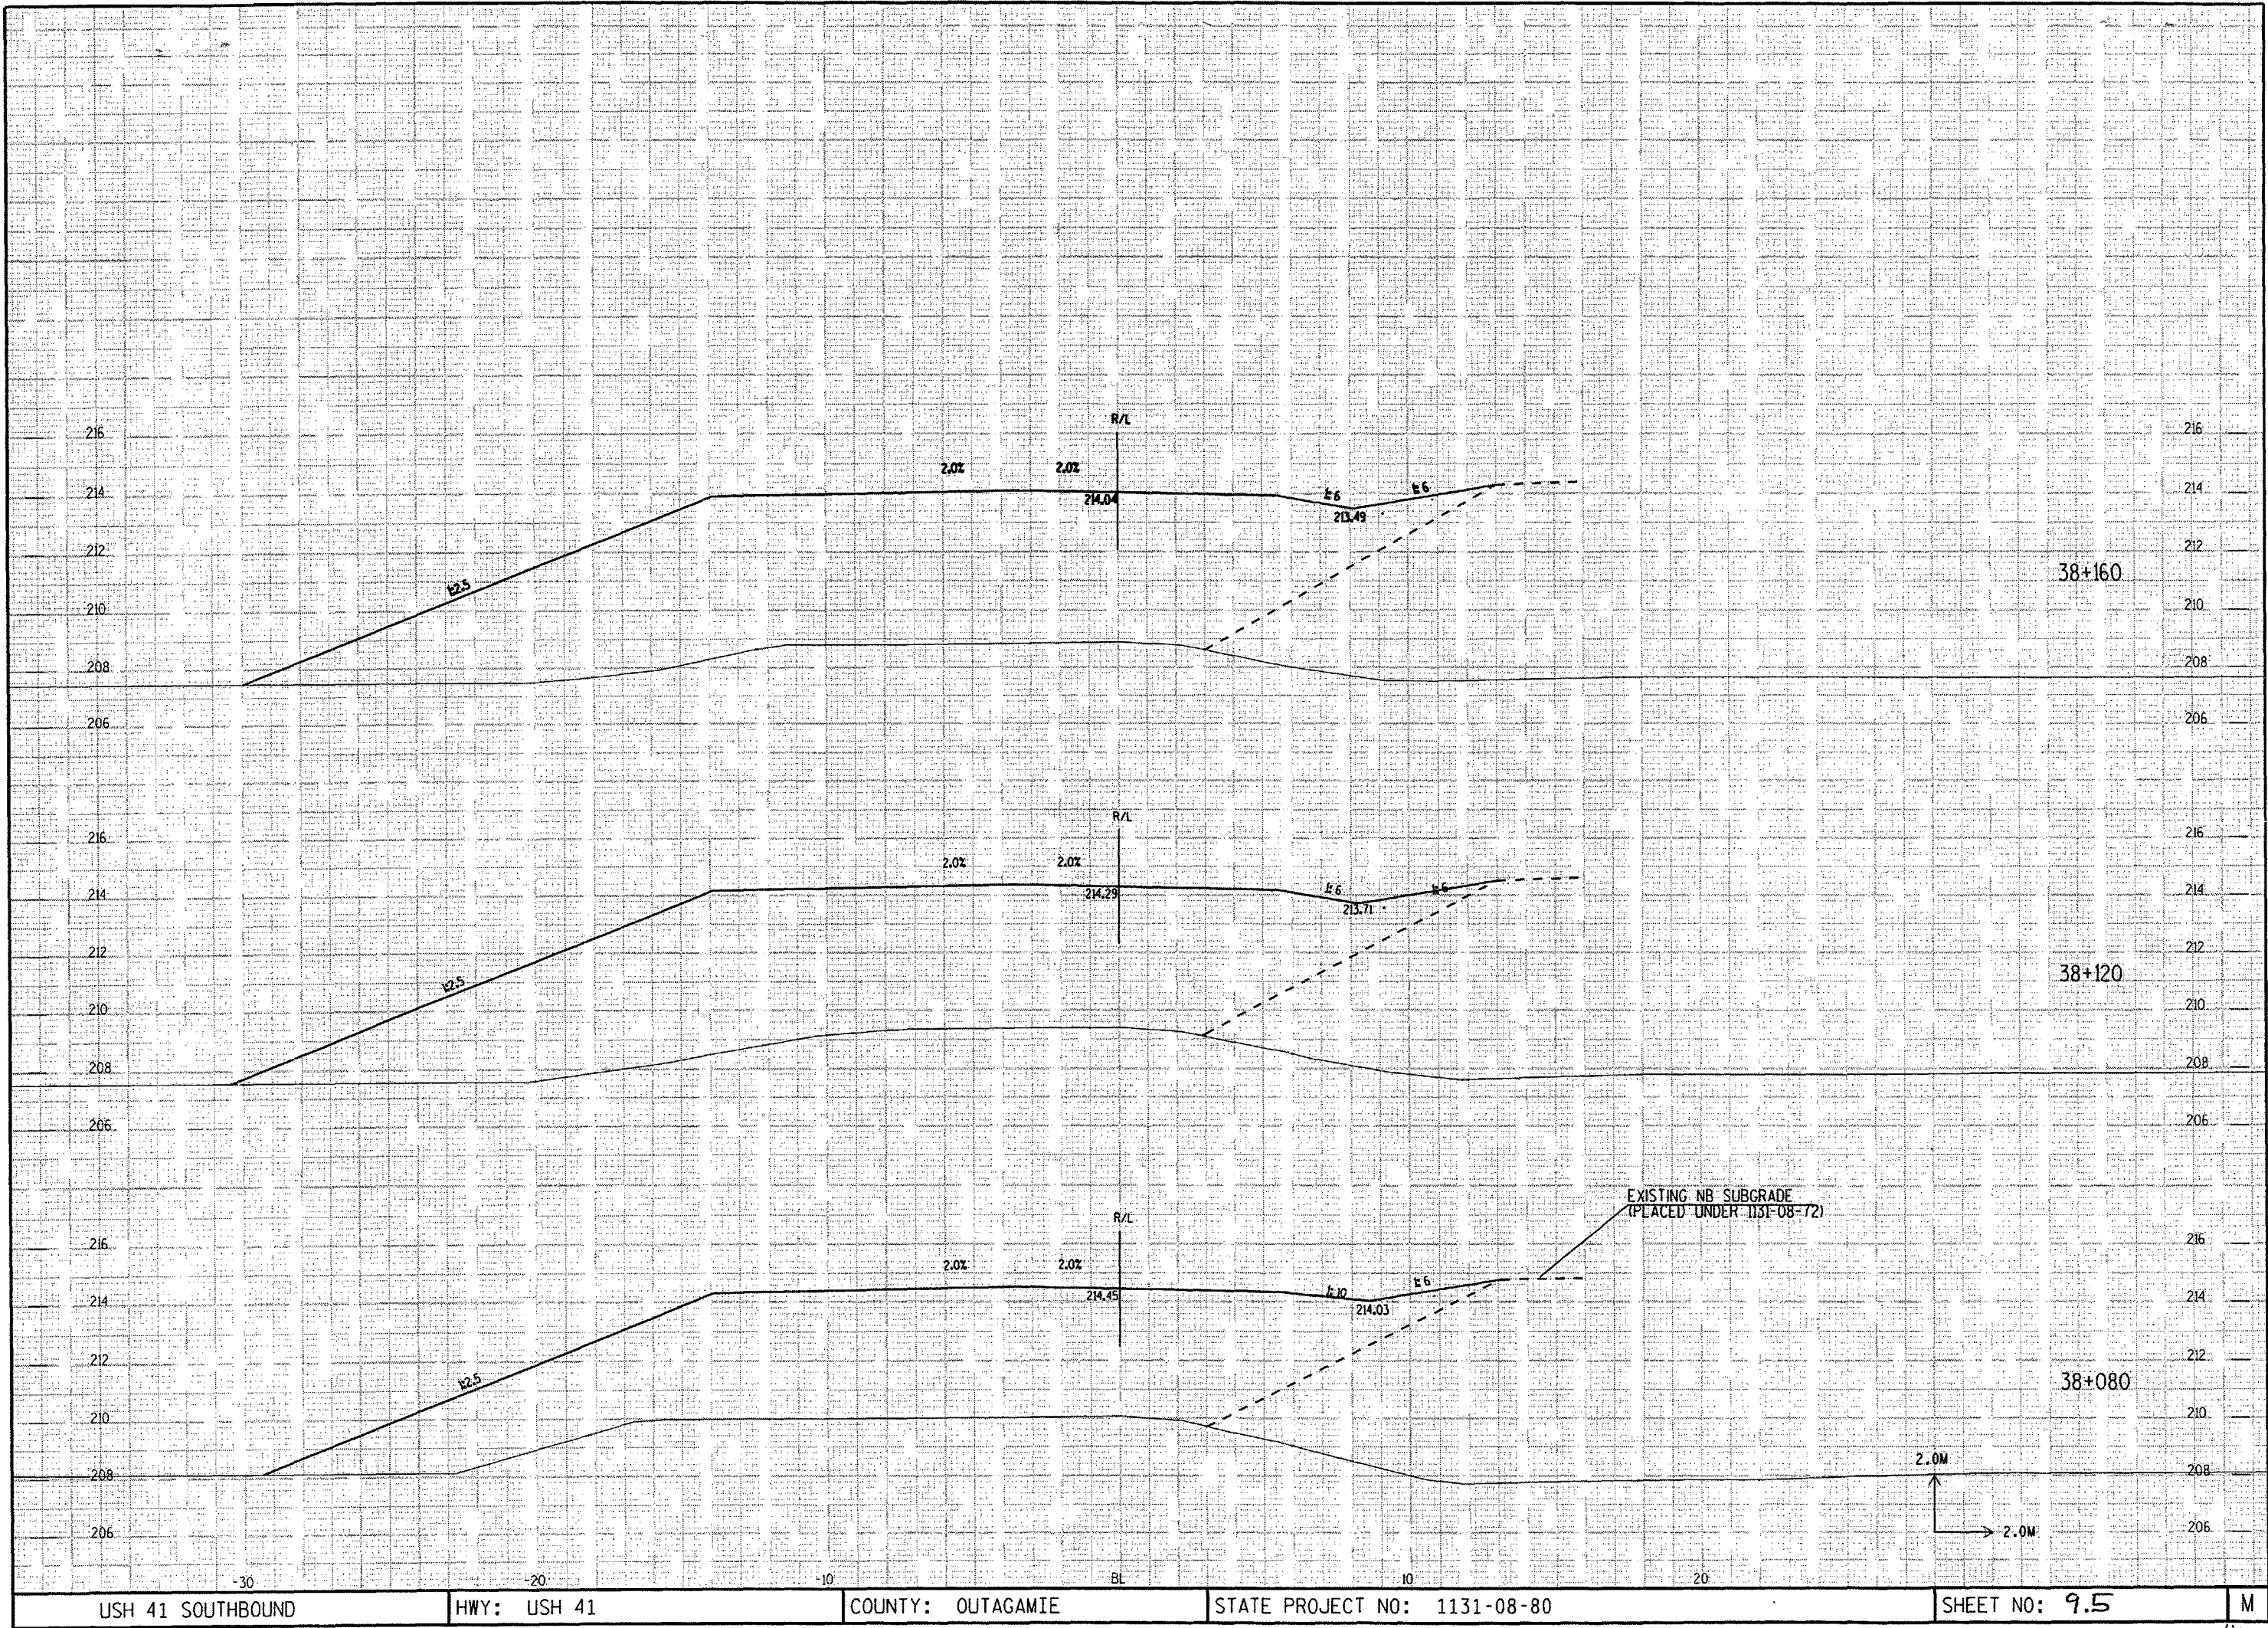

005 Tue 10/19/1999 7:05:36 PM C:\USERS\AP\31130878\usm\lca\USM11\1131-08-80.dgn

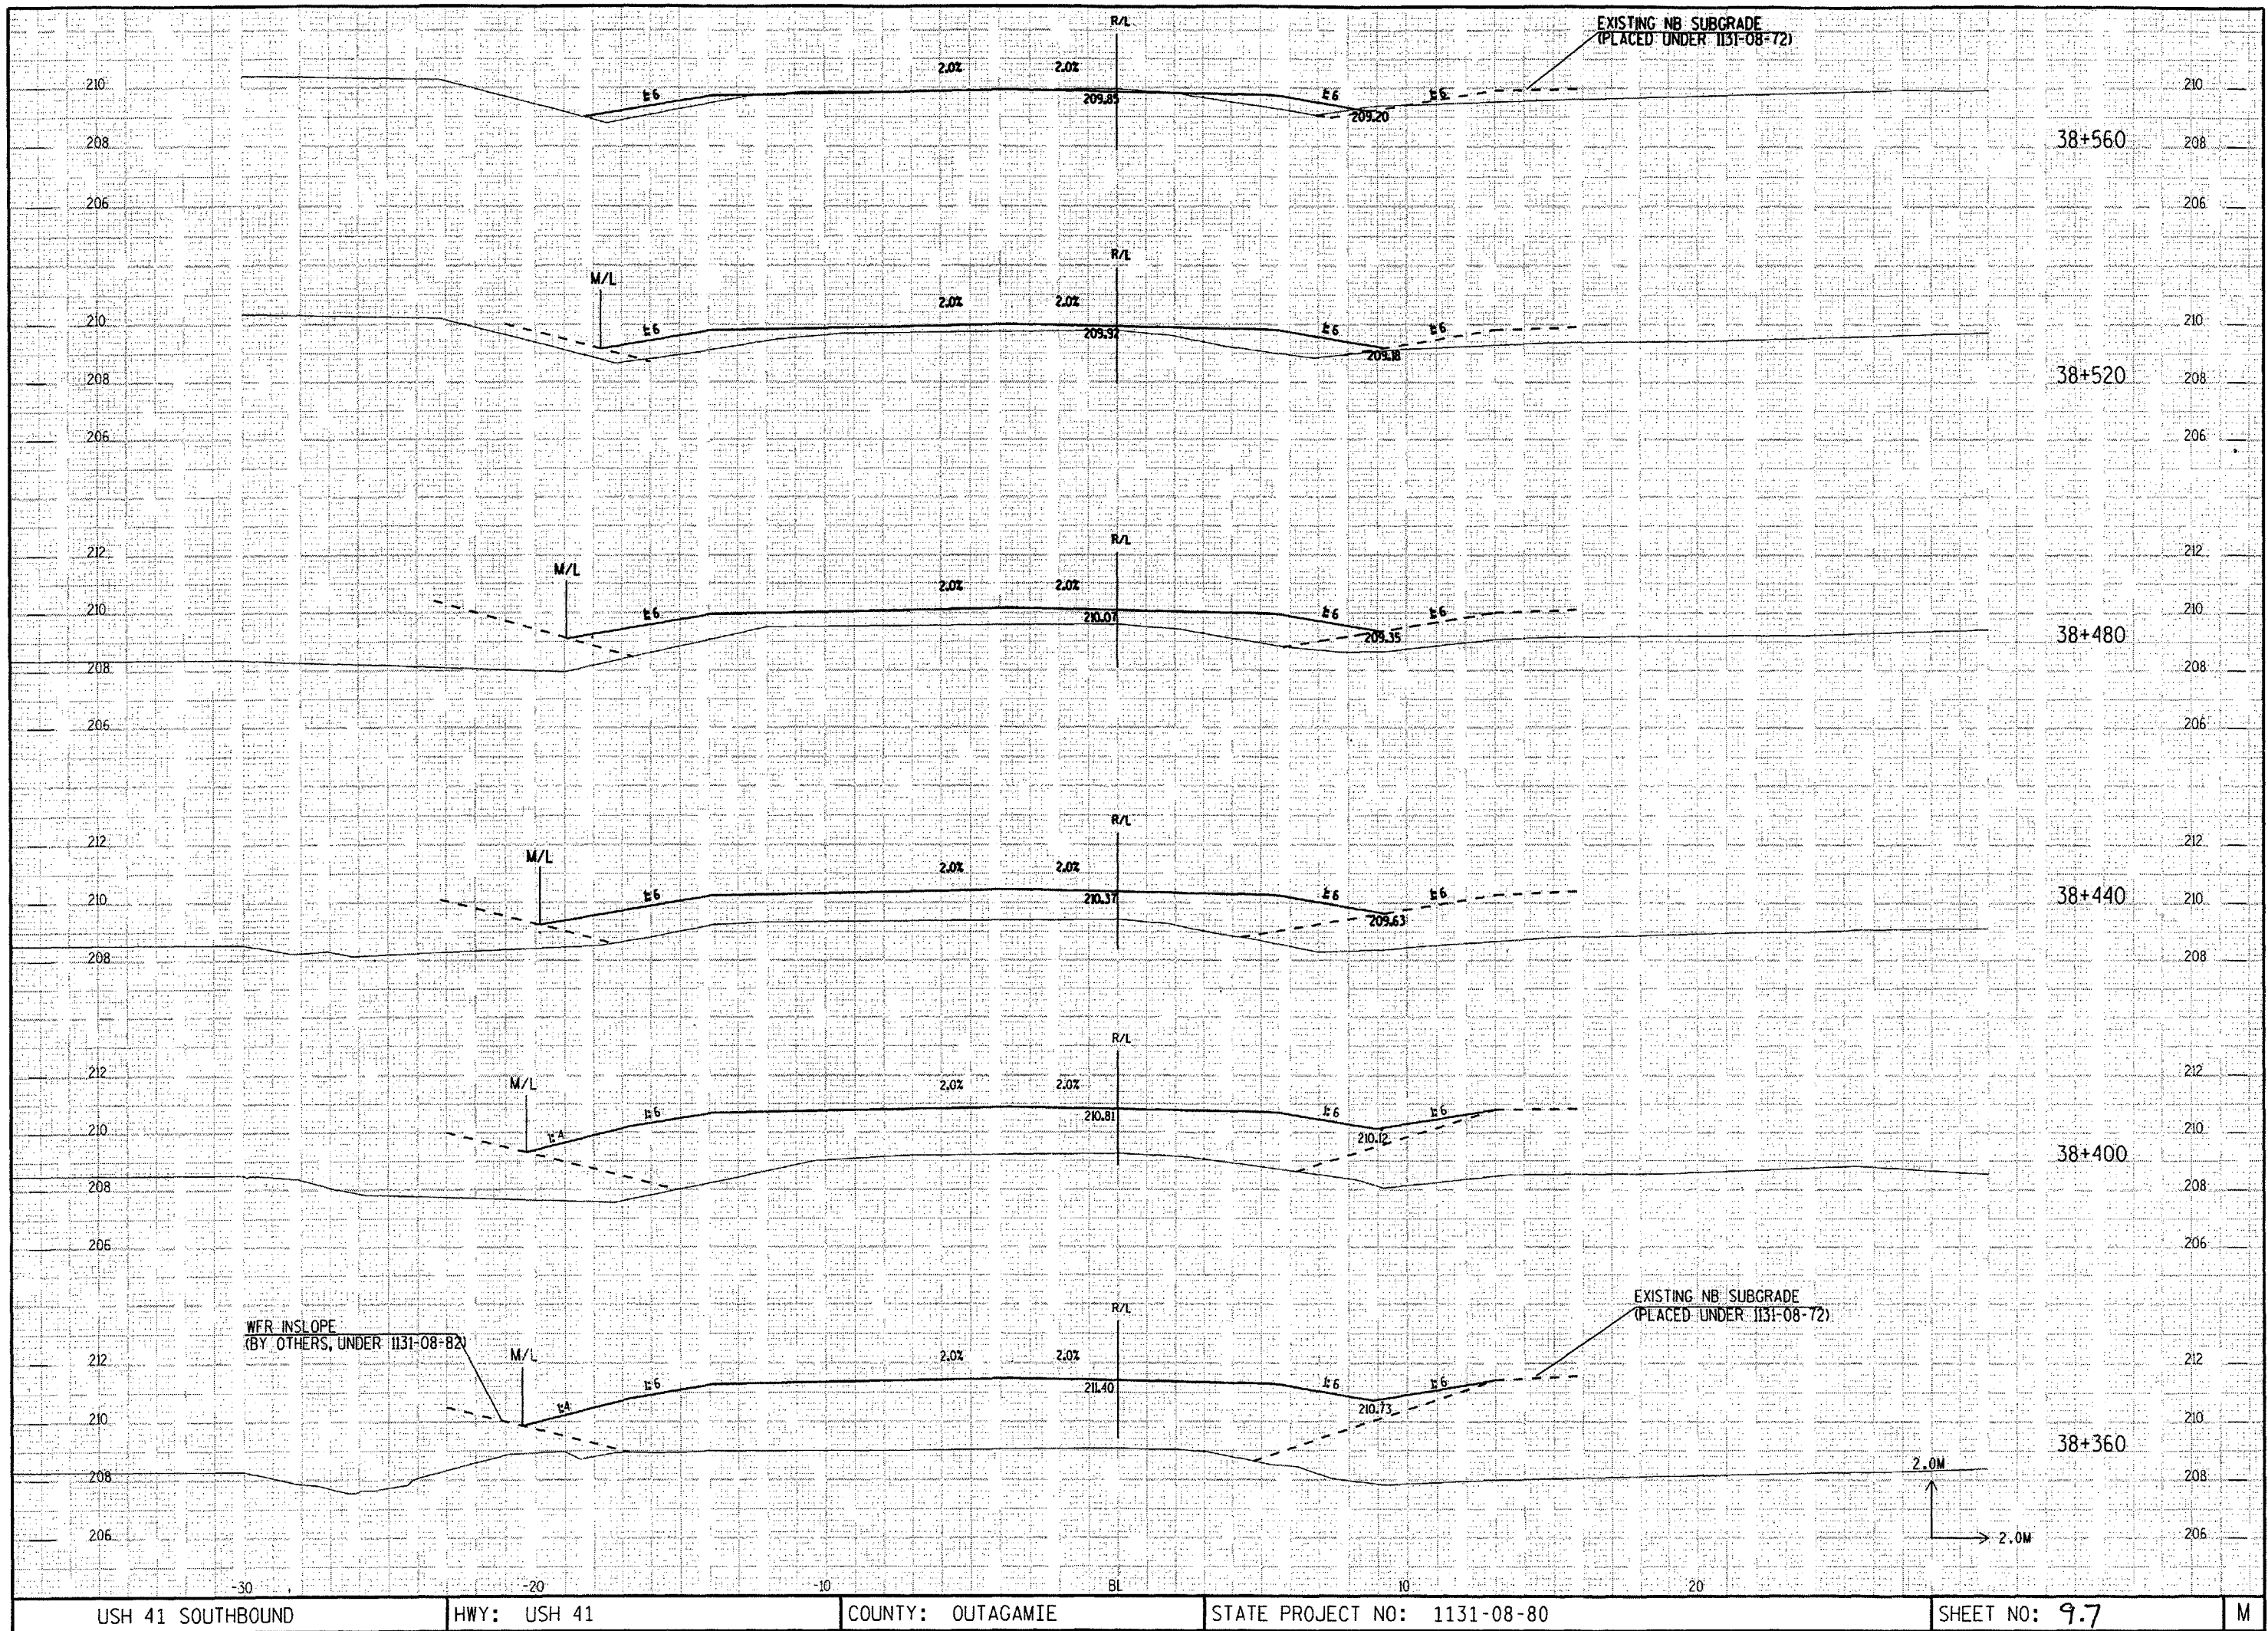

USH 41 SOUTHBOUND

HWY: USH 41


COUNTY: OUTAGAMIE

STATE PROJECT NO: 1131-08-80

SHEET NO: 9.7

M

CCS Tue 10/19/1999 7:40:36 PM C:\USERS\p4311\10878\us41\us41a41s01c1.dgn

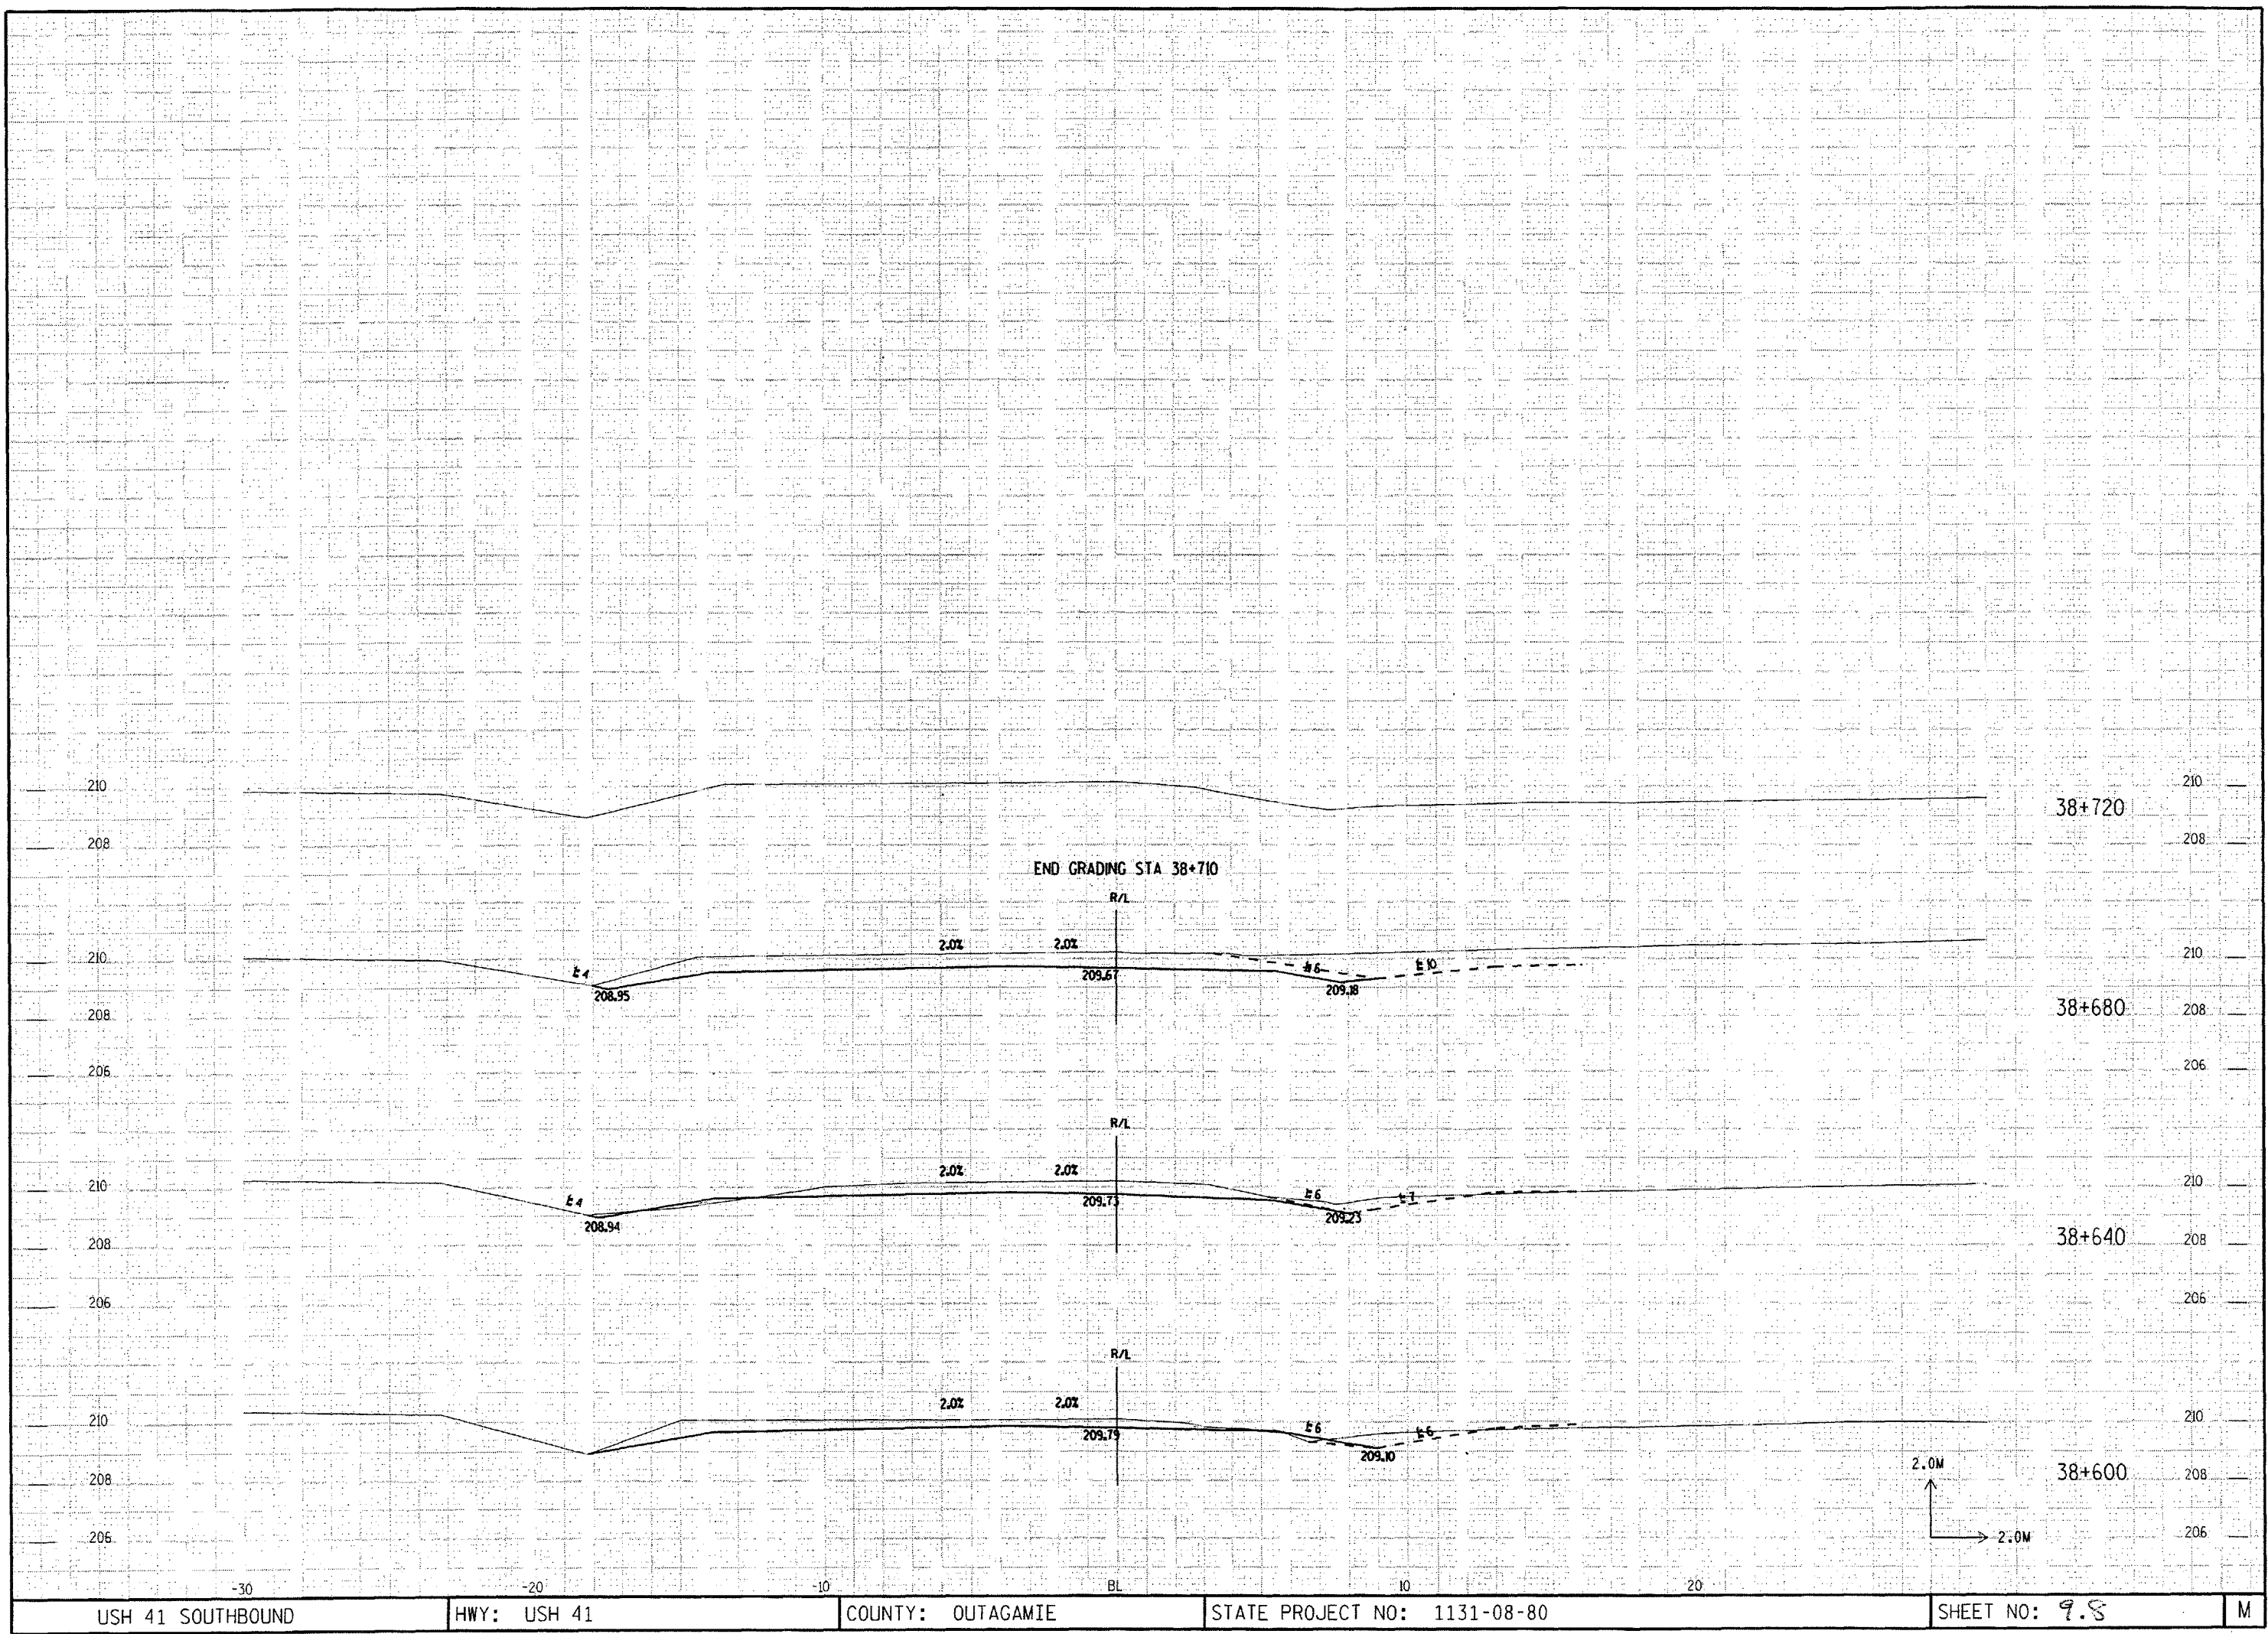

USH 41 SOUTHBOUND

HWY: USH 41

COUNTY: OUTAGAMIE

STATE PROJECT NO: 1131-08-80

SHEET NO: 9.8

M

CCS Tue 10/19/1999 4:03:10 PM C:\USERS\Pd3\11308080\US41nrb.dgn



USH 41 NORTHBOUND

HWY: USH 41


COUNTY: OUTAGAMIE

STATE PROJECT NO: 1131-08-80

SHEET NO: 9.9

M

CCS Tue 10/19/1999 4:03:10 PM C:\USERS\p\d3\110880\US41\iro4.s.dgn

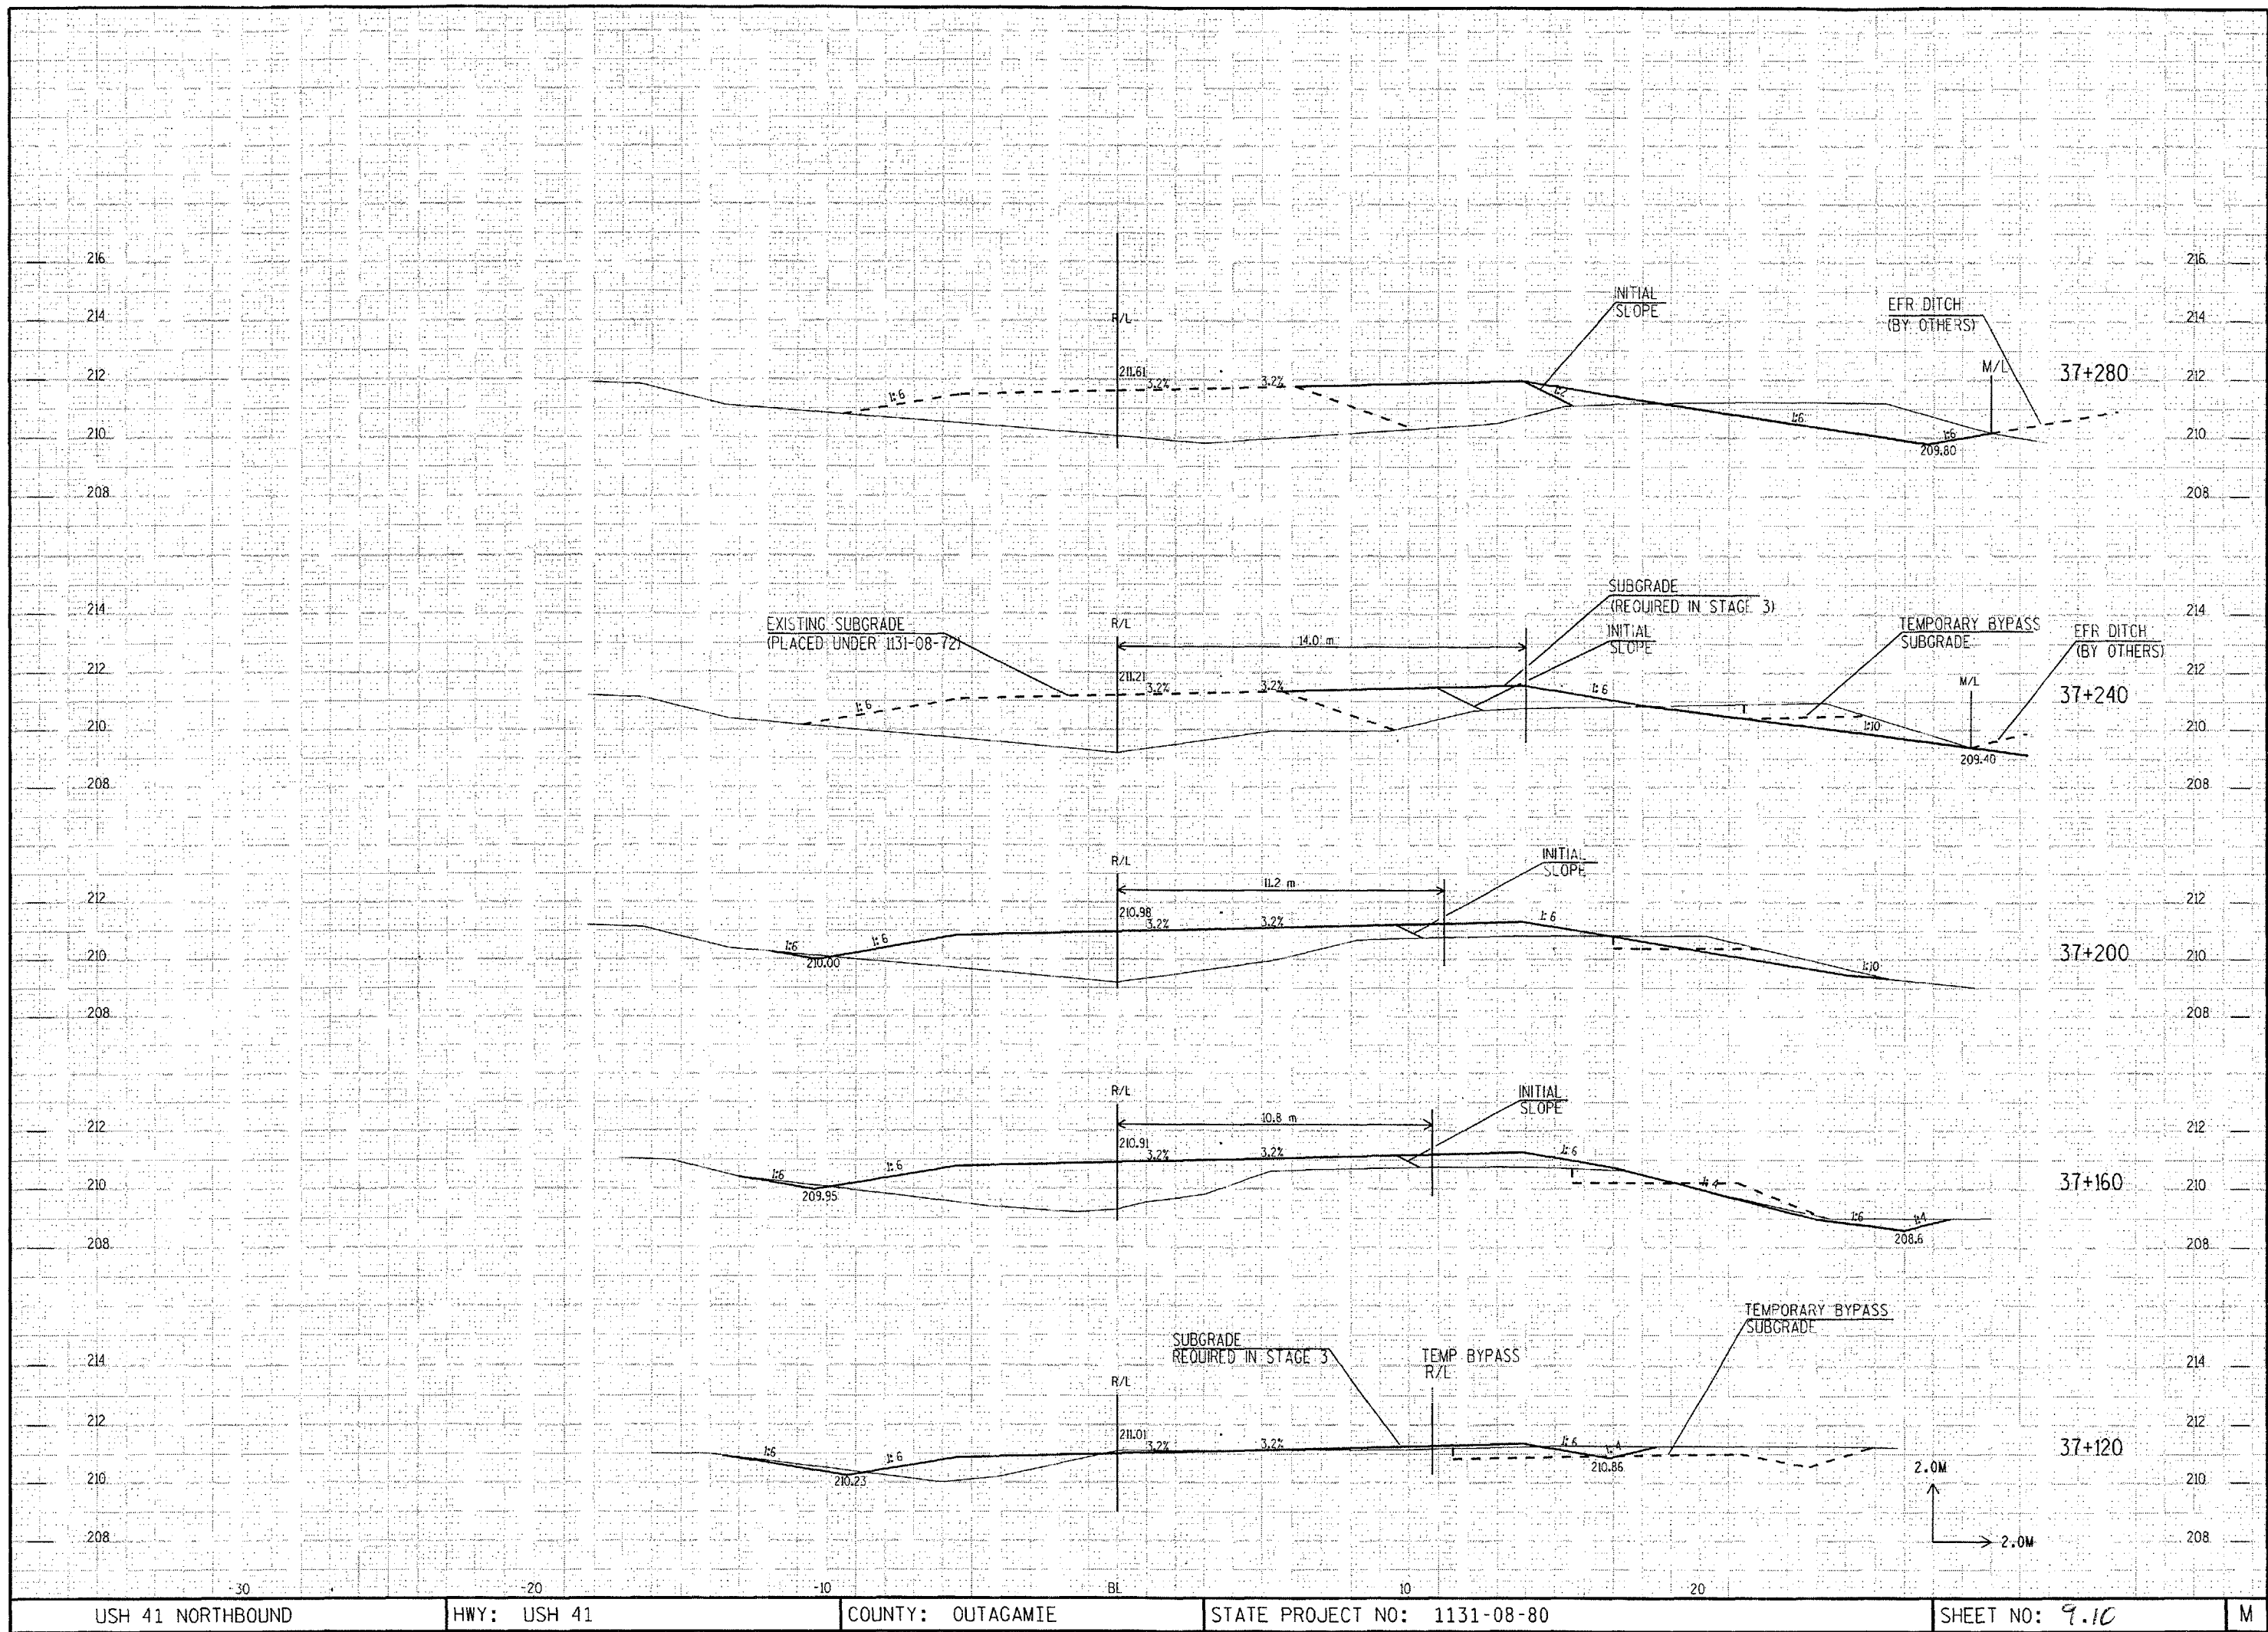

USH 41 NORTHBOUND

HWY: USH 41

COUNTY: OUTAGAMIE

STATE PROJECT NO: 1131-08-80

SHEET NO: 9.10

M

QCS Tue 10/19/1999 4:02:10 PM C:\USERS\p\p\31130880\US41\us41ns.dgn



USH 41 NORTHBOUND

HWY: USH 41


COUNTY: OUTAGAMIE

STATE PROJECT NO: 1131-08-80

SHEET NO: 9.11

M

C:\CS Tue 10/19/1999 22:00:01 PM C:\USERS\p\p\d3\11310880\US41\trb3.s.dgn

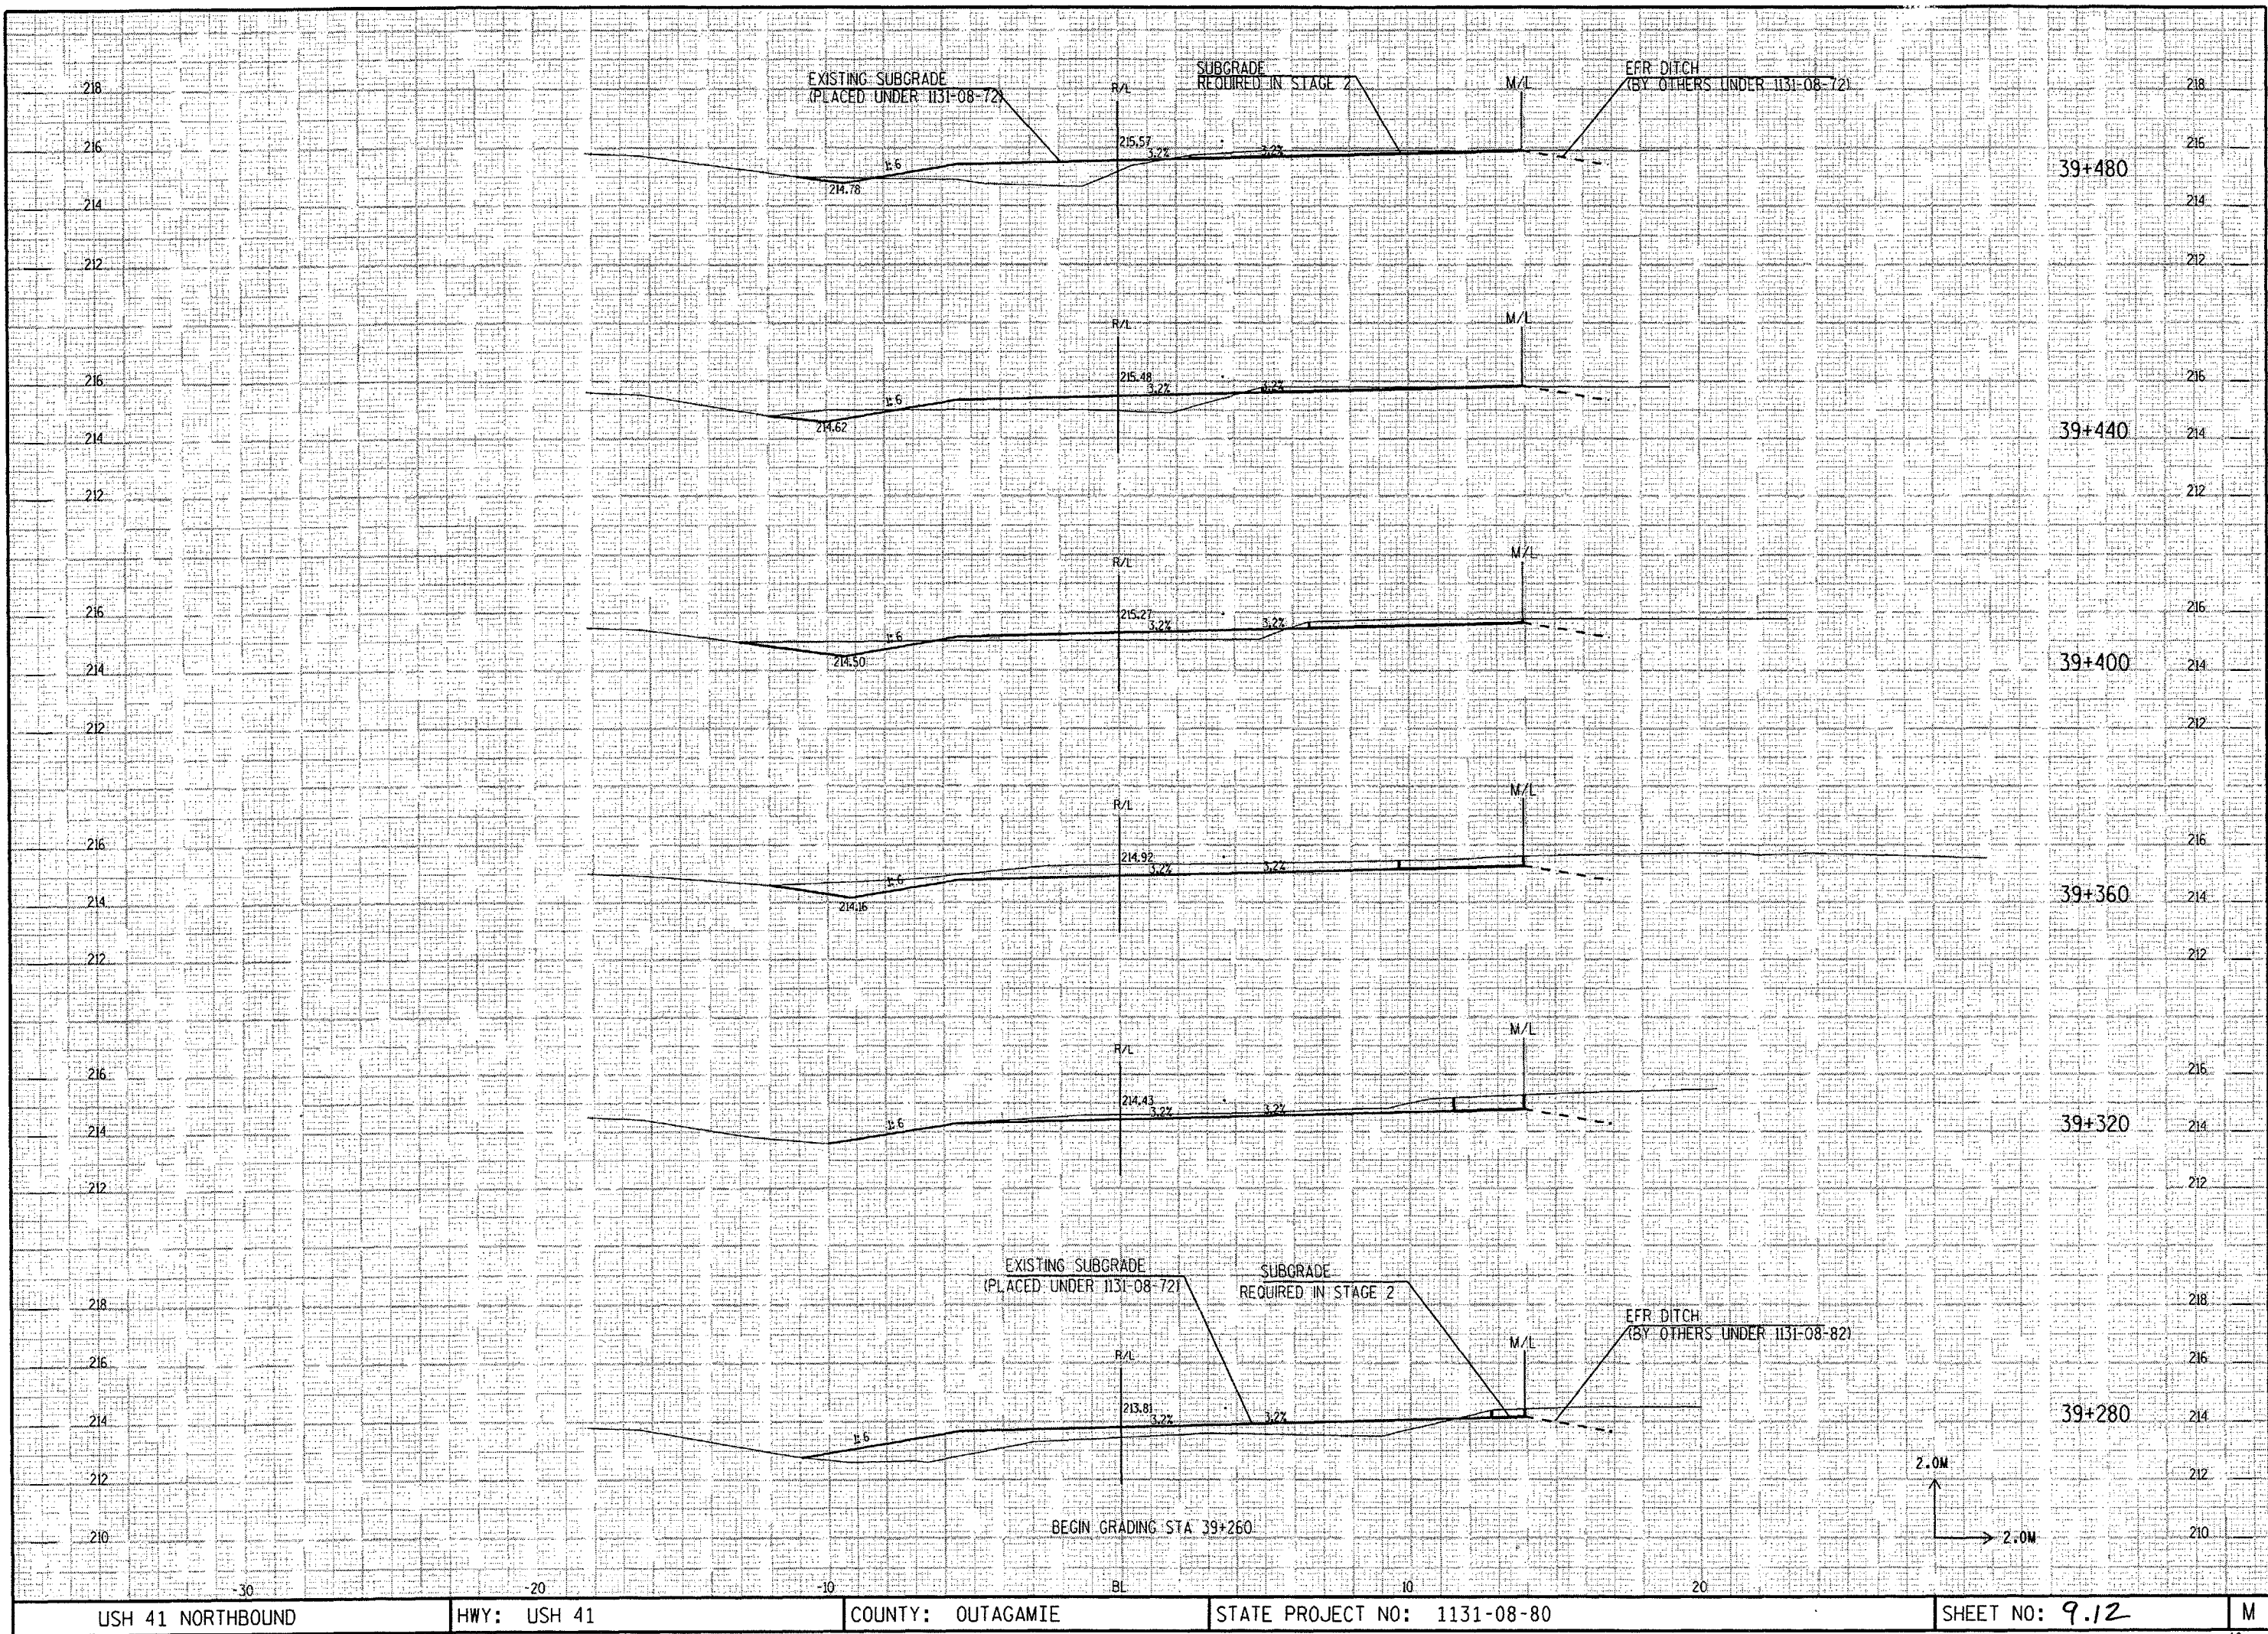

USH 41 NORTHBOUND

HWY: USH 41

COUNTY: OUTAGAMIE

STATE PROJECT NO: 1131-08-80


SHEET NO: 9.12

M





C:\GIS\10/19/1999 14:25 PM C:\USERS\pjd\1130878\us41\us41a41sb\us41a41sb.dgn

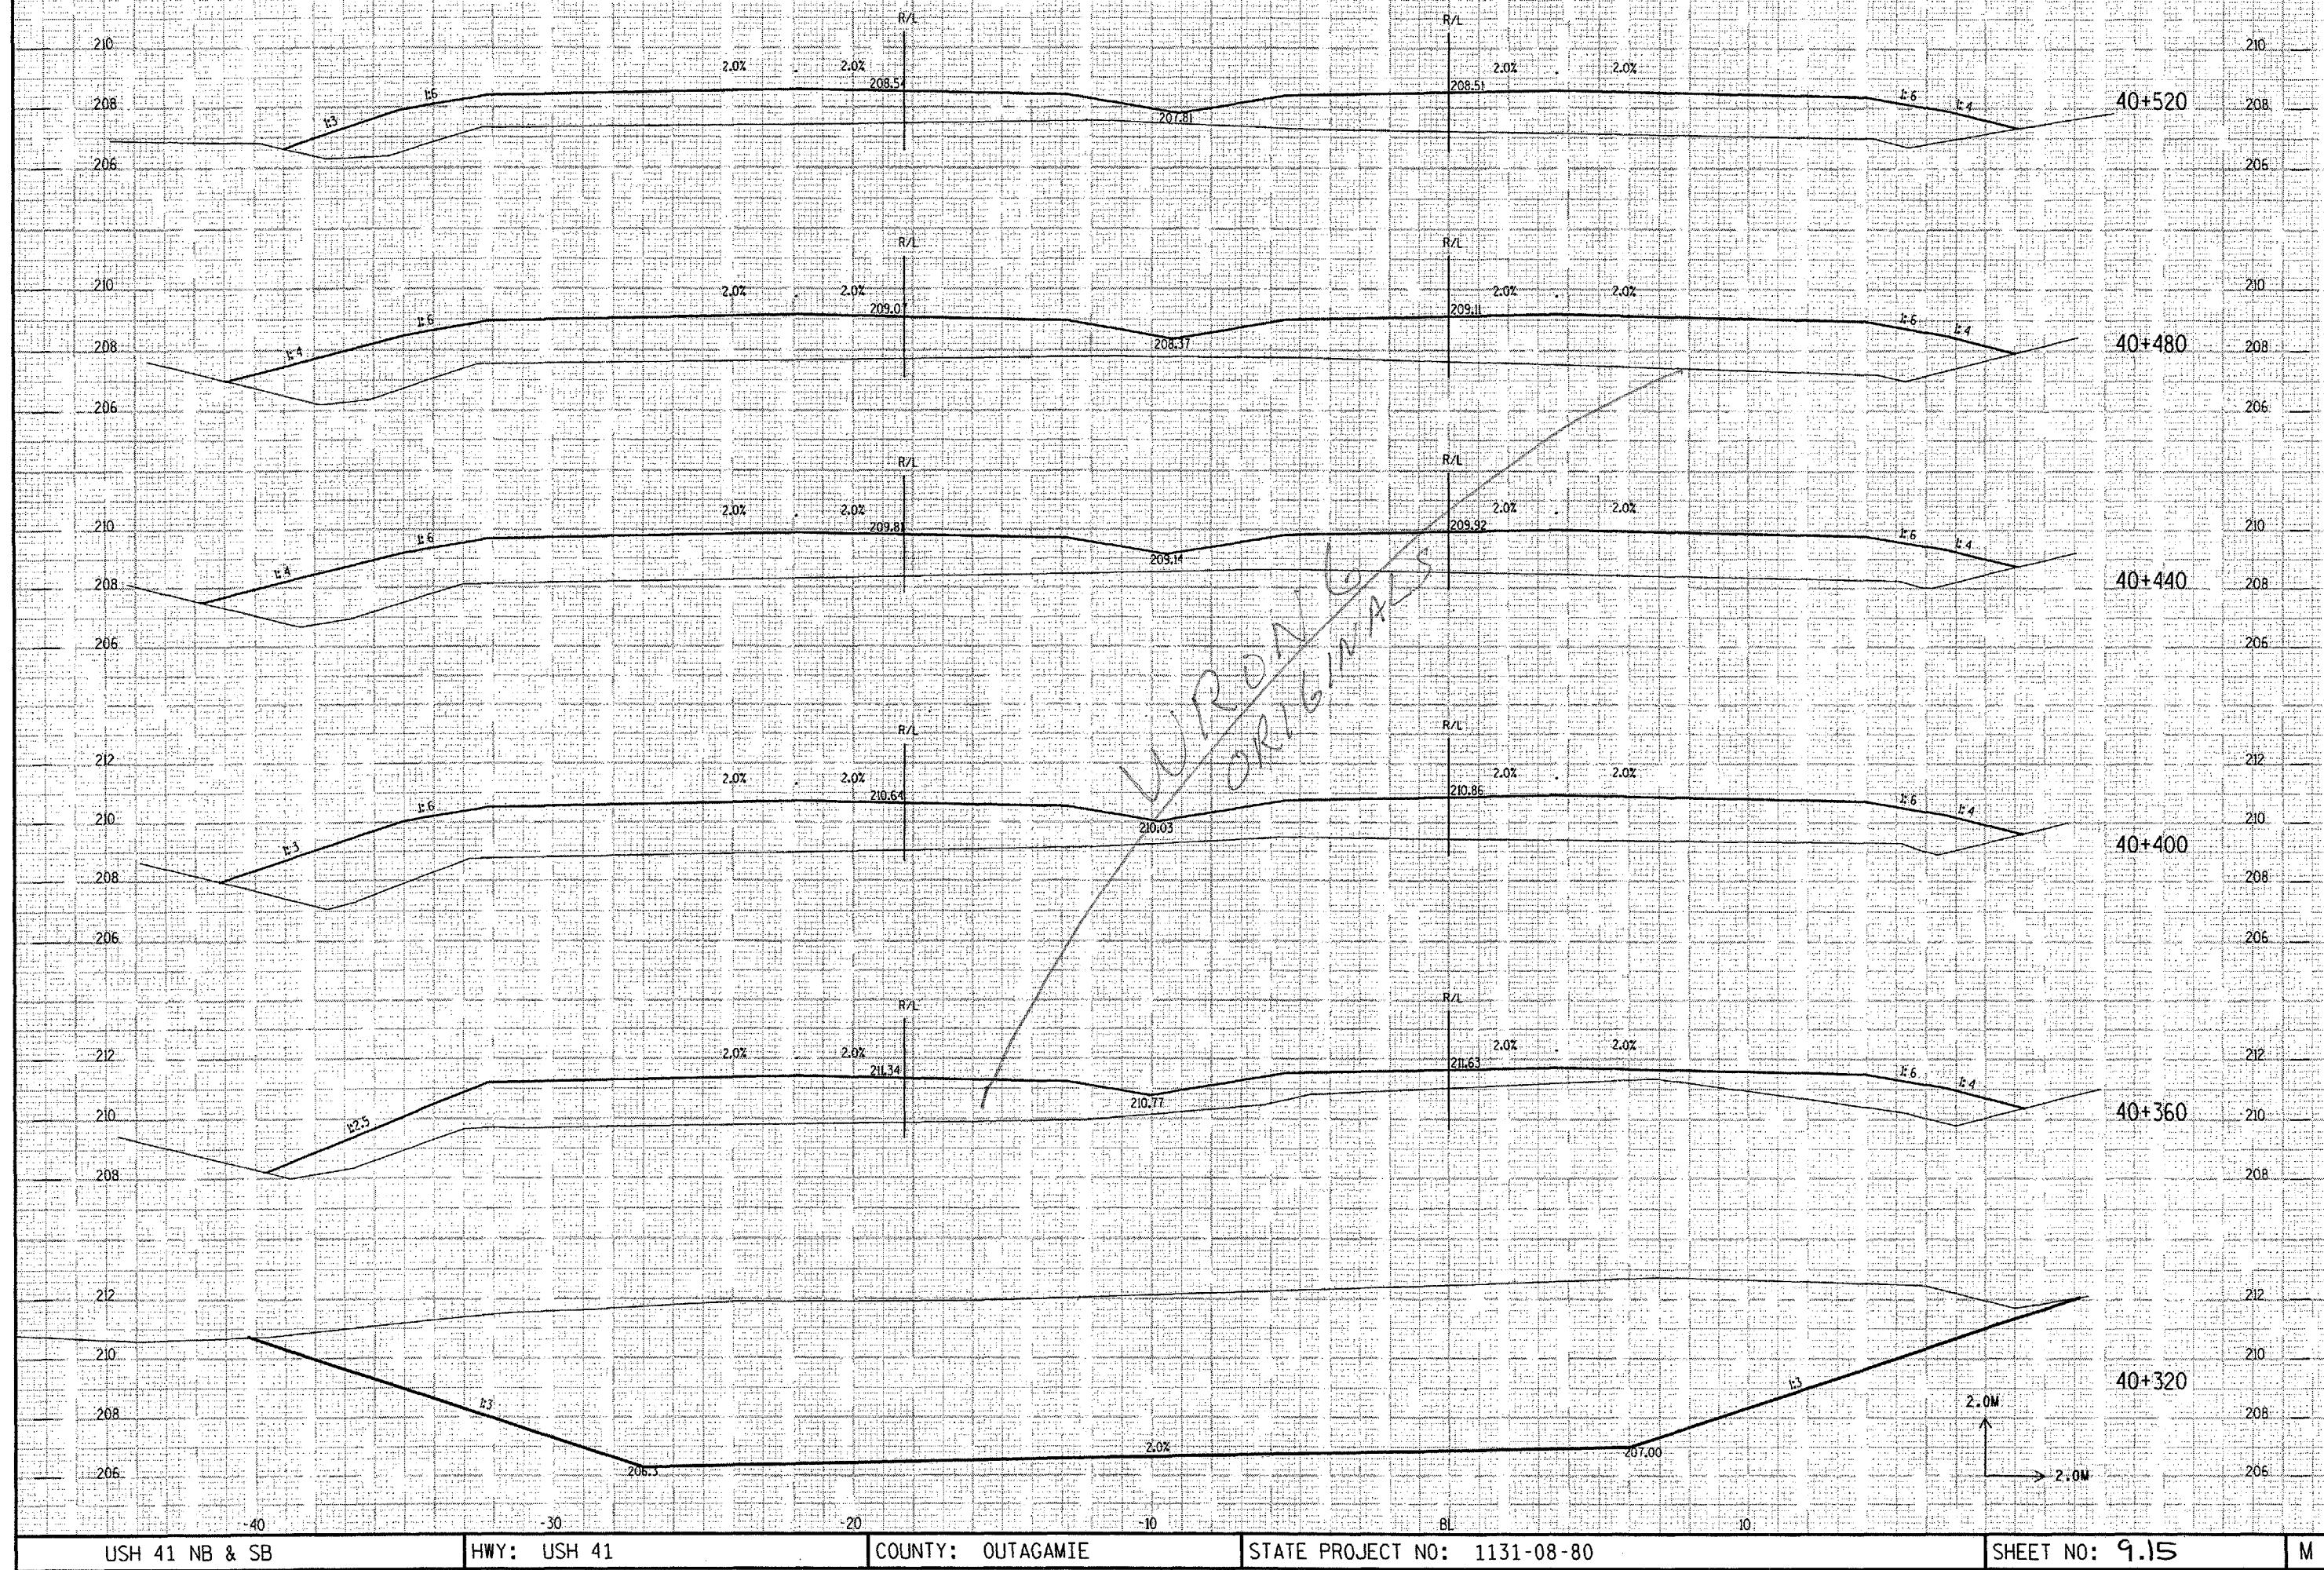

USH 41 NB & SB

HWY: USH 41


COUNTY: OUTAGAMIE


STATE PROJECT NO: 1131-08-80

SHEET NO: 9.15





M

QCS Tue 10/19/1999 4:45 PM C:\USERS\Pad3\130878\us41\us41a\41sb\dxs.dgn

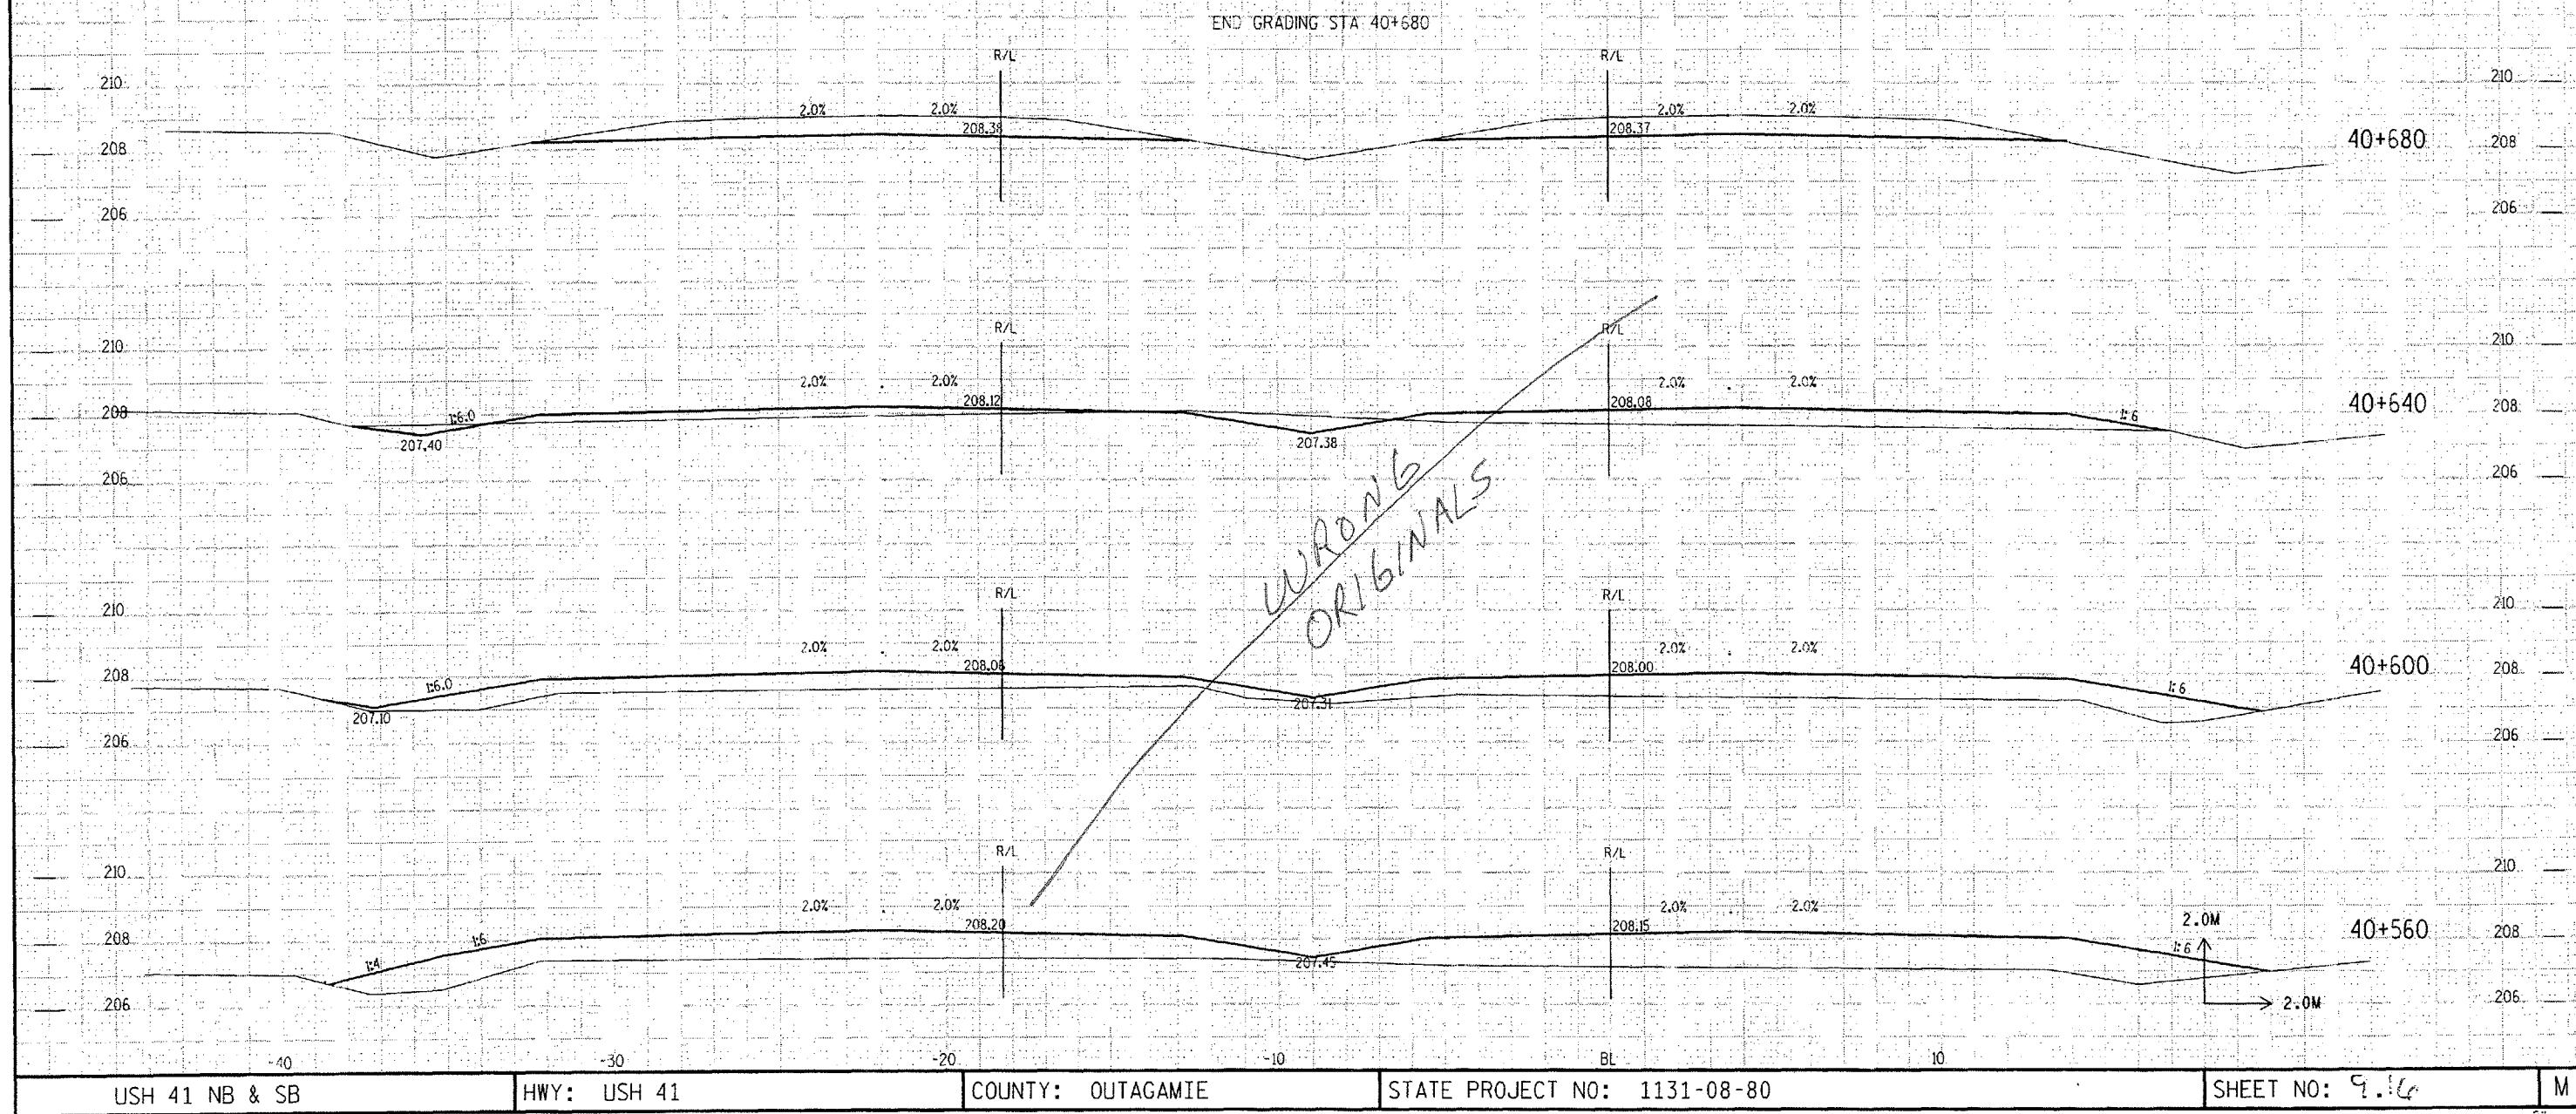

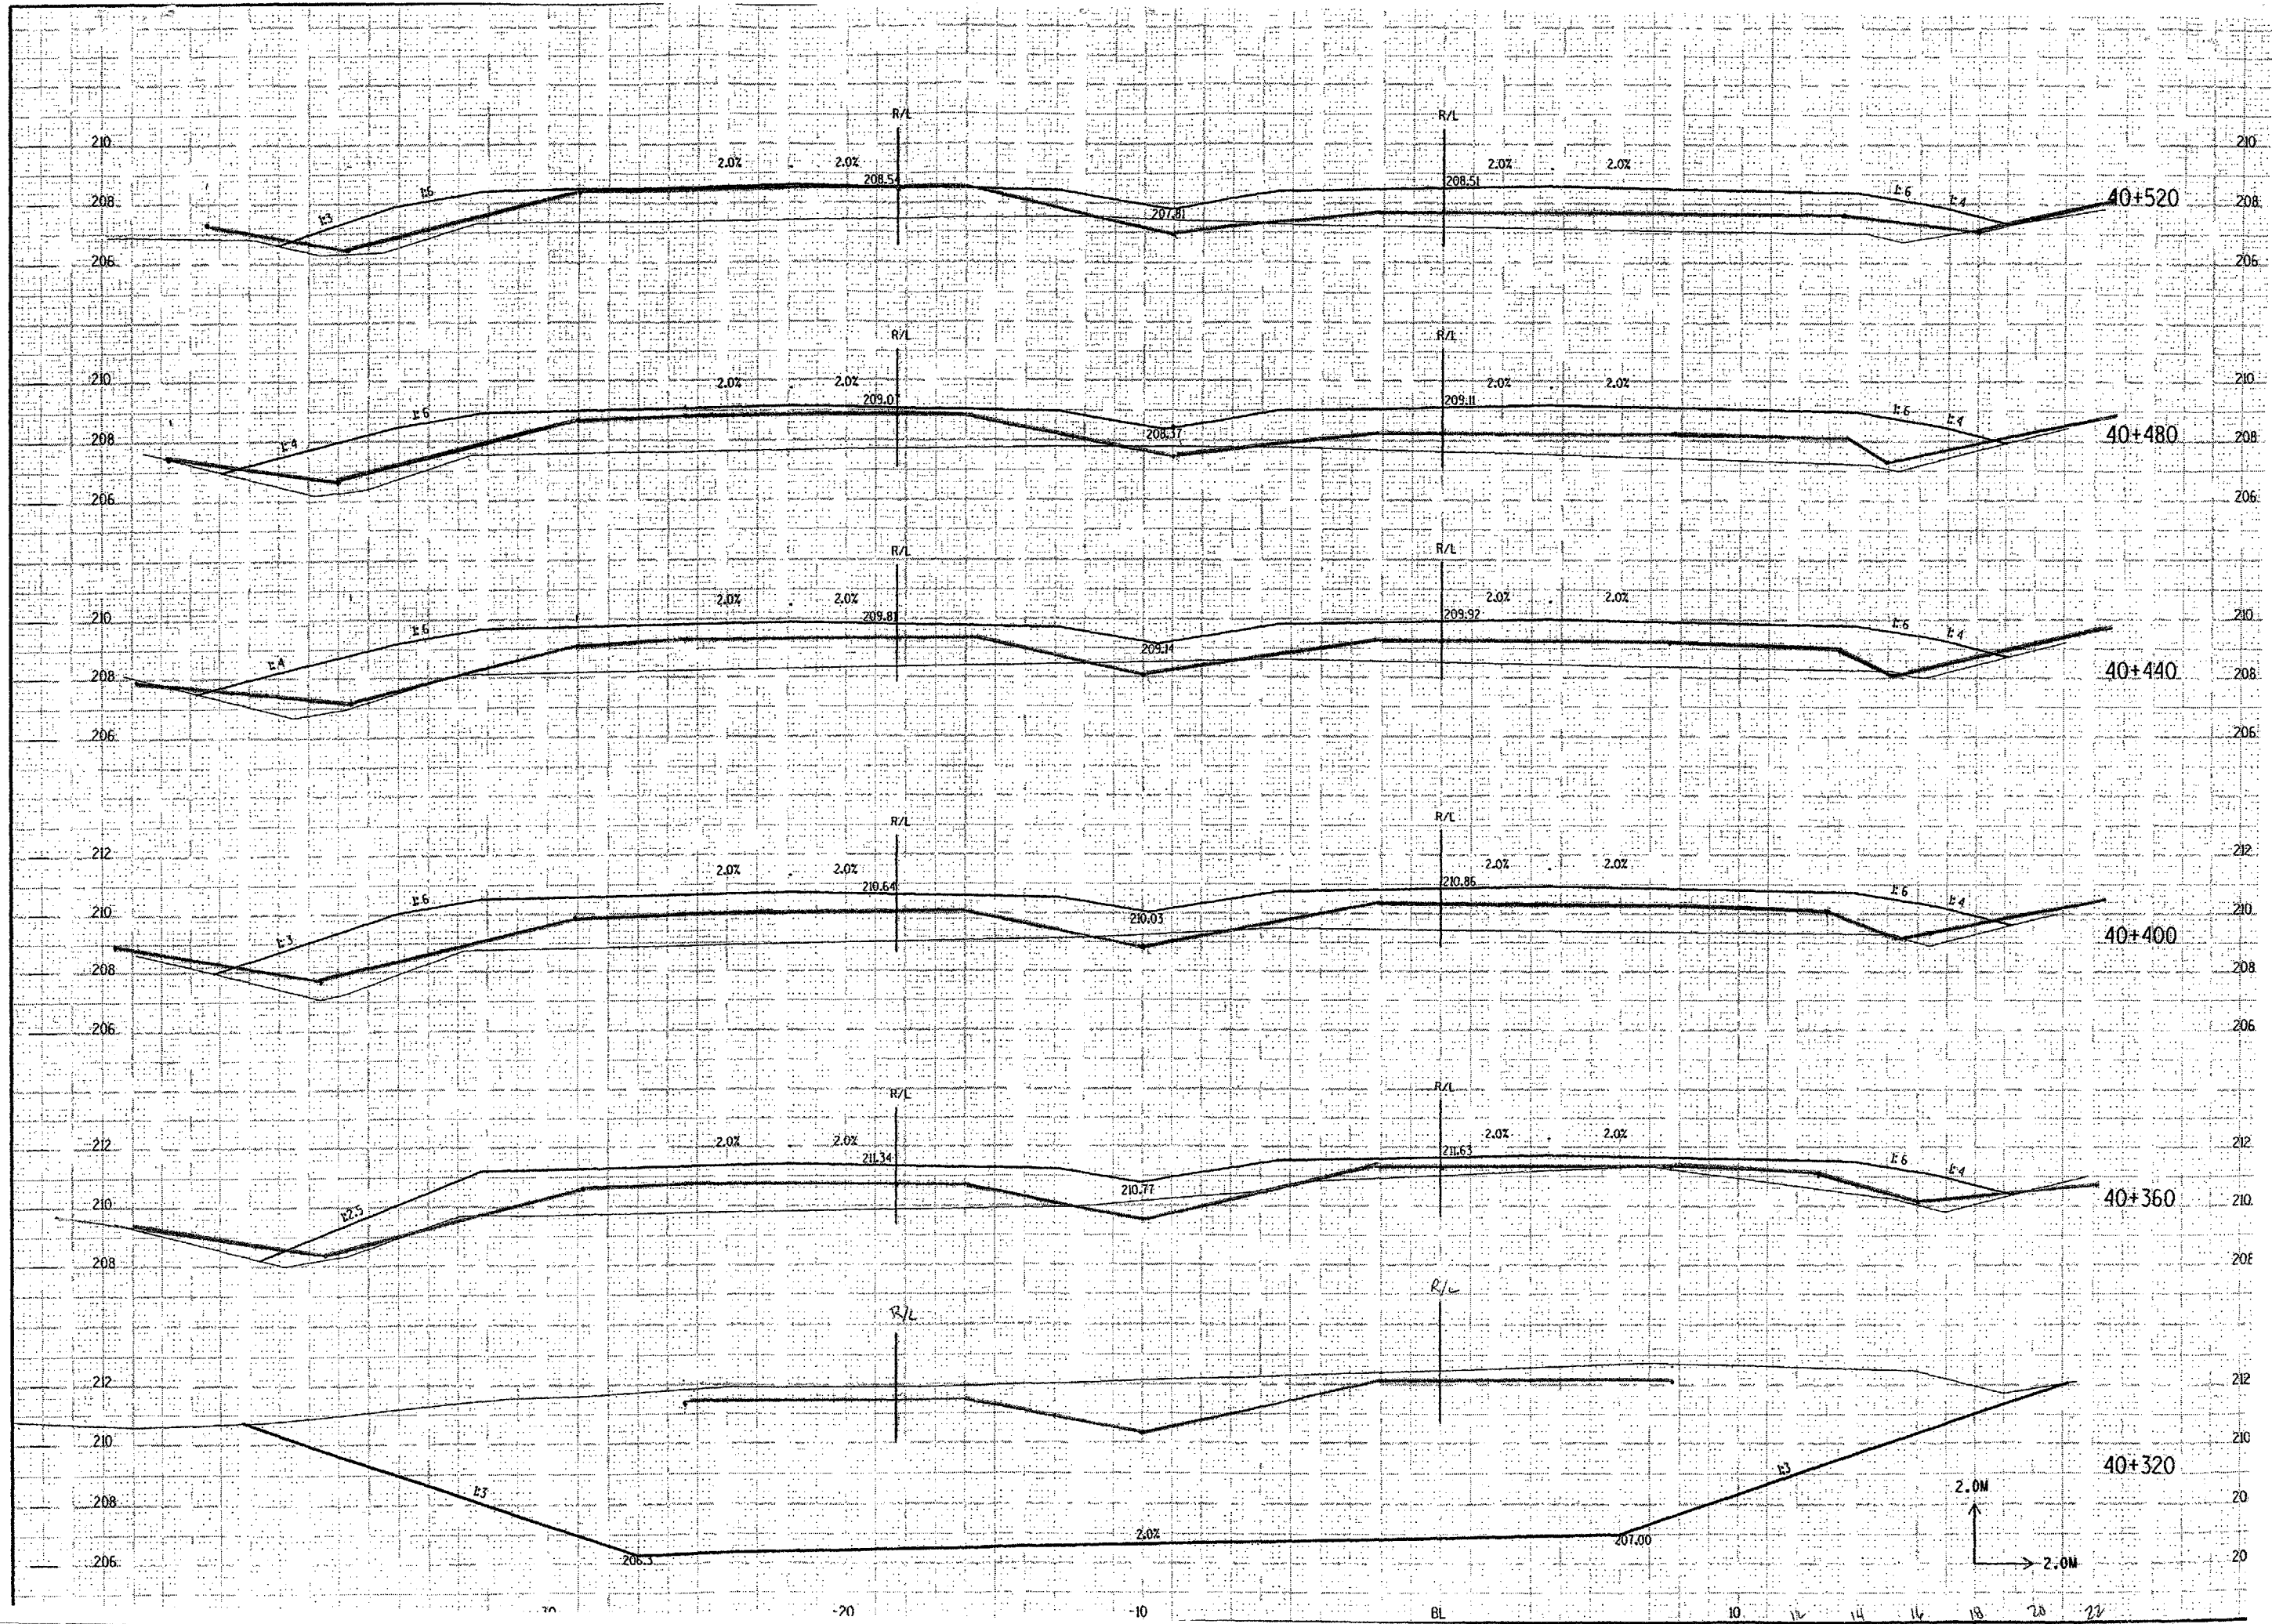

END GRADING STA 40+680

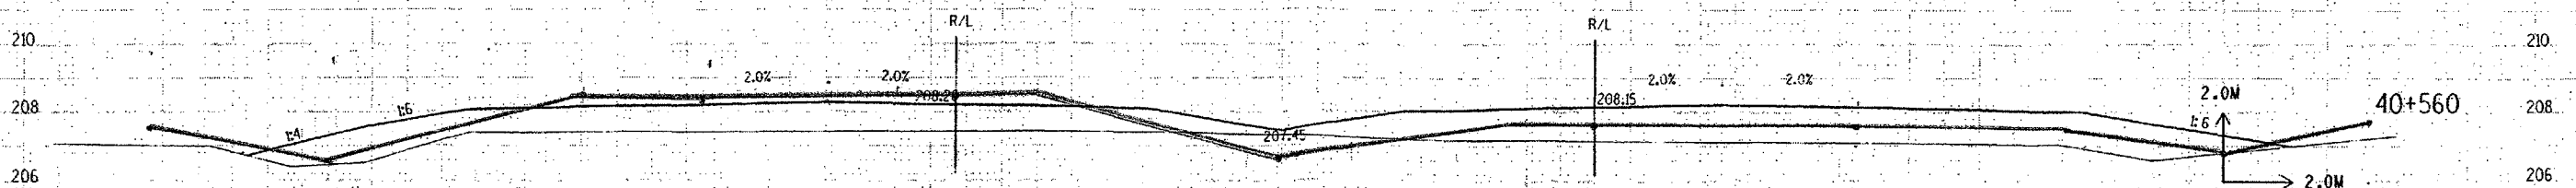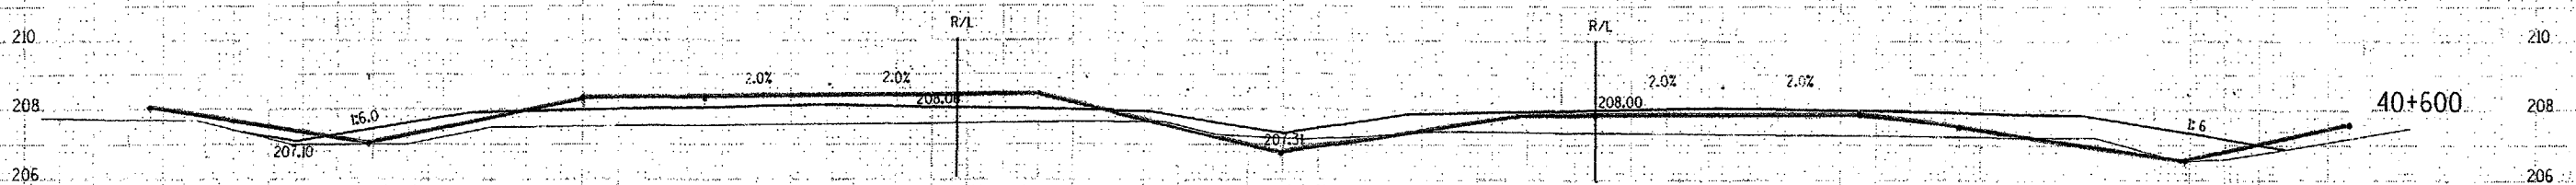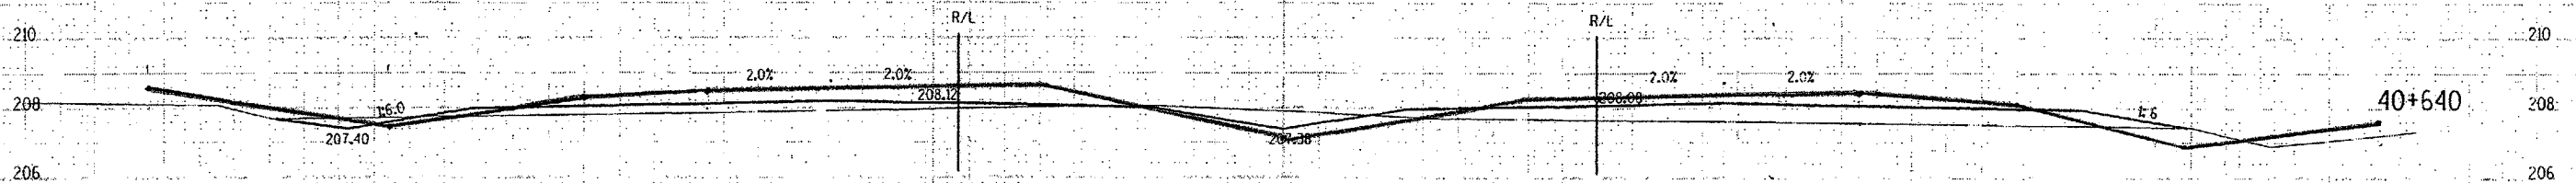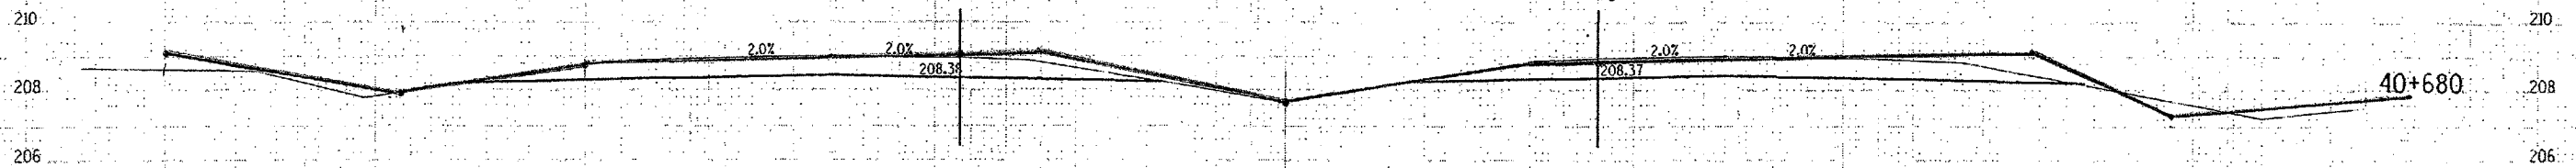

USH 41 NB & SB

HWY: USH 41

COUNTY: OUTAGAMIE

STATE PROJECT NO: 1131-08-80

SHEET NO: 9.14

M