

Feb 2000
OUTAGAMIE
PLOT NAME: 104
REV. DATE: 10-5-99
1131-08-80
ORIGINATOR: DIST. 3
FILE NAME: D3 - d3 113108m104.dgn

INDEX OF SHEETS

Sheet No. 1 Title
Sheet No. 2.1-2.15 Typical Sections and Details
Sheet No. 3.1-3.4 Estimate of Quantities
Sheet No. 3A-3H Miscellaneous Quantities
Sheet No. 4.1-4.11 Right of Way Plat
Sheet No. 5.1-5.21 Plan and Profile
Sheet No. 6.1-6.41 Standard Detail Drawings
Sheet No. 7.1 Sign Plates
Sheet No. Structure Plans
Sheet No. 9.1-9.2 Computer Earthwork Data
Sheet No. 9.3-9.16 Cross Sections

TOTAL SHEETS = 118




DESIGN DESIGNATION


USH 41
A.D.T. 1998 = 28 665
A.D.T. 2018 = 37 050
D.H.V. 2018 = 2 425
D. = 60-40
T. = 13.9%
V. = 110 KPH
ESALS = N/A

CONVENTIONAL SYMBOLS

COUNTY LINE
CORPORATE LIMITS
PROPERTY LINE
LOT LINE
LIMITED EASEMENT
EXISTING RIGHT OF WAY
PROPOSED OR NEW R/W LINE
SURVEY LINE
SLOPE INTERCEPT
ORIGINAL GROUND
MARSH OR ROCK PROFILE
EXISTING CULVERT
PROPOSED CULVERT (Box or Pipe)
CULVERT (Profile View)

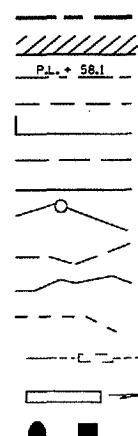

COMBUSTIBLE FLUIDS
UNDERGROUND UTILITIES
GAS
ELECTRIC
TELEPHONE OR TELEGRAPH
SERVICE PEDESTAL
CABLE MARKER
POWER POLE
TELEPHONE POLE
RAILROAD
MARSH AREA
WOODED OR SHRUB AREA

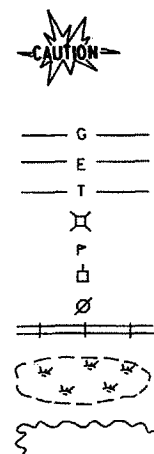

STATE OF WISCONSIN DEPARTMENT OF TRANSPORTATION

KAUKAUNA - DE PERE

CTH 00 - WRIGHTSTOWN ROAD (MAINLINE)

USH 41

OUTAGAMIE COUNTY


STATE PROJECT NUMBER
1131-08-80

AS BUILT

1735

AS BUILT PLAN
NO.

SUPERVISOR Jill Michaelson
RESIDENT Mike Leitzke
CONTRACTOR Strey Construction
COMPLETED 12-1-2000

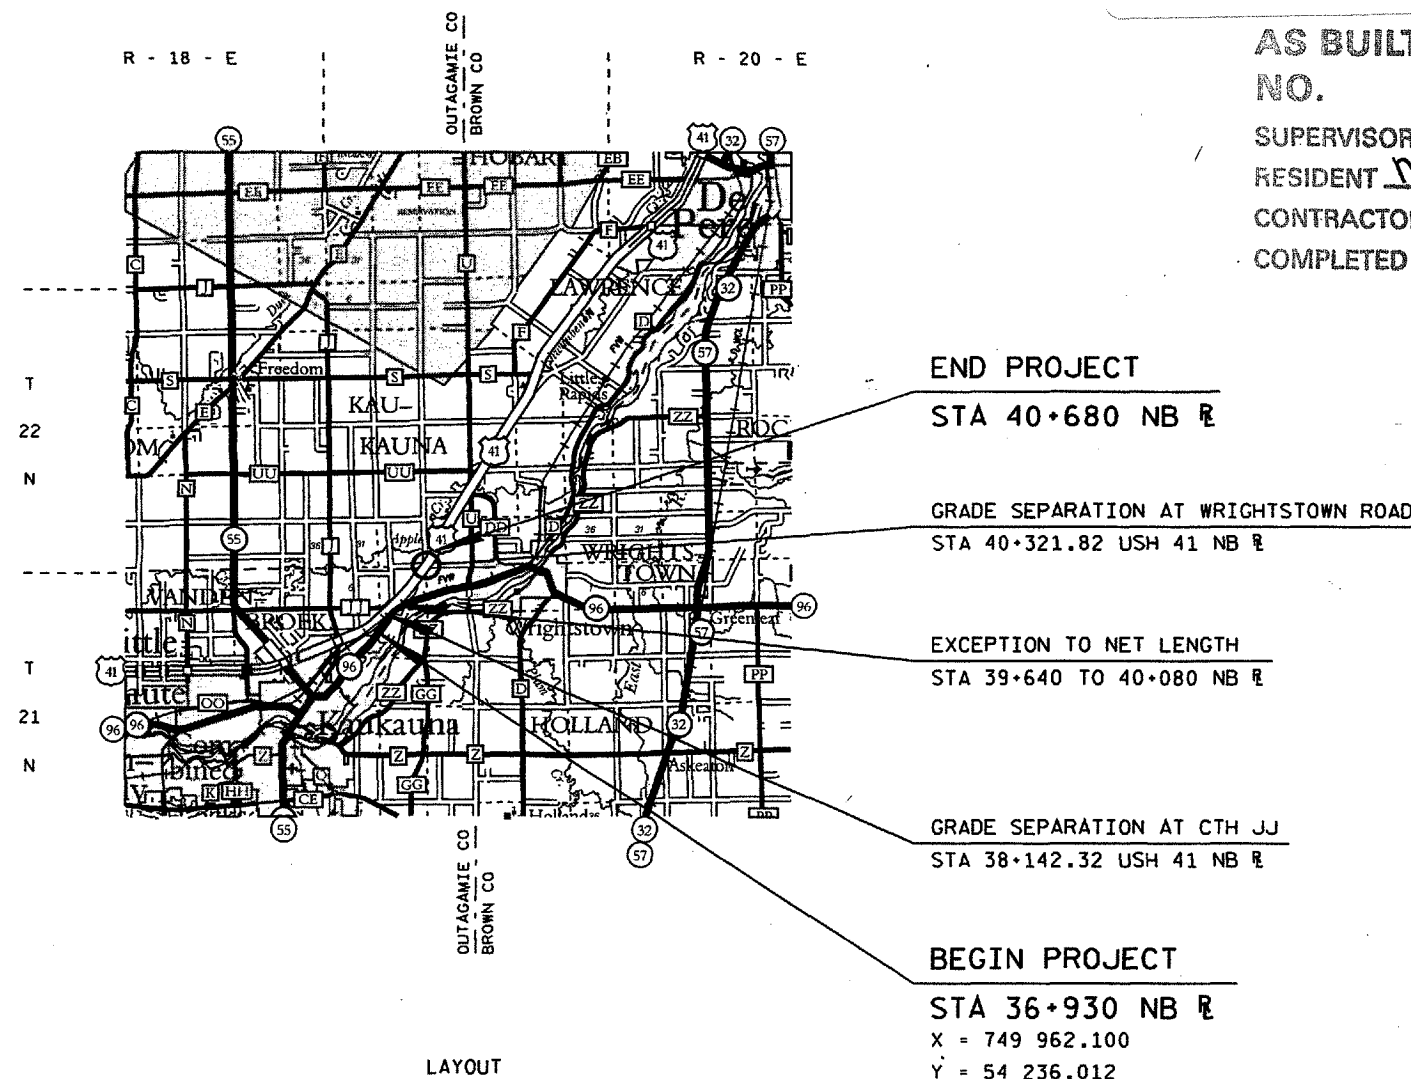

TOTAL NET LENGTH OF CENTERLINE = 3.310 km

ALL COORDINATES ON THIS PLAN ARE REFERENCED TO
THE WISCONSIN COORDINATE SYSTEM CENTRAL ZONE.

SURVEY BOOK NO. 1480 & 1480A

STATE OF WISCONSIN DEPARTMENT OF TRANSPORTATION

PREPARED BY
Surveyor DISTRICT 3
Designer J. S. BOADO
District Examiner G. STOIBER & E. L. VANN
District Supervisor M. J. BERG
Proj. Dev. Engineer N.R. AFFELDT
C.O. Examiner

APPROVED FOR DISTRICT OFFICE
DATE: 10/25/99 [Signature]
(Signature) P.E.

AUTHORIZED FOR CENTRAL OFFICE DESIGN
DATE: 11/29/99 [Signature]
(Signature)