


QCS Thu 10/28/1999 8:28:54 AM C:\USERS\p.d\1\10882\FR1\FR1.mxd

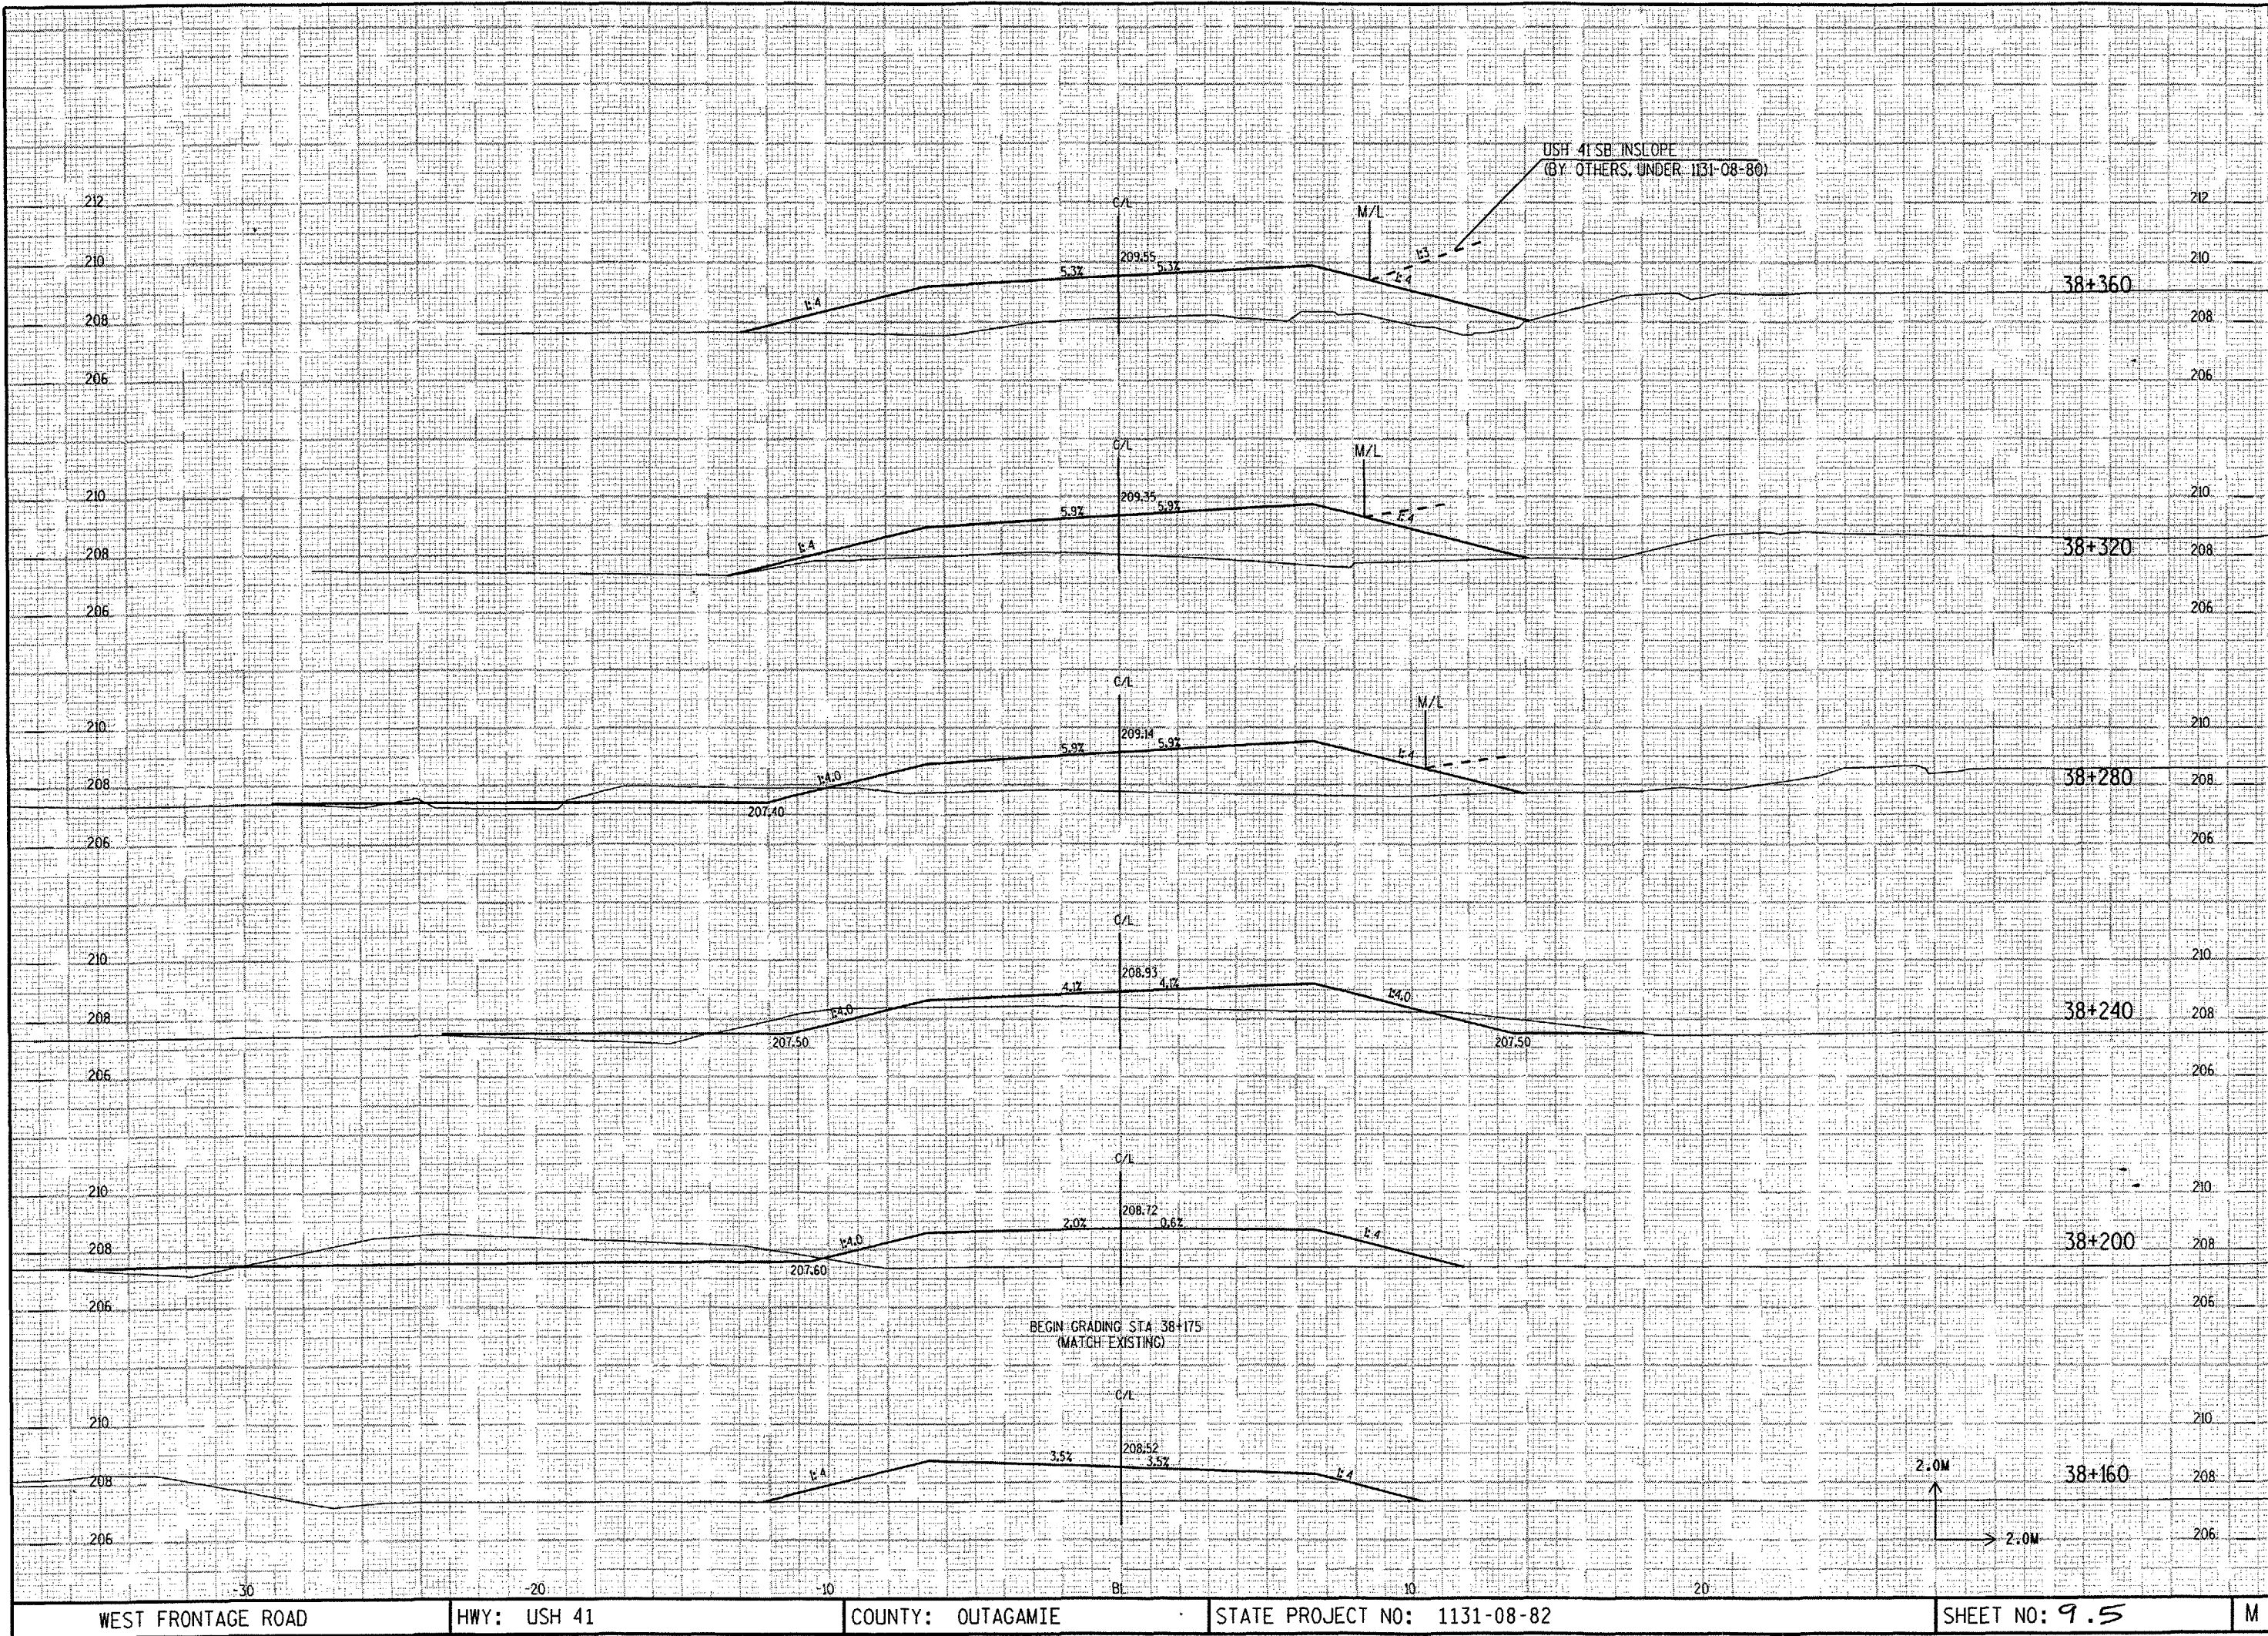

WEST FRONTAGE ROAD

HWY: USH 41


COUNTY: OUTAGAMIE

STATE PROJECT NO: 1131-08-82

SHEET NO: 9.5

M

UCS Thu 10/28/1999 8:28:54 AM C:\USERS\AP\d311310882\WFR14\FR14S.dgn

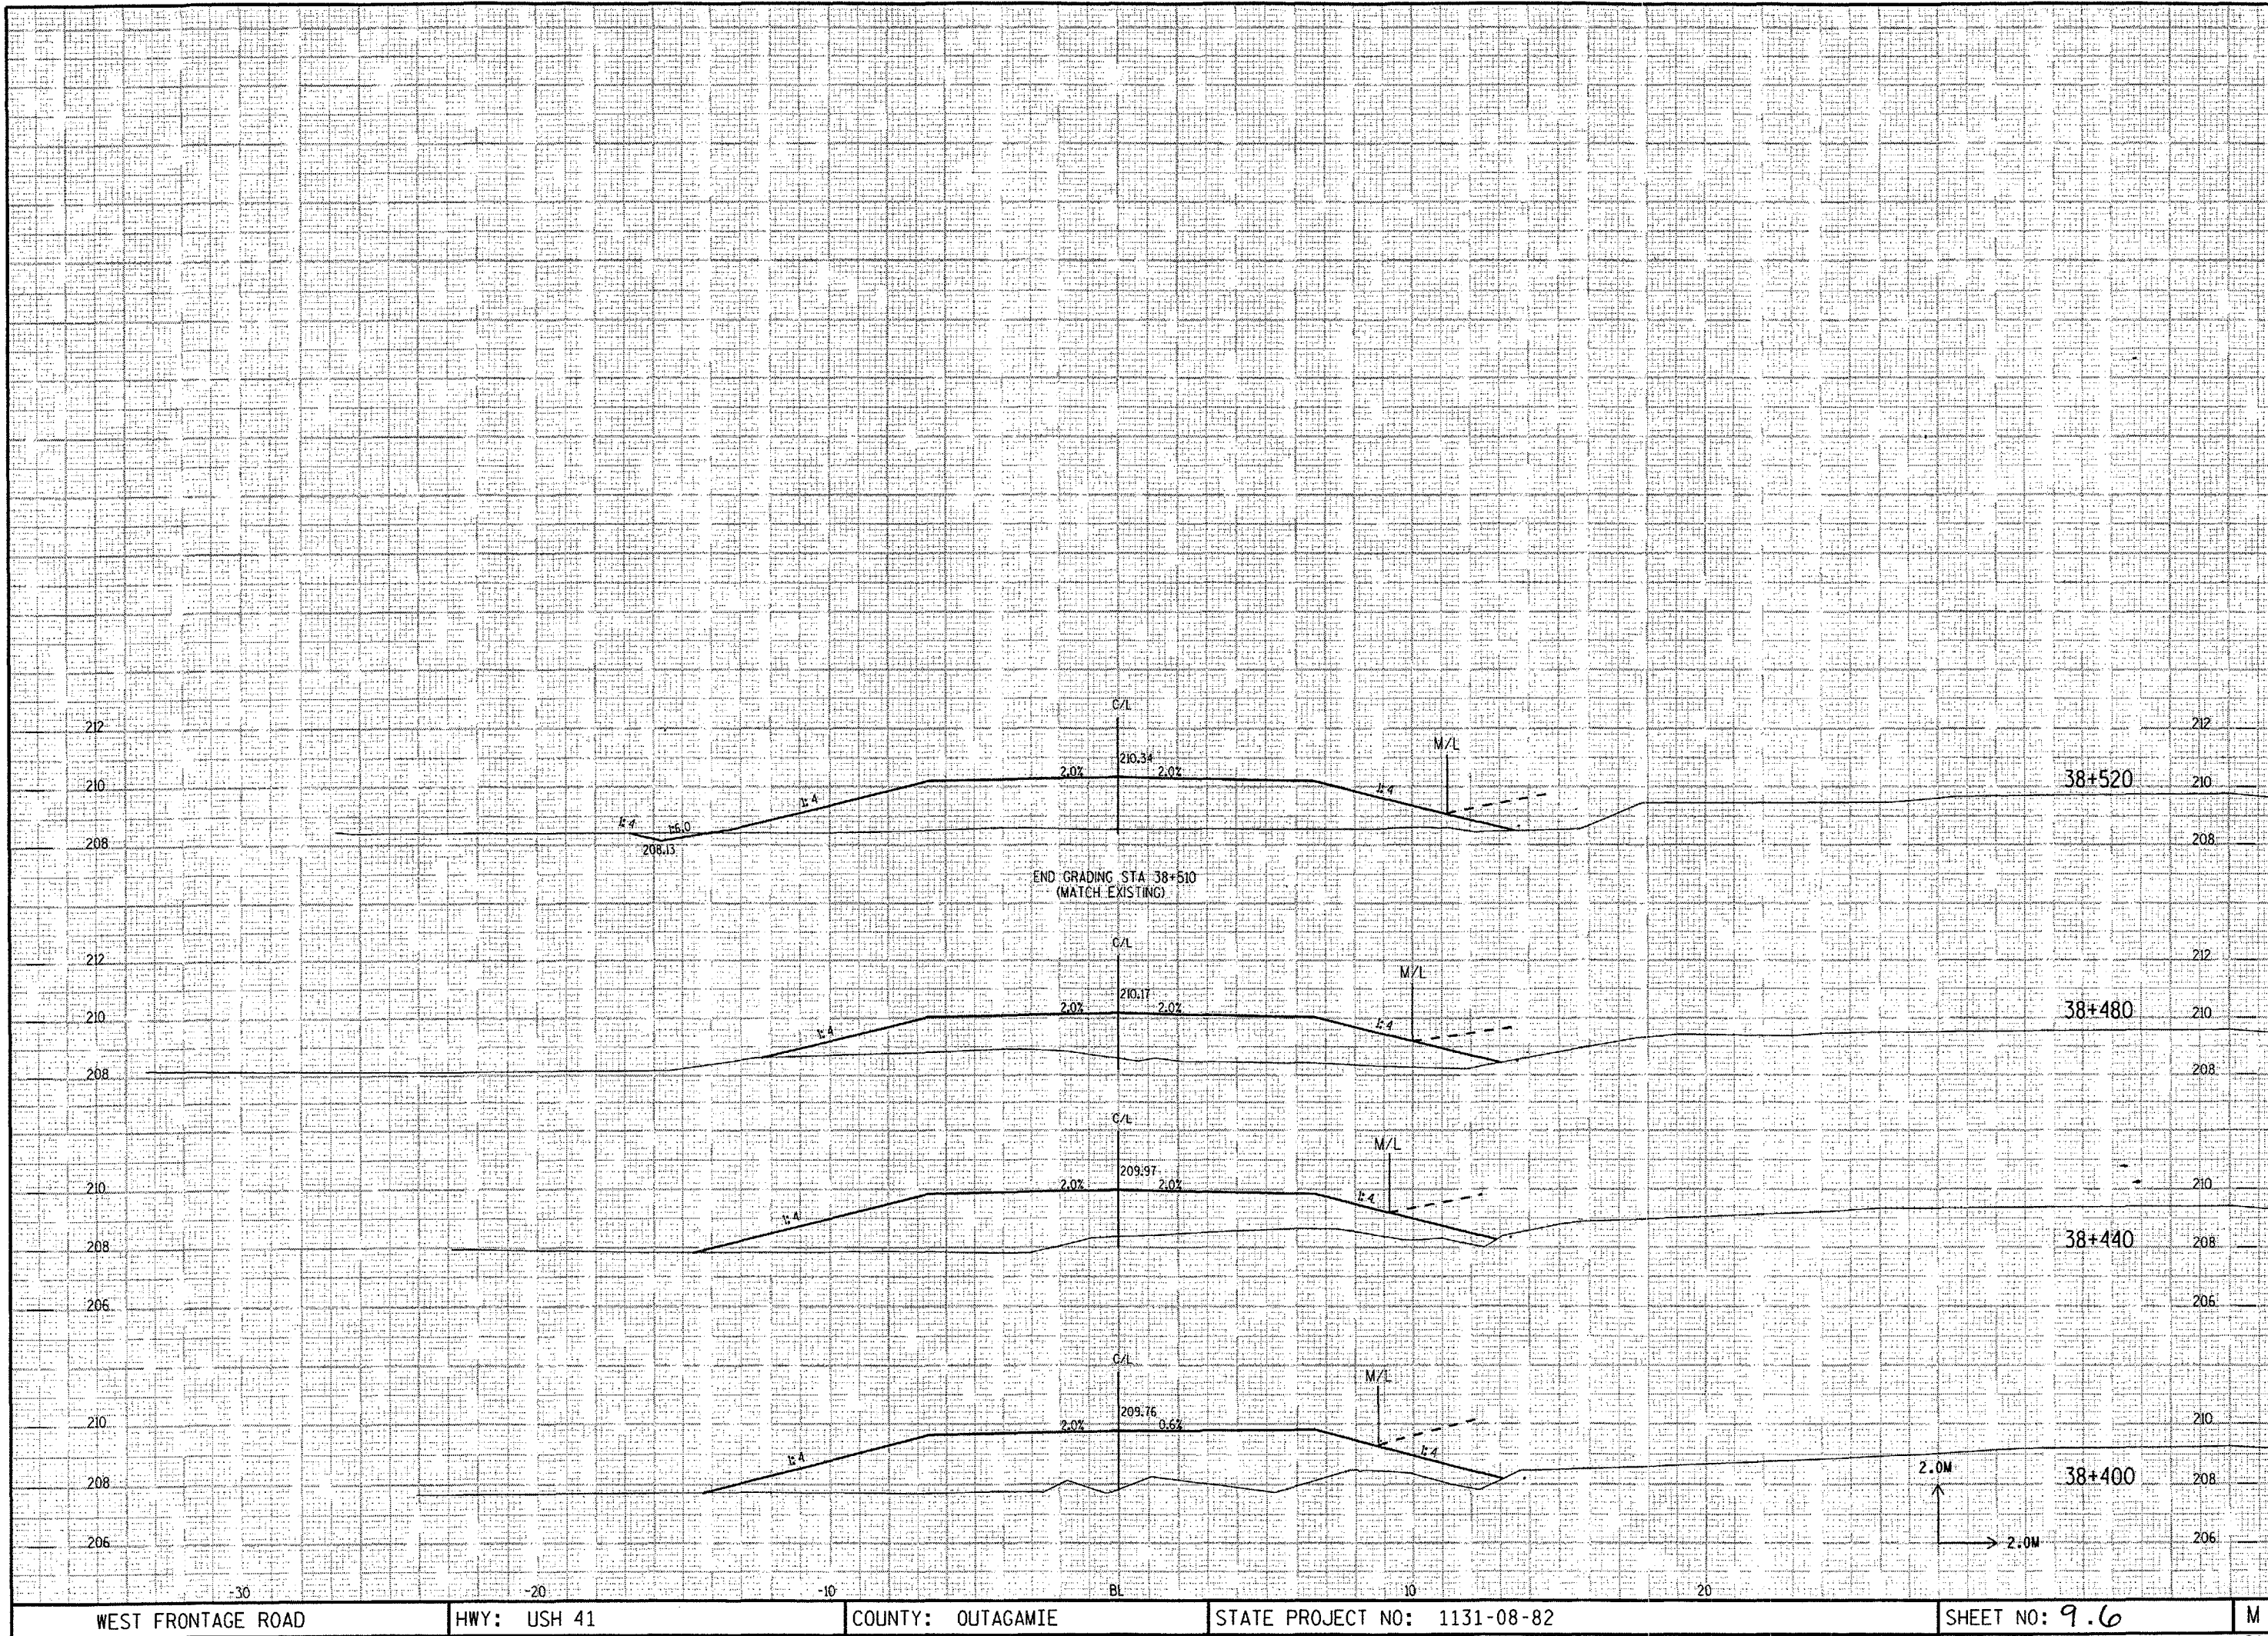

WEST FRONTAGE ROAD

HWY: USH 41


COUNTY: OUTAGAMIE

STATE PROJECT NO: 1131-08-82


SHEET NO: 9.6

M

C:\Users\p311310878\OneDrive\US41\US41A\tr-4.dgn

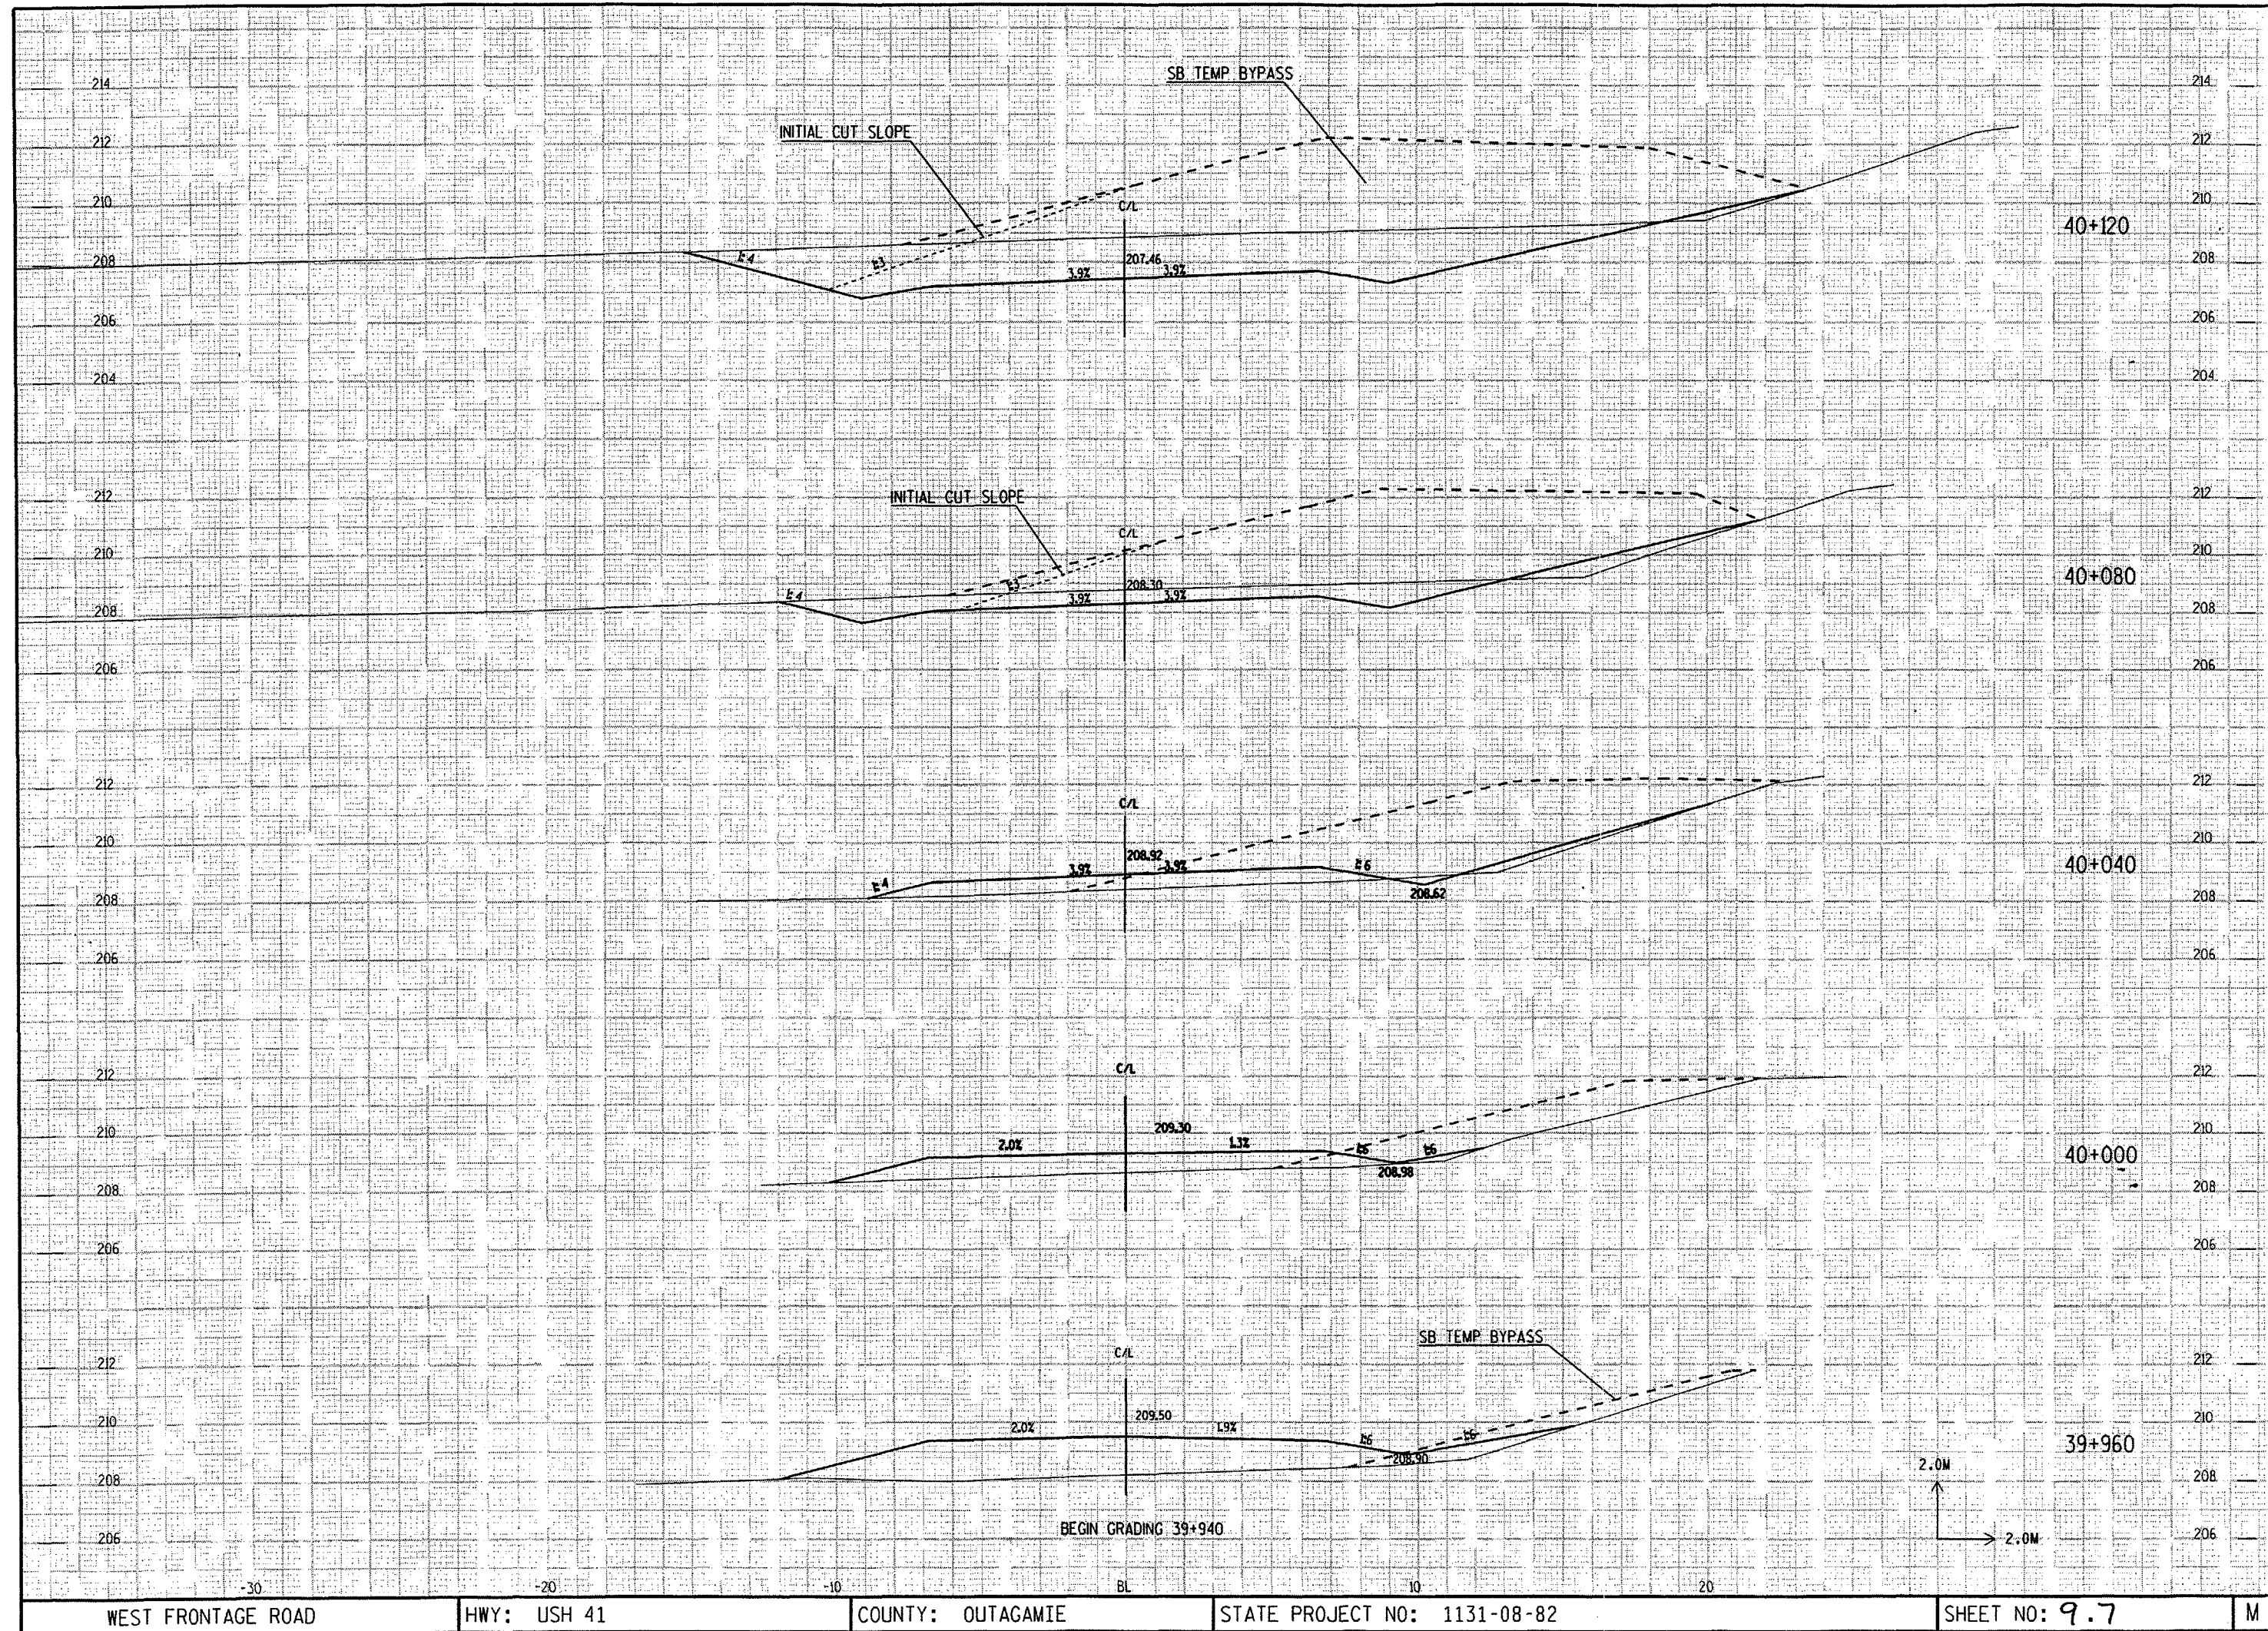

GCS Thu 10/28/1999 9:54:37 AM C:\USERS\p-r\311310878\ush41a\ush41a\wfr-4.dgn

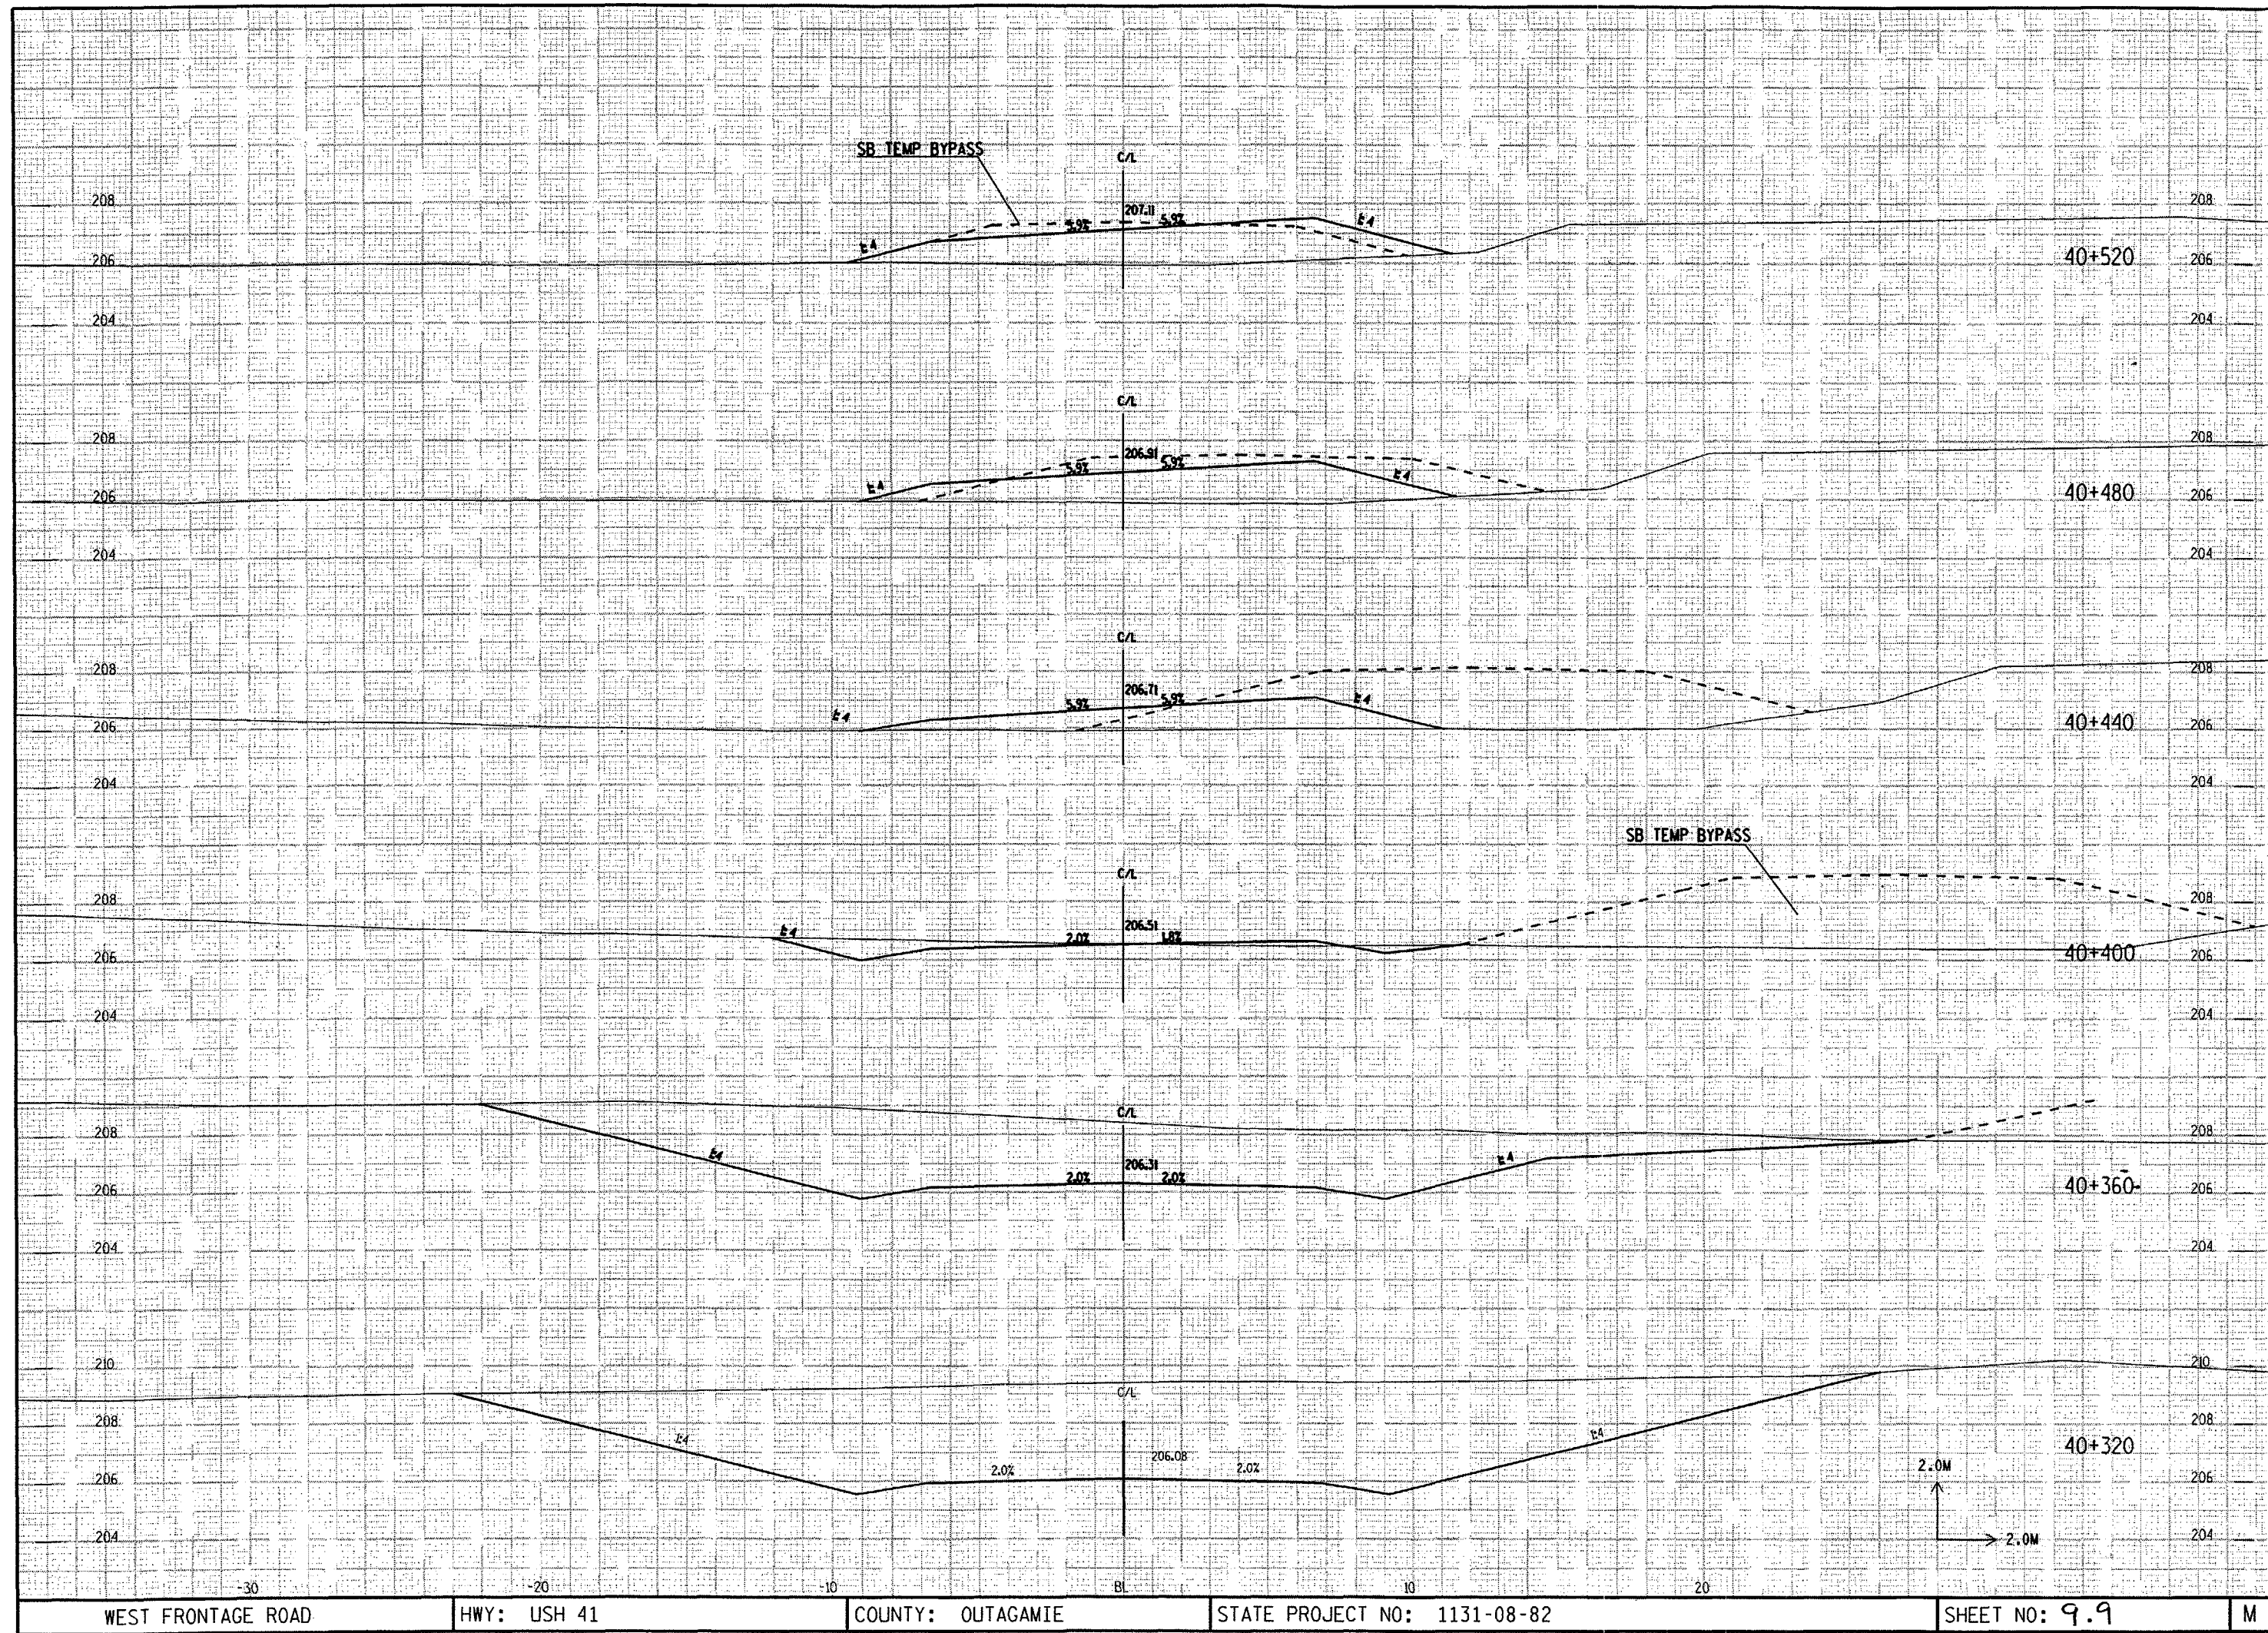

WEST FRONTAGE ROAD

HWY: USH 41

COUNTY: OUTAGAMIE


STATE PROJECT NO: 1131-08-82

SHEET NO: 9.9

M

44

C:\Users\pdp311310878\OneDrive\US41\wfr4.dgn 10/28/1999 9:54:37 AM

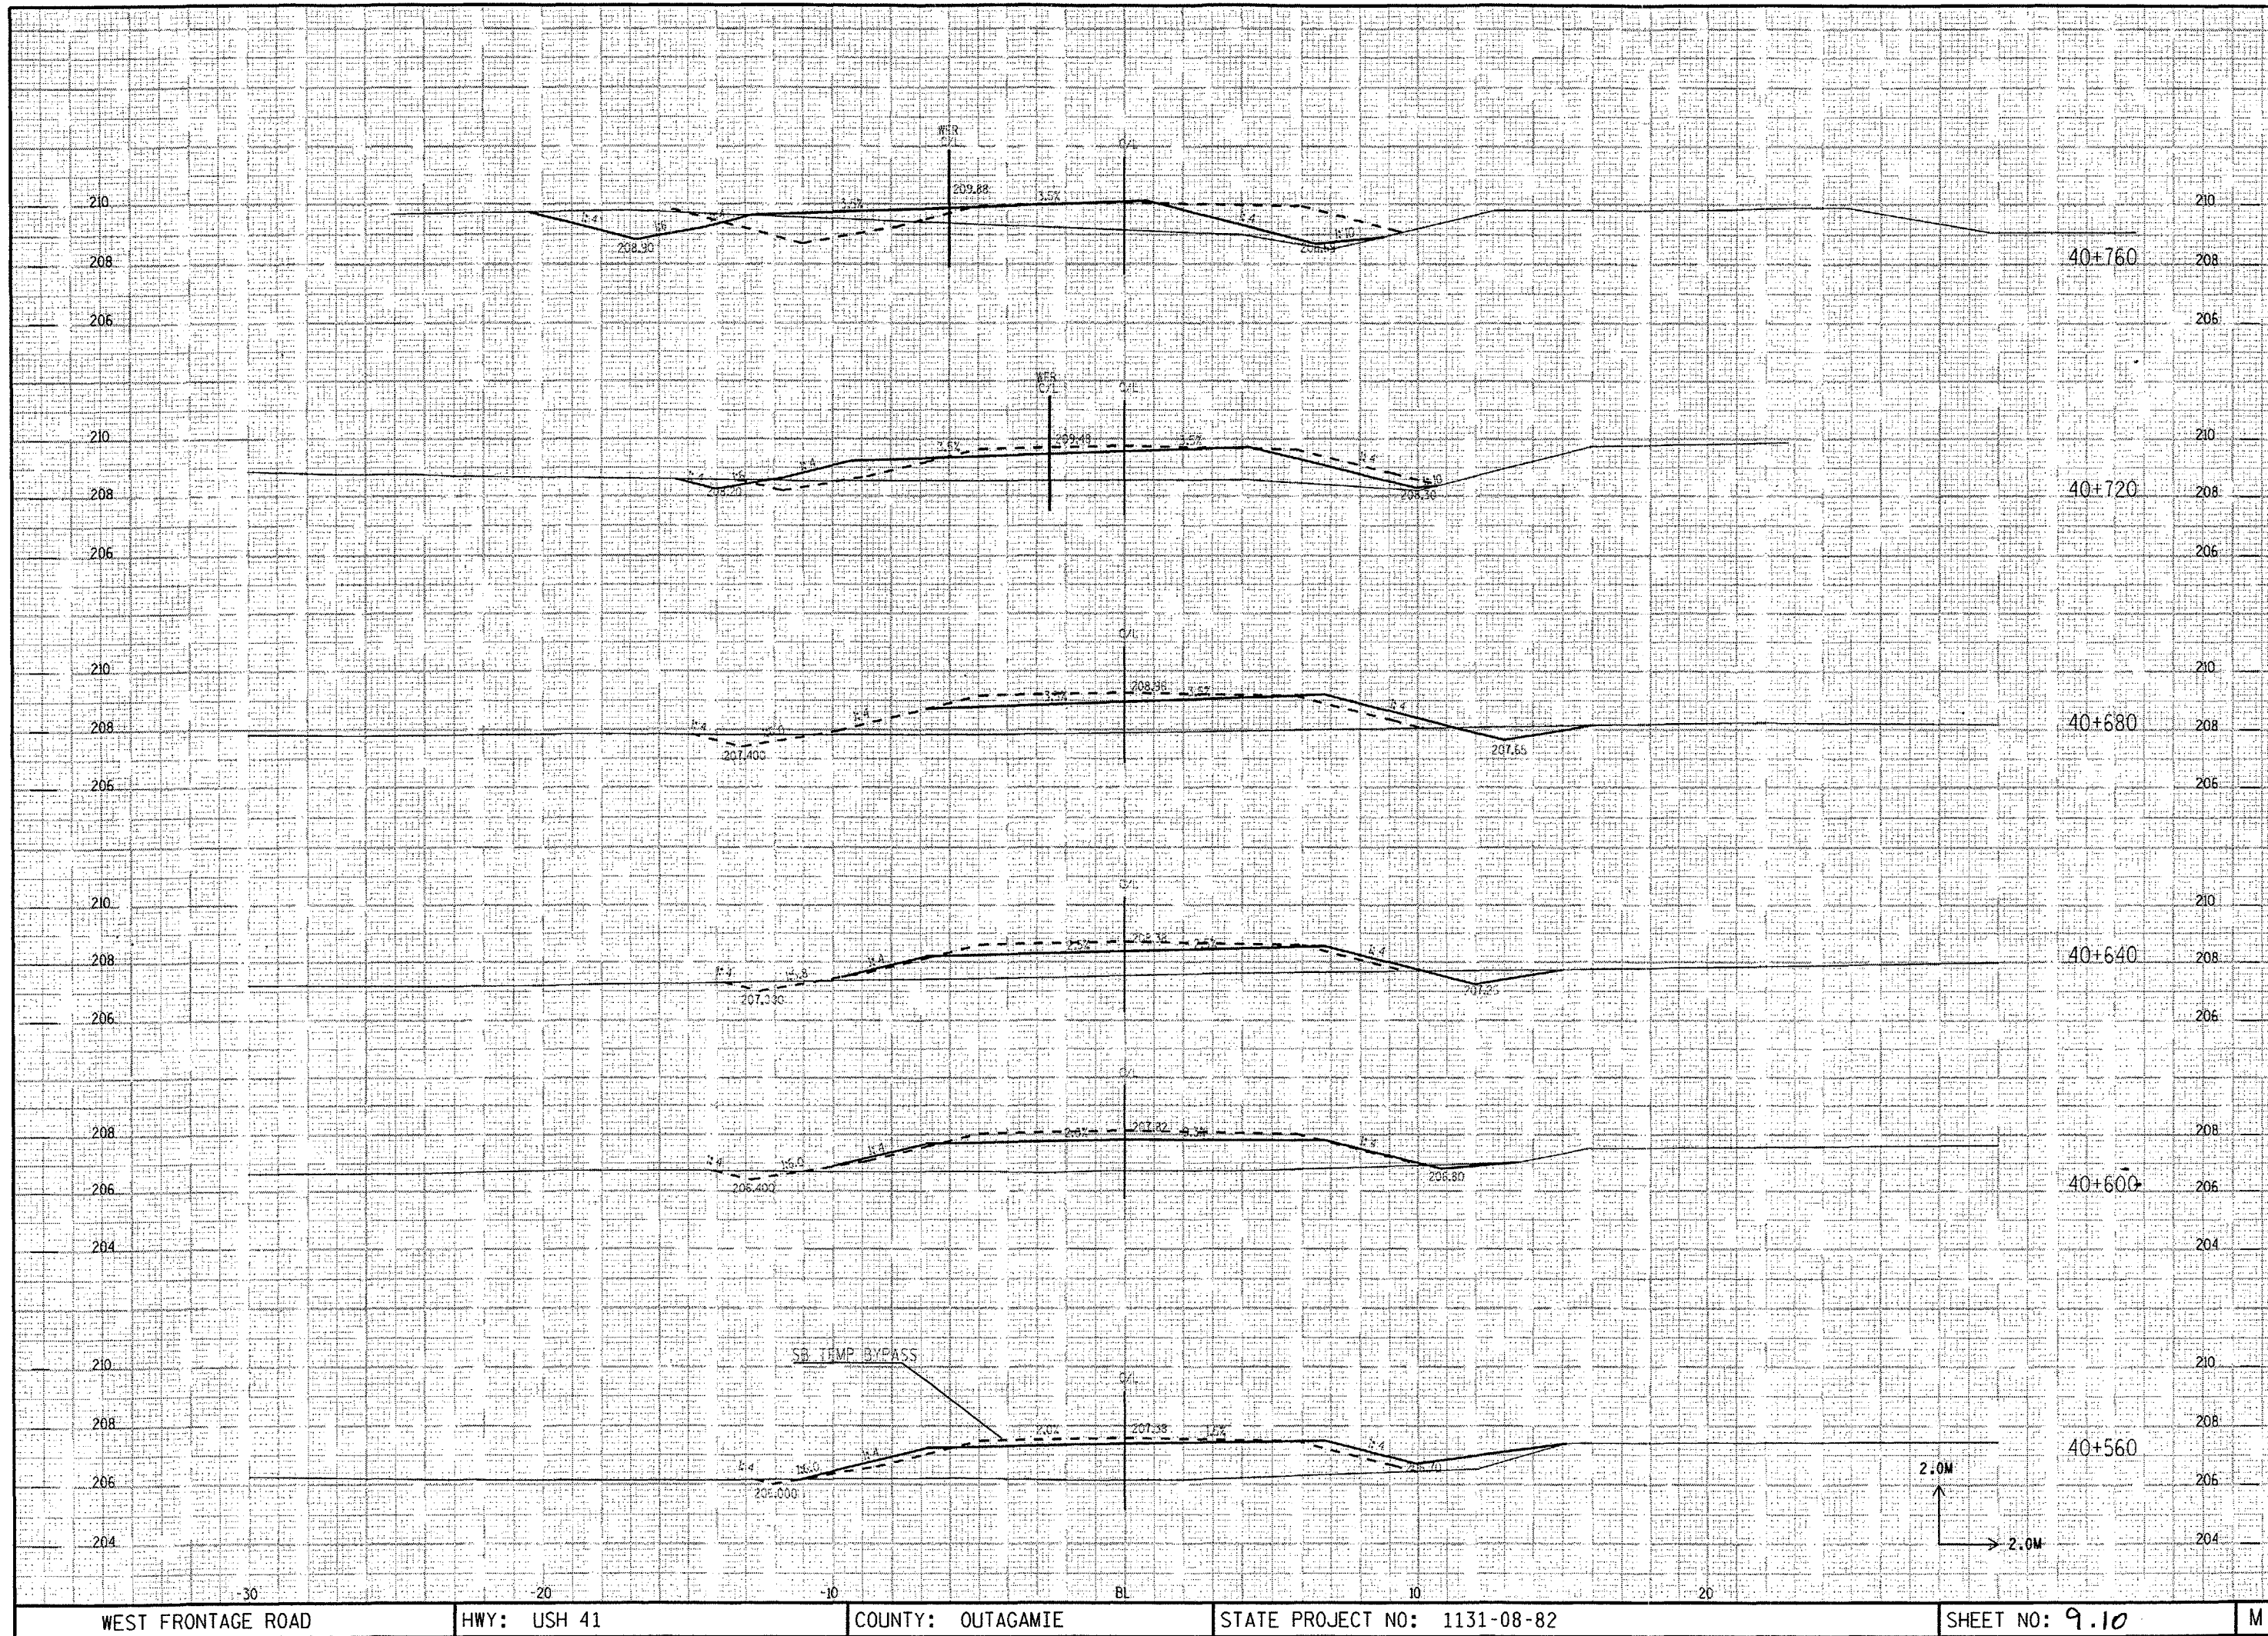

WEST FRONTAGE ROAD

HWY: USH 41


COUNTY: OUTAGAMIE

STATE PROJECT NO: 1131-08-82

SHEET NO: 9.10

M

0CS Thu 10/26/99 9:54:37 AM C:\USERS\p\03\110878\ush41\ush41a\wfr4.dgn

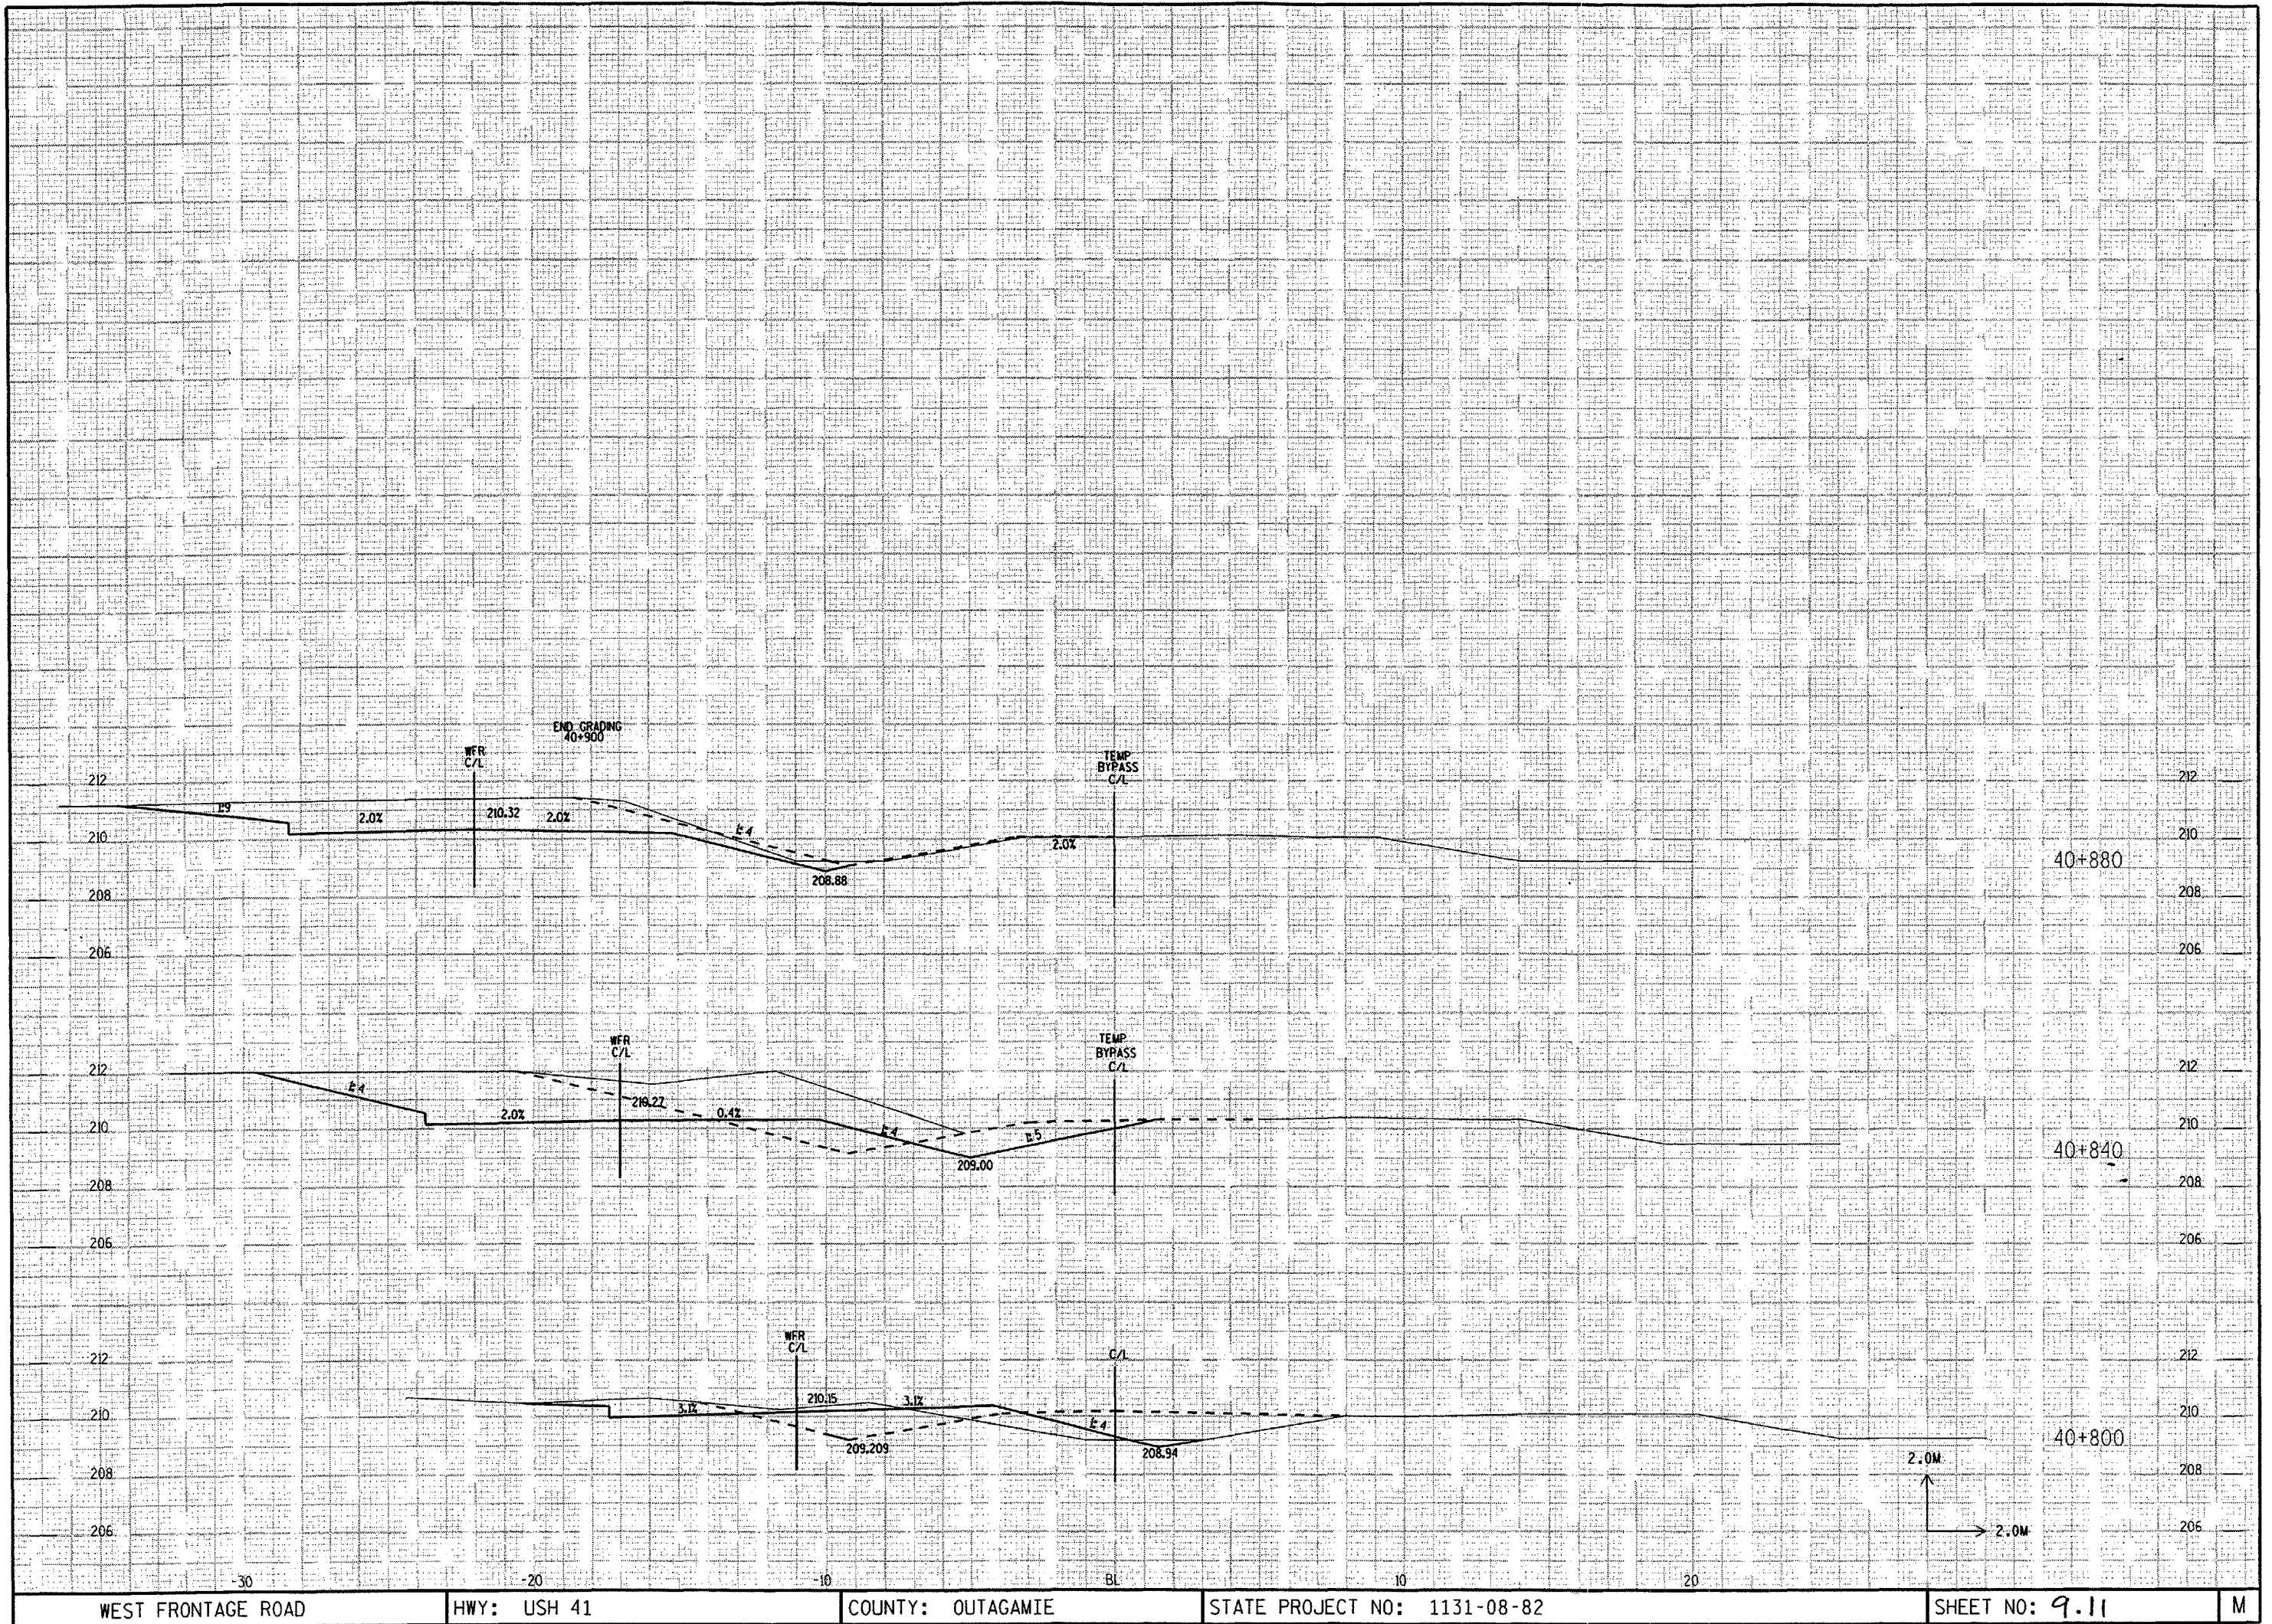

WEST FRONTAGE ROAD

HWY: USH 41


COUNTY: OUTAGAMIE

STATE PROJECT NO: 1131-08-82

SHEET NO: 9.11

M

TCS Thu 10/26/1999 6:06:12 AM C:\USERS\p\d\11310882\WFR31wfr4a.sgn

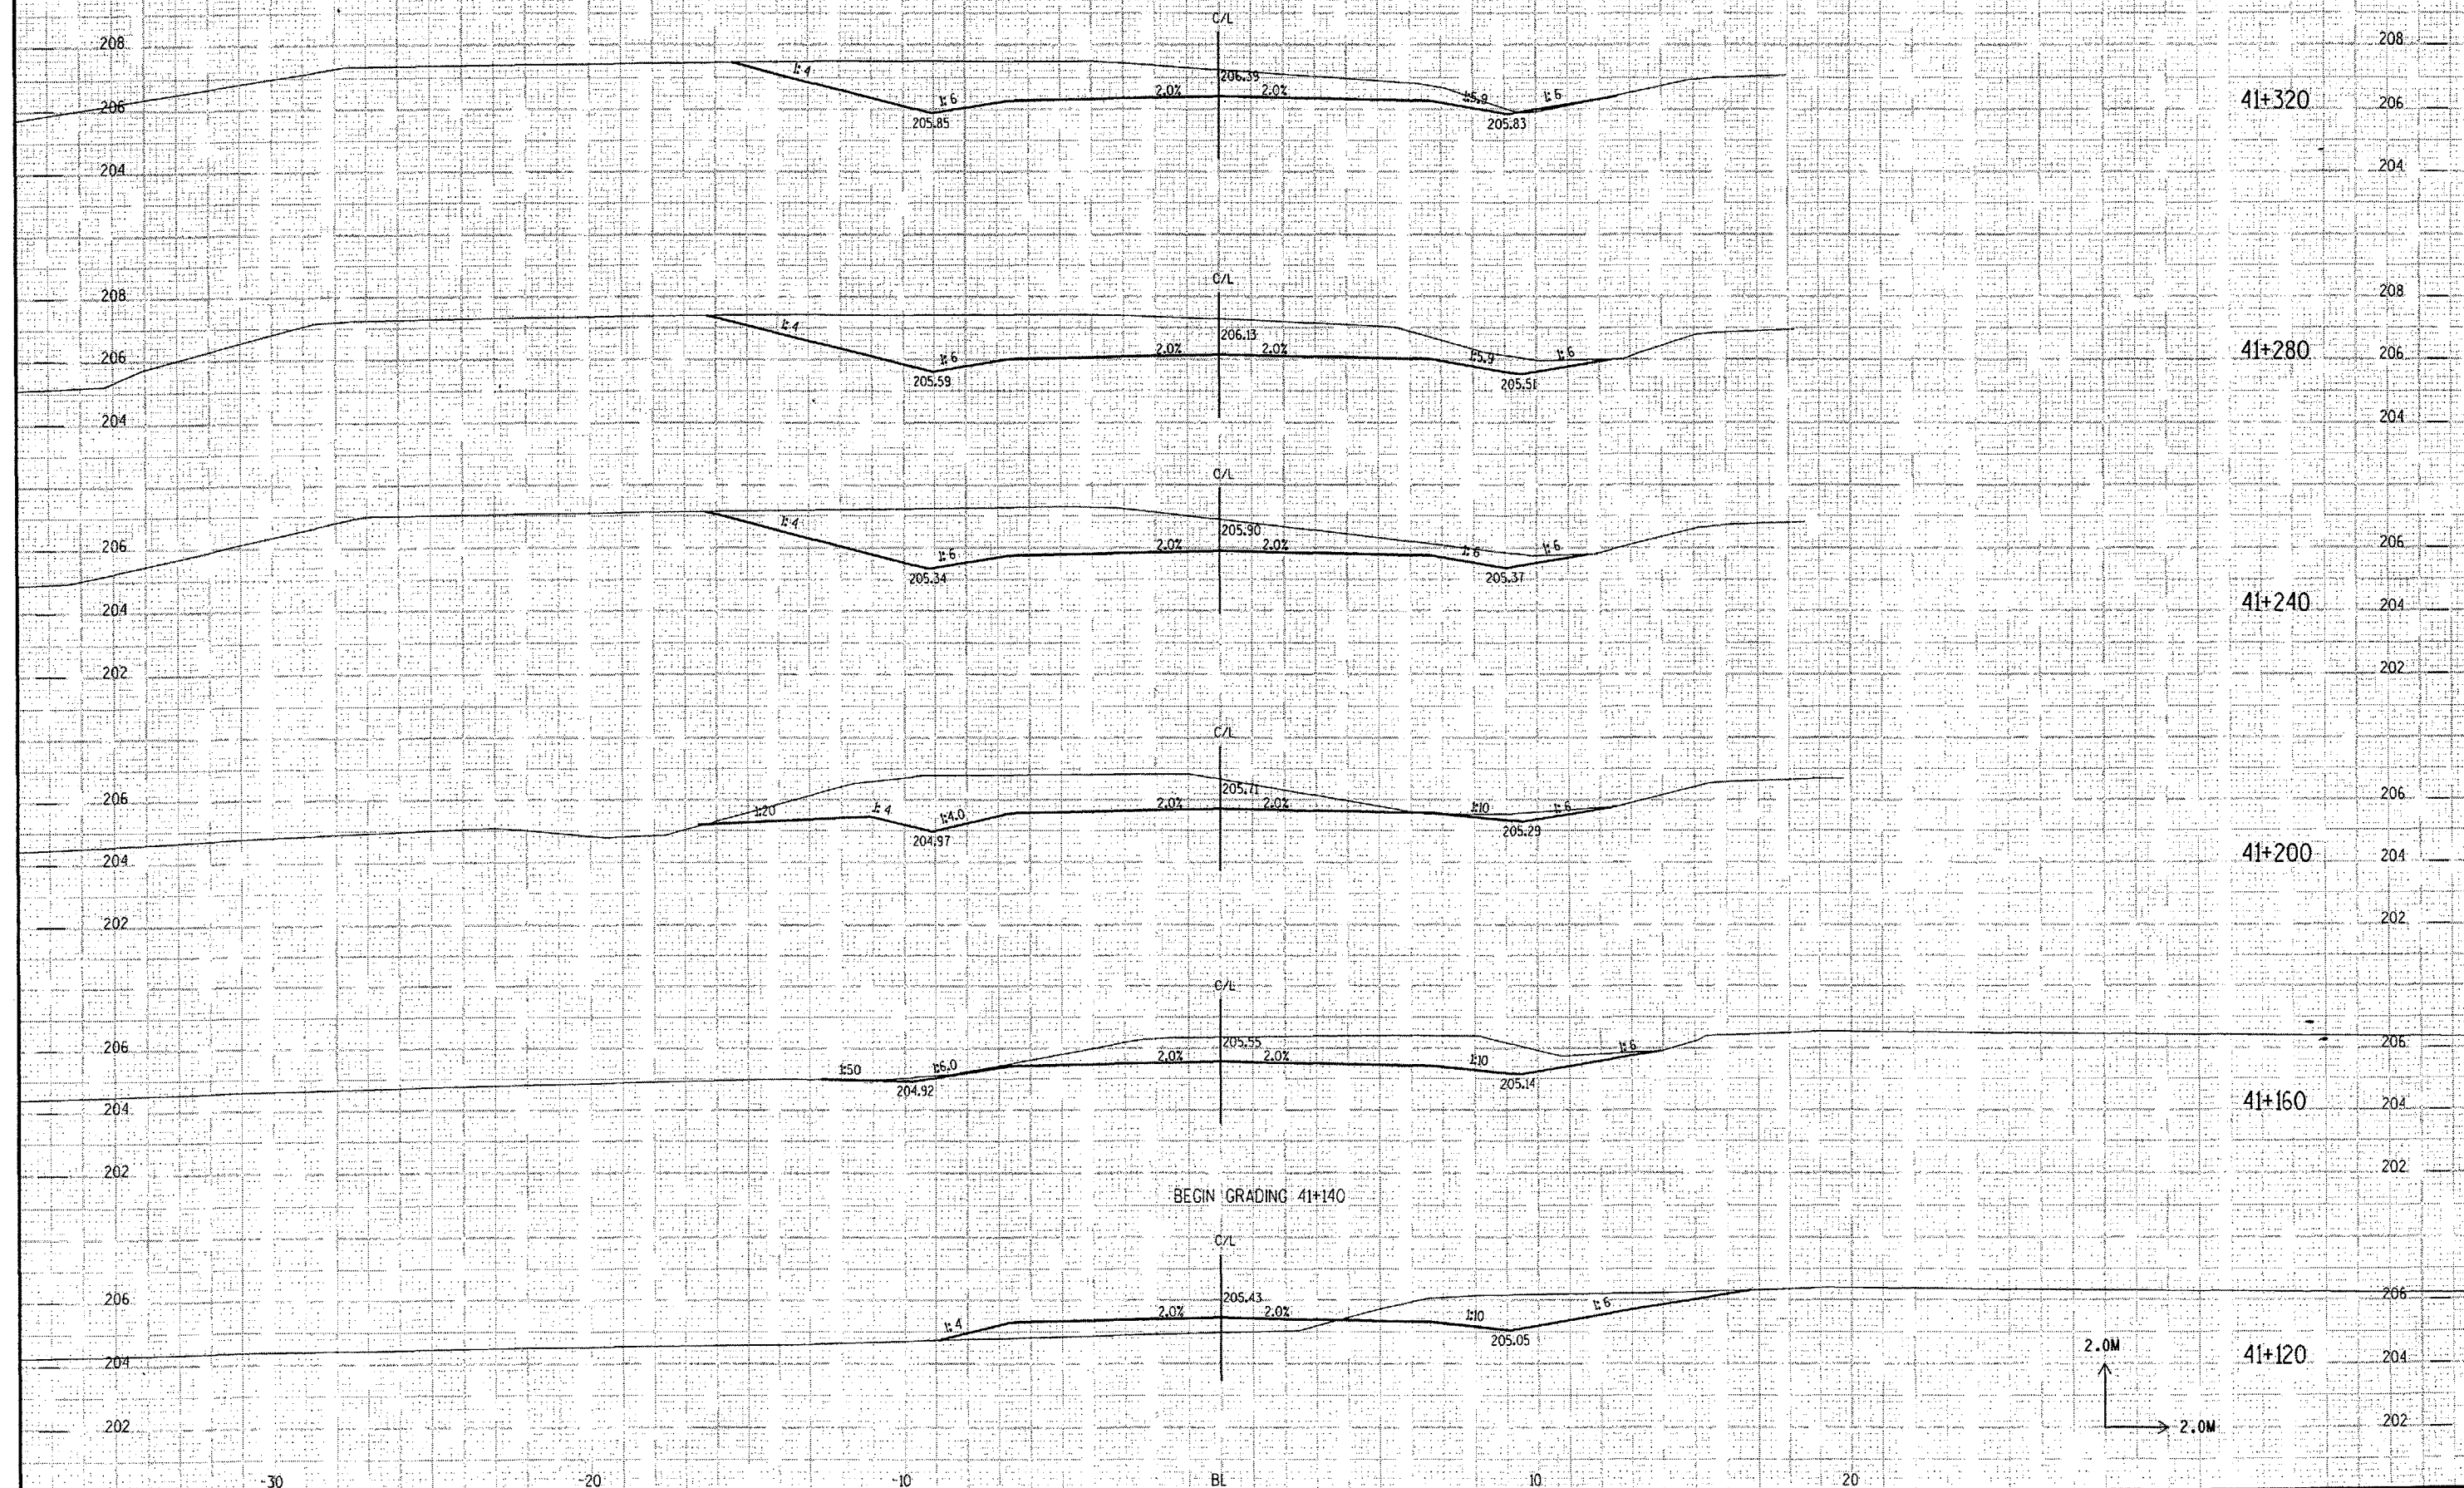

2.0M
2.0M

WEST FRONTAGE ROAD

HWY: USH 41


COUNTY: BROWN

STATE PROJECT NO: 1131-08-82

SHEET NO: 9.12

M

\\cs\pro\10/20/1999 6:06:12 AM C:\USERS\p\p\110882\WFR3\wfr4.sgn

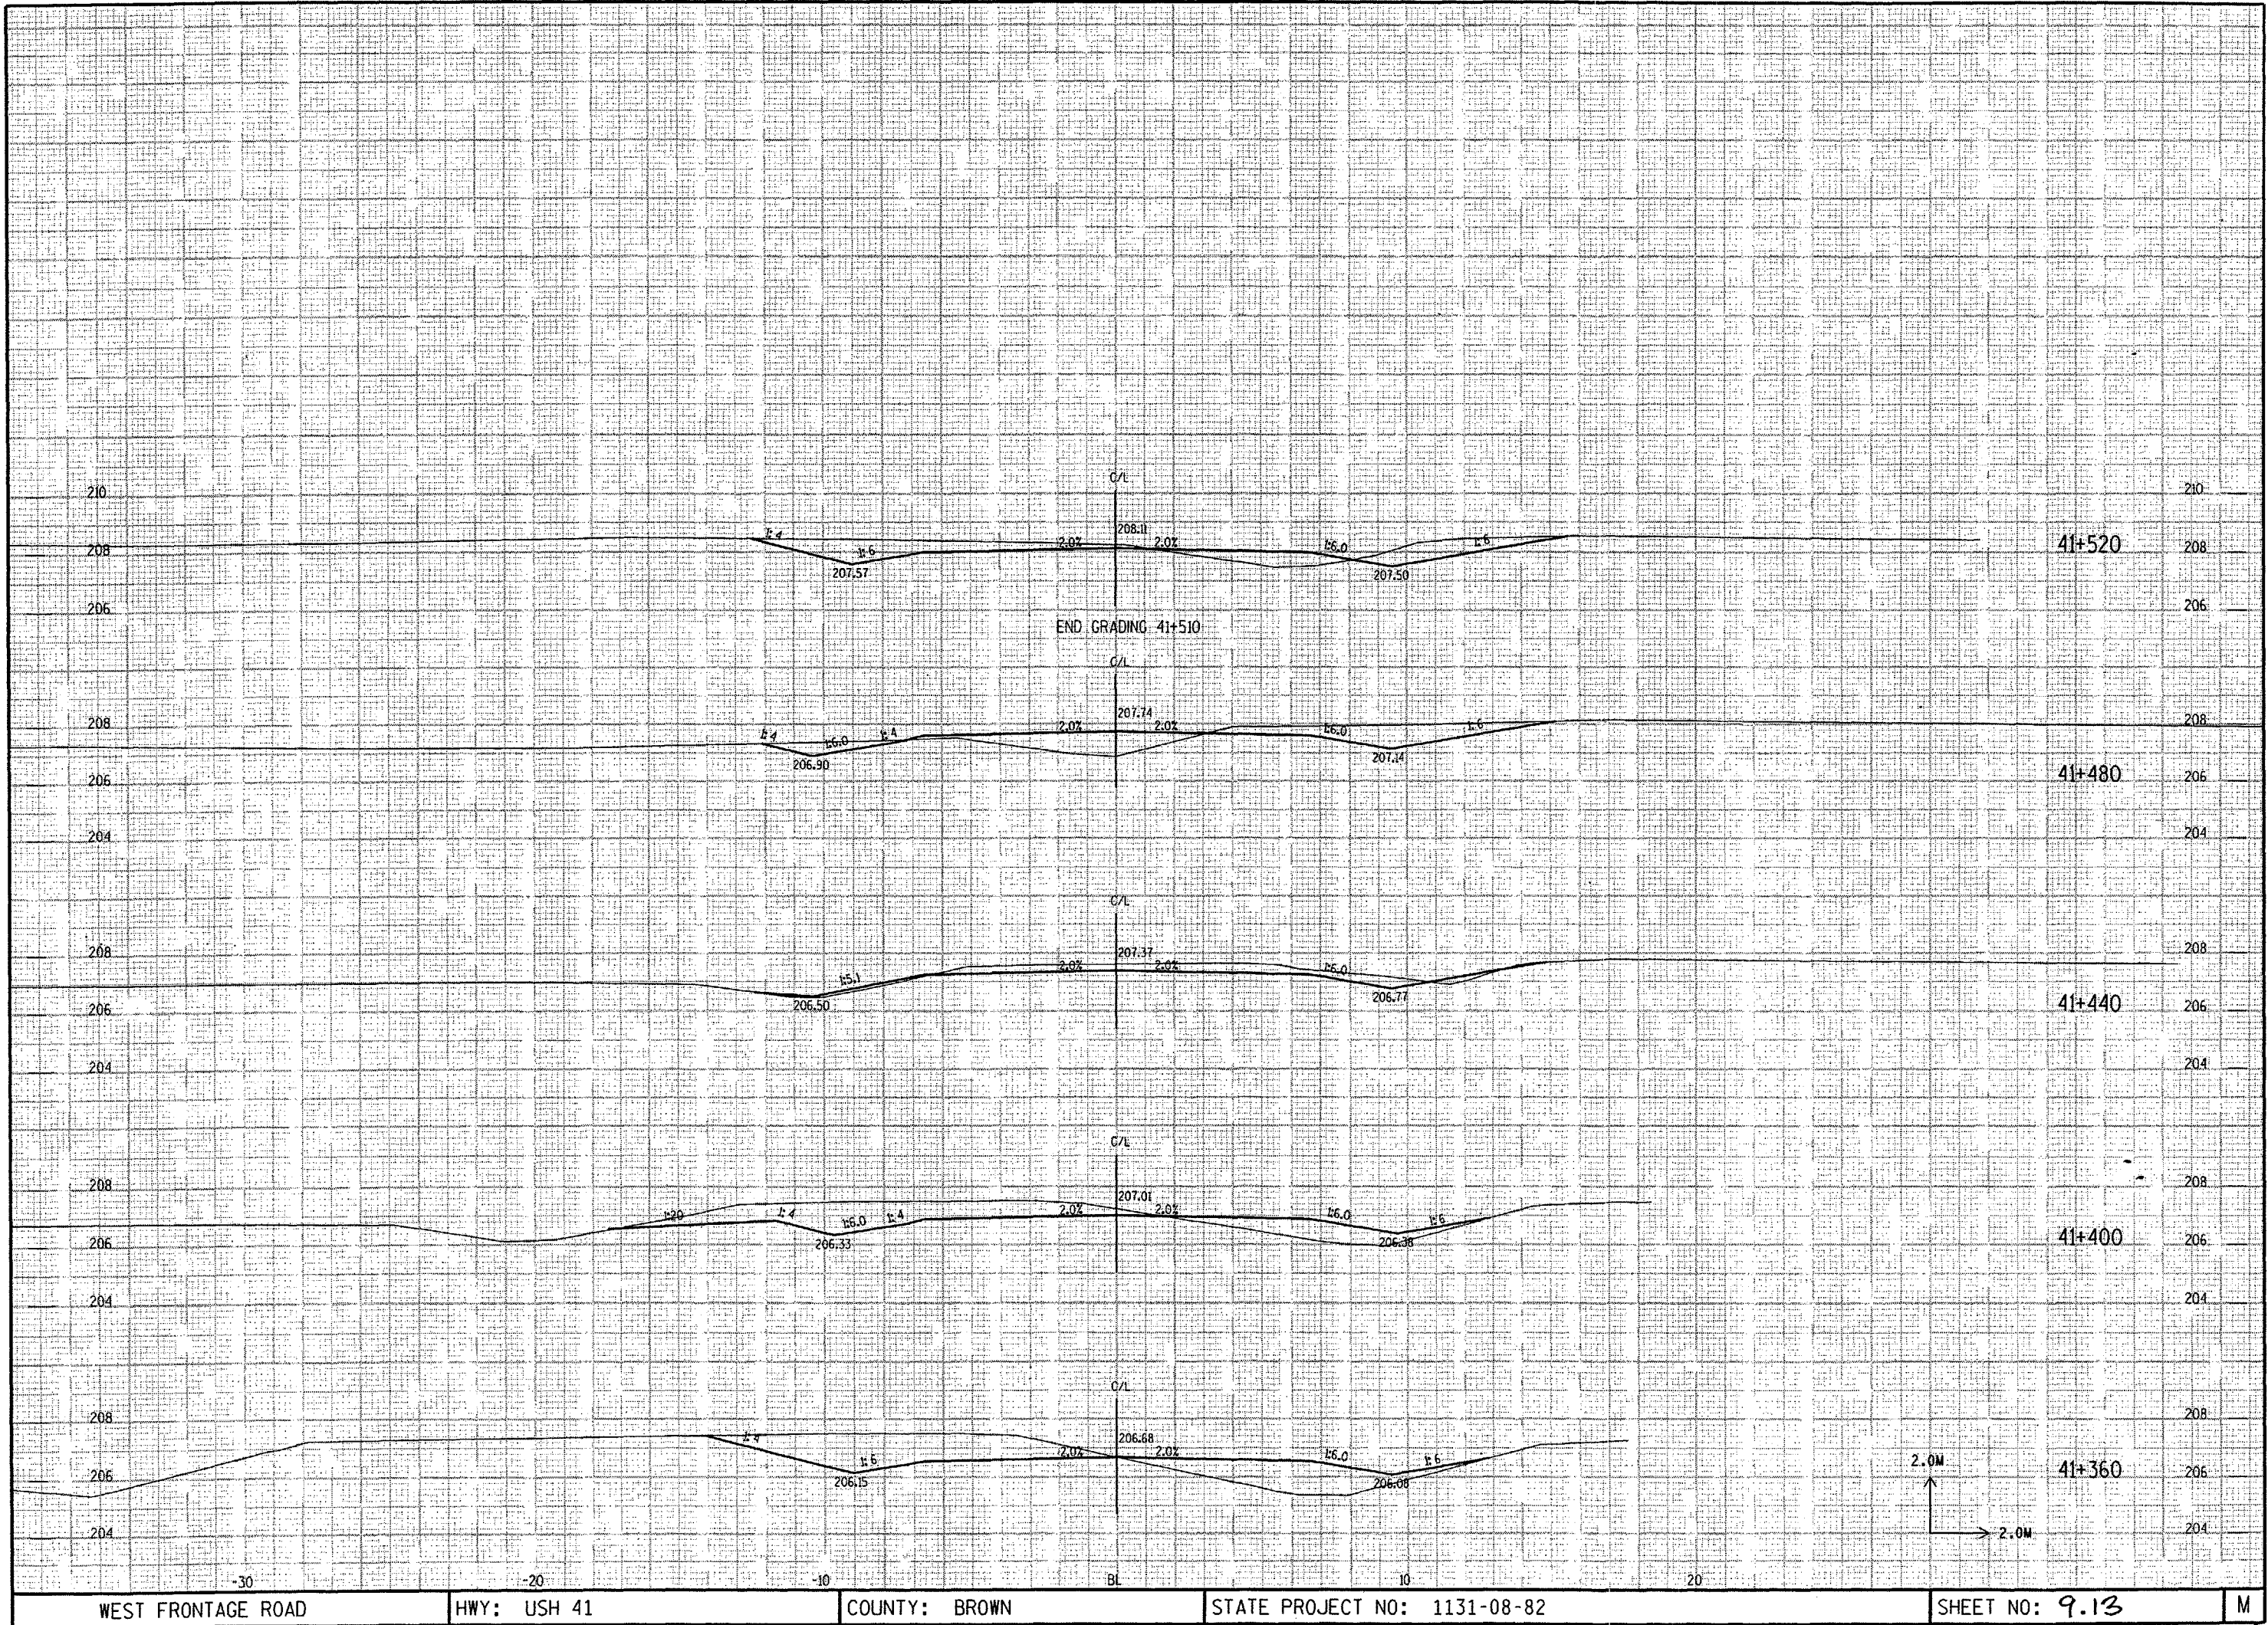

WEST FRONTAGE ROAD

HWY: USH 41


COUNTY: BROWN

STATE PROJECT NO: 1131-08-82

SHEET NO: 9.13

M

C:\CS Thu 10/20/1999 6:25:57 AM C:\USERS\Pd3\efr\frh\us.dgn

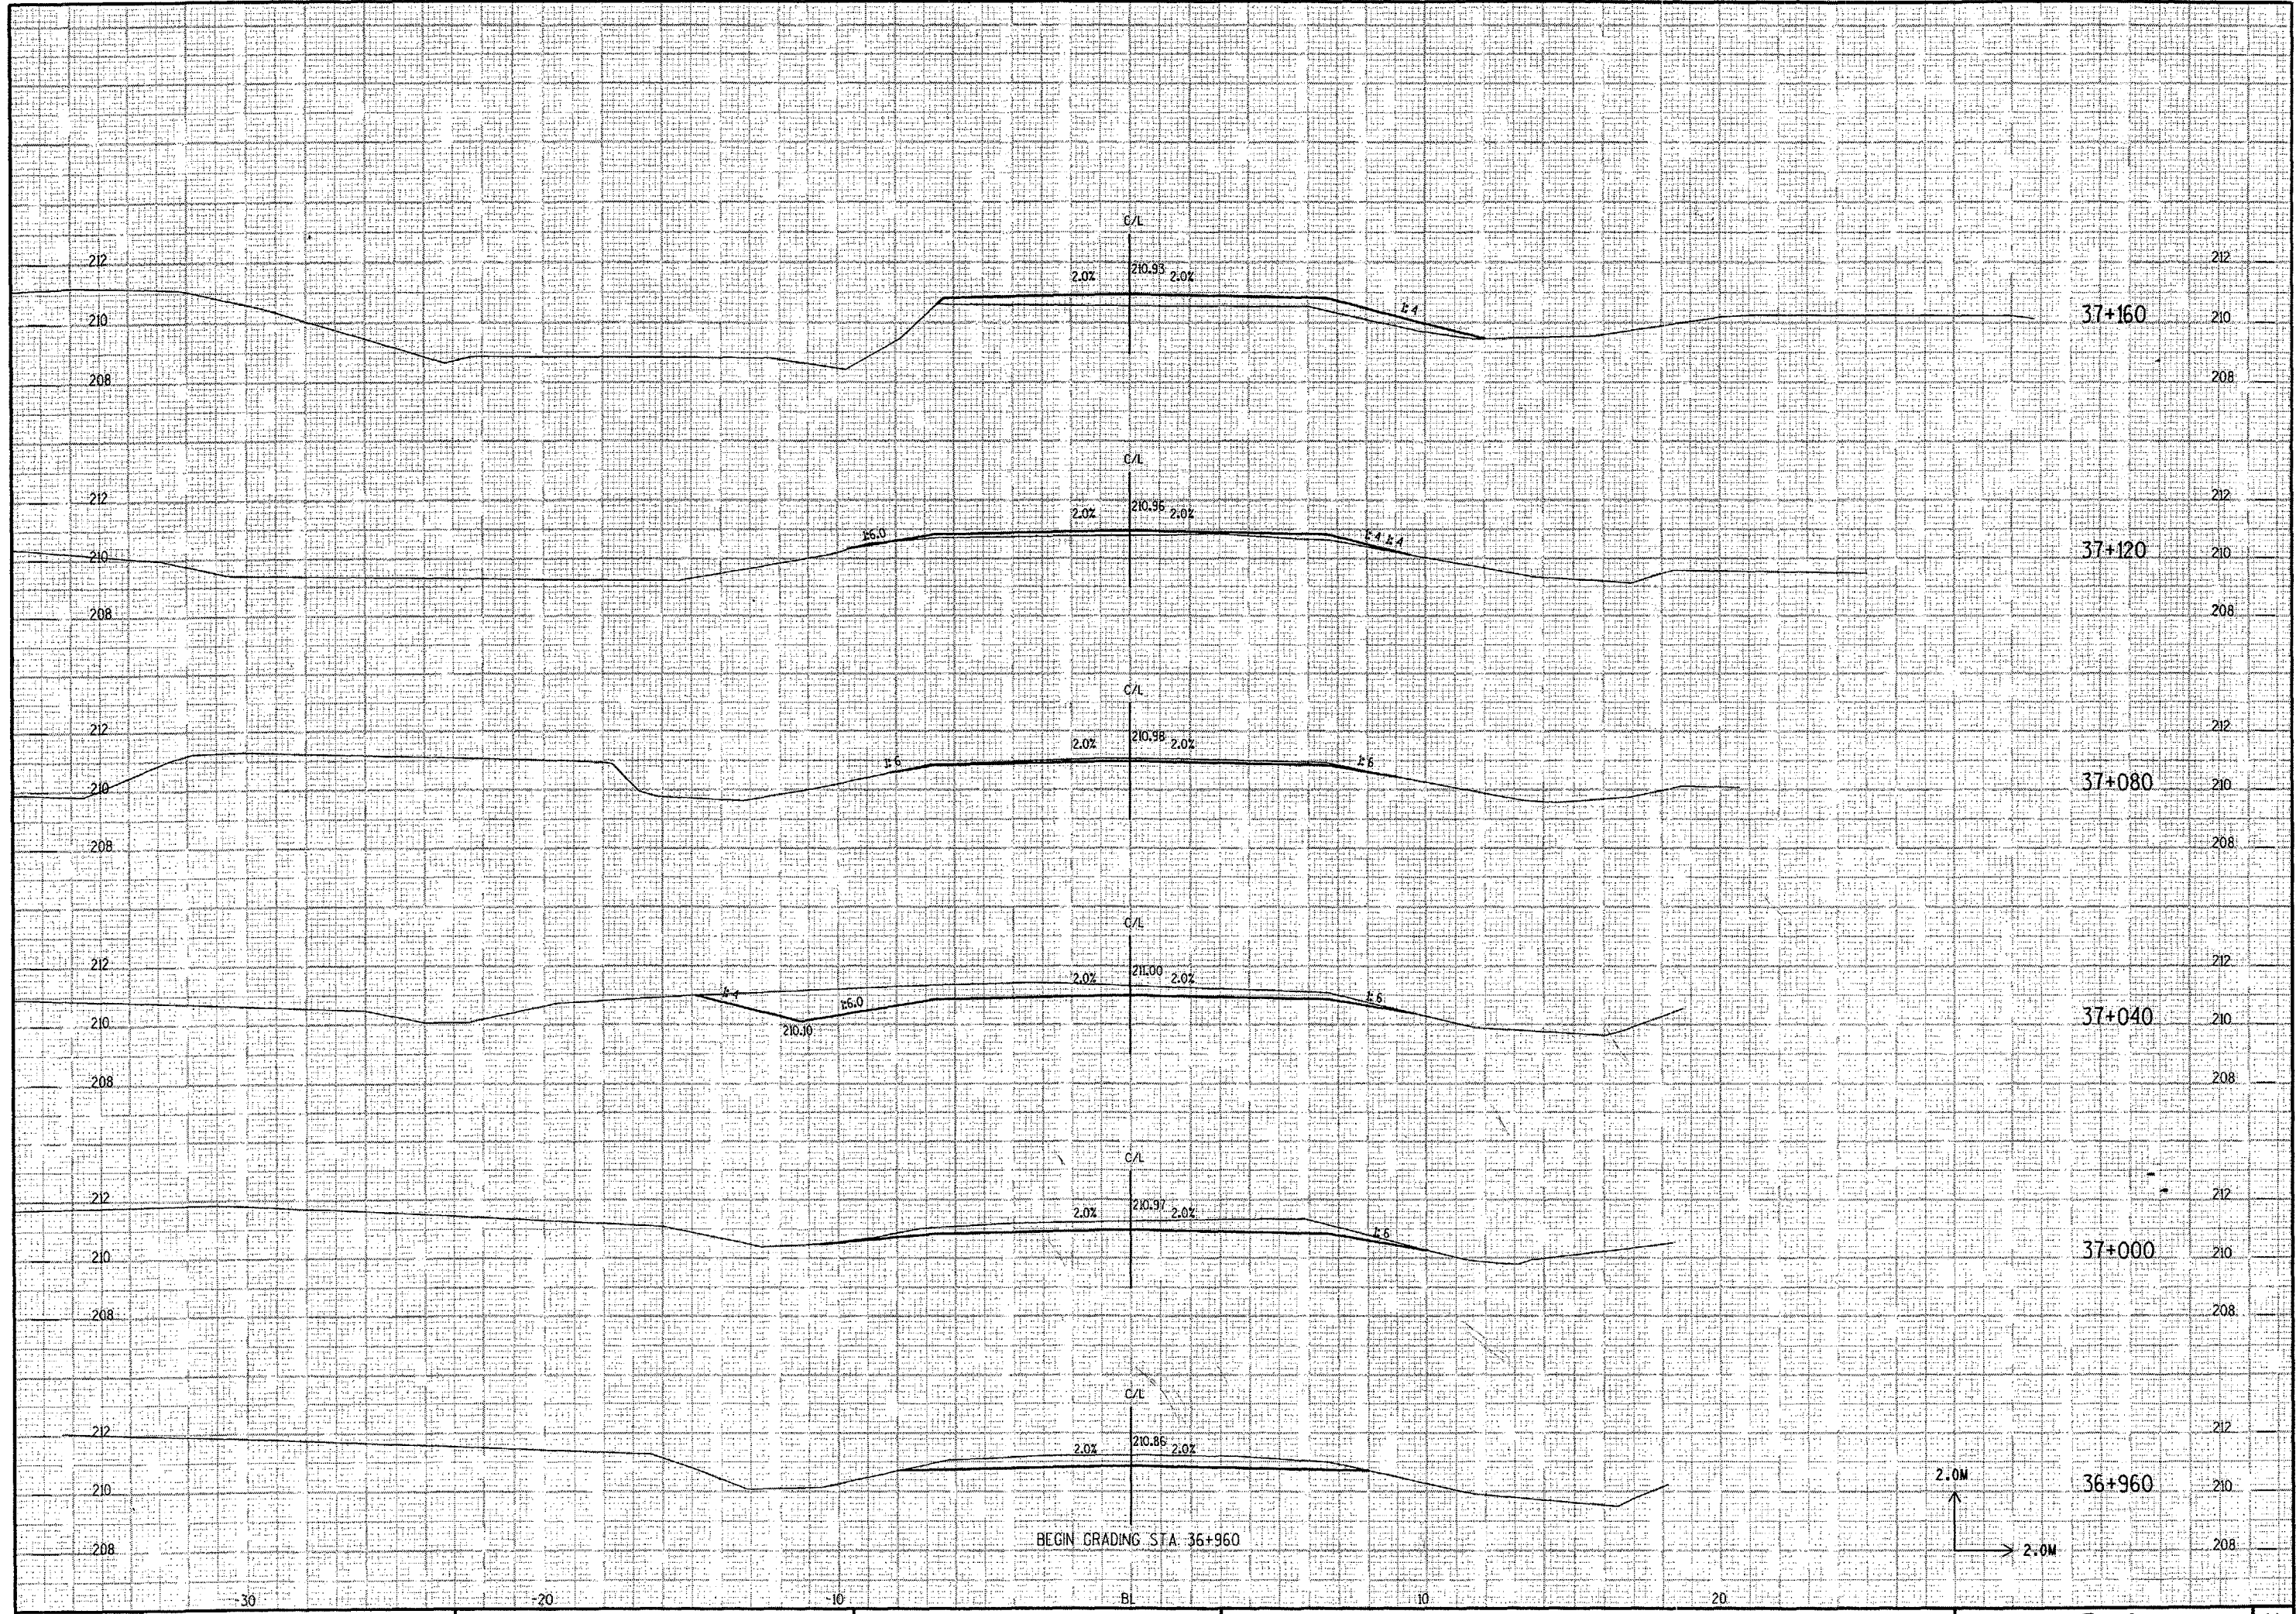

EAST FRONTAGE ROAD

HWY: USH 41


COUNTY: OUTAGAMIE

STATE PROJECT NO: 1131-08-82

SHEET NO: 9.14

M

C:\Users\p3d3\p3d3\p3d3\p3d3.dgn

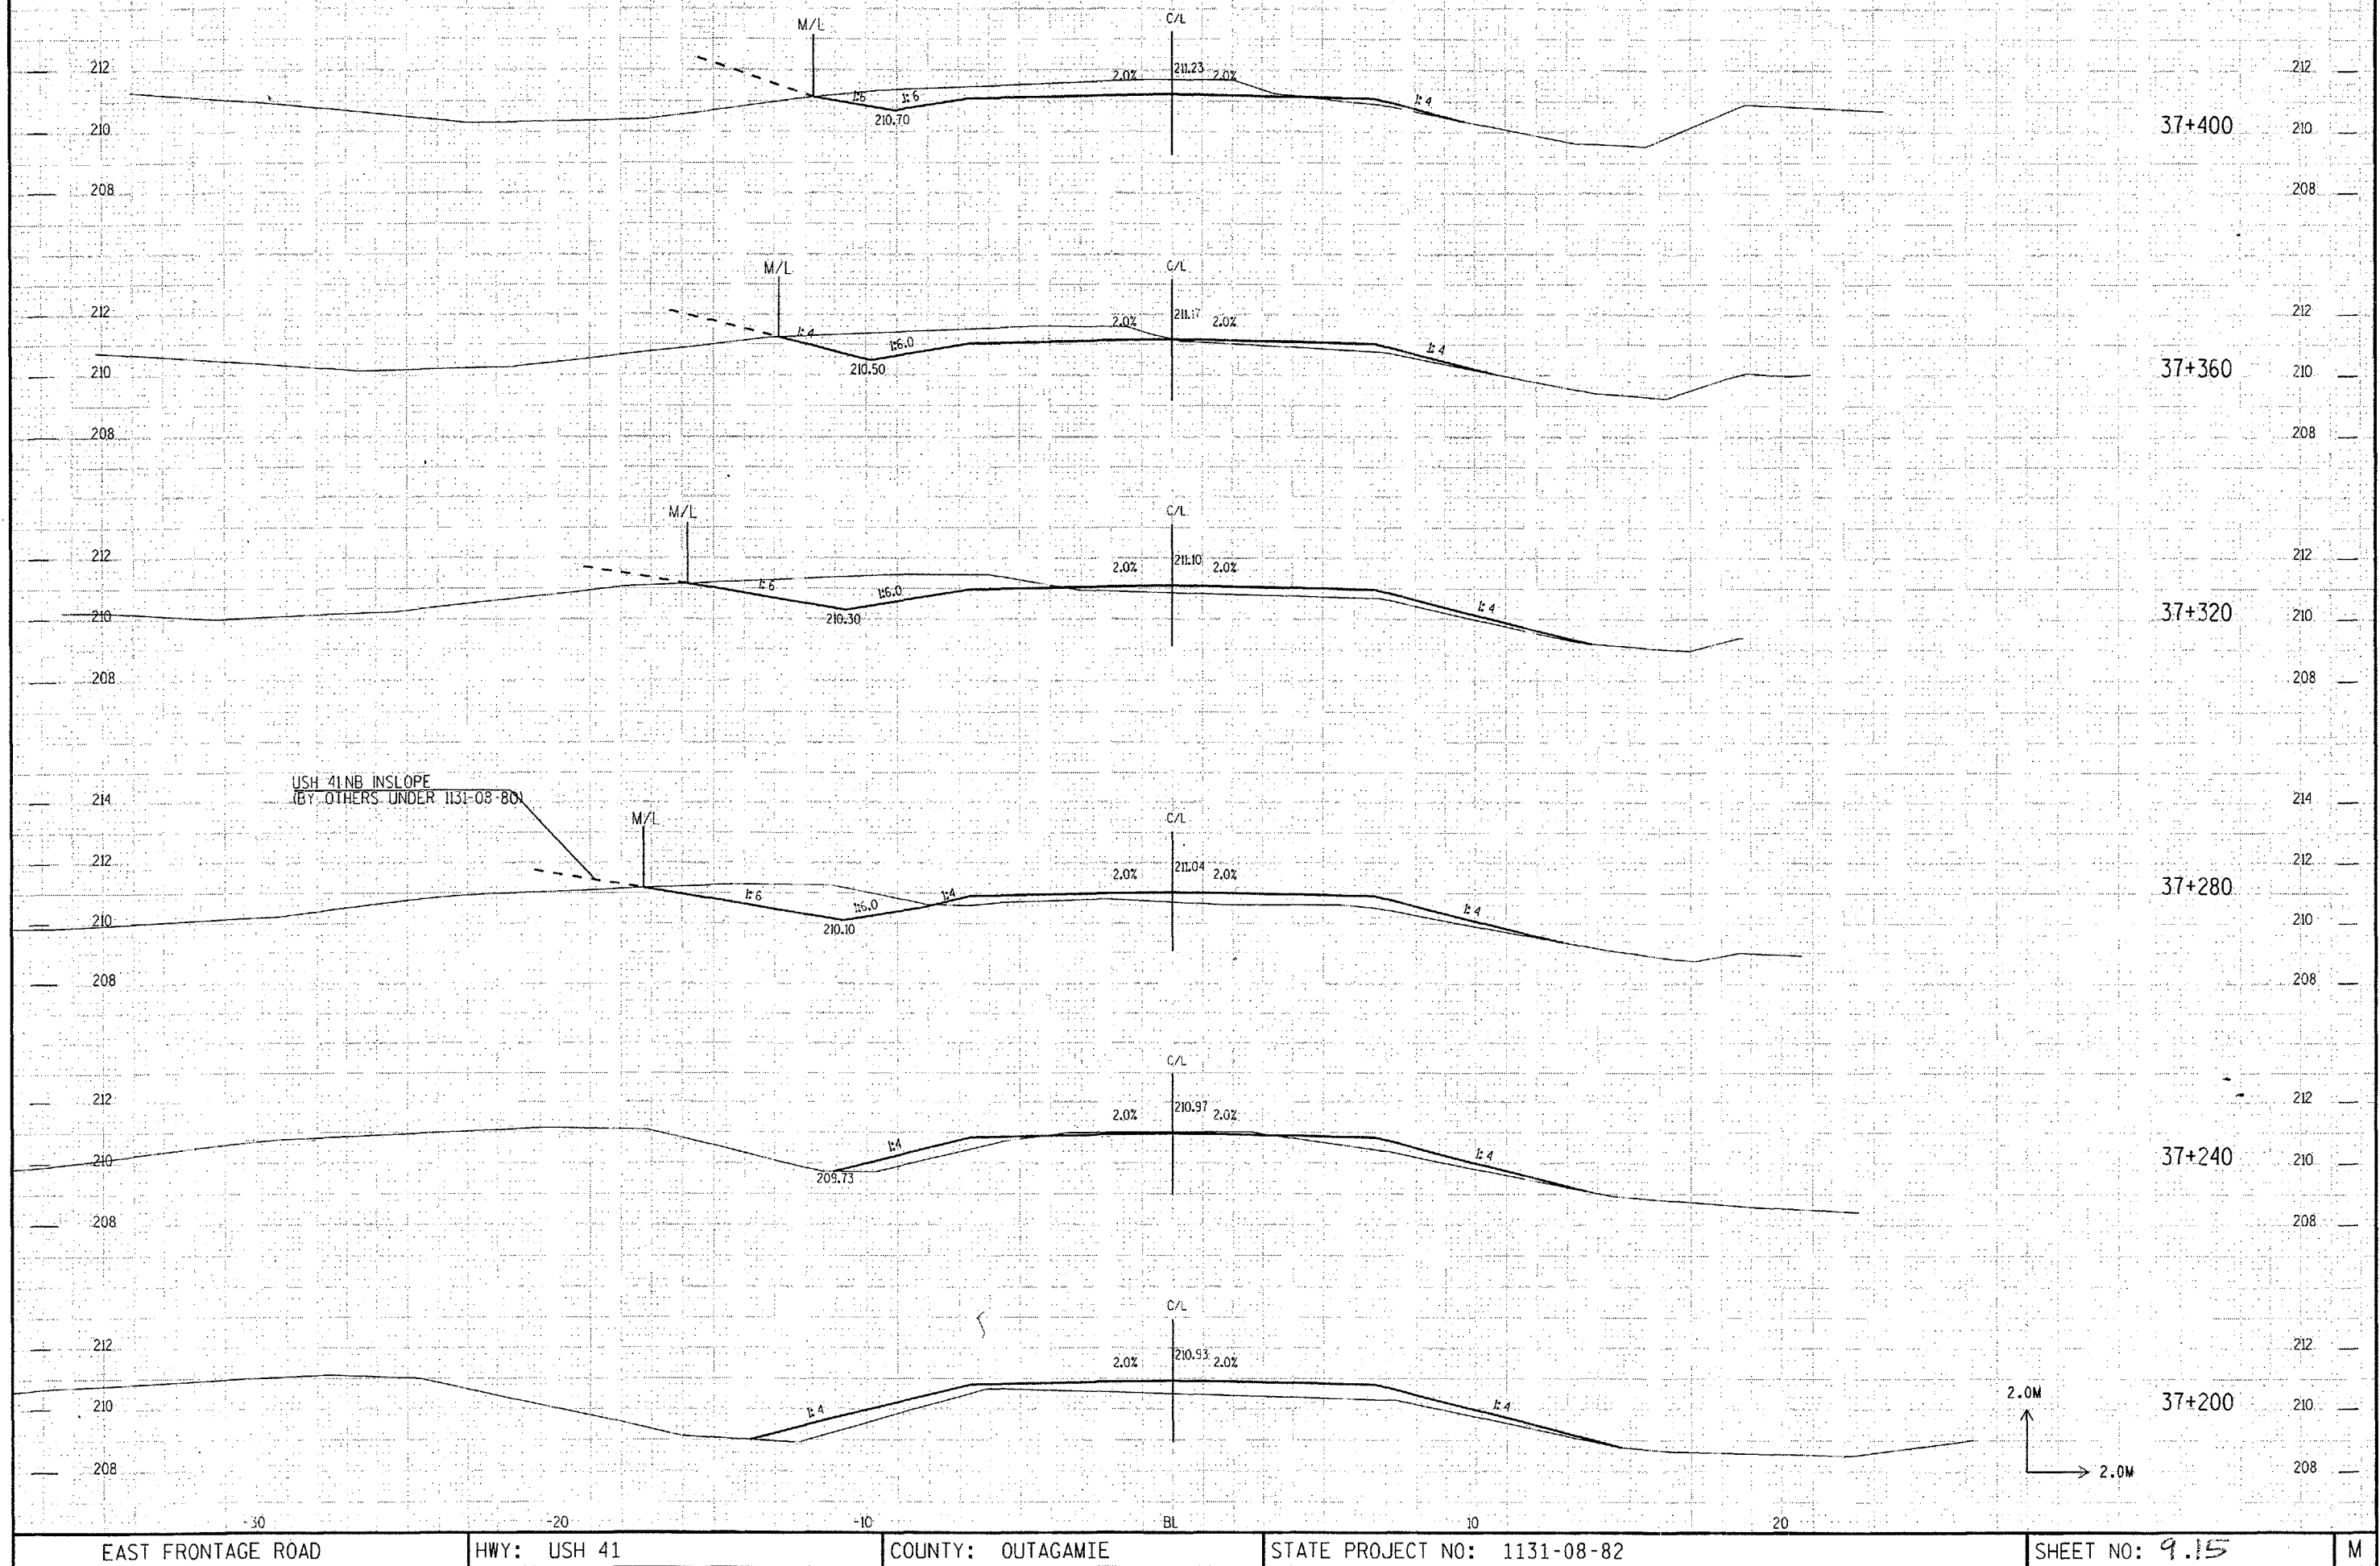

EAST FRONTAGE ROAD

HWY: USH 41


COUNTY: OUTAGAMIE

STATE PROJECT NO: 1131-08-82

SHEET NO: 9.15

M

END GRADING STA 37+660

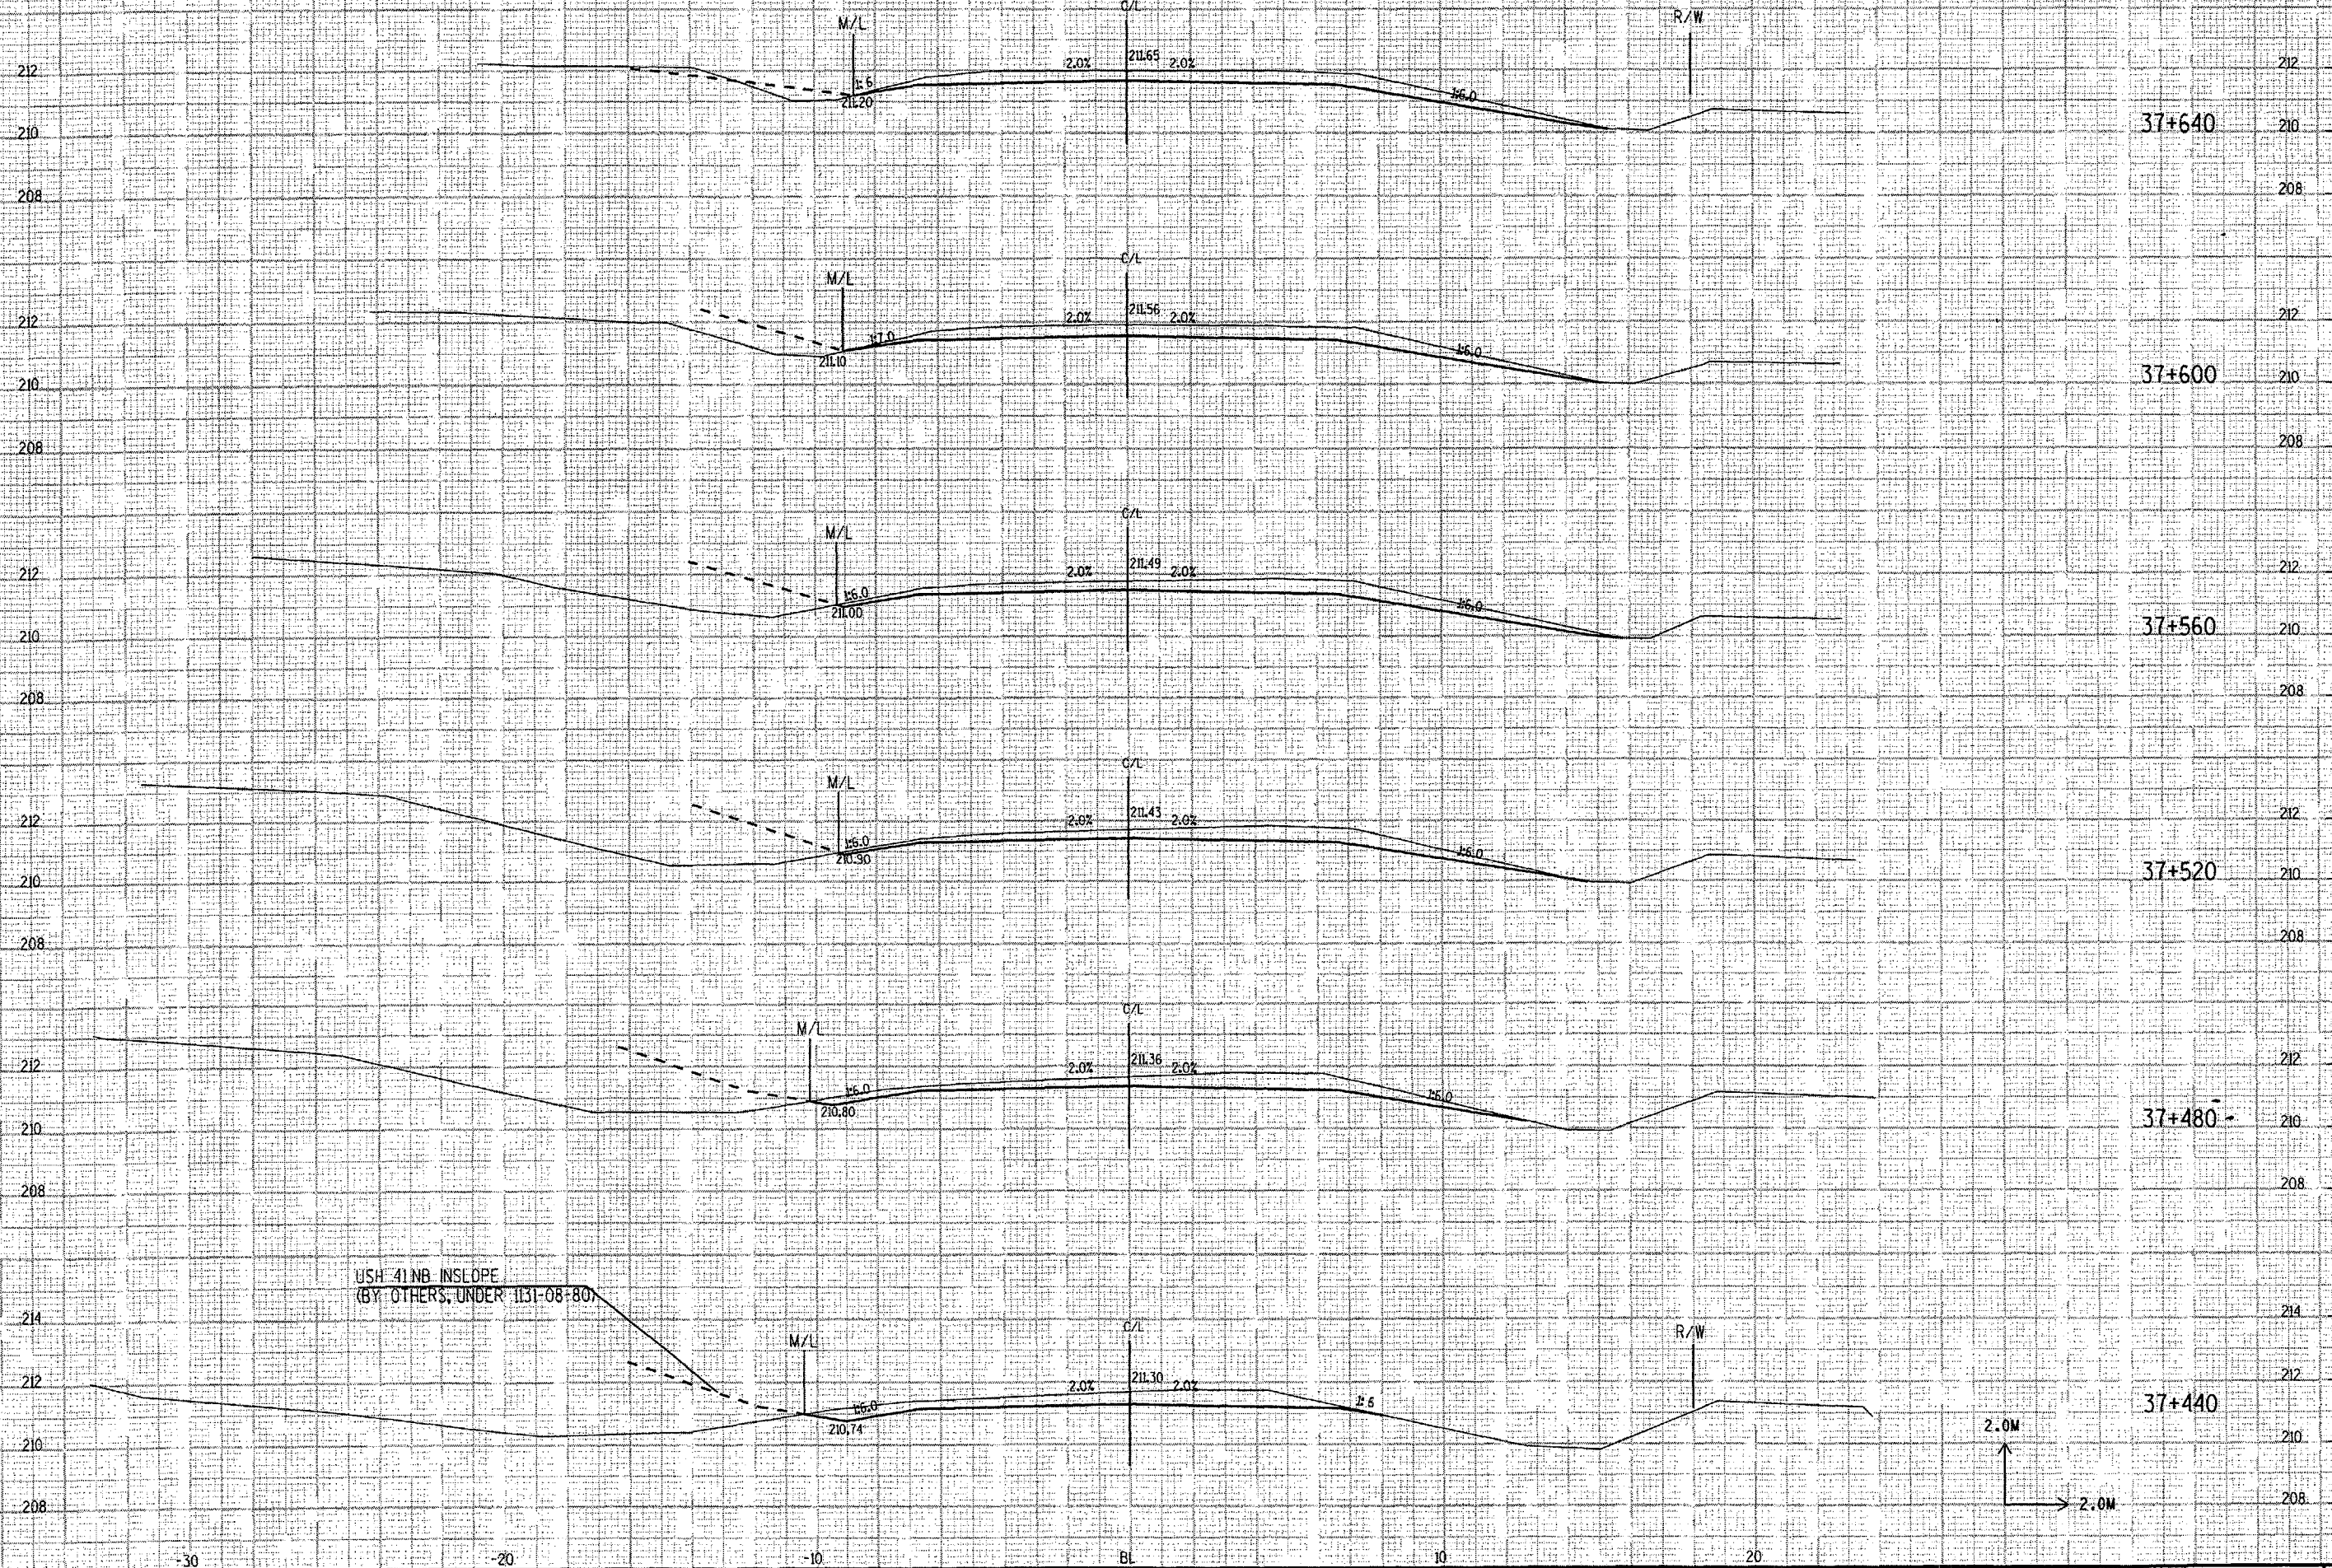

USH 41 NB INSLOPE
(BY OTHERS, UNDER 1131-08-80)

EAST FRONTAGE ROAD

HWY:	USH 41
------	--------


COUNTY: OUTAGAMIE

STATE PROJECT NO: 1131-08-82

SHEET NO: 9.16

1

005 Thu 10/28/1999 6:15:44 AM C:\USERS\p\03\11310882\EF2\efr2x.dgn

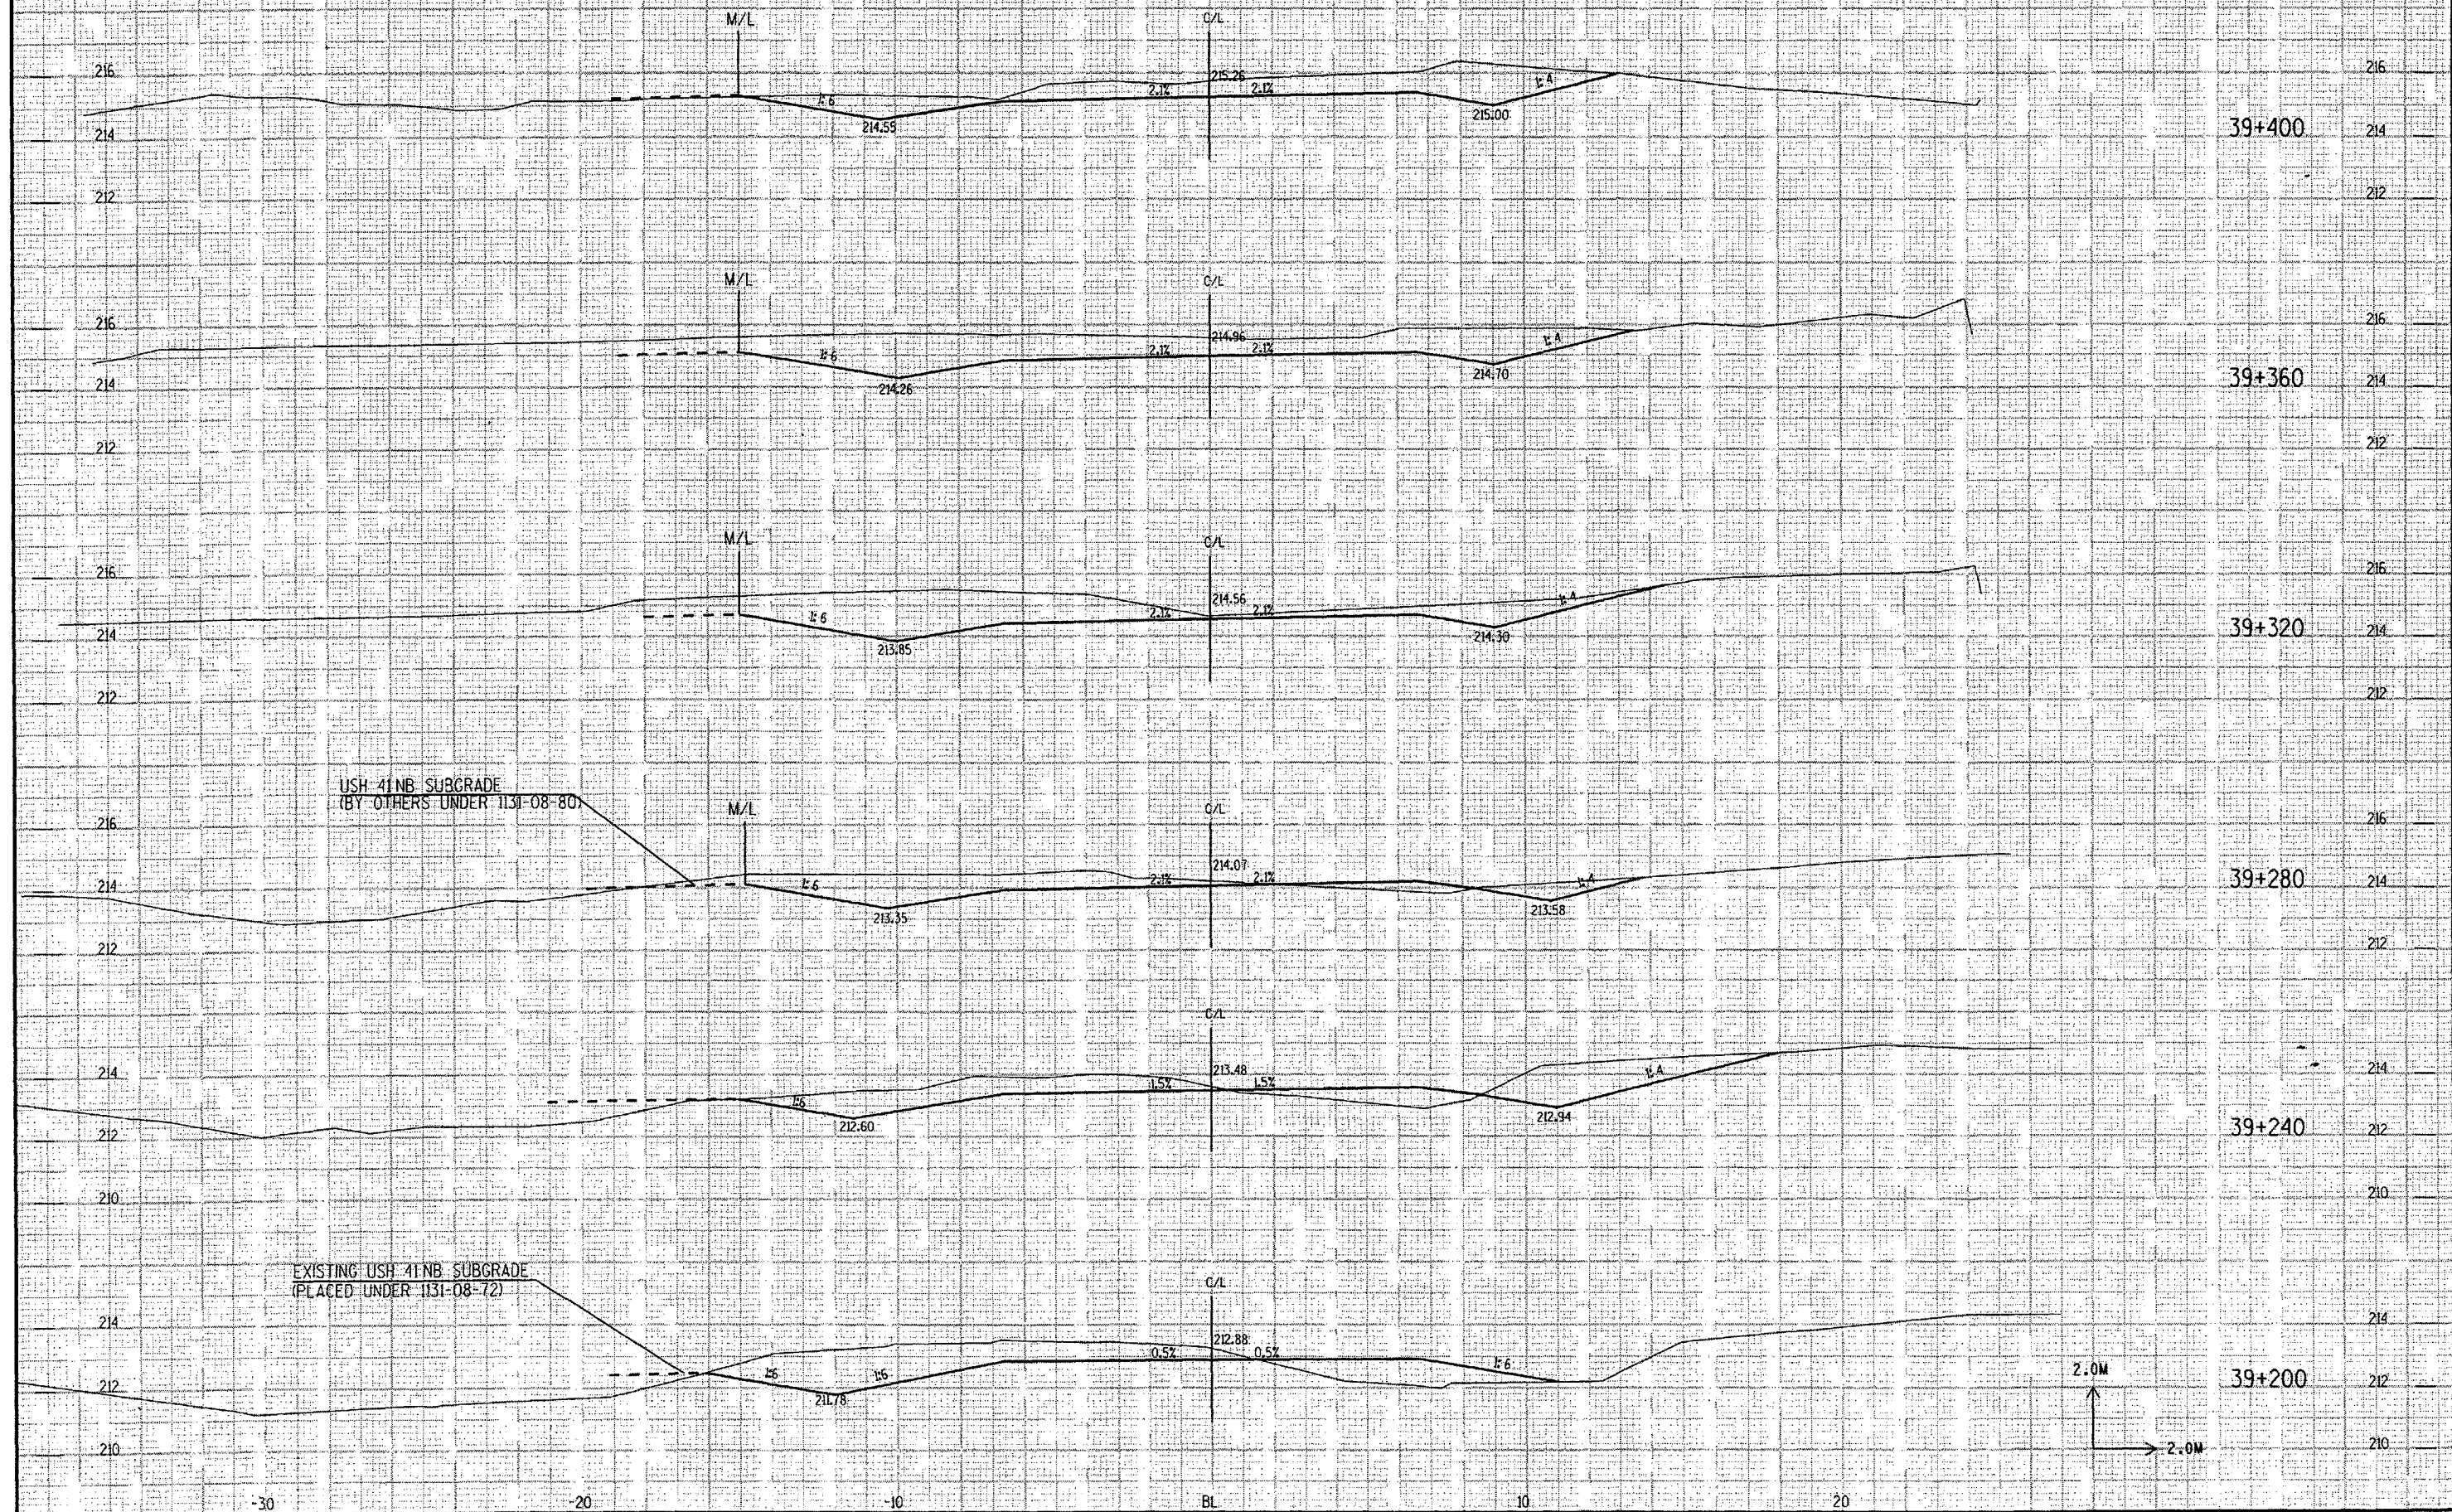

EAST FRONTAGE ROAD

HWY: USH 41

COUNTY: OUTAGAMIE


STATE PROJECT NO: 1131-08-82

SHEET NO: 9.18

M

103

CCS Thu 10/28/1999 6:15:44 AM C:\USERS\p\03\11310802\FR219121.dgn

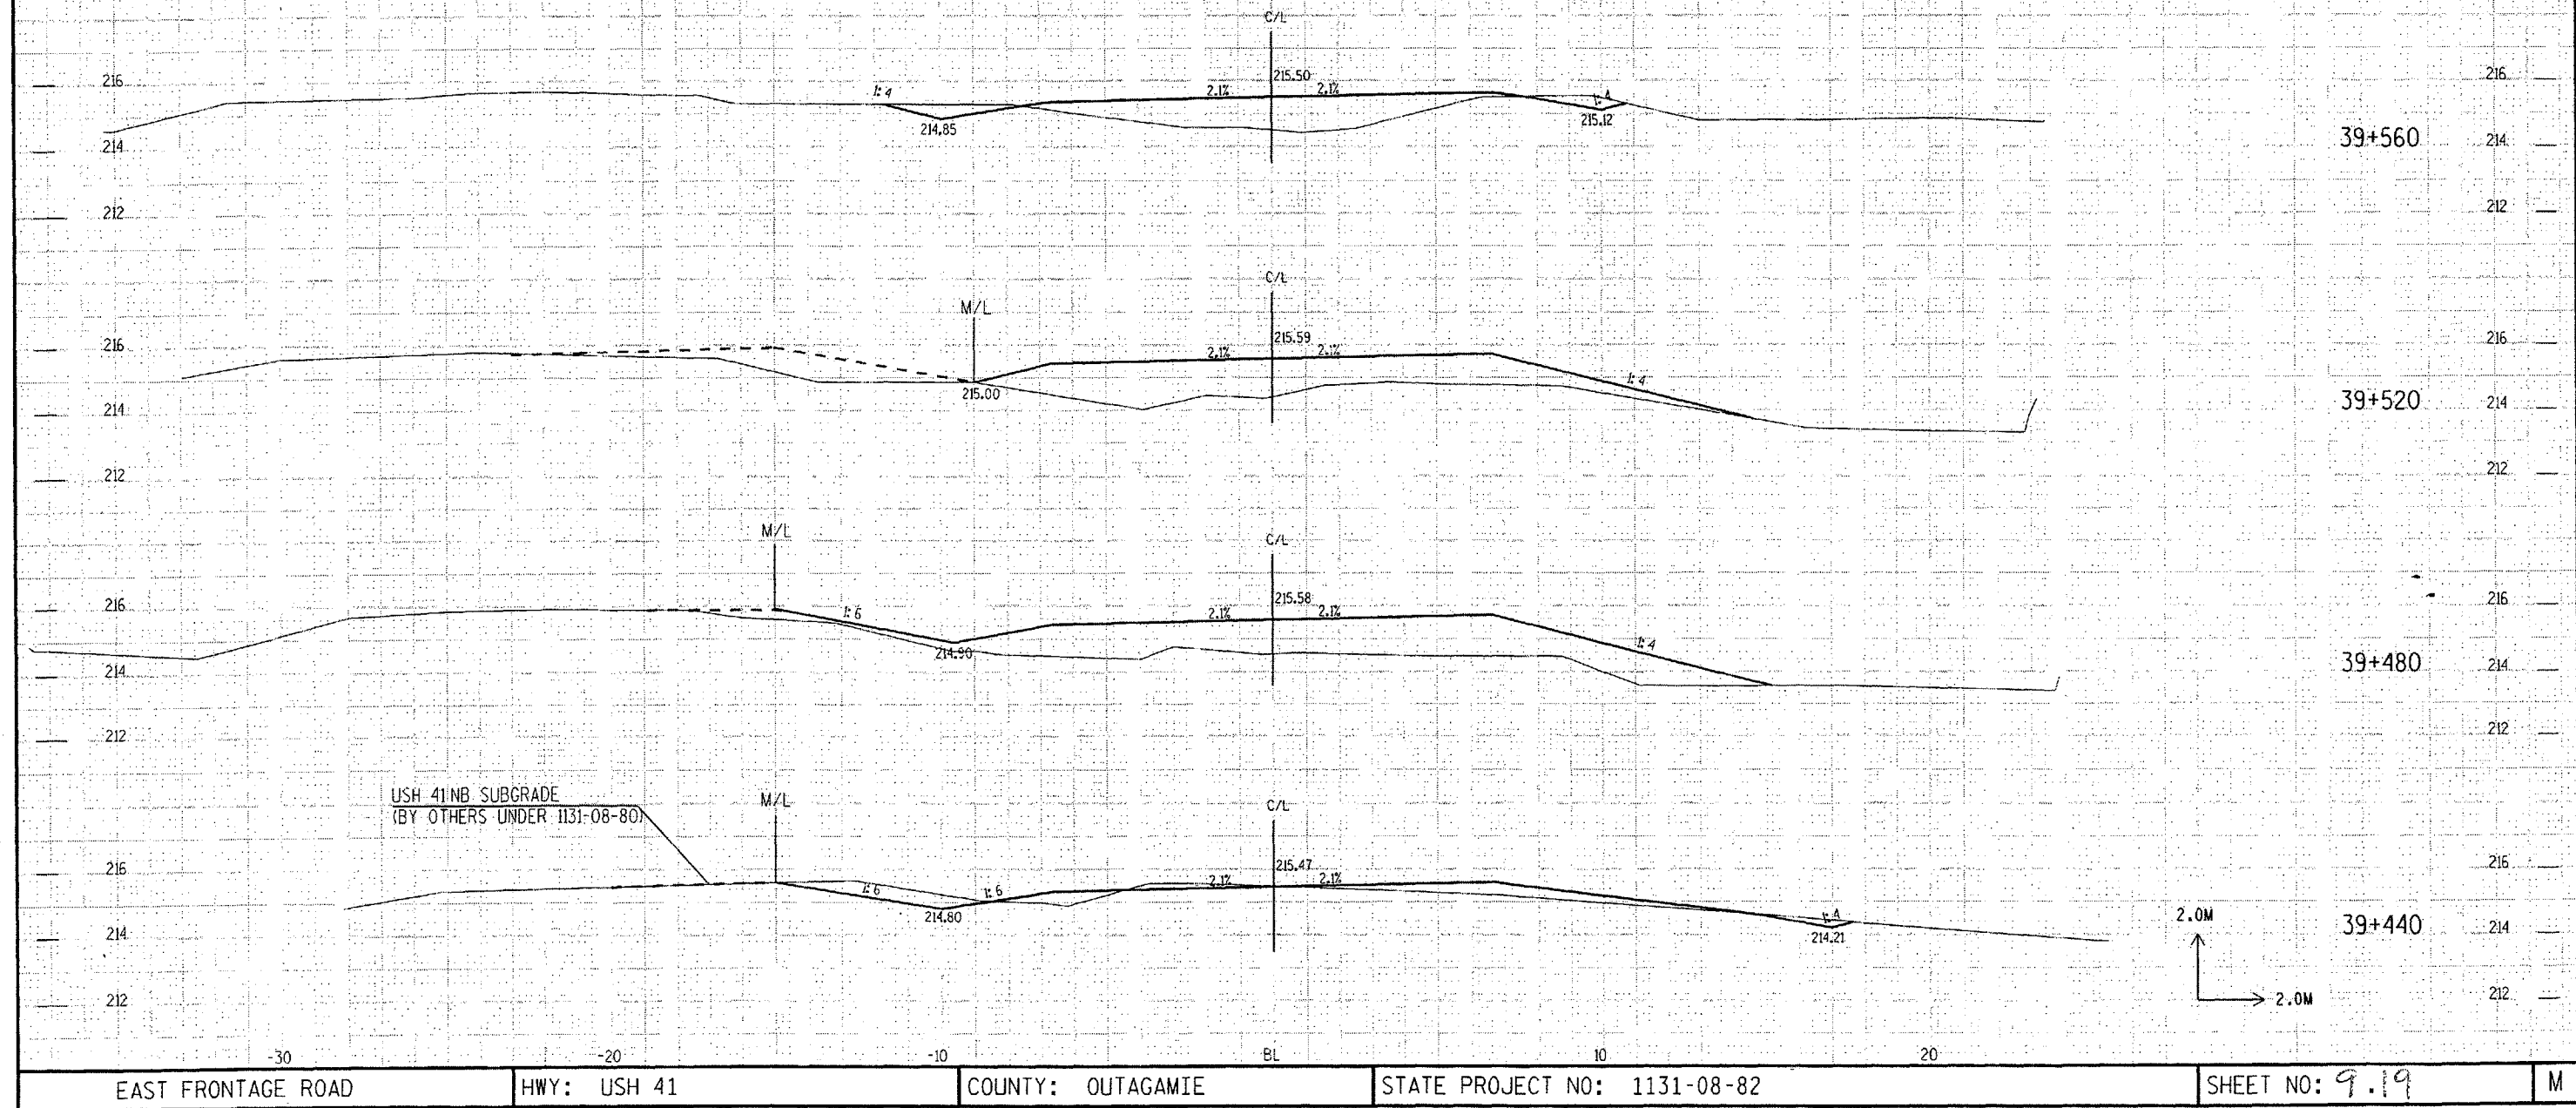

EAST FRONTAGE ROAD

HWY: USH 41


COUNTY: OUTAGAMIE

STATE PROJECT NO: 1131-08-82

SHEET NO: 9.19

M

005 Tue 10/26/99 10:28:17 AM C:\USERS\p.d\1310878\us41\101US41A\trbby\us.dgn

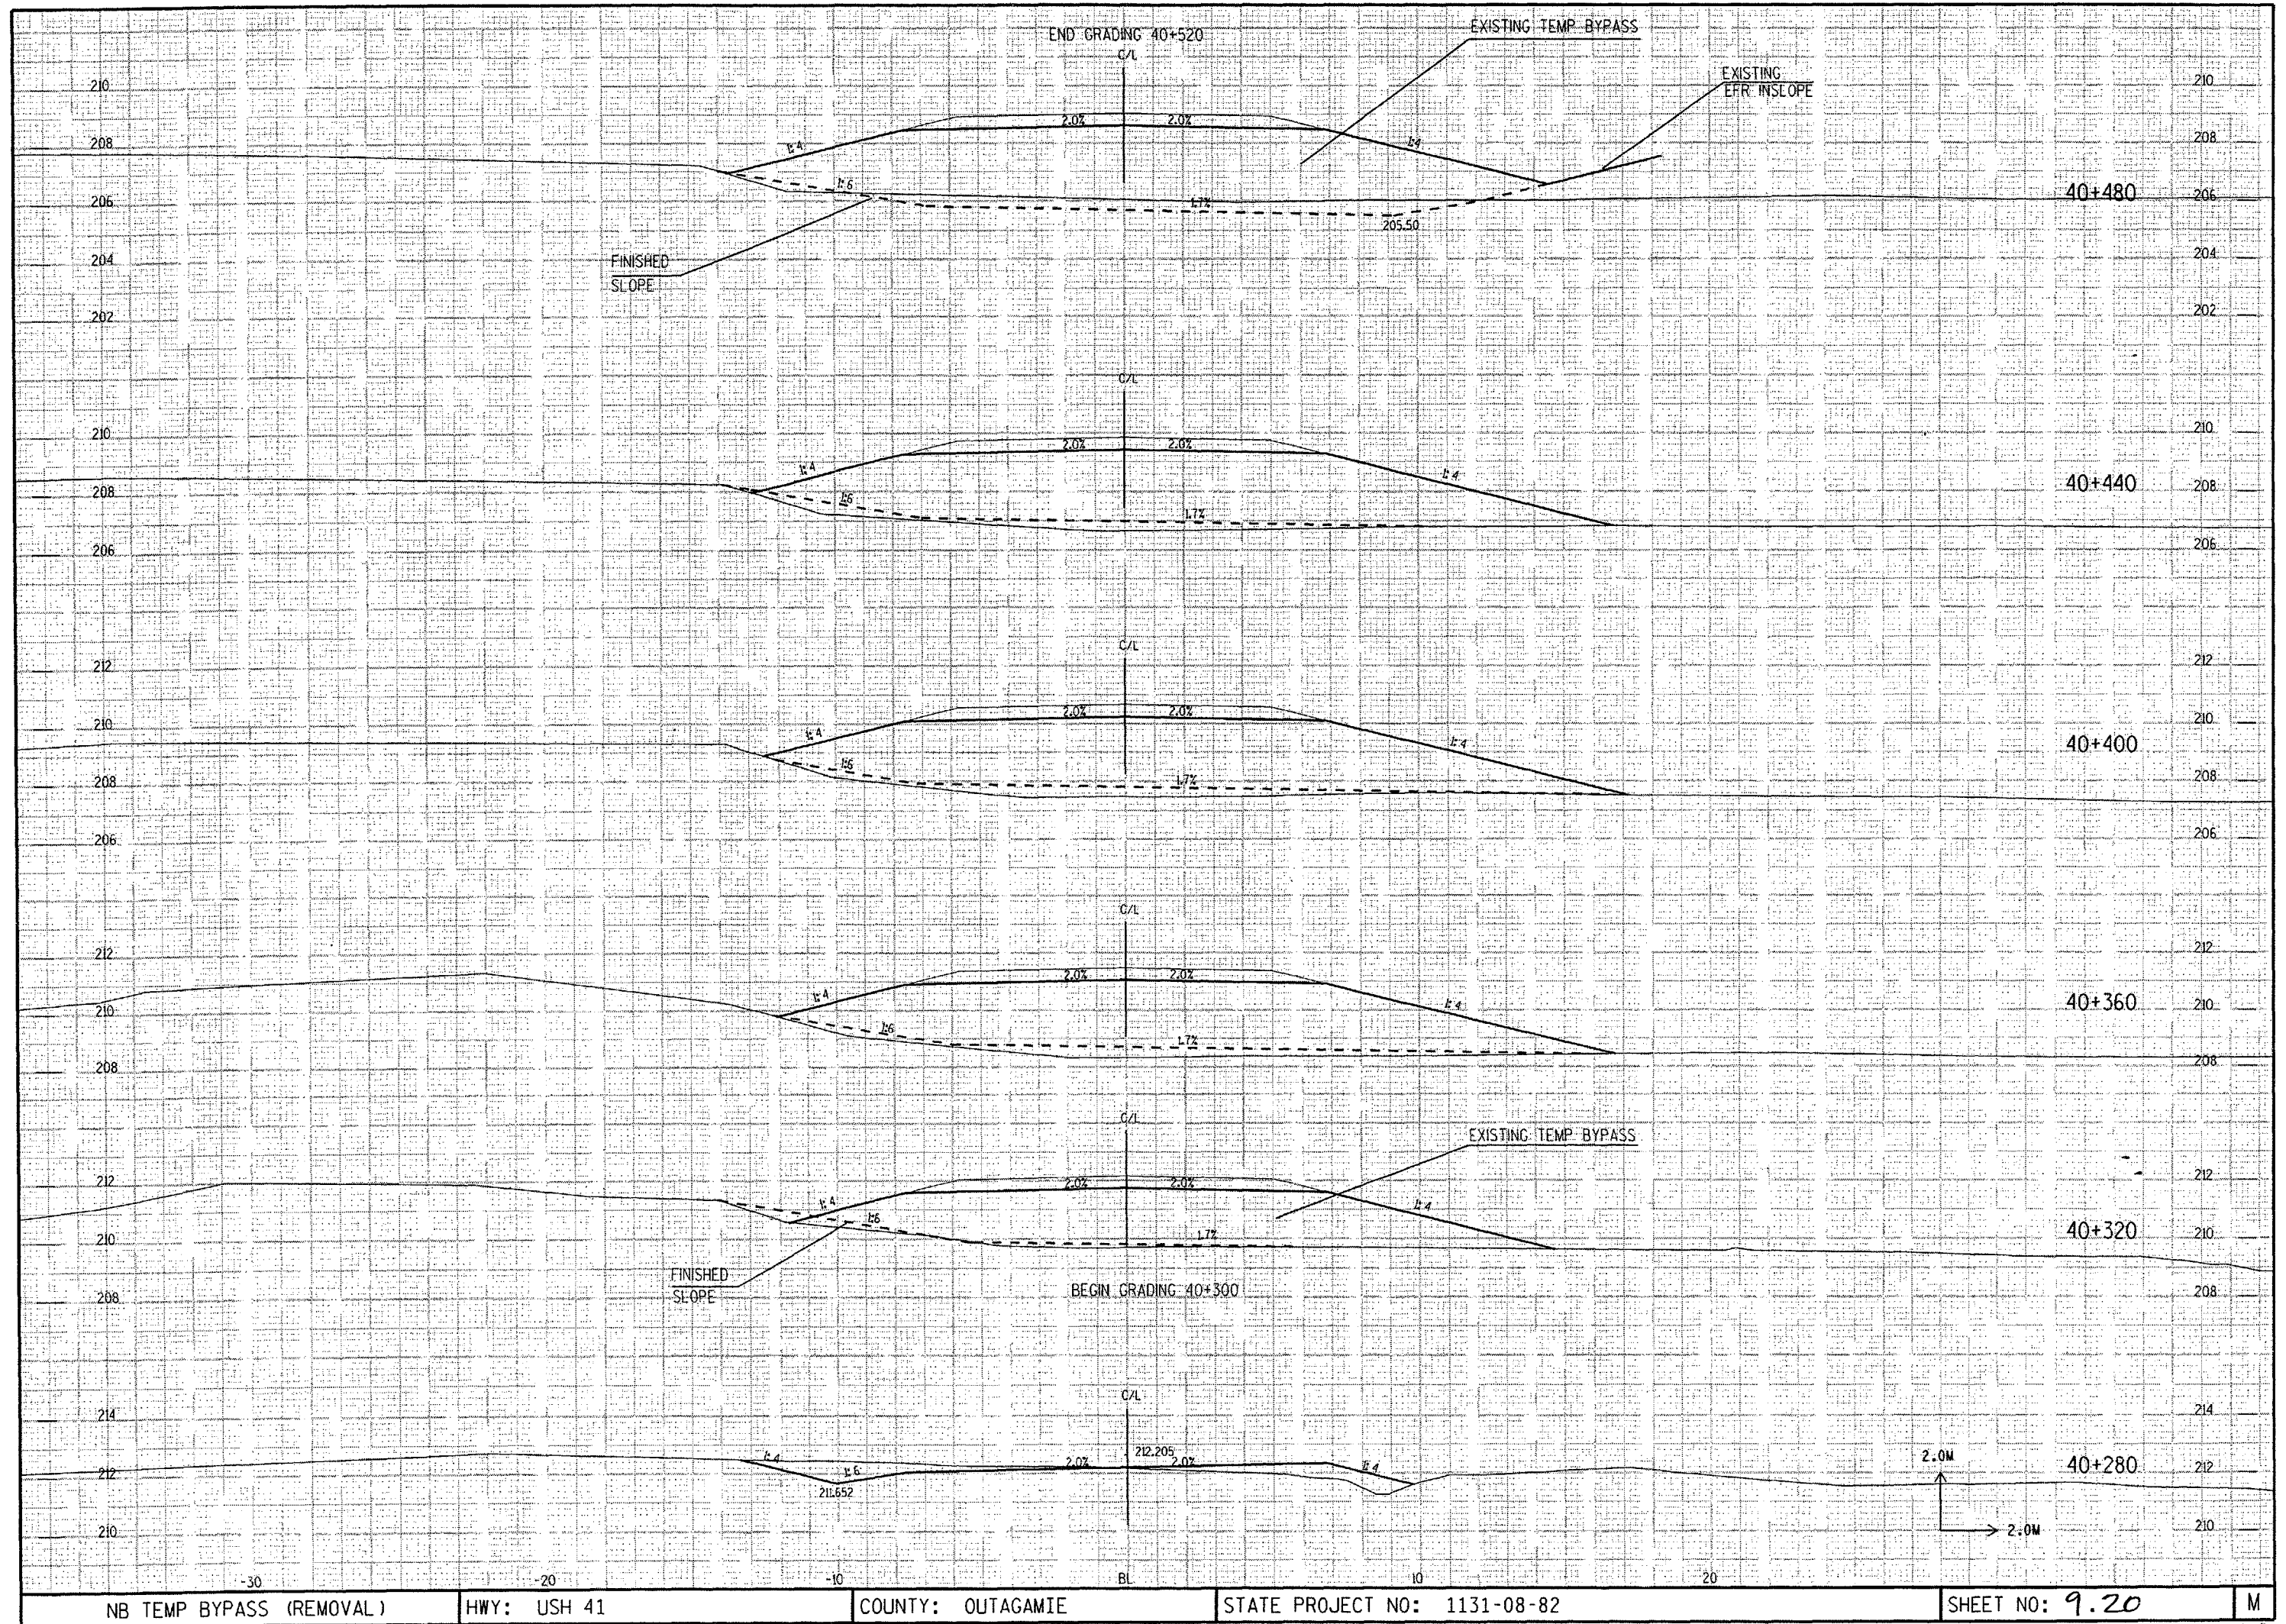

NB TEMP BYPASS (REMOVAL)

HWY: USH 41

COUNTY: OUTAGAMIE

STATE PROJECT NO: 1131-08-82


SHEET NO: 9.20

M

105



C:\SERS\p0311310878\us41\st\SH\lambby\lcs.dgn 12/27/1999 12:00:02 AM

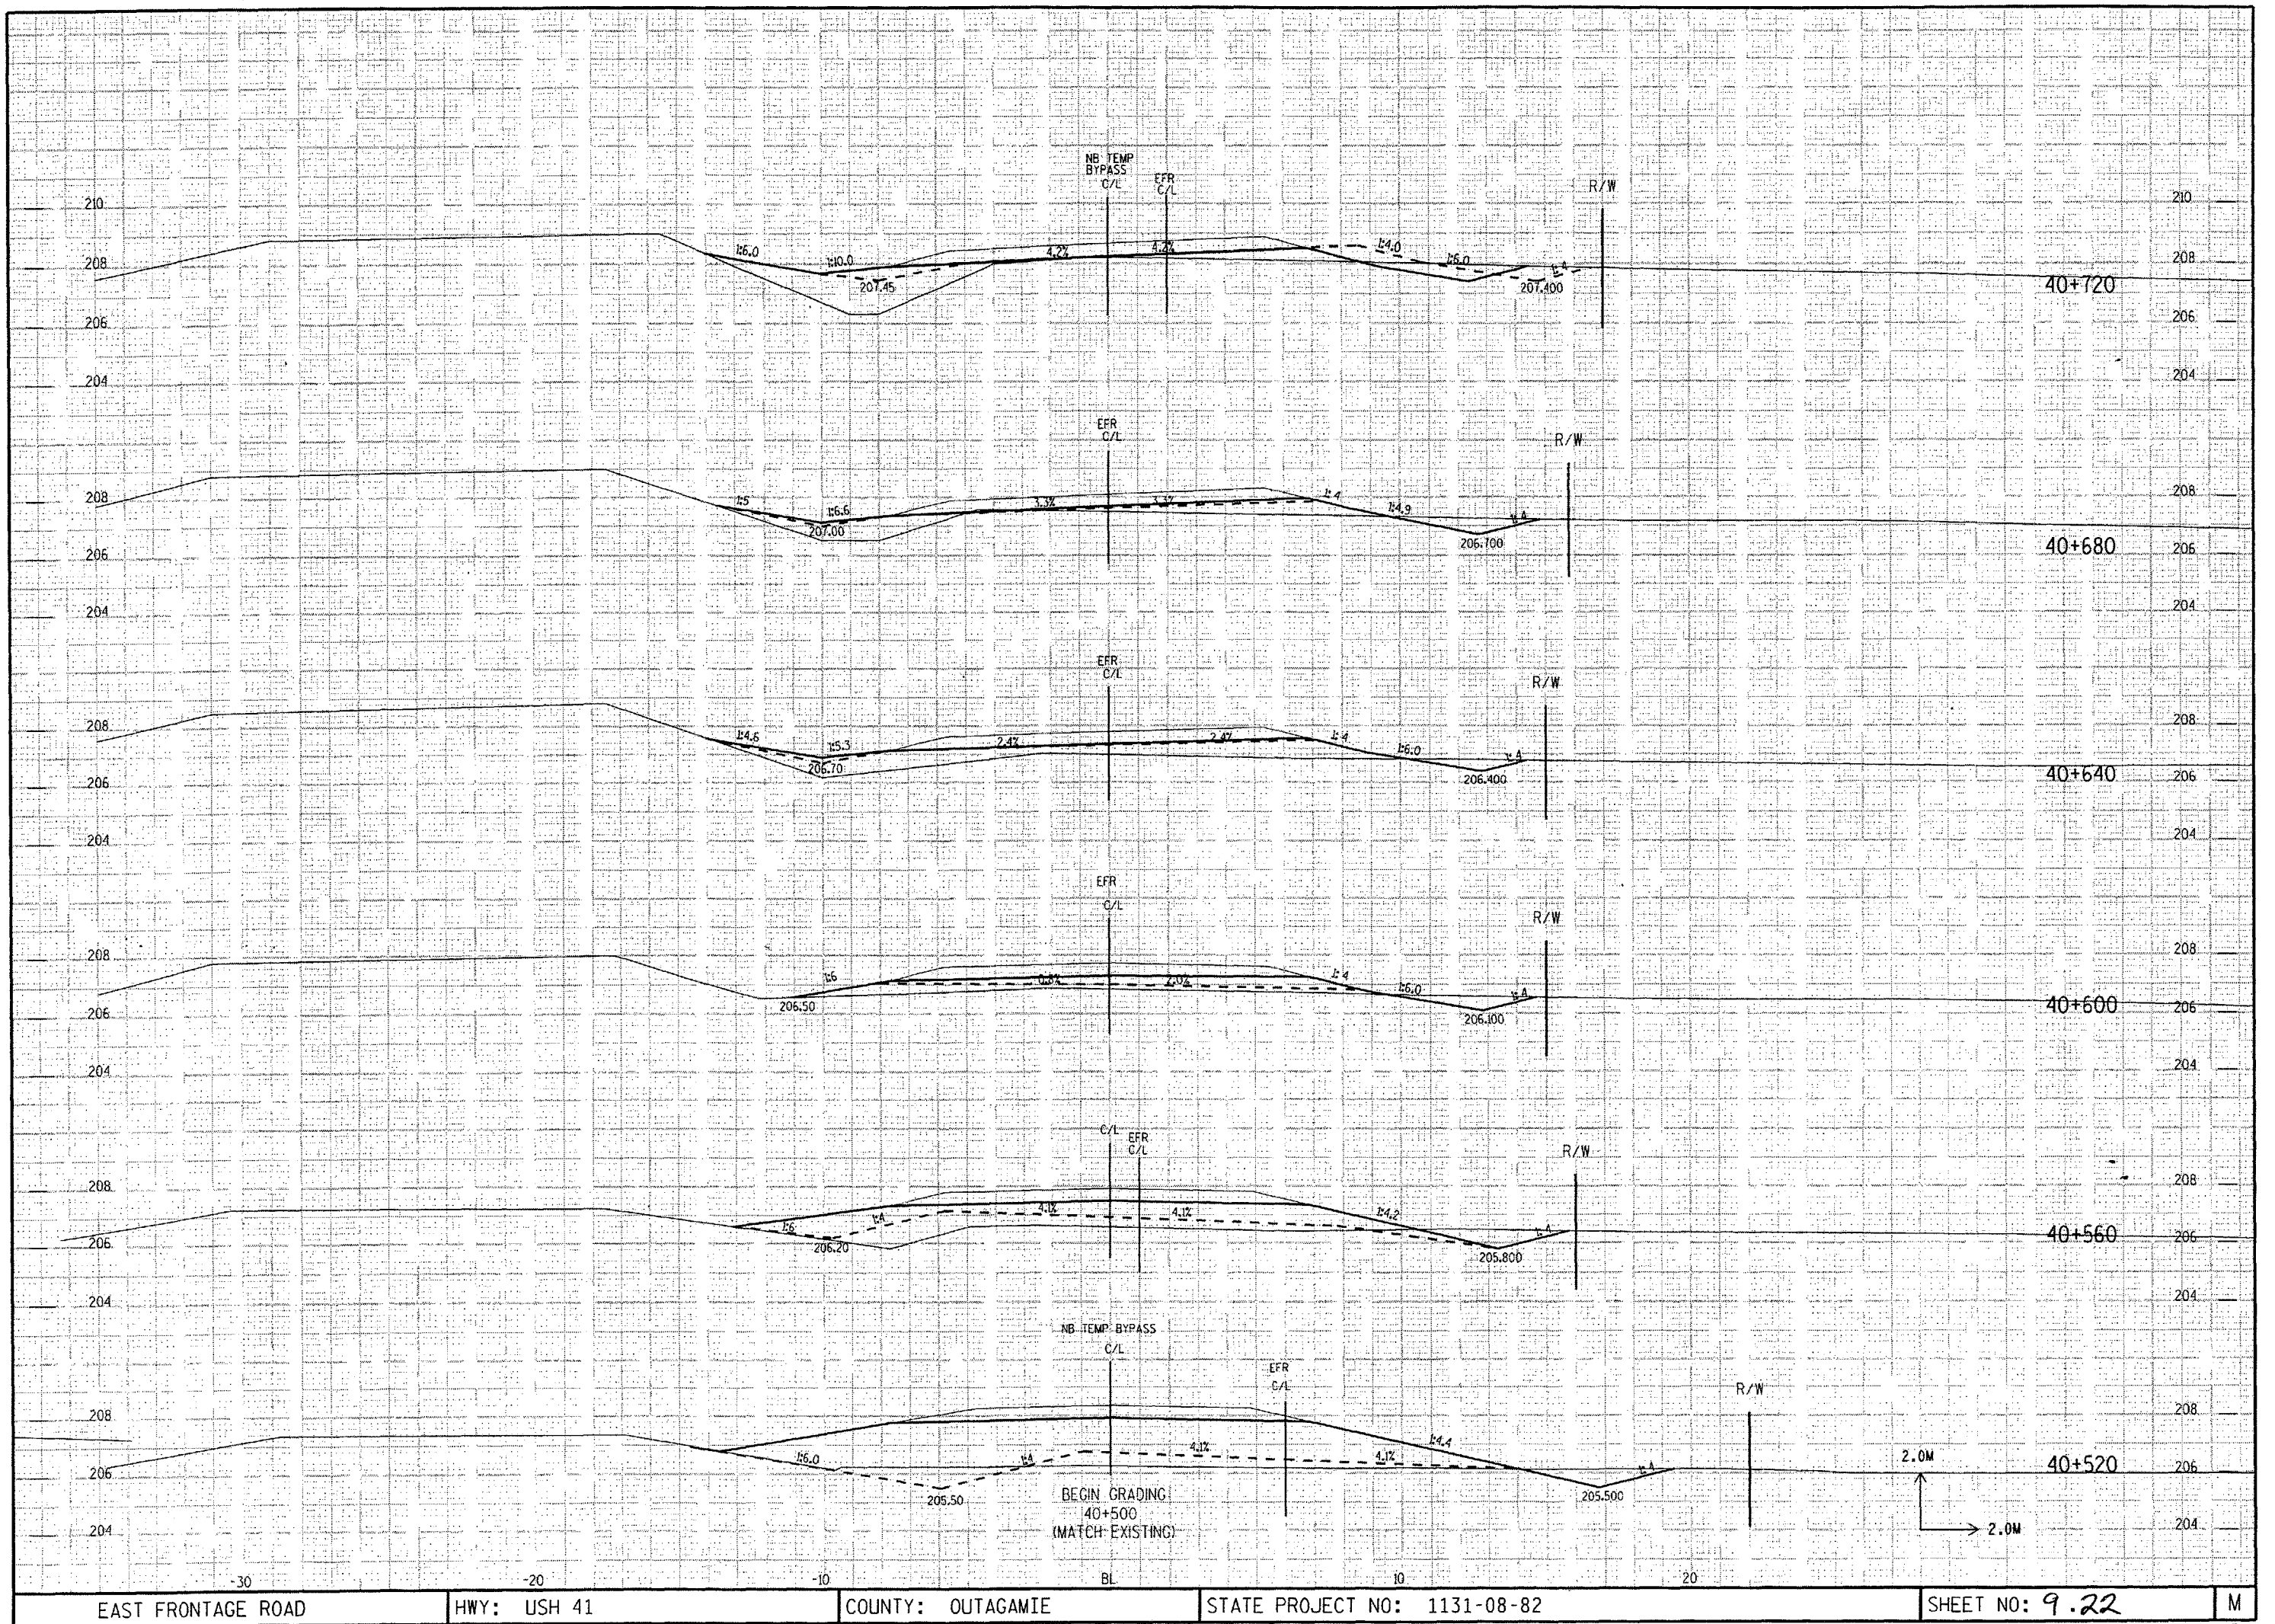

EAST FRONTAGE ROAD

HWY: USH 41


COUNTY: OUTAGAMIE

STATE PROJECT NO: 1131-08-82

SHEET NO: 9.22

M

CCS Wed 10/27/1999 12:00:02 AM C:\USERS\p3d3\1130878\usht4\1\SH4\1trbby\ks.dgn

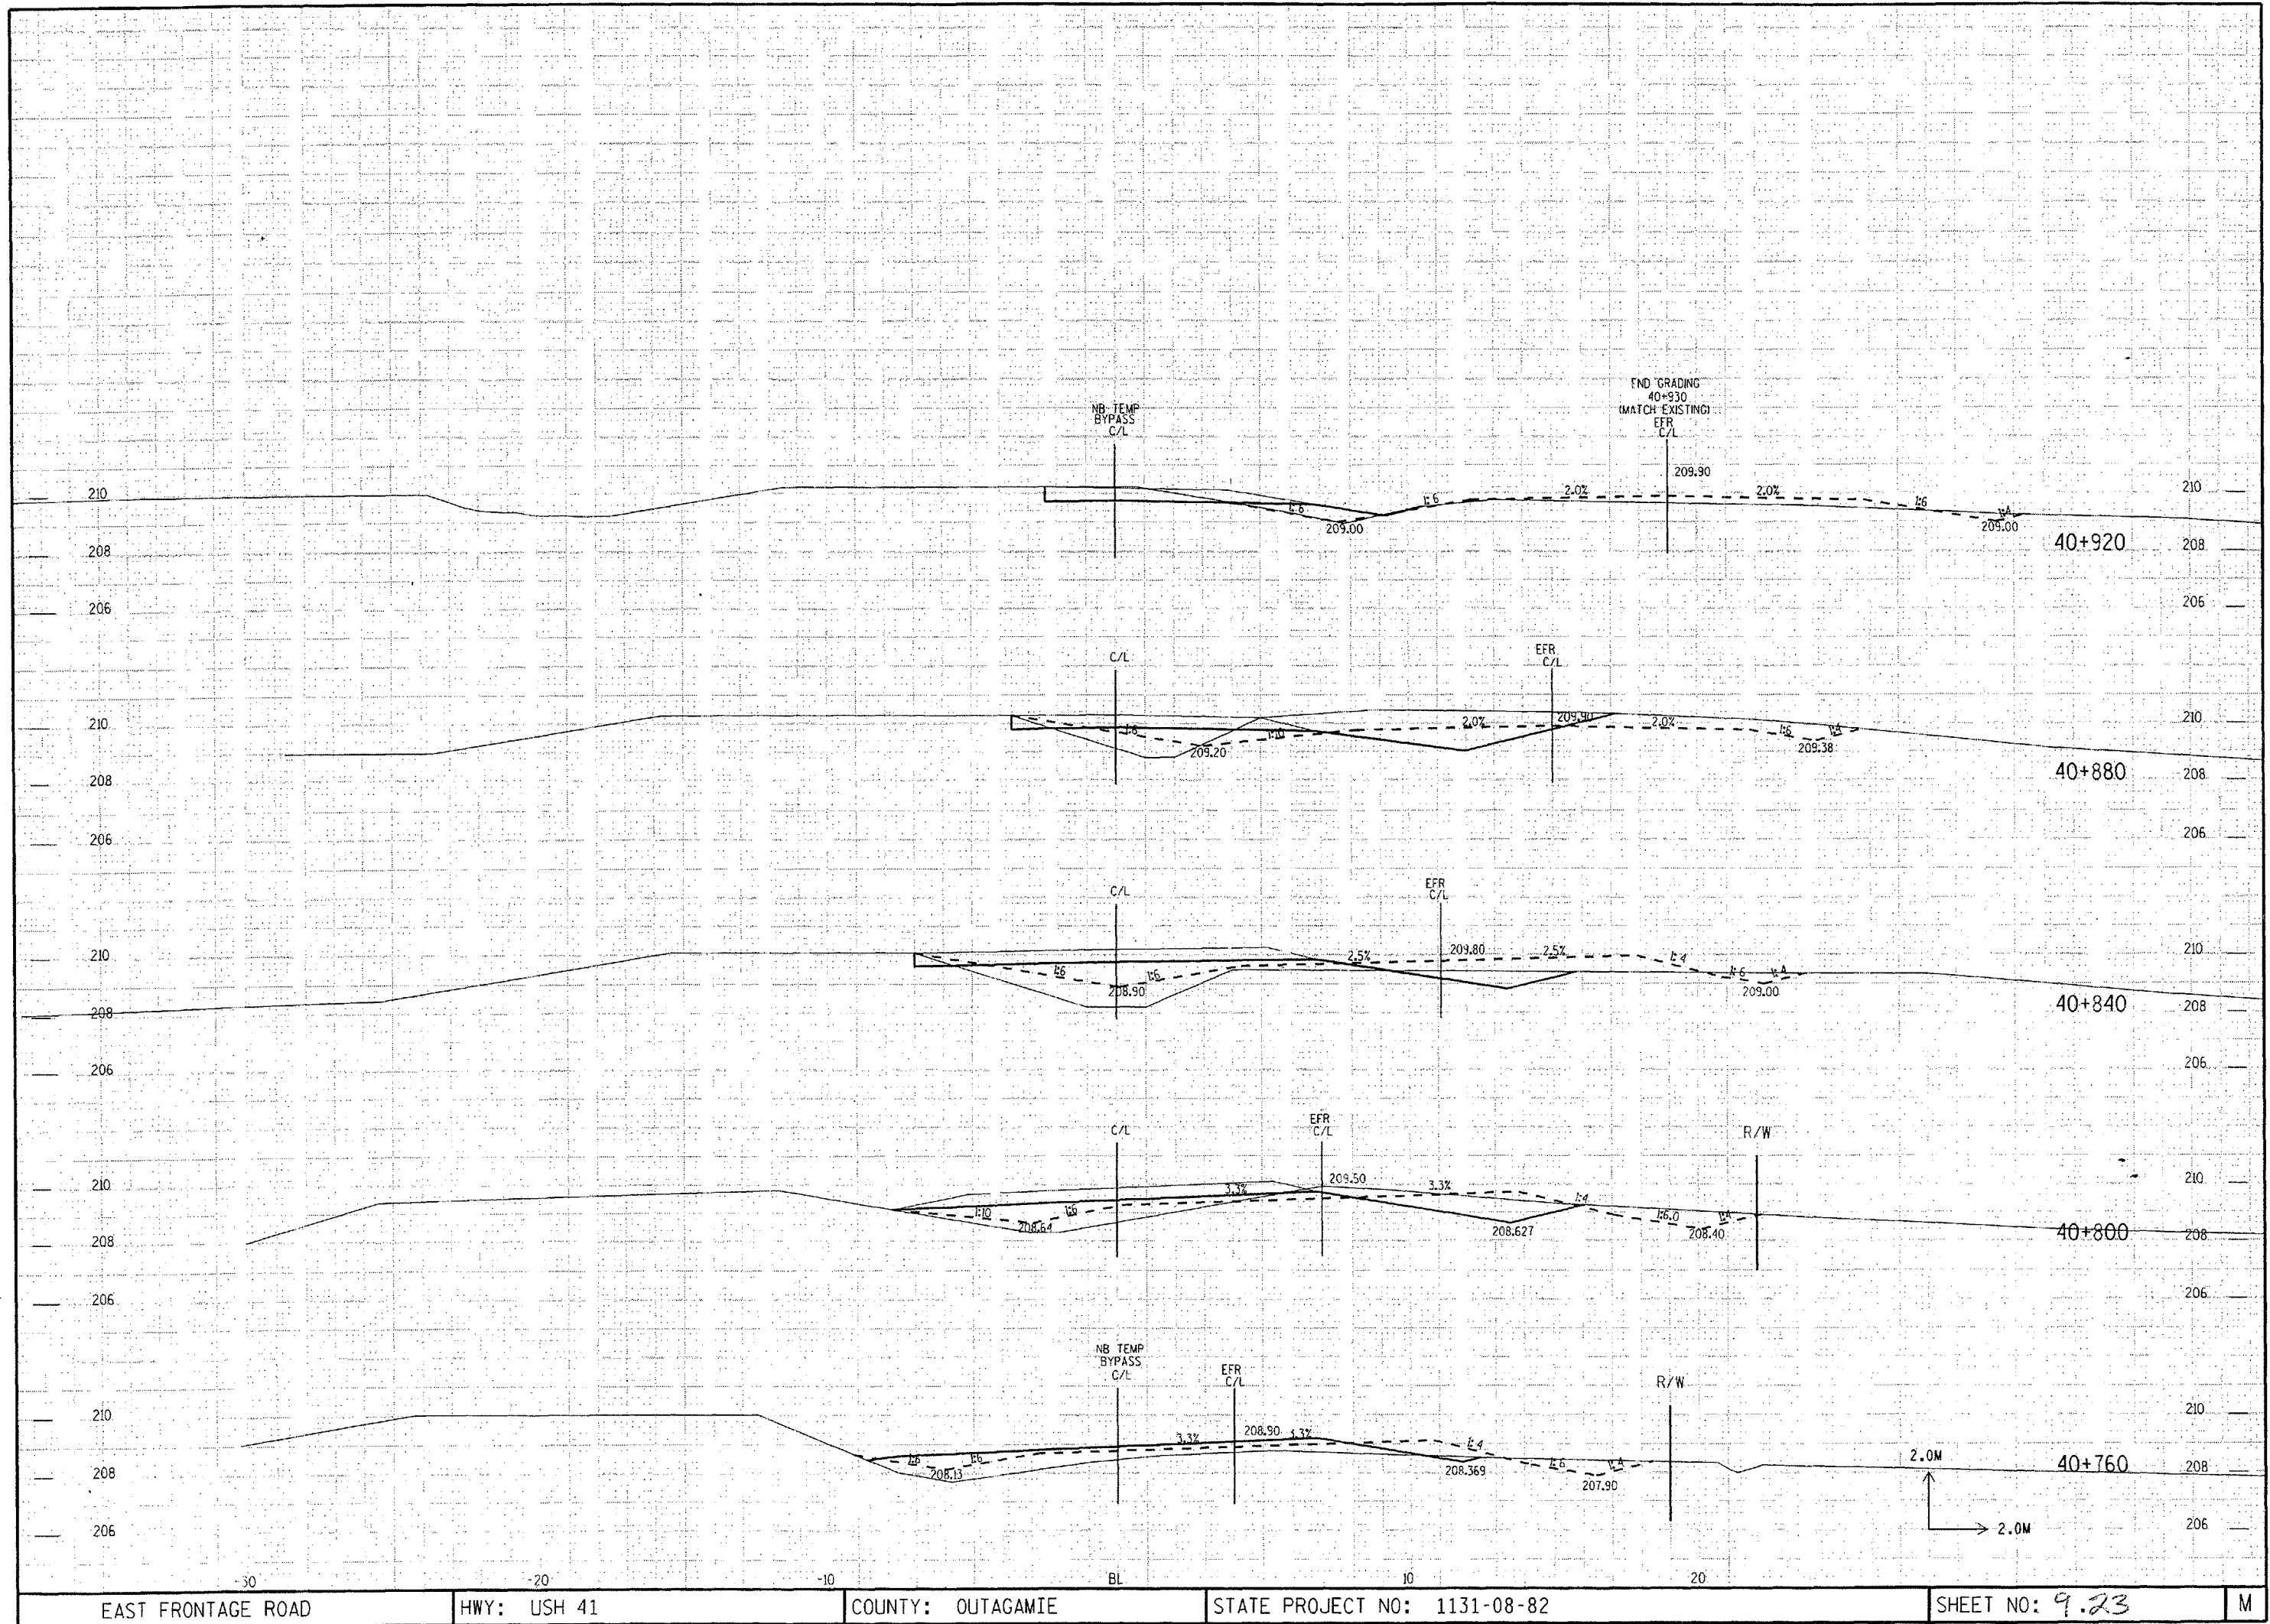

EAST FRONTAGE ROAD

HWY: USH 41


COUNTY: OUTAGAMIE

STATE PROJECT NO: 1131-08-82


SHEET NO: 9.23

M

\\cs\fr 10/28/1999 6:17:29 AM C:\USERS\p3d3\1131082\FR31e.fr3xs.dgn

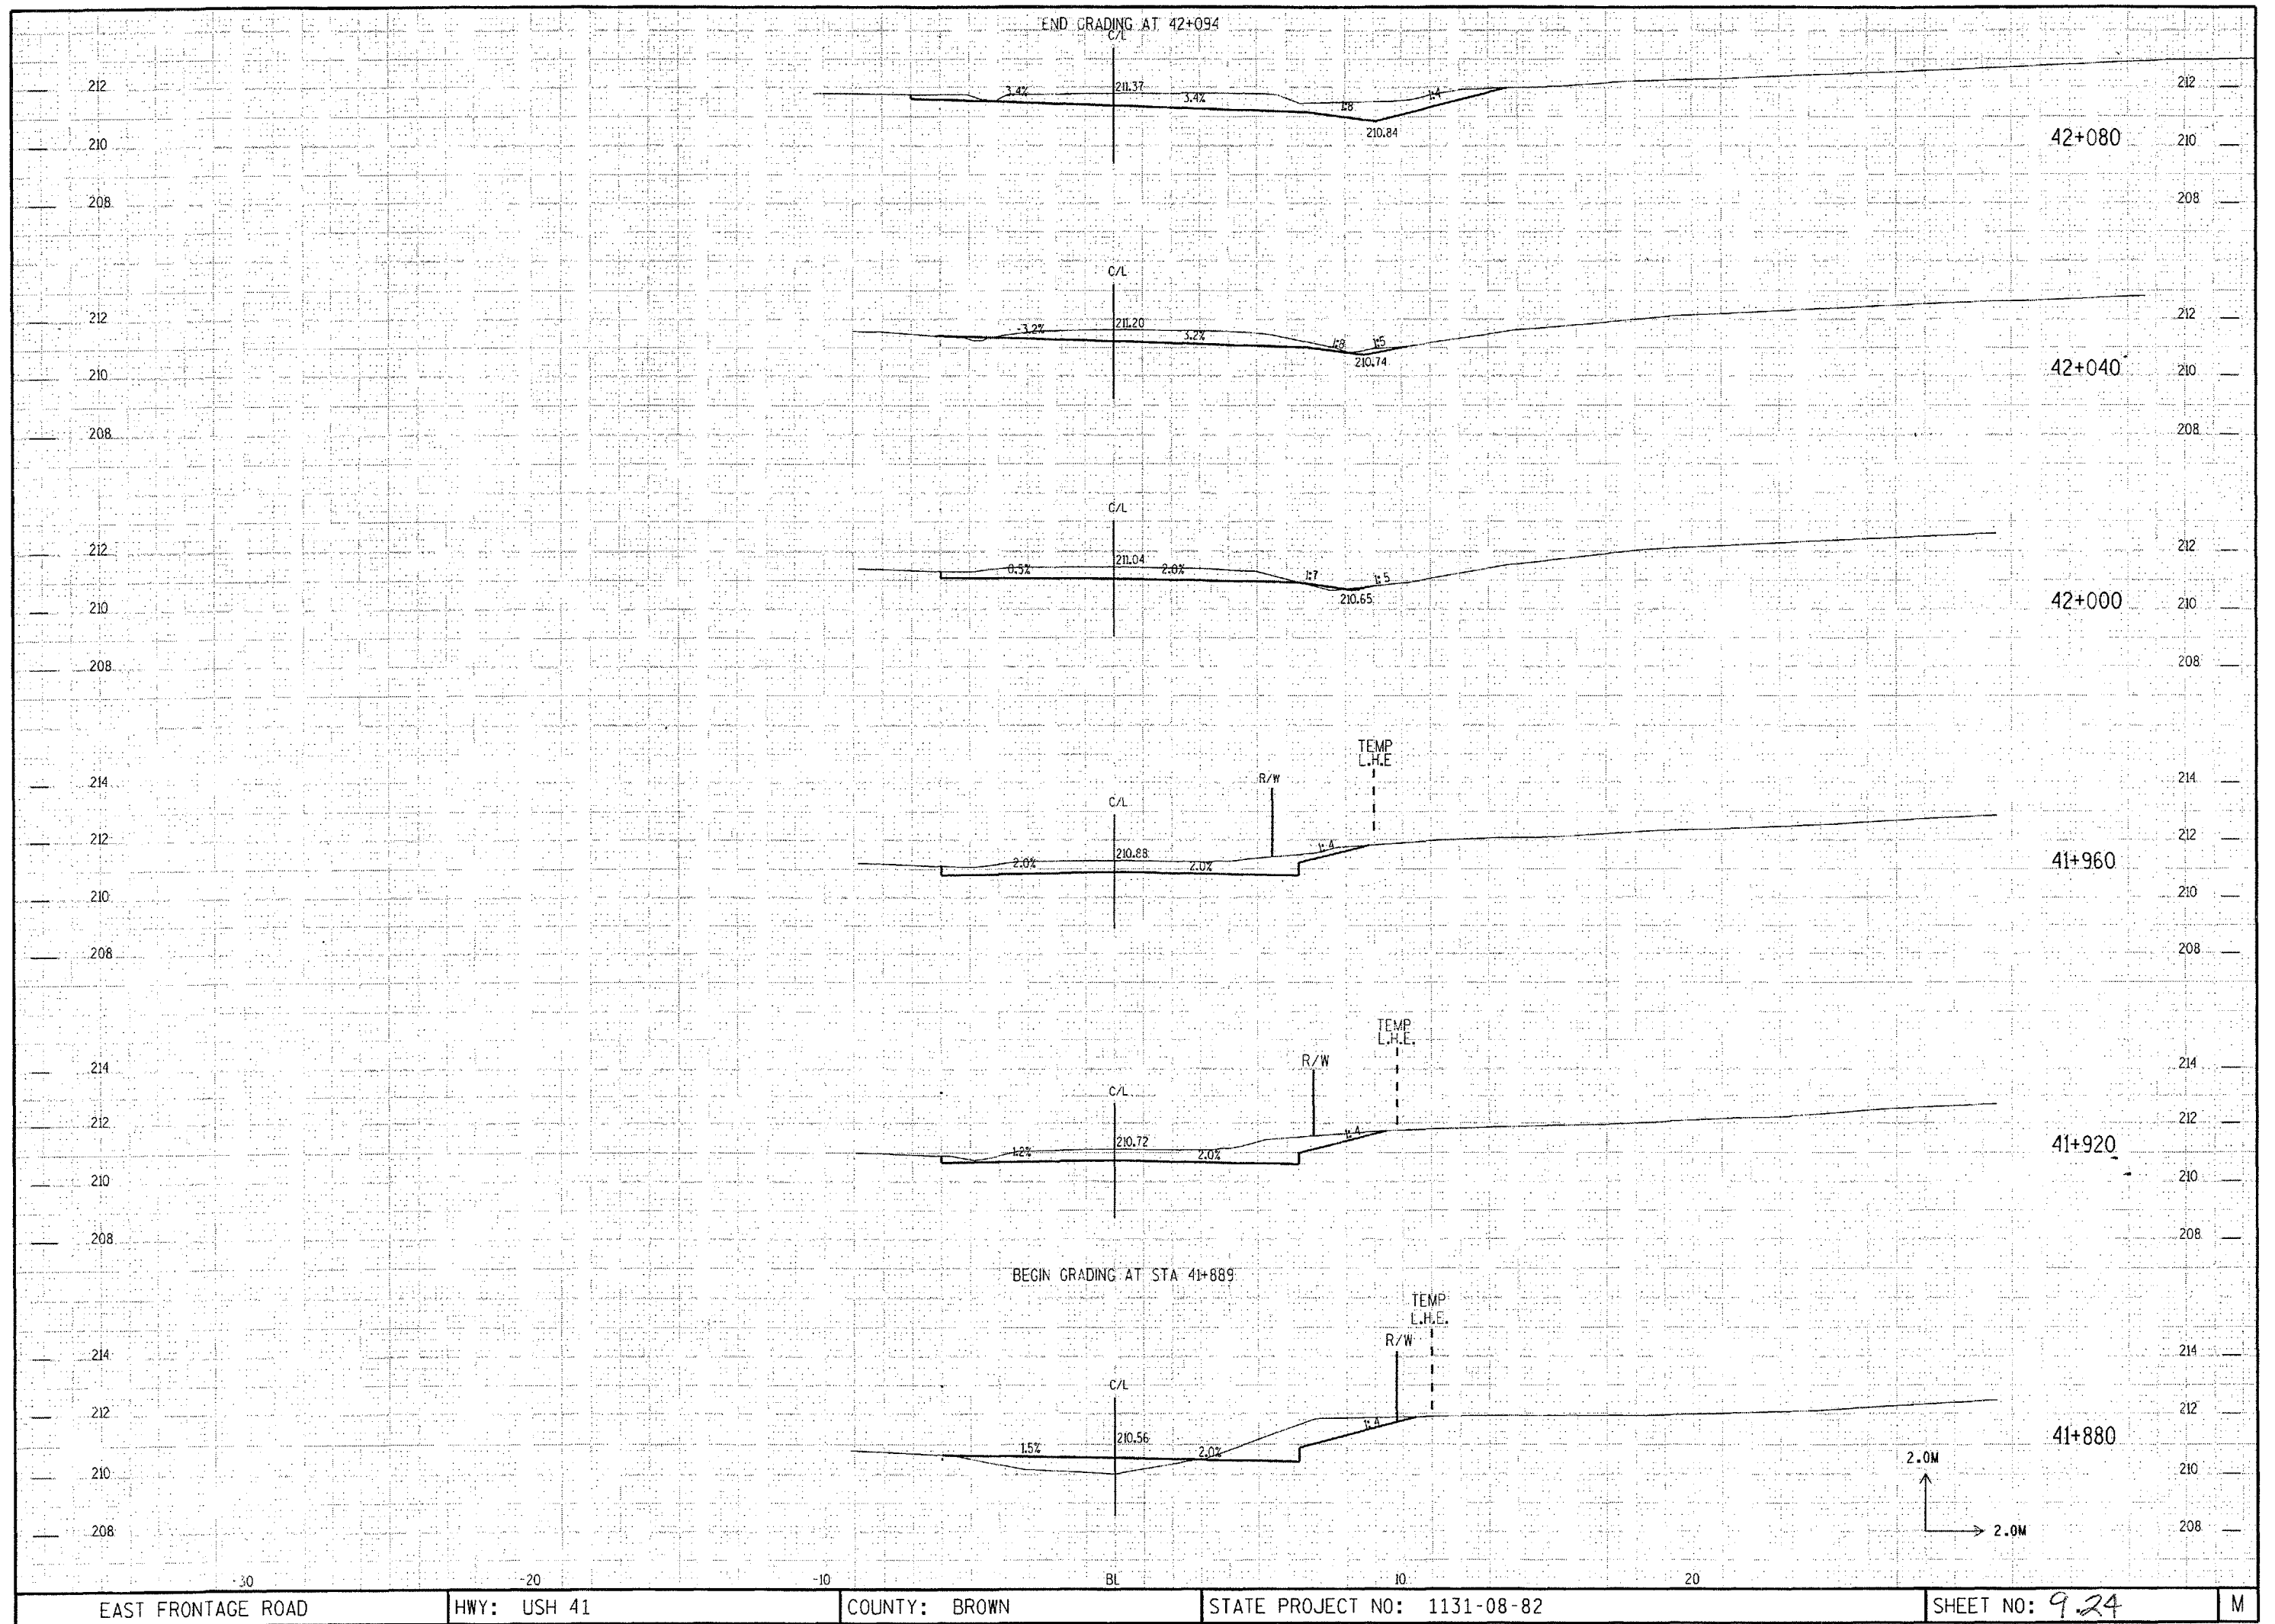

C:\CS 10/28/1999 6:07:55 AM C:\USERS\p\ed3\103080\US41\cctb\12.s.dgn

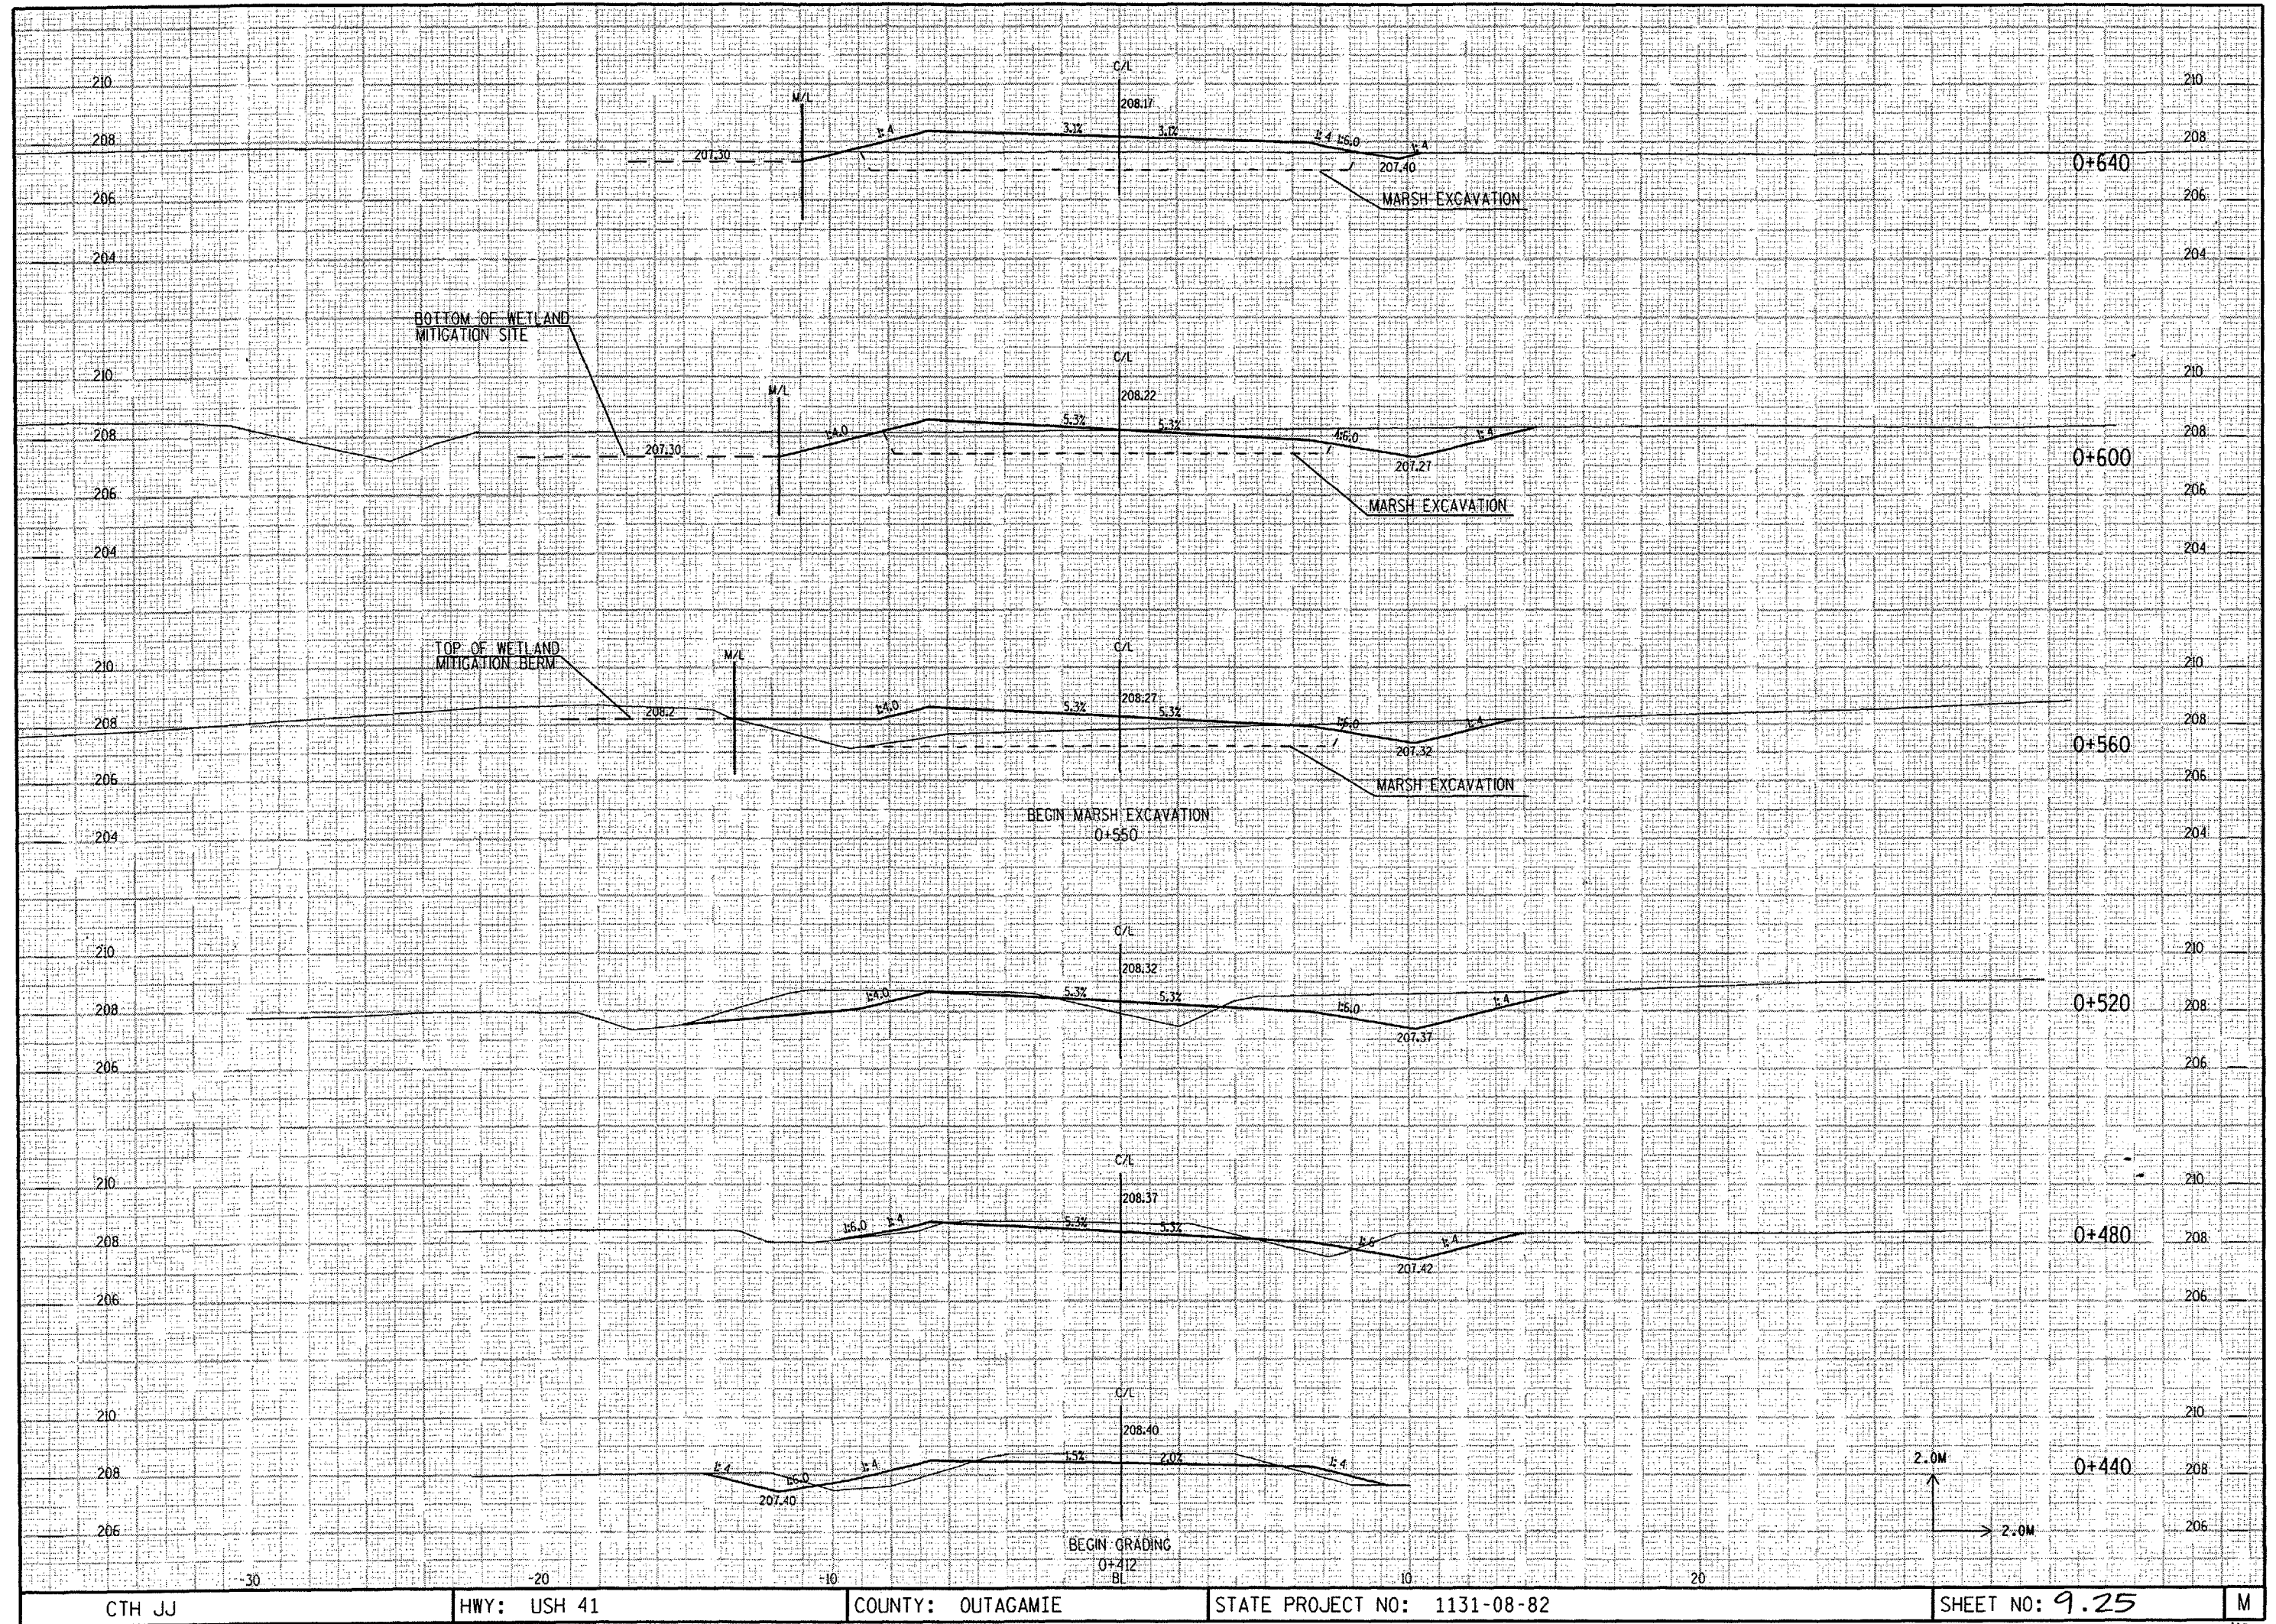

CTH JJ

HWY: USH 41

COUNTY: OUTAGAMIE


STATE PROJECT NO: 1131-08-82

SHEET NO: 9.25

M

110

C:\CS PROJ 10/28/1999 6:07:55 AM C:\GISERS\PE\03110380\US41\ctm\2.s.dgn

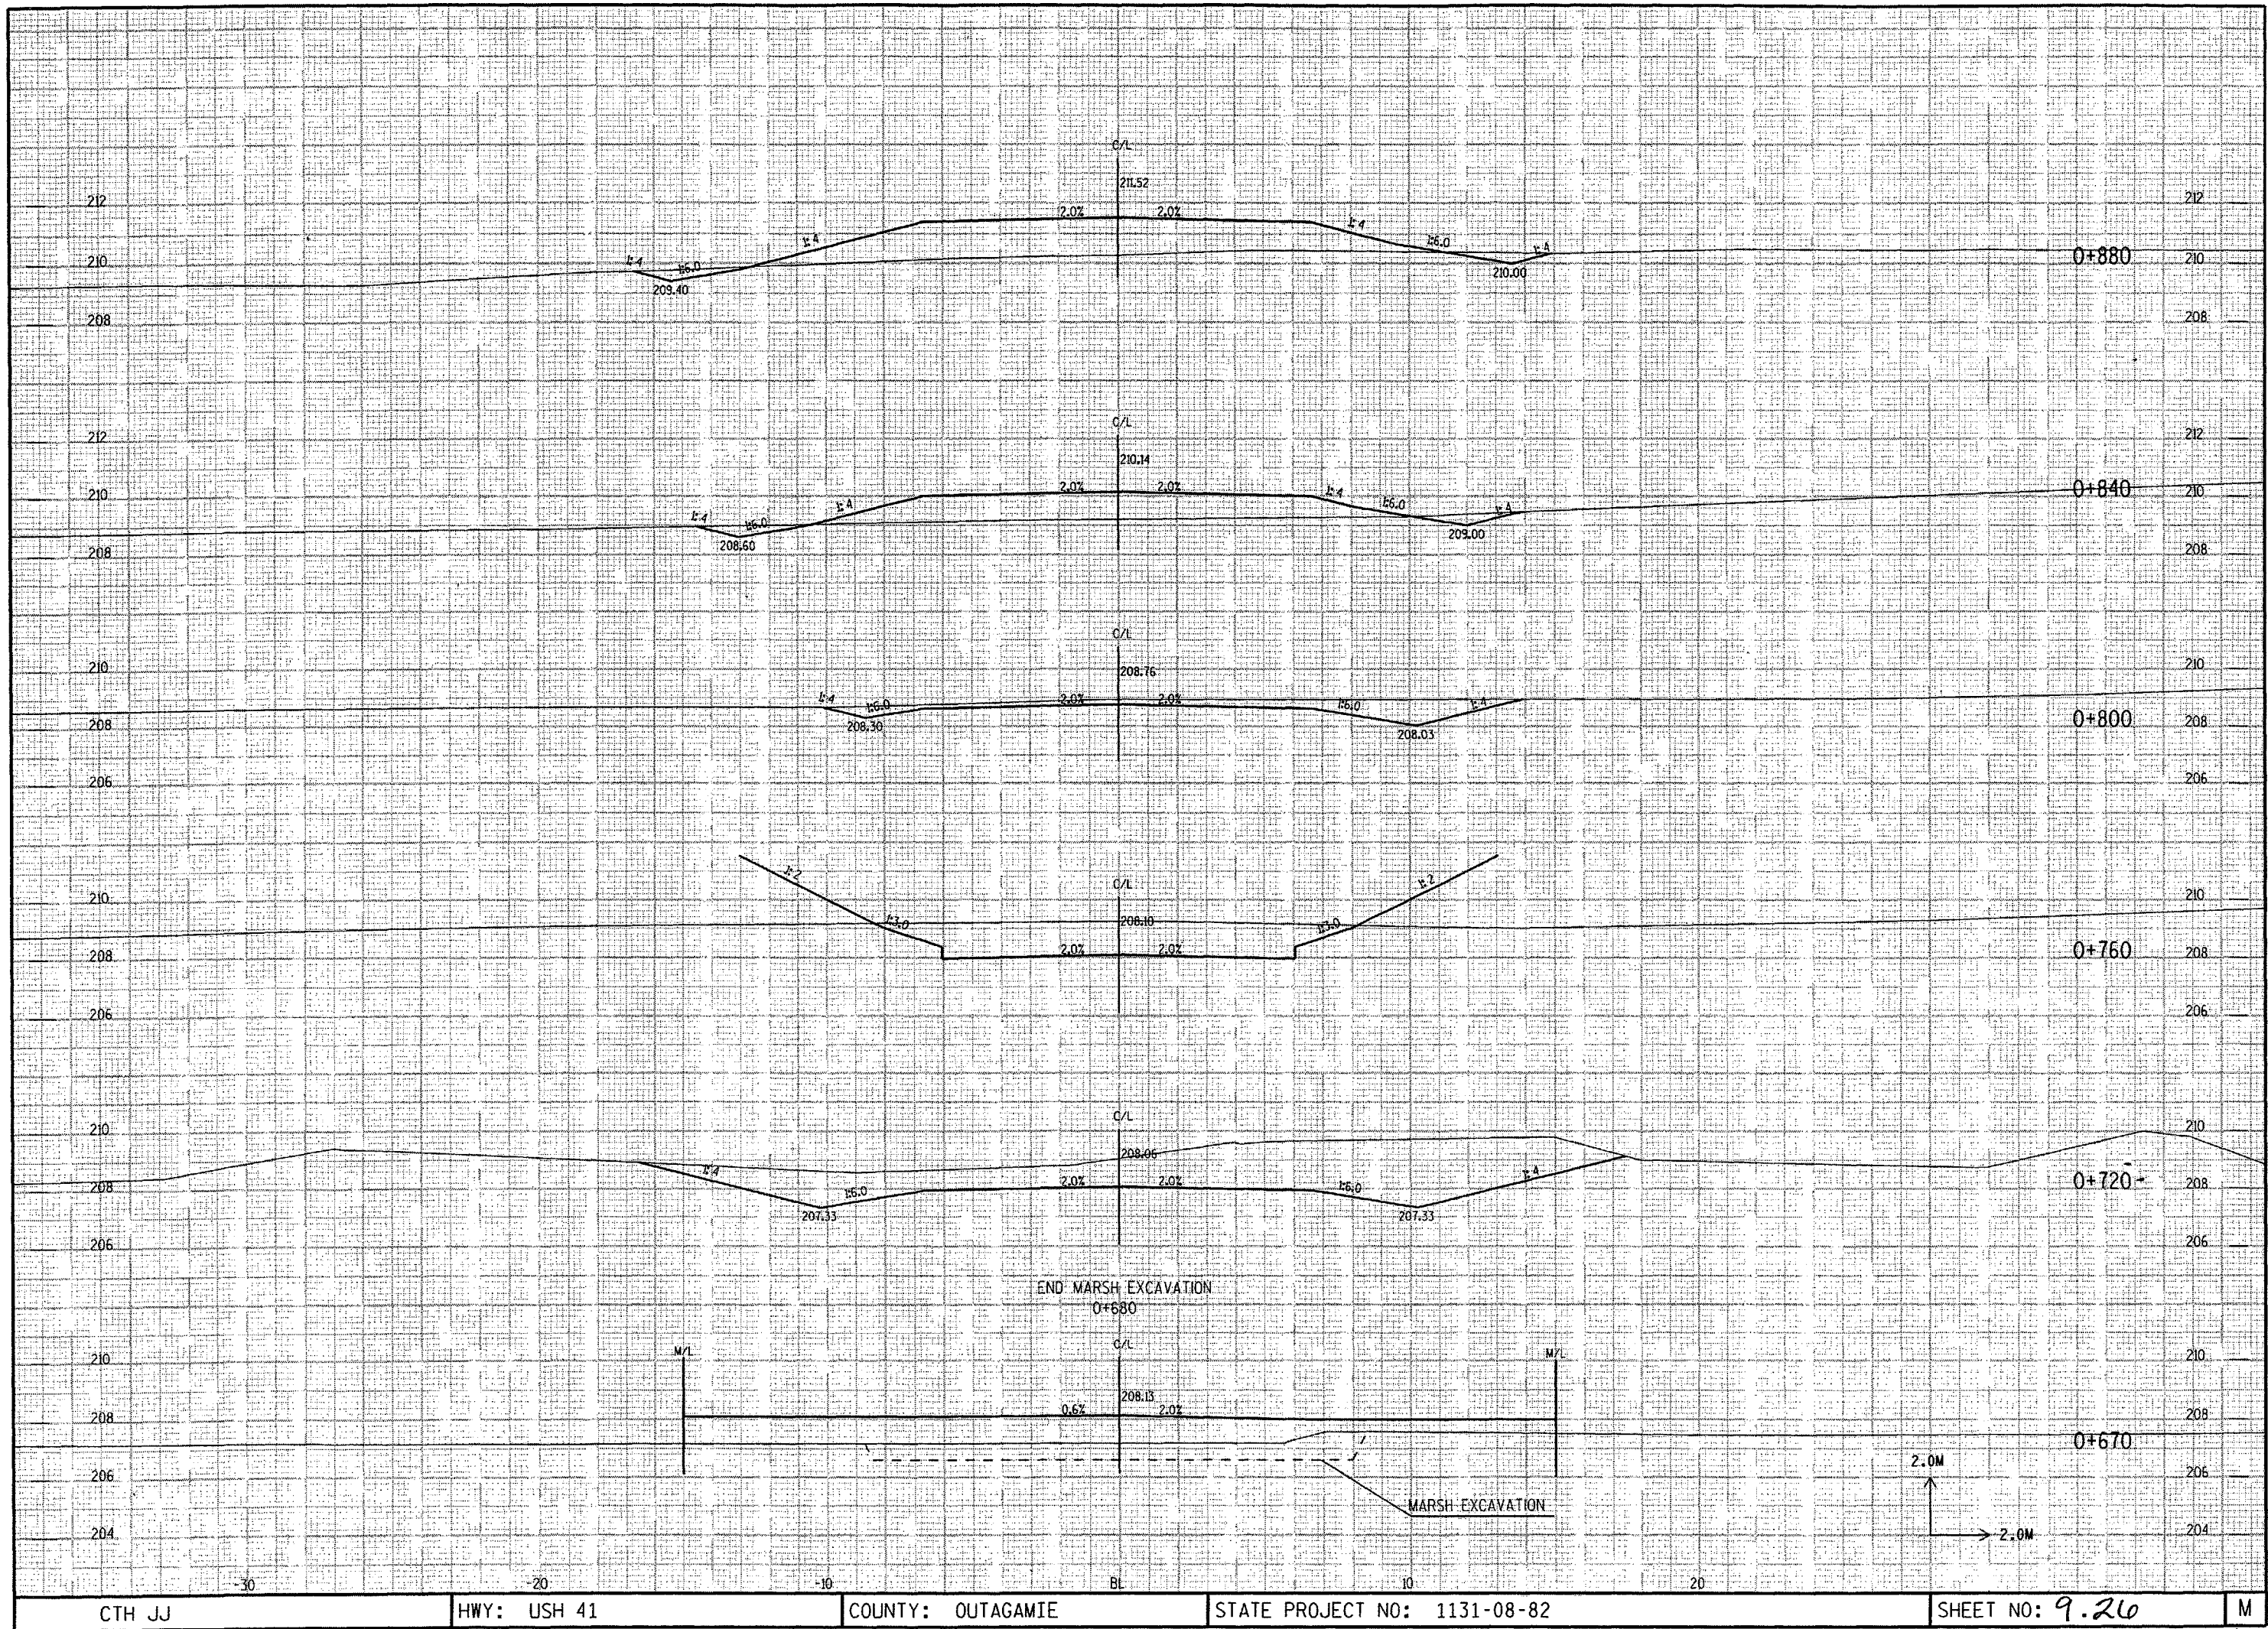

CTH JJ

HWY: USH 41


COUNTY: OUTAGAMIE

STATE PROJECT NO: 1131-08-82

SHEET NO: 9.26

M

C:\CS T10\10/28/1999 6:07:55 AM C:\USERS\p203\1\10880\USM4\cch\2\as.dgn

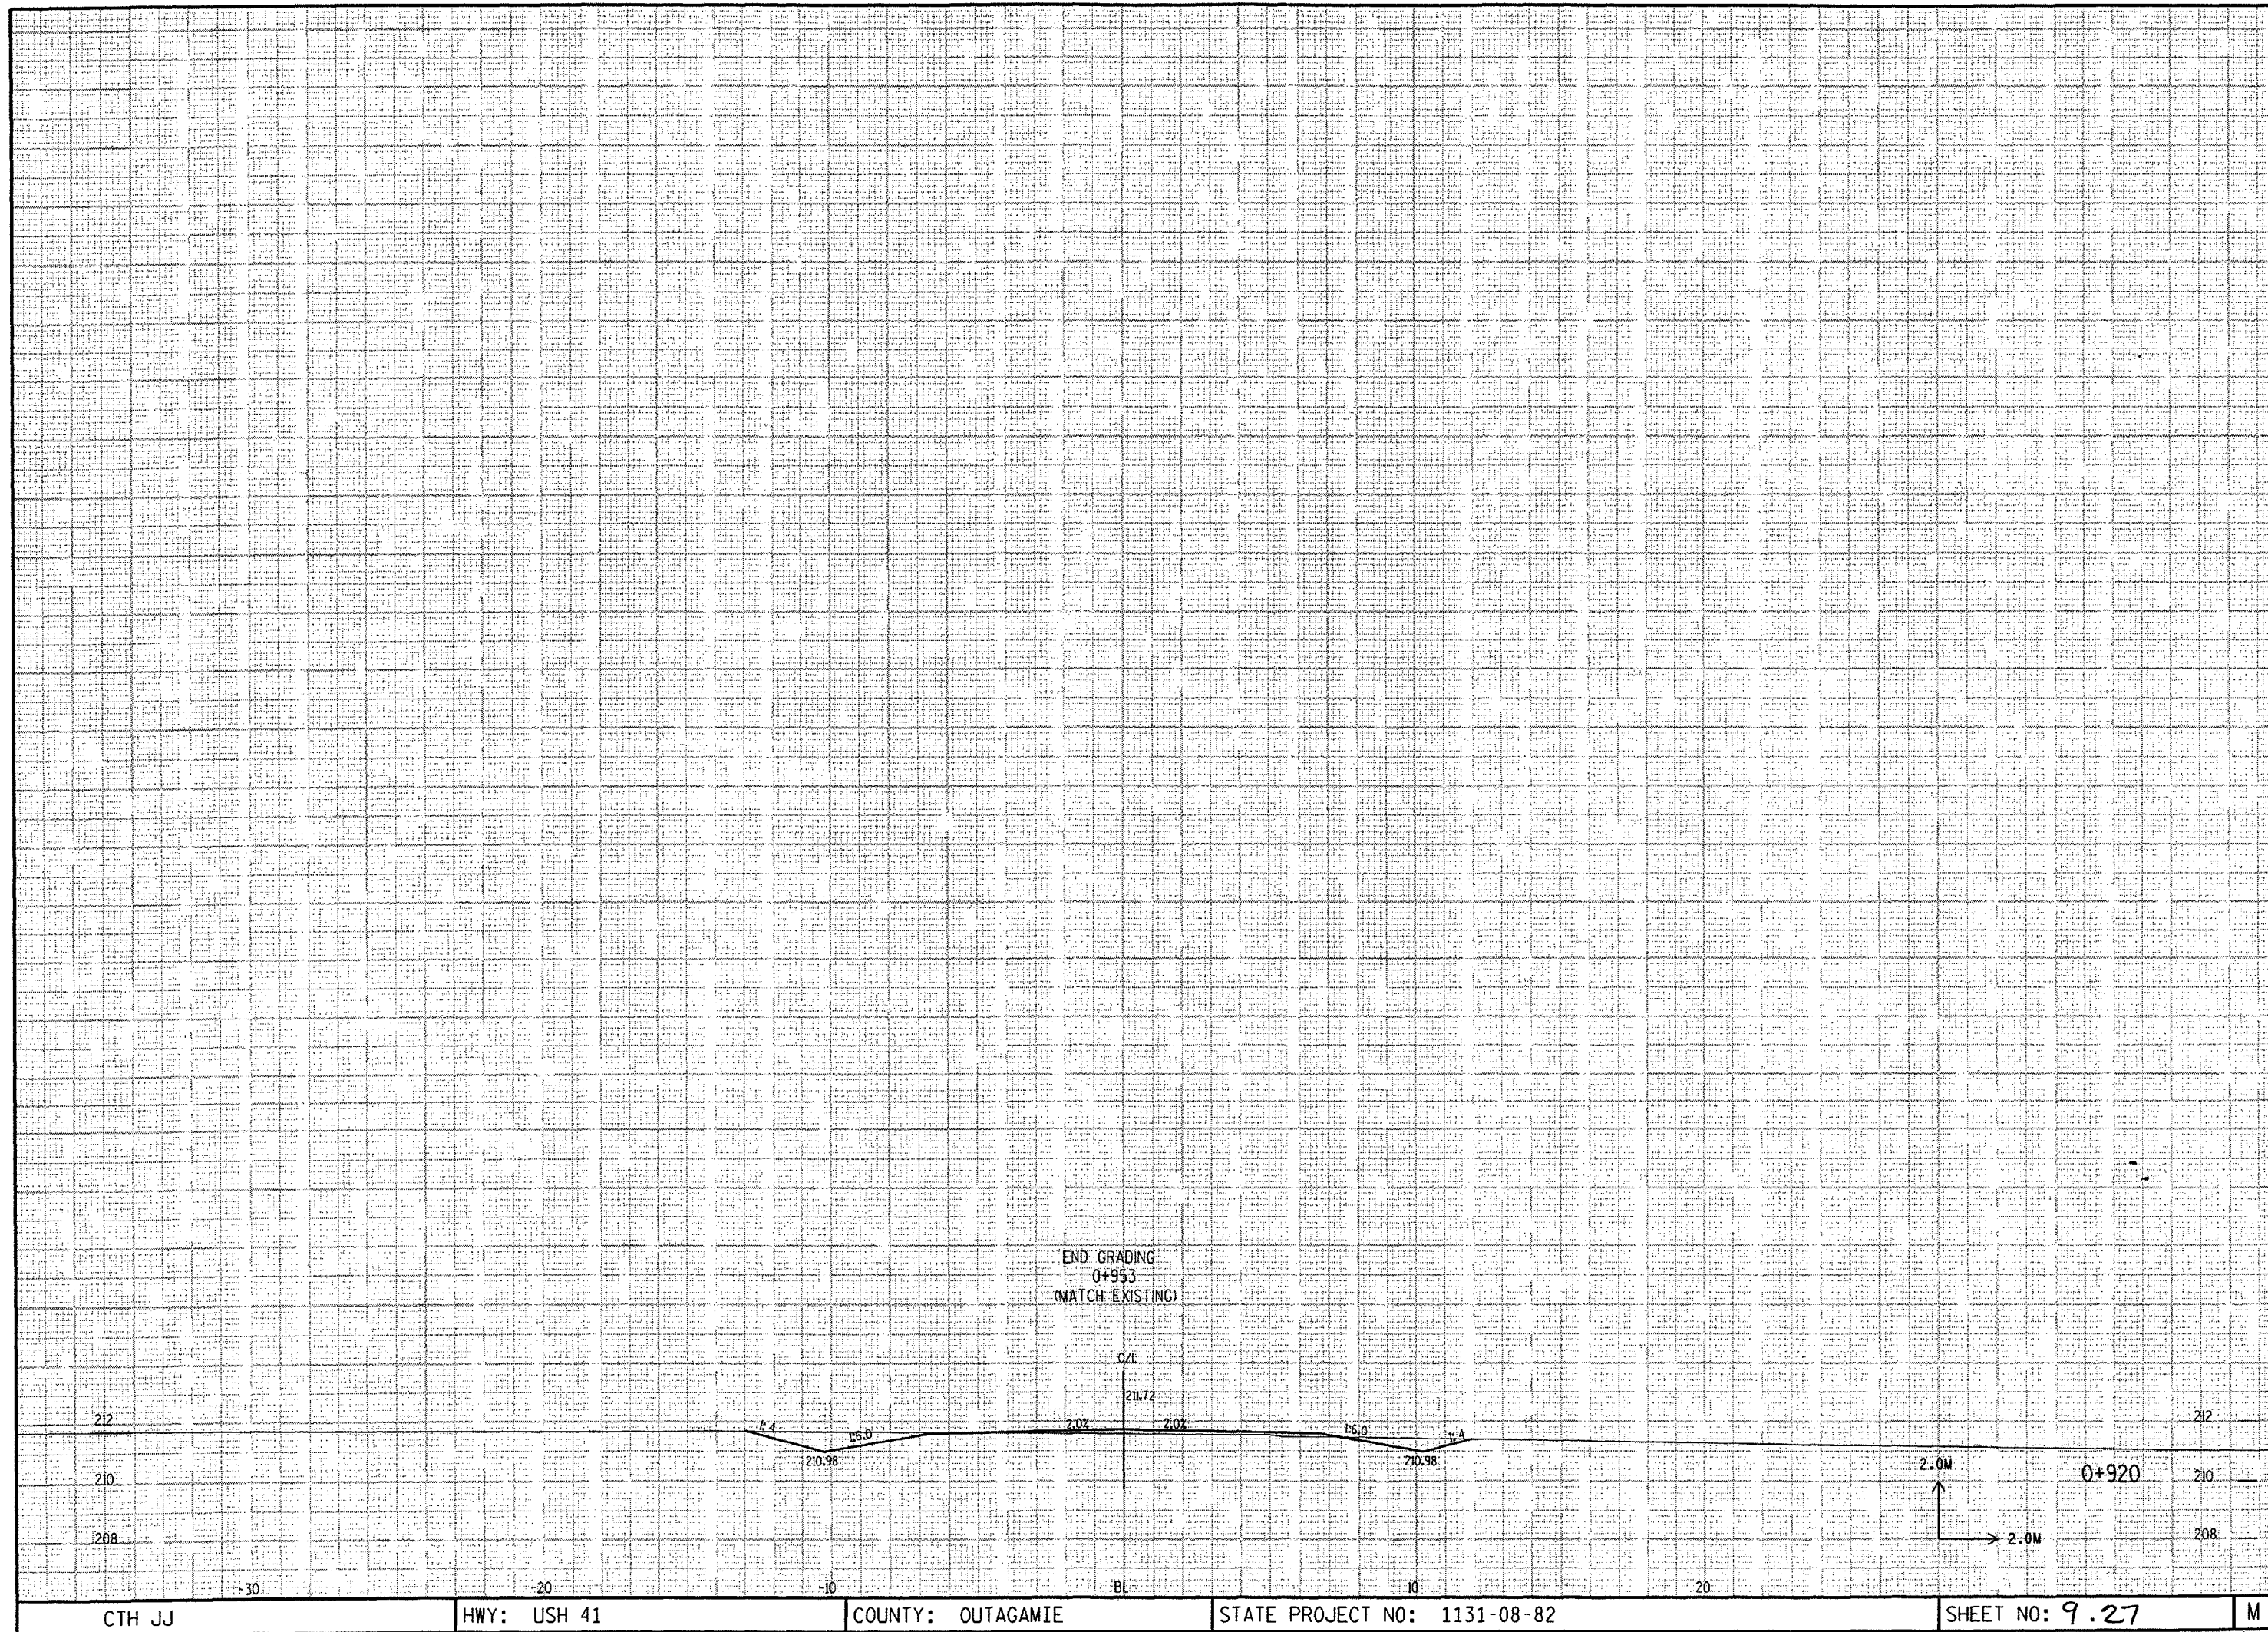

CTH JJ

HWY: USH 41


COUNTY: OUTAGAMIE

STATE PROJECT NO: 1131-08-82


SHEET NO: 9.27

M

005 Thu 10/28/1999 7:58:19 AM C:\USERS\p\p\d3\130878\us41\us41a\us41a.rks.dgn

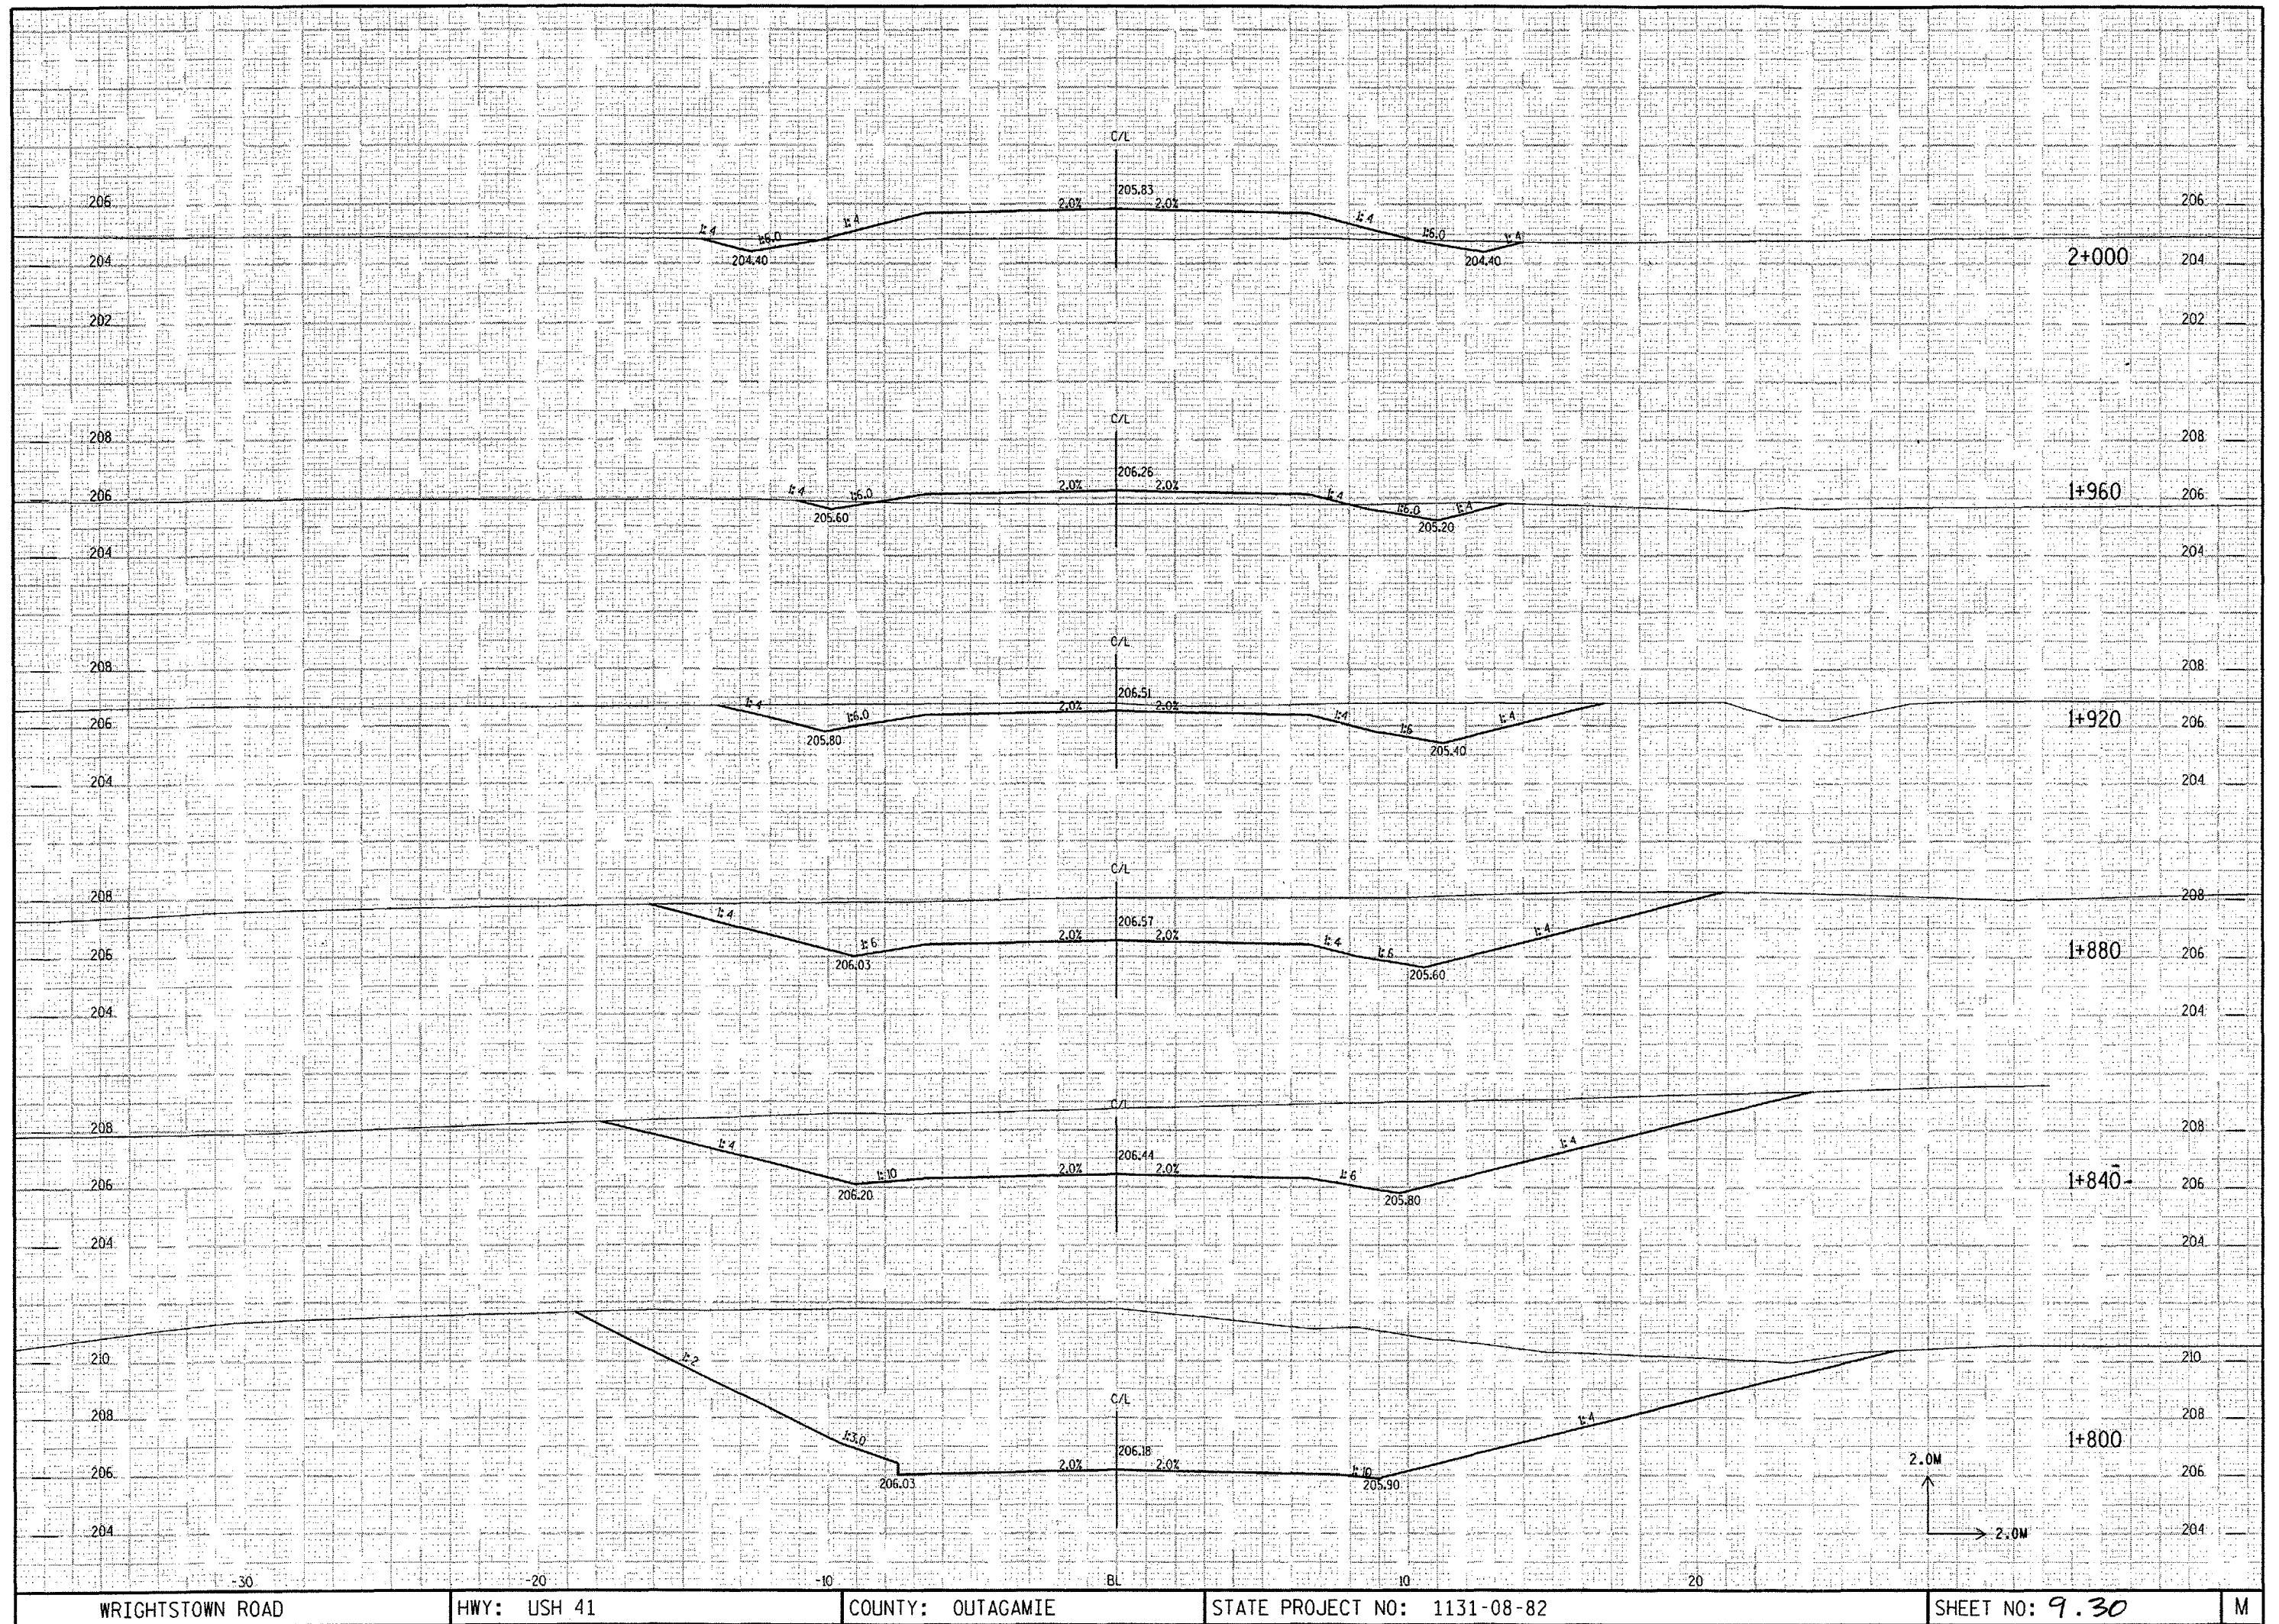

\\cs\thu\10\28\1999\713819 AM C:\USERS\p\p\311310878\us41\outag\m\w\1\ks.dgn

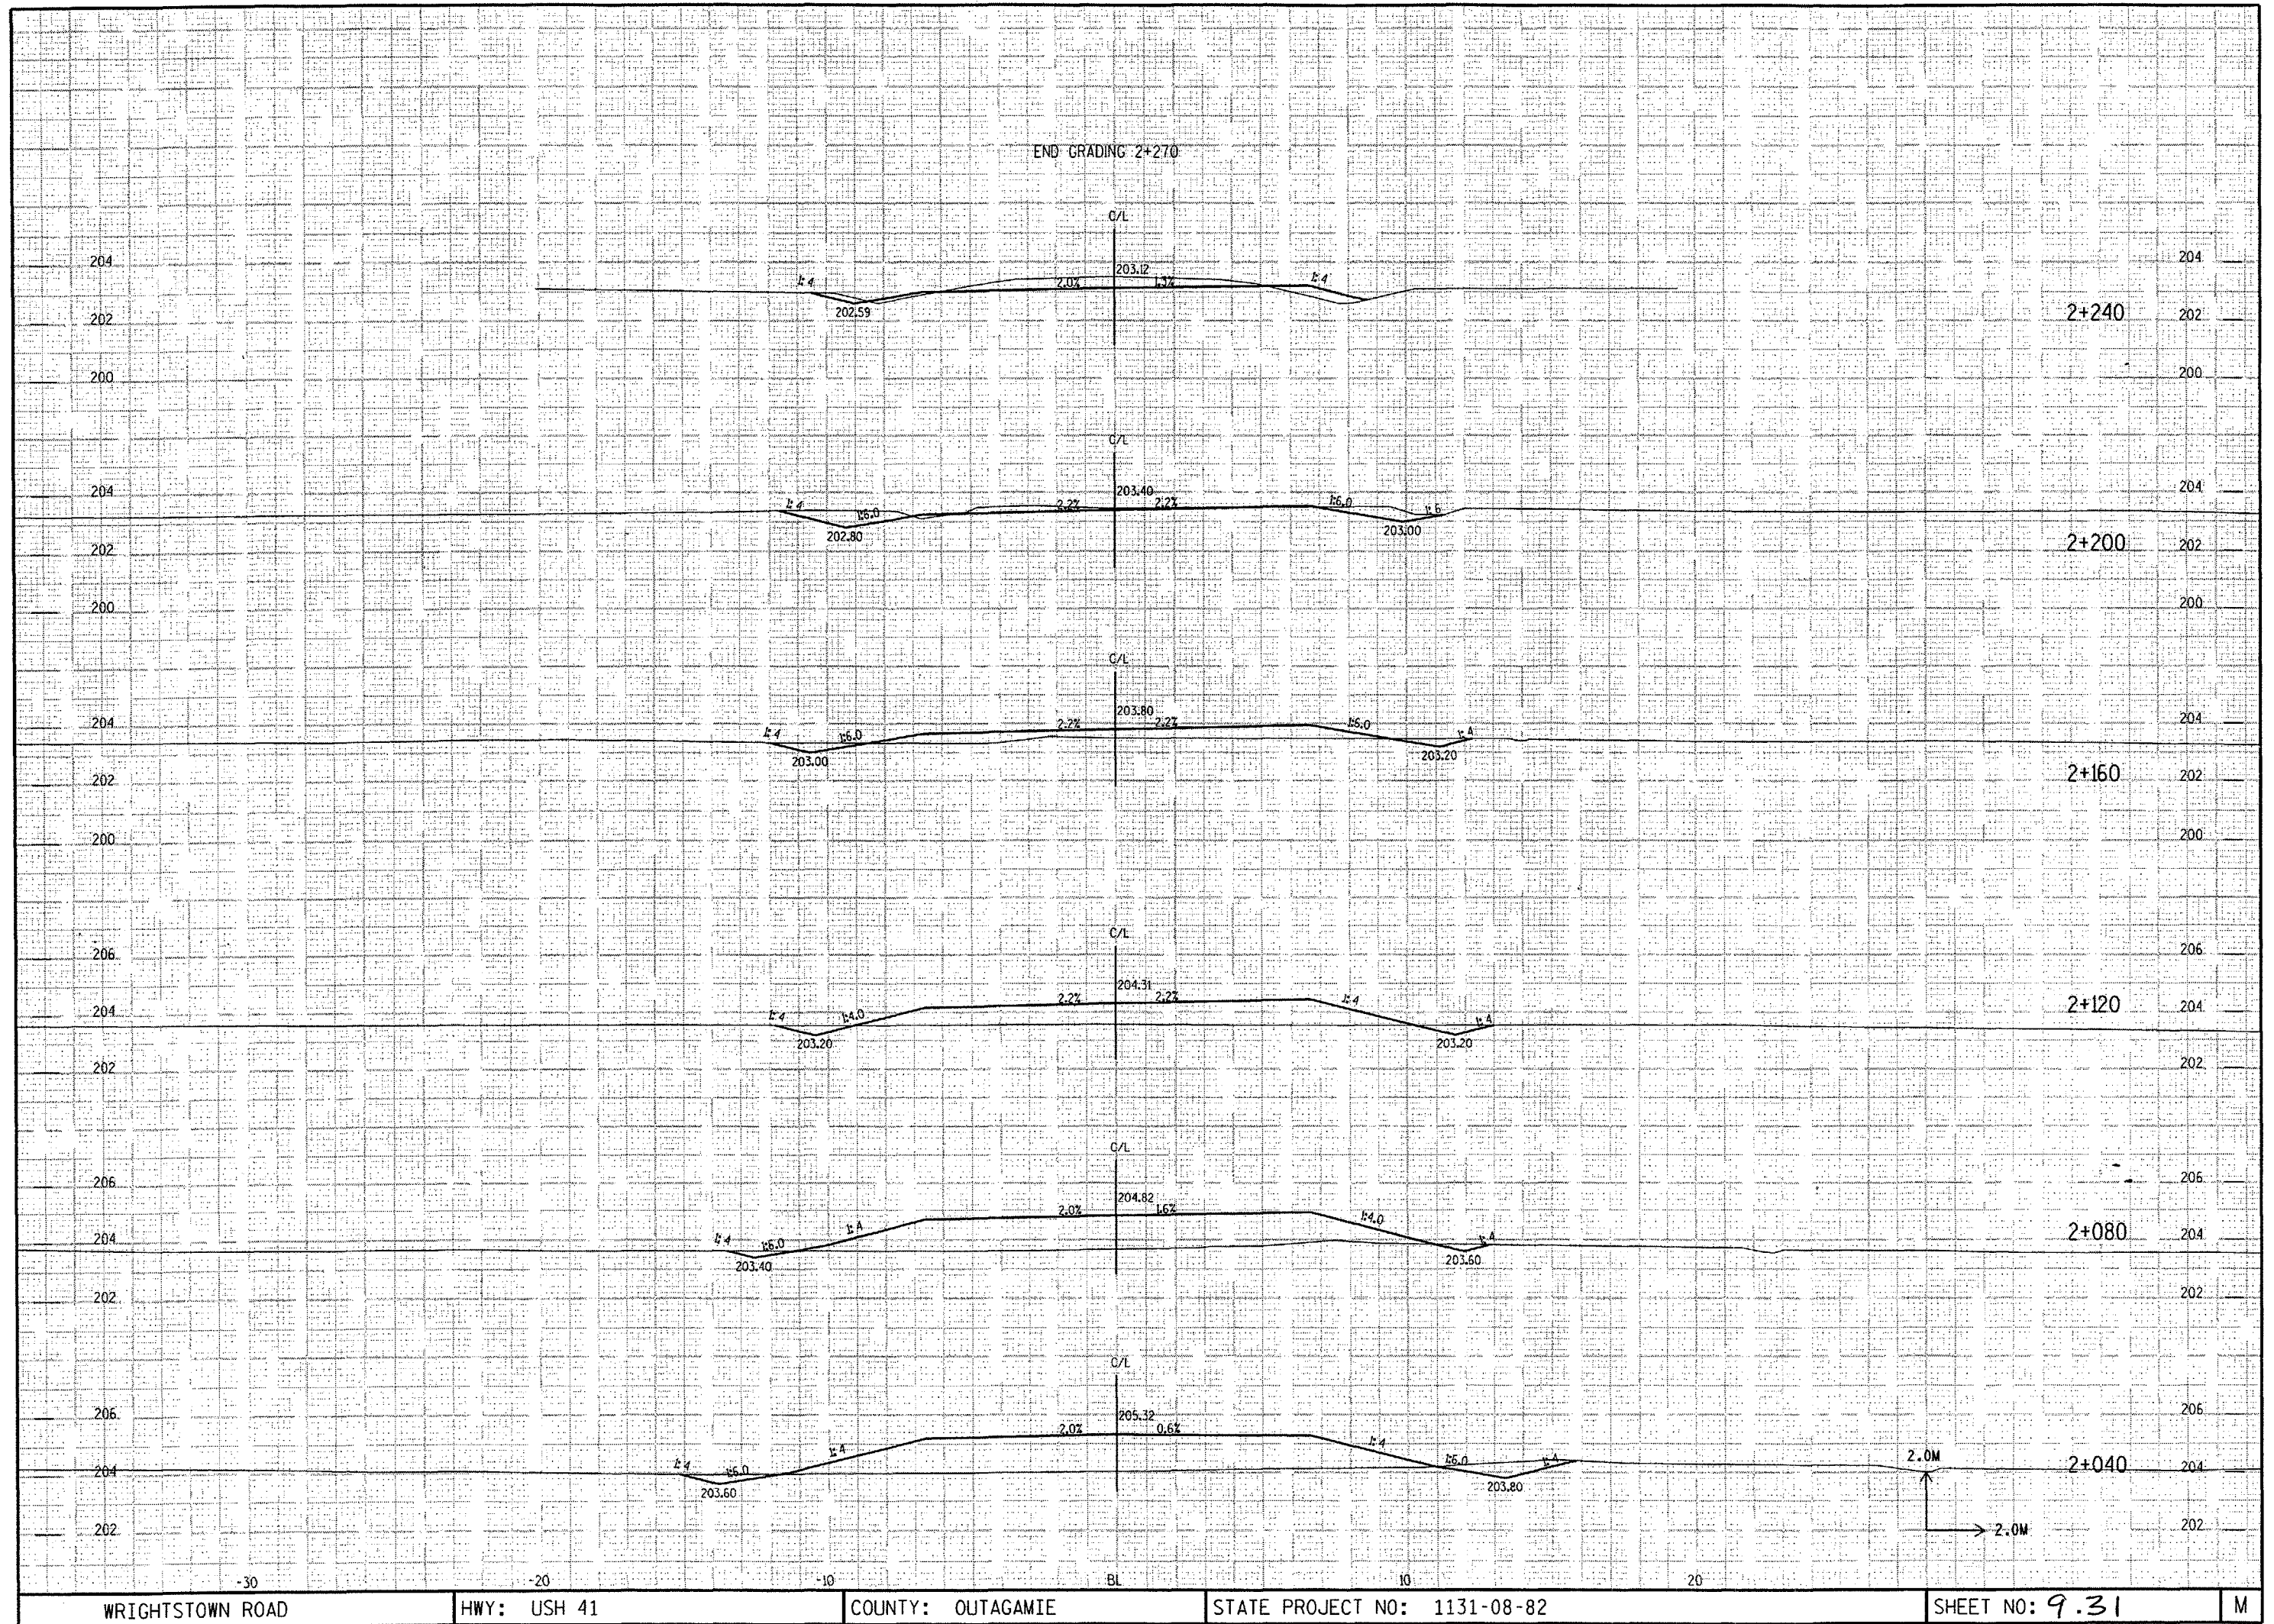

WRIGHTSTOWN ROAD

HWY: USH 41


COUNTY: OUTAGAMIE

STATE PROJECT NO: 1131-08-82


SHEET NO: 9.31

M

ccs Tue 11/09/1999 10:32:35 AM C:\USERS\p+d3\110882\MT-line.dgn

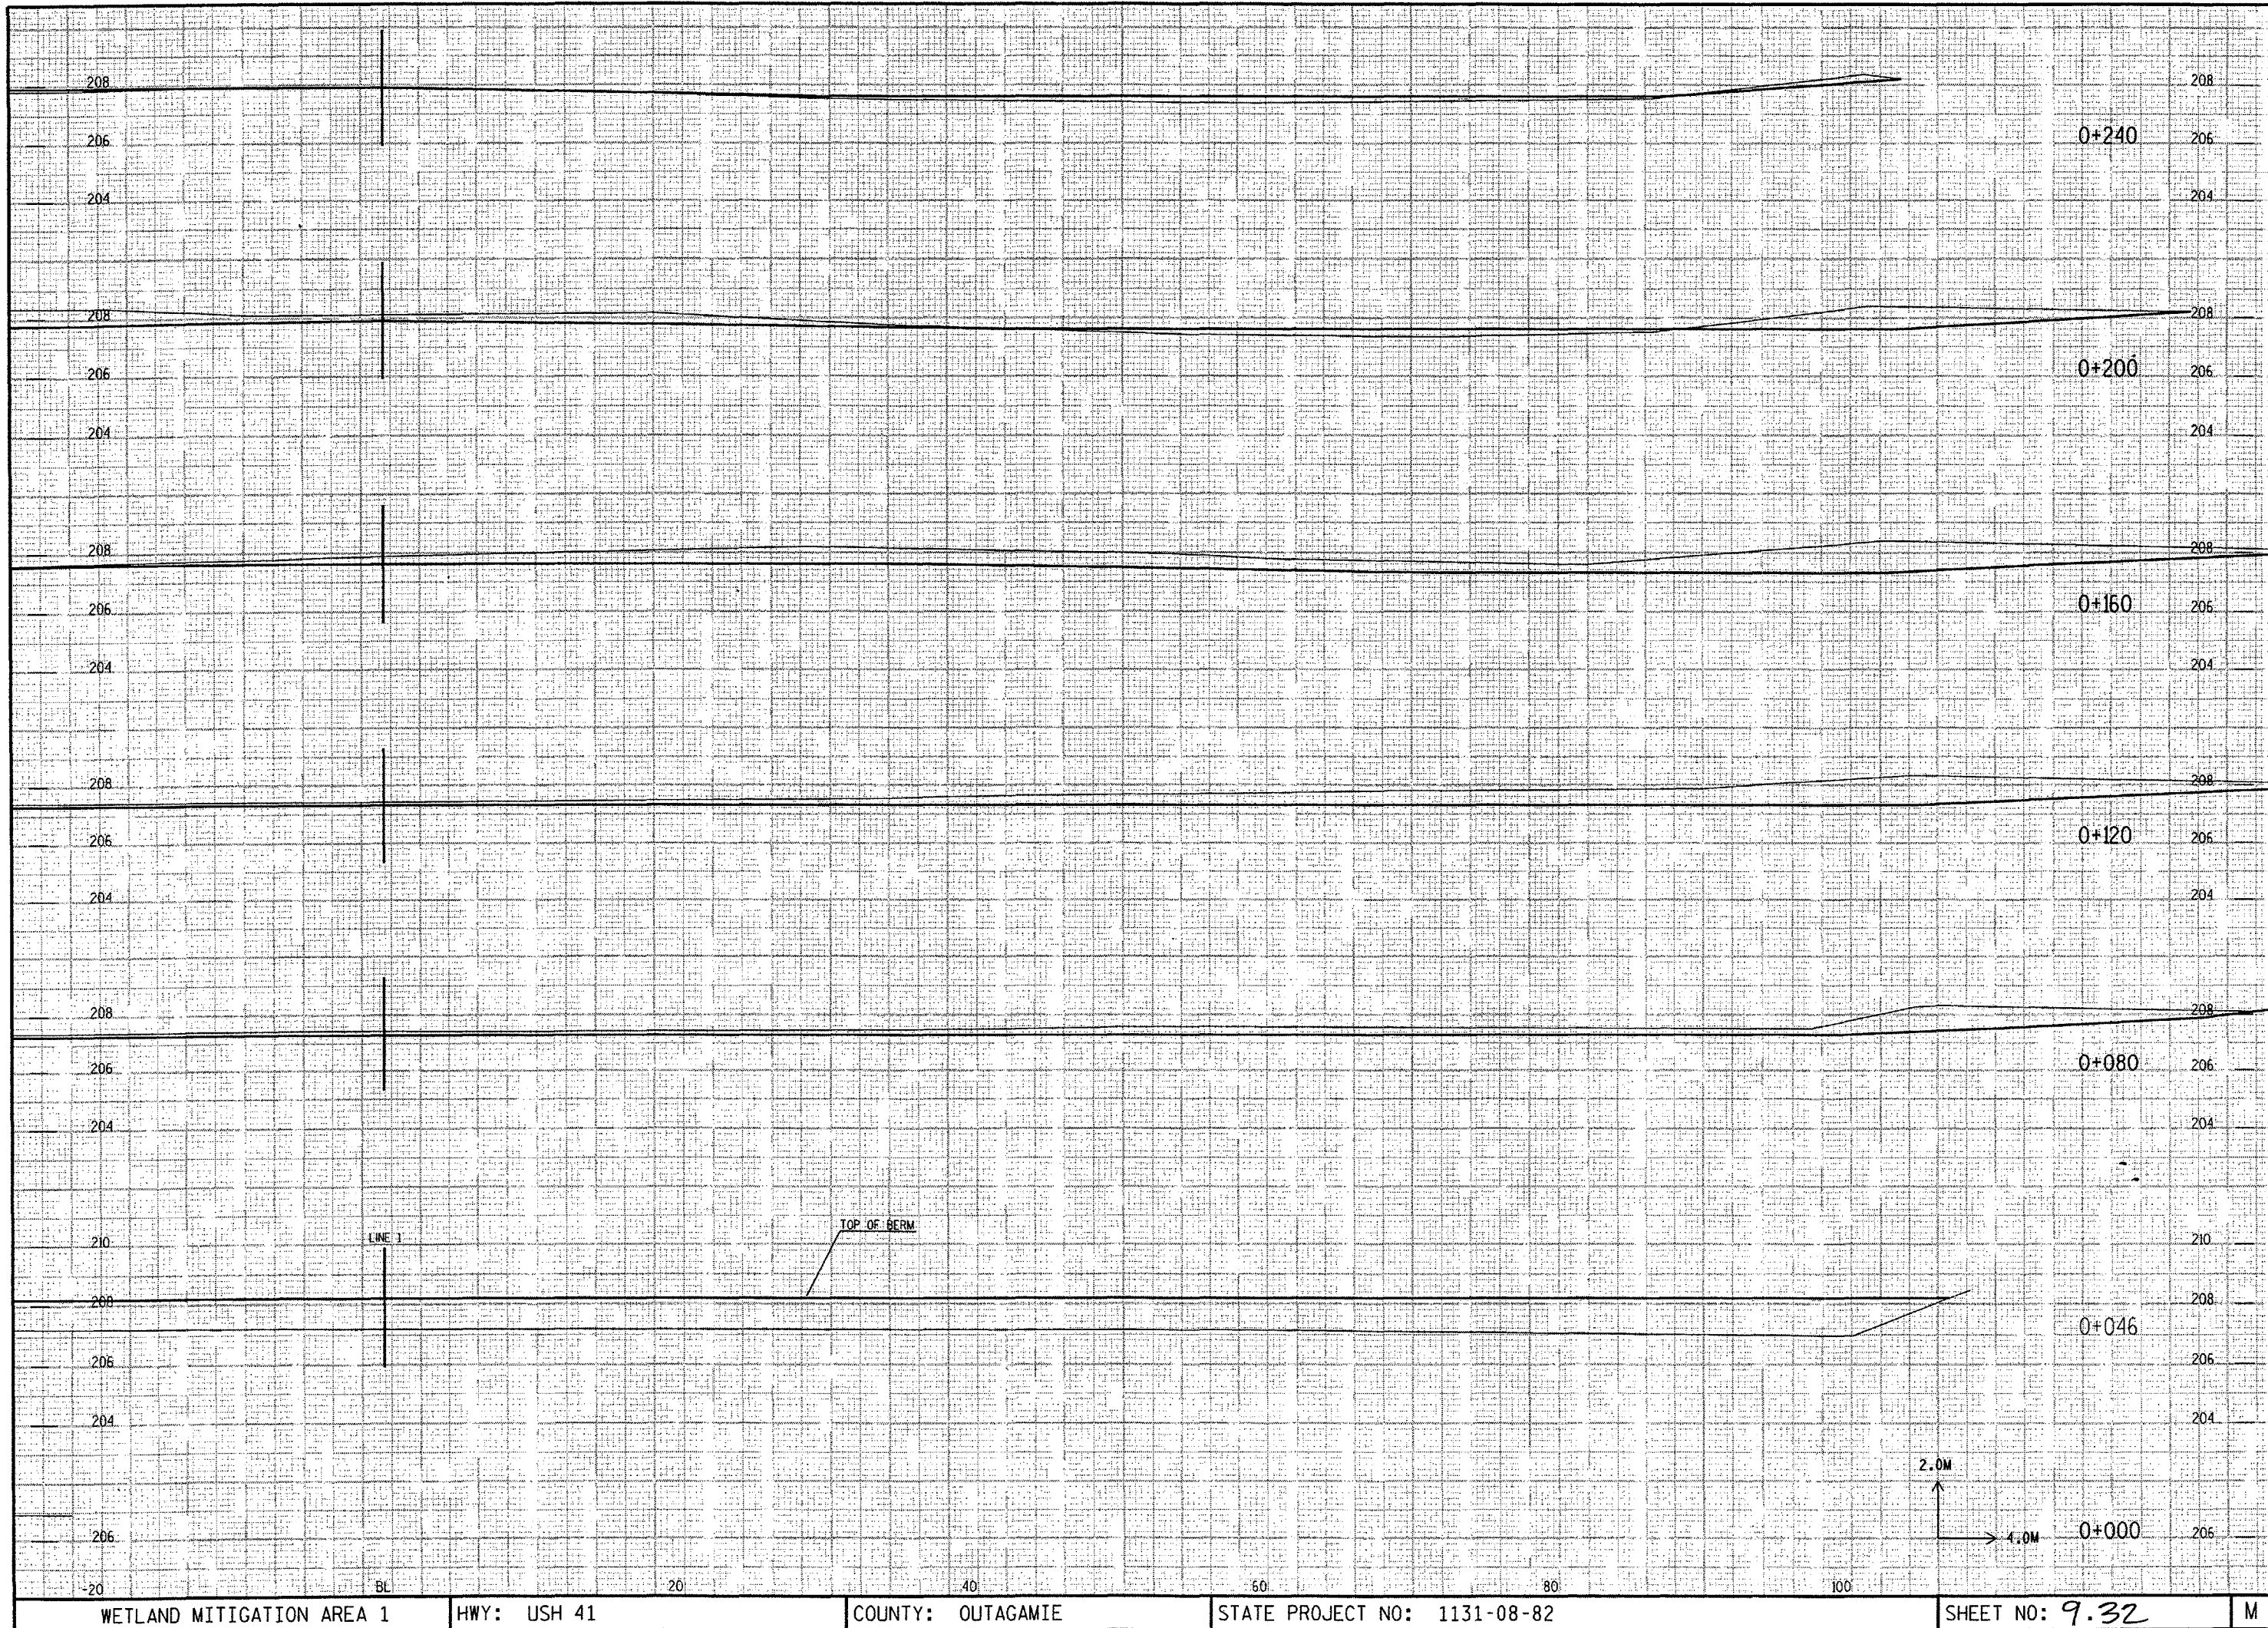

CCS Tue 11/09/1999 10:32:35 AM C:\USERS\p\d3\1131082\MT\line1.dgn

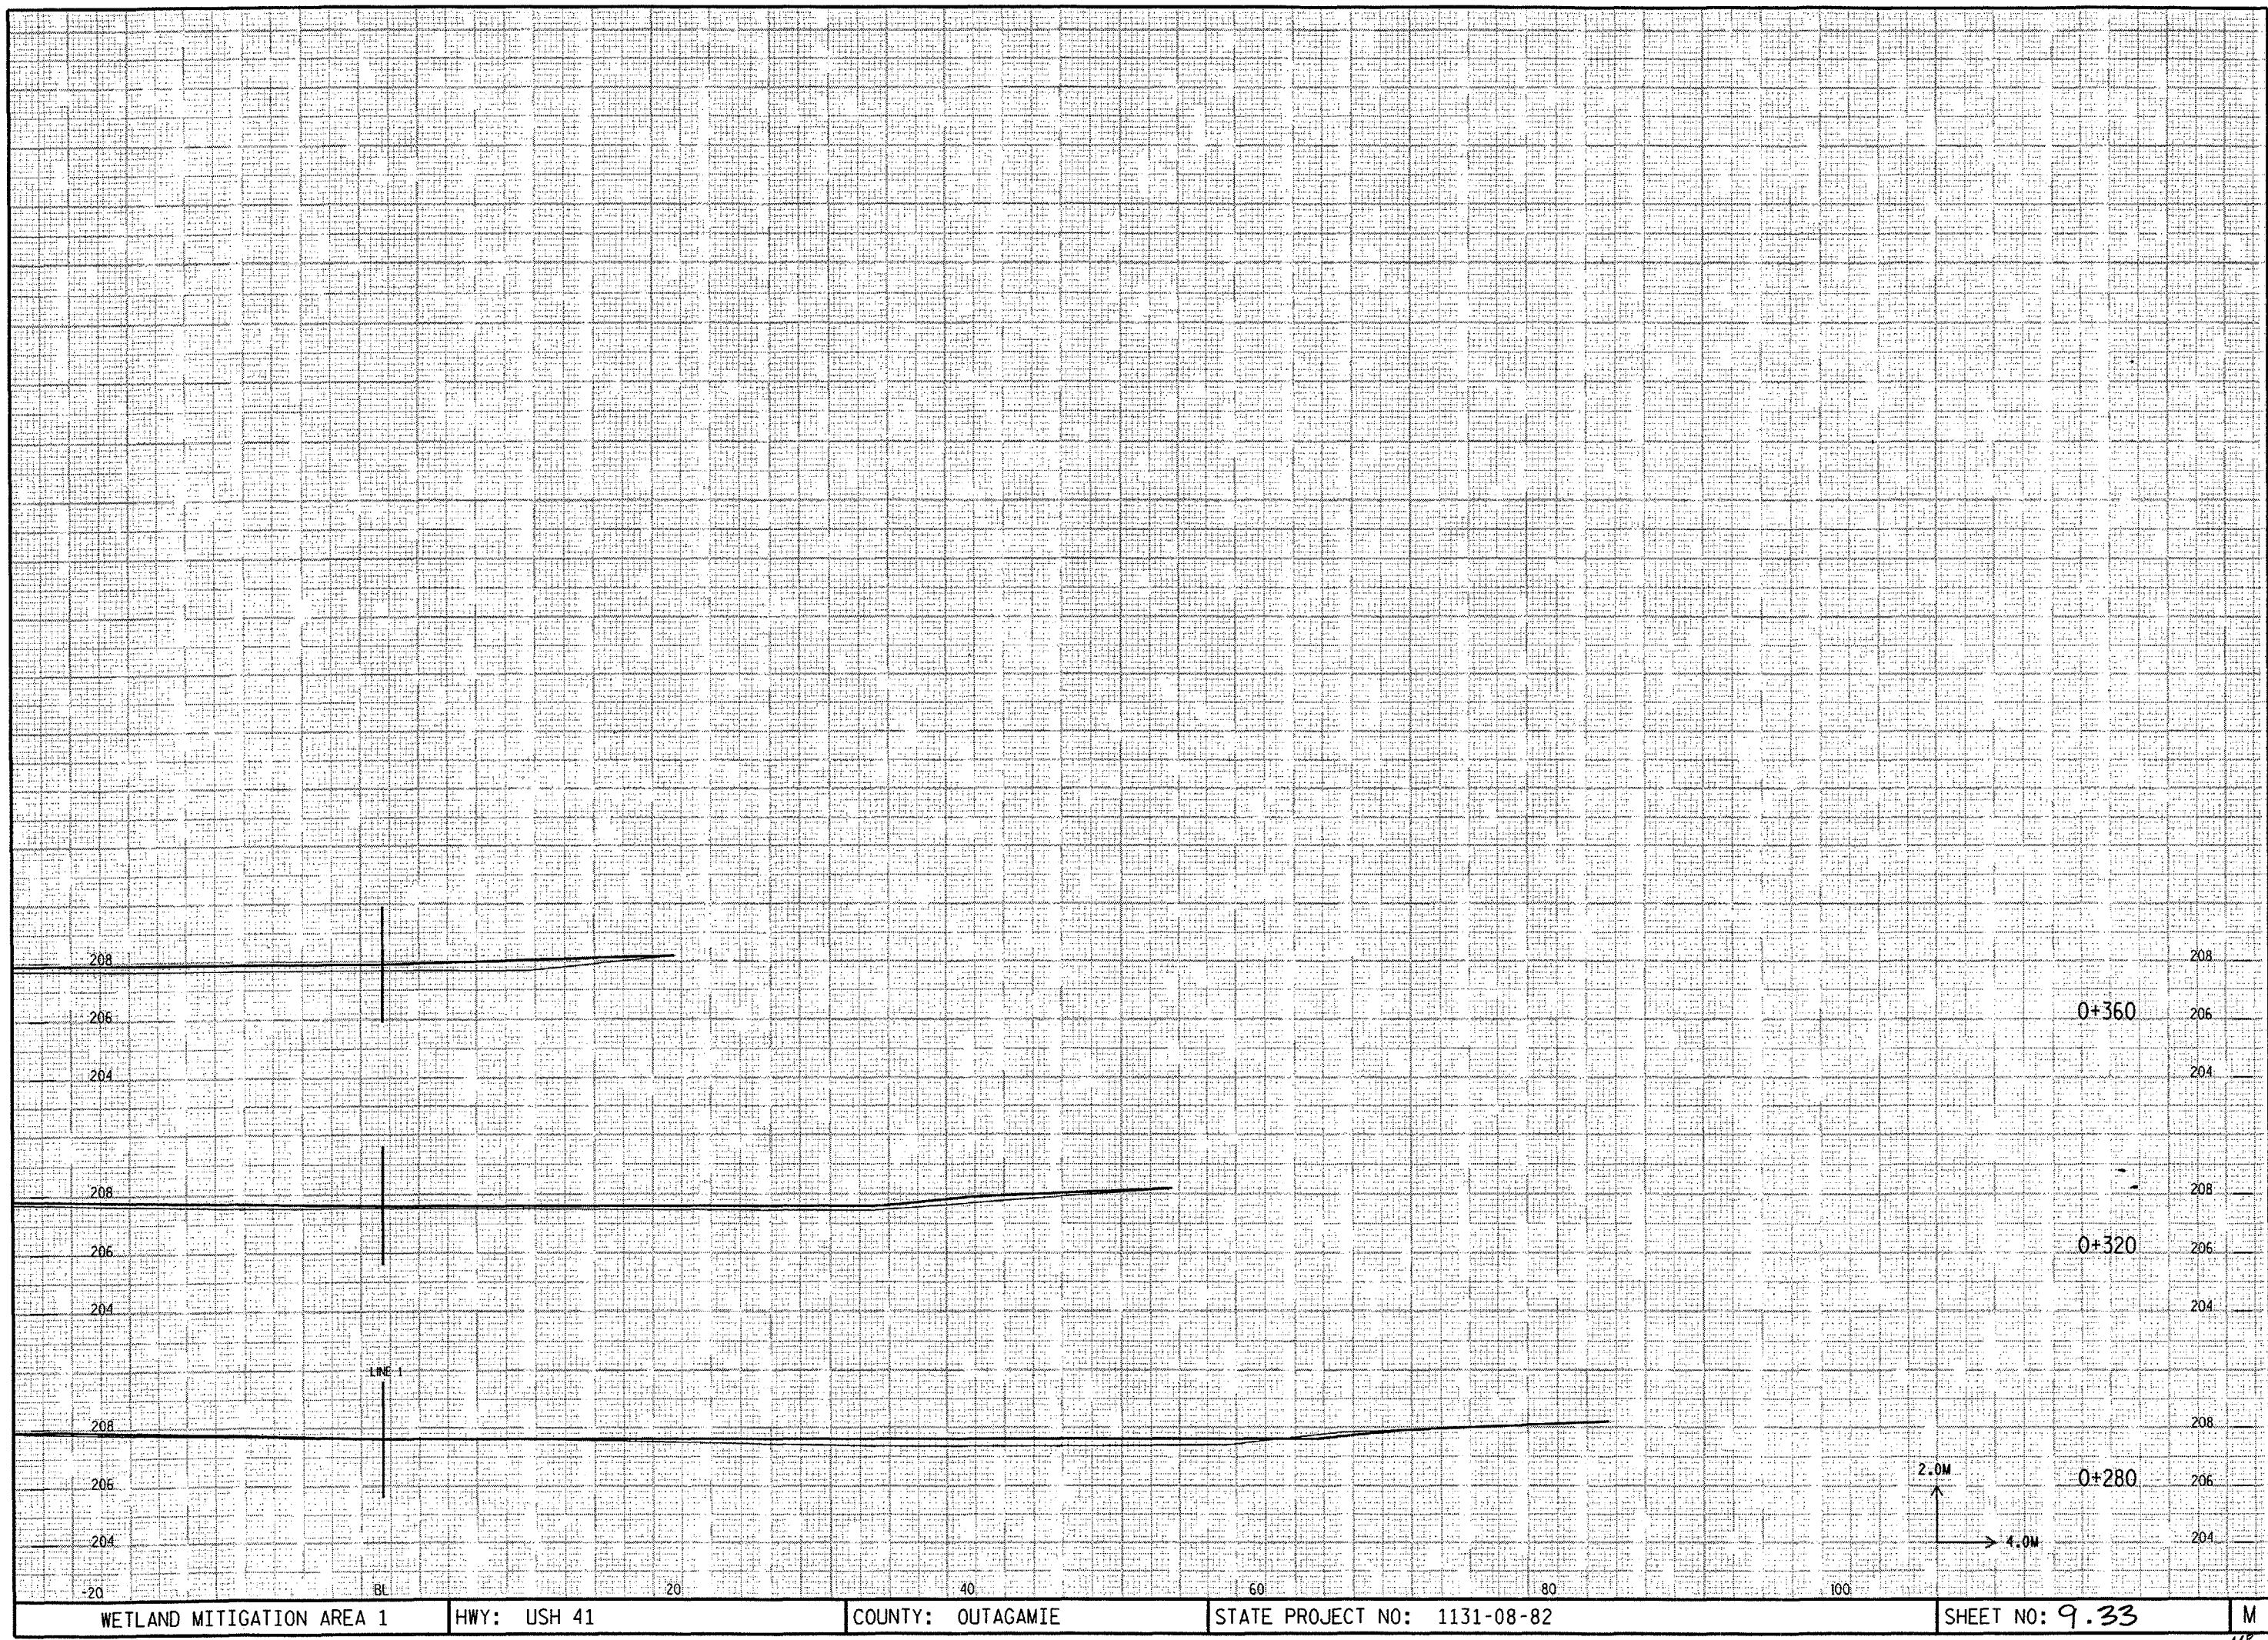

WETLAND MITIGATION AREA 1

HWY: USH 41


COUNTY: OUTAGAMIE

STATE PROJECT NO: 1131-08-82

SHEET NO: 9.33

M

10/09/1999 10:53:33 AM C:\USERS\p\p341\10862\MT\line1a.dgn

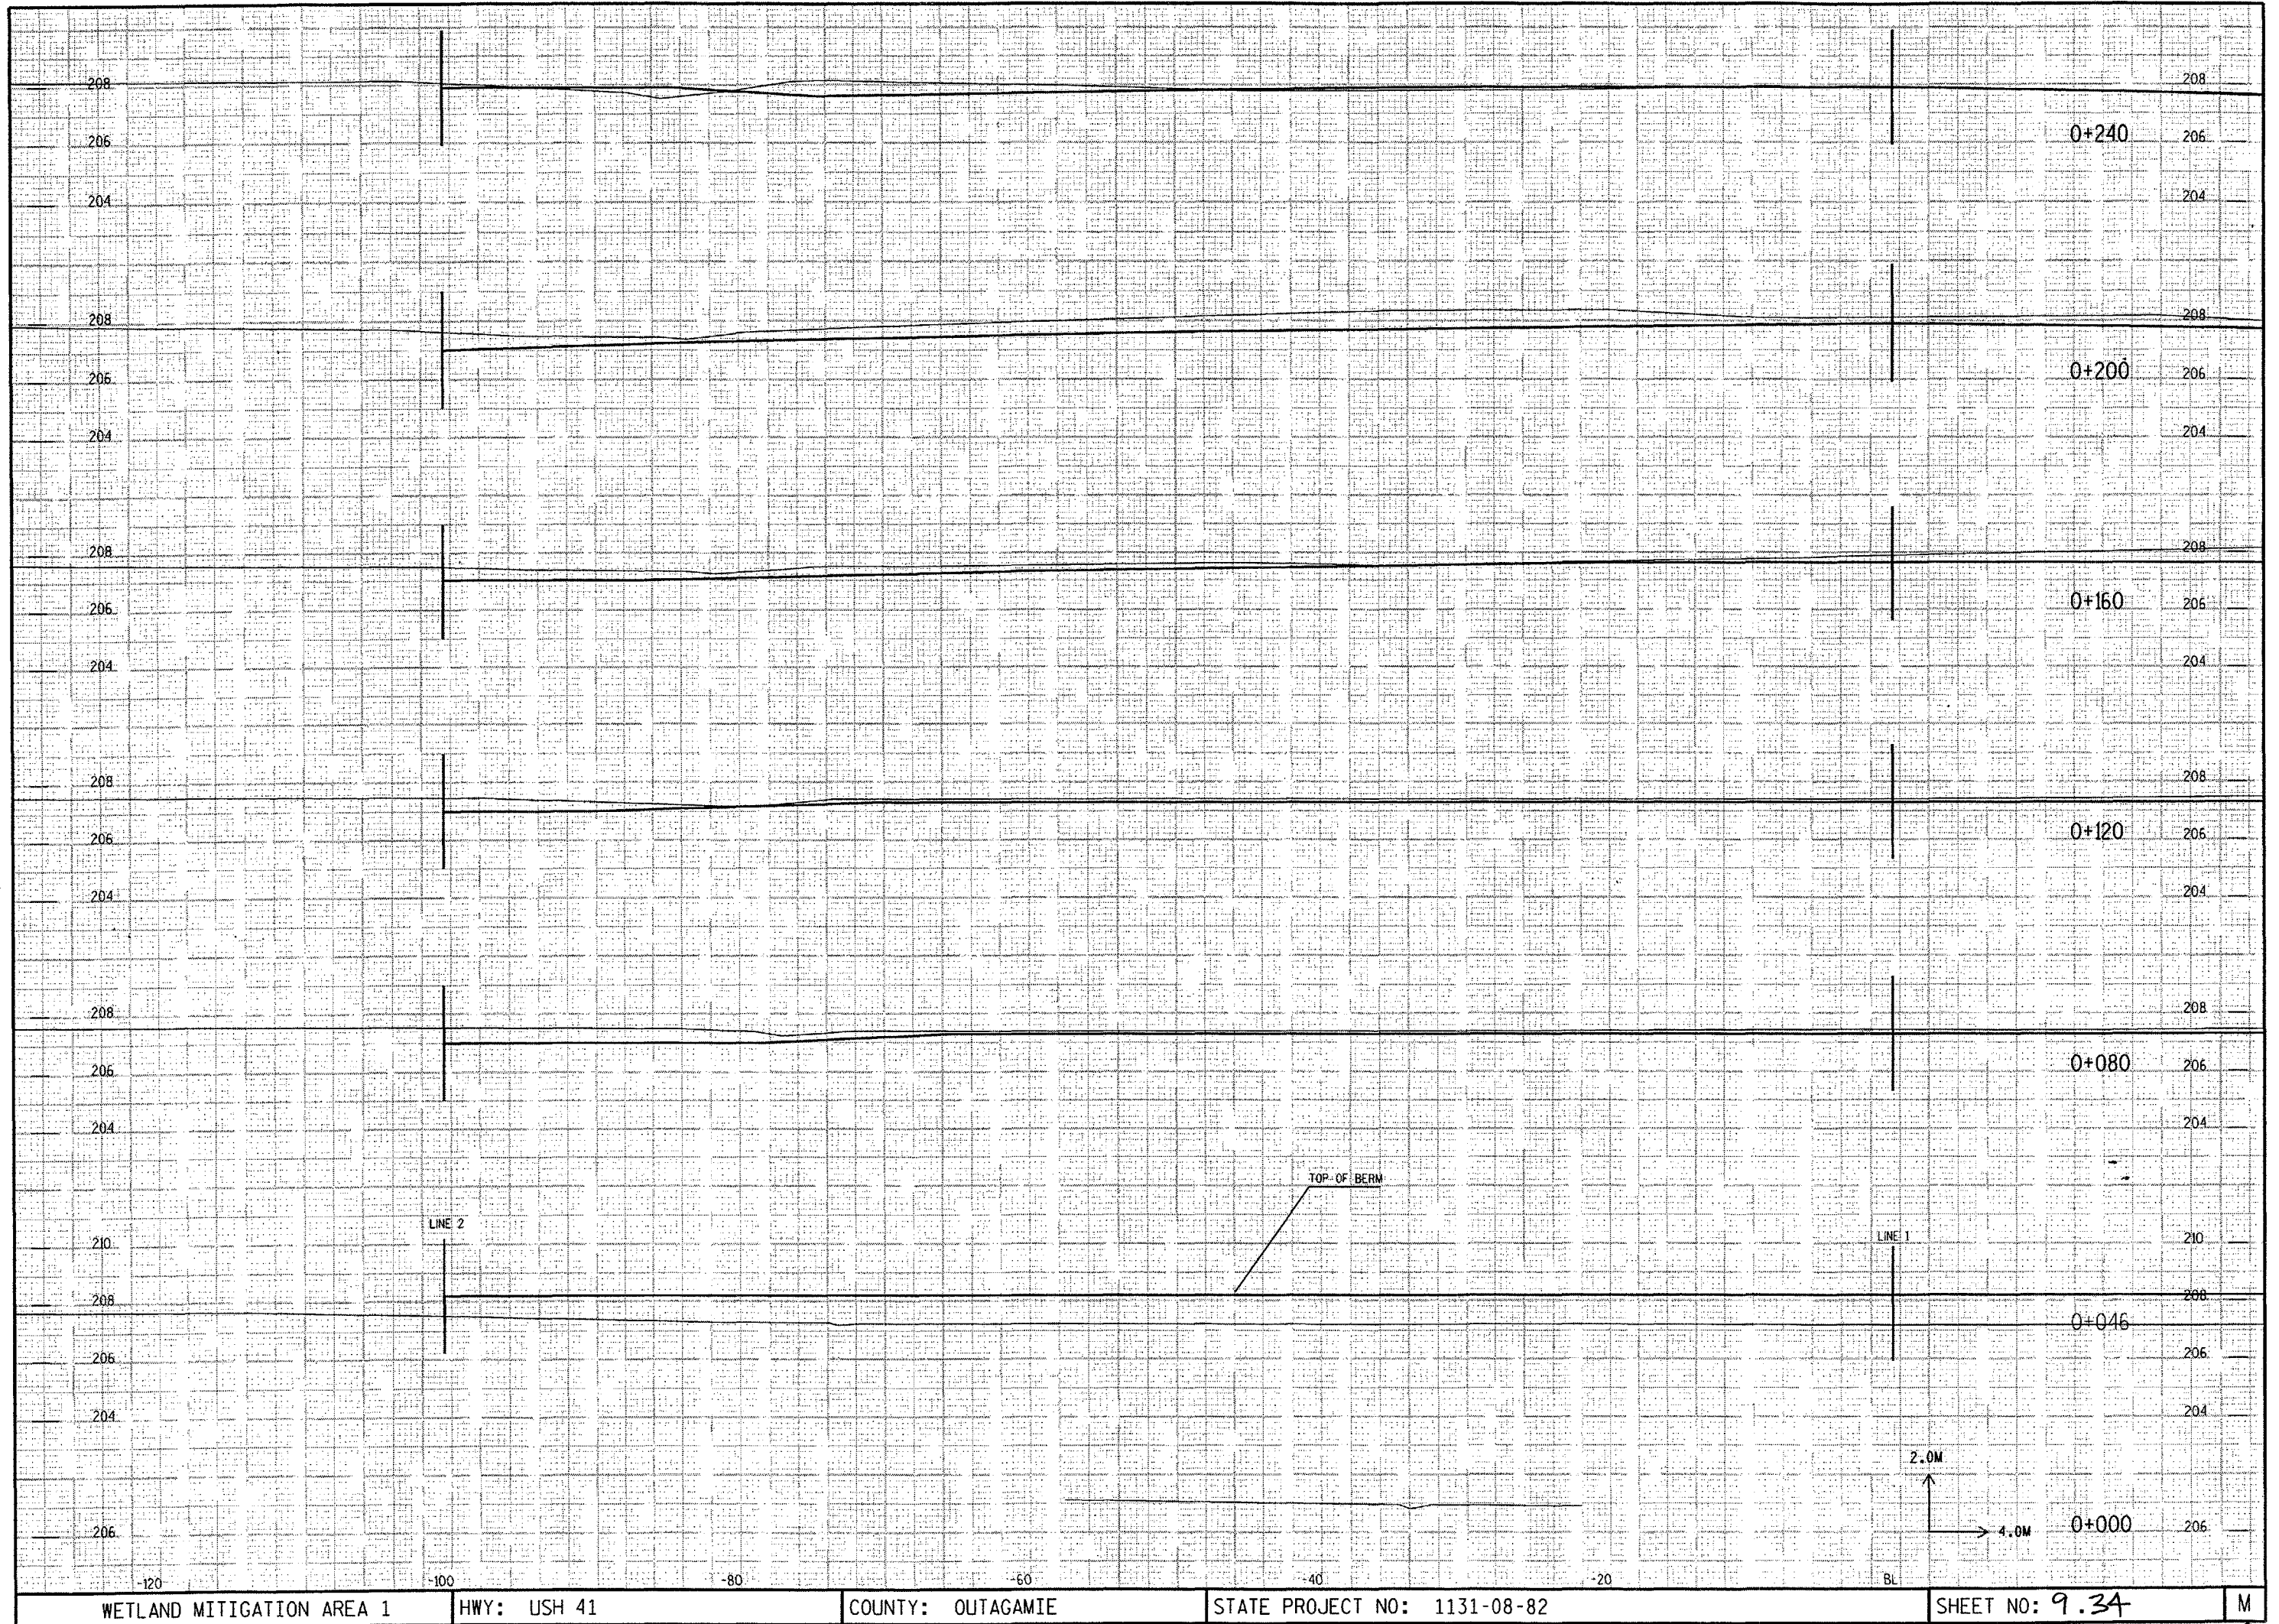

WETLAND MITIGATION AREA 1

HWY: USH 41

COUNTY: OUTAGAMIE


STATE PROJECT NO: 1131-08-82

SHEET NO: 9.34

M

119

C:\Users\p131131082\MT\line1a.dgn

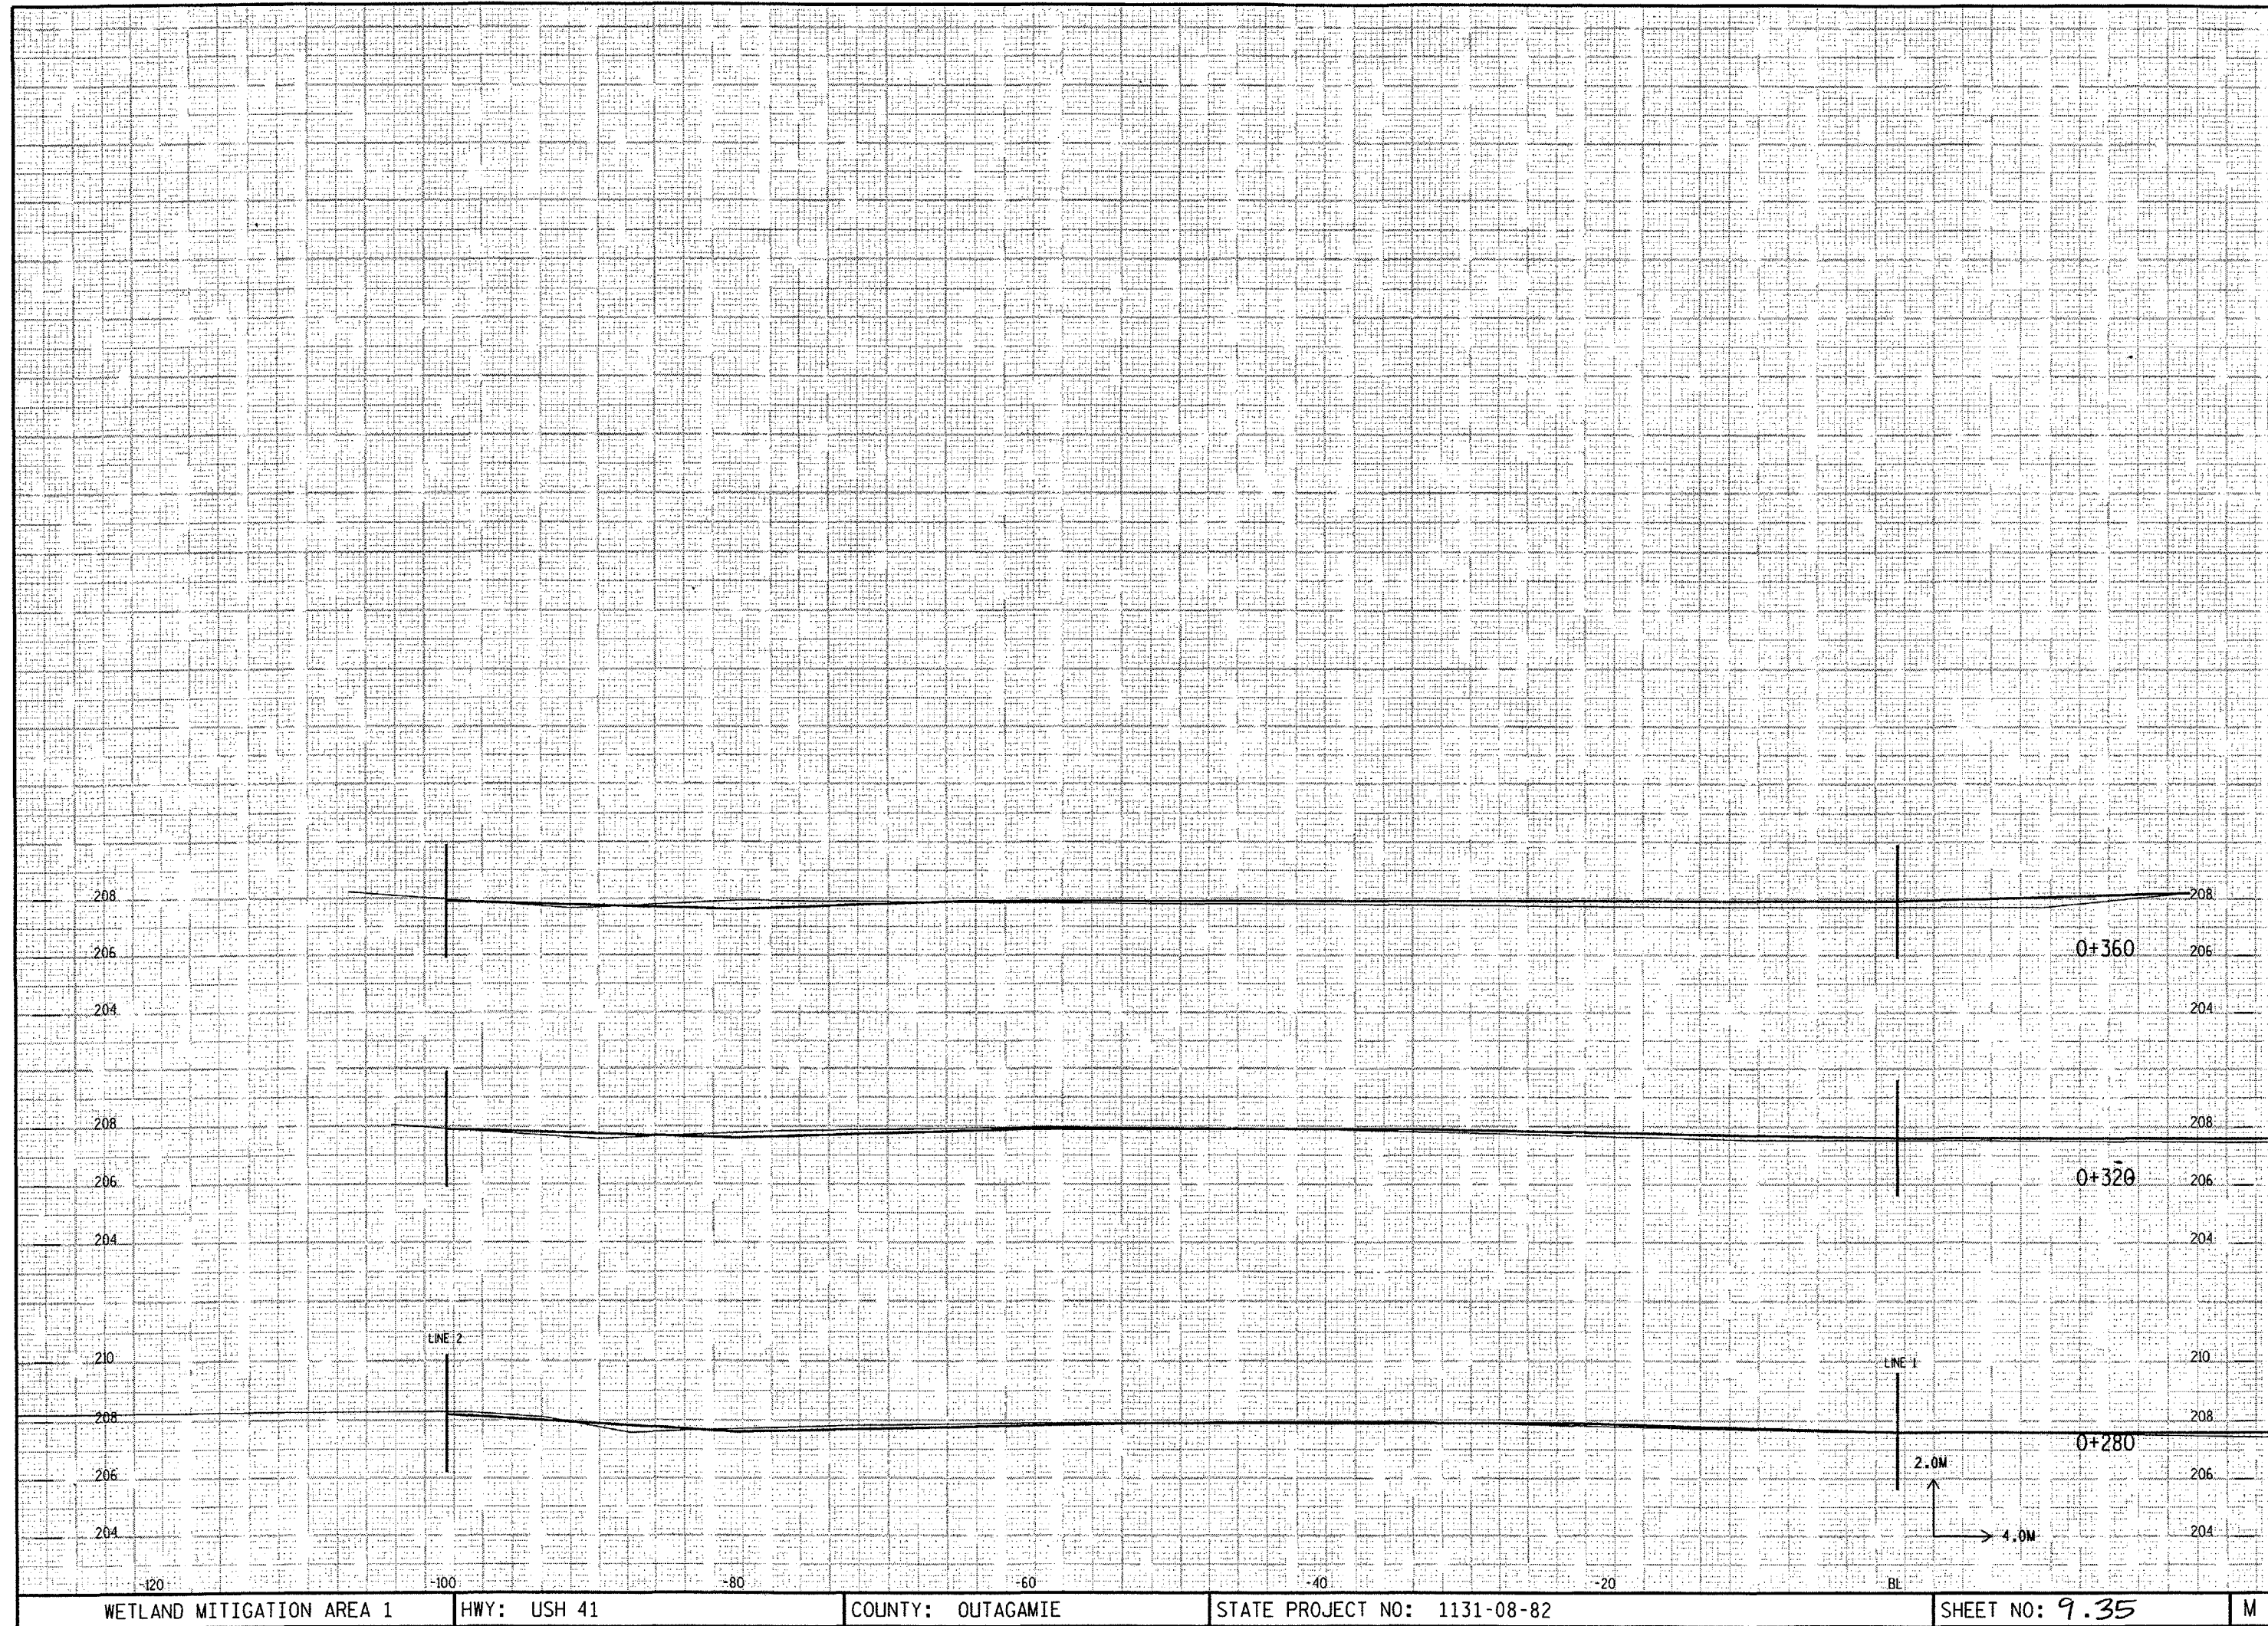

WETLAND MITIGATION AREA 1

HWY: USH 41


COUNTY: OUTAGAMIE

STATE PROJECT NO: 1131-08-82

SHEET NO: 9.35

M

C:\Users\p31131082\MT\11162.dgn

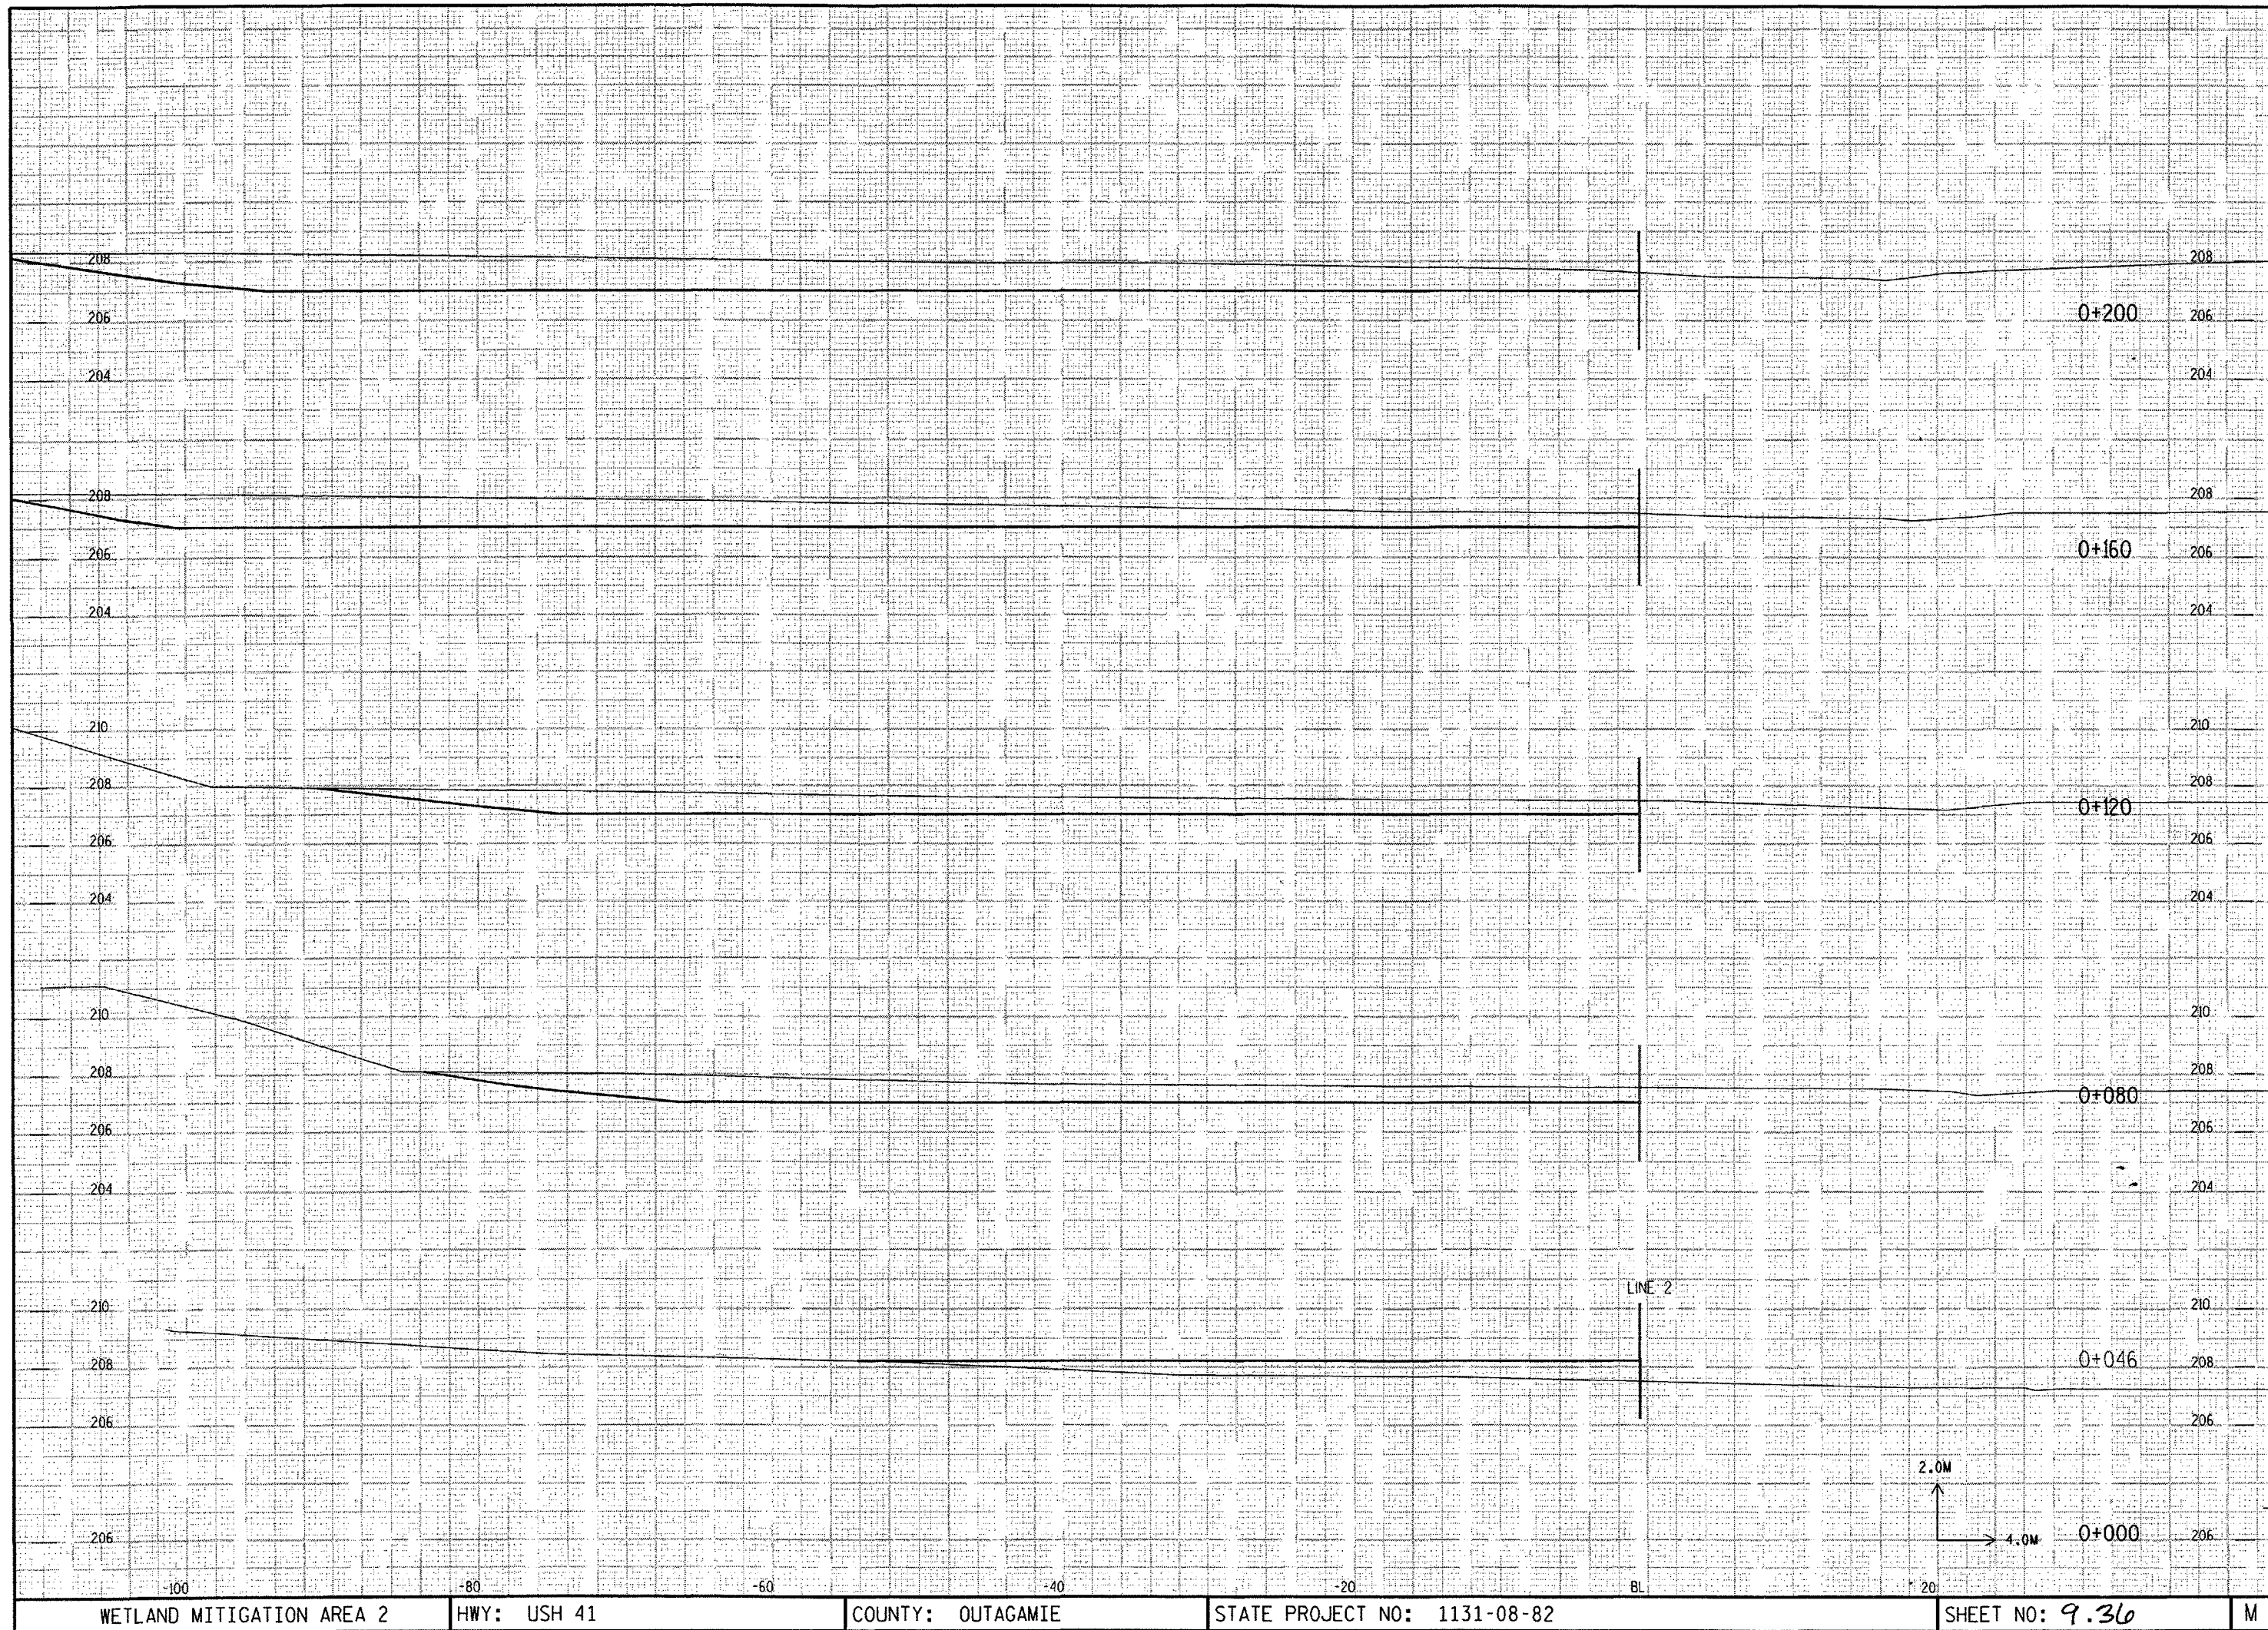

WETLAND MITIGATION AREA 2

HWY: USH 41

COUNTY: OUTAGAMIE

STATE PROJECT NO: 1131-08-82

SHEET NO: 9.36

M