
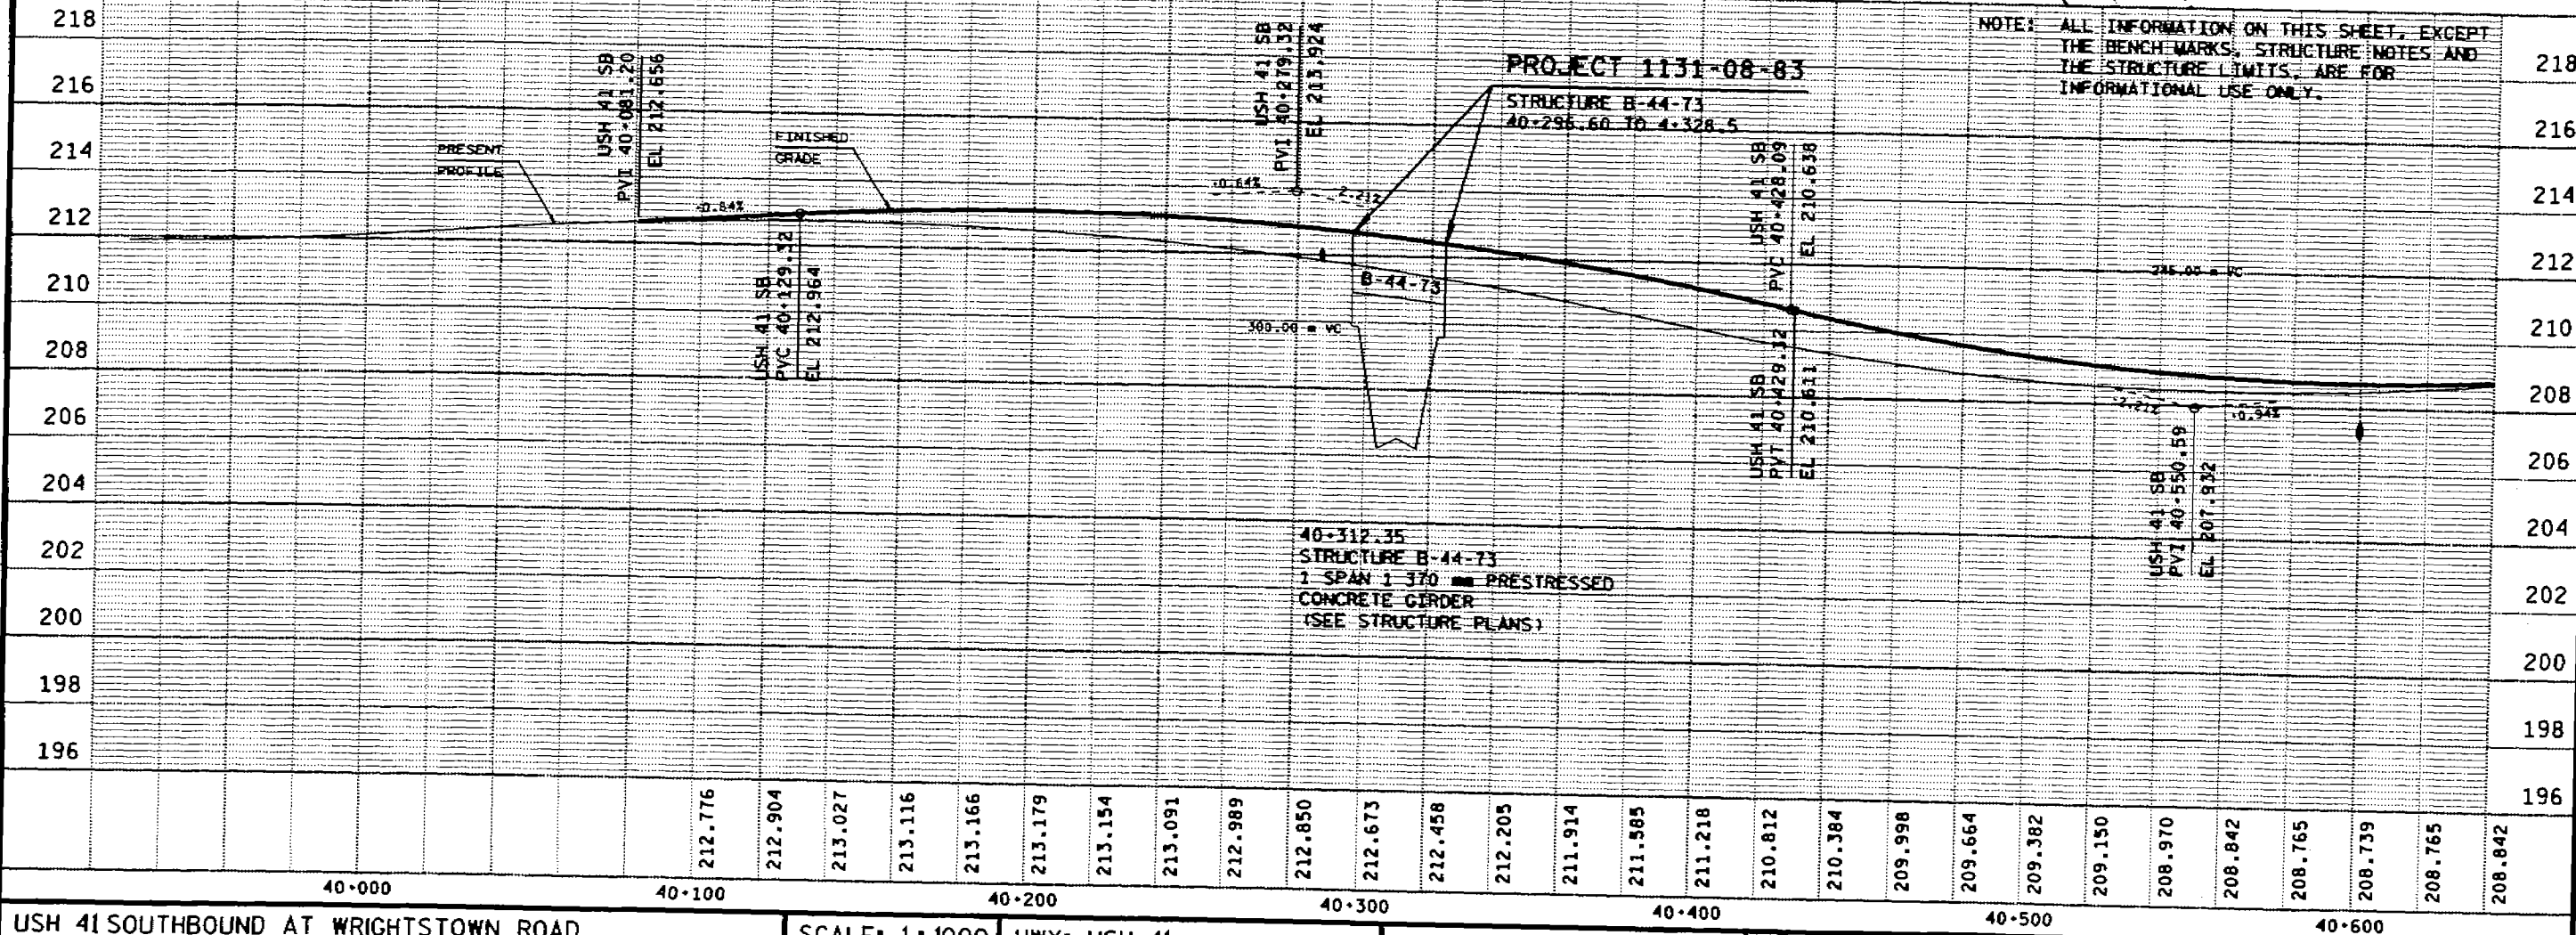


BENCH MARKS

NO.	STATION	DESCRIPTION	ELEV.
604	40+257	30.48" RT. SP. POWER POLE SE. 00 WRIGHTSTOWN RD. & NB 41	213.159
604	40+503	147.5" RT. MED. USH 41, TOP WELL CAP, RITE PRODUCT COMPANY	202.723
		CAP ON WINGWALL, SE, NB STRUCTURE B-44-74	213.842
		CAP ON NW WINGWALL, SB STRUCTURE B-44-73	213.174

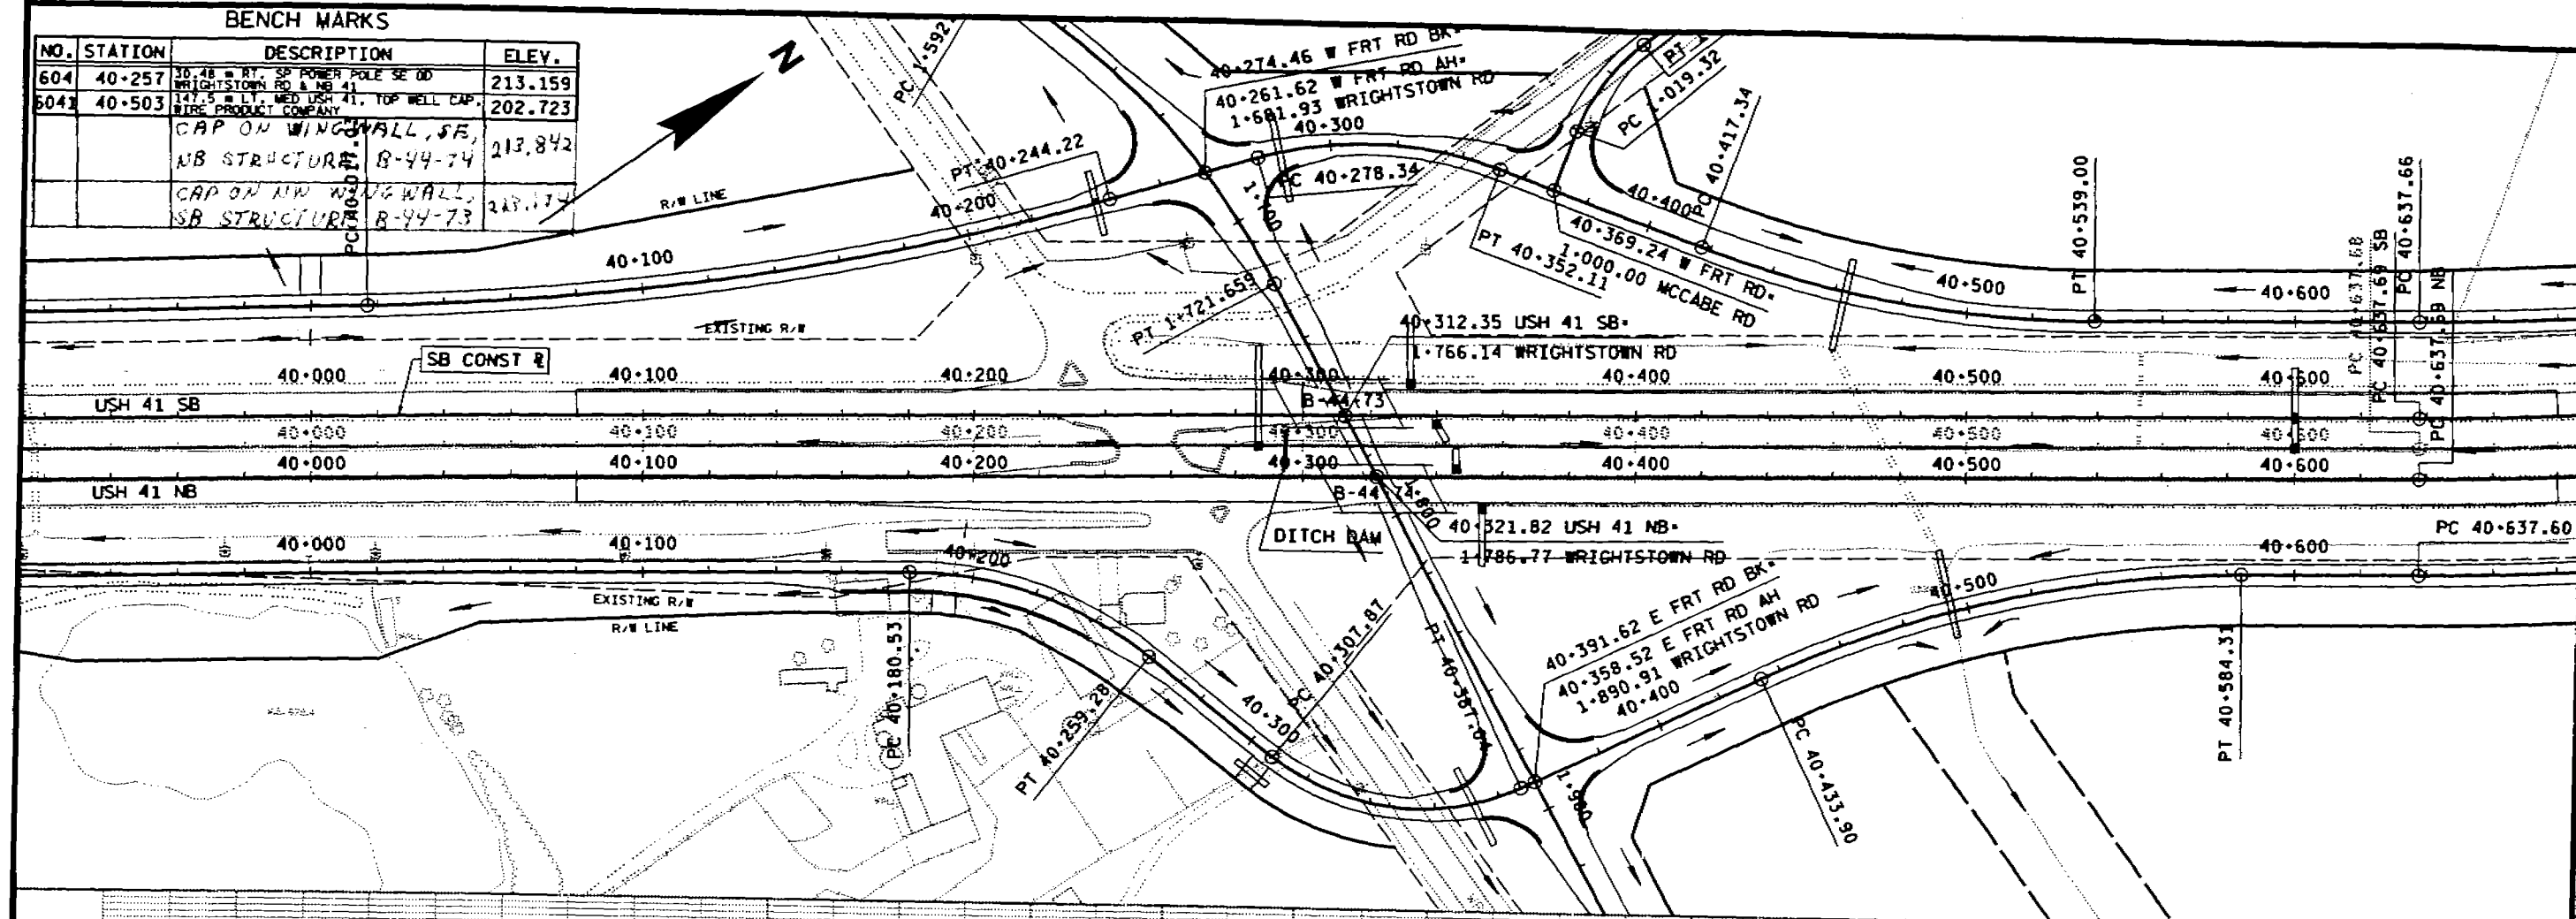

NOTE: ALL INFORMATION ON THIS SHEET, EXCEPT THE BENCH MARKS, STRUCTURE NOTES AND THE STRUCTURE LIMITS, ARE FOR INFORMATIONAL USE ONLY.

PROJECT 1131-08-83

STRUCTURE B-44-73
40+298.60 TO 4+328.5

40+312.35
STRUCTURE B-44-73
1 SPAN 1370 PRESTRESSED
CONCRETE GIRDER
(SEE STRUCTURE PLANS)

USH 41 SOUTHBOUND AT WRIGHTSTOWN ROAD

SCALE: 1:1000 HWY: USH 41

COUNTY: OUTAGAMIE

STATE PROJECT NO: 1131-08-83

SHEET NO: 5.1

M

PLOT SCALE: 1:1

PLOT NAME: 5066d

REV. DATE: 10-22-99

8-5-96


ORIGINATOR: BALDWIN

LEVELS ON: 1, 2, 3, 62, 63

FILE NAME: D3 113108m:5066d.dgn

BENCH MARKS


NO.	STATION	DESCRIPTION	ELEV.
601	38+091	60.95 RT CHISEL SQUARE NW BOLT BILLBOARD BASE	211.105
600	38+374	59.05 RT CHISEL NE BOLT RR SIGNAL BASE, 215 CTH JJ	212.534
		CAP ON SE WINGWALL, NB STRUCTURE B-44-72	215.981
		CAP ON NW WINGWALL, SB STRUCTURE B-44-71	215.475

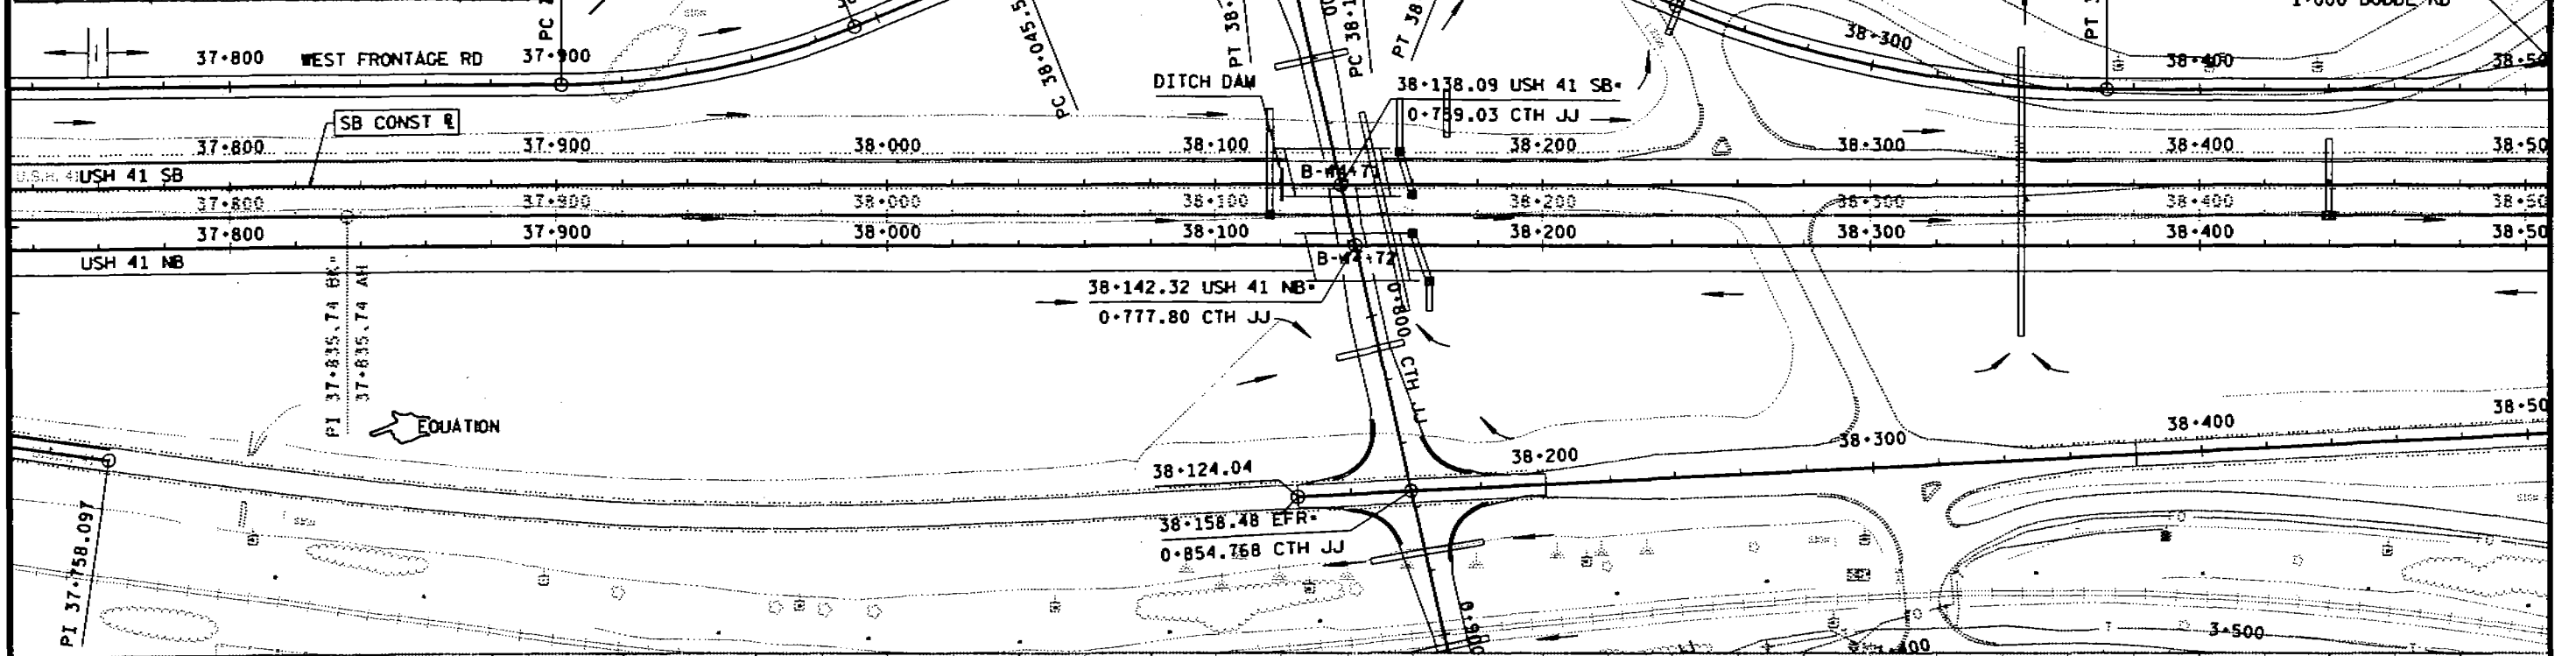

NOTE: ALL INFORMATION ON THIS SHEET, EXCEPT THE BENCH MARKS, STRUCTURE NOTES AND THE STRUCTURE LIMITS, ARE FOR INFORMATIONAL USE ONLY.

PROJECT 1131-08-83

STRUCTURE B-44-71
38+122.58 TO 38+152.50

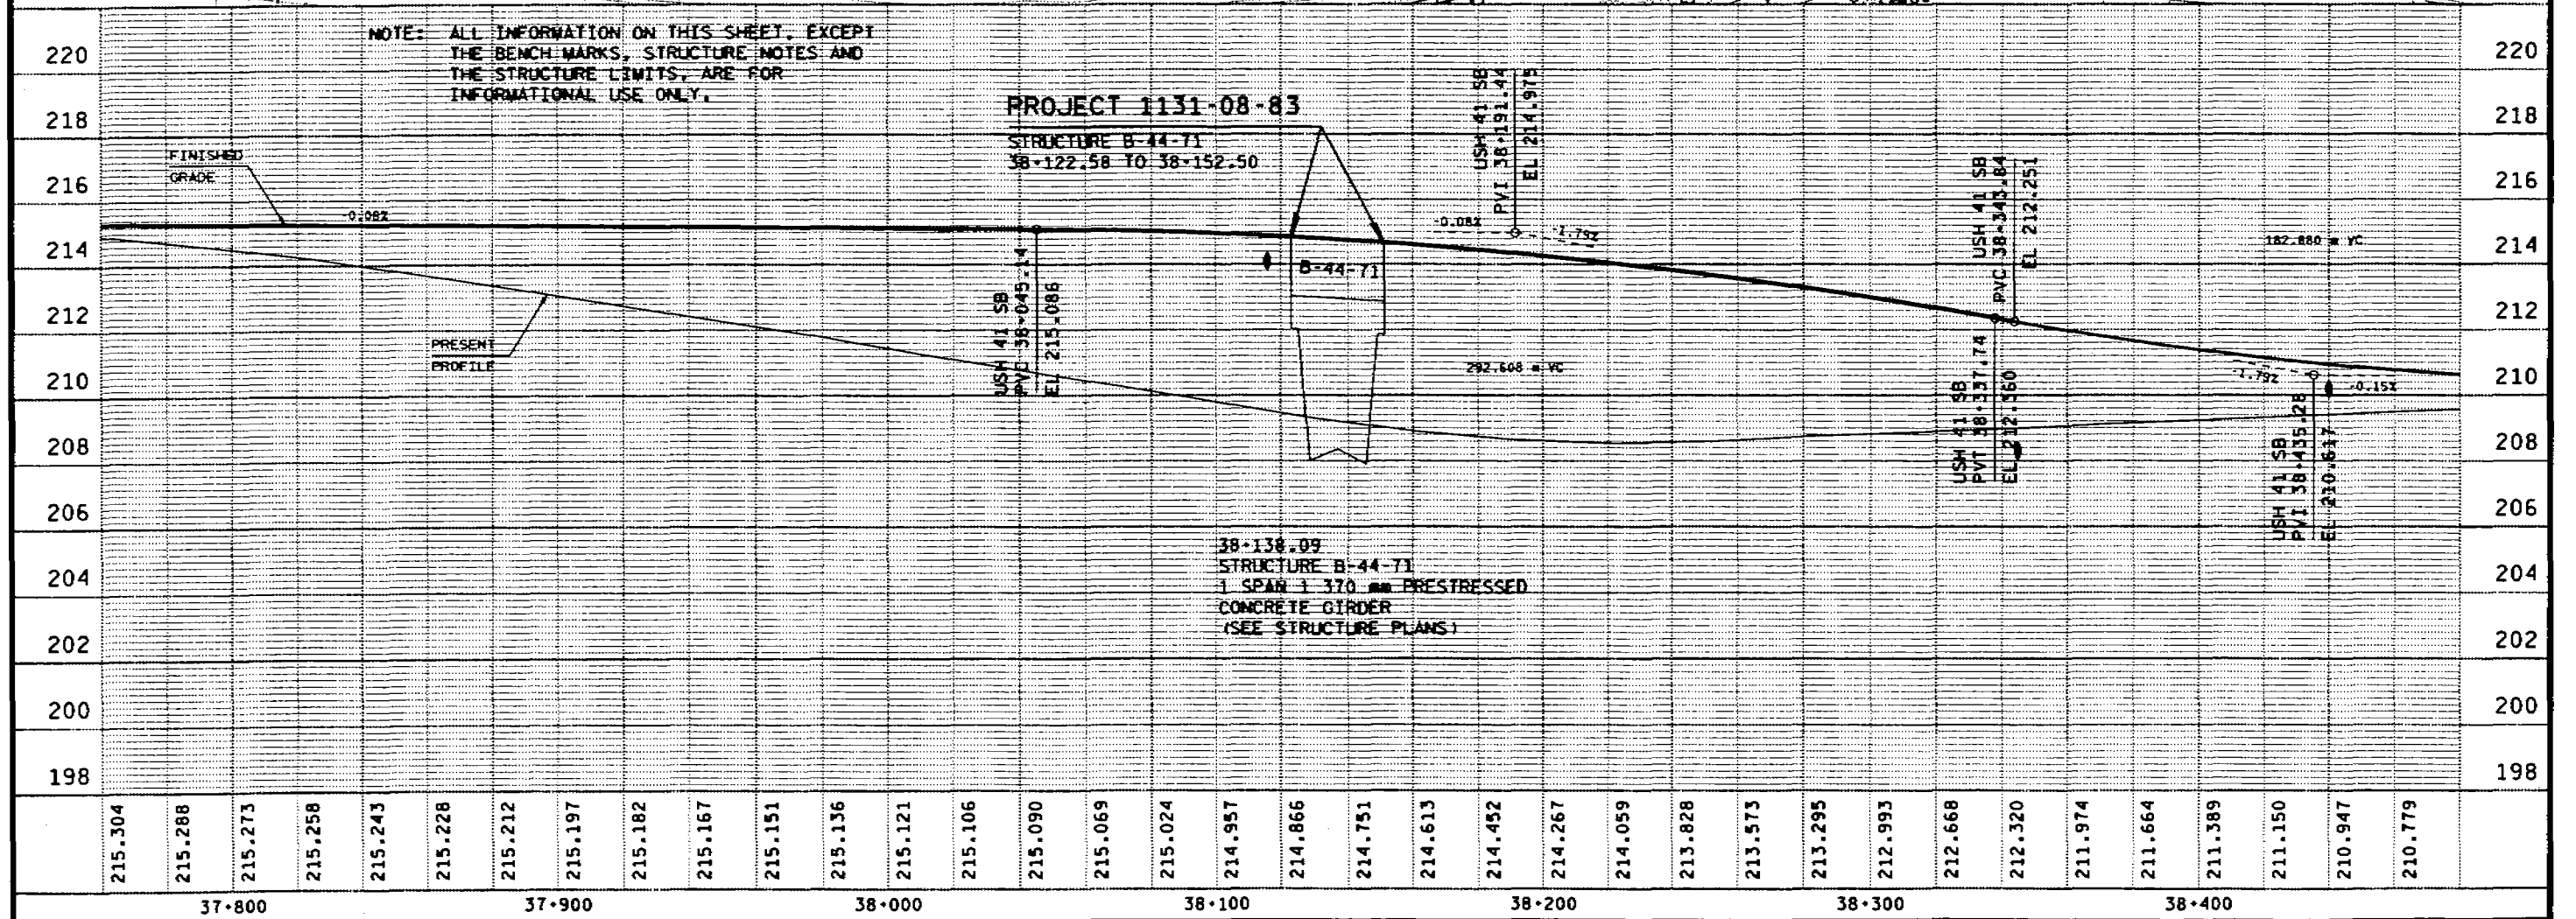

38+138.09
STRUCTURE B-44-71
1 SPAN 1 370 mm PRESTRESSED
CONCRETE GIRDER
(SEE STRUCTURE PLANS)

SOUTHBOUND

SCALE: 1:1000 HWY: USH 41

COUNTY: OUTAGAMIE

STATE PROJECT NO: 1131-08-83

SHEET NO: 5.2

M

PLOT SCALE: 1:1

PLOT NAME: 503sb

REV. DATE: 10-22-99

7-8-96

ORIGINATOR: BALDWIN

LEVELS ON: 1, 2, 3, 53, 55, 56, 57, 58, 59, 60, 61, 62, 63

FILE NAME: 03 113108m:503sb.dgn

ORIGINATOR: BALDWIN 8-5-96
REV. DATE: 10-22-99
PLOT NAME: 506
PLOT SCALE: 1:1
54,55,56,57, 59,60,61,62,63
22,23,24,25,26,27,28,29,30,31,32,33,34,35,36,37,38,39,40,41,42,43,44,45,46,47,48,49,50,51

