

09-2011

OUTAGAMIE
PLOT NAME: 106

(1131-08-00)


1131-08-83

2/15/00

INDEX OF SHEETS

Sheet No.	Title
Sheet No. 2.1-2.4	Typical Sections and Details
Sheet No. 3.1-3.2	Estimate of Quantities
Sheet No. 3A	Miscellaneous Quantities
Sheet No. _____	Right of Way Plat
Sheet No. 5.1-5.3	Plan and Profile
Sheet No. 6.1-6.3	Standard Detail Drawings
Sheet No. _____	Sign Plates
Sheet No. 8.1-8.36	Structure Plans
Sheet No. _____	Computer Earthwork Data
Sheet No. _____	Cross Sections

TOTAL SHEETS = 50

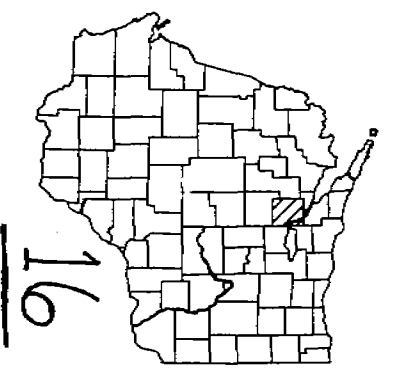


DESIGN DESIGNATION

A.D.T. 1998	=	USH 41
A.D.T. 2018	=	28 665
D.H.V. 2018	=	37 050
D.	=	2 425
T.	=	60-40
V.	=	13.9%
ESALS	=	110 KPH
	=	N/A

CONVENTIONAL SYMBOLS

COUNTY LINE	COMBUSTIBLE FLUIDS
CORPORATE LIMITS	UNDERGROUND UTILITIES
PROPERTY LINE	GAS
LOT LINE	ELECTRIC
LIMITED EASEMENT	TELEPHONE OR TELEGRAPH
EXISTING RIGHT OF WAY	SERVICE PEDESTAL
PROPOSED OR NEW R/W LINE	CABLE MARKER
SURVEY LINE	POWER POLE
SLOPE INTERCEPT	TELEPHONE POLE
ORIGINAL GROUND	RAILROAD
MARSH OR ROCK PROFILE	MARSH AREA
EXISTING CULVERT	WOODED OR SHRUB AREA
PROPOSED CULVERT (Box or Pipe)	
CULVERT (Profile View)	

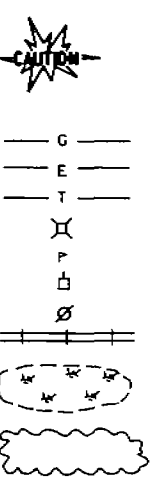

CAUTION

LAYOUT

SCALE 0 5 km

TOTAL NET LENGTH OF CENTERLINE = 0.032 km

SURVEY BOOK NO. 1480 & 1480A

ALL COORDINATES ON THIS PLAN ARE REFERENCED TO THE WISCONSIN COORDINATE SYSTEM CENTRAL ZONE.

STATE OF WISCONSIN DEPARTMENT OF TRANSPORTATION

PREPARED BY

Surveyor

Designer

District Examiner

District Supervisor

Proj. Dev. Engineer

C.O. Examiner

APPROVED FOR DISTRICT OFFICE

DATE: 10/26/99

SIGNATURE: P.E.

AUTHORIZED FOR CENTRAL OFFICE DESIGN

DATE: 12/22/99

SIGNATURE: P.E.

WI SDOT: MSHT10

FILE NAME: D3_#3308#06.dgn

STATE OF WISCONSIN DEPARTMENT OF TRANSPORTATION

PREPARED BY

Surveyor

Designer

District Examiner

District Supervisor

Proj. Dev. Engineer

C.O. Examiner

APPROVED FOR DISTRICT OFFICE

DATE: 10/26/99

SIGNATURE: P.E.

AUTHORIZED FOR CENTRAL OFFICE DESIGN

DATE: 12/22/99

SIGNATURE: P.E.

WI SDOT: MSHT10

FILE NAME: D3_#3308#06.dgn</