

PLOT SCALE: 50


PLOT NAME: 200Q

REV. DATE: 10-25-99

7-14-99

ORIGINATOR: BALDWIN

LEVELS ON: 1, 2, 3, 62, 63

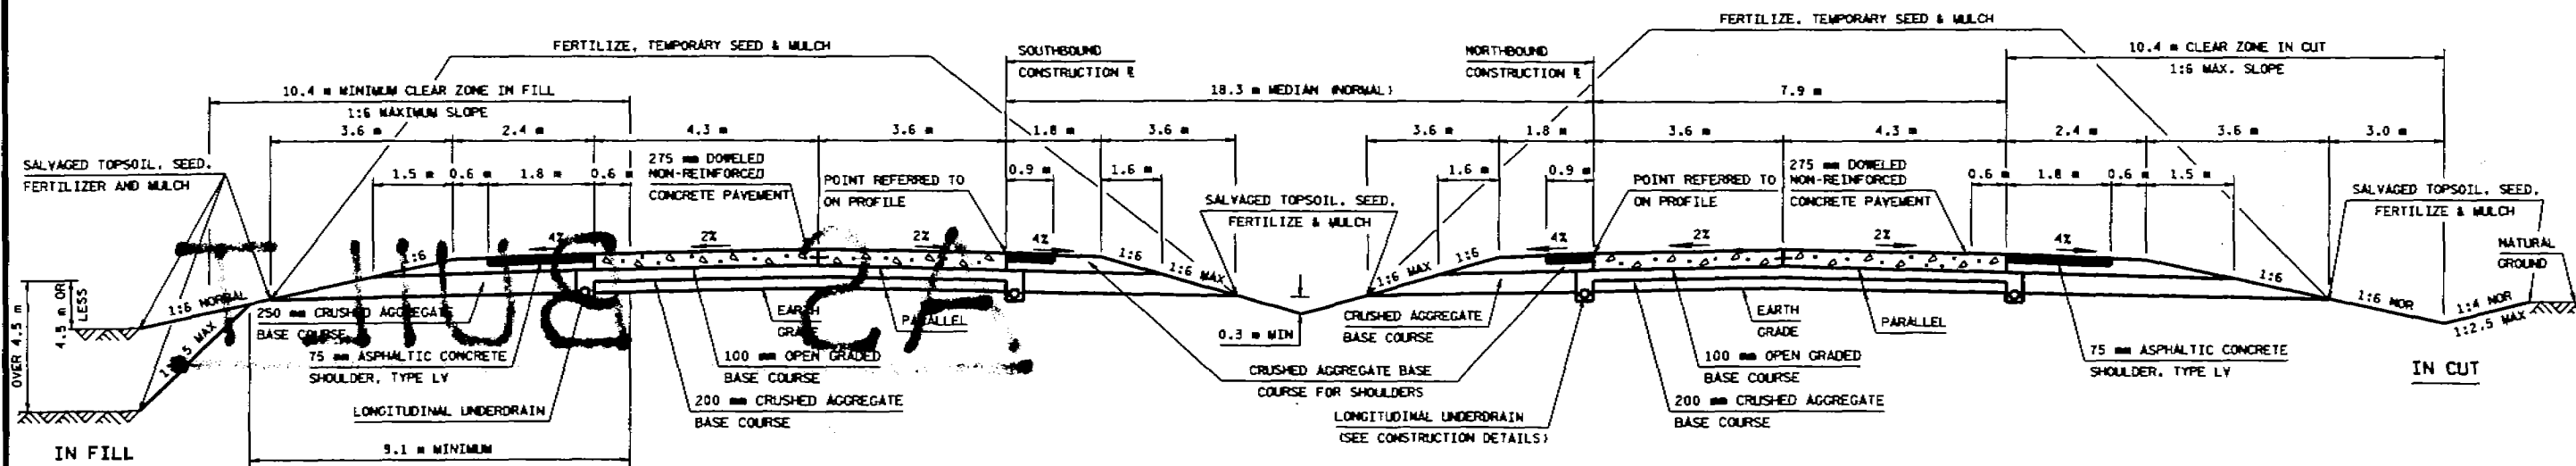

TYPICAL FINISHED CROSS SECTION FOR USH 41
(FOR INFORMATION ONLY)

UTILITIES

DIGGER'S HOTLINE 1-800-242-8511 (TOLL FREE)

AMERITECH
TONY PETTINATO
221 W WASHINGTON STREET
4TH FLOOR OSPE
APPLETON WI 54911
920 735-3243 FAX 735-3073
TELEPHONE

AMR PIPELINE CO
GARY KLITZKY
W 4956 OAKCREST DRIVE
PO BOX 398
BONDUEL WI 54107
715-758-2131 EXT 11
GAS

CITY OF DEPERE ENGINEER
LEE SCHLEY
925 SOUTH SIXTH STREET
DEPERE WI 54115
920-339-4060
SEWER AND STREET LIGHTS

CITY OF DEPERE WATER DEPT
PAUL WINTEN
925 SOUTH SIXTH STREET
DEPERE WI 54115
920-339-4063
WATER

KALKALUNA ELECTRIC AND WATER DEPT
PETER PRAST
777 ISLAND STREET
PO BOX 1777
KALKALUNA WI 54130
(920-766-5721 EXT 17) (920-766-7698 fax)
ELECTRIC

NORLIGHT TELECOMMUNICATIONS INC
PAUL NEUMANN
275 NORTH CORPORATE DRIVE
BROOKFIELD WI 53045-5818
(414) 792-7932
COMMUNICATION FACILITIES

TDS METROCOM
MIKE KENNY
PO BOX 5158
301 S WESTFIELD ROAD
WADISON WI 53705-0158
608-664-4407 OR KEITH WHITE AT 608-664-4439
COMMUNICATION FACILITIES

TIME WARNER CABLE
STEVE POEHLEIN
1001 KENNEDY AVENUE
PO BOX 145
KIMBERLY WI 54136-0145
(920-831-9207) pager 234-2167
CABLE TELEVISION

US EXCHANGE
DALE ANDERSON
44 GRANDVILLE AVENUE SW SUITE 400
GRAND RAPIDS MI 49503
616-493-5352
COMMUNICATION FACILITIES

WEPCO ELECTRIC OPERATIONS
MIKE JAMES
231 W WICHIGAN A440
MILWAUKEE WI 53201
414-221-2719
ELECTRIC TRANSMISSION

WISCONSIN PUBLIC SERVICE
MICHAEL CERKAS
700 NORTH ADAMS STREET
PO BOX 19001
GREEN BAY WI 54307-9001
920-433-4942 FAX 920-433-1360
GAS AND ELECTRIC

WISCONSIN PUBLIC SERVICE (GAS)
JERRY PEOT
2850 S ASHLAND AVENUE
PO BOX 19002
GREEN BAY WI 54307 9002
920 498 5127
GAS

WISCONSIN PUBLIC SERVICE ELECTRIC
TIM NICLA
2850 S ASHLAND AVENUE
GREEN BAY WI 54304
920 498 5153
ELECTRIC



STANDARD DETAIL DRAWINGS (METRIC)

SLOPE PAVING-STRUCTURES (CRUSHED AGGREGATE)	12A2-3
NAME PLATE-STRUCTURES	12A3-5
BARRICADES AND SIGNS FOR	
ROAD CLOSURES	15C2-3

GENERAL NOTES

THE CONTROL SURVEY FOR THIS PROJECT WAS CONDUCTED UNDER AND MET SPECIFICATIONS FOR THIRD ORDER CONTROL SURVEYS. ALL COORDINATES SHOWN ON THIS PLAN ARE GRID COORDINATES REFERENCED TO THE WISCONSIN COORDINATE SYSTEM, CENTRAL ZONE. CURVE DATA SHOWN ON THE PLAN IS "ARC DEFINITION". ALL DISTANCES AND STATIONING SHOWN ON THIS PLAN ARE GROUND VALUES. GRID VALUES ARE OBTAINED BY MULTIPLYING GROUND VALUES BY 0.999946. BEARINGS ON THIS PLAN ARE GRID BEARINGS TO THE NEAREST SECOND. ALL ELEVATIONS ON THIS PROJECT ARE REFERENCED TO THE NATIONAL GEODETIC VERTICAL DATUM OF 1929 (N.G.V.D.). THE LOCATIONS OF EXISTING AND PROPOSED UTILITY FACILITIES AS SHOWN ON THE PLAN ARE APPROXIMATE. THERE MAY BE OTHER UTILITY FACILITIES WITHIN THE PROJECT AREA THAT ARE NOT SHOWN.

FILE NAME: F:\113108\113108.mxd 22983.dgn
LEVELS ON: 113108.mxd 22983.dgn
ORIGINATOR: BALDWIN T-14-99
REV. DATE: 10-11-99
PLOT SCALE: 8.0435011000000
PLOT DATE: 11-OCT-1999 06:51

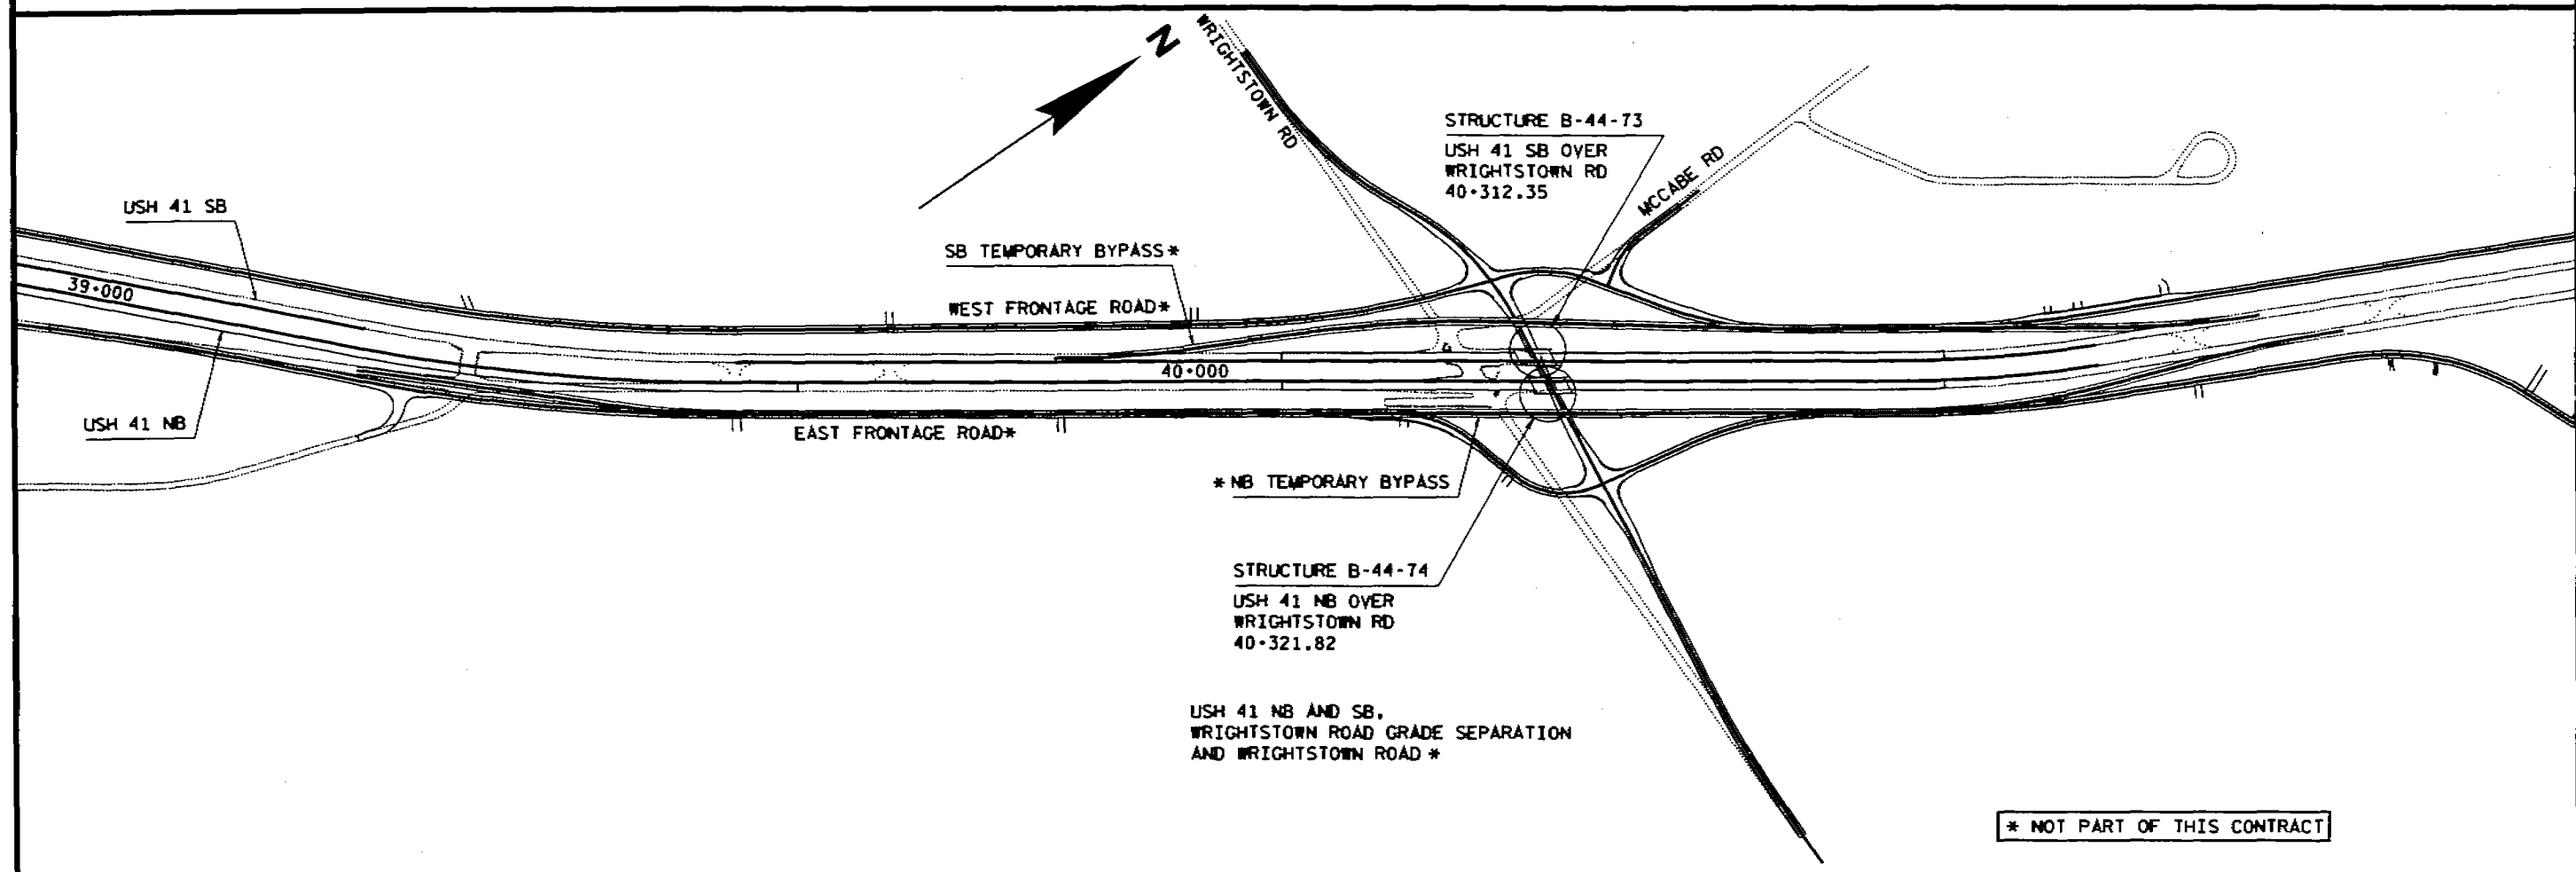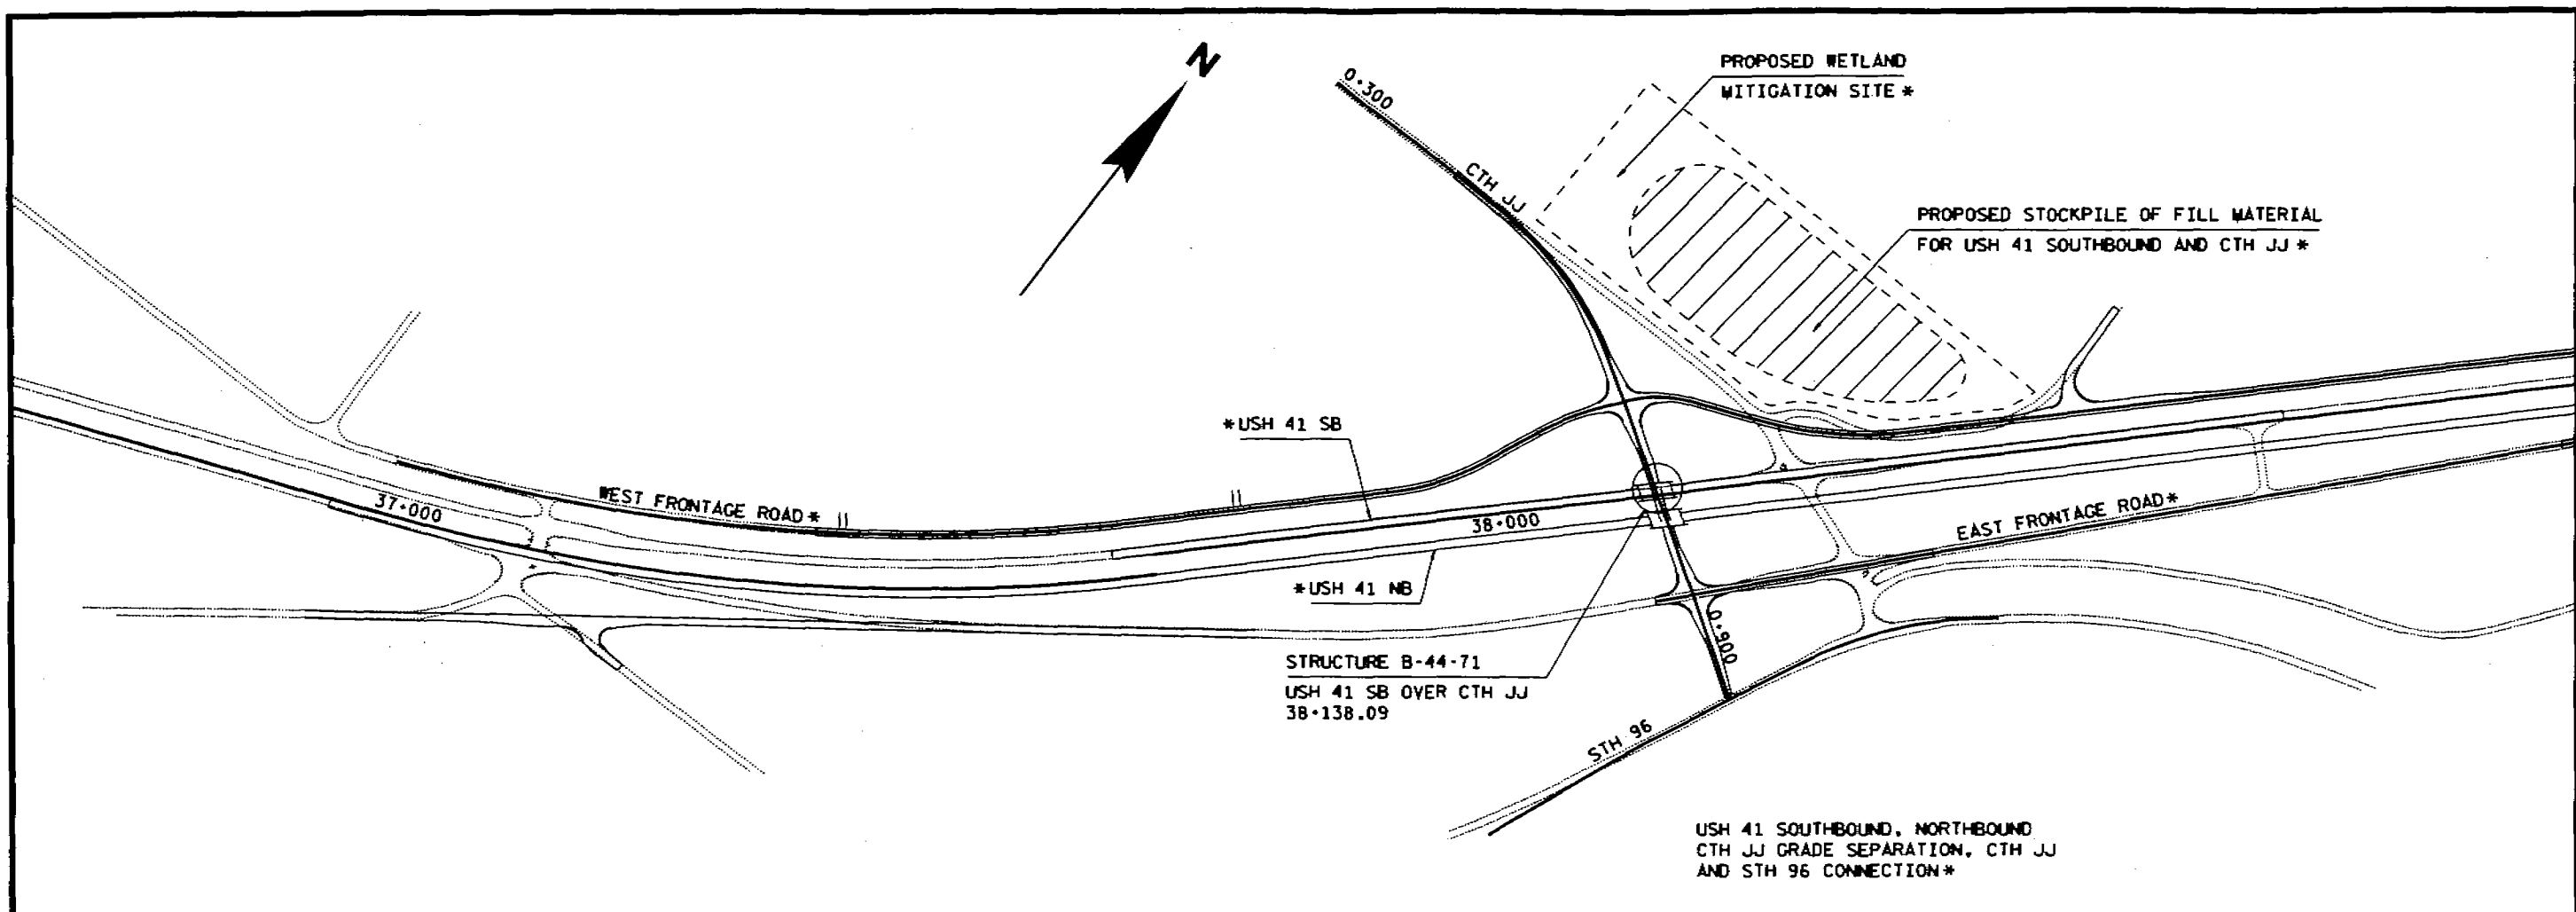

* NOT PART OF THIS CONTRACT

PLOT SCALE: 1:1

PLOT NAME: 204md
LEVELS ON: 1, 2, 3, 62, 63

REV. DATE: 10-15-99

7-14-99

ORIGINATOR: BALDWIN

CONSTRUCTION DETAILS

SCALE: 1:


HWY: USH 41

COUNTY: OUTAGAMIE

STATE PROJECT NO: 1131-08-83

SHEET NO: 2.3

M

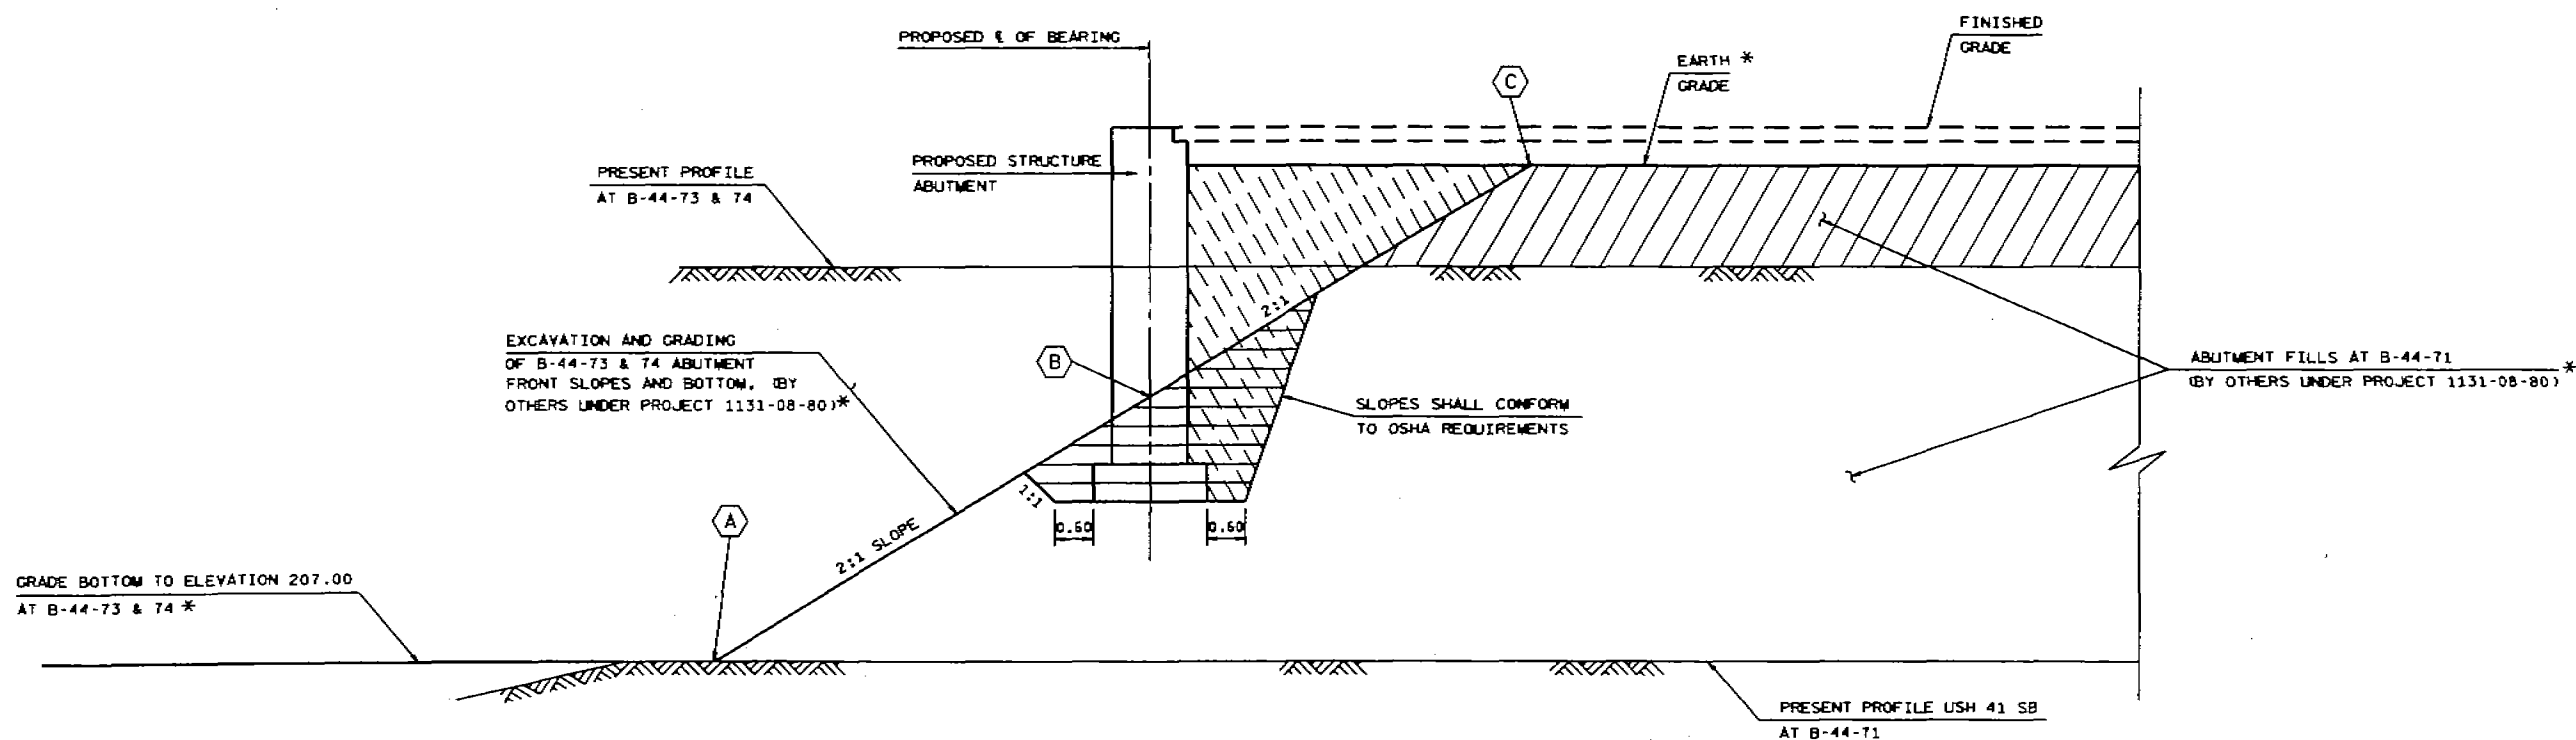

		A	B	C
B-44-71 SOUTH ABUTMENT	STATION	38+127.75	38+122.99	38+119.89
	ELEVATION	209.00	211.38	212.93
B-44-71 NORTH ABUTMENT	STATION	38+147.69	38+152.09	38+155.19
	ELEVATION	209.00	211.20	212.75
B-44-73 SOUTH ABUTMENT	STATION	40+301.53	40+297.05	40+293.97
	ELEVATION	207.00	209.24	210.78
B-44-73 NORTH ABUTMENT	STATION	40+323.57	40+328.05	40+331.11
	ELEVATION	207.00	208.91	210.44
B-44-74 SOUTH ABUTMENT	STATION	40+311.48	40+306.52	40+303.36
	ELEVATION	207.00	209.48	211.06
B-44-74 NORTH ABUTMENT	STATION	40+333.40	40+337.52	40+340.70
	ELEVATION	207.00	209.06	210.65

- STRUCTURAL BACKFILL
- SUITABLE EARTH FILL (BY OTHERS UNDER PROJECT 1131-08-80) *
- EXCAVATION FOR STRUCTURES
- FILL REQUIRED AT B-44-73 & 74 APPROACHES (BY OTHERS UNDER PROJECT 1131-08-80) *

LONGITUDINAL SECTION AT STRUCTURE ABUTMENTS

B-44-71 USH 41 SB (OVER CTH JJ)
B-44-73 USH 41 SB (OVER WRIGHTSTOWN RD)
B-44-74 USH 41 NB (OVER WRIGHTSTOWN RD)

* NOT PART OF THIS CONTRACT

