

Index of Sheets

Sheet No.	1	Title
Sheet No.	2	Typical Sections and Details
Sheet No.	3	Estimate of Quantities
Sheet No.	3A	Miscellaneous Quantities
Sheet No.		Right of Way Plat
Sheet No.		Plan and Profile
Sheet No.	6-6.1	Standard Detail Drawings
Sheet No.		Standard Sign Plates
Sheet No.		Structure Plans
Sheet No.		Computer Earthwork Data
Sheet No.		Cross Sections

TOTAL SHEETS = 6

STATE OF WISCONSIN DEPARTMENT OF TRANSPORTATION PLAN OF PROPOSED IMPROVEMENT

MAIN ST., VILLAGE OF WRIGHTSTOWN

LINDA STREET - FOX RIVER

S.T.H. 96
BROWN COUNTY

STATE PROJECT NUMBER
4077-2-71




STATE PROJECT	FEDERAL PROJECT	
	PROJECT	CONTRACT
4077-2-71	F 0142(10)	1

AS BUILT PLAN

NO.

DESIGNED BY J. HOLLISTER
CHECKED BY S. NOEL
DATE RELIANCE
5-19-86

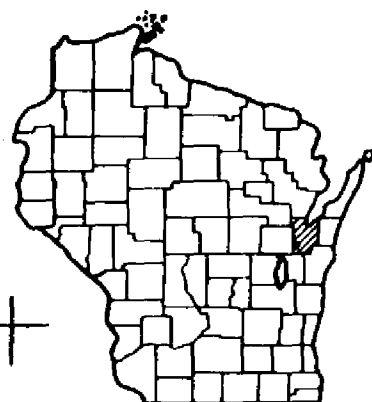

Design Designation


A.D.T.	1,985	=	5,300
A.D.T.	2,005	=	5,700
O.M.V.		=	680
D.		=	60 - 40
T.		=	7%
V.		=	35 M.P.H.

Conventional Signs

County Line	-----
Township or Range Line	-----
Section Line	-----
Corporate or City Limits	-----
Property line	-----
Lot Line	-----
Existing Right of Way Line	-----
New Right of Way Line	-----
Base or Survey Line	-----
Slope Intercept	-----
Existing Roadway or	-----
Private Entrance	-----

Caution Symbol (Combustible fluids under pressure)	-----
Railroads	-----
Fence	-----
Culverts in Place	-----
Culverts Required	-----
Power Pole	-----
Telephone or Telegraph Pole	-----
Right of Way Markers	-----
Marsh	-----
Wooded Area	-----
Grade Elevation	-----

BEGIN PROJECT
STA. 0 + 00
X = 2,477,800
Y = 852,900

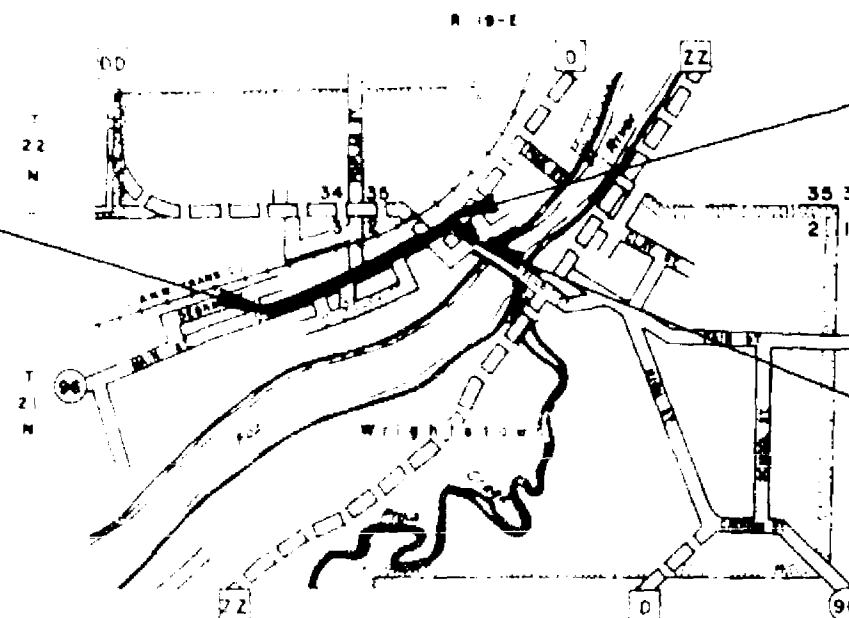

STA 22 + 24.5 BACK -
STA 19 + 48.55 AHEAD EQUATION

END PROJECT
STA. 16 + 90

Layout
Scale 0 500 1000 1500
IN FEET

Total Net Length of Centerline = 0.470 Mi.

STATE OF WISCONSIN DEPARTMENT OF TRANSPORTATION	
Surveyor	District Checker
Designer	C. O. Checker
District Supervisor	C. O. Coordinator
Approved:	
Date	Signature
Approved:	
Date	Signature
Approved:	
Date	Signature
U.S. DEPARTMENT OF TRANSPORTATION FEDERAL HIGHWAY ADMINISTRATION REGION 5 WISCONSIN DIVISION	
Approved:	
Date	Signature