


PLOT SCALE:

PLOT NAME:

REV. DATE:

ORIGINATOR:

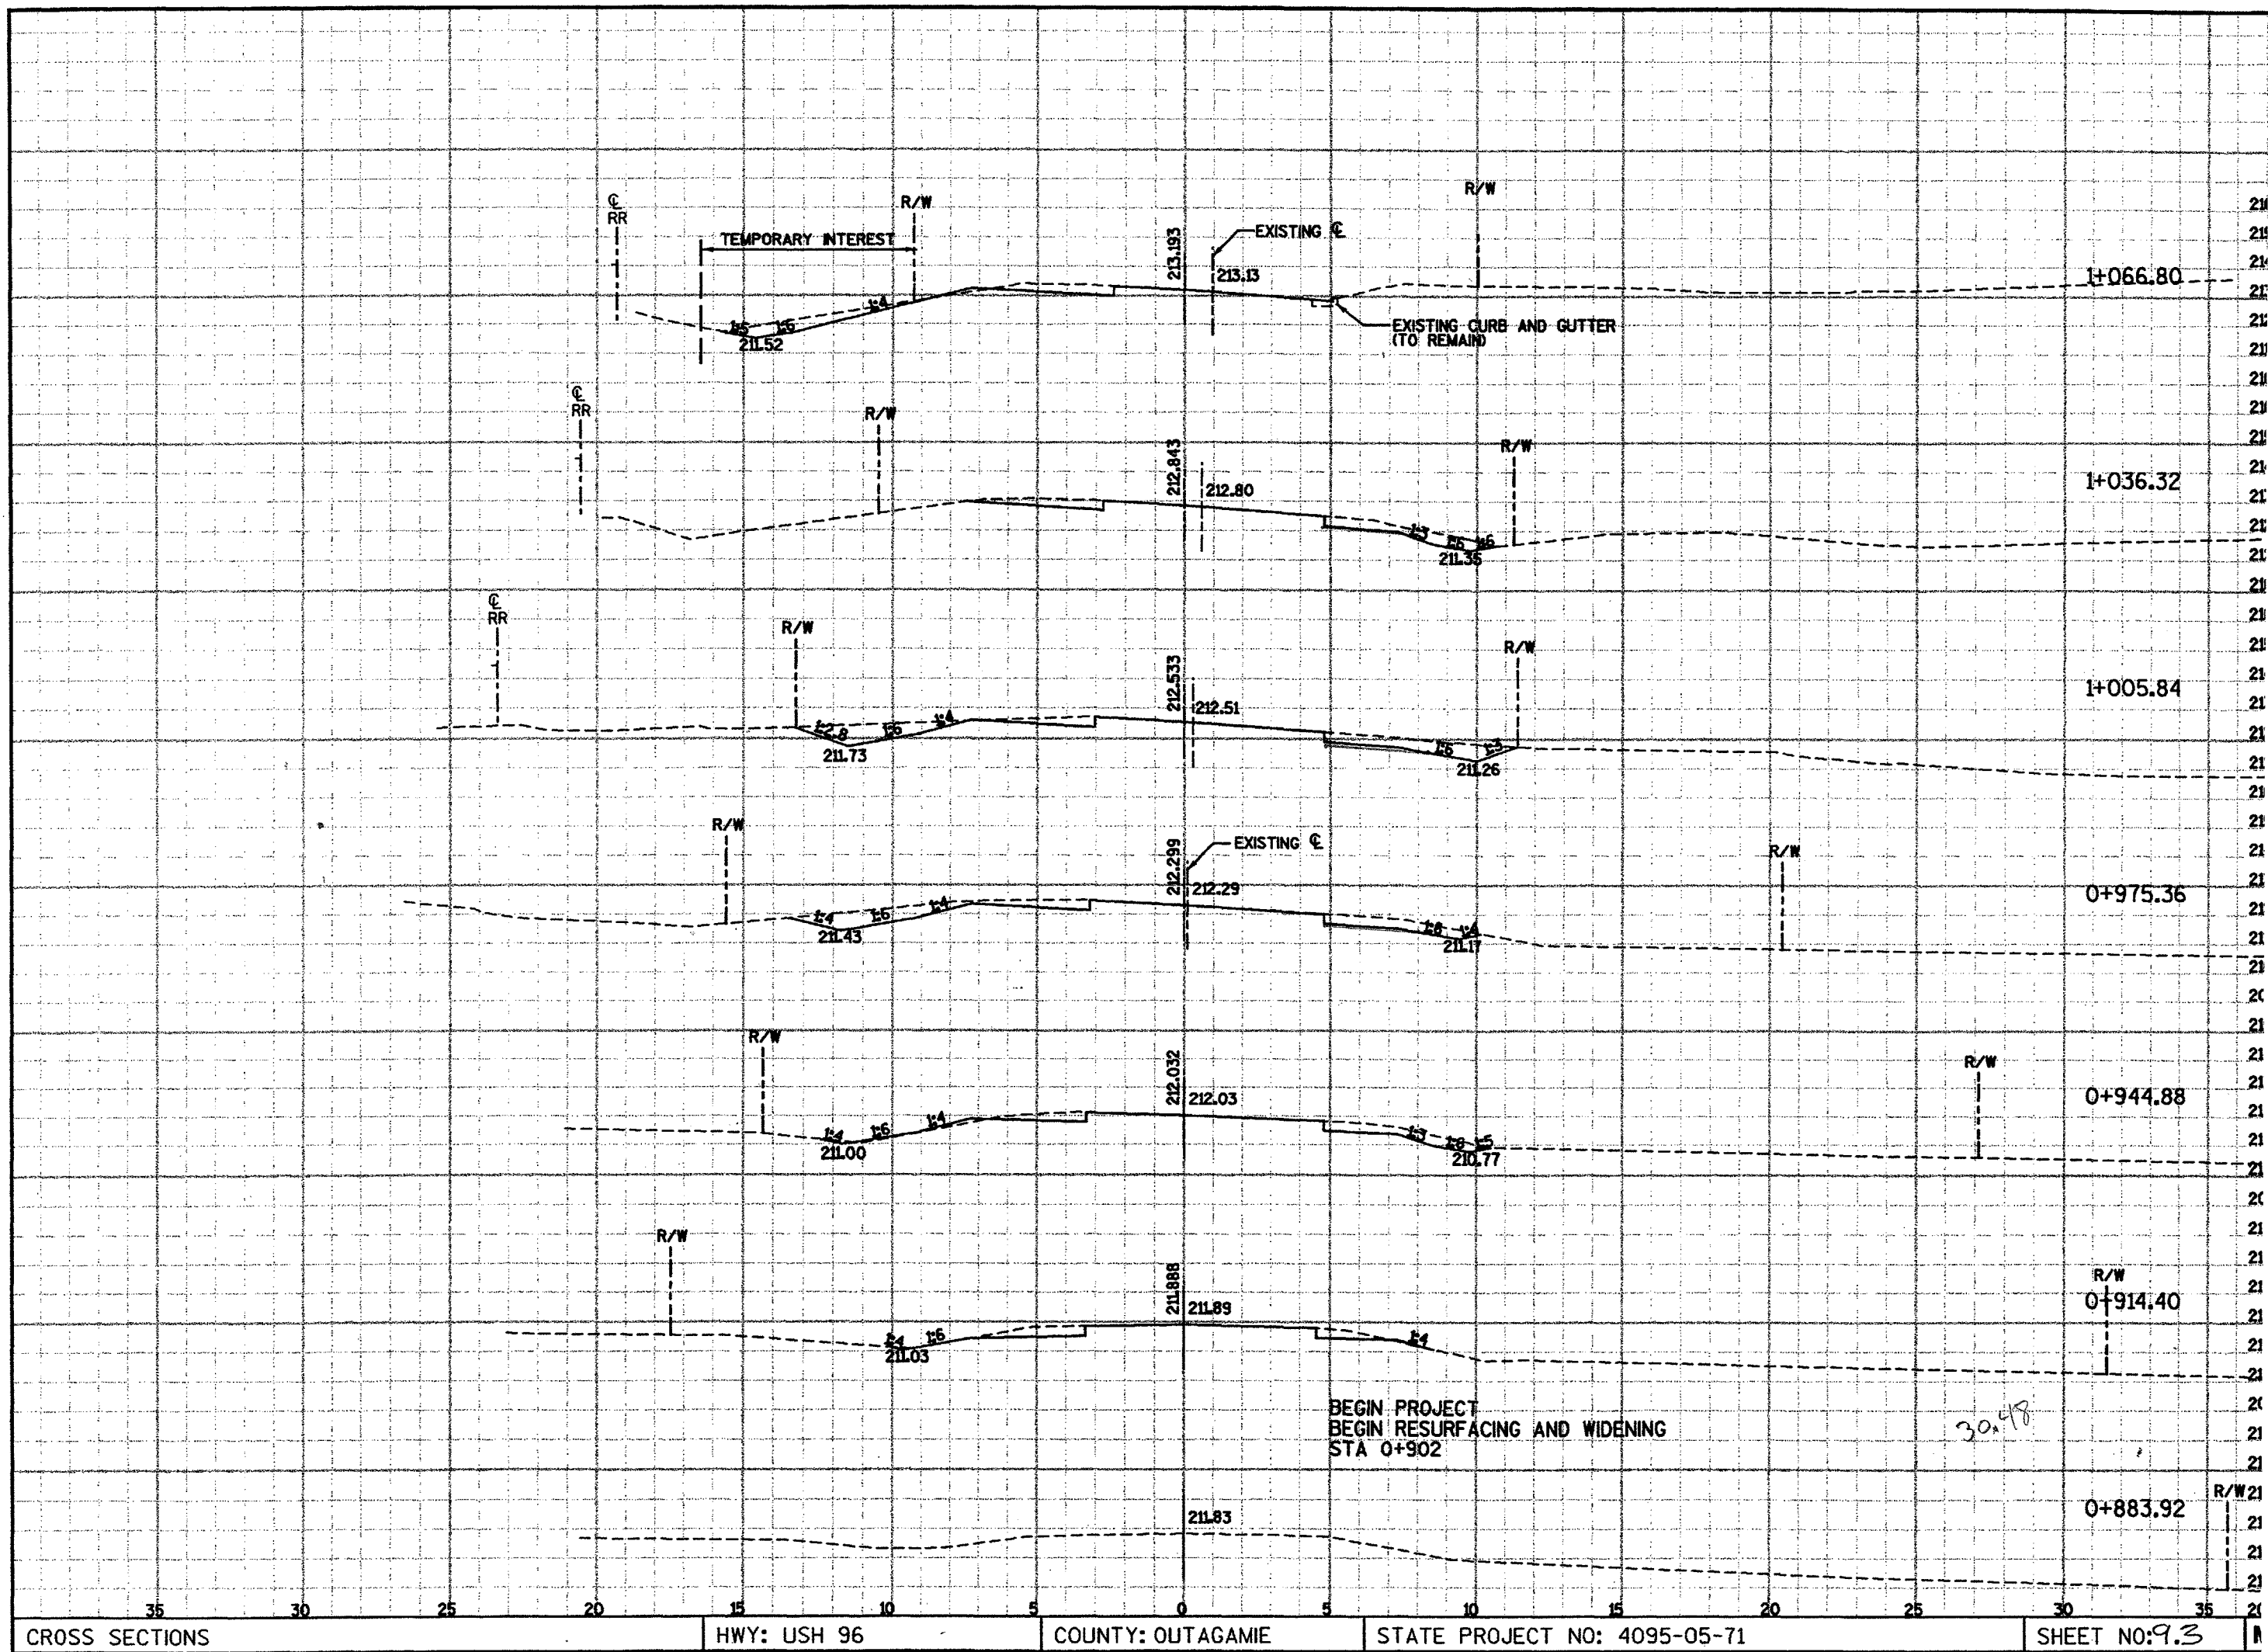


PLOT SCALE:

PLOT NAME:

REV. DATE:

ORIGINATOR:

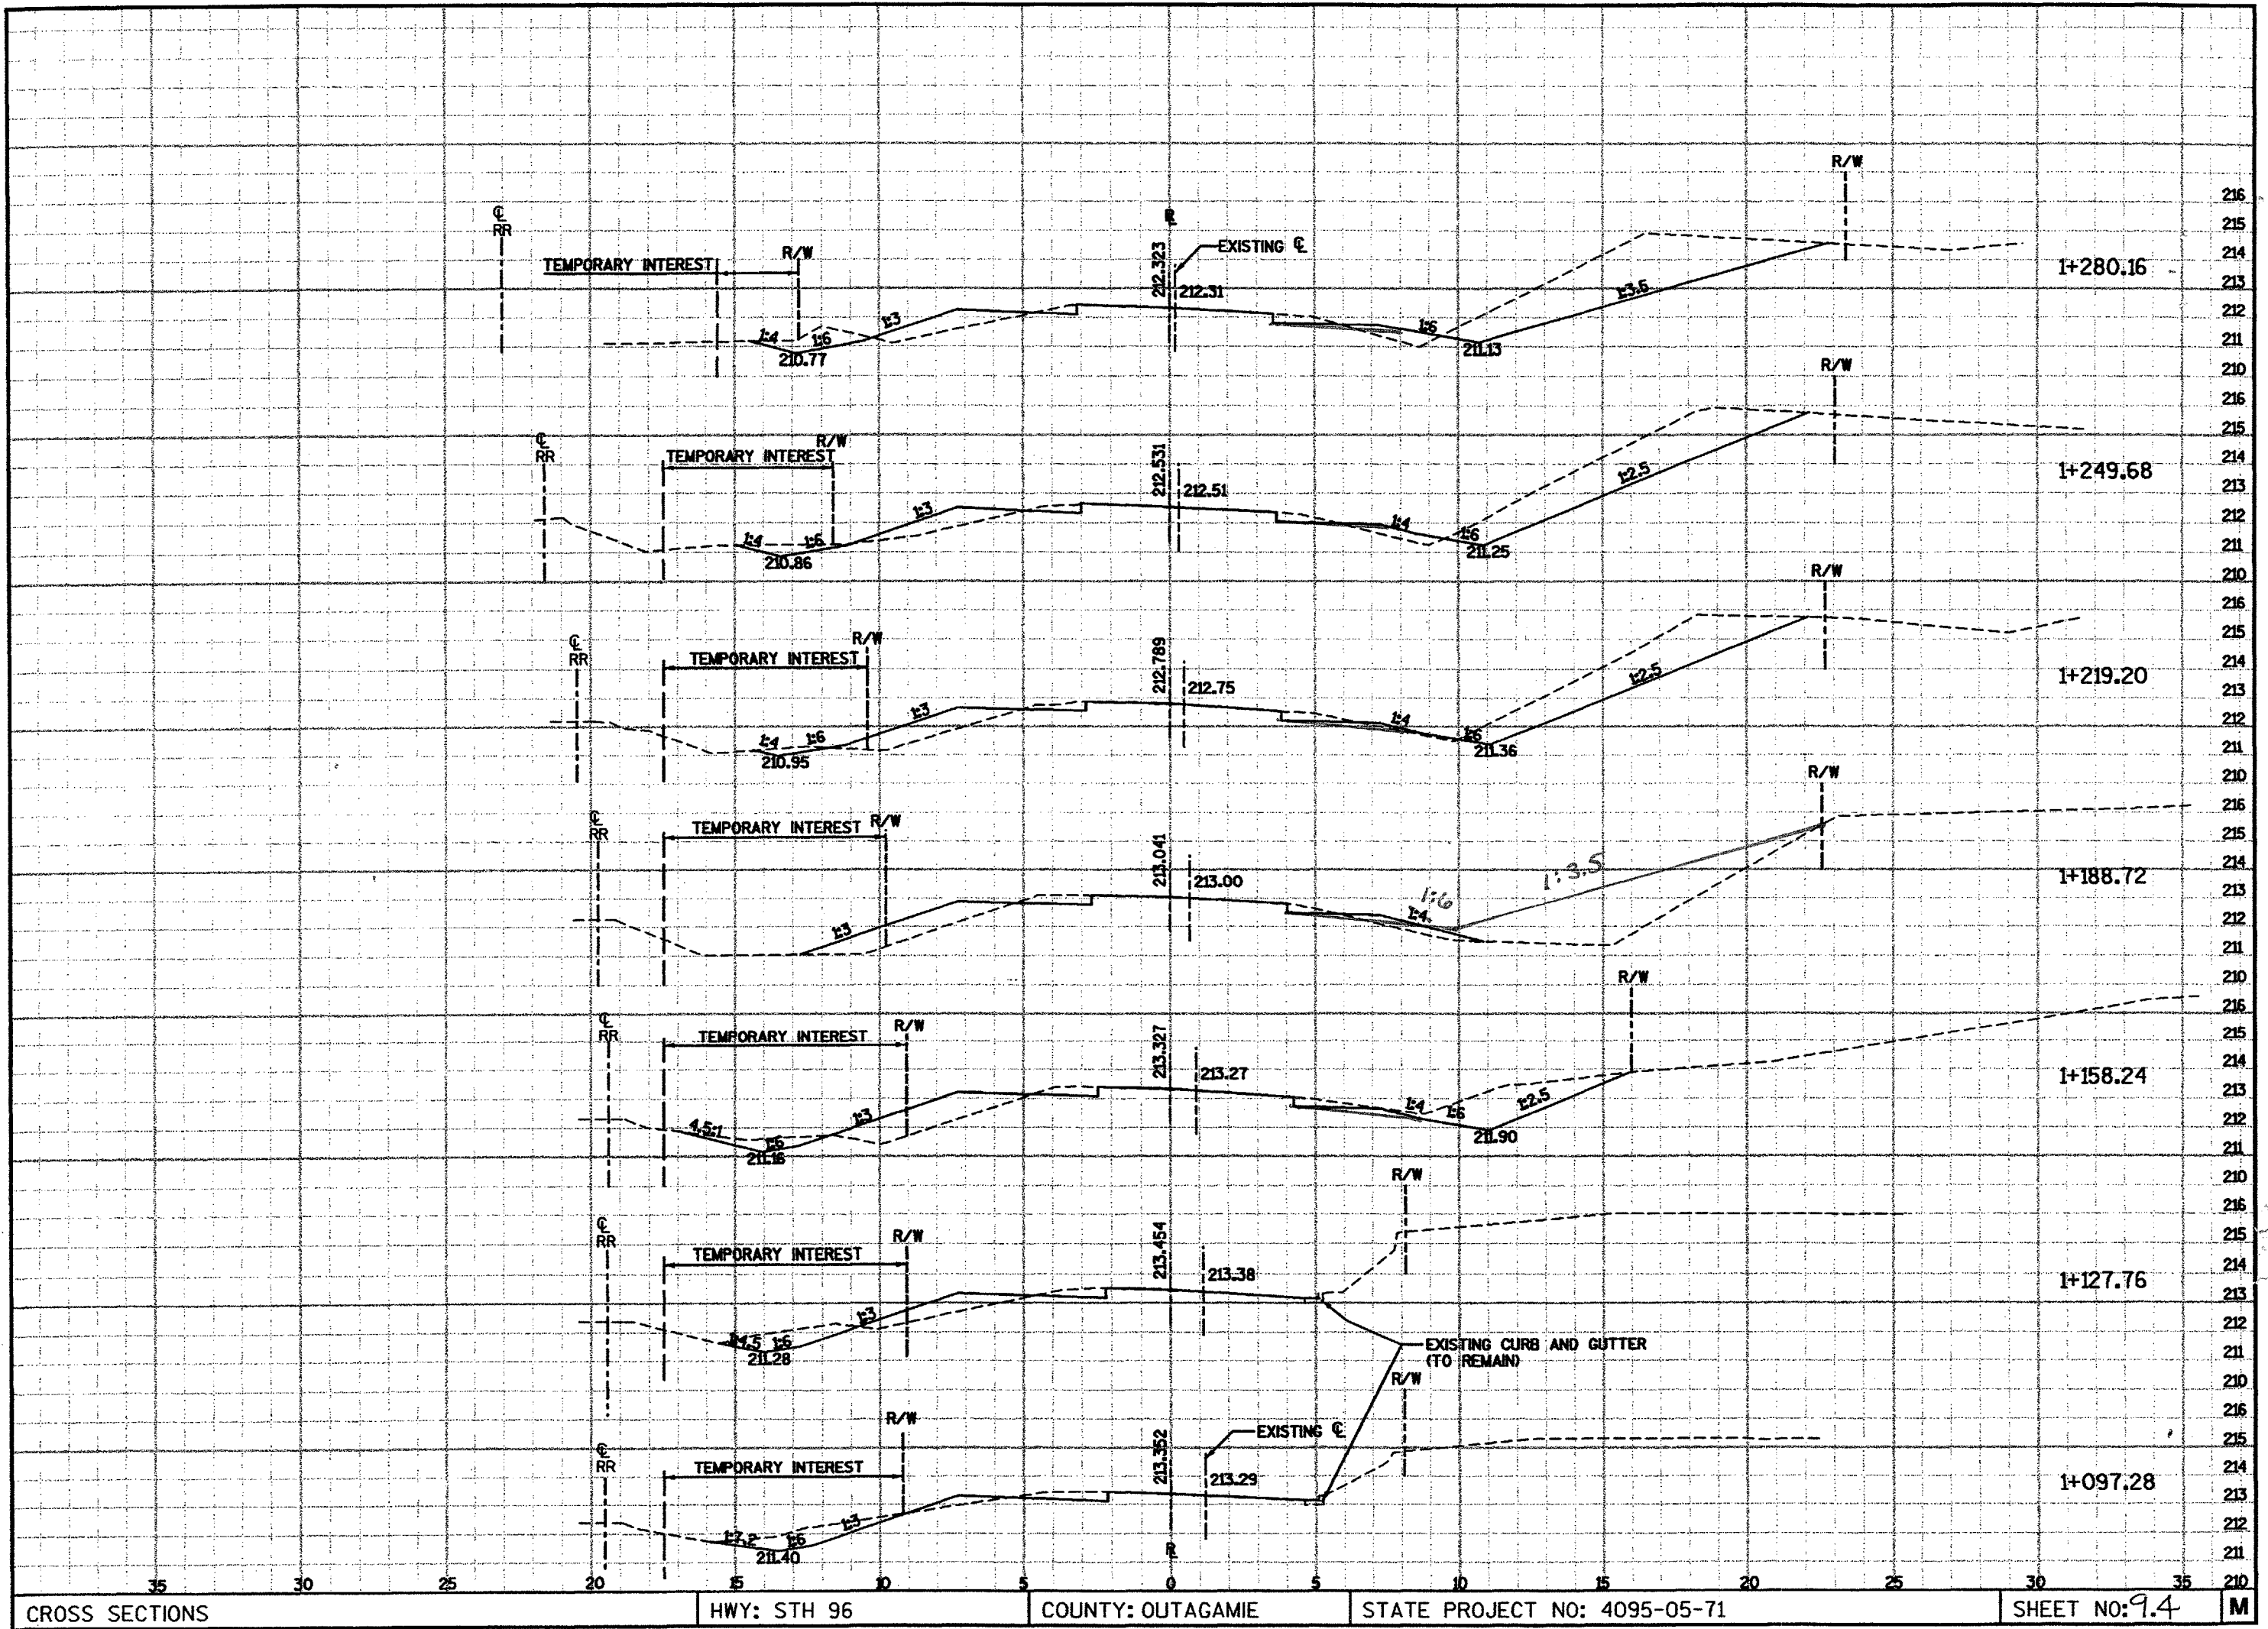

CROSS SECTIONS

HWY: STH 96

COUNTY: OUTAGAMIE

STATE PROJECT NO: 4095-05-71

SHEET NO: 9.4


M

PLOT SCALE:

PLOT NAME:

REV. DATE:

ORIGINATOR:

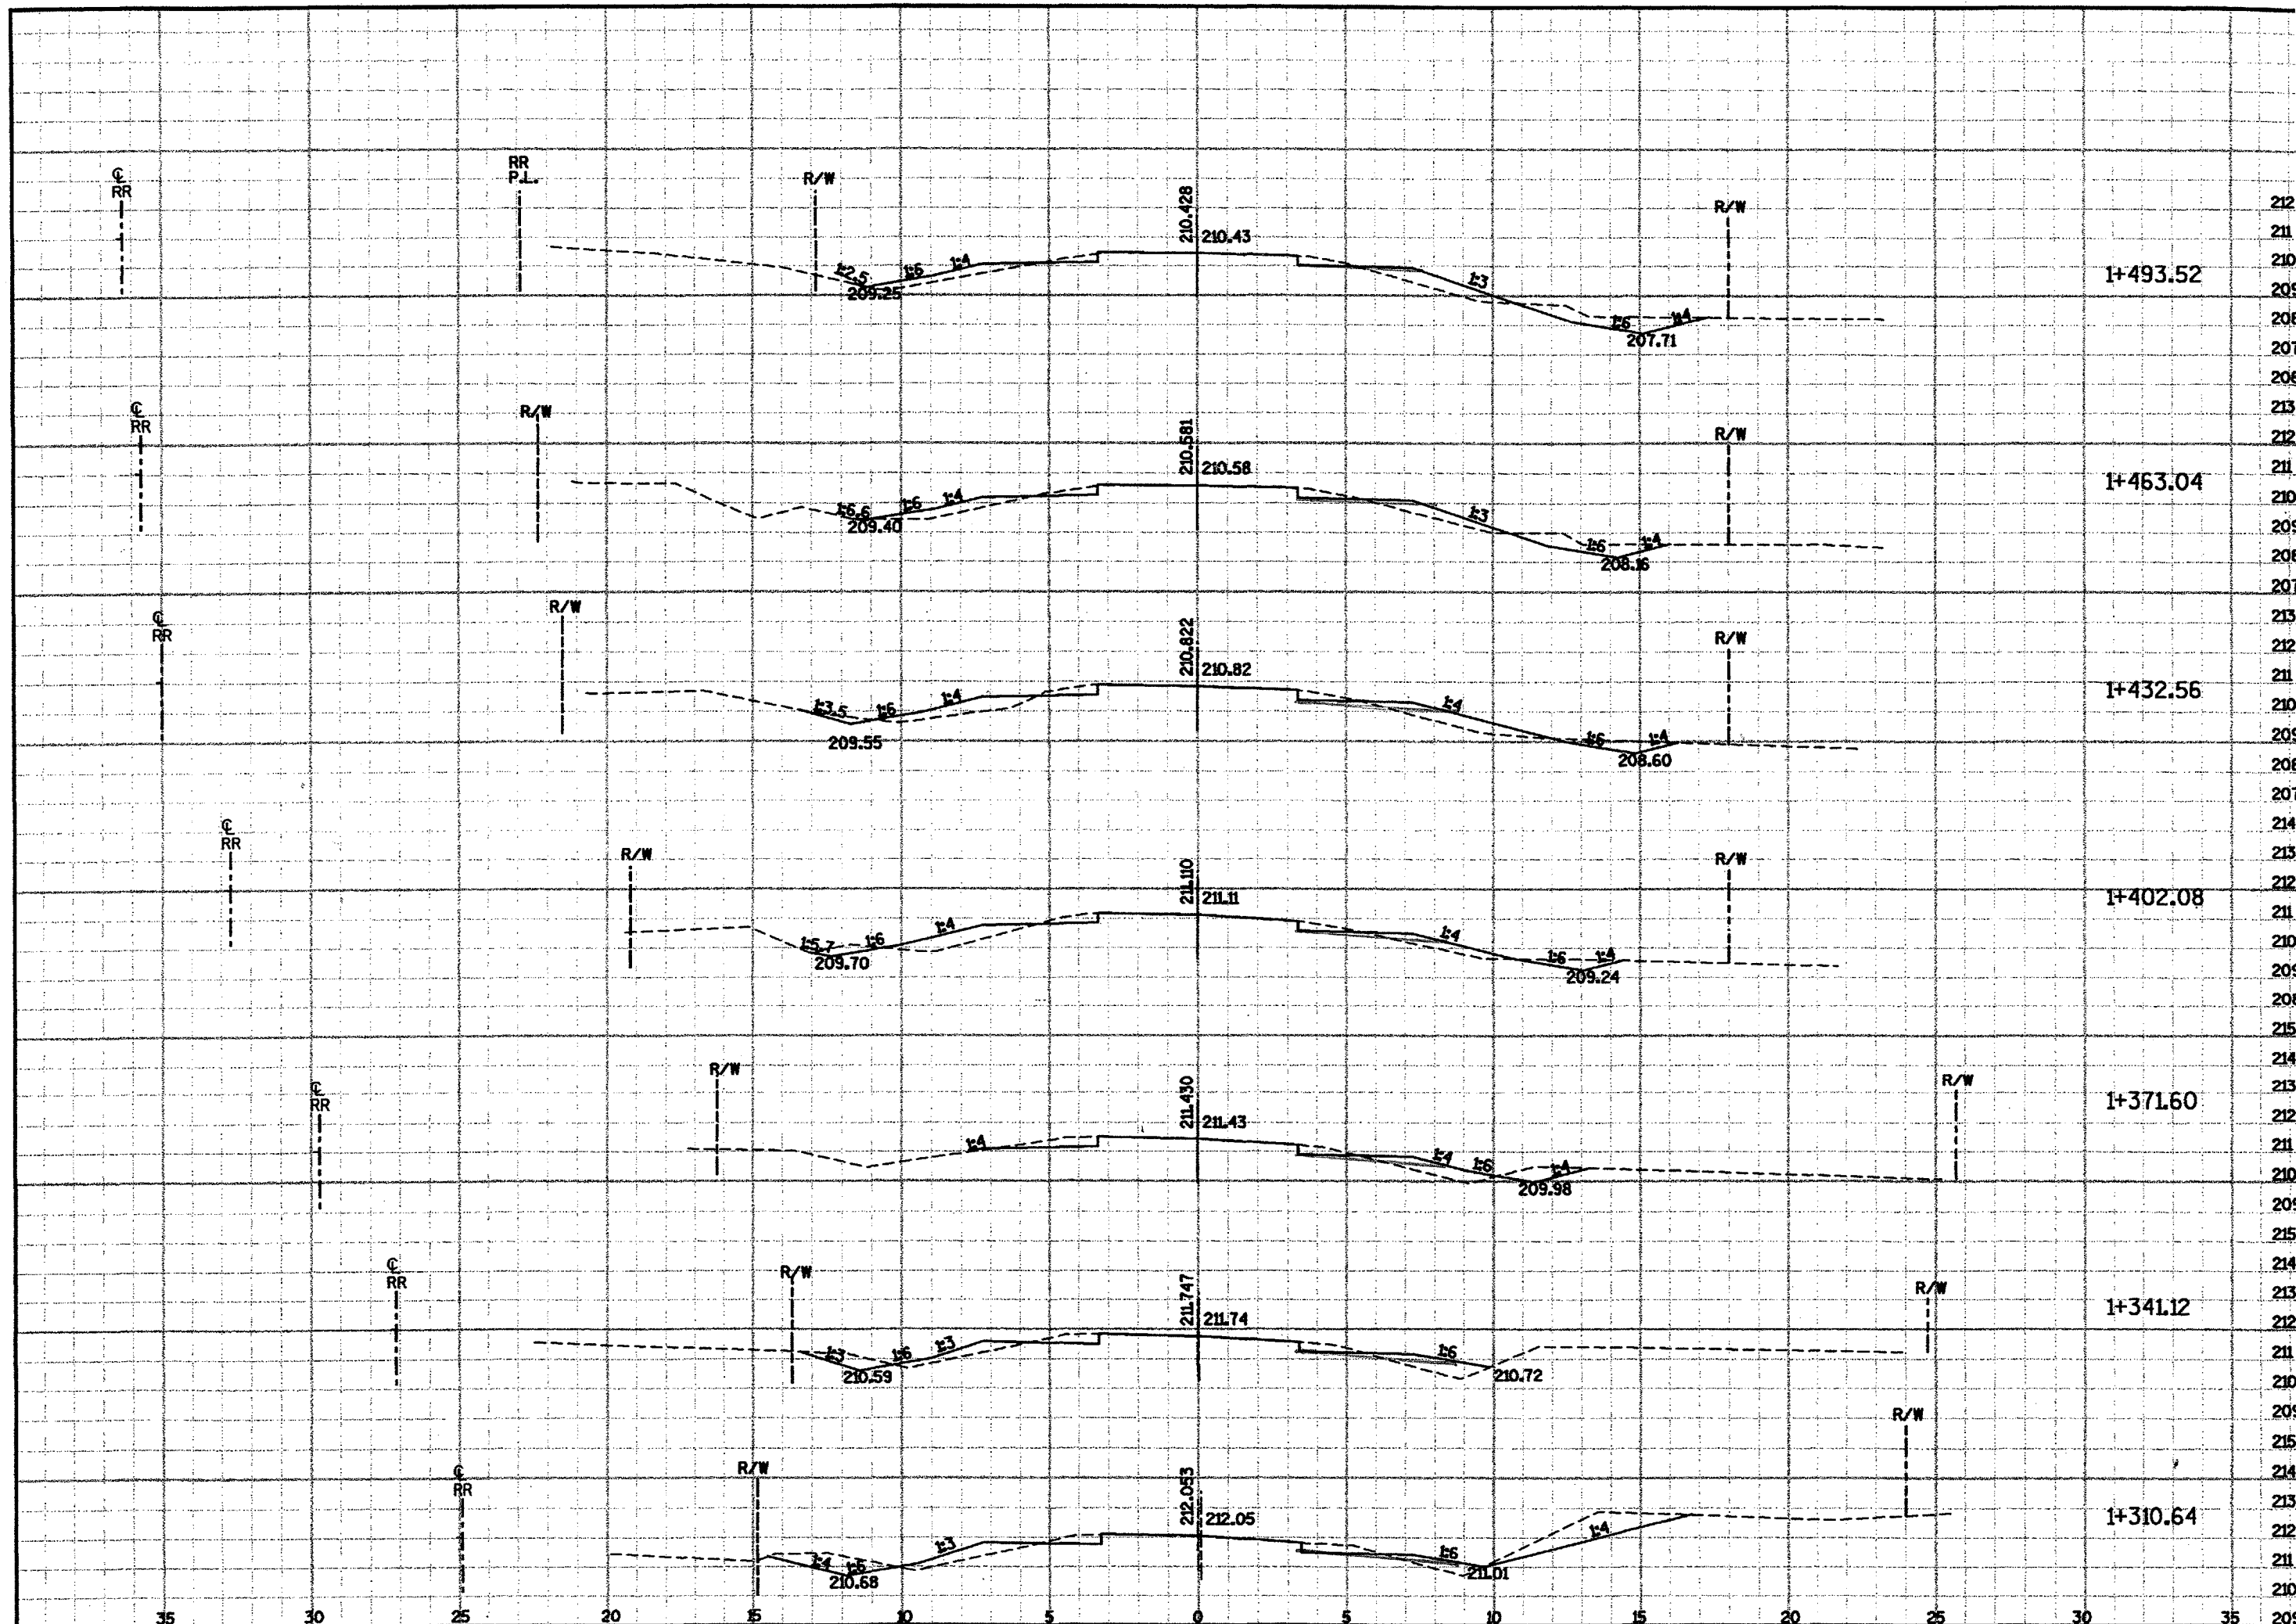


CROSS SECTIONS	HWY: STH 96	COUNTY: OUTAGAMIE	STATE PROJECT NO: 4095-05-71	SHEET NO: 9.5	M
----------------	-------------	-------------------	------------------------------	---------------	---

PLOT SCALE:

PLOT NAME:

REV. DATE:

ORIGINATOR:

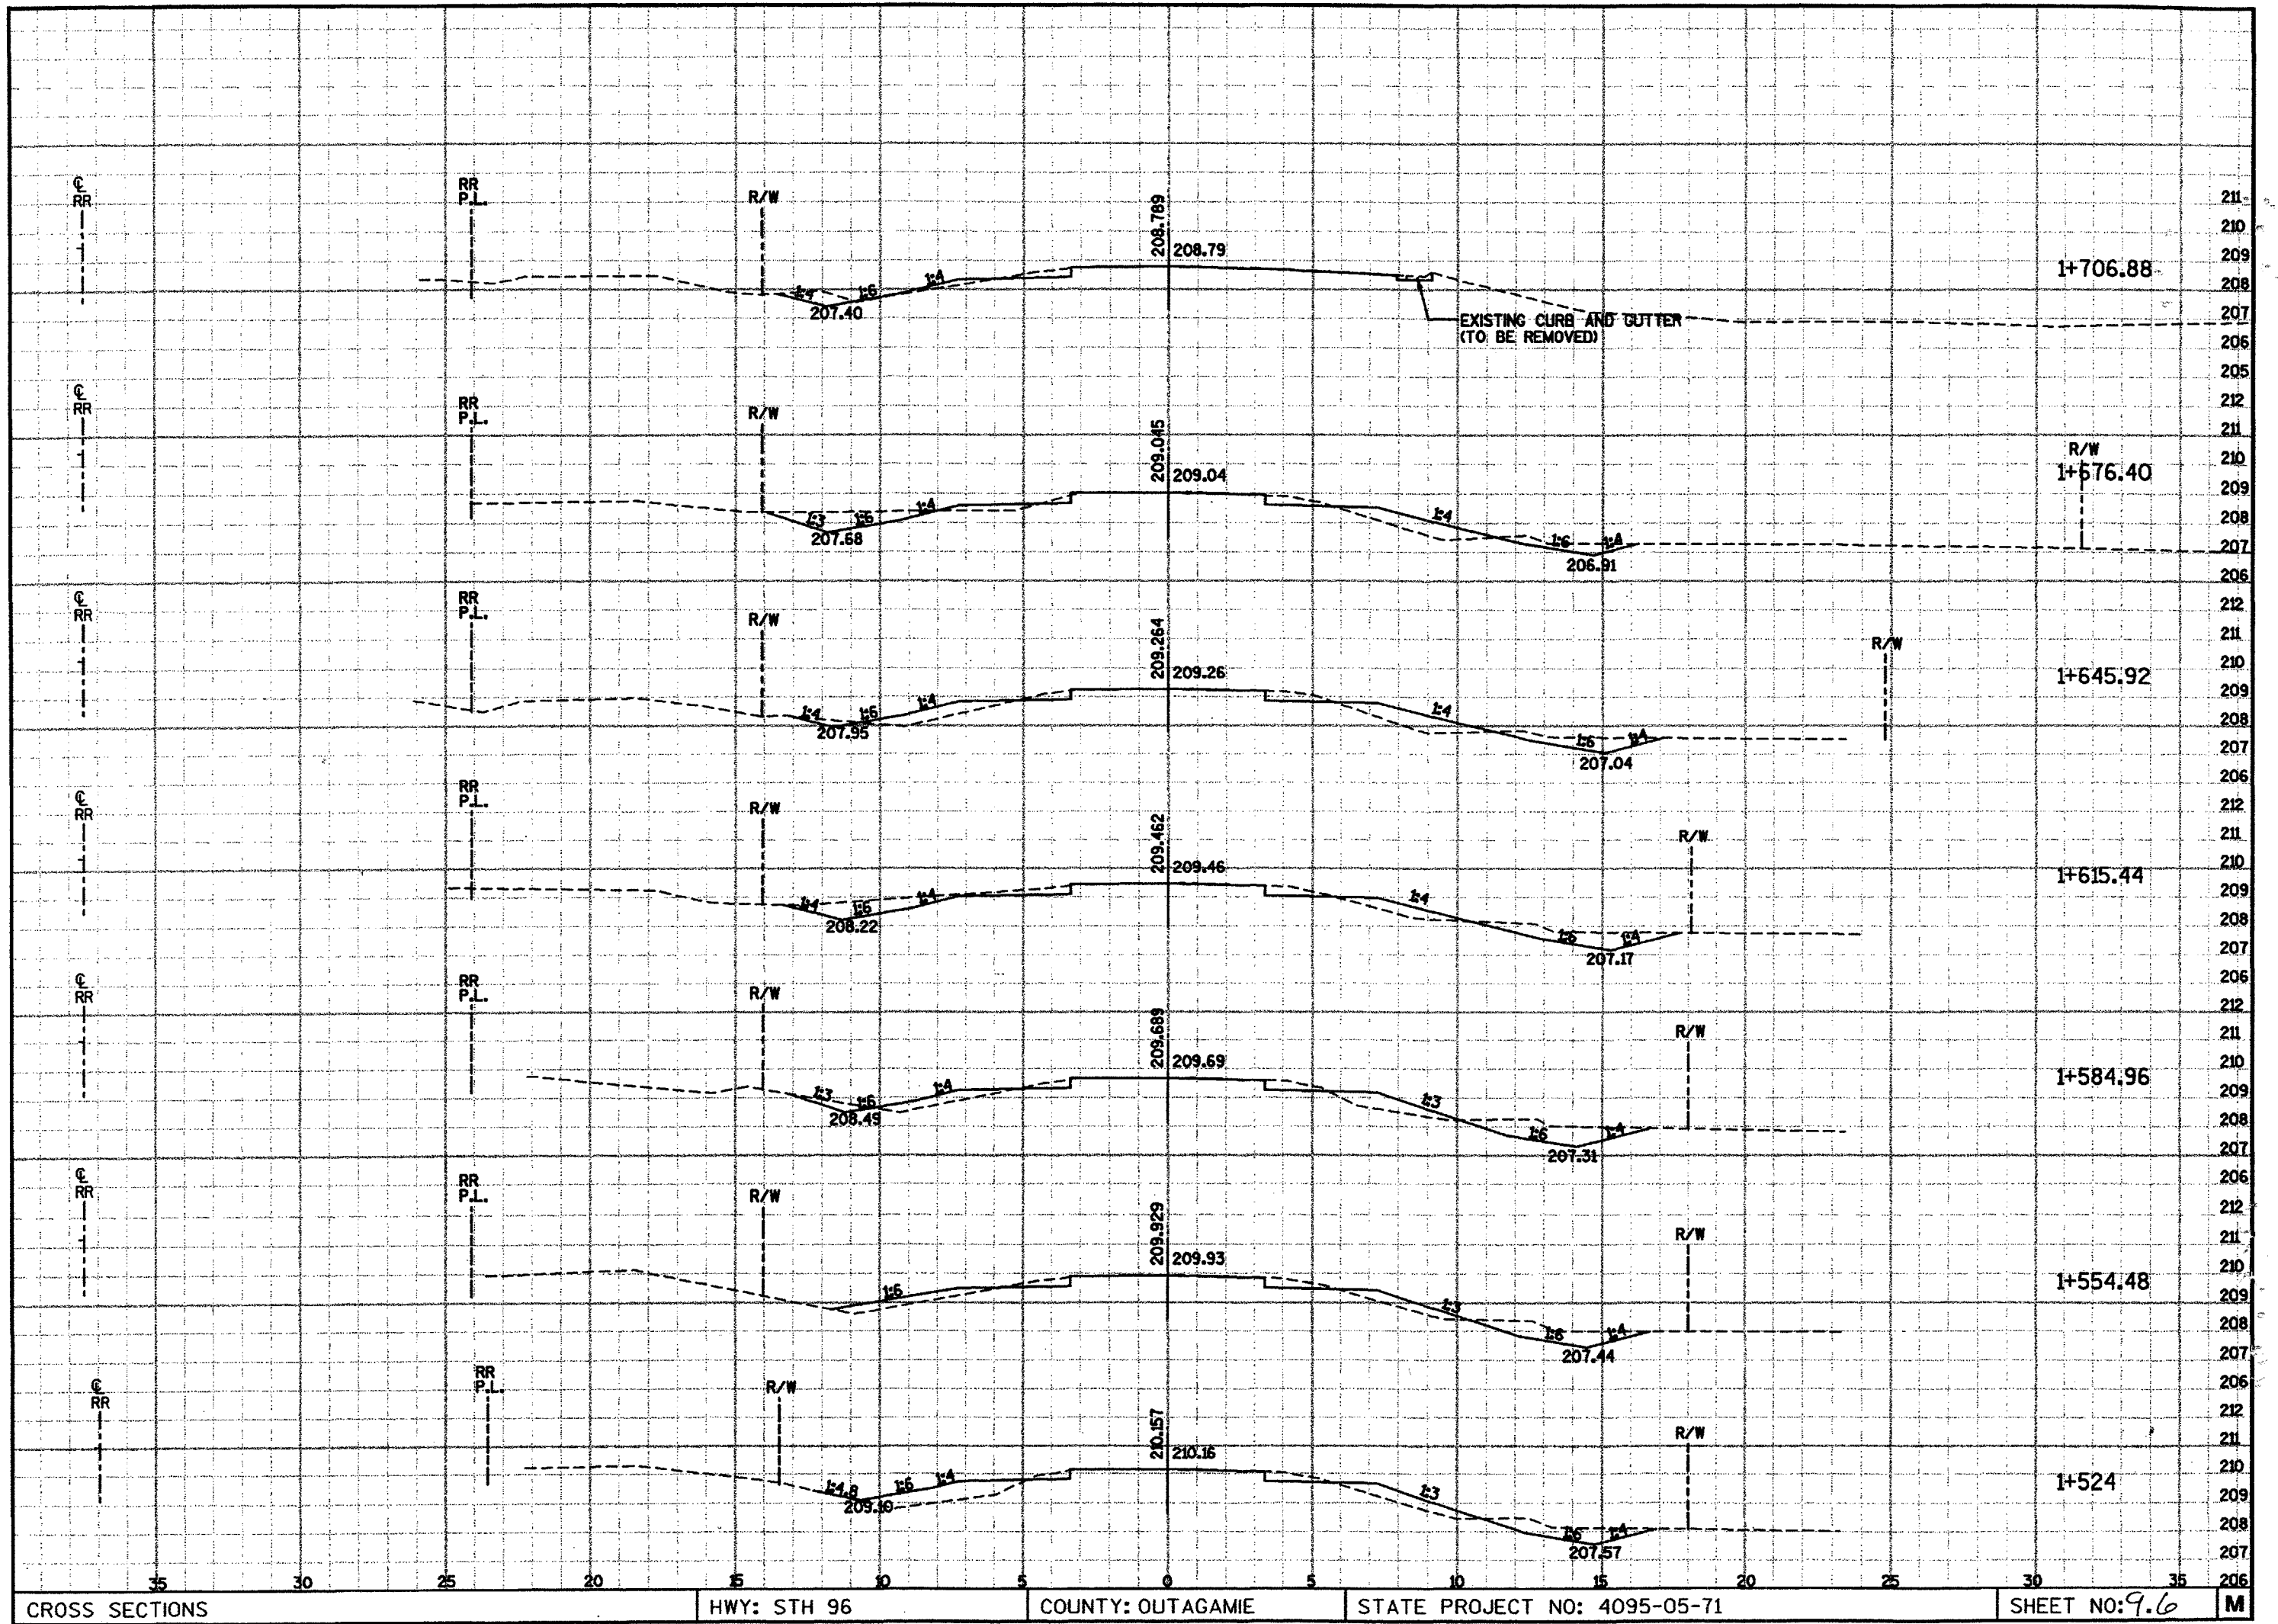


PLOT SCALE:

PLOT NAME:


REV. DATE:

ORIGINATOR:

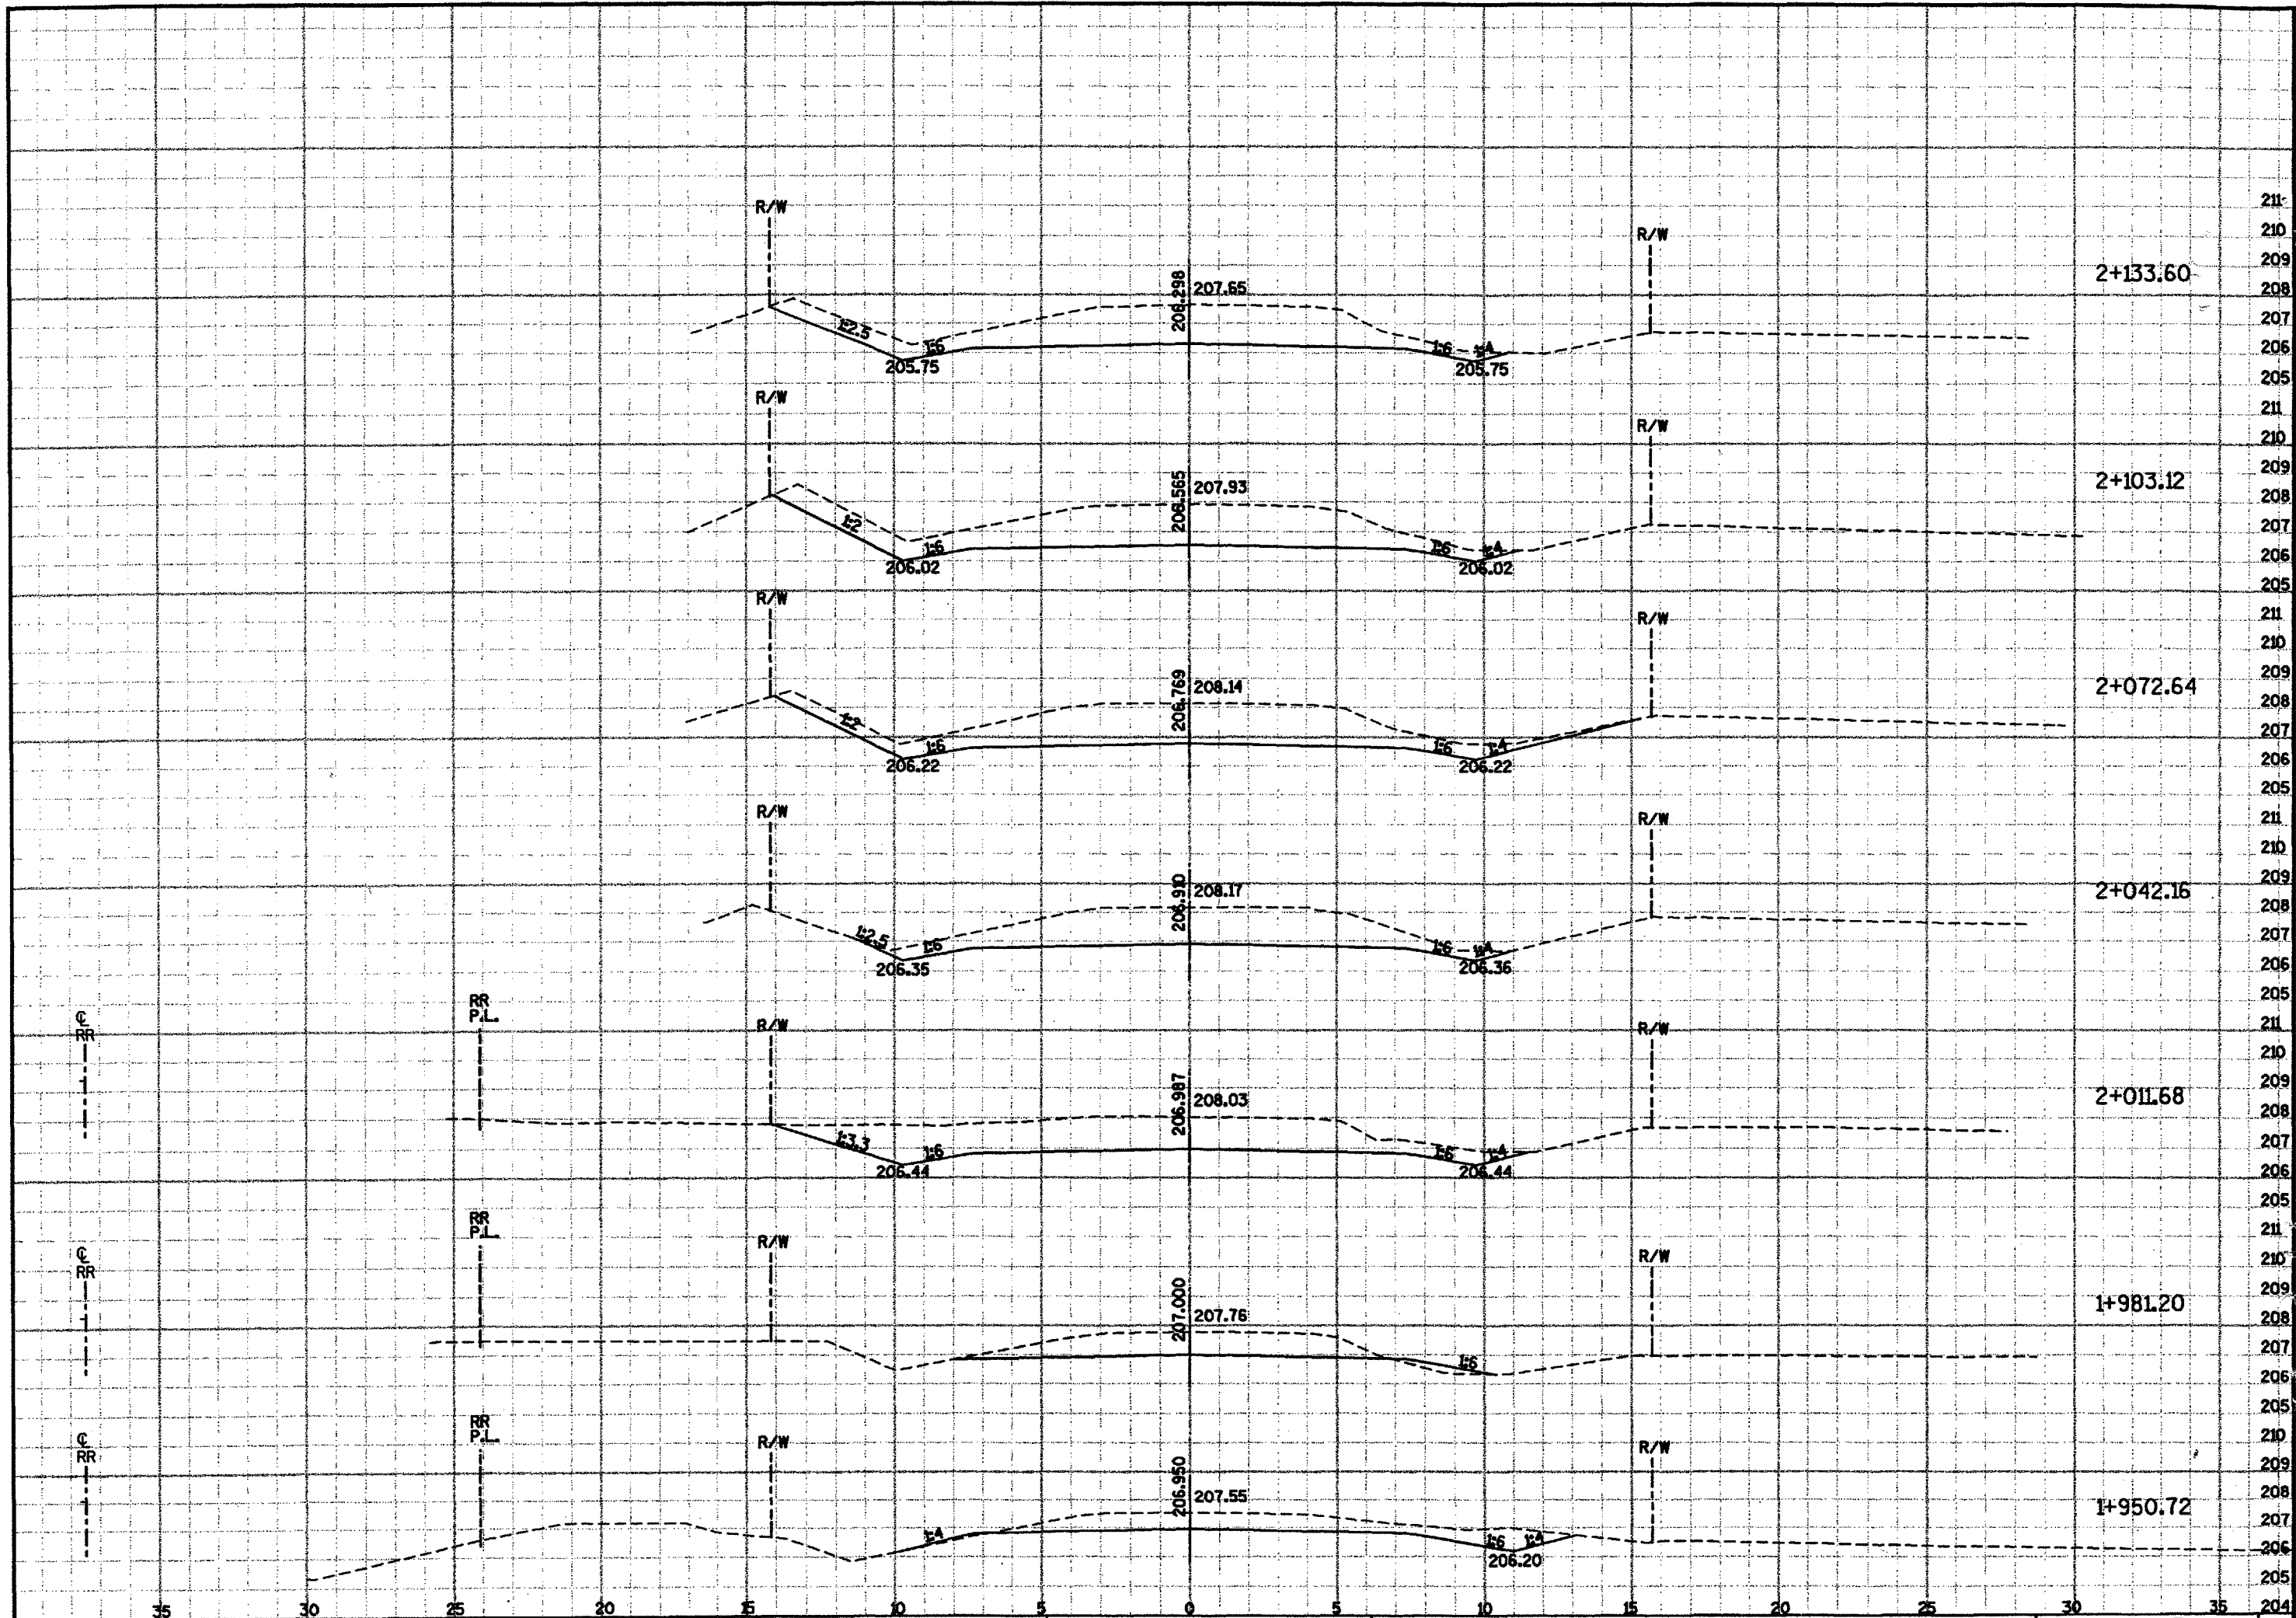


CROSS SECTIONS HWY: STH 96 COUNTY: OUTAGAMIE STATE PROJECT NO: 4095-05-71 SHEET NO: 9.8 M

ORIGINATOR:

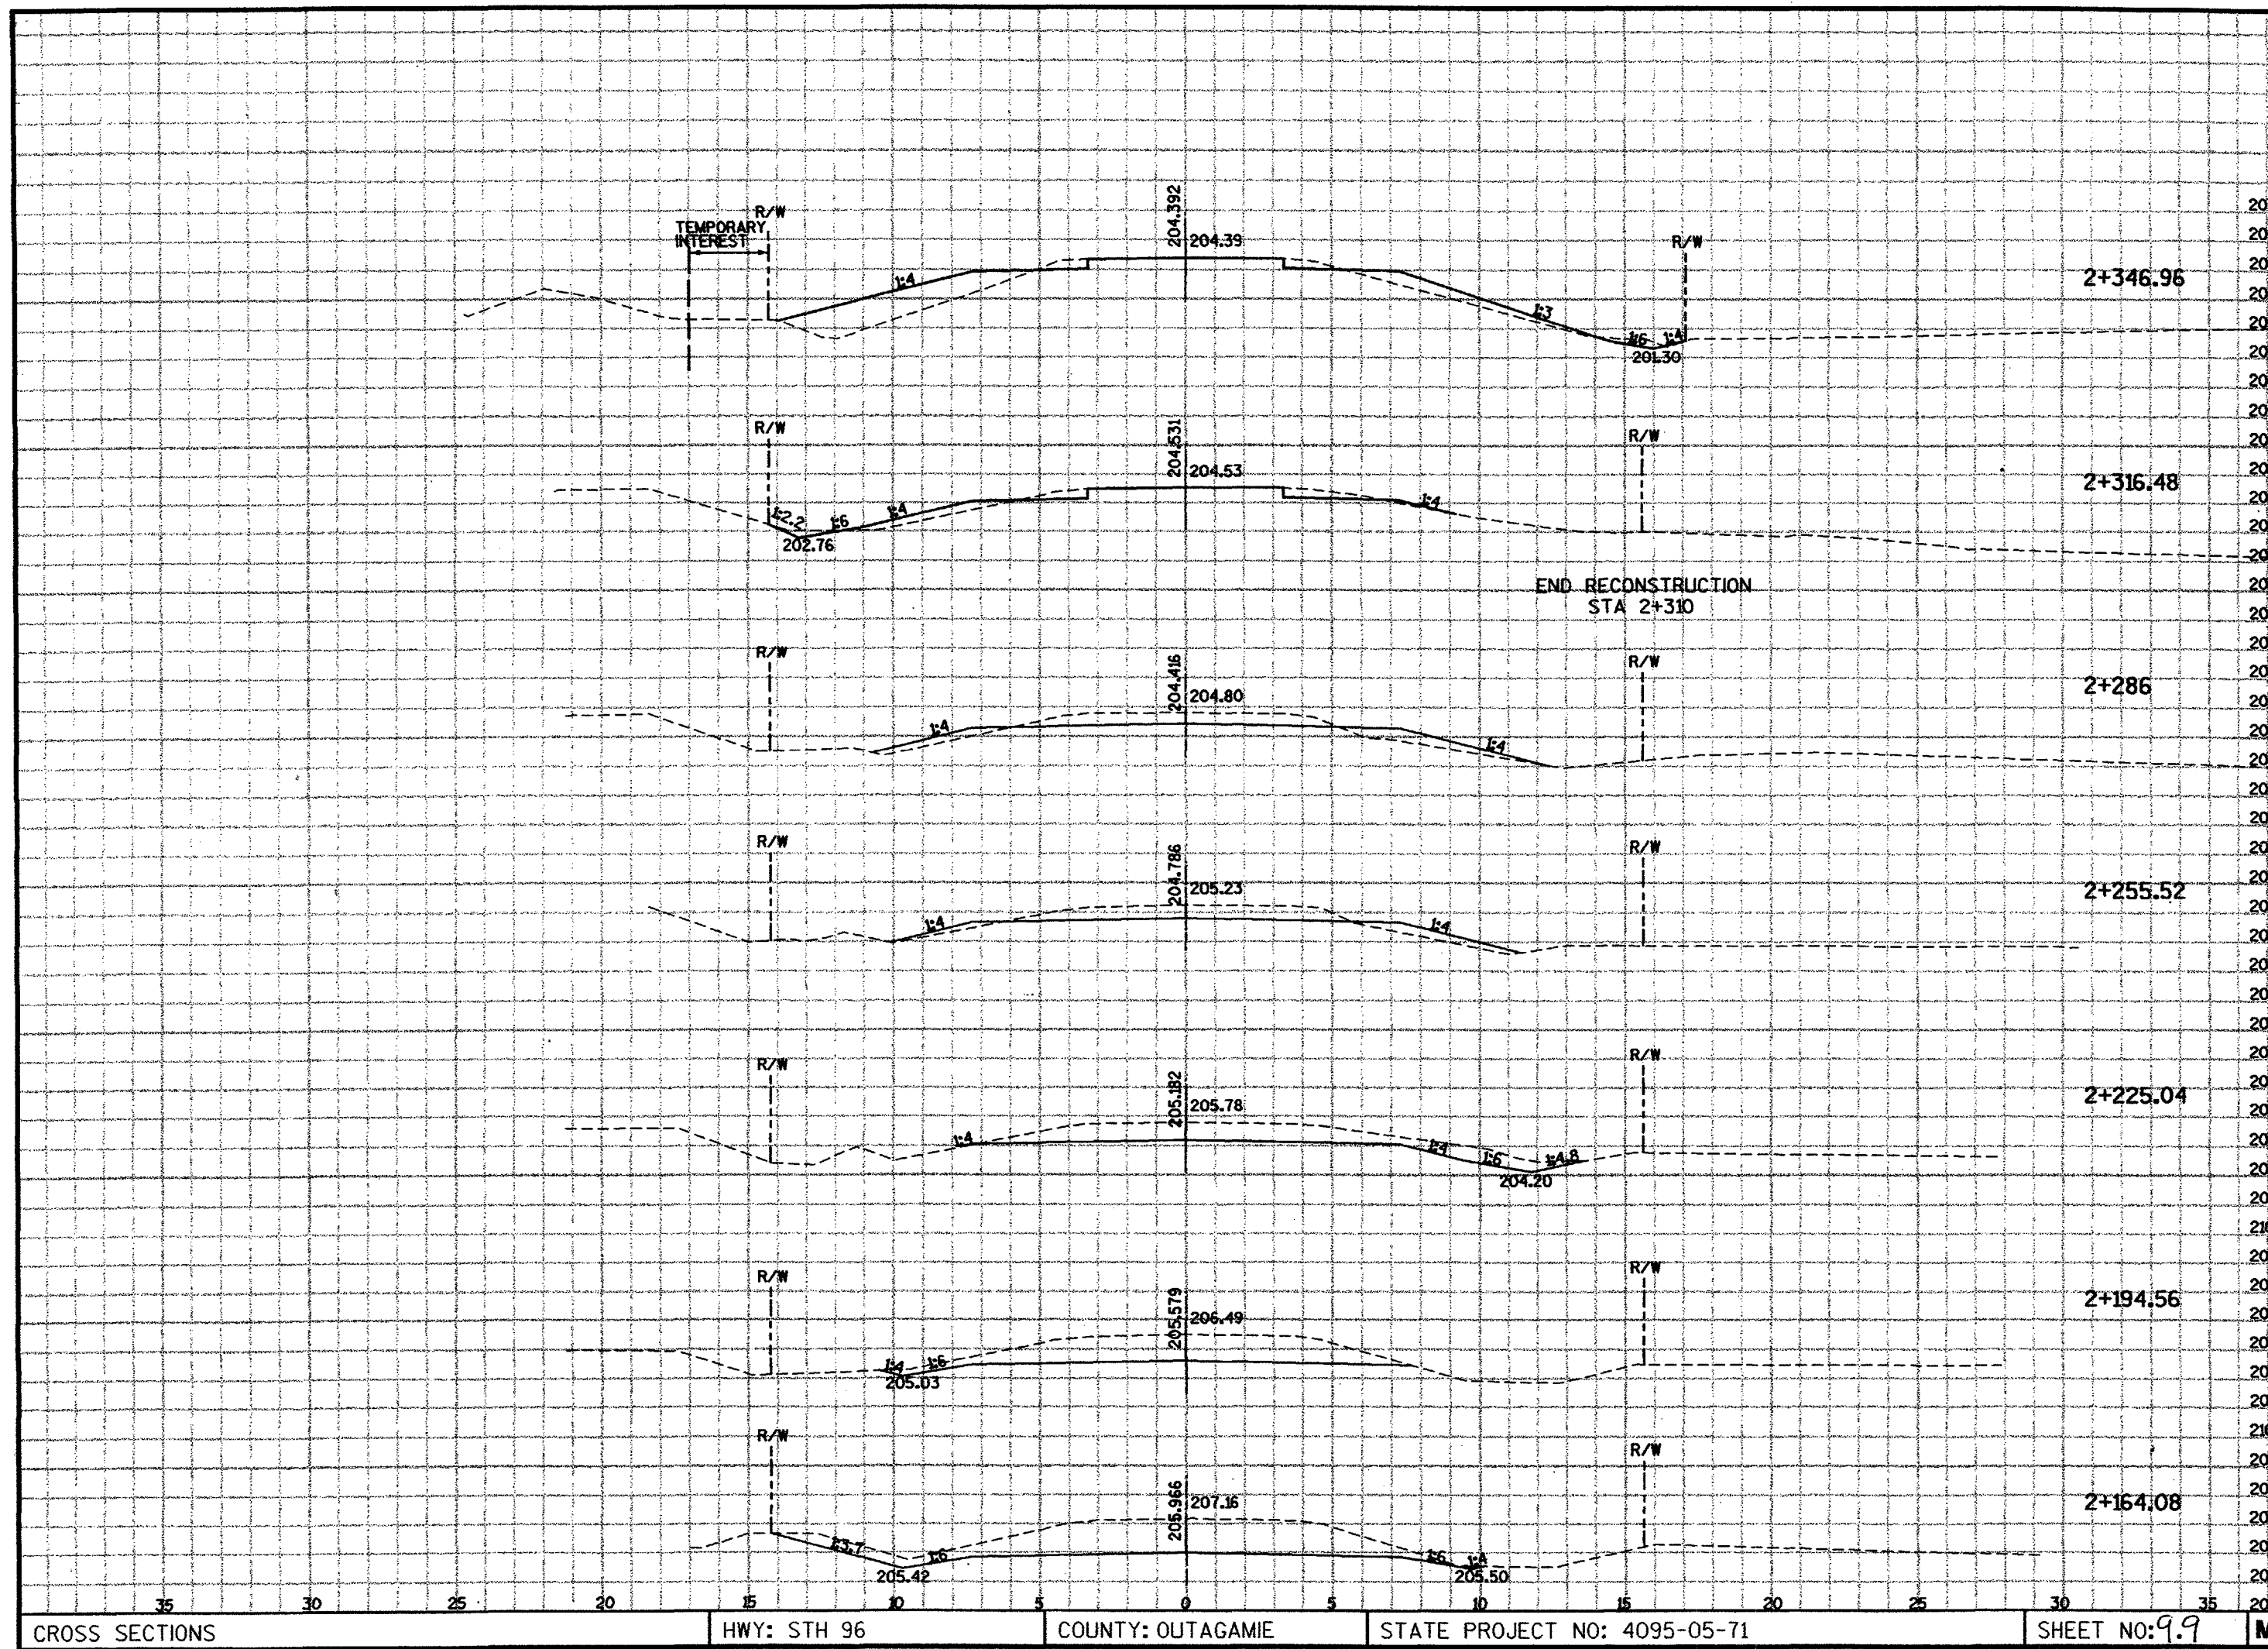

ORIGINATOR:

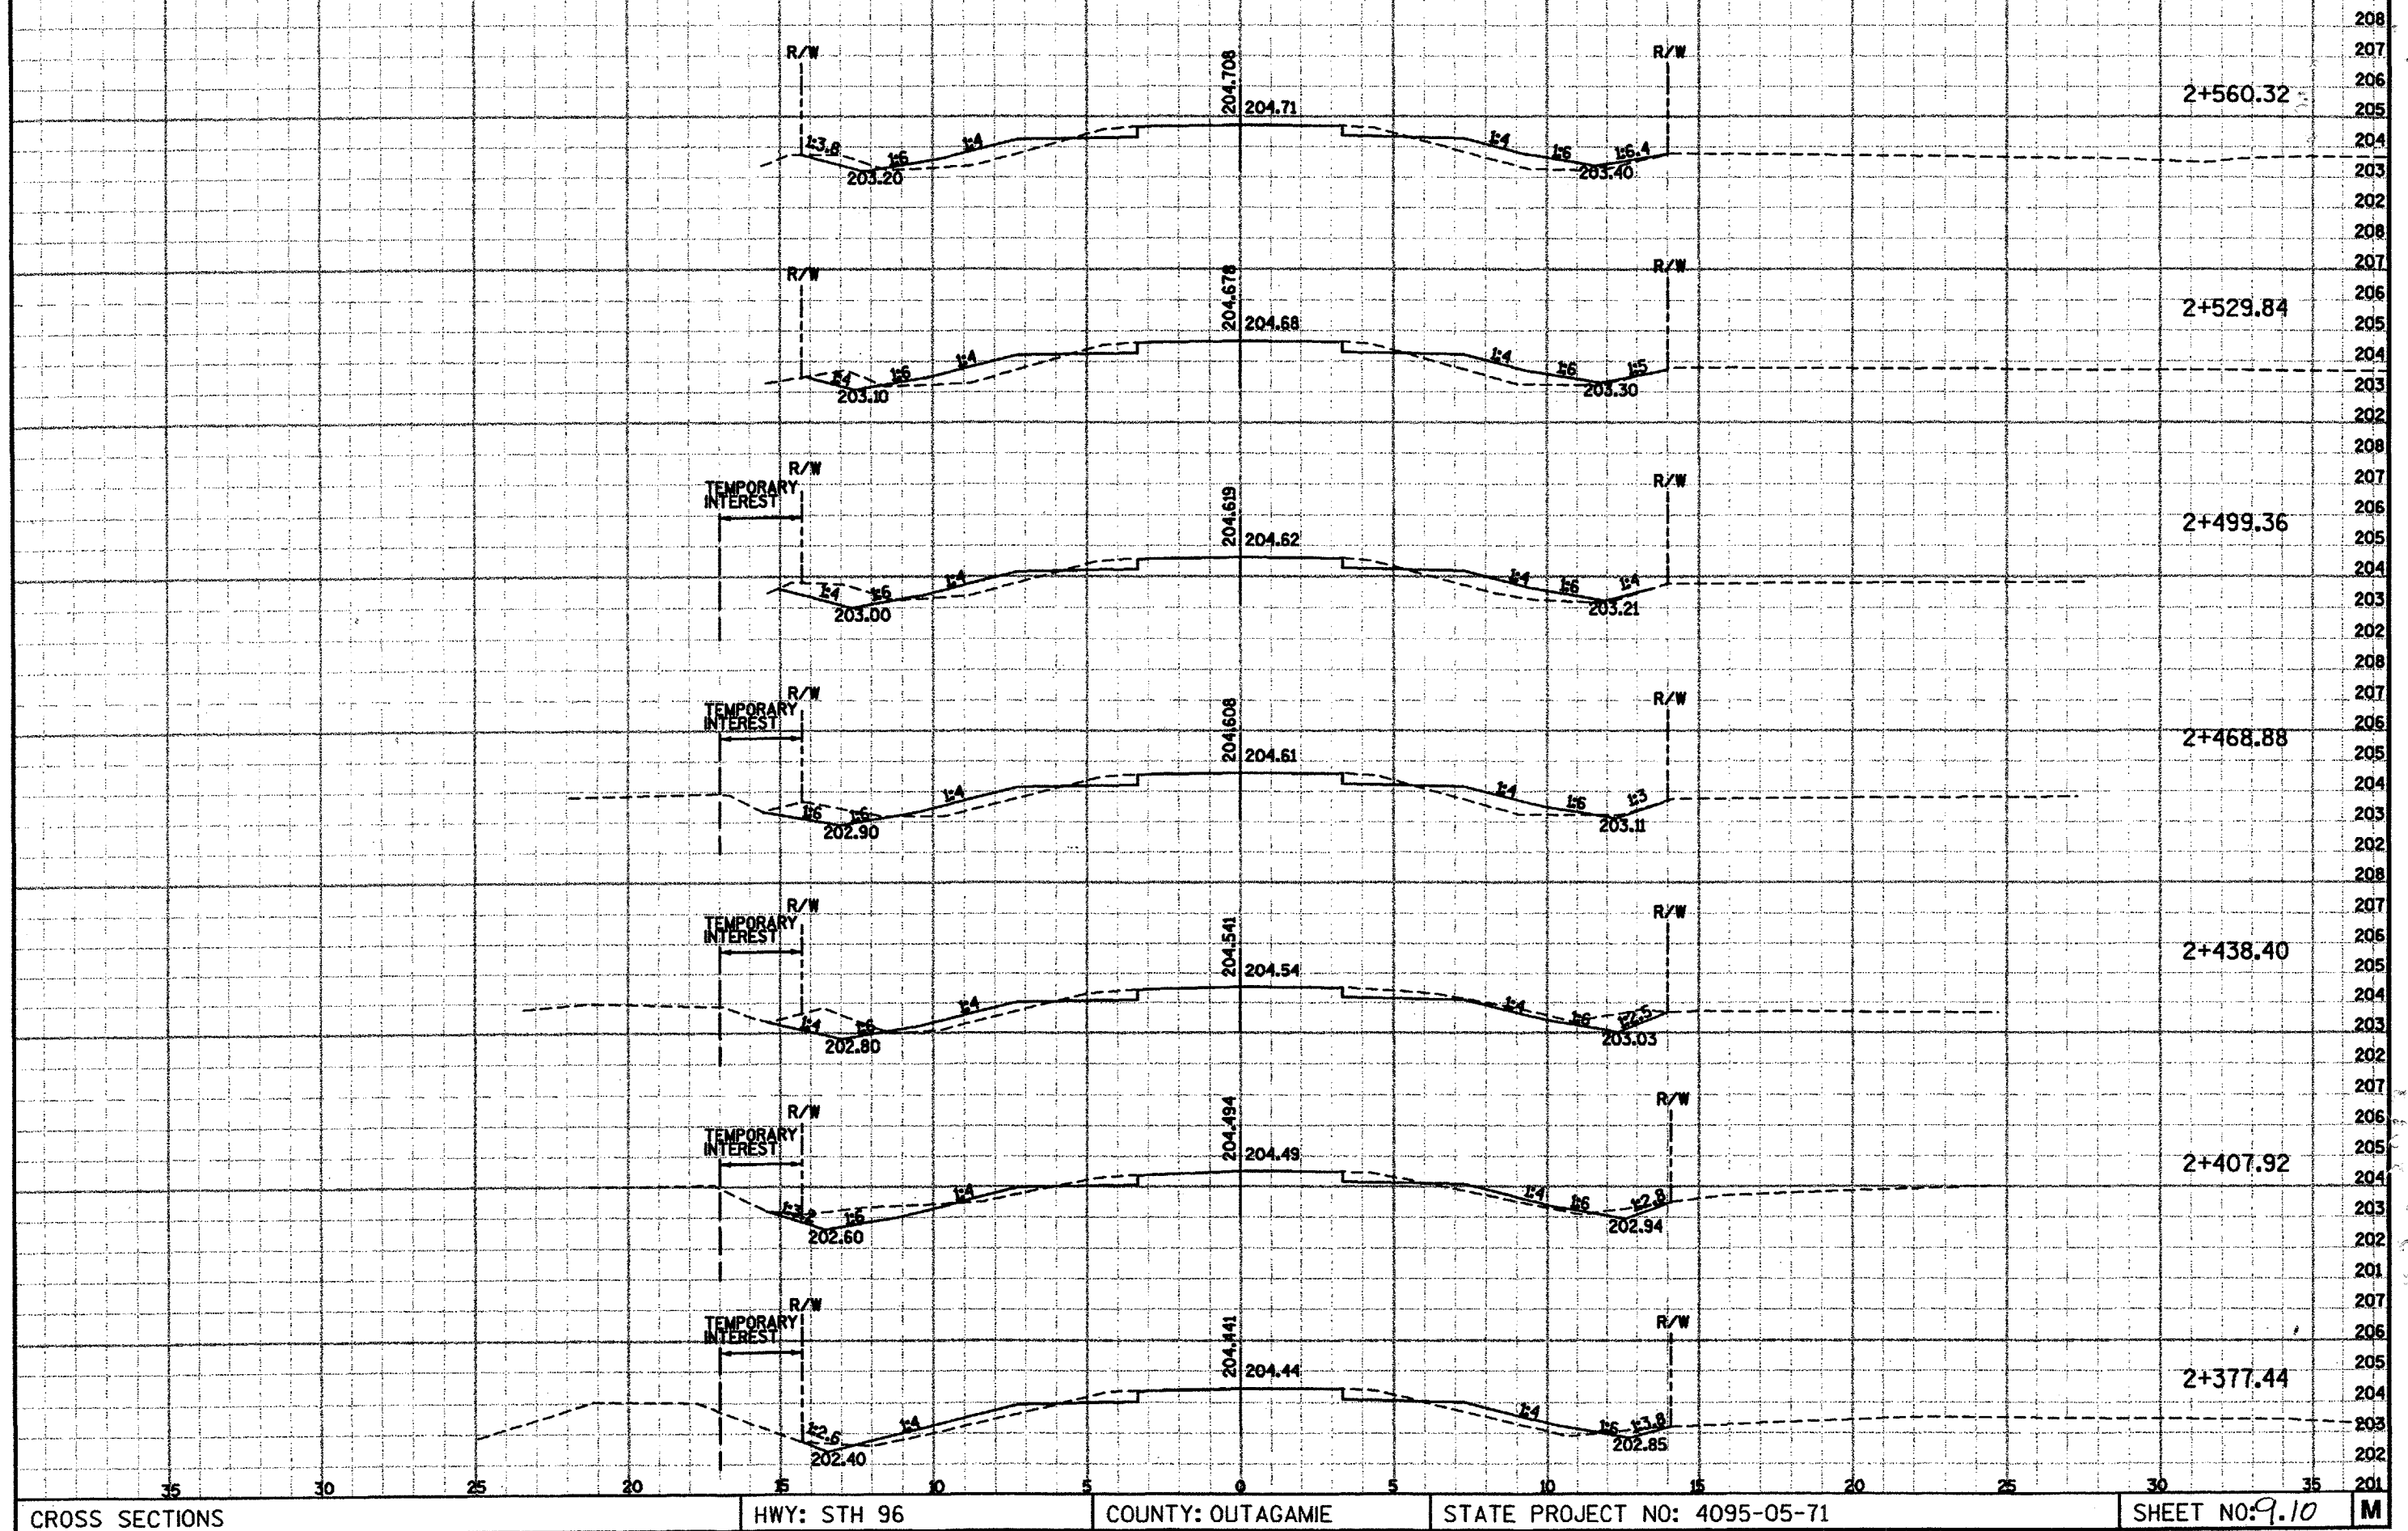


PLOT SCALE: 1"=40'

PLOT NAME:

REV. DATE:

ORIGINATOR:

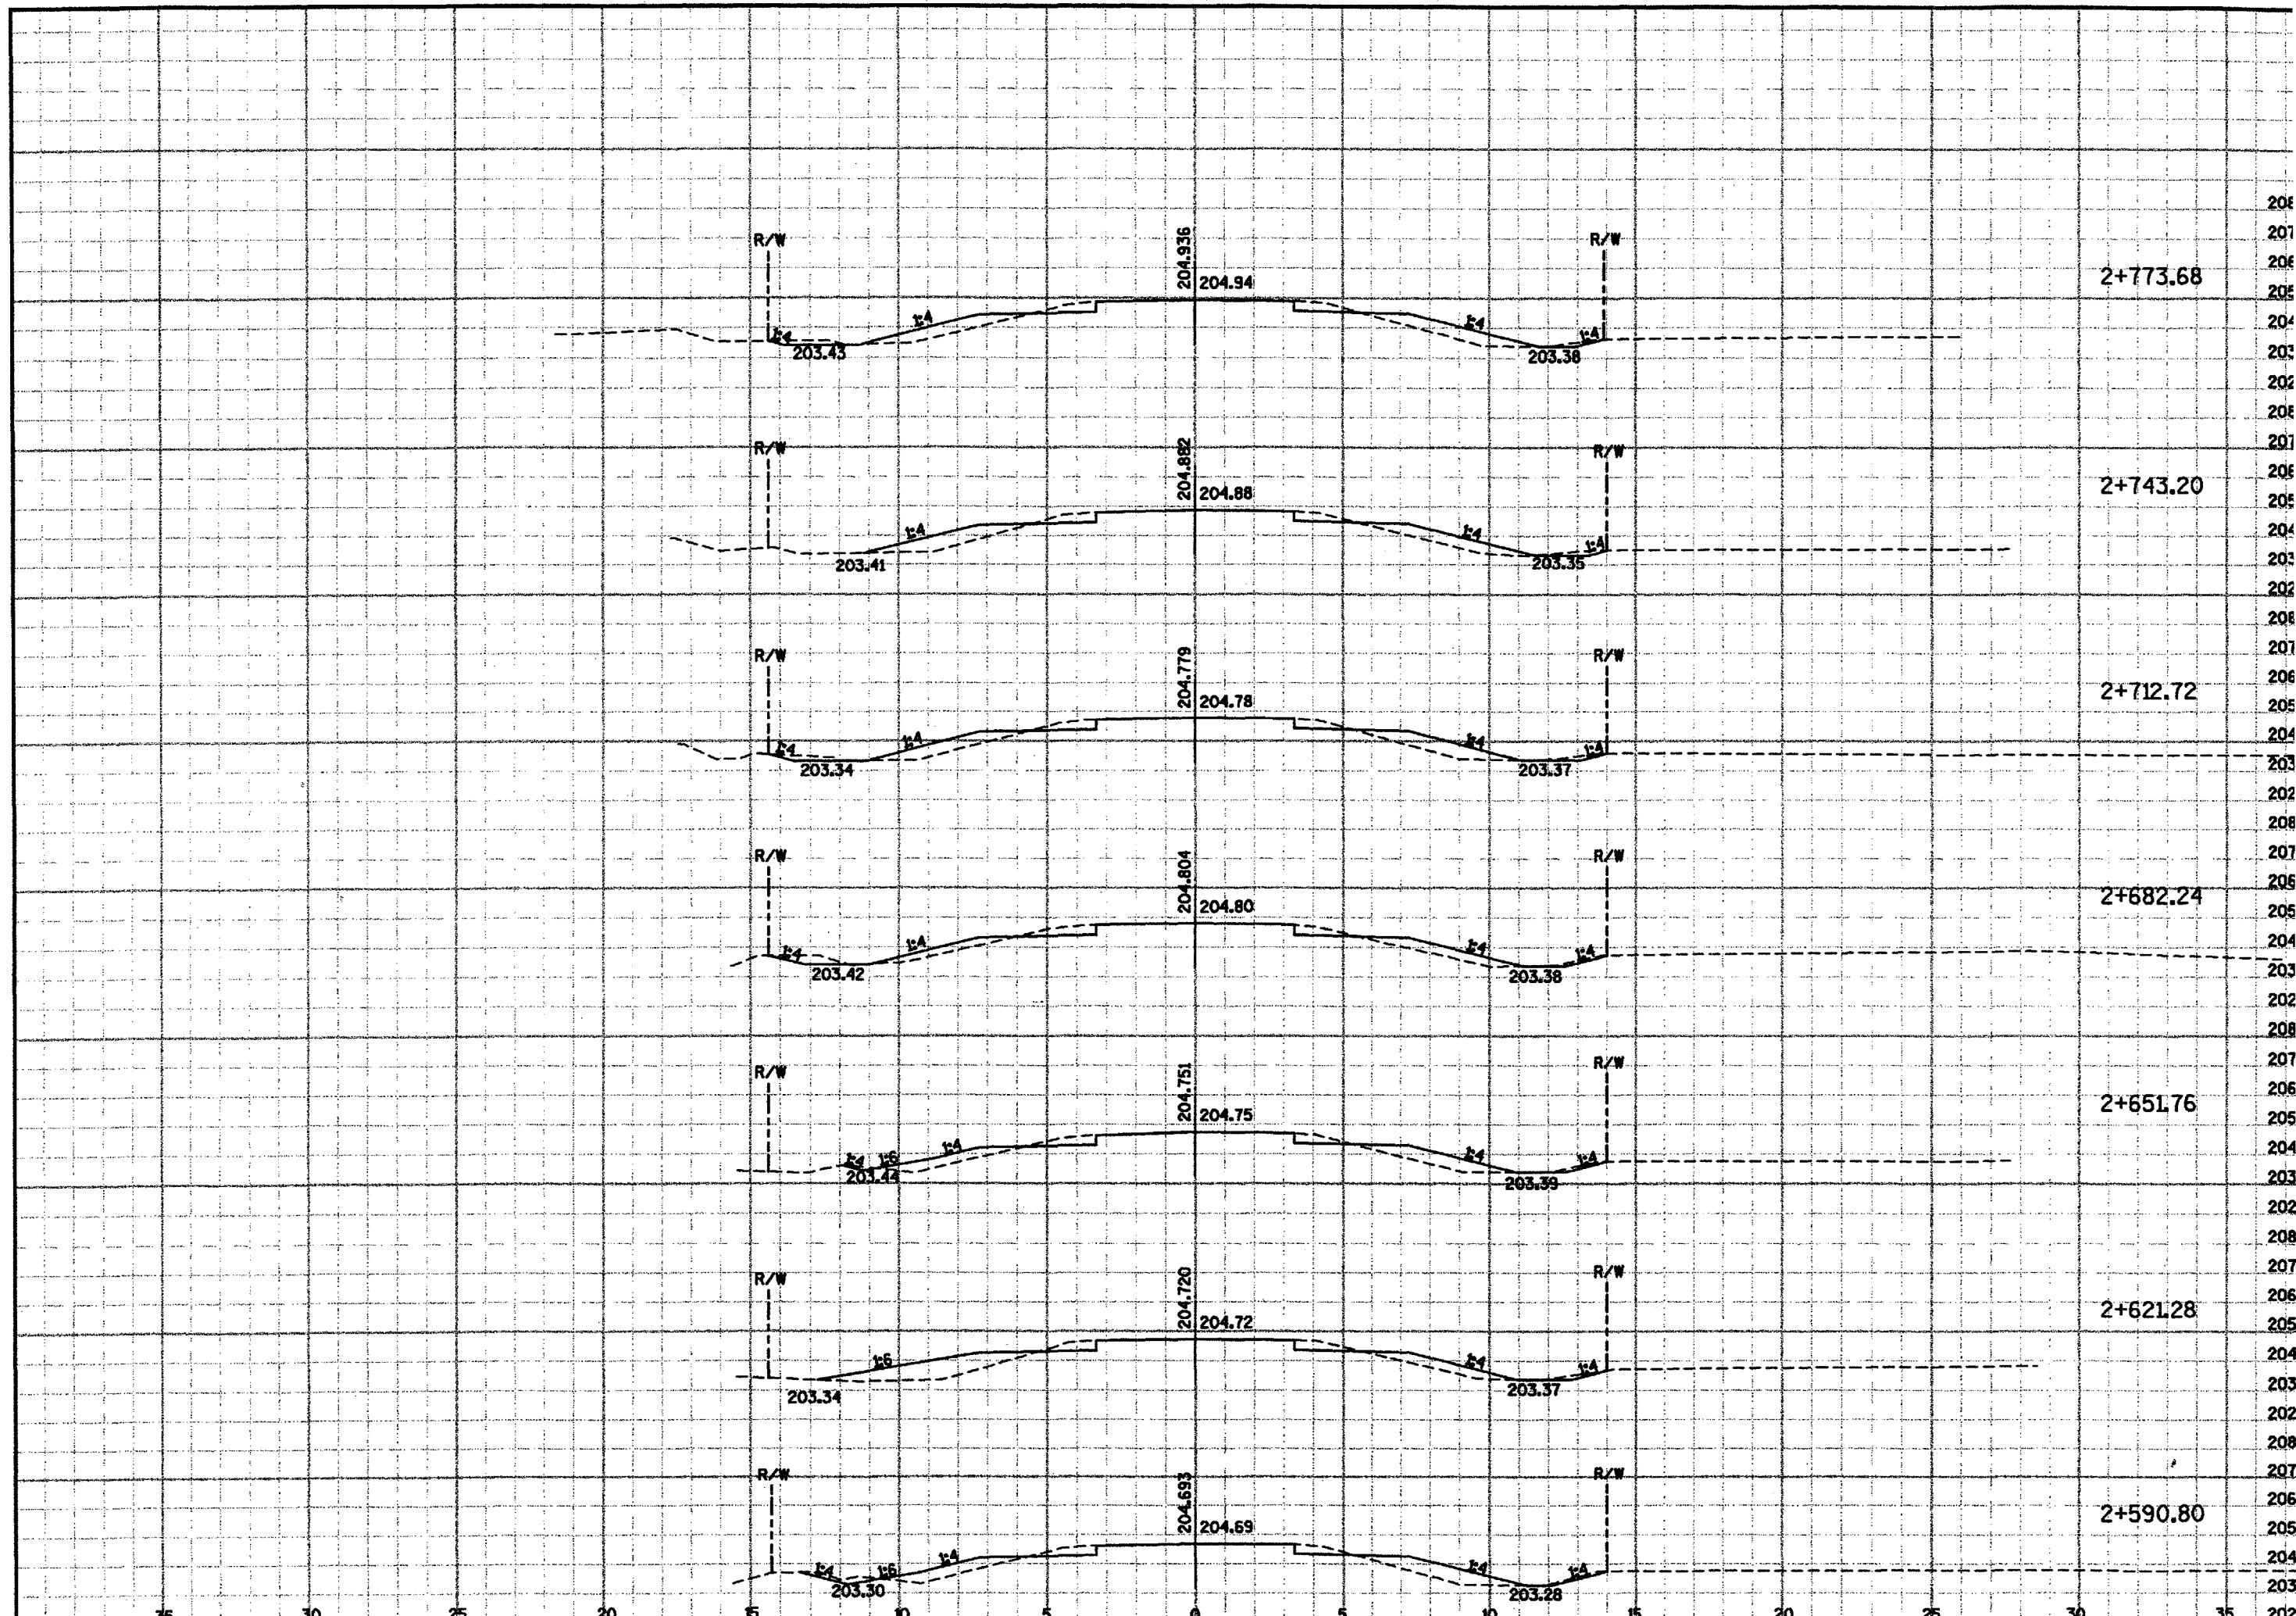


CROSS SECTIONS	HWY: STH 96	COUNTY: OUTAGAMIE	STATE PROJECT NO: 4095-05-71	SHEET NO: 9.11	M
----------------	-------------	-------------------	------------------------------	----------------	---

PLOT SCALE:

PLOT NAME:

REV. DATE:

ORIGINATOR:

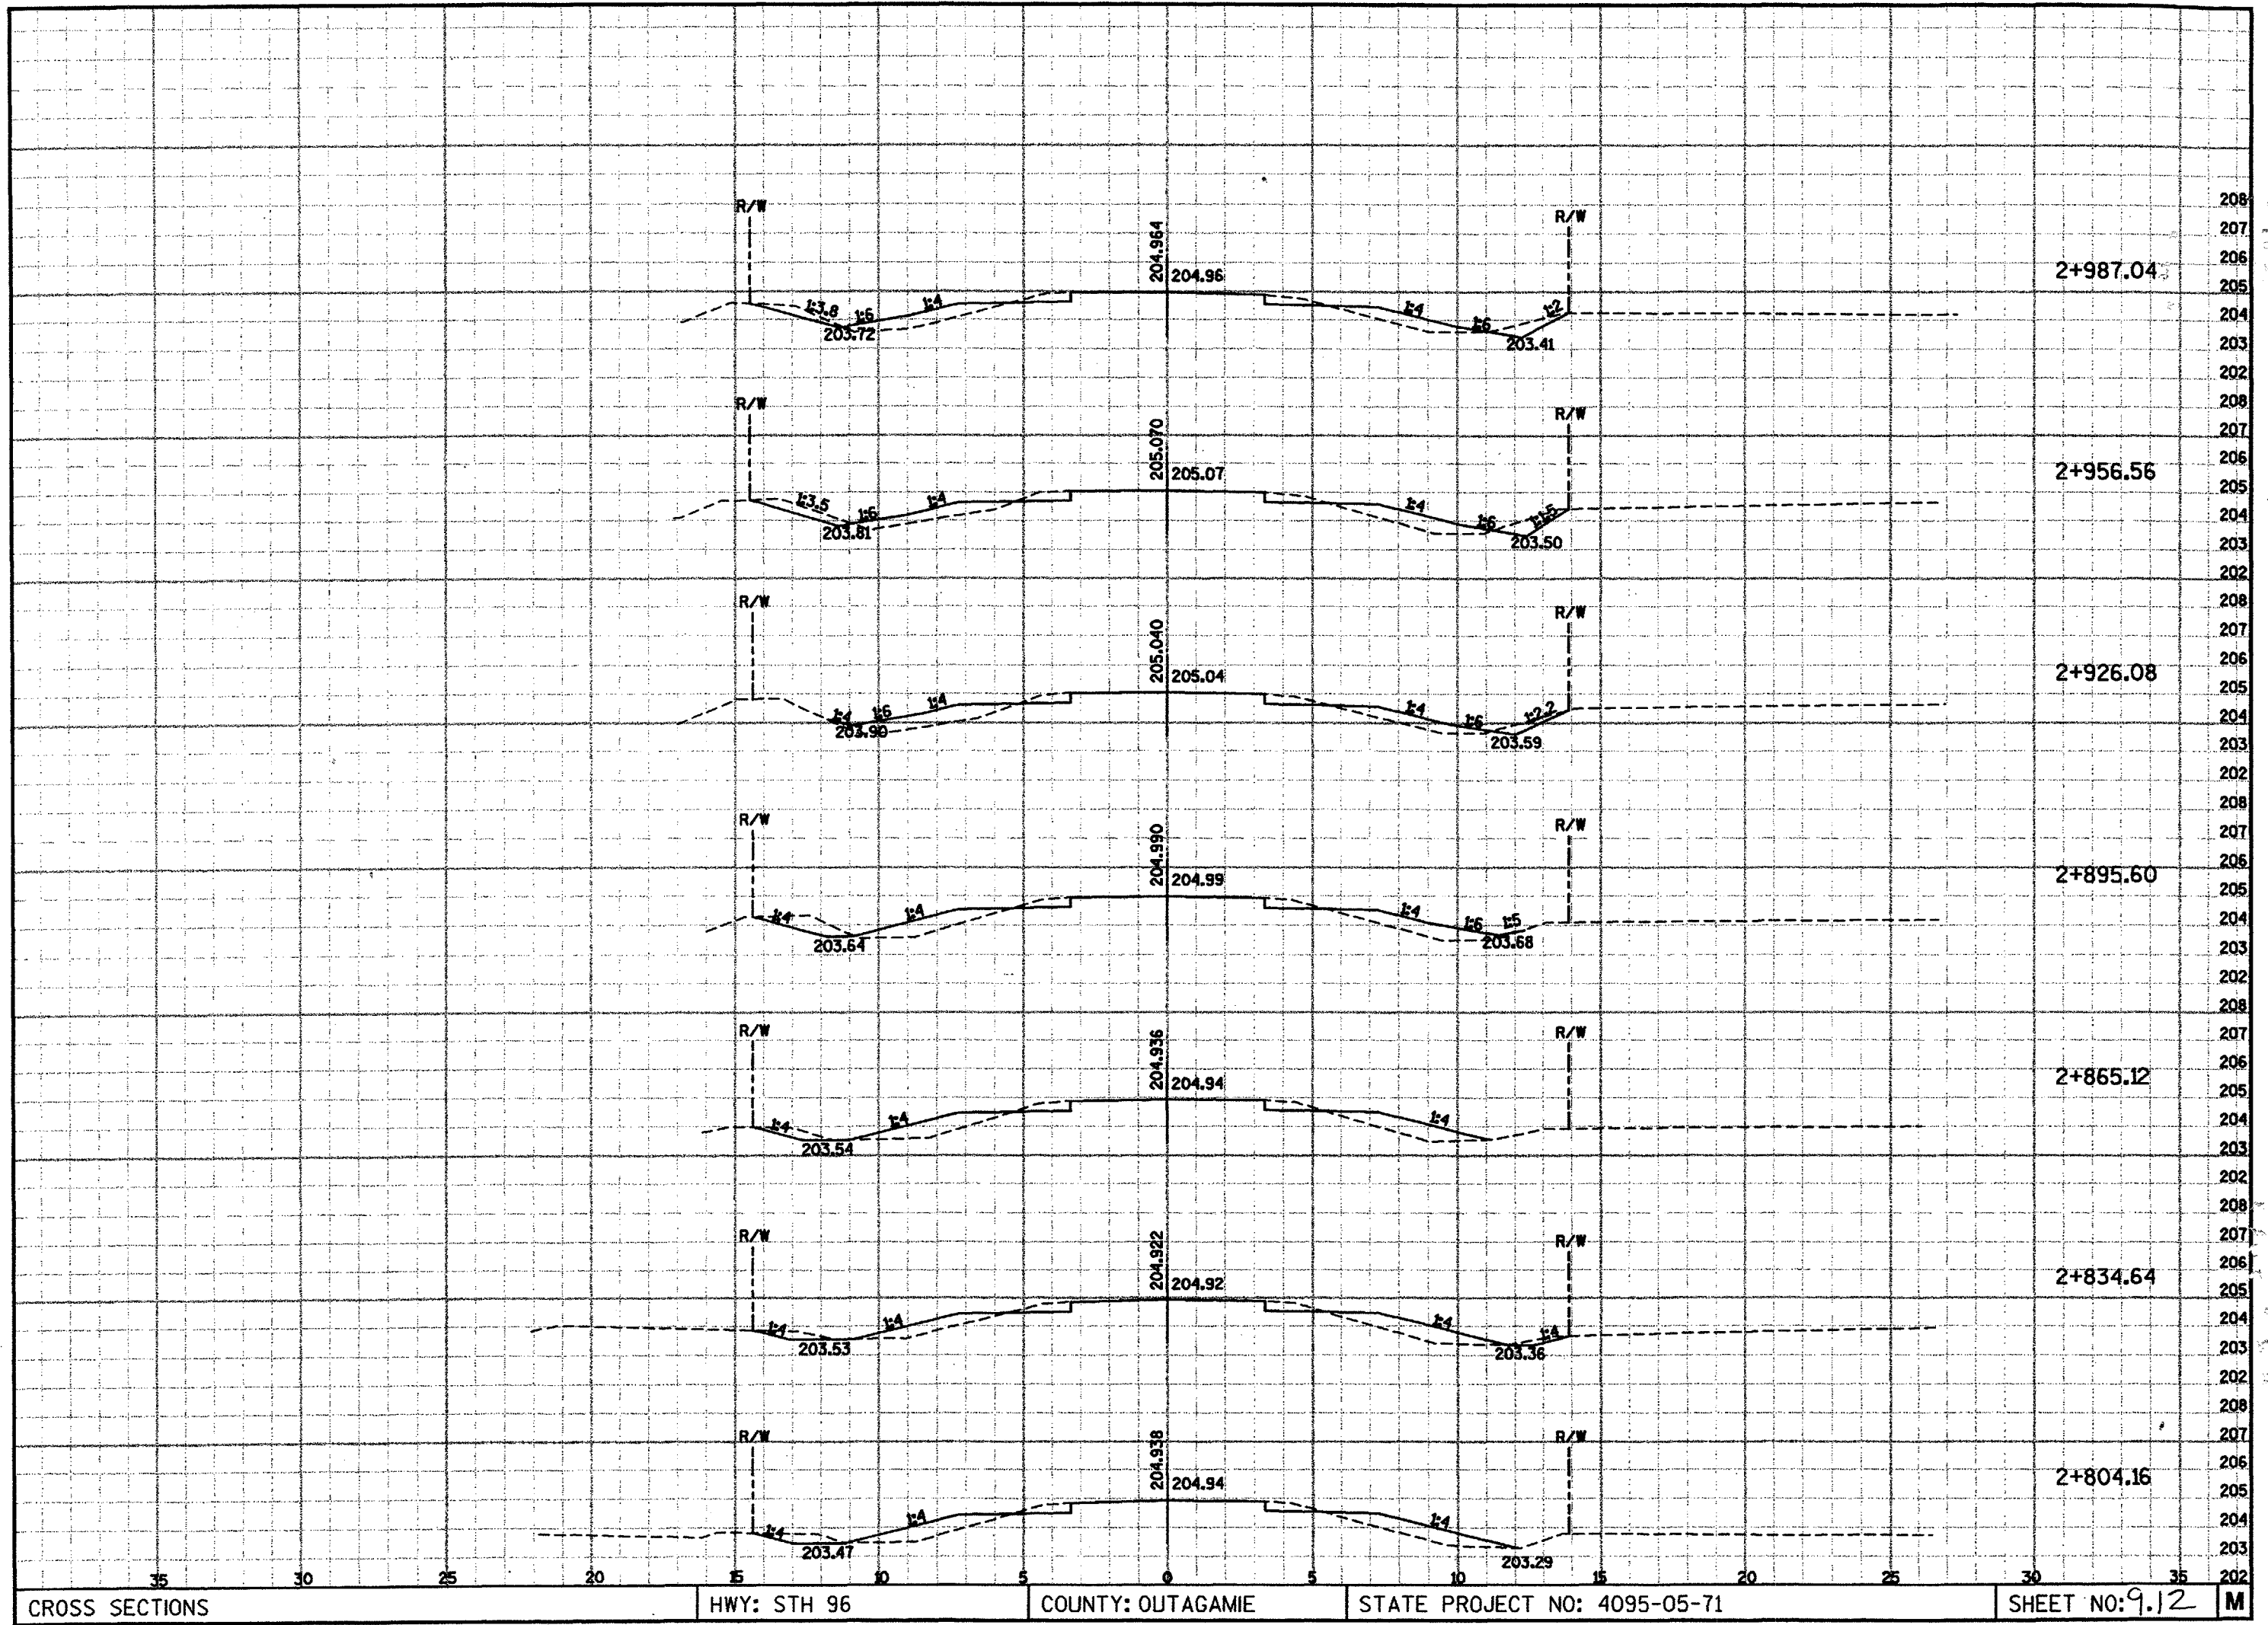


PLOT SCALE: 1" = 20'

PLOT NAME:

REV. DATE:

ORIGINATOR:

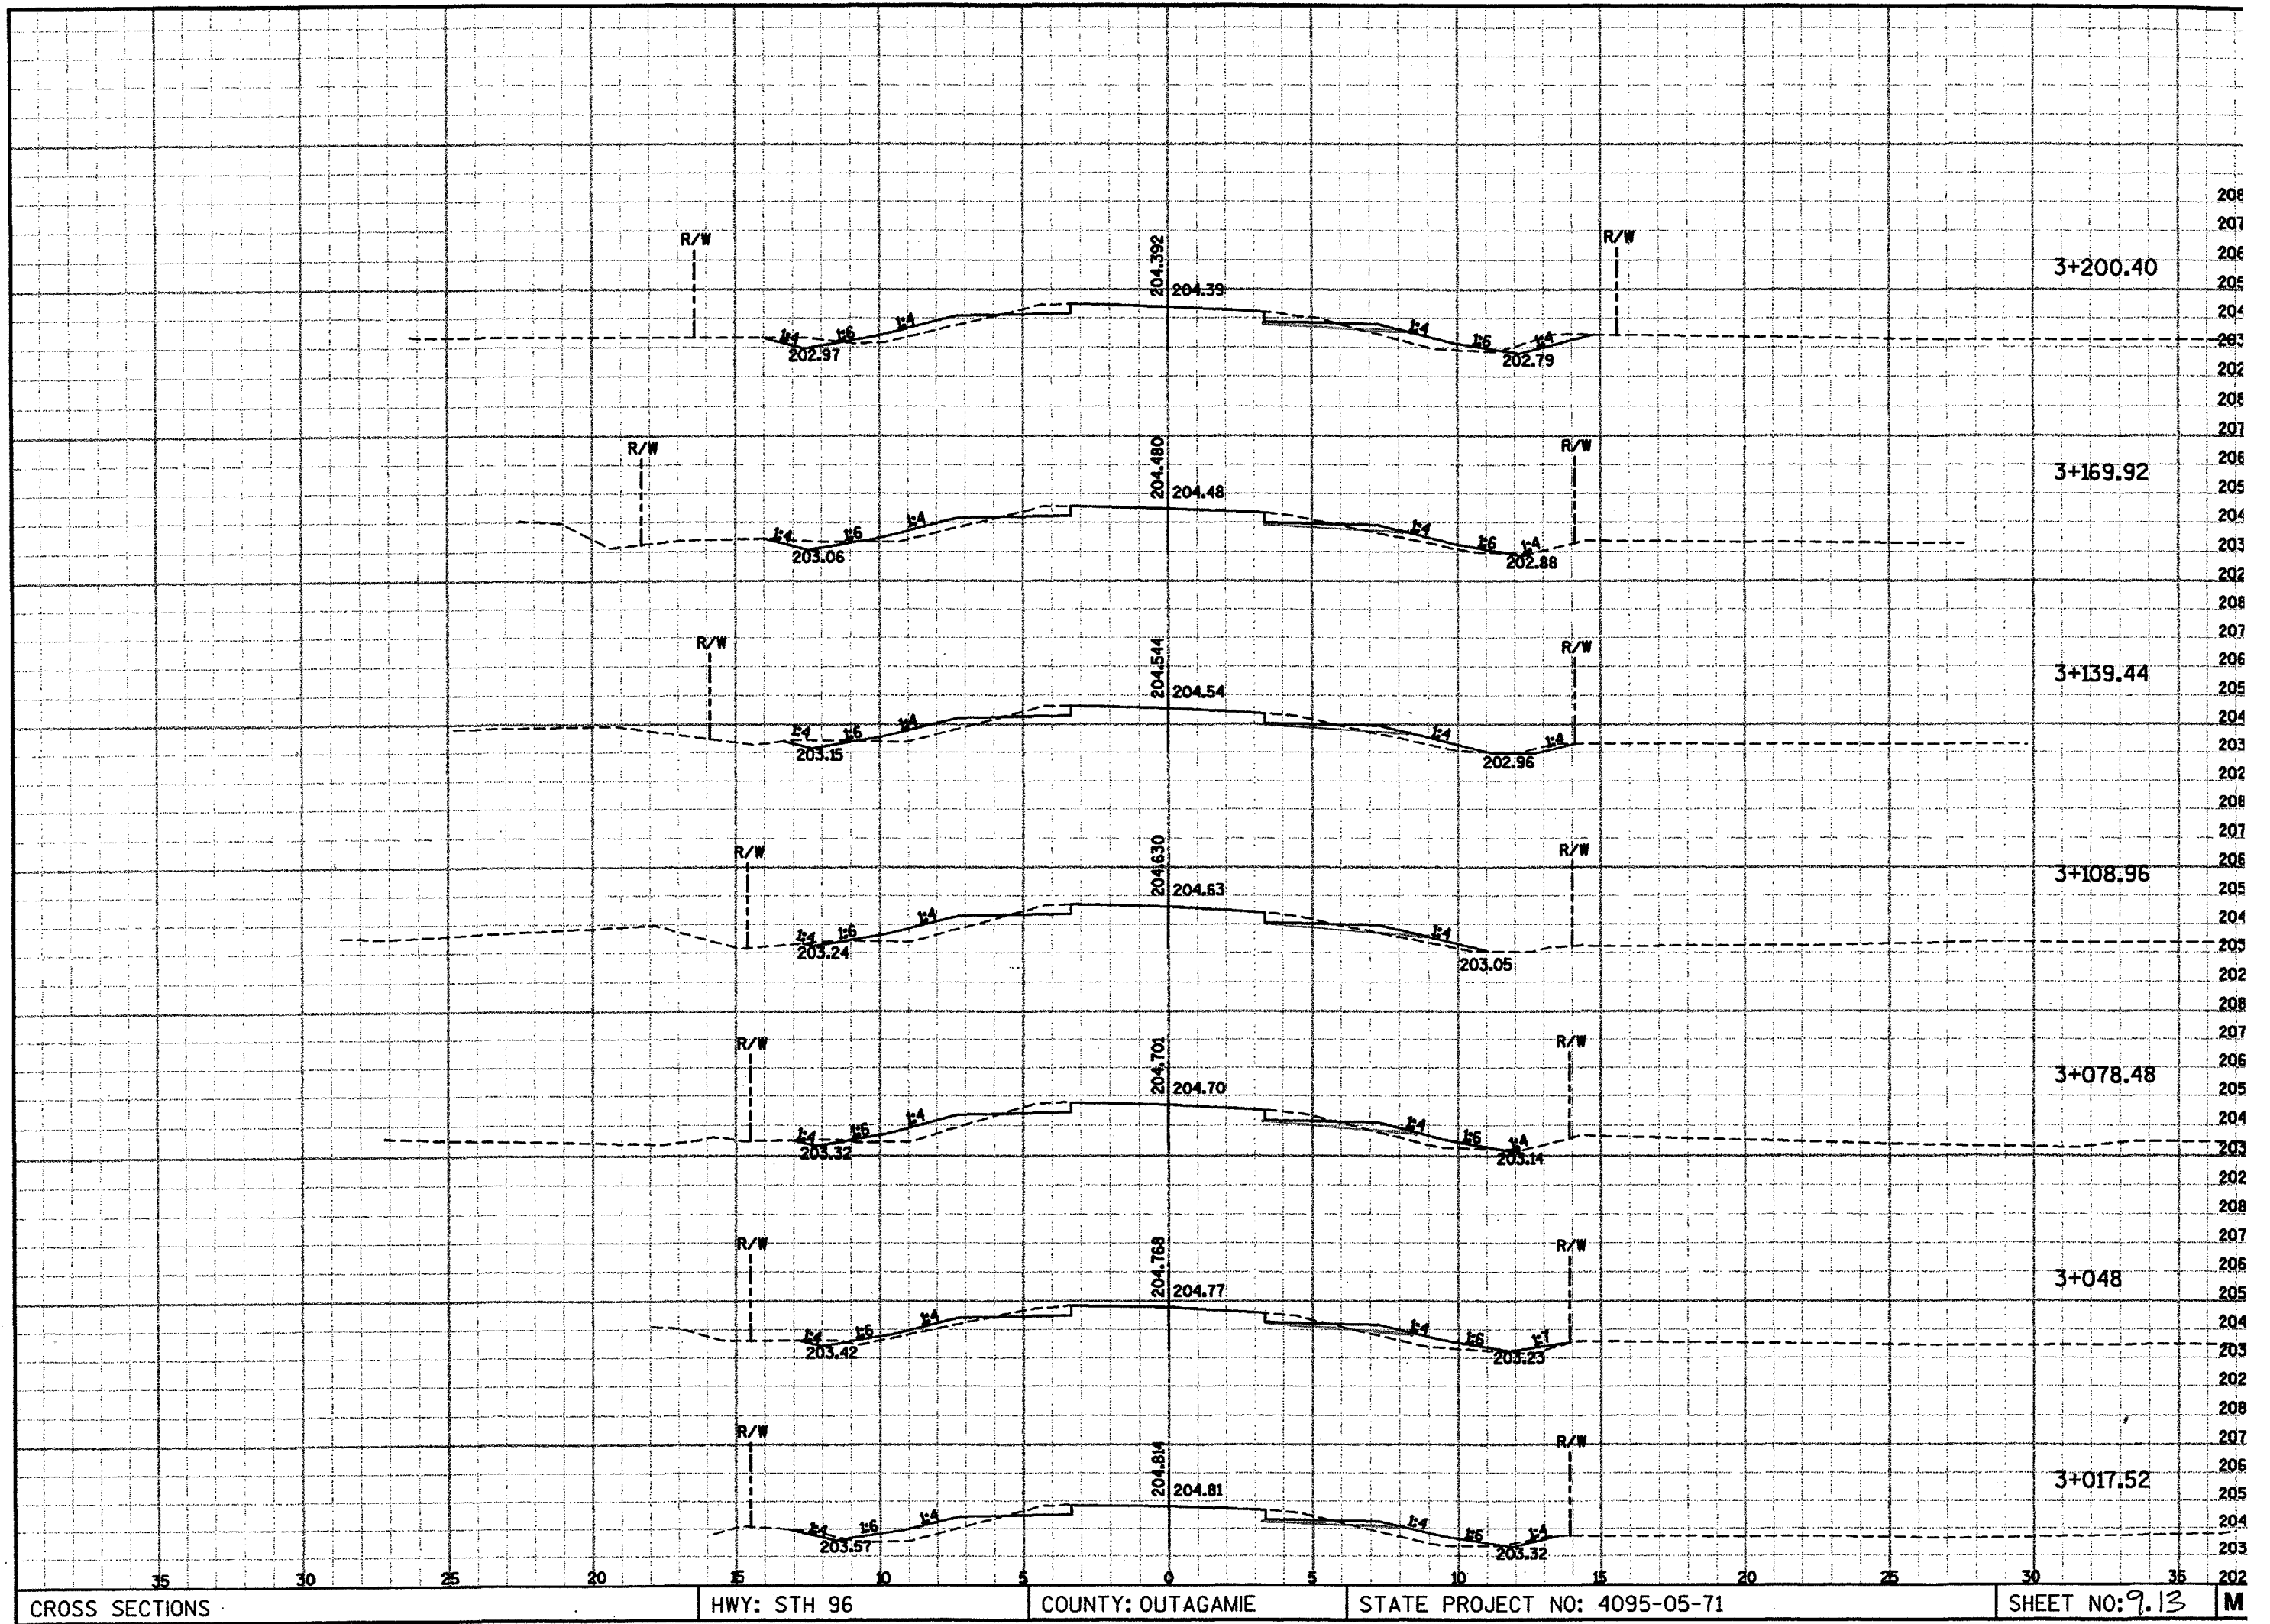


PLOT SCALE:

PLOT NAME:

REV. DATE:

ORIGINATOR:

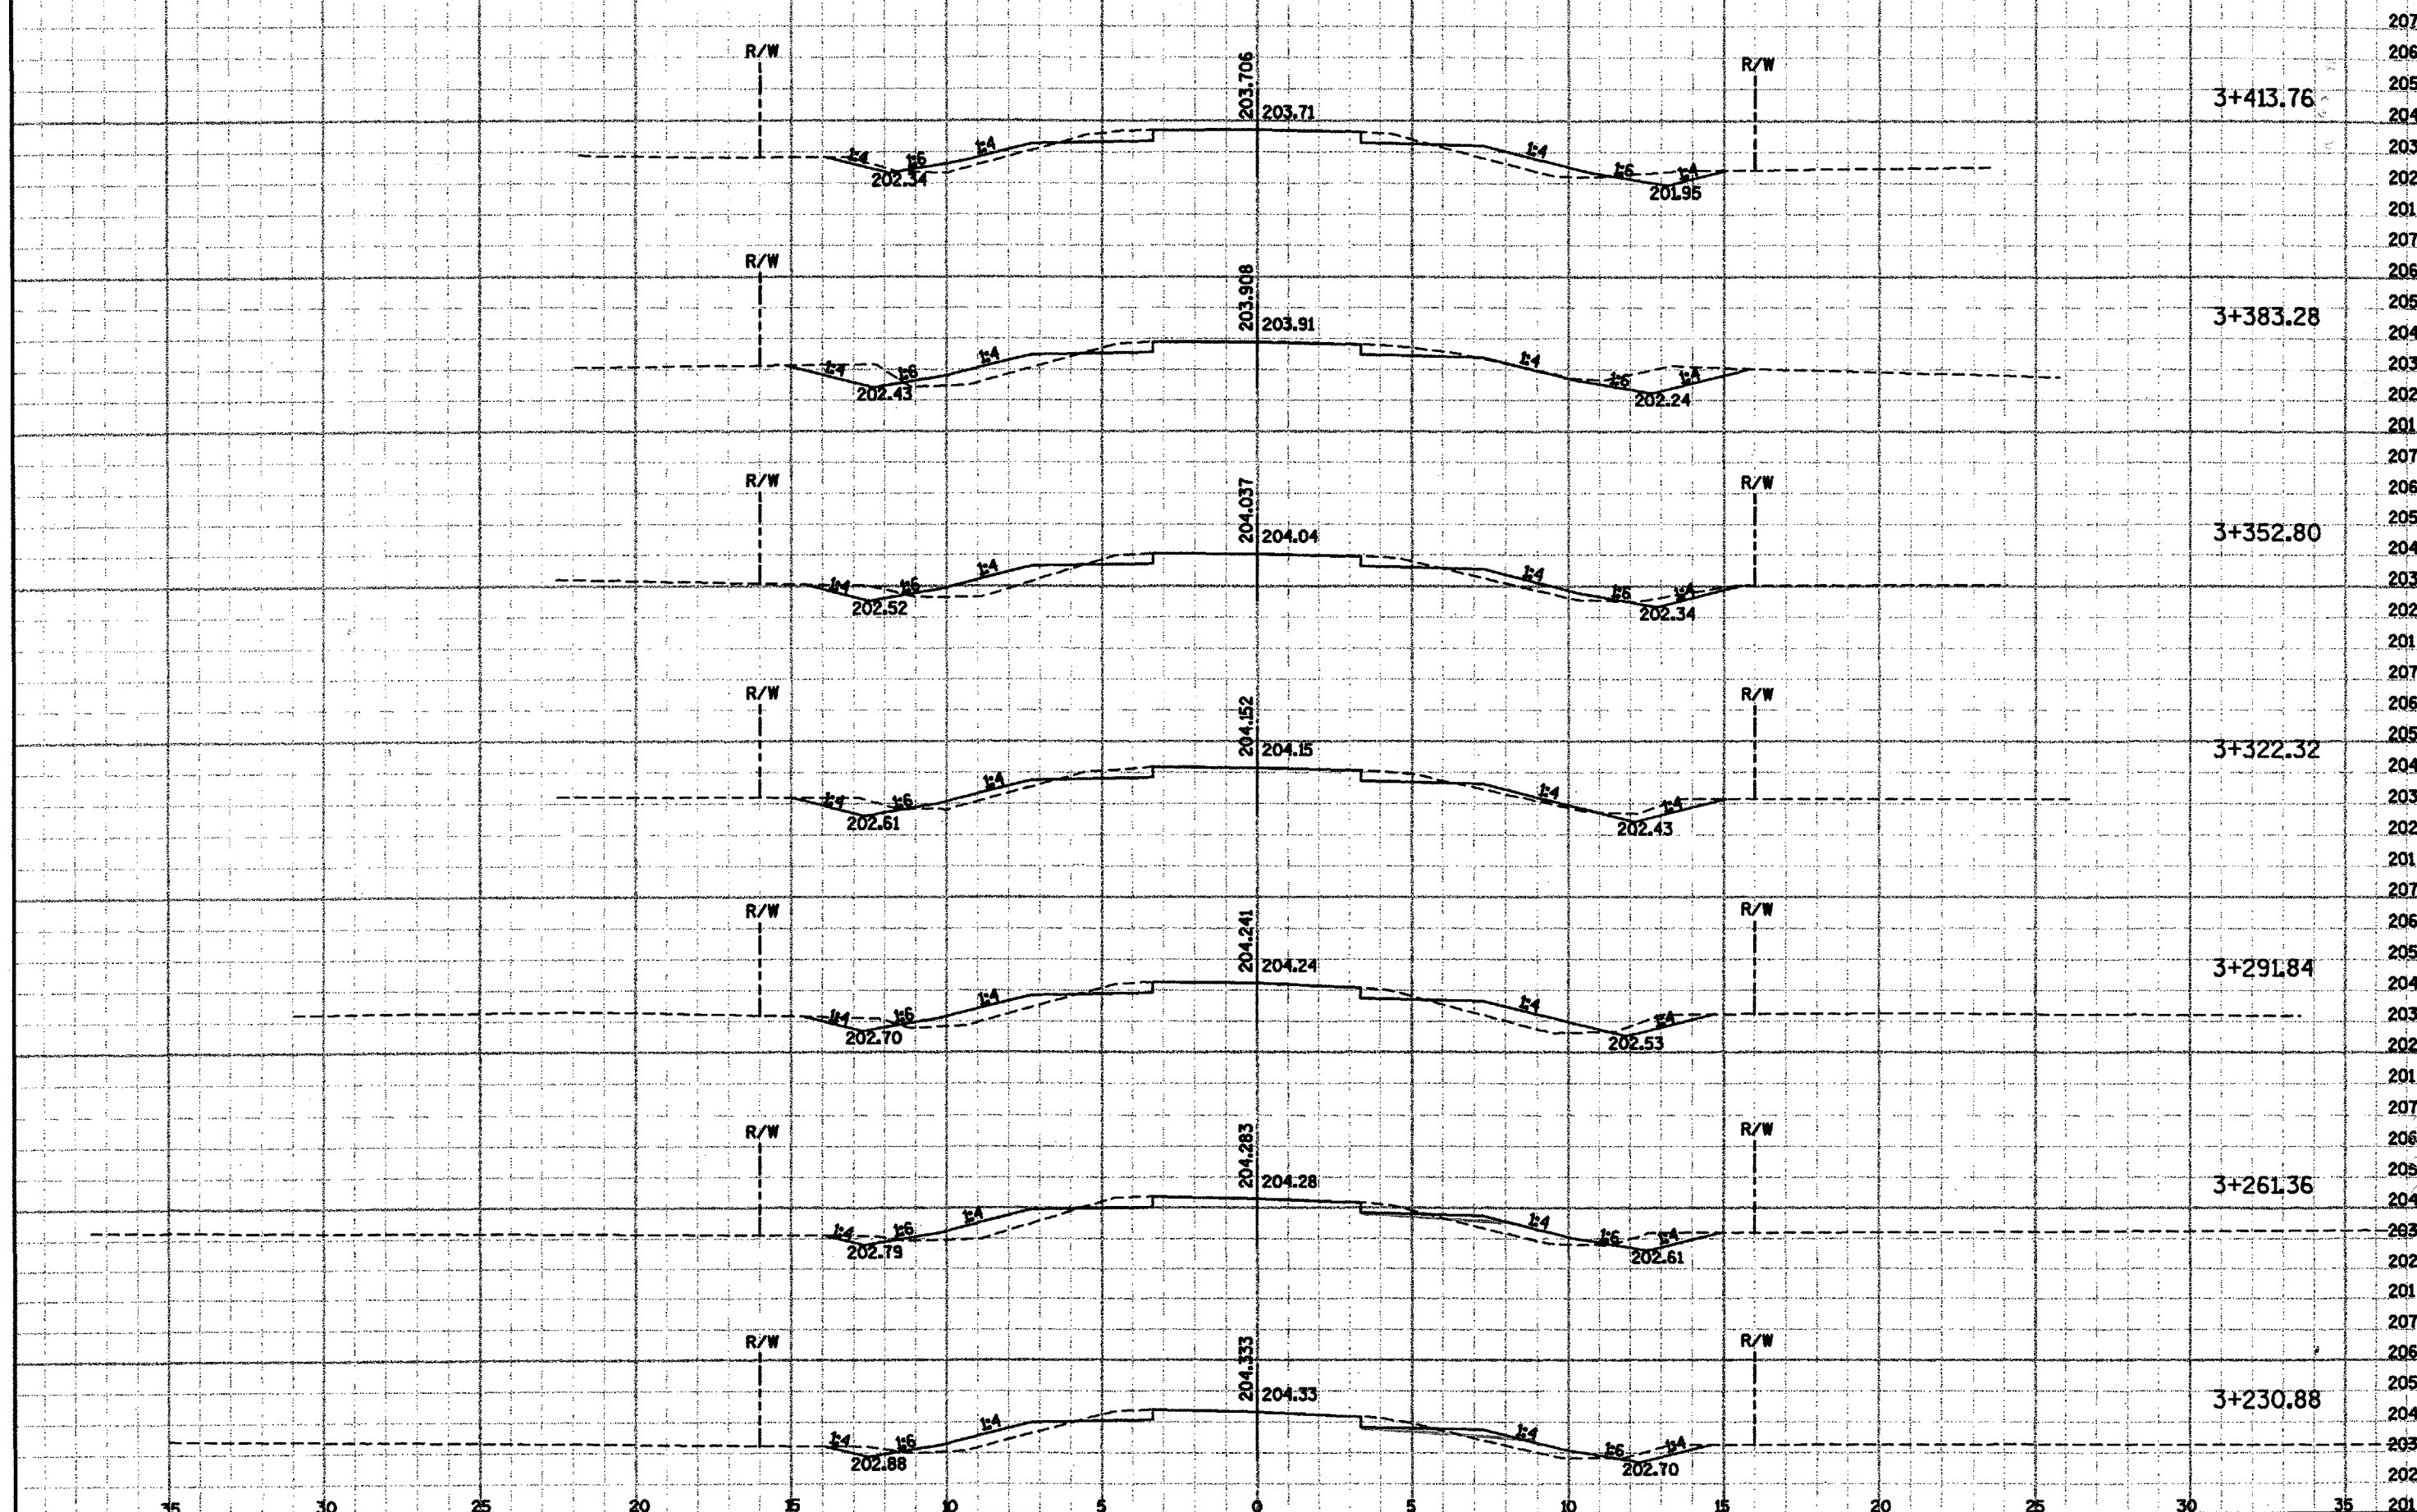


CROSS SECTIONS	HWY: STH 96	COUNTY: OUTAGAMIE	STATE PROJECT NO: 4095-05-71	SHEET NO: 9.14	M
----------------	-------------	-------------------	------------------------------	----------------	---

ORIGINATOR:



ORIGINATOR:

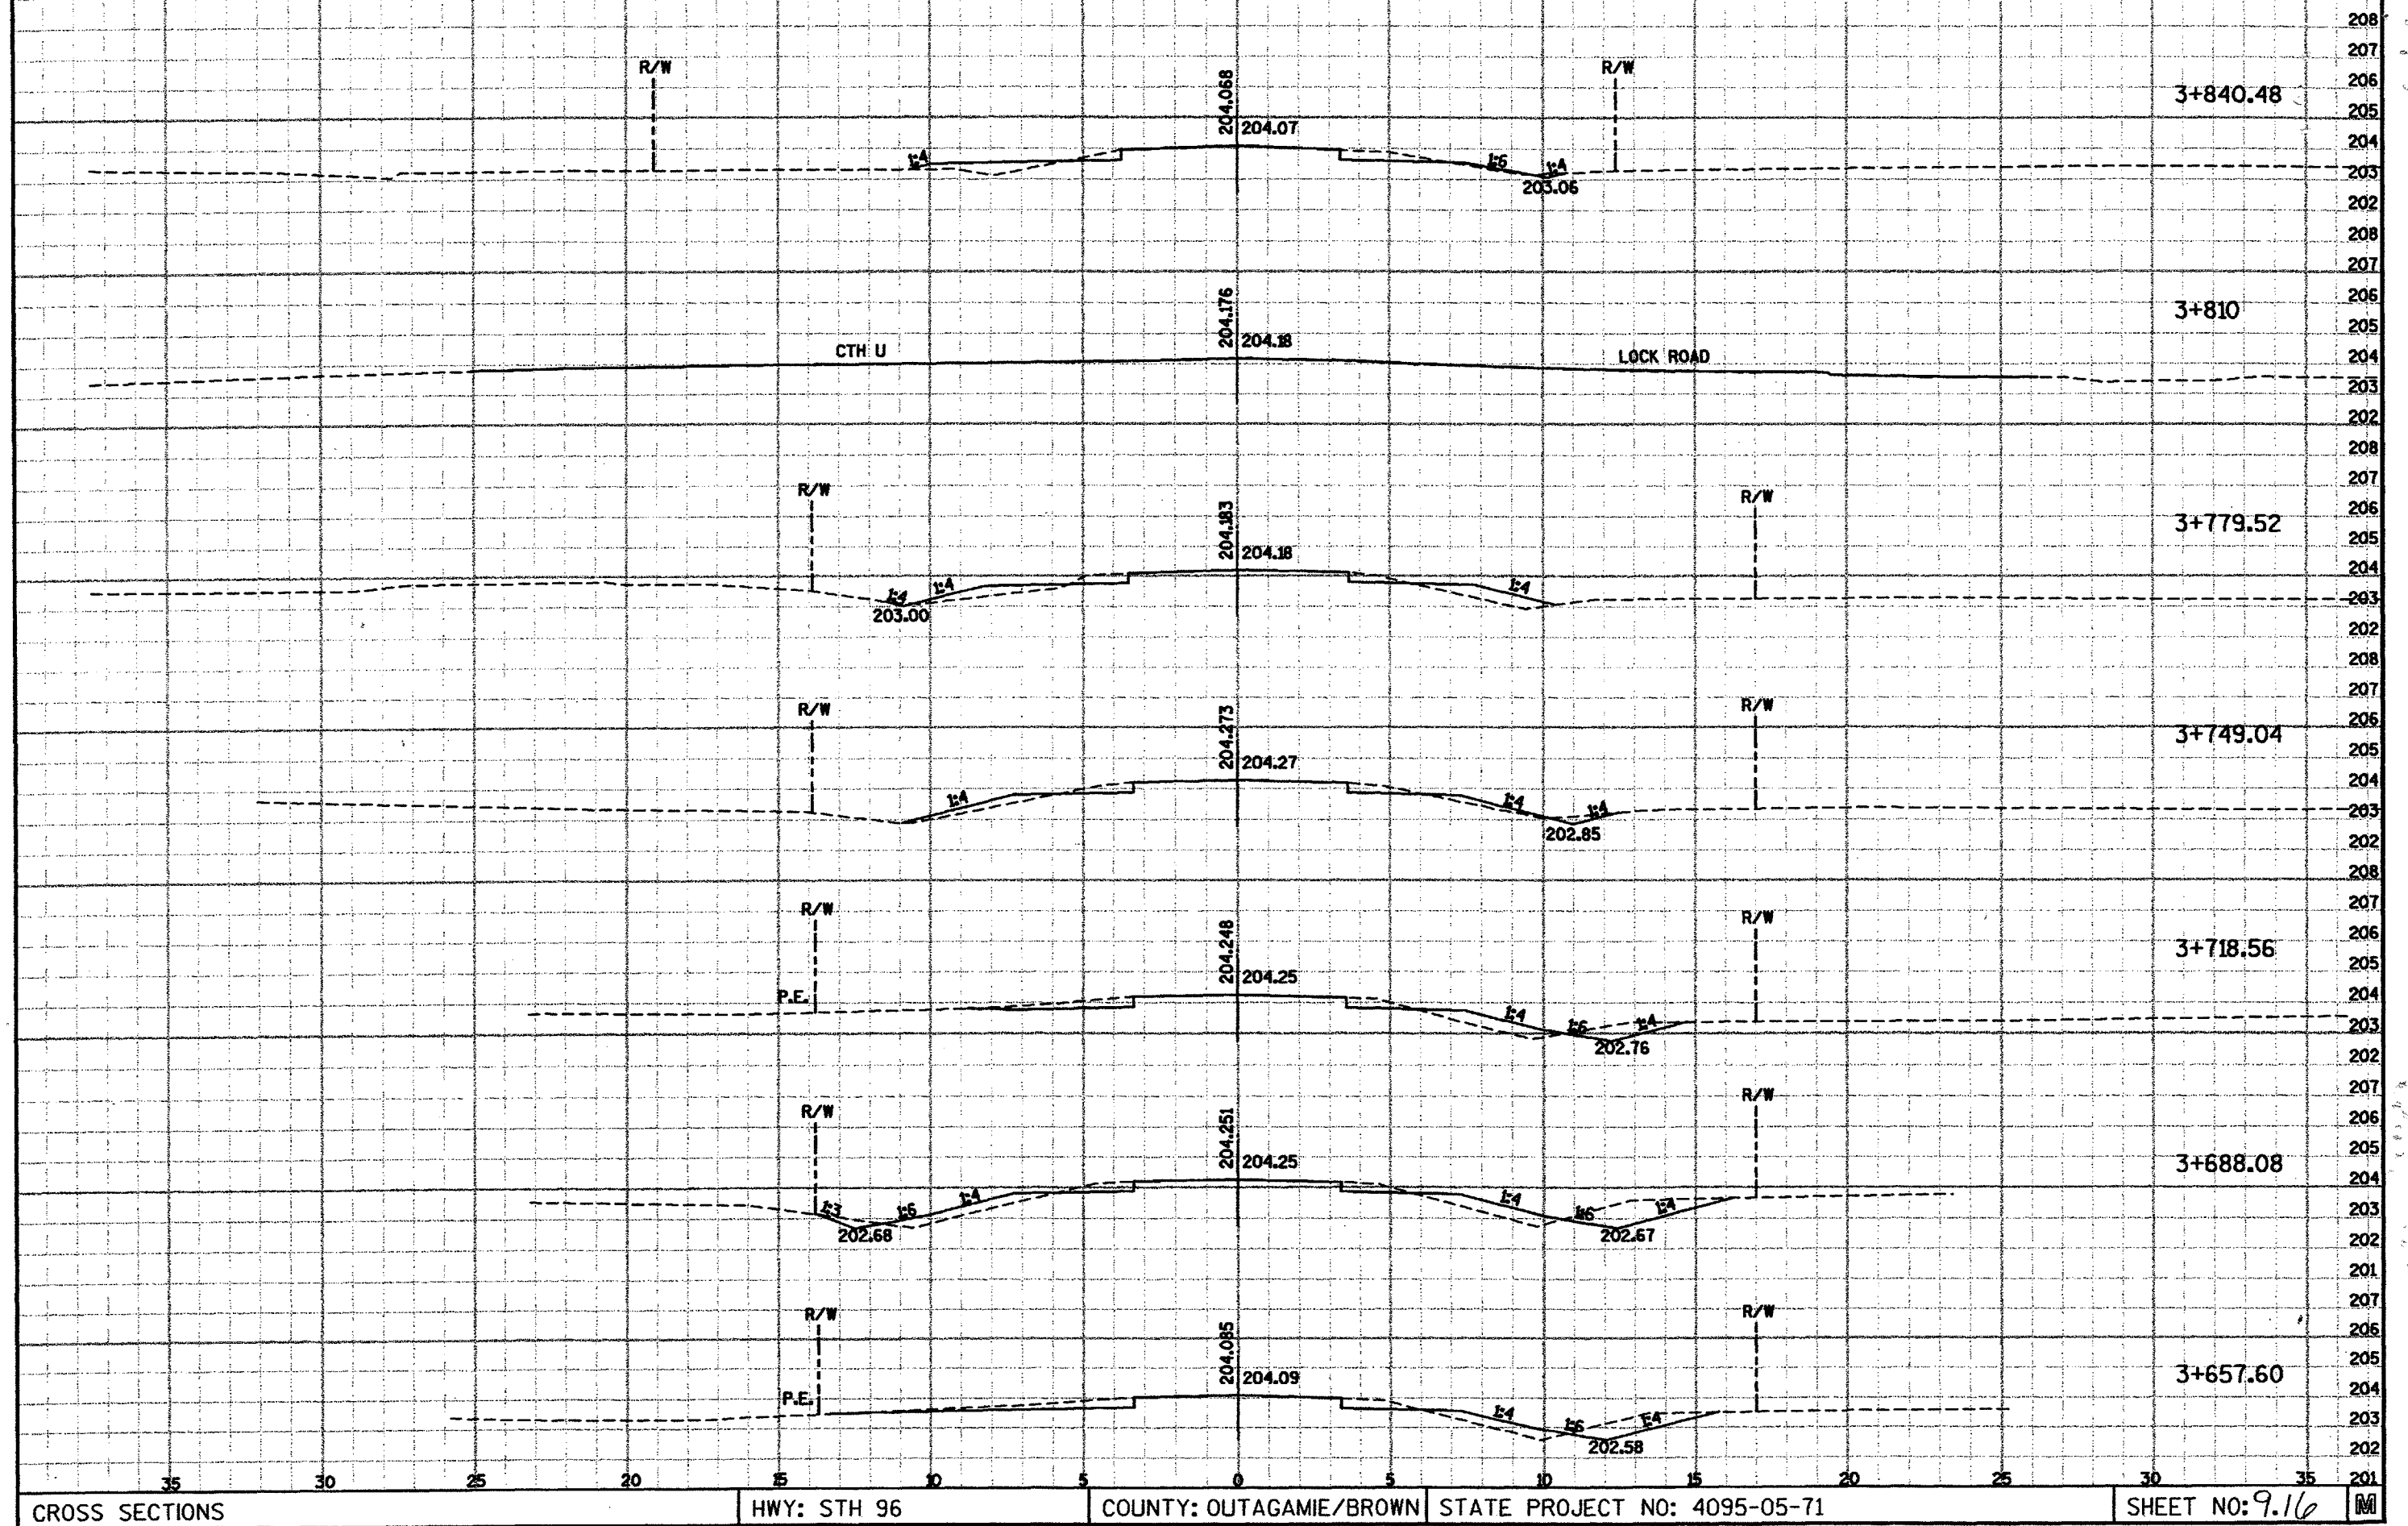


PLOT SCALE:

PLOT NAME:

REV. DATE:

ORIGINATOR:

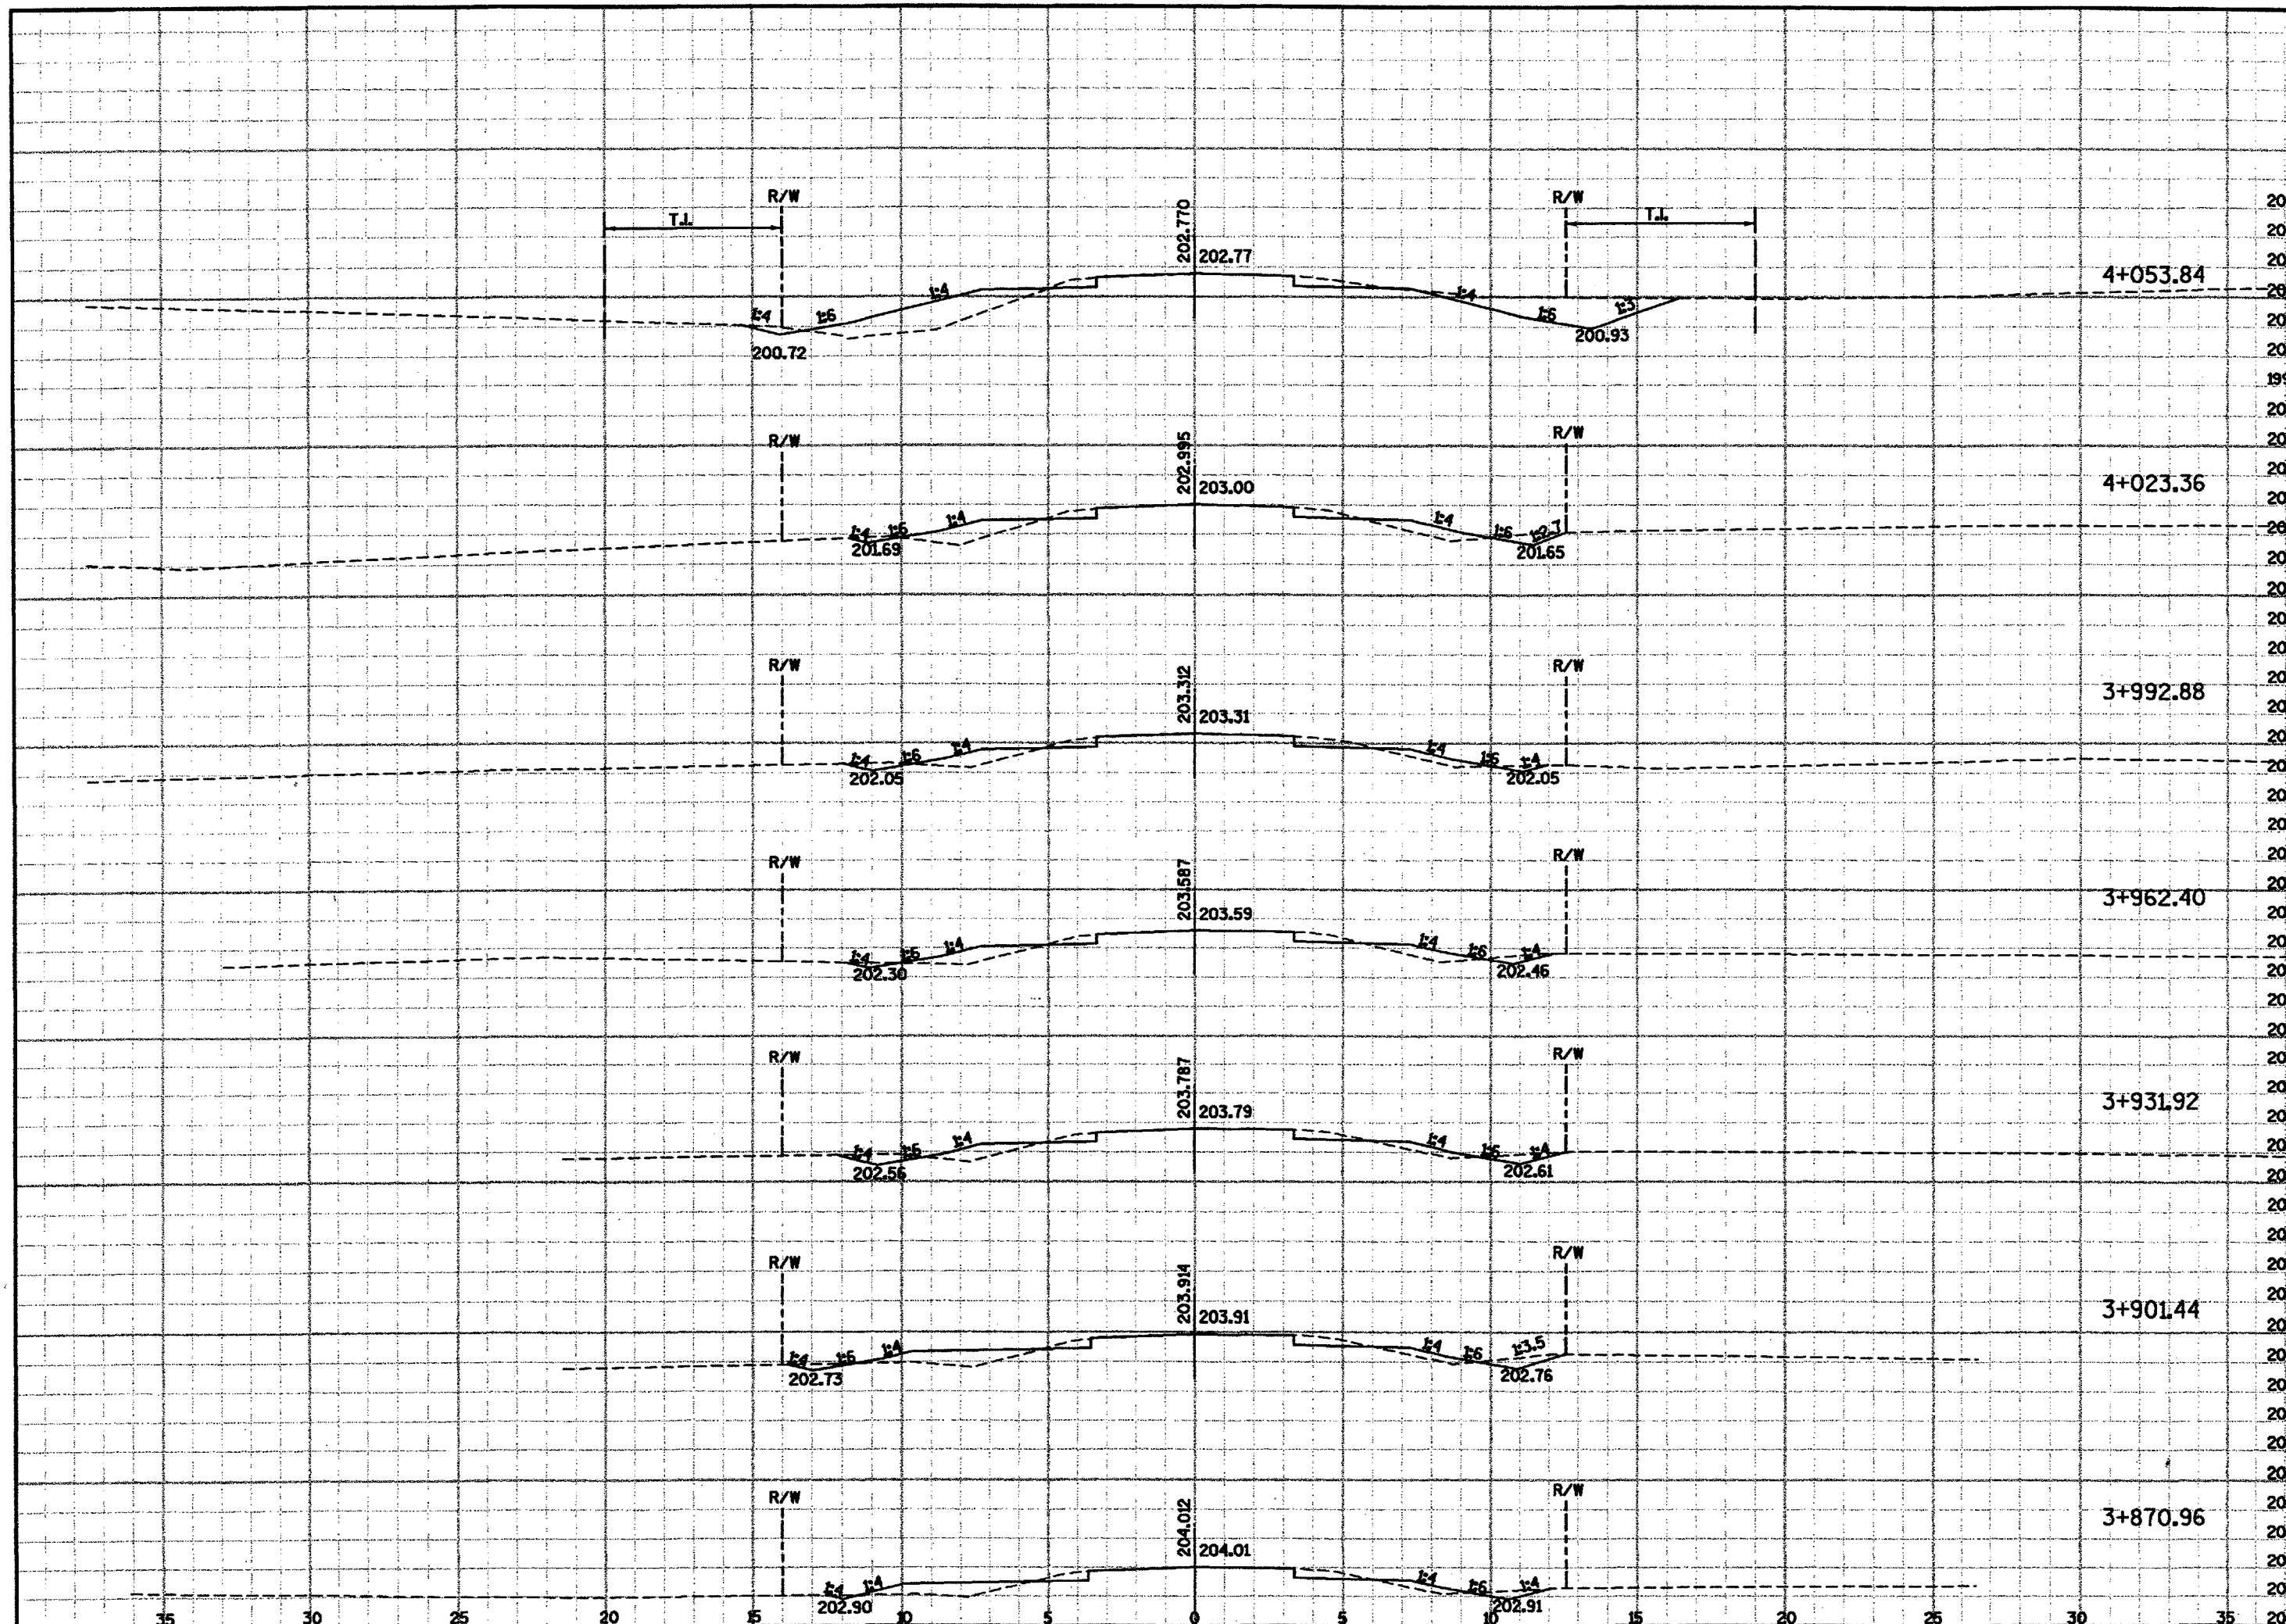

CROSS SECTIONS

HWY: STH 96

COUNTY: BROWN

STATE PROJECT NO: 4095-05-71

SHEET NO: 9.17


M

PLOT SCALE:

PLOT NAME:

REV. DATE:

ORIGINATOR:

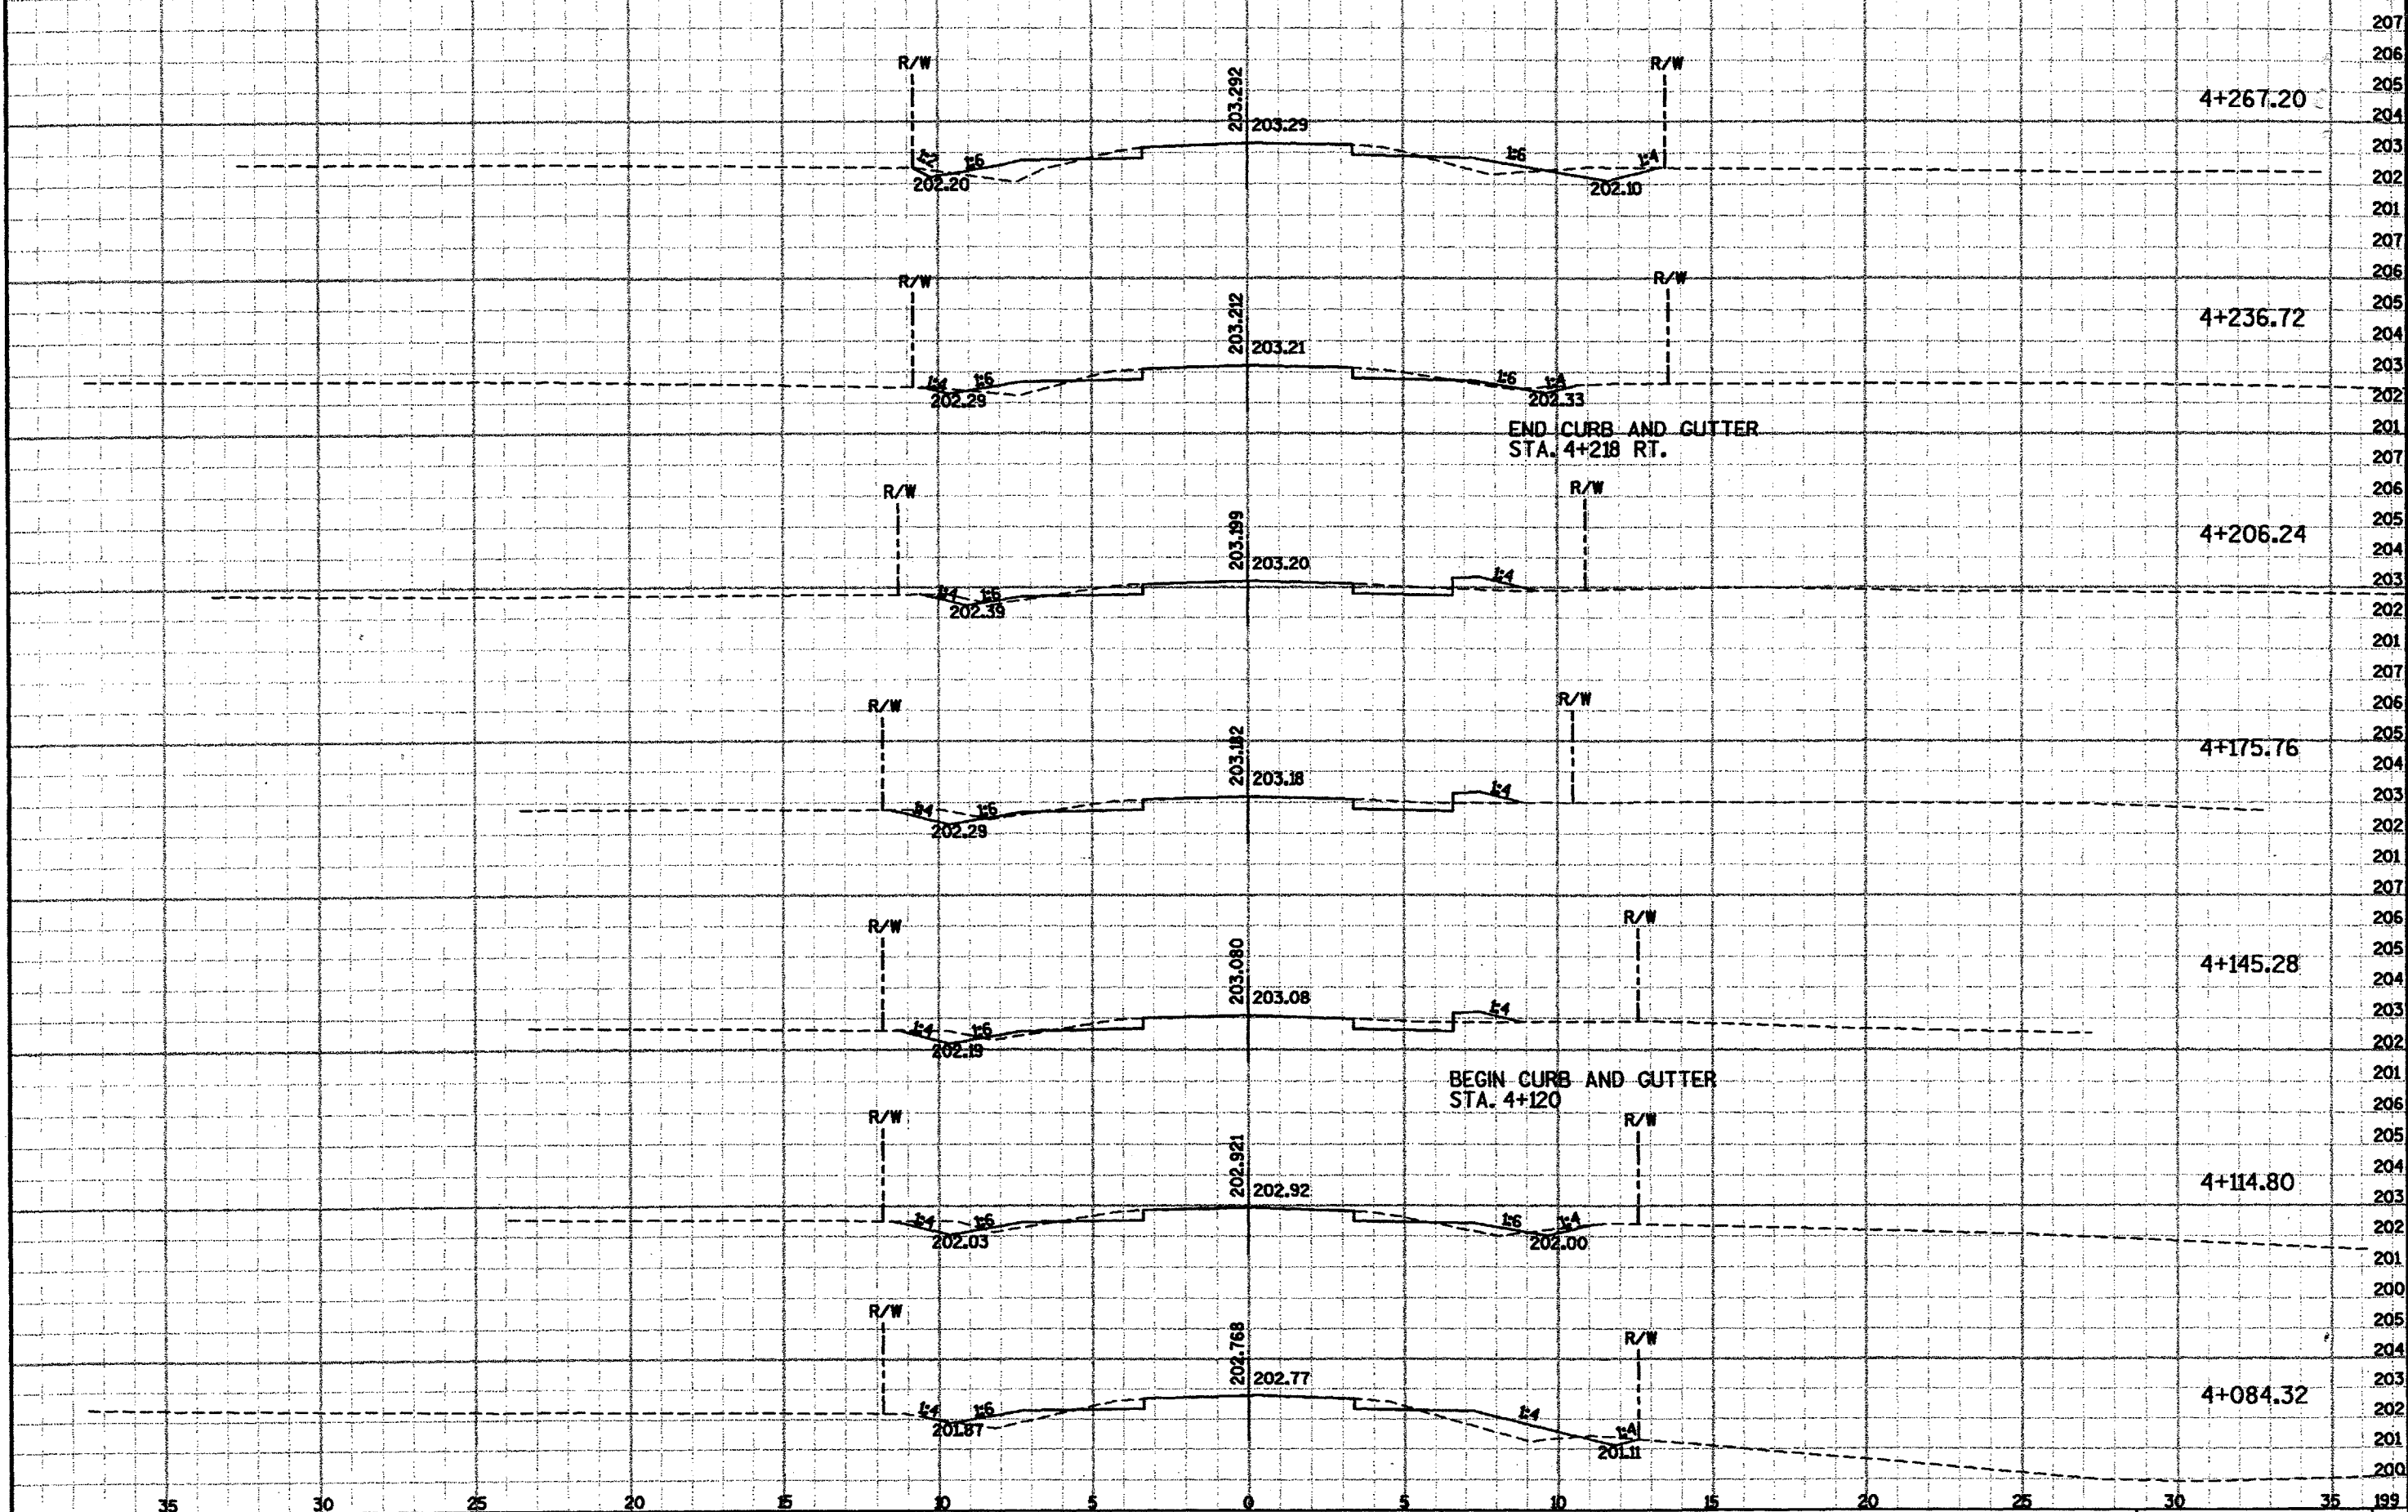

CROSS SECTIONS

HWY: STH 96

COUNTY: BROWN

STATE PROJECT NO: 4095-05-71

SHEET NO: 9.18


M

PLOT SCALE:

PLOT NAME:

REV. DATE:

ORIGINATOR:

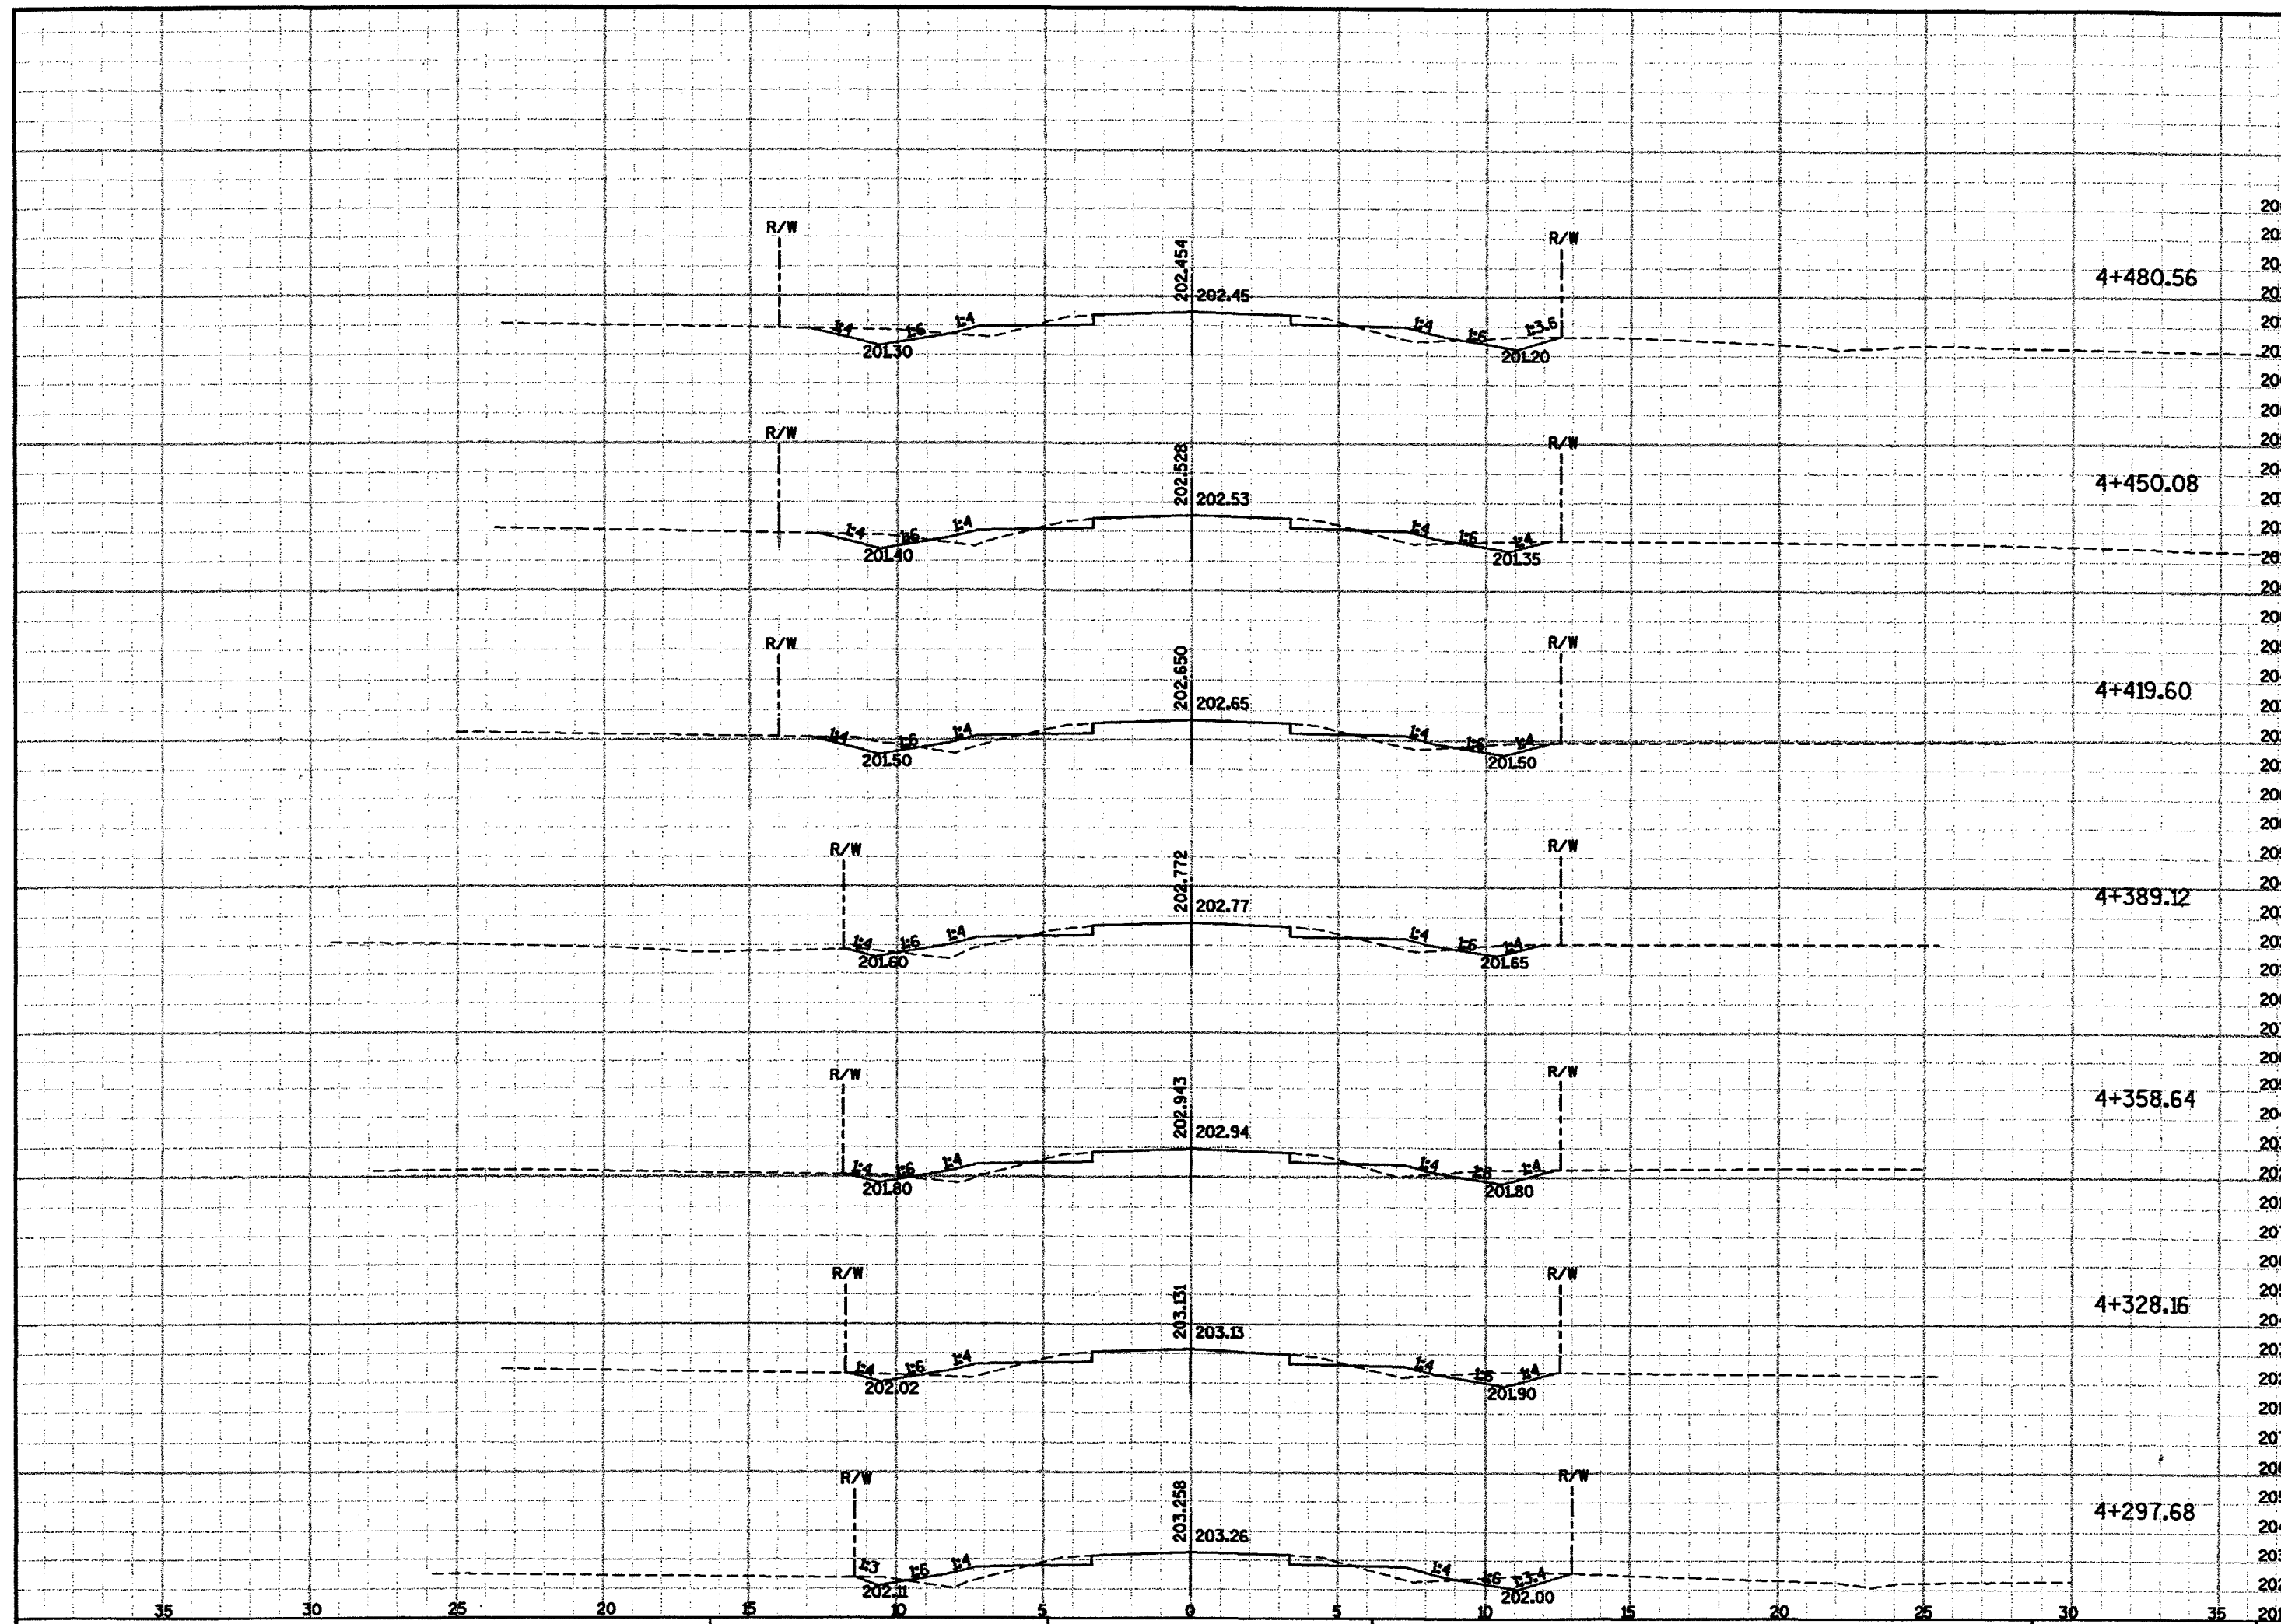


CROSS SECTIONS	HWY: STH 96	COUNTY: BROWN	STATE PROJECT NO: 4095-05-71	SHEET NO: 9.19	M
----------------	-------------	---------------	------------------------------	----------------	---

PLOT SCALE:

PLOT NAME:

REV. DATE:

ORIGINATOR:

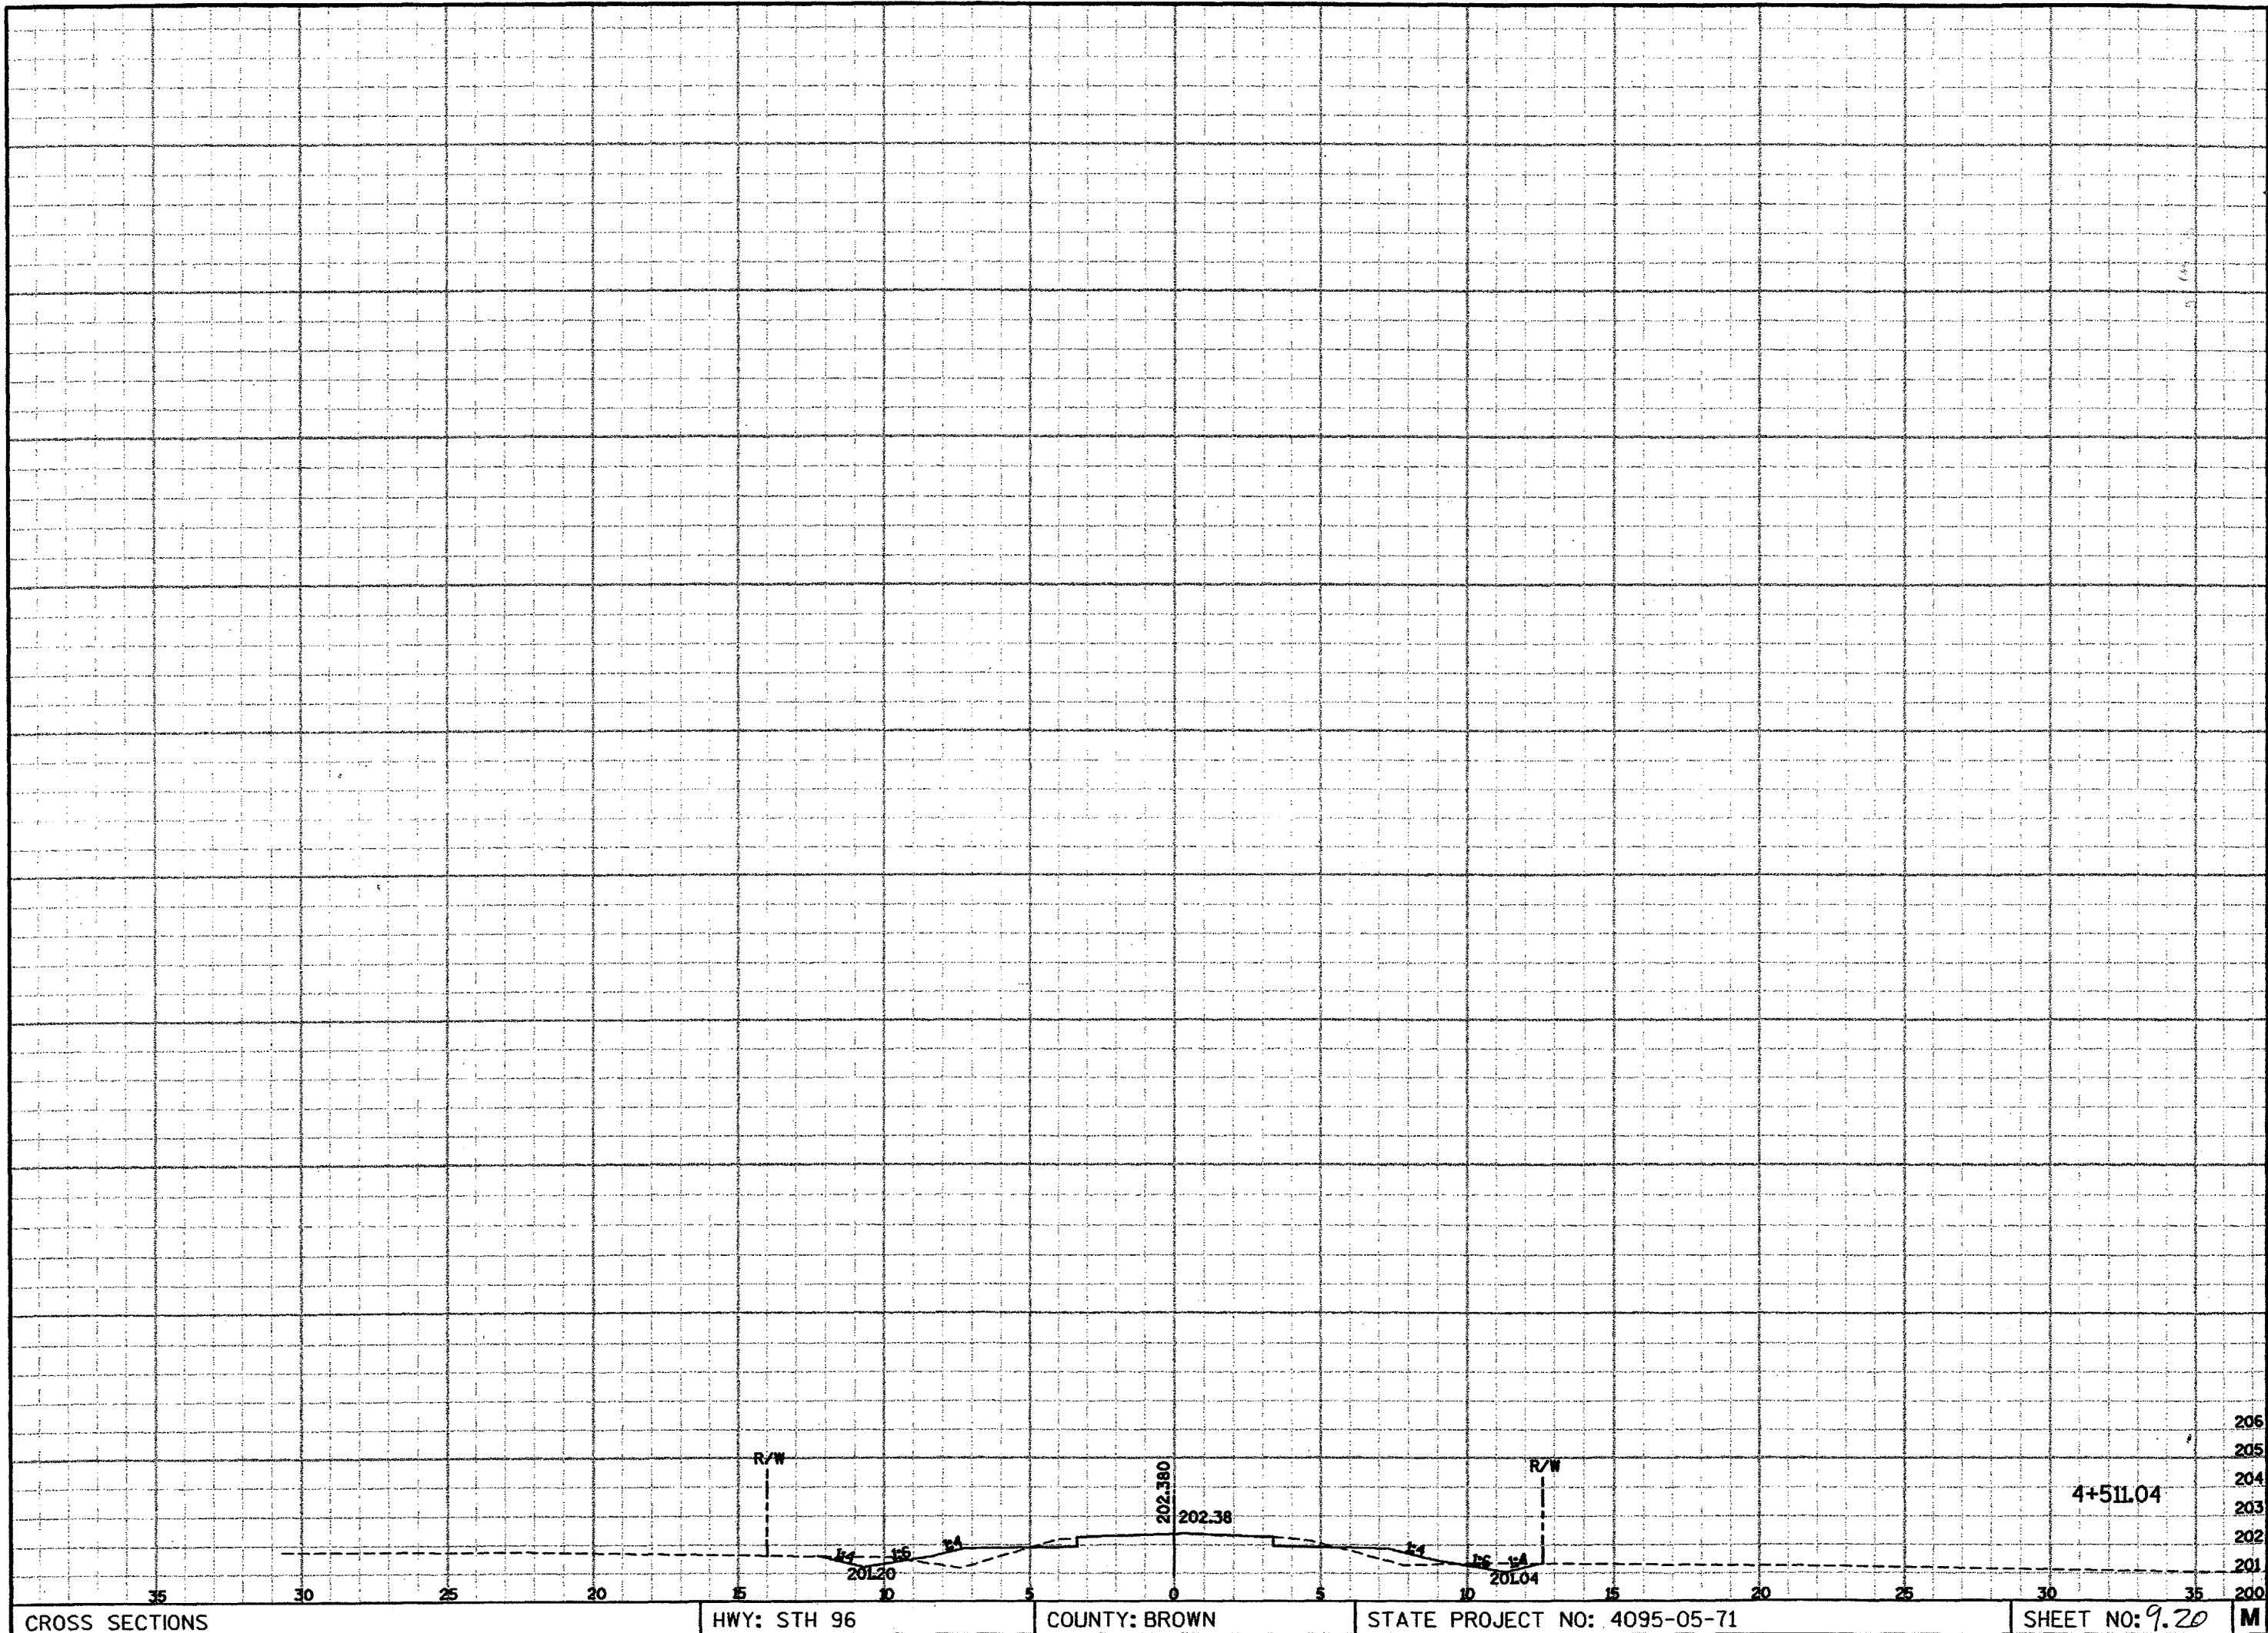


PLOT SCALE:

PLOT NAME:

REV. DATE:

ORIGINATOR:

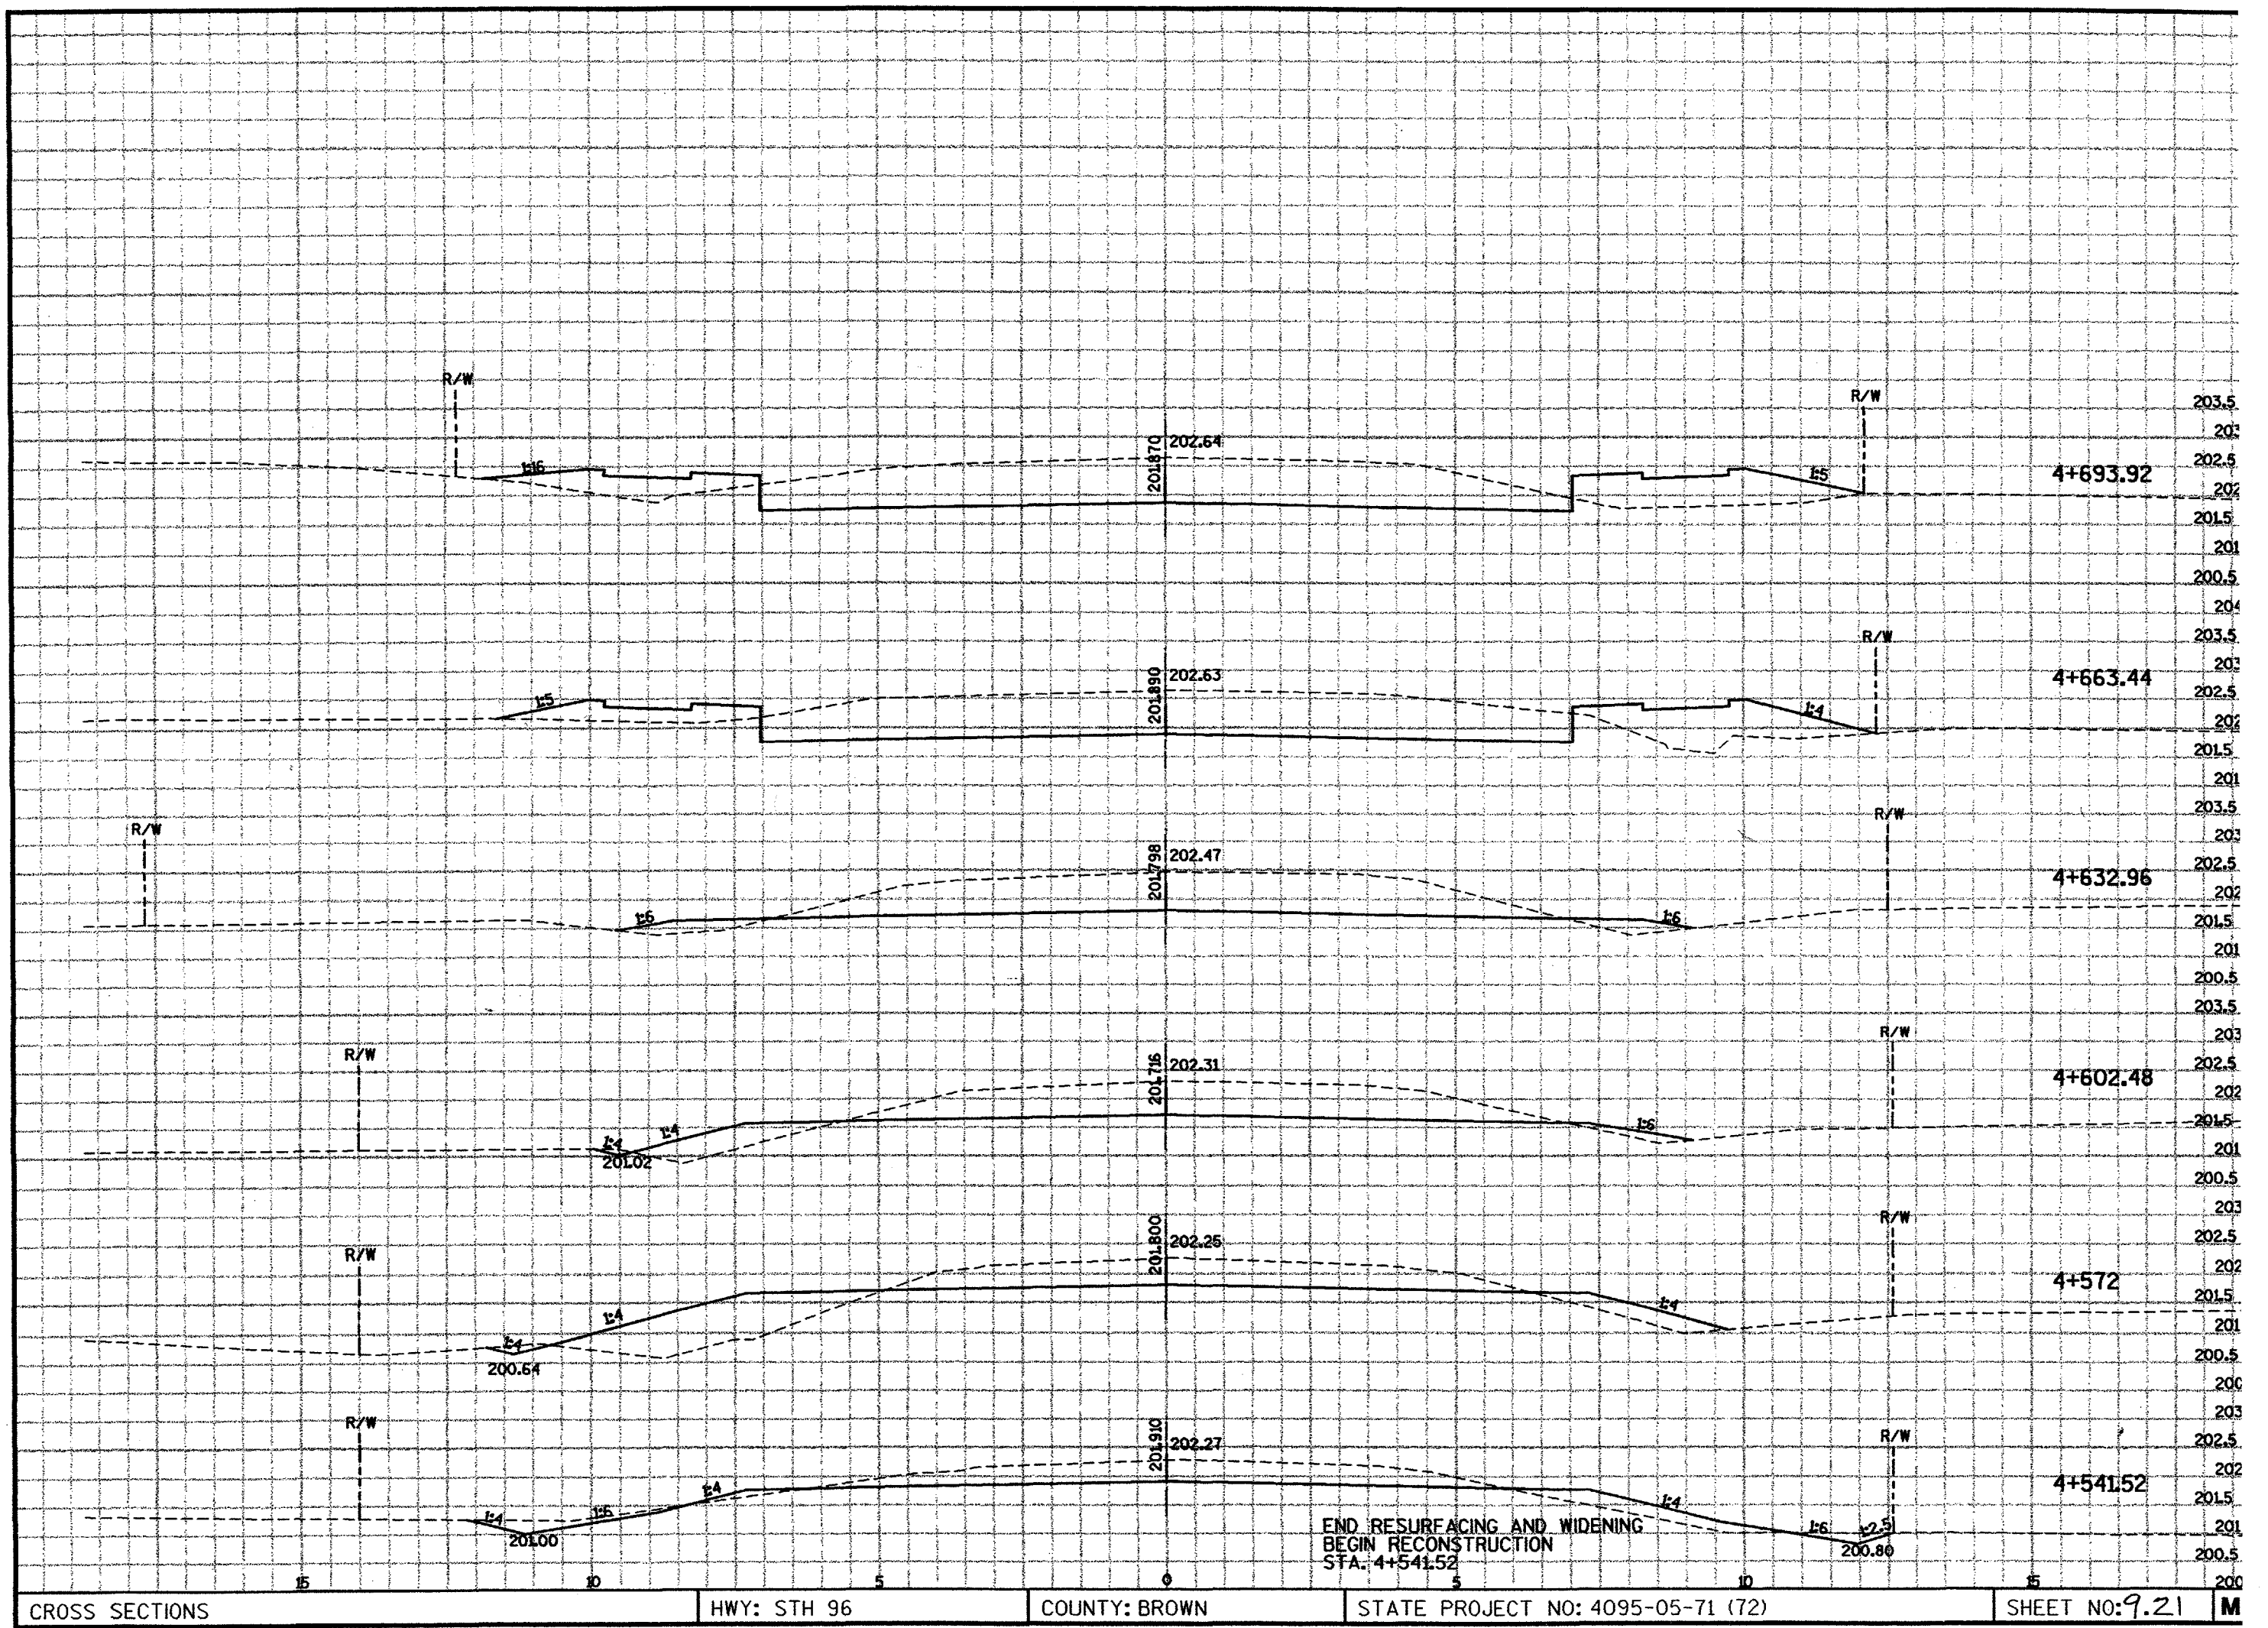


PLOT SCALE:

PLOT NAME:

REV. DATE:

ORIGINATOR:

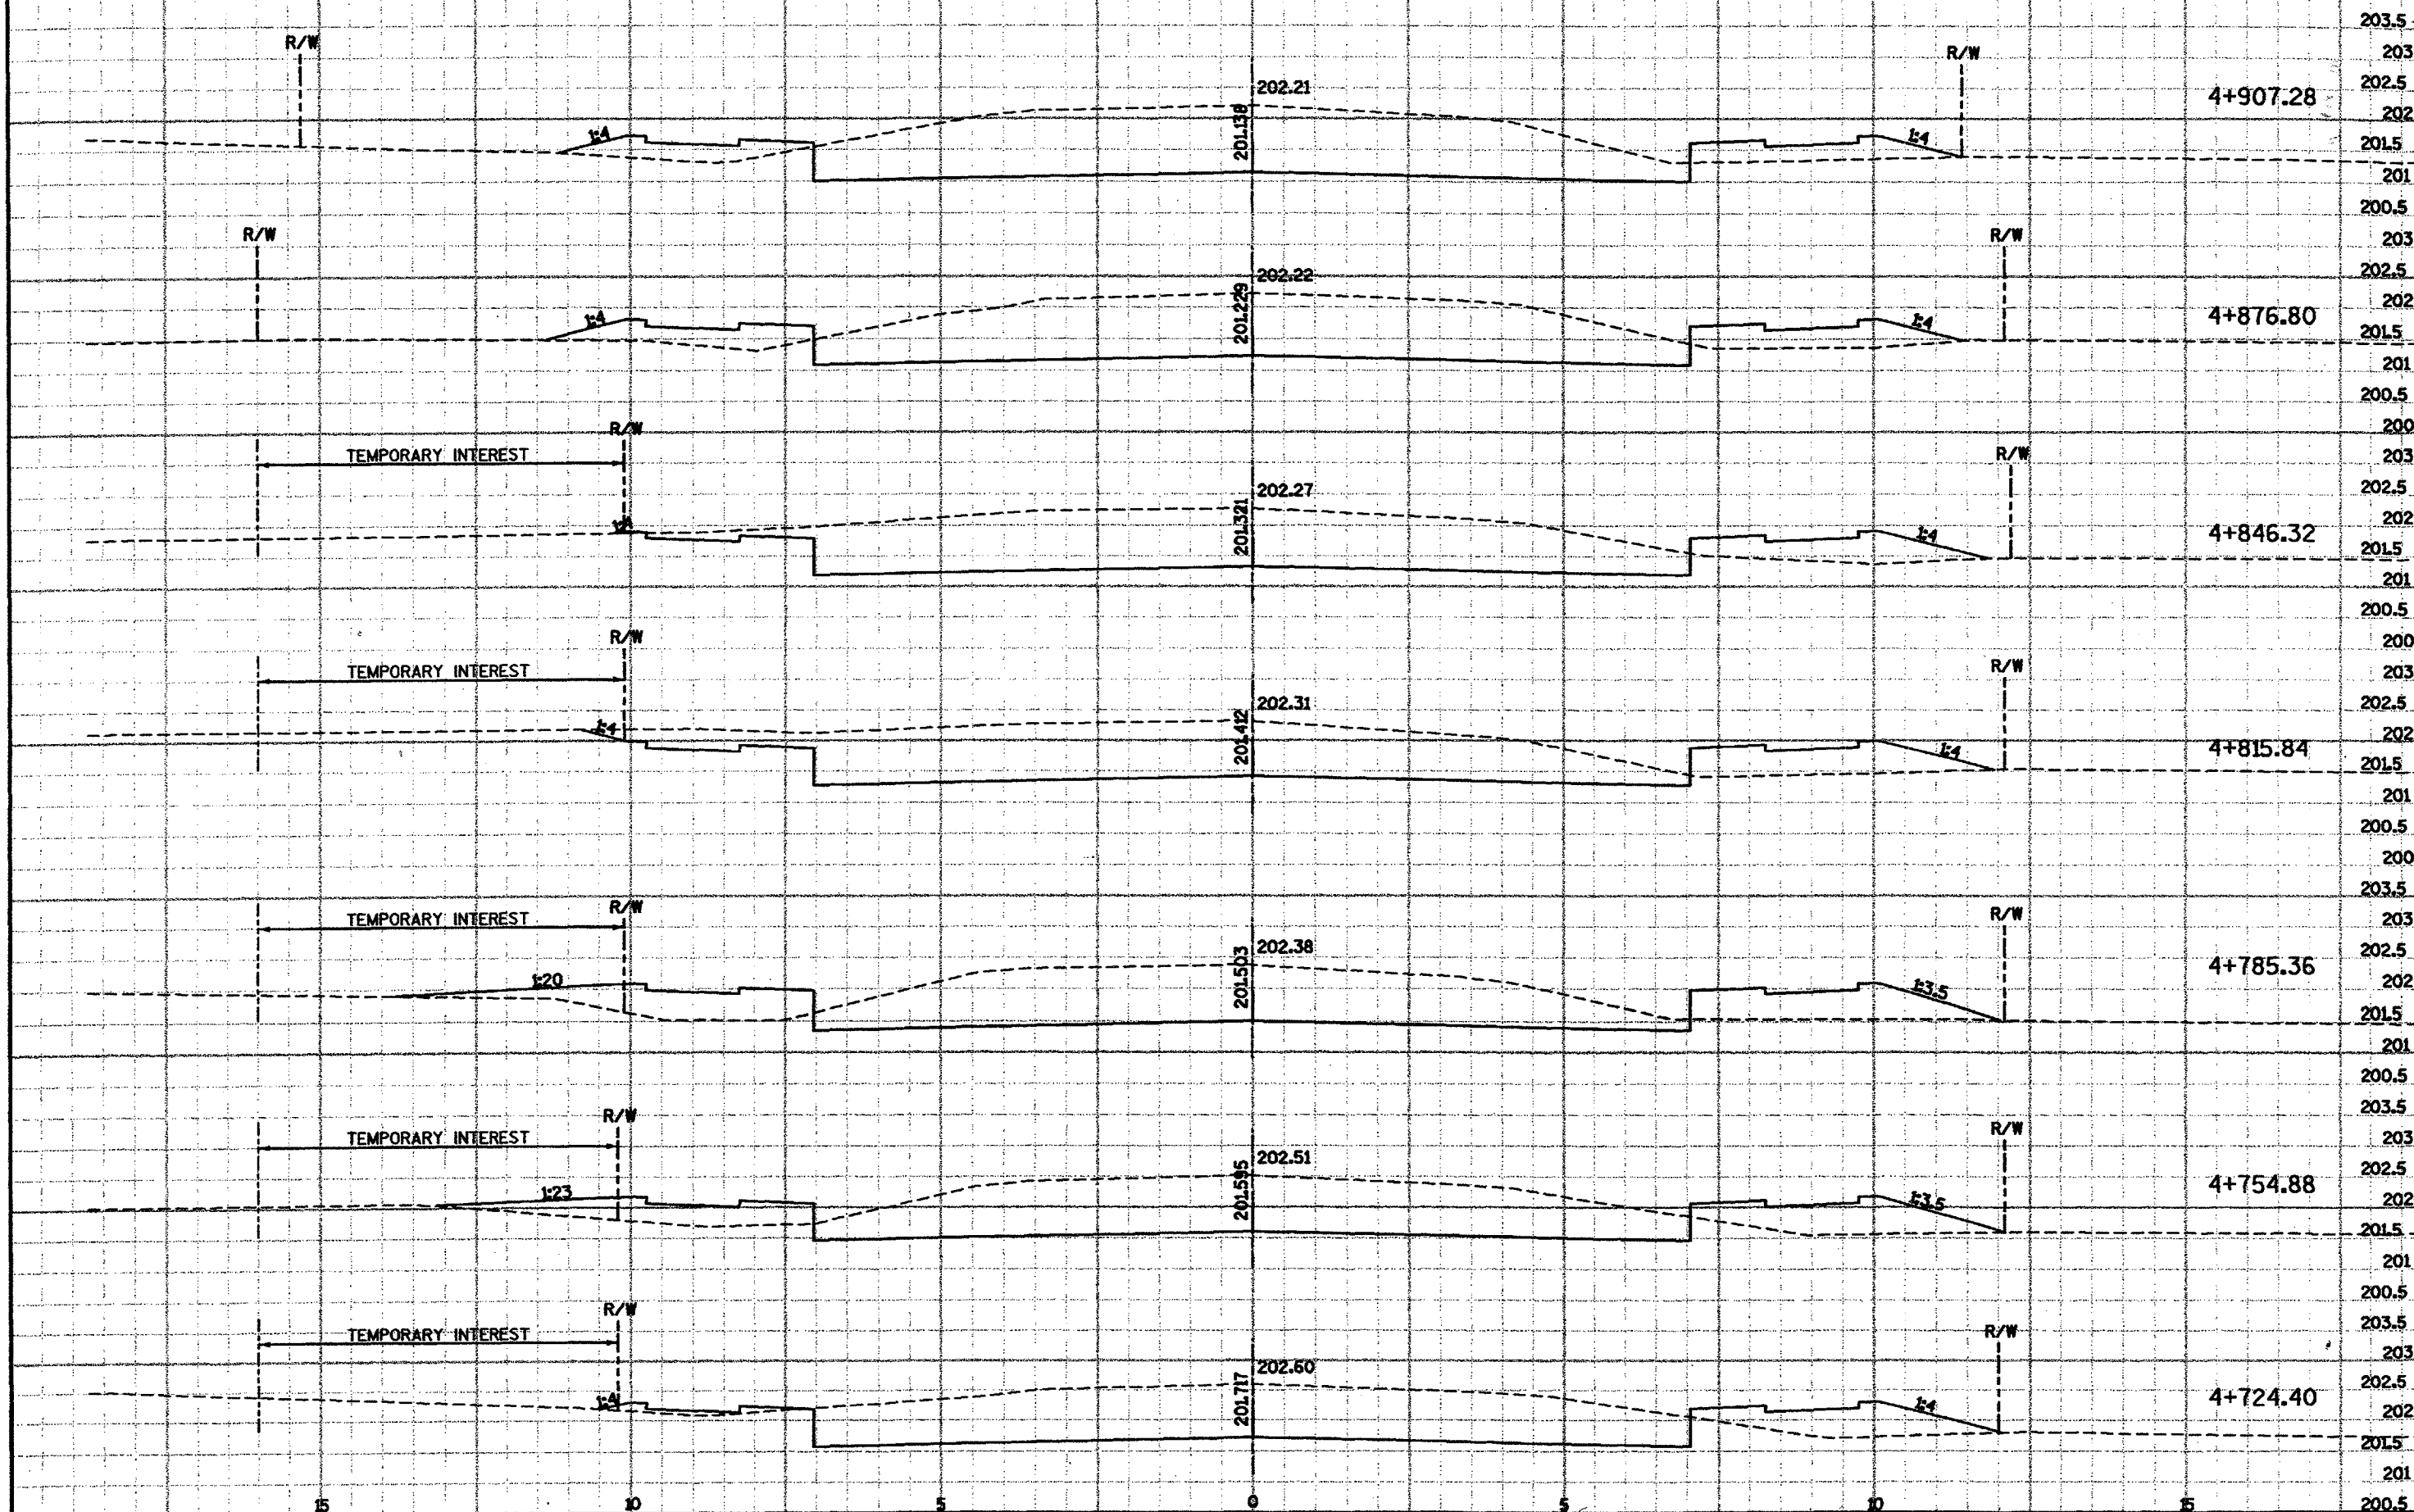

CROSS SECTIONS

HWY: STH 96

COUNTY: BROWN

STATE PROJECT NO: 4095-05-72

SHEET NO: 9.22


M

PLOT SCALE:

PLOT NAME:

REV. DATE:

ORIGINATOR:

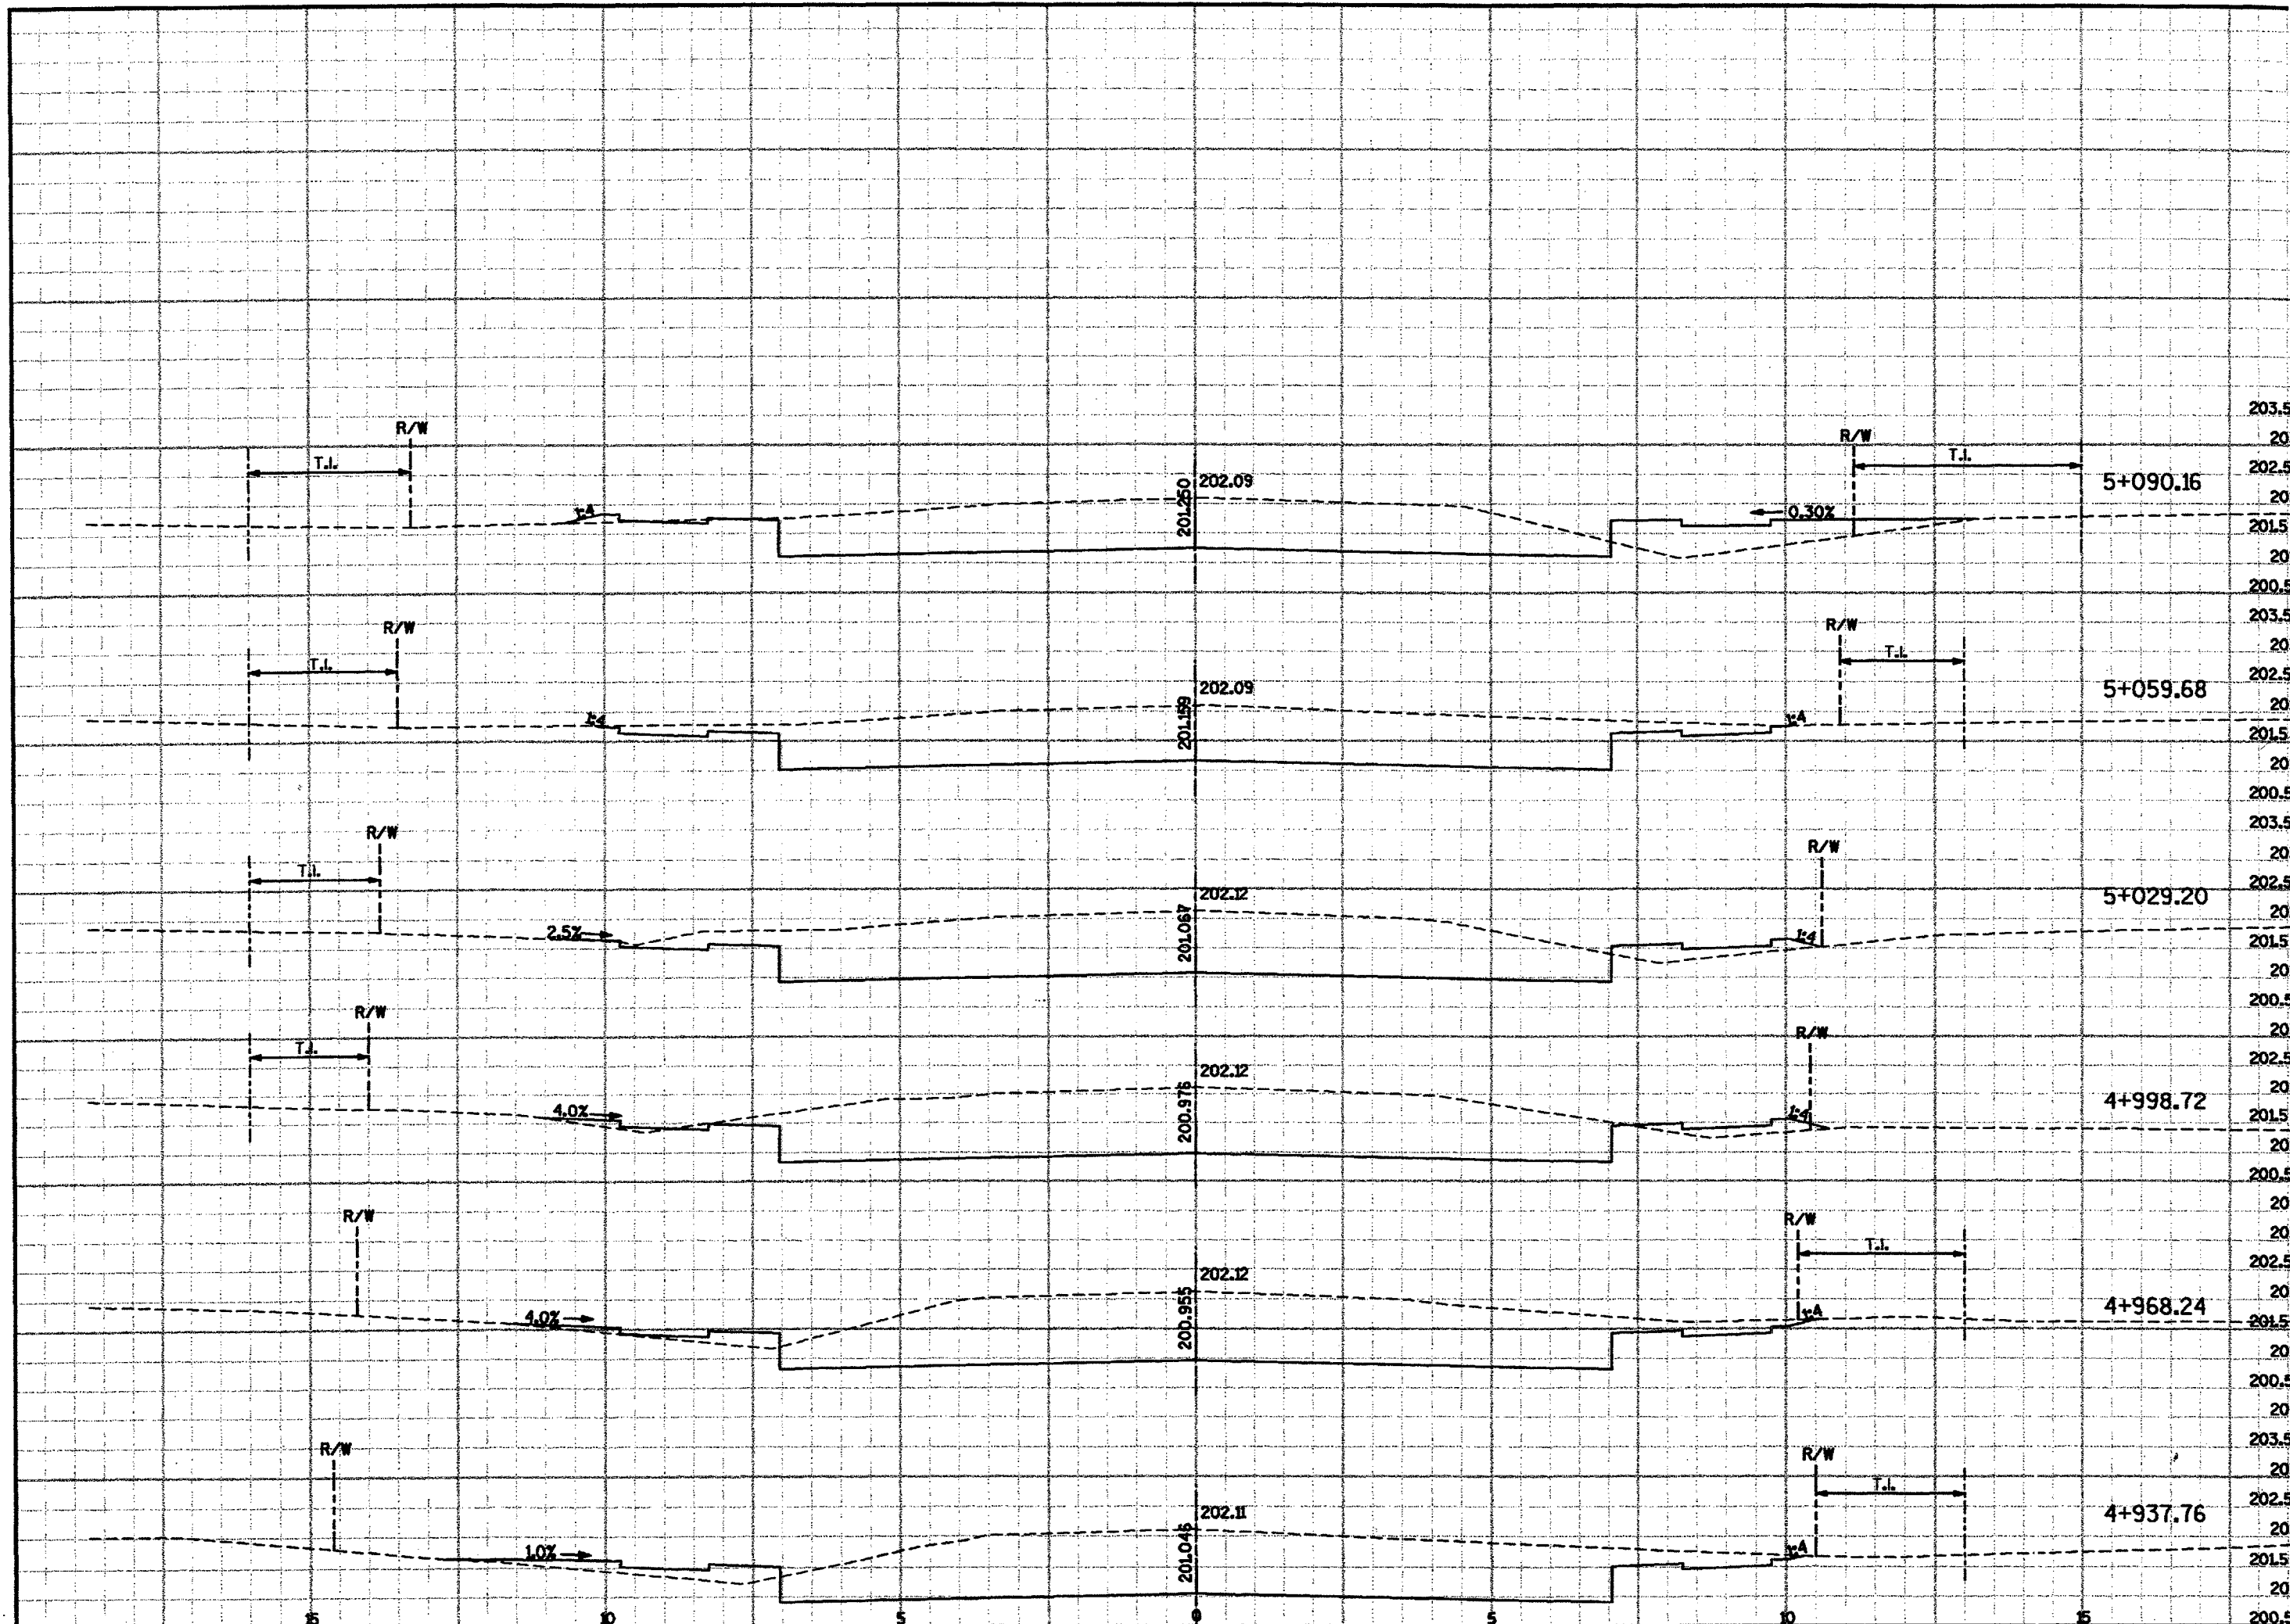

CROSS SECTIONS

HWY: STH 96

COUNTY: BROWN

STATE PROJECT NO: 4095-05-72

SHEET NO: 9.23


M

PLOT SCALE:

PLOT NAME:

REV. DATE:

ORIGINATOR:

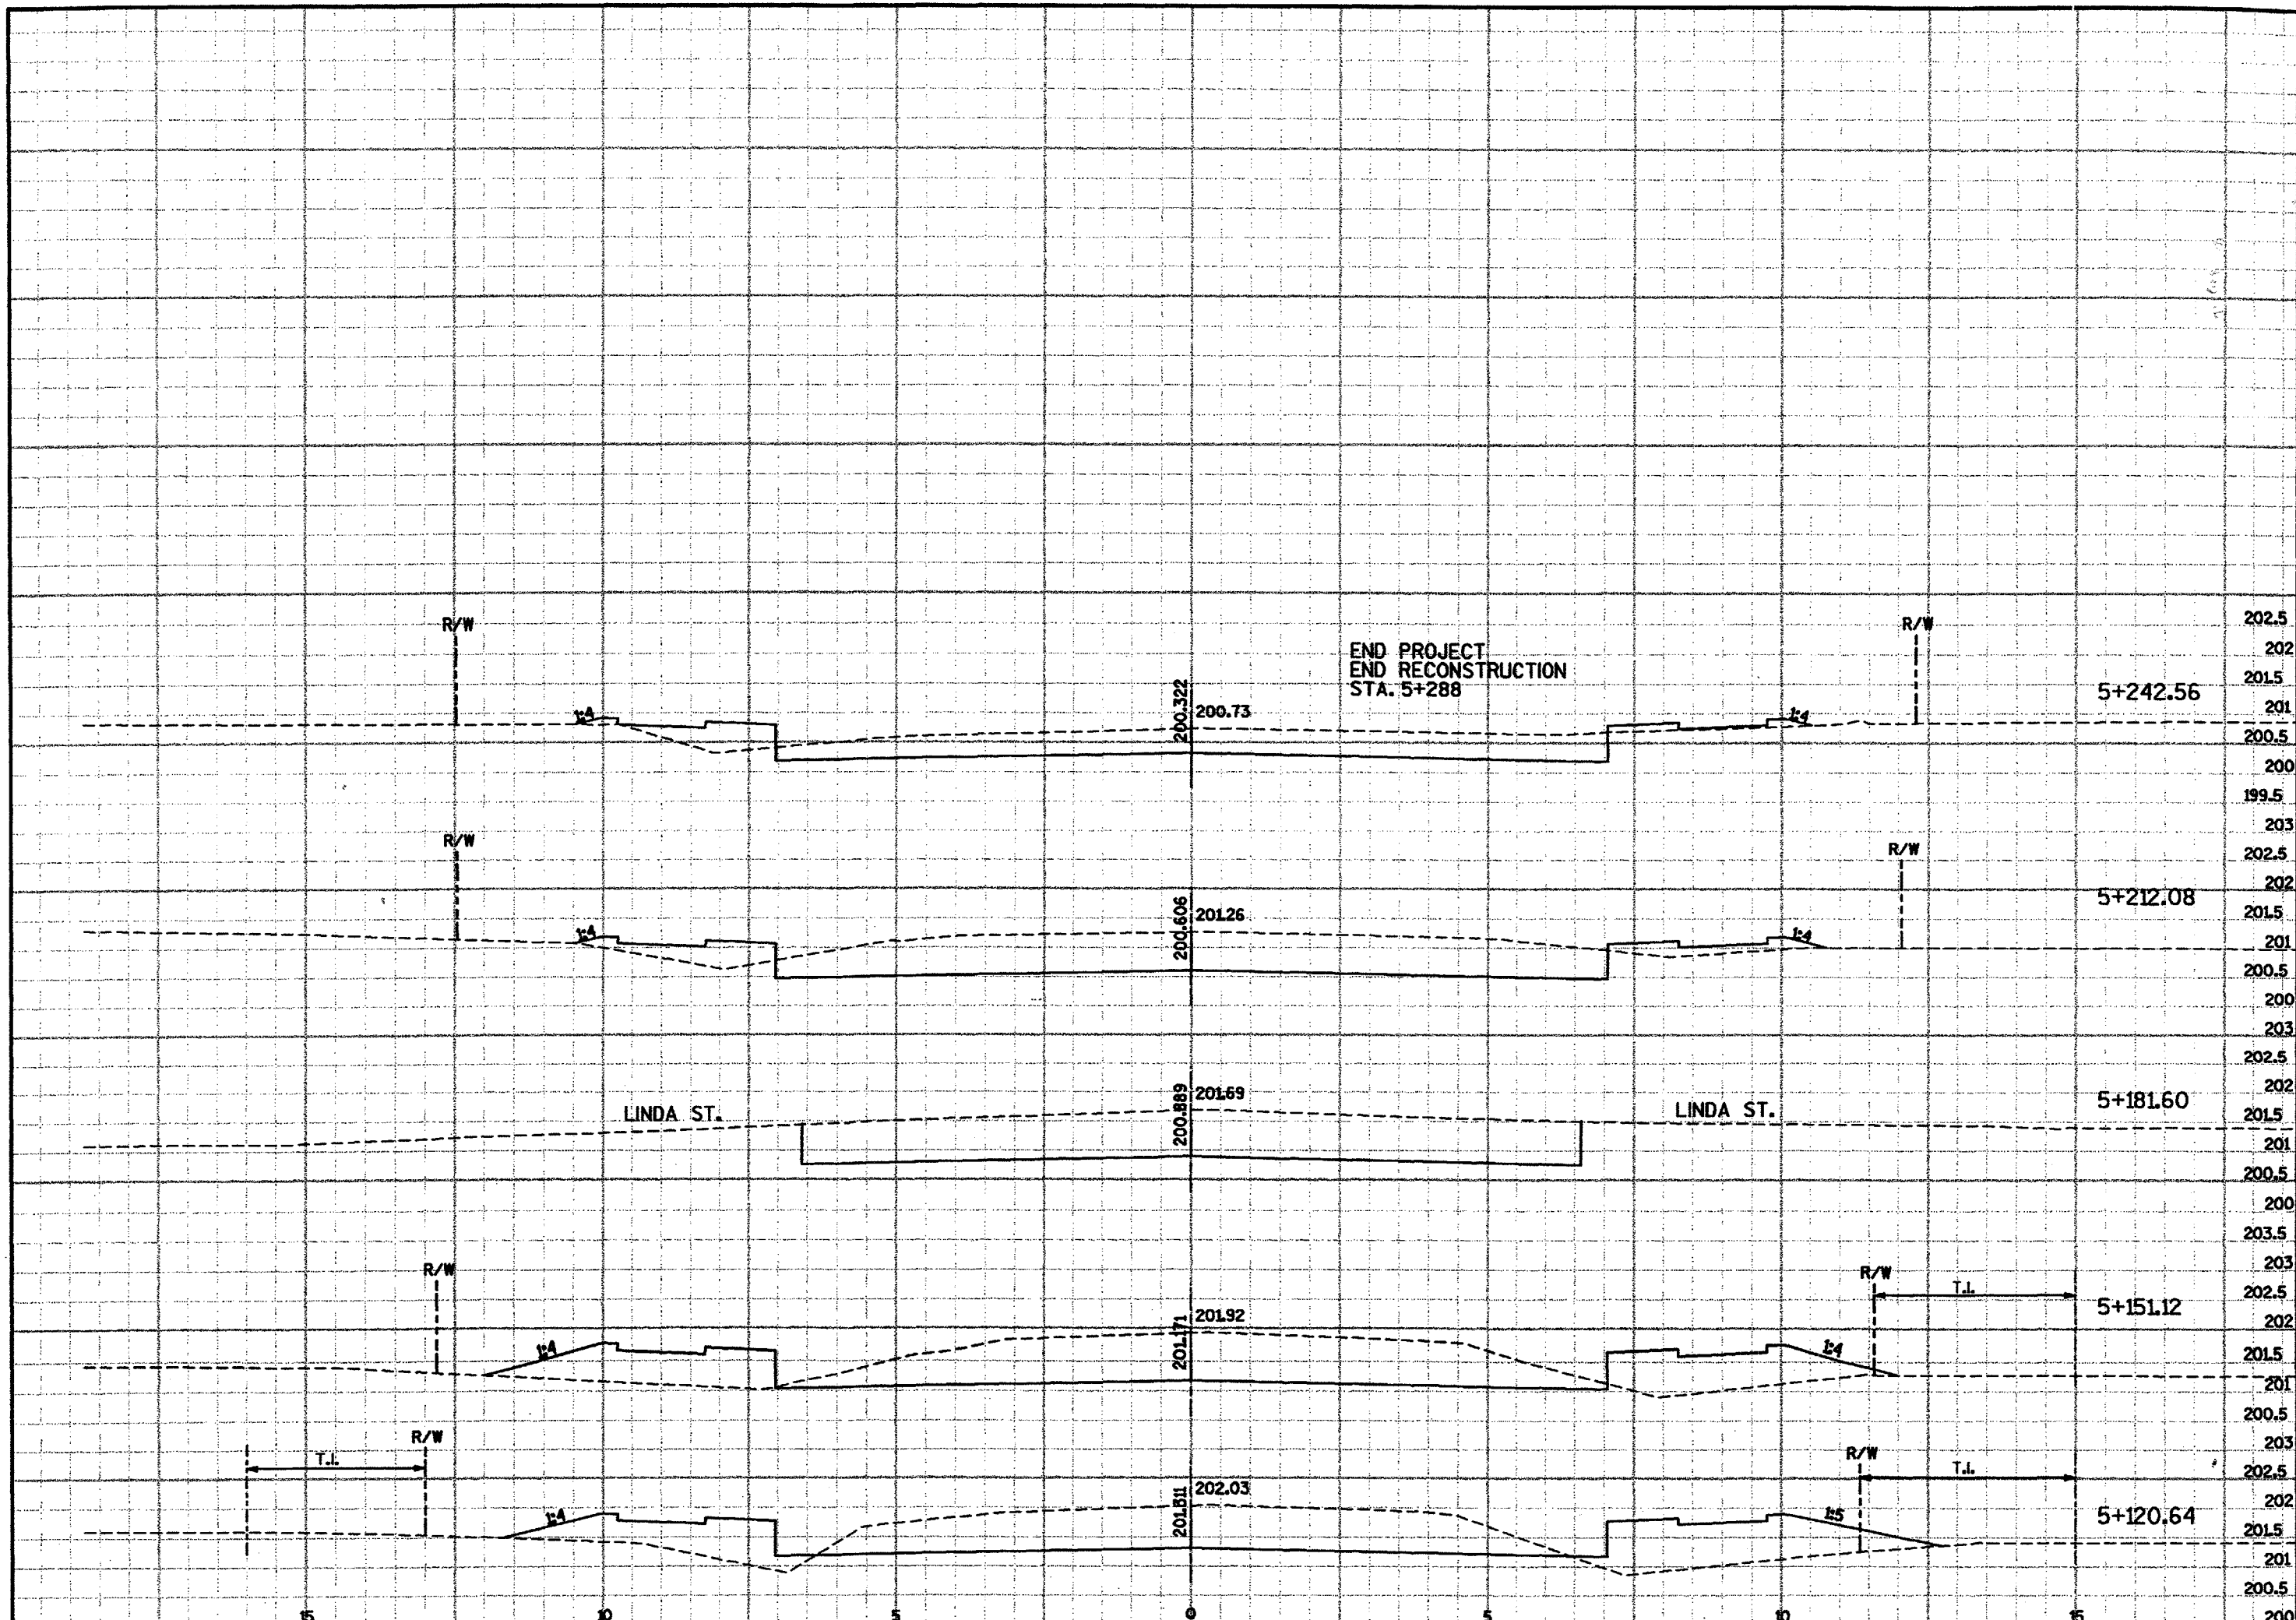

CROSS SECTIONS

HWY: STH 96

COUNTY: BROWN

STATE PROJECT NO: 4095-05-72

SHEET NO: 9.24


M

PLOT SCALE:

PLOT NAME:

REV. DATE:

ORIGINATOR:

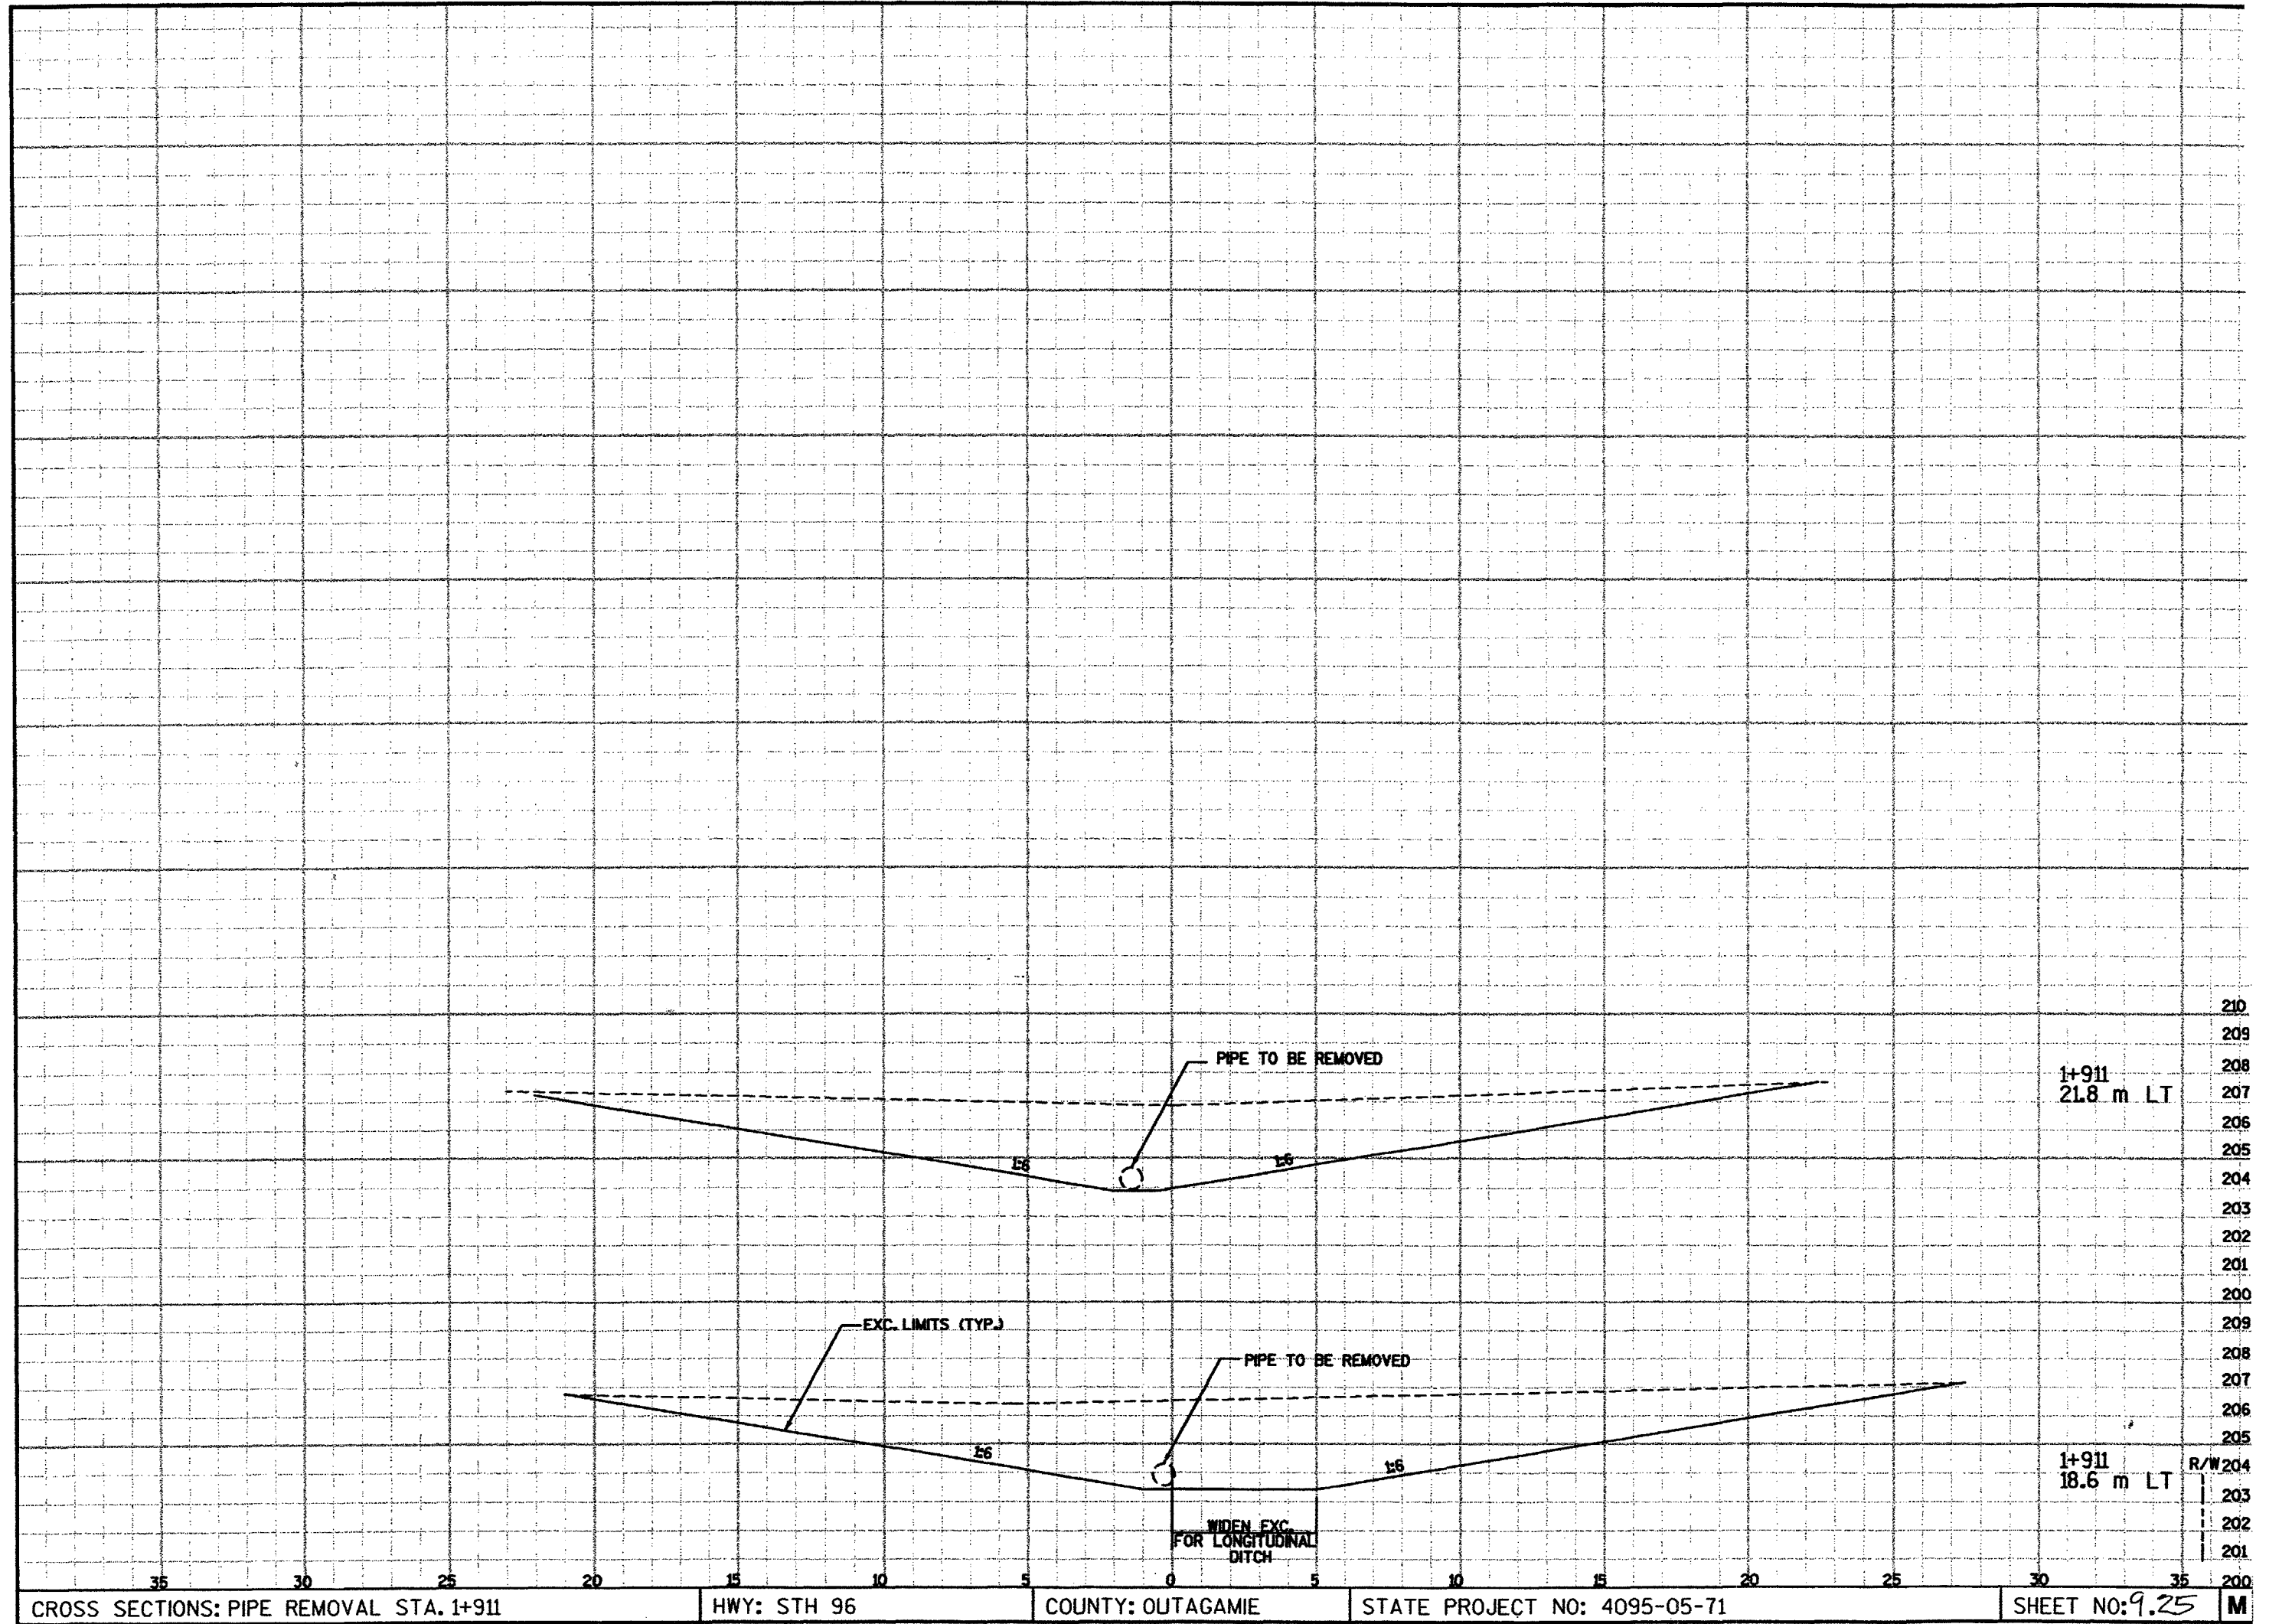


PLOT SCALE:

PLOT NAME:

REV. DATE:

ORIGINATOR:

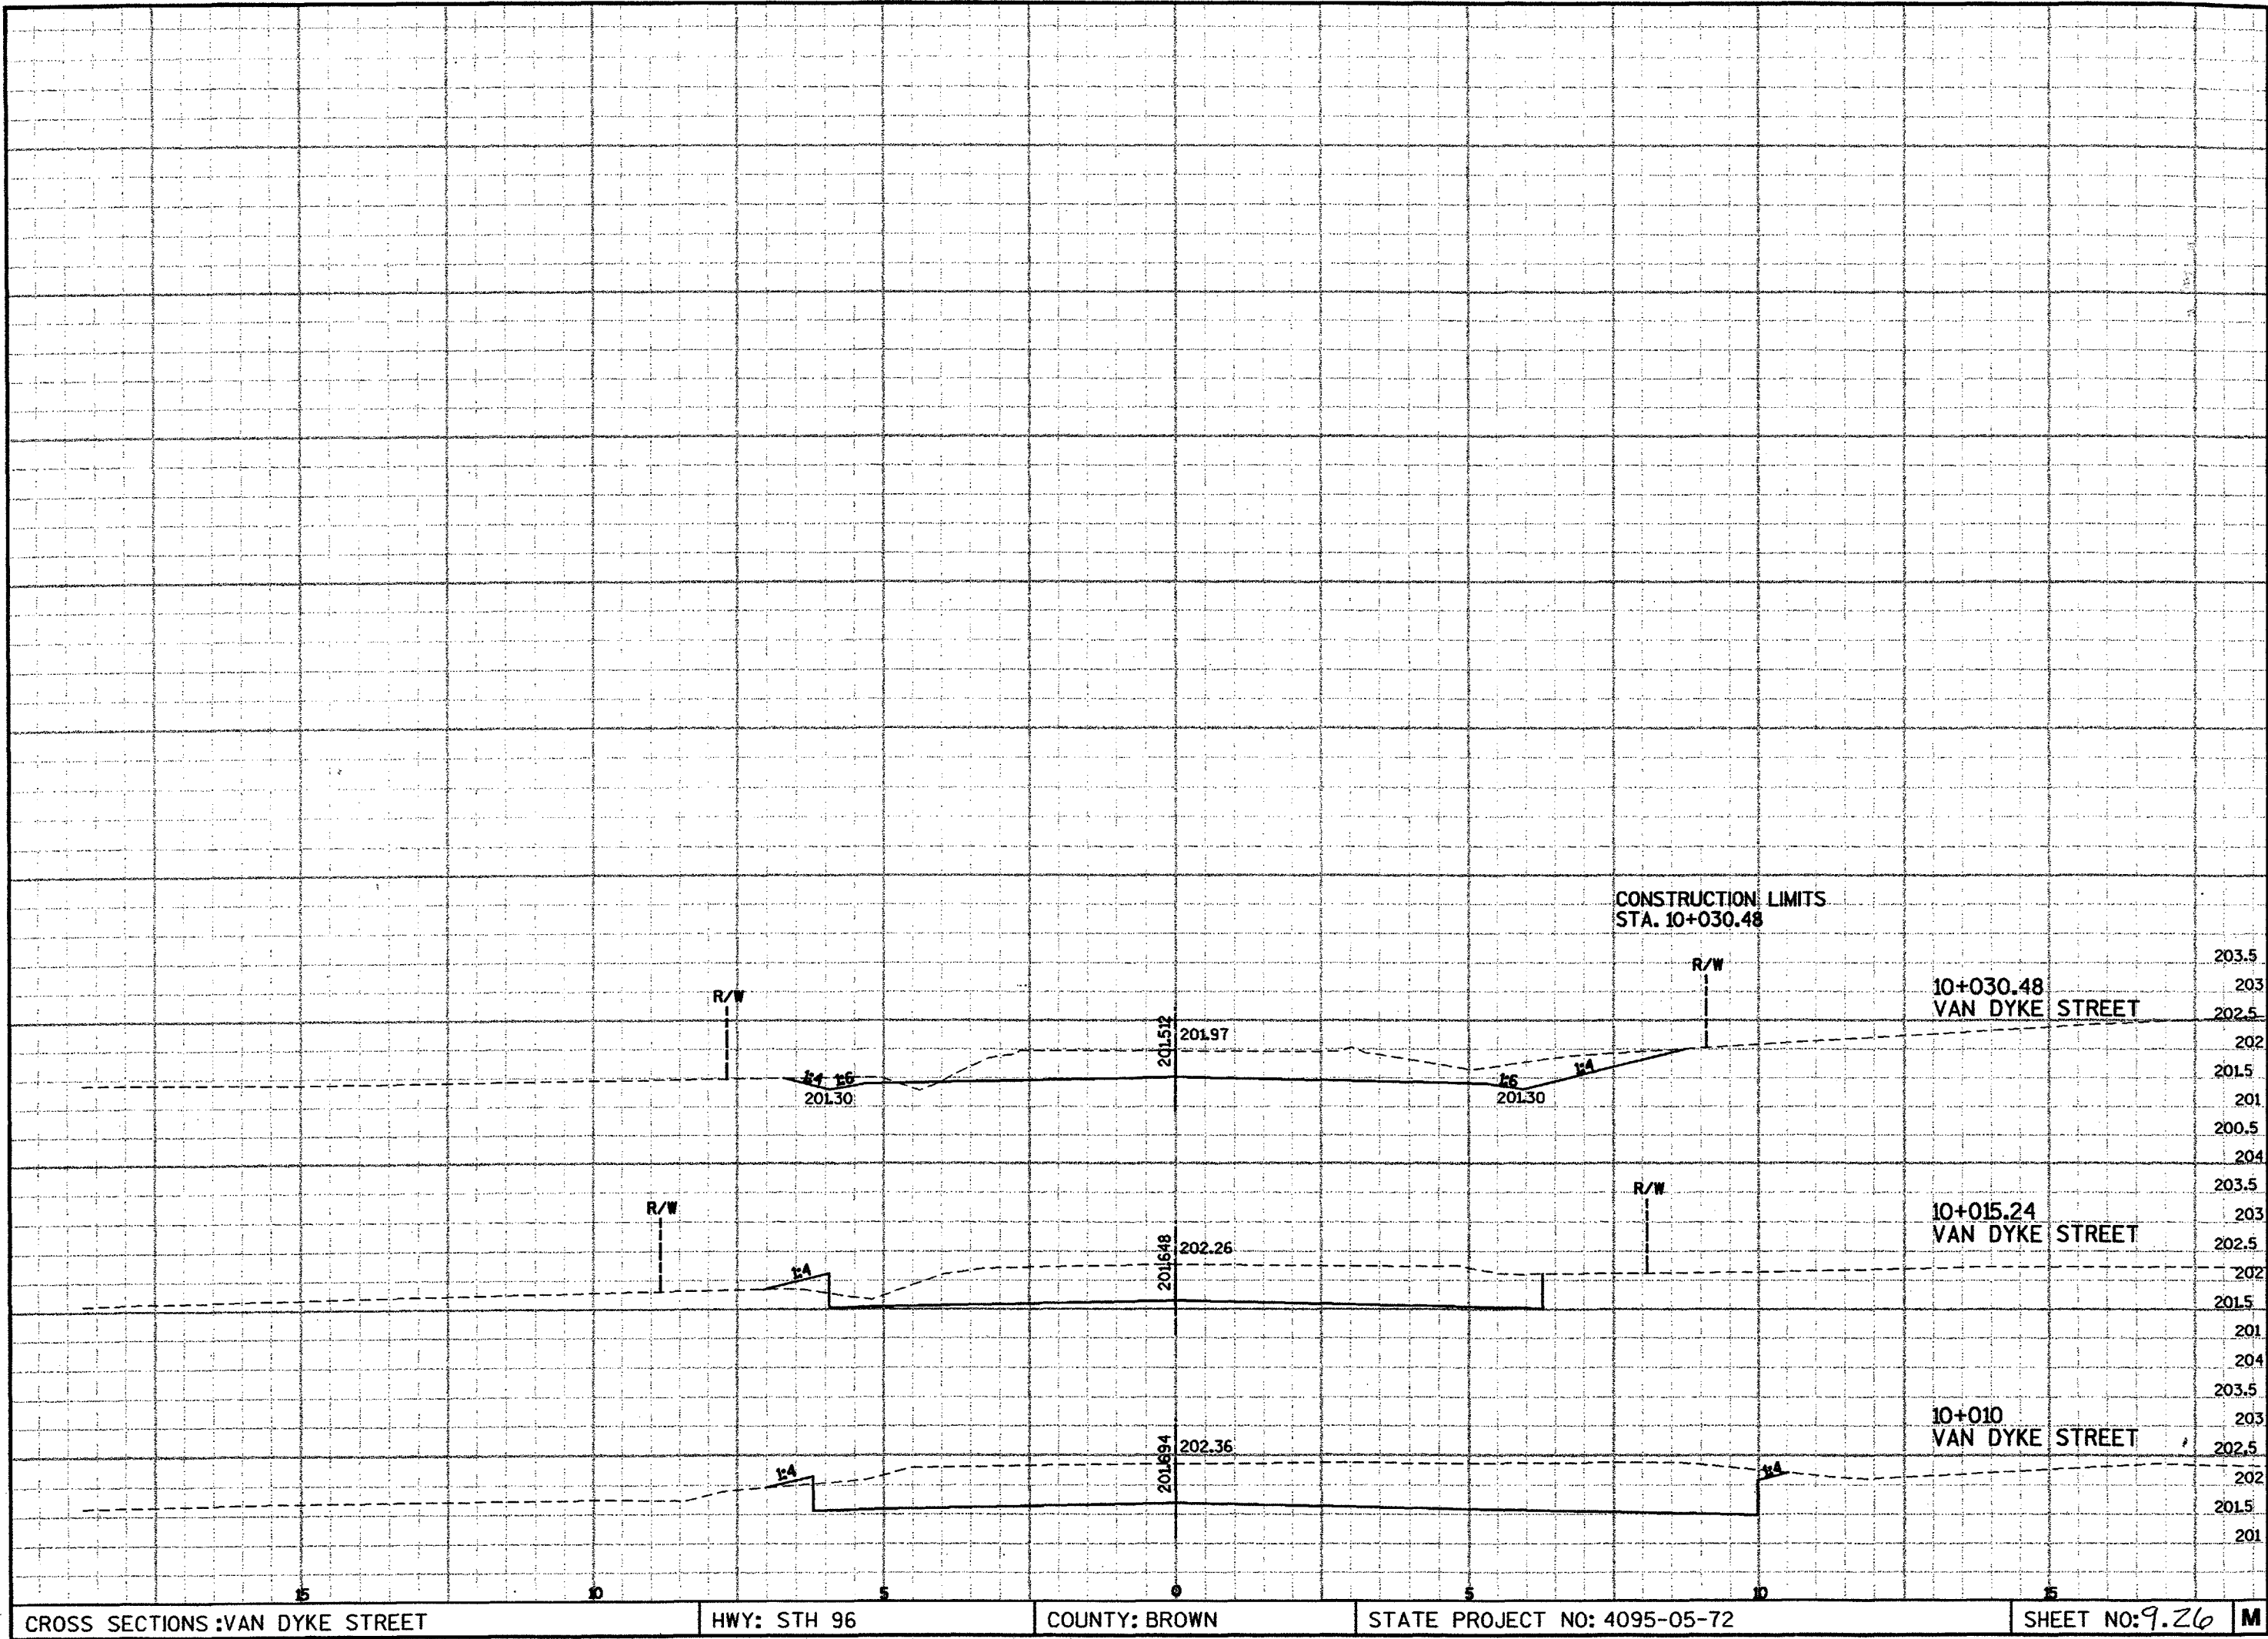

CROSS SECTIONS :VAN DYKE STREET

HWY: STH 96

COUNTY: BROWN

STATE PROJECT NO: 4095-05-72


SHEET NO: 9.26 M

PLOT SCALE:

PLOT NAME:


REV. DATE:

ORIGINATOR:

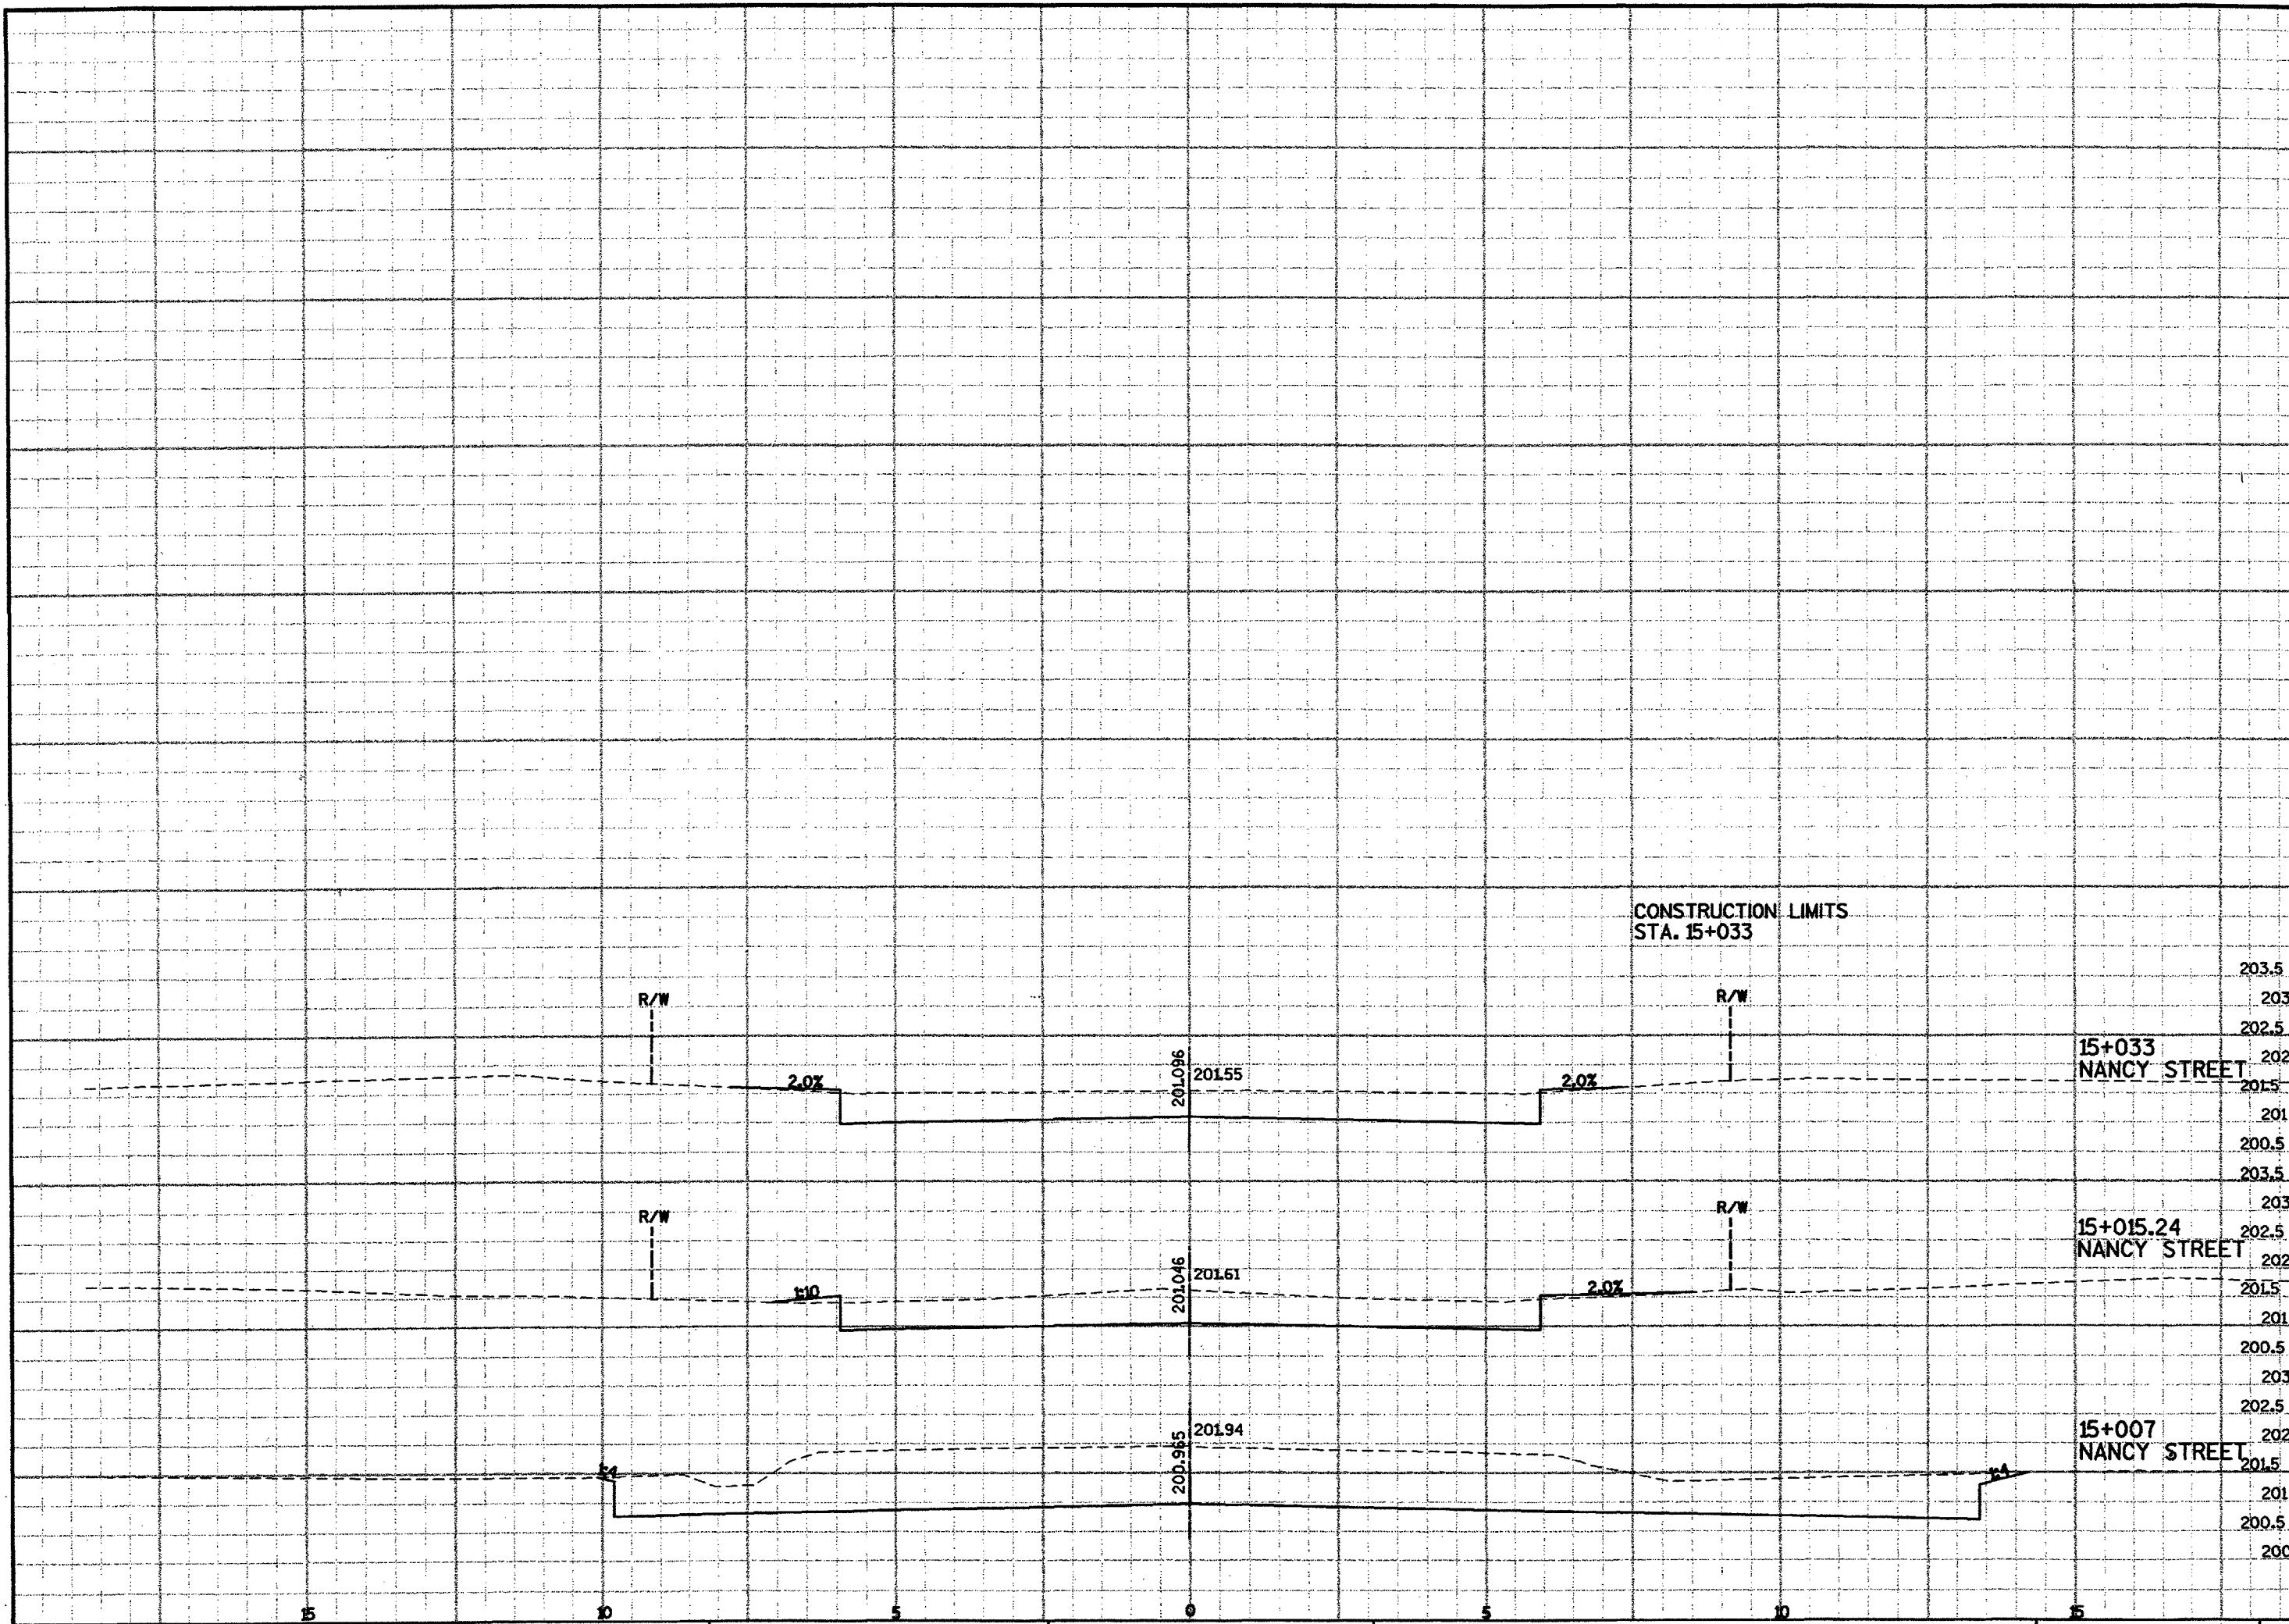

CROSS SECTIONS :NANCY STREET HWY: STH 96 COUNTY: BROWN STATE PROJECT NO: 4095-05-72 SHEET NO: 9.27 M

ORIGINATOR:

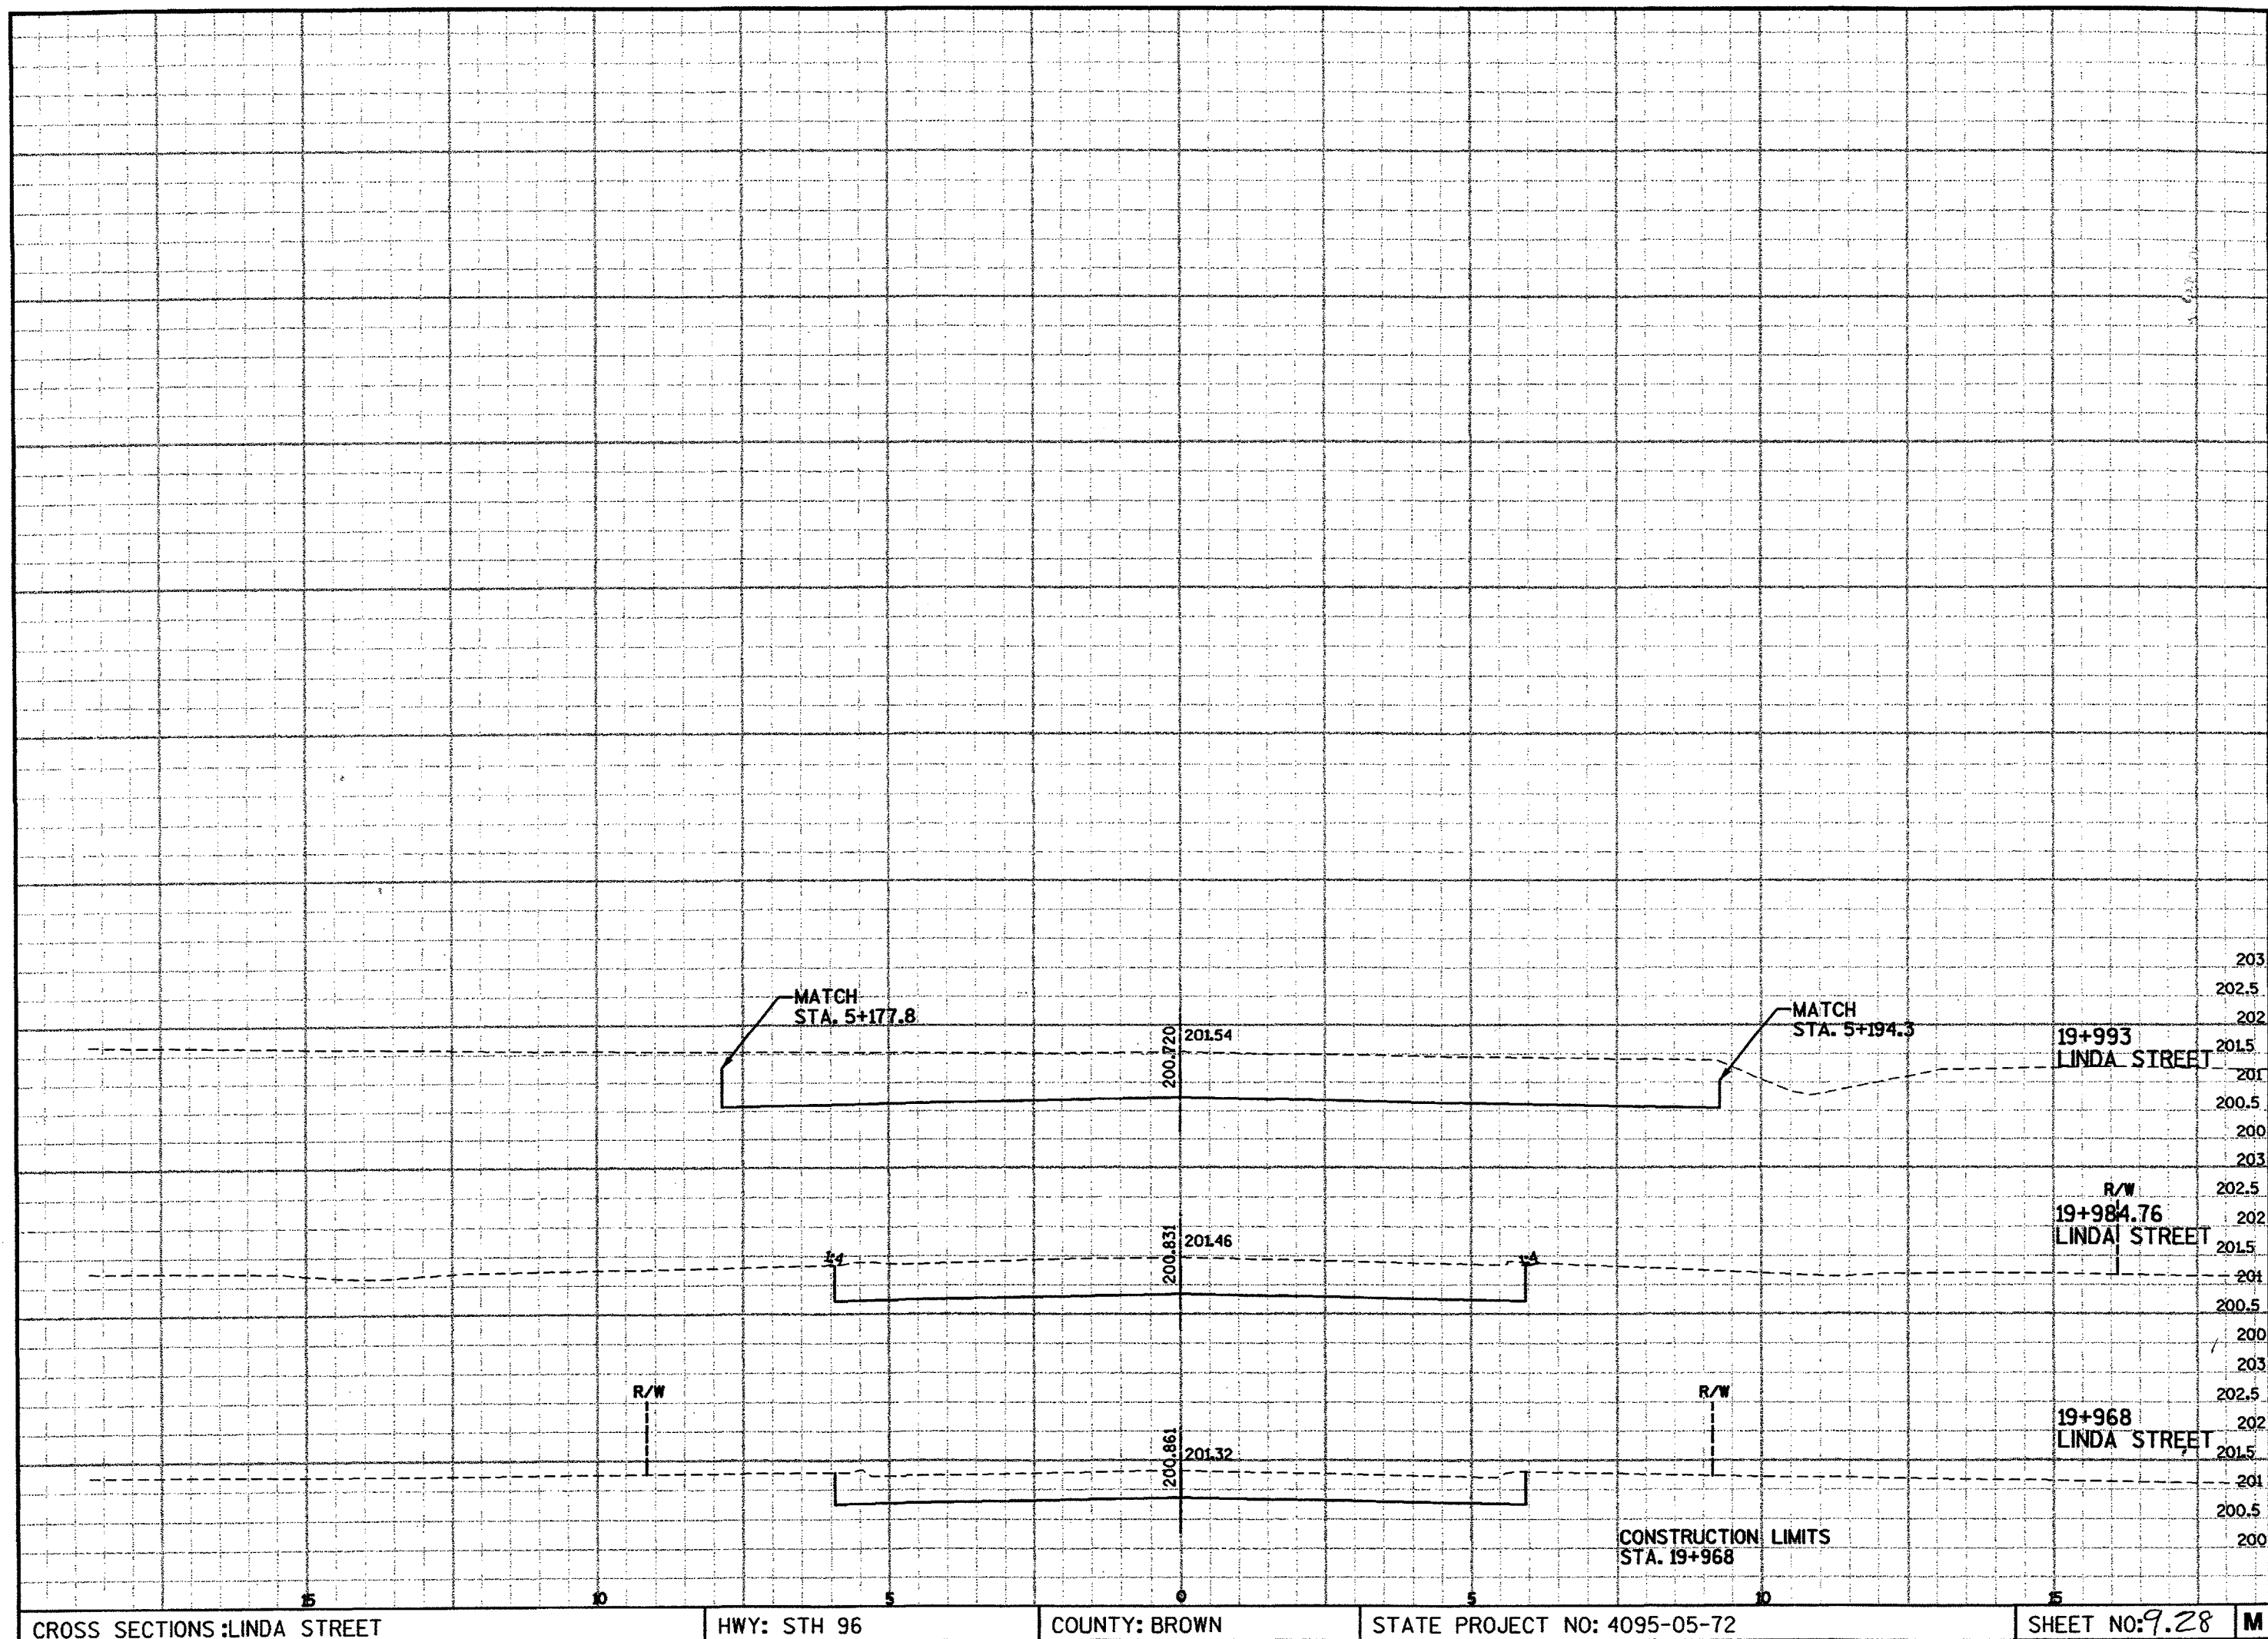


PLOT SCALE:

PLOT NAME:

REV. DATE:

ORIGINATOR:

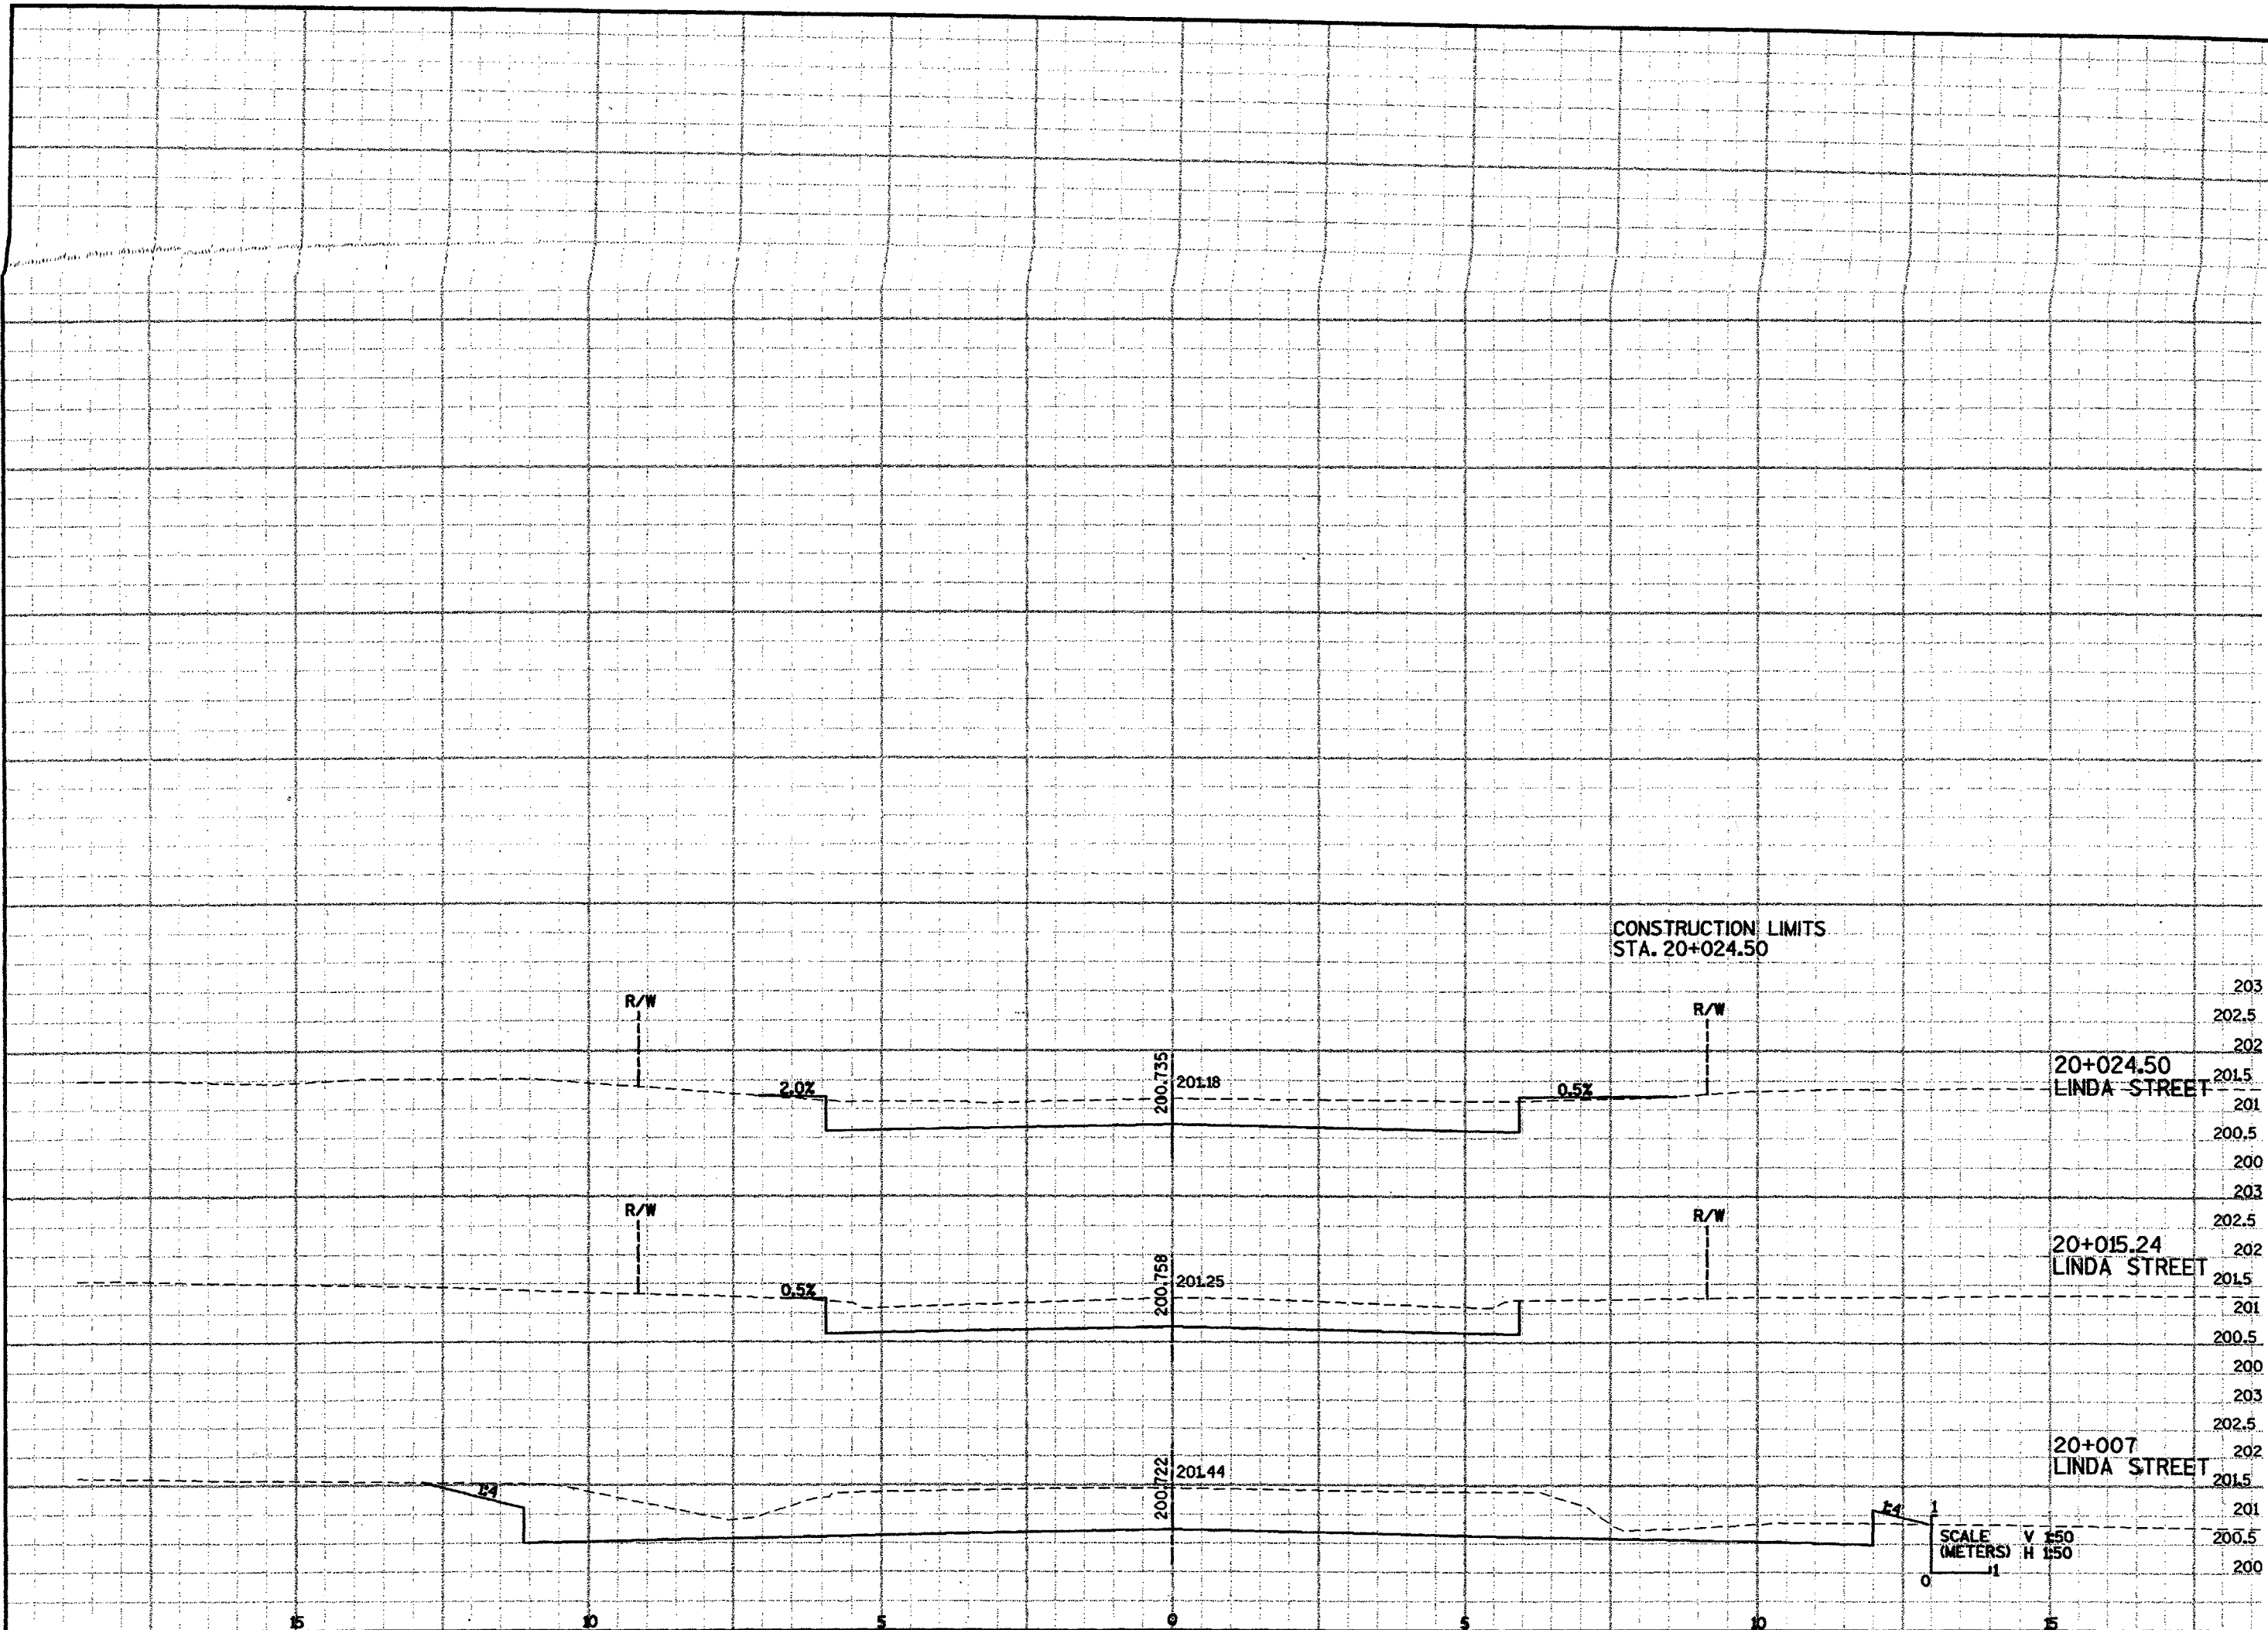


CROSS SECTIONS :LINDA STREET	HWY: STH 96	COUNTY: BROWN	STATE PROJECT NO: 4095-05-72	SHEET NO: 9.29	M
------------------------------	-------------	---------------	------------------------------	----------------	---

PLOT SCALE:

PLOT NAME:

REV. DATE:

ORIGINATOR:

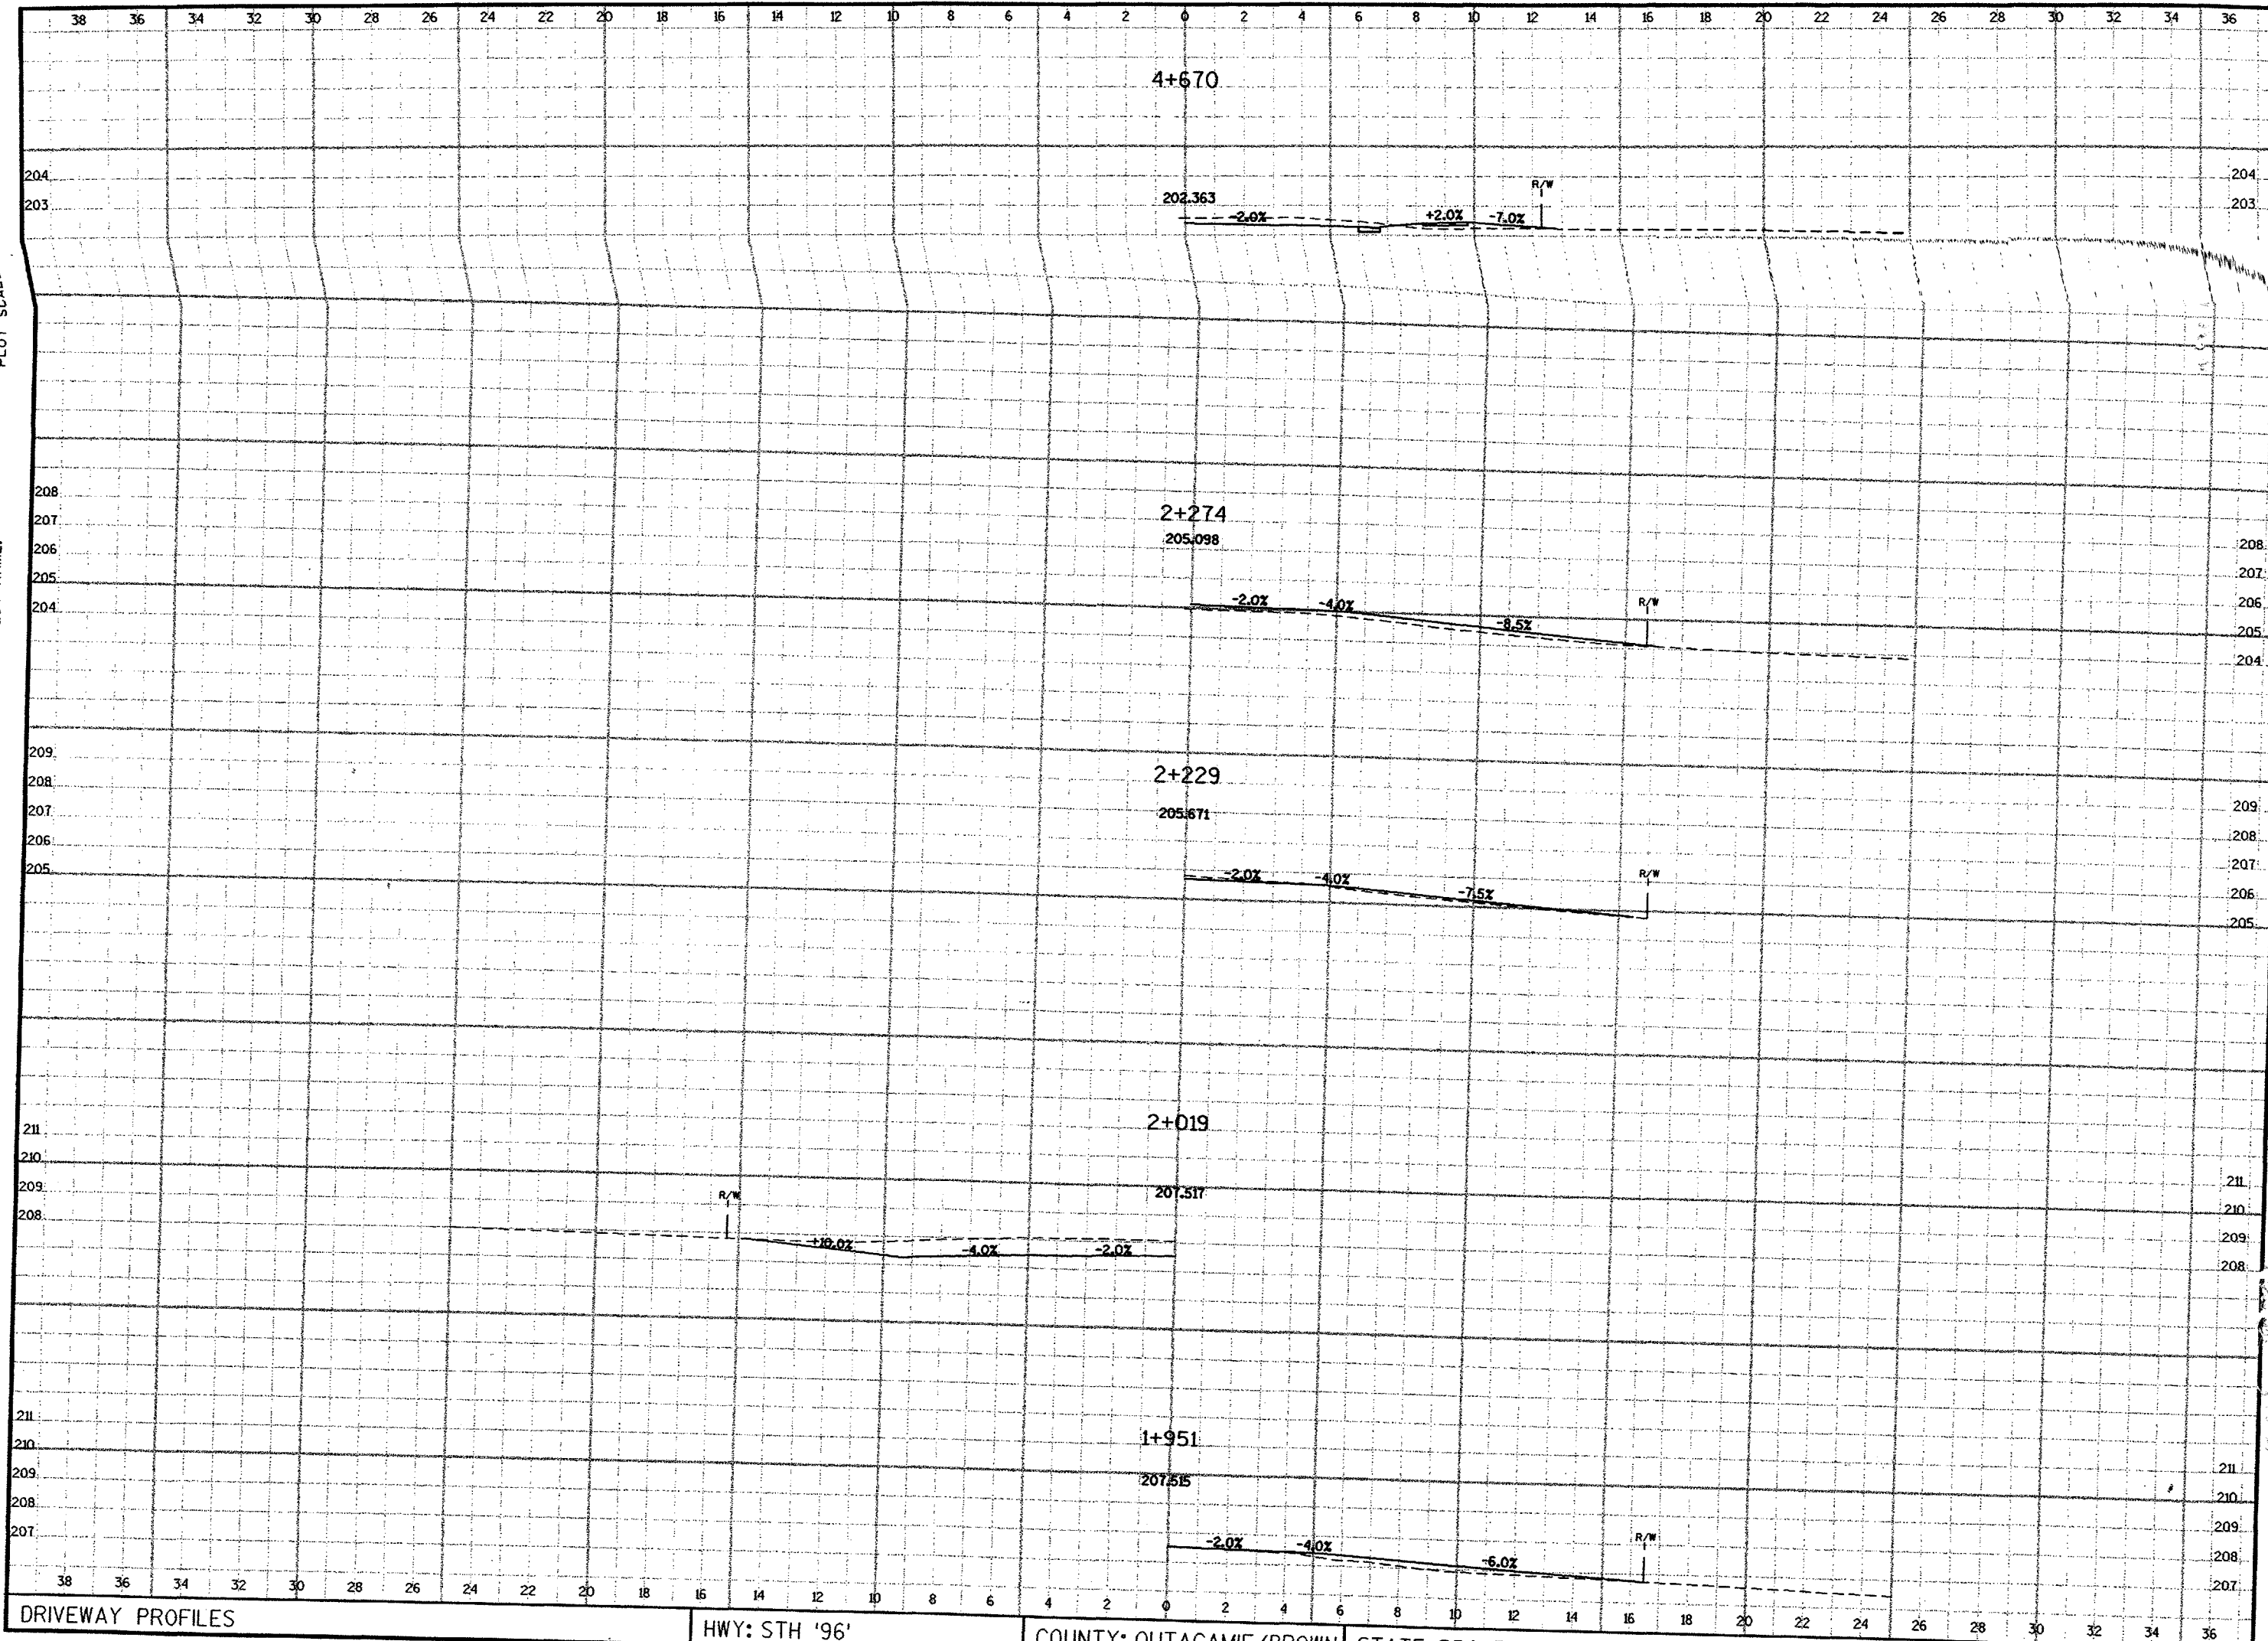

DRIVEWAY PROFILES


HWY: STH '96'

COUNTY: OUTAGAMIE/BROWN

STATE PROJECT NO: 4095-05-71(72)

SHEET NO: 9.30

M

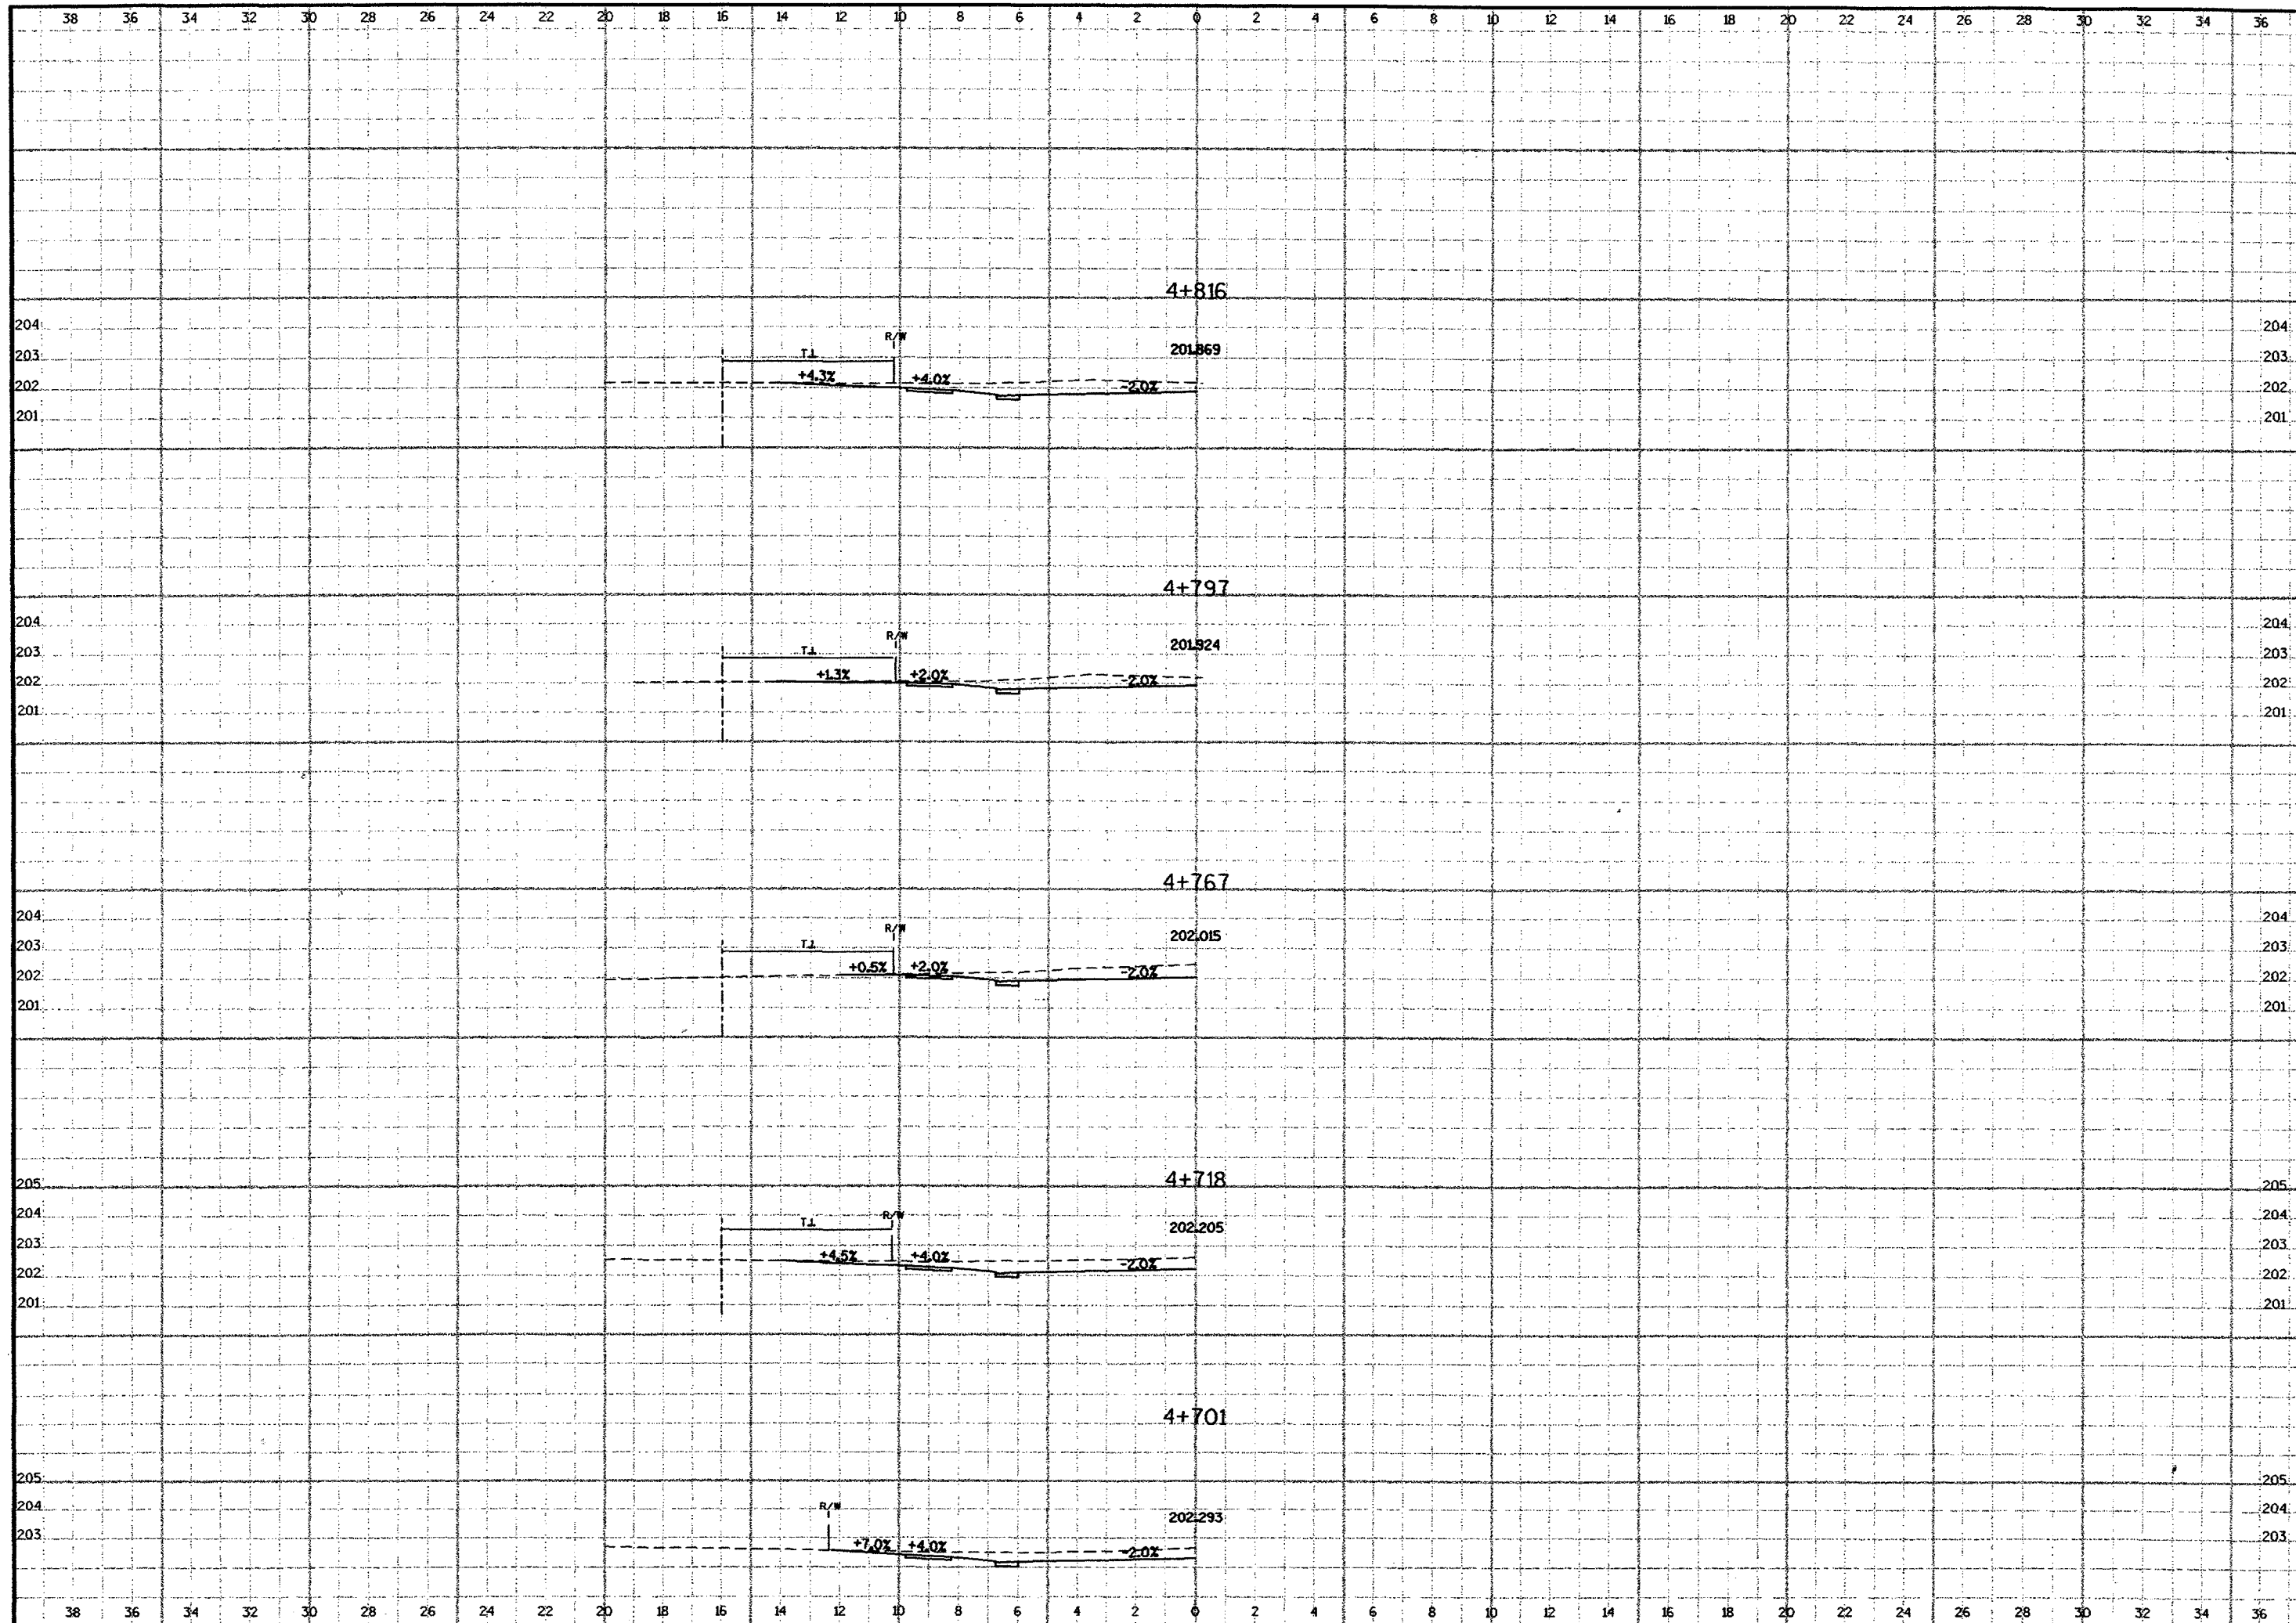

PLOT SCALE: 1" = 10'

PLOT NAME:

REV. DATE:


ORIGINATOR:

PLOT SCALE:

PLOT NAME:

REV. DATE:

ORIGINATOR:

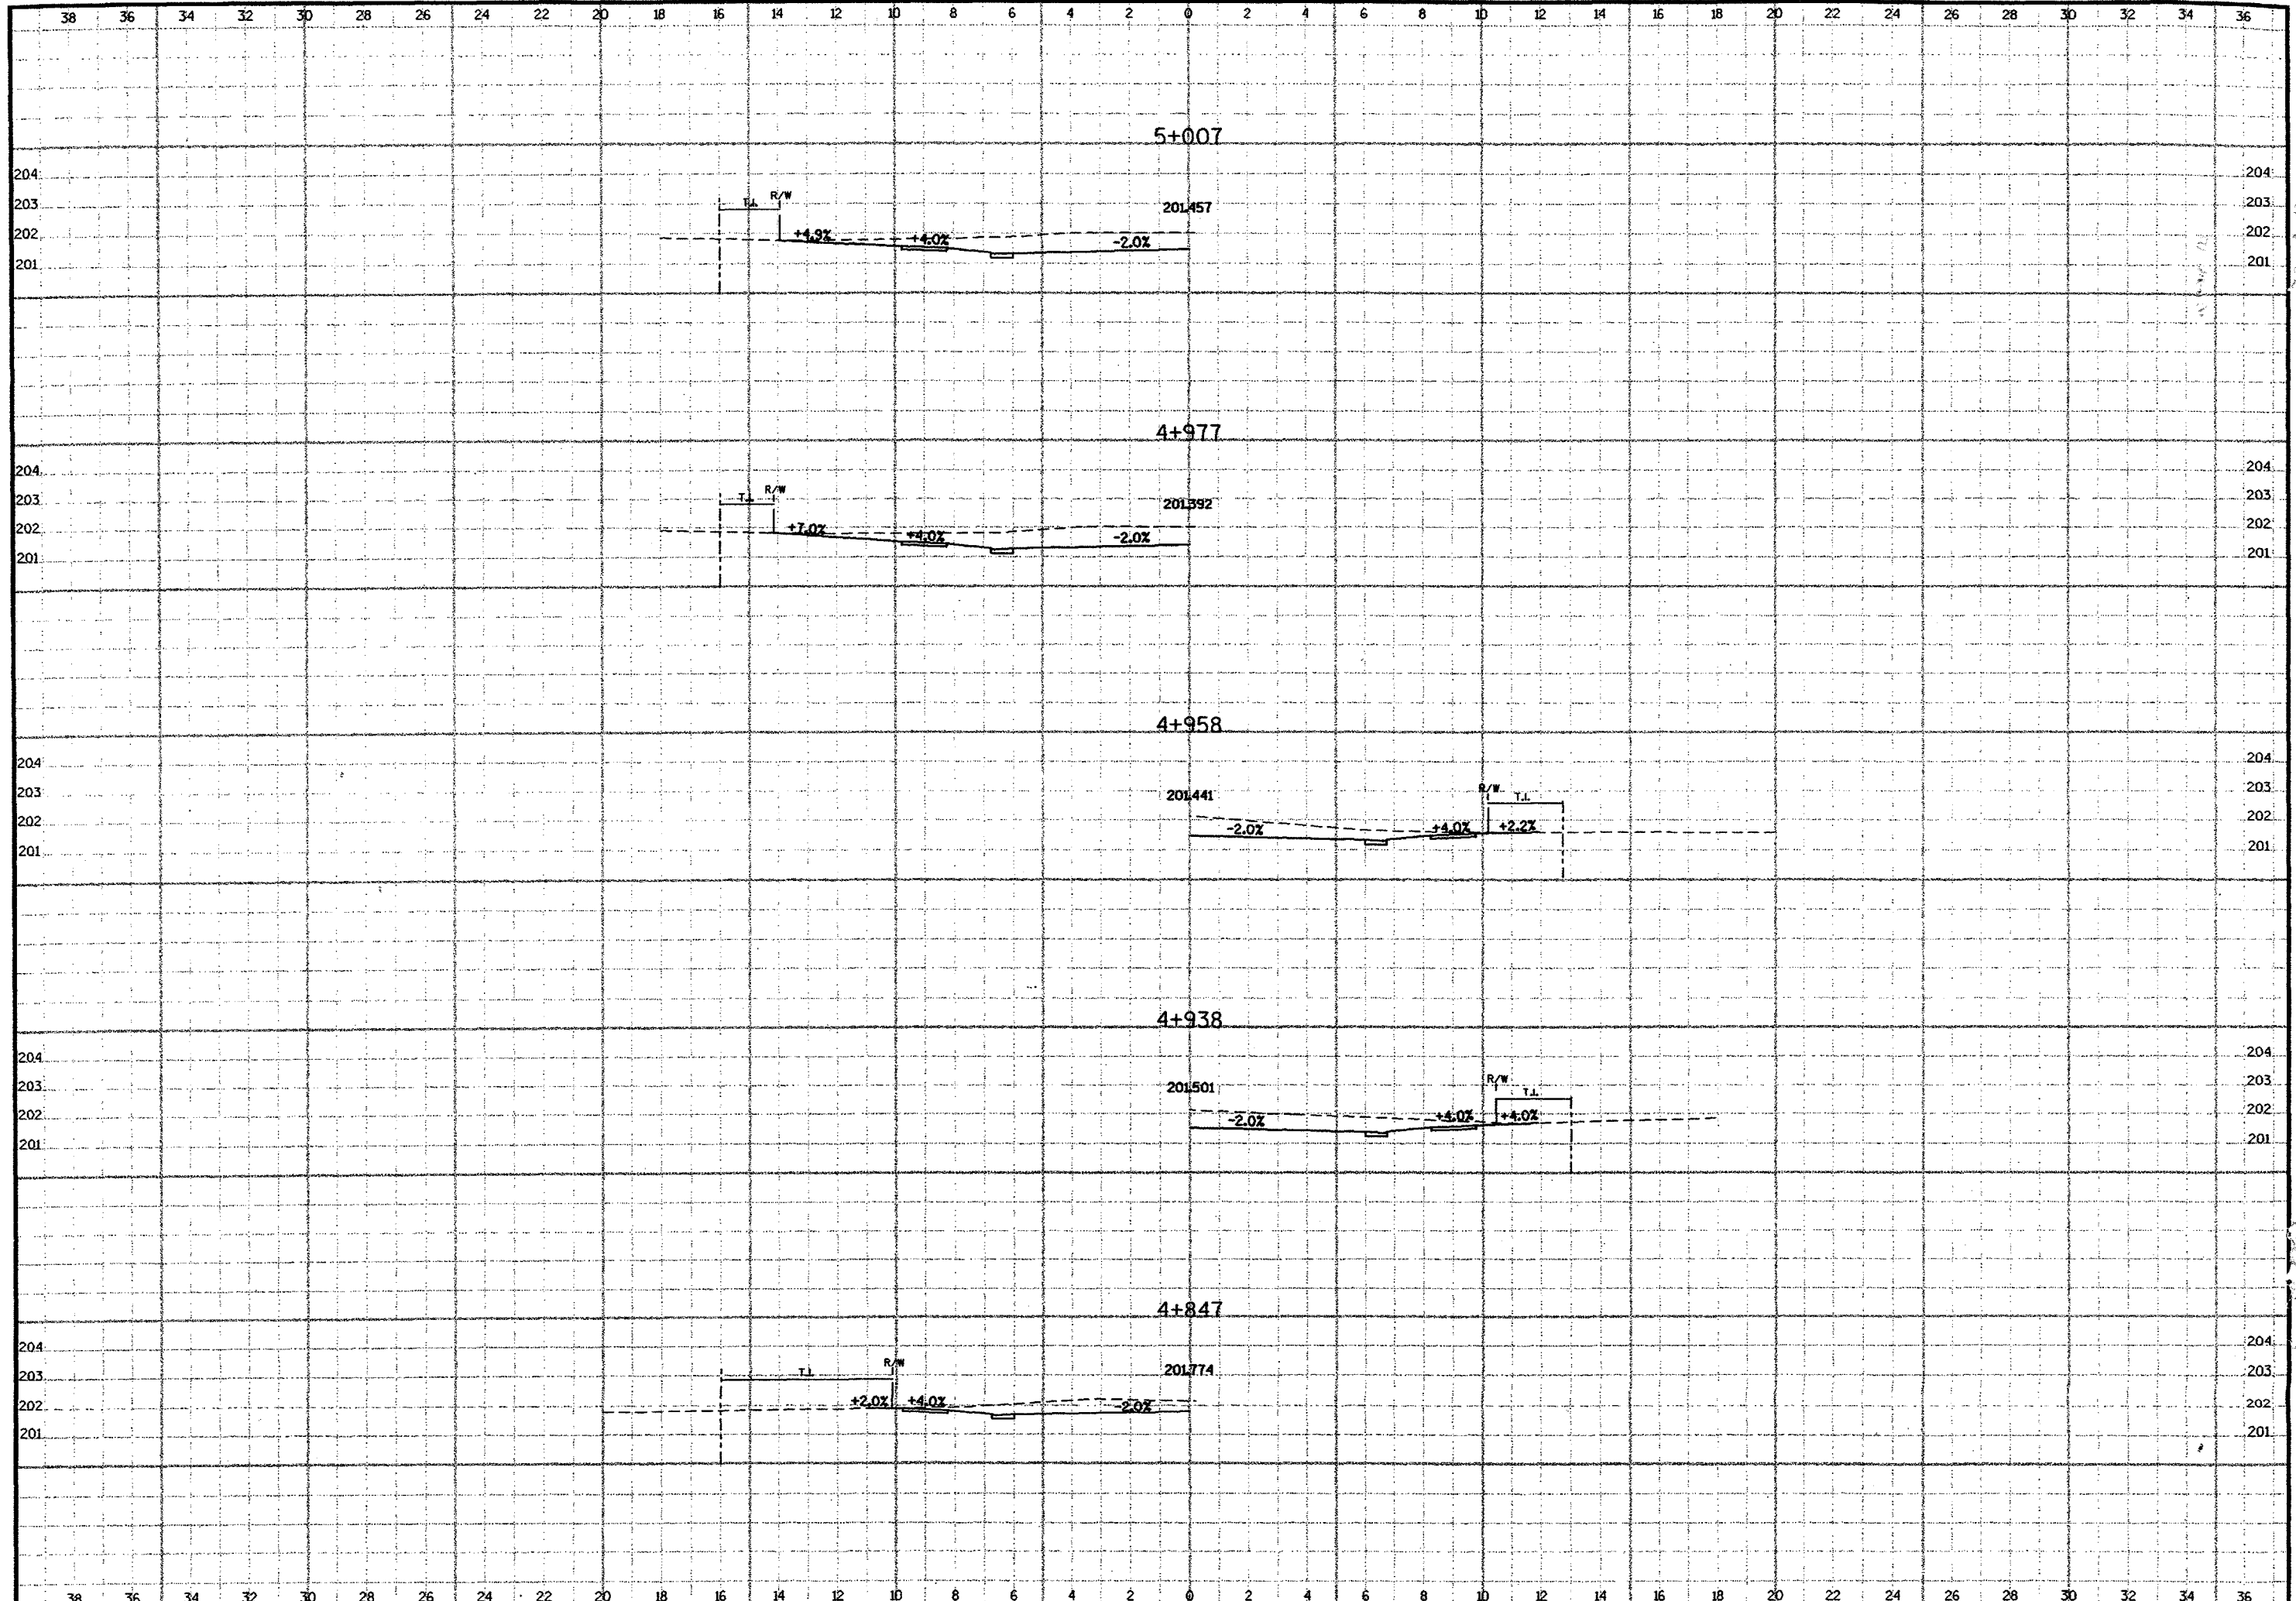


DRIVEWAY PROFILES

HWY: STH '96'

COUNTY: BROWN

STATE PROJECT NO: 4095-05-72

SHEET NO: 9.32 M

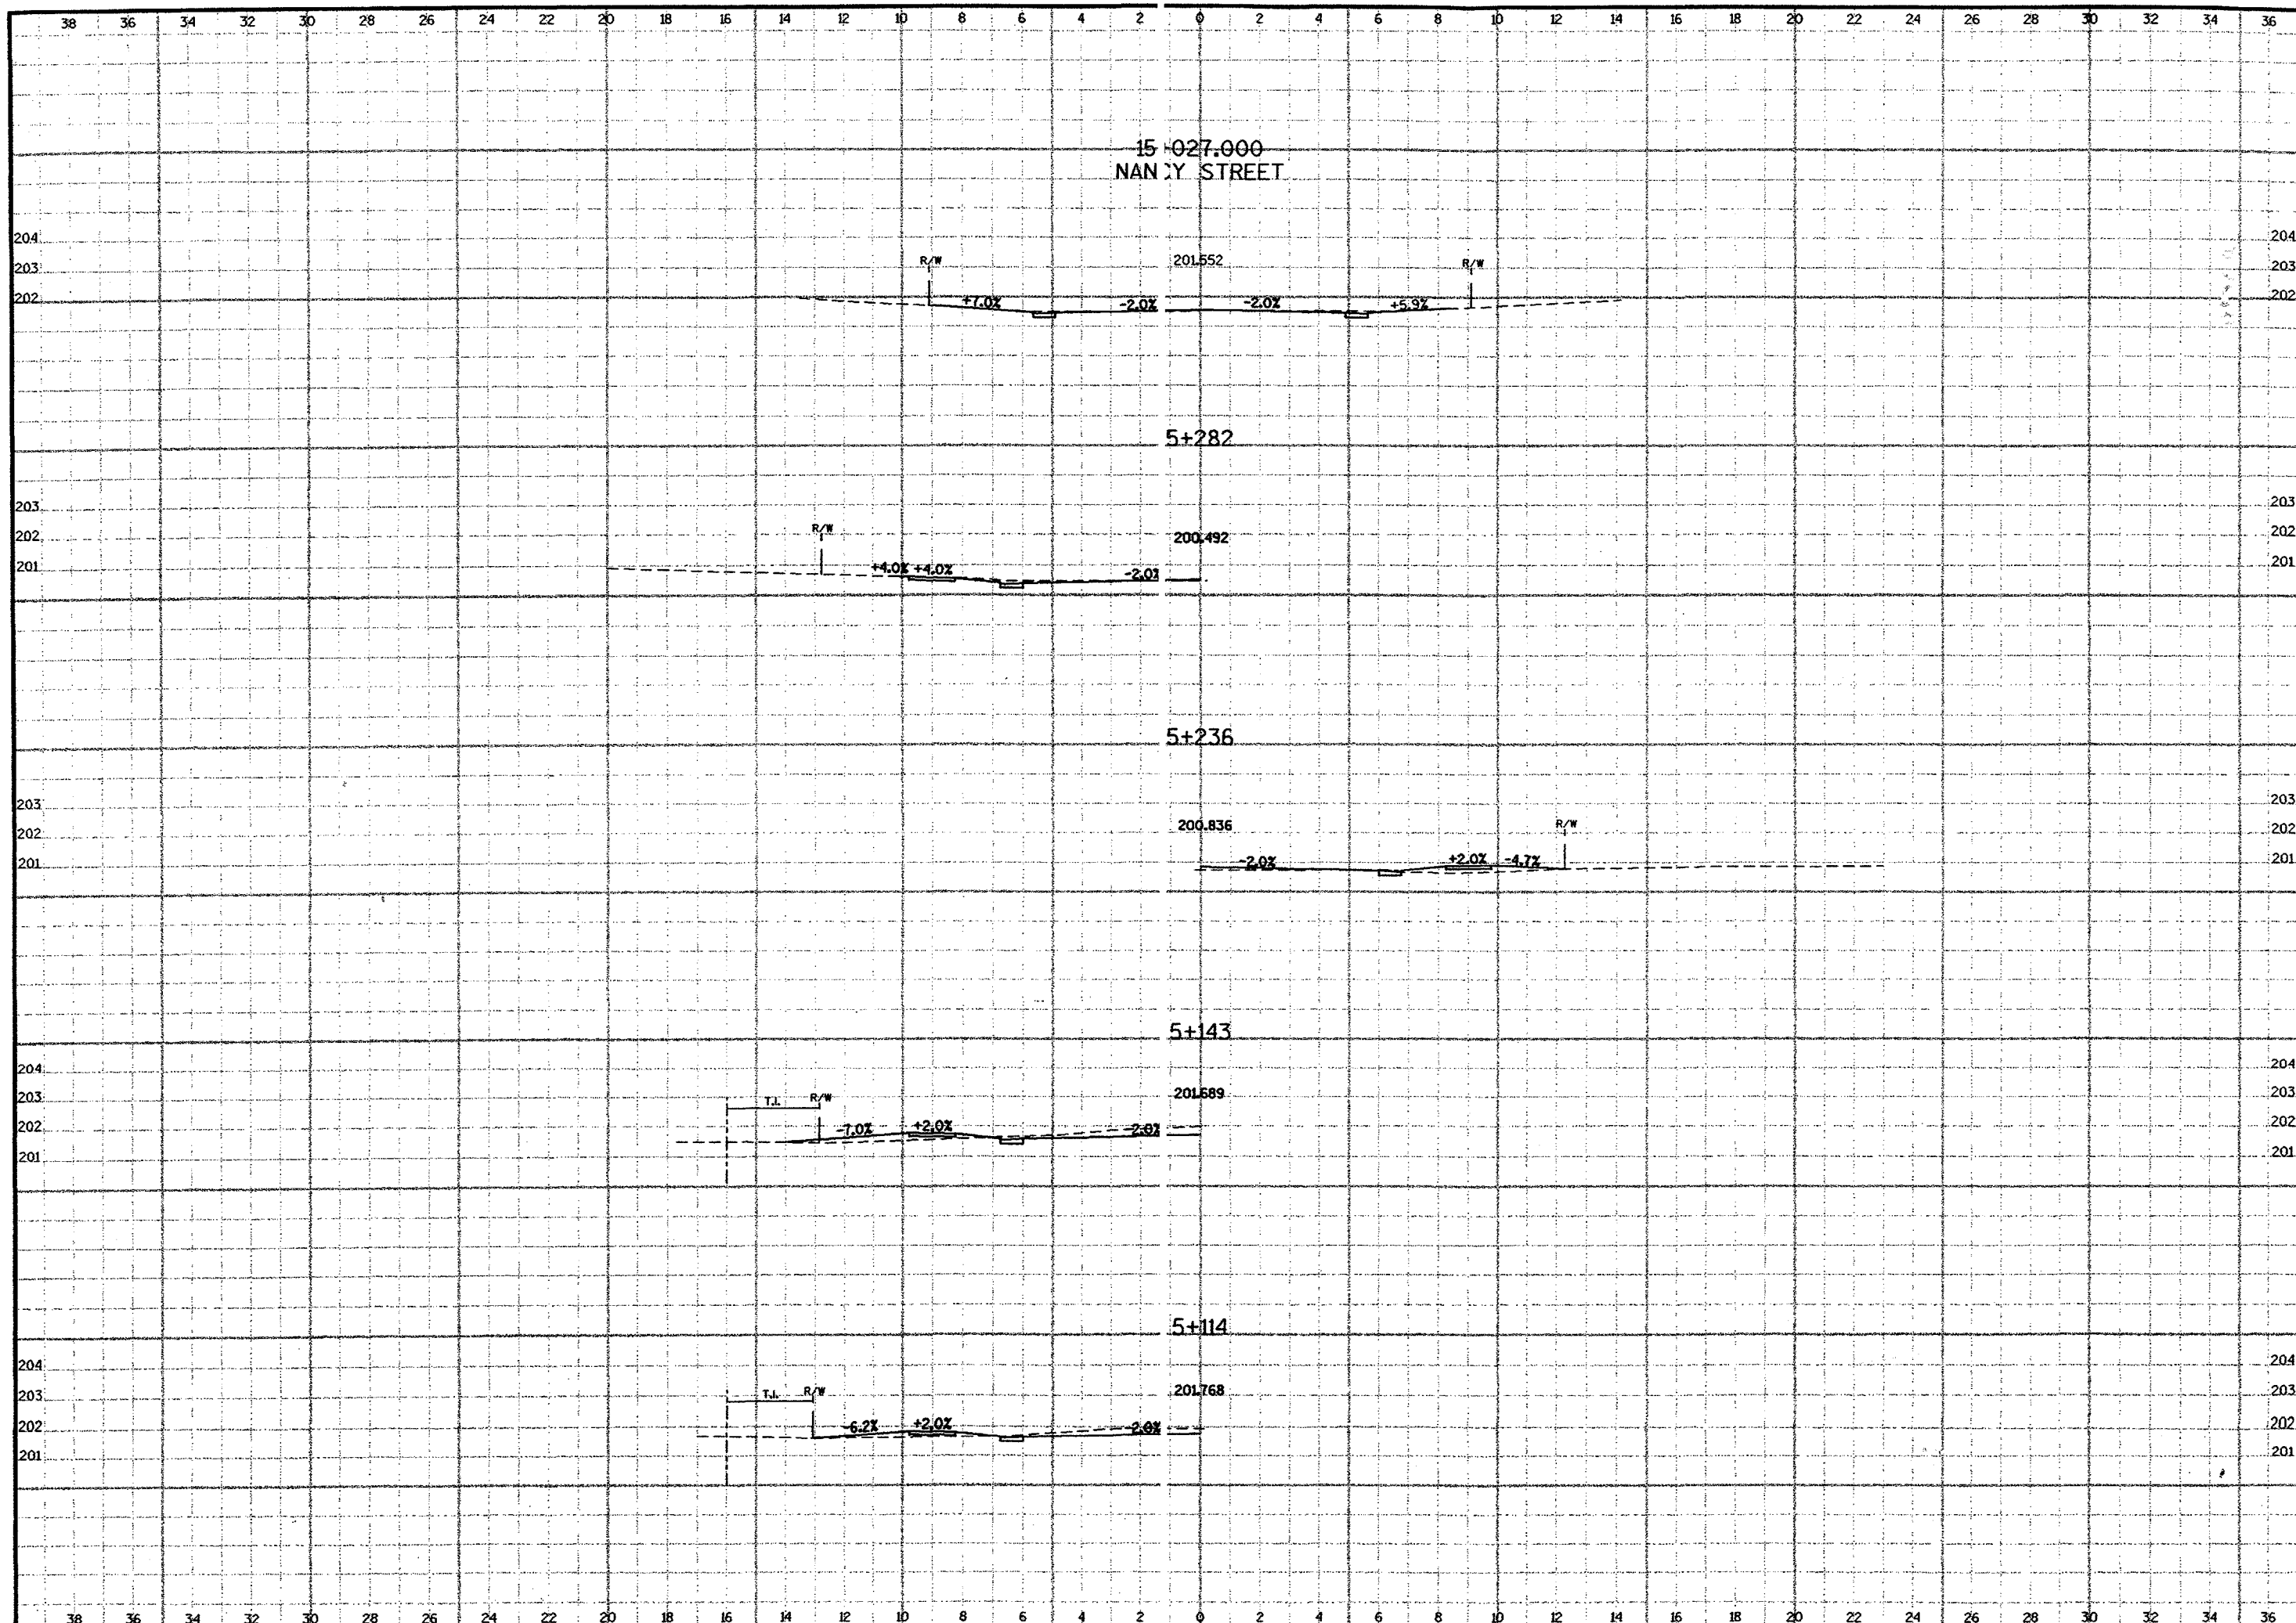

DRIVEWAY PROFILES

HWY: STH '96'

COUNTY: BROWN

STATE PROJECT NO: 4095-05-72

SHEET NO: 9.34

M