



CURVE DATA (#2)
P.I. = 1+259.398
N = 55,173.4478
E = 141,735.5592
DELTA = 22° 32' 20" (RT)
T = 140.482 m
L = 277.331 m
R = 705.000 m
P.C. = 1+118.916
P.T. = 1+396.247

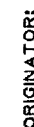

NO.	STA.	DESCRIPTION	ELEV.
1	0+994: 28.6 m LT.	"+" ON NE BOLT RR SIGNAL (D.O.T. #600)	212.534
2	1+249: 12.5 m RT.	PK NATL SE SIDE 500 mm ASPEN	213.452
3	1+460: 14.5 m RT.	PK NATL SE SIDE TWIN 200 mm ASH	211.184

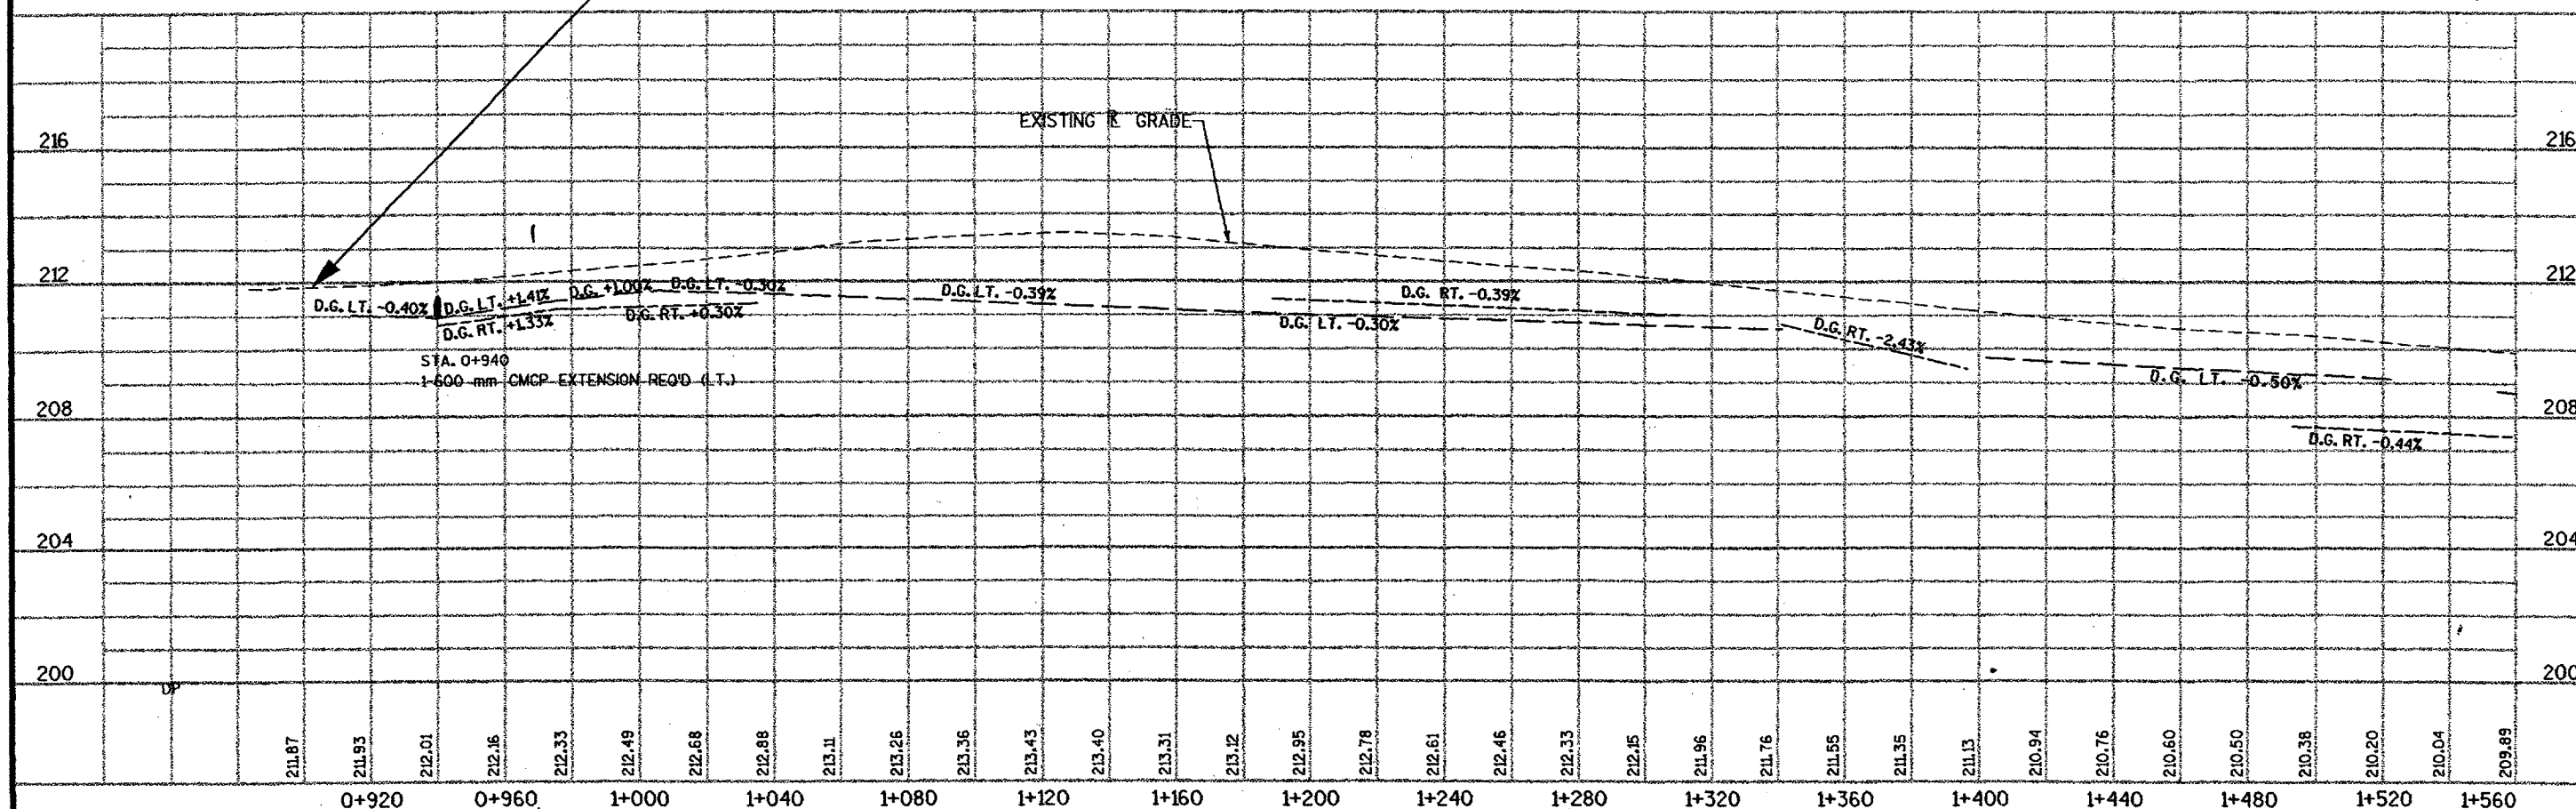

PLAN AND PROFILE	SCALE: 1:1000	HWY: STH '96'	COUNTY: OUTAGAMIE/BROWN	STATE PROJECT NO: 4095-05-71	SHEET NO: 5.1
------------------	---------------	---------------	-------------------------	------------------------------	---------------

ORIGINATOR:

PLAN AND PROFILE	SCALE: 1:1000	HWY: STH '96'	COUNTY: OUTAGAMIE	STATE PROJECT NO: 4095-05-71	SHEET NO: 5.2
------------------	---------------	---------------	-------------------	------------------------------	---------------

PLOT SCALE:



PLOT NAME:

REV. DATE:

ORIGINATOR:

BENCH MARK TABLE			
NO.	STA.	DESCRIPTION	ELEV.
9	2+303 18.9 m RT.	PK NAIL NORTH SIDE SERVICE POLE (HOUSE #483)	203.430
10	2+518 13.6 m LT.	PK NAIL SOUTH SIDE POWER POLE #35B1-4/6	204.049
11	2+771 13.6 m LT.	PK NAIL SOUTH SIDE POWER POLE #35B1-11/9	203.927
11A	2+880 13.8 m RT.	PK NAIL POWER POLE	204.468

N

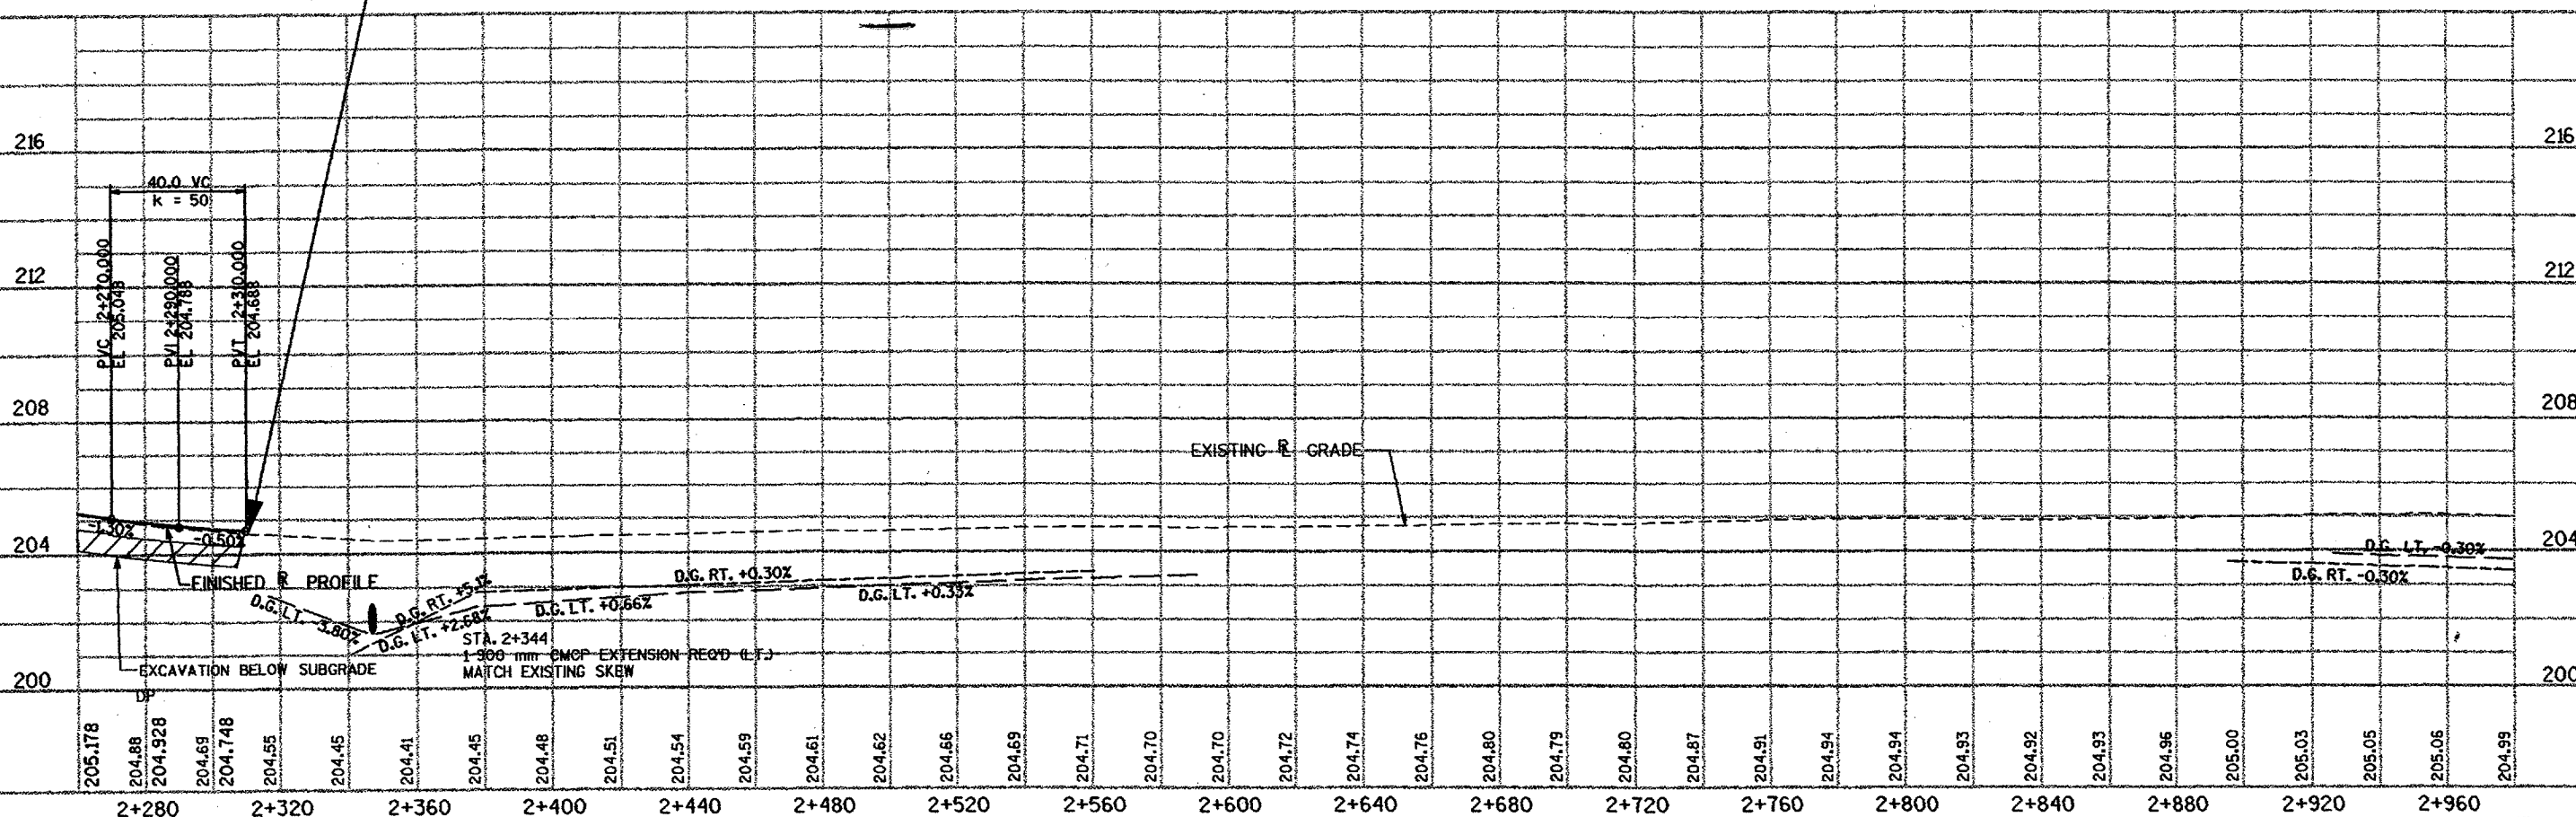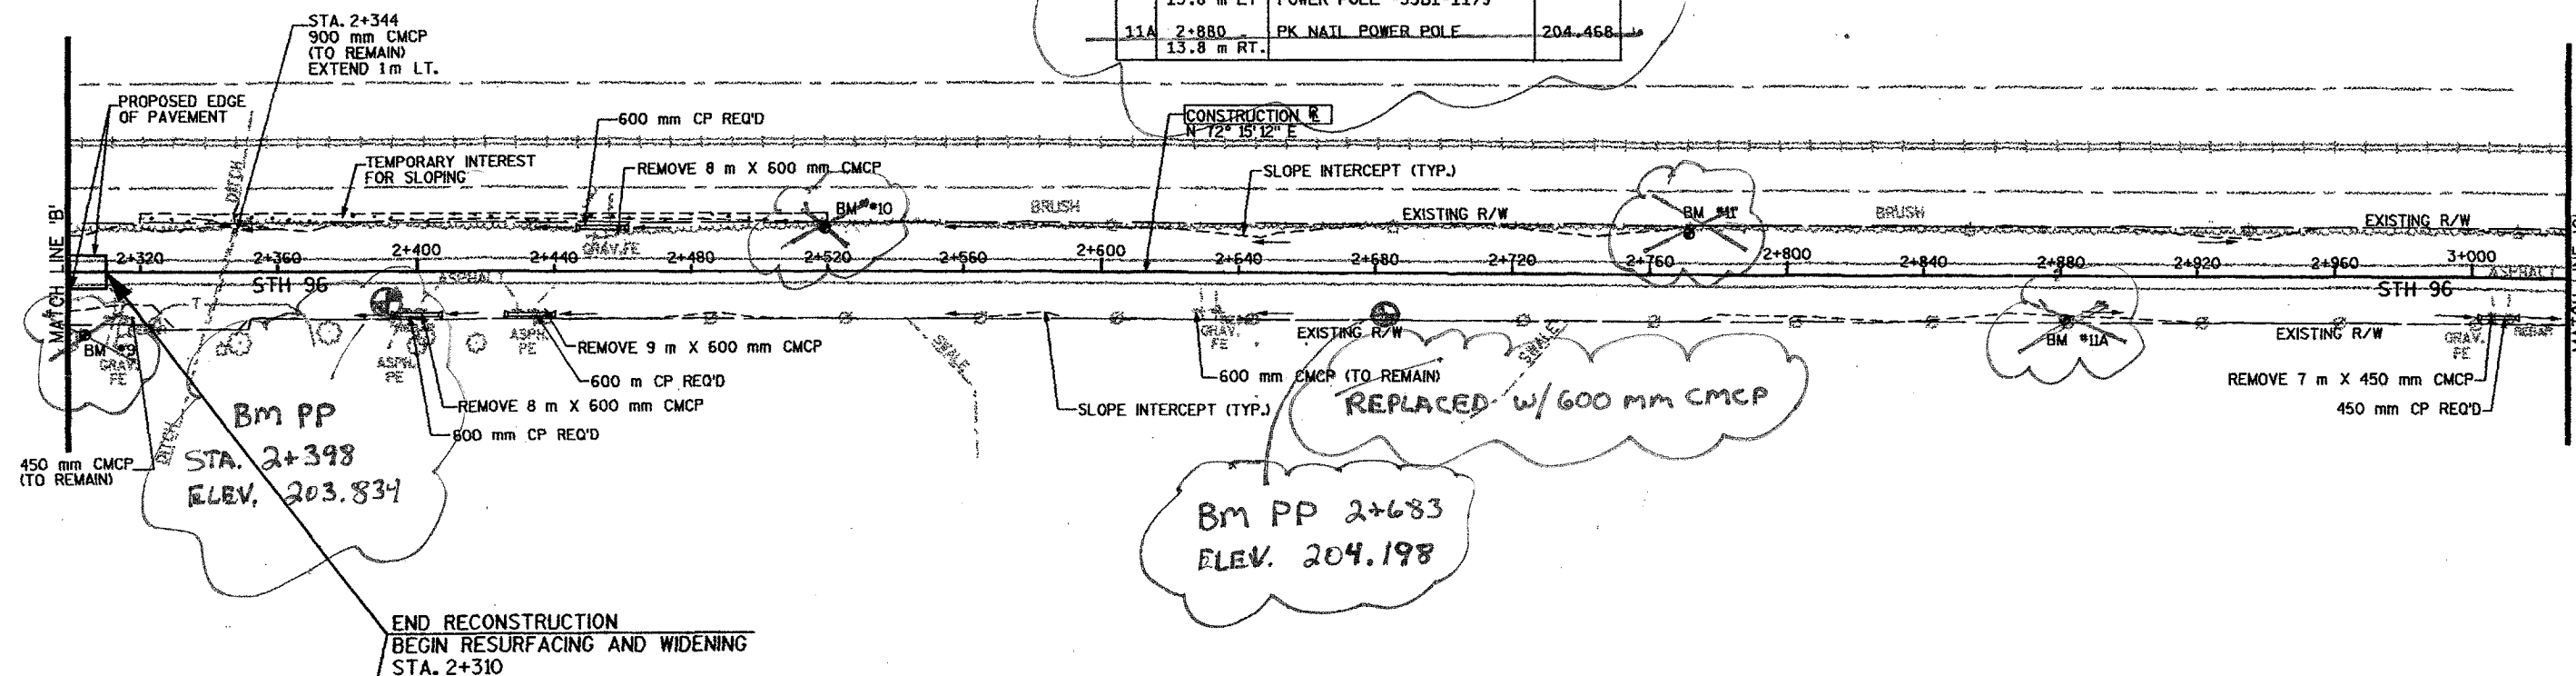

PLAN AND PROFILE

SCALE: 1:1000 HWY: STH '96'

COUNTY: OUTAGAMIE

STATE PROJECT NO: 4095-05-71

SHEET NO: 5.3


M

PLOT SCALE:

PLOT NAME:

REV. DATE:

ORIGINATOR:


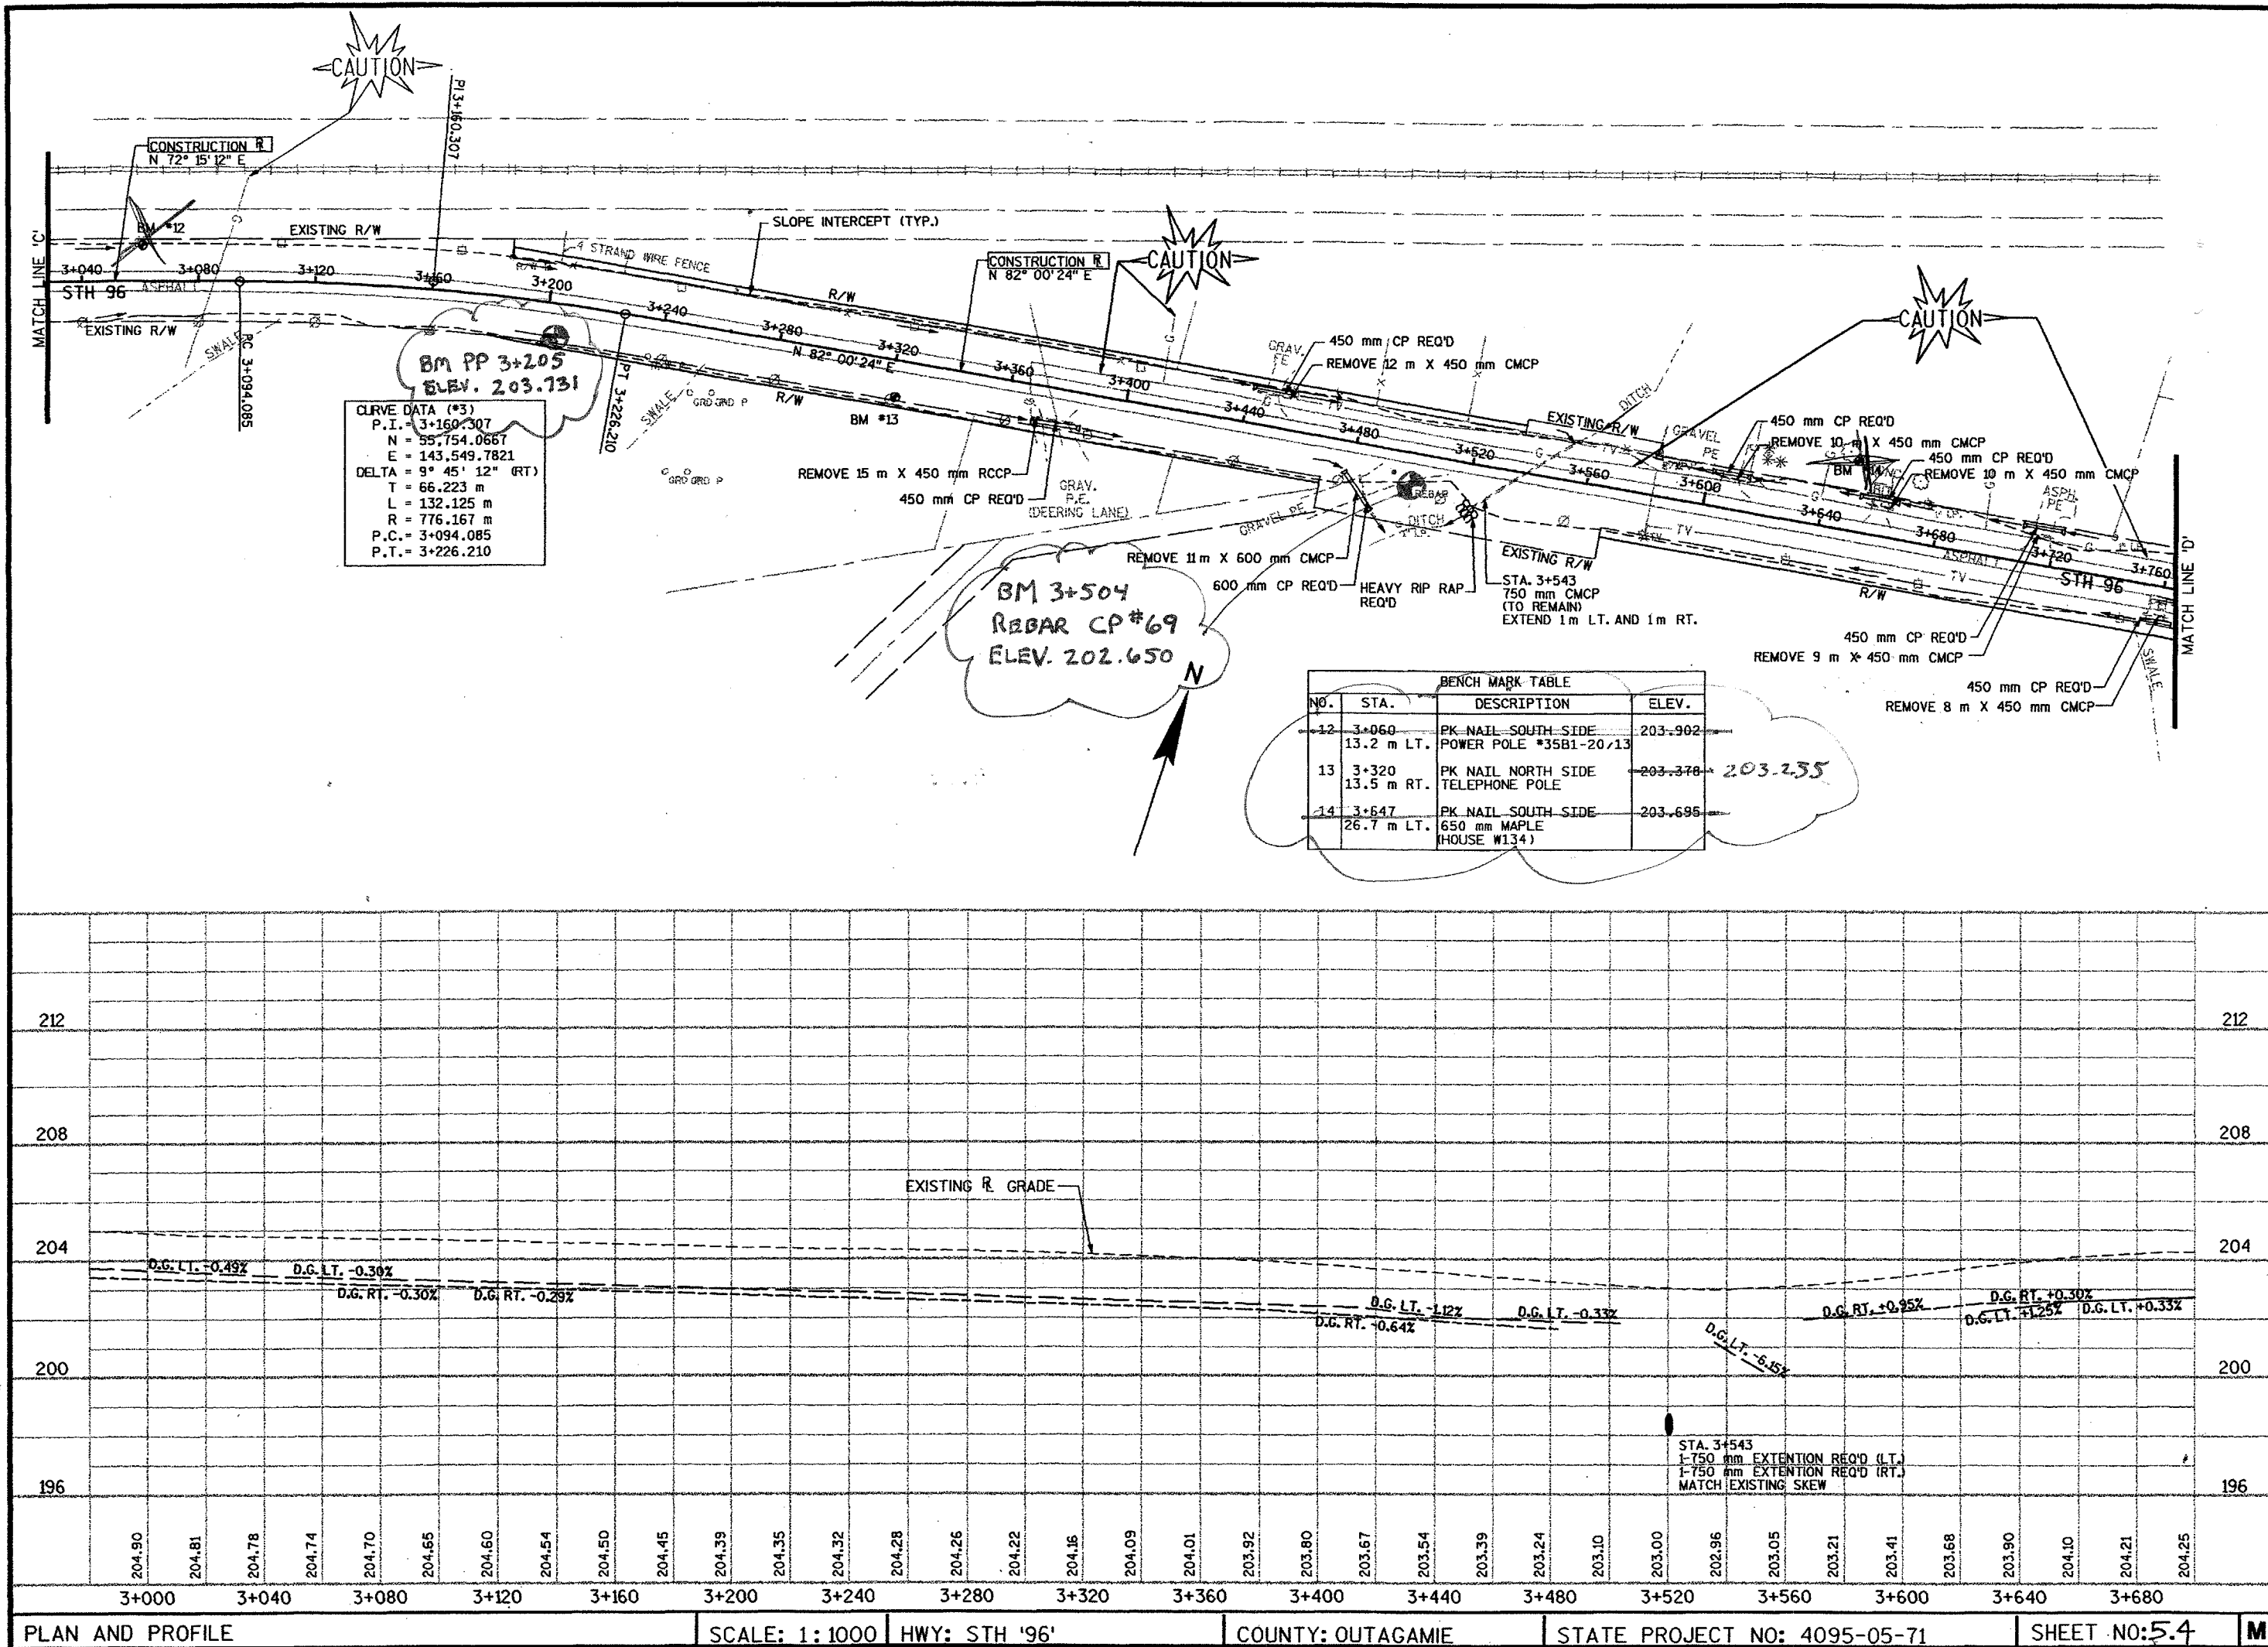


PLOT SCALE:

PLOT NAME:

REV. DATE:

ORIGINATOR:

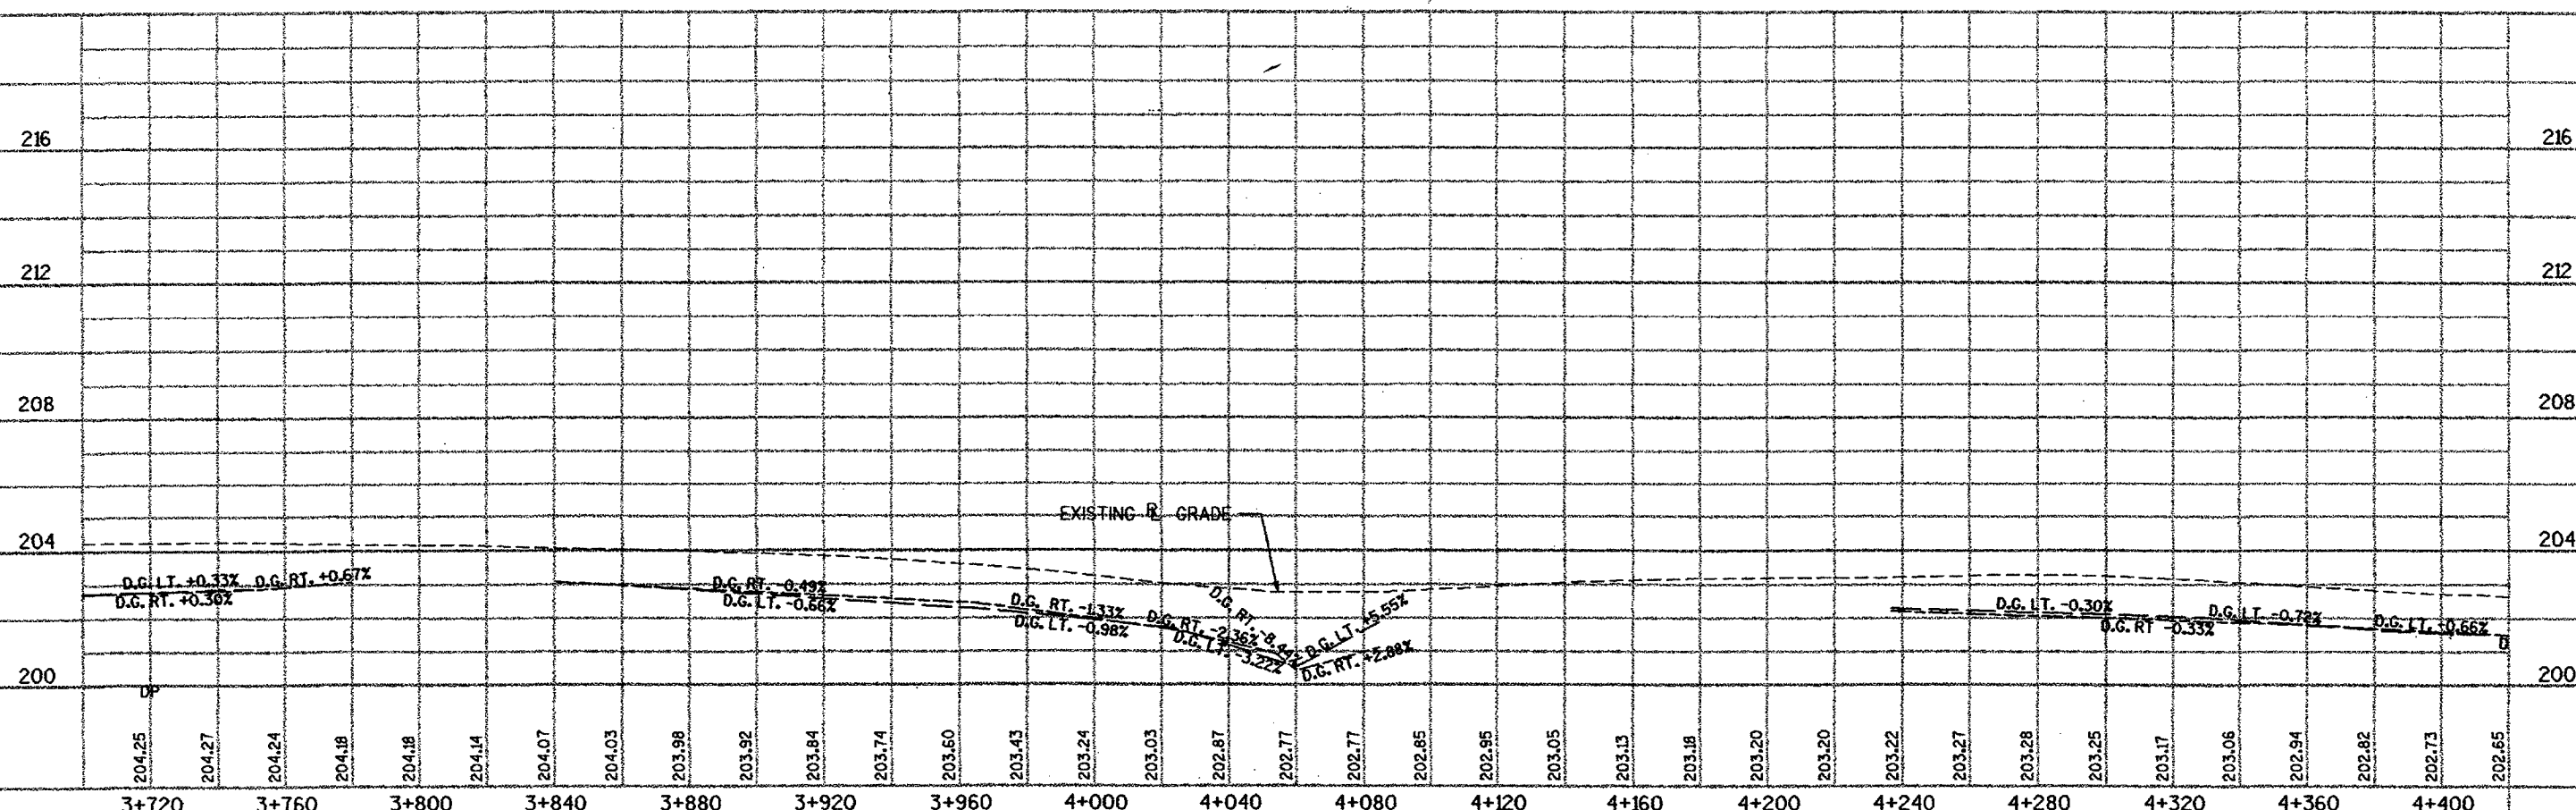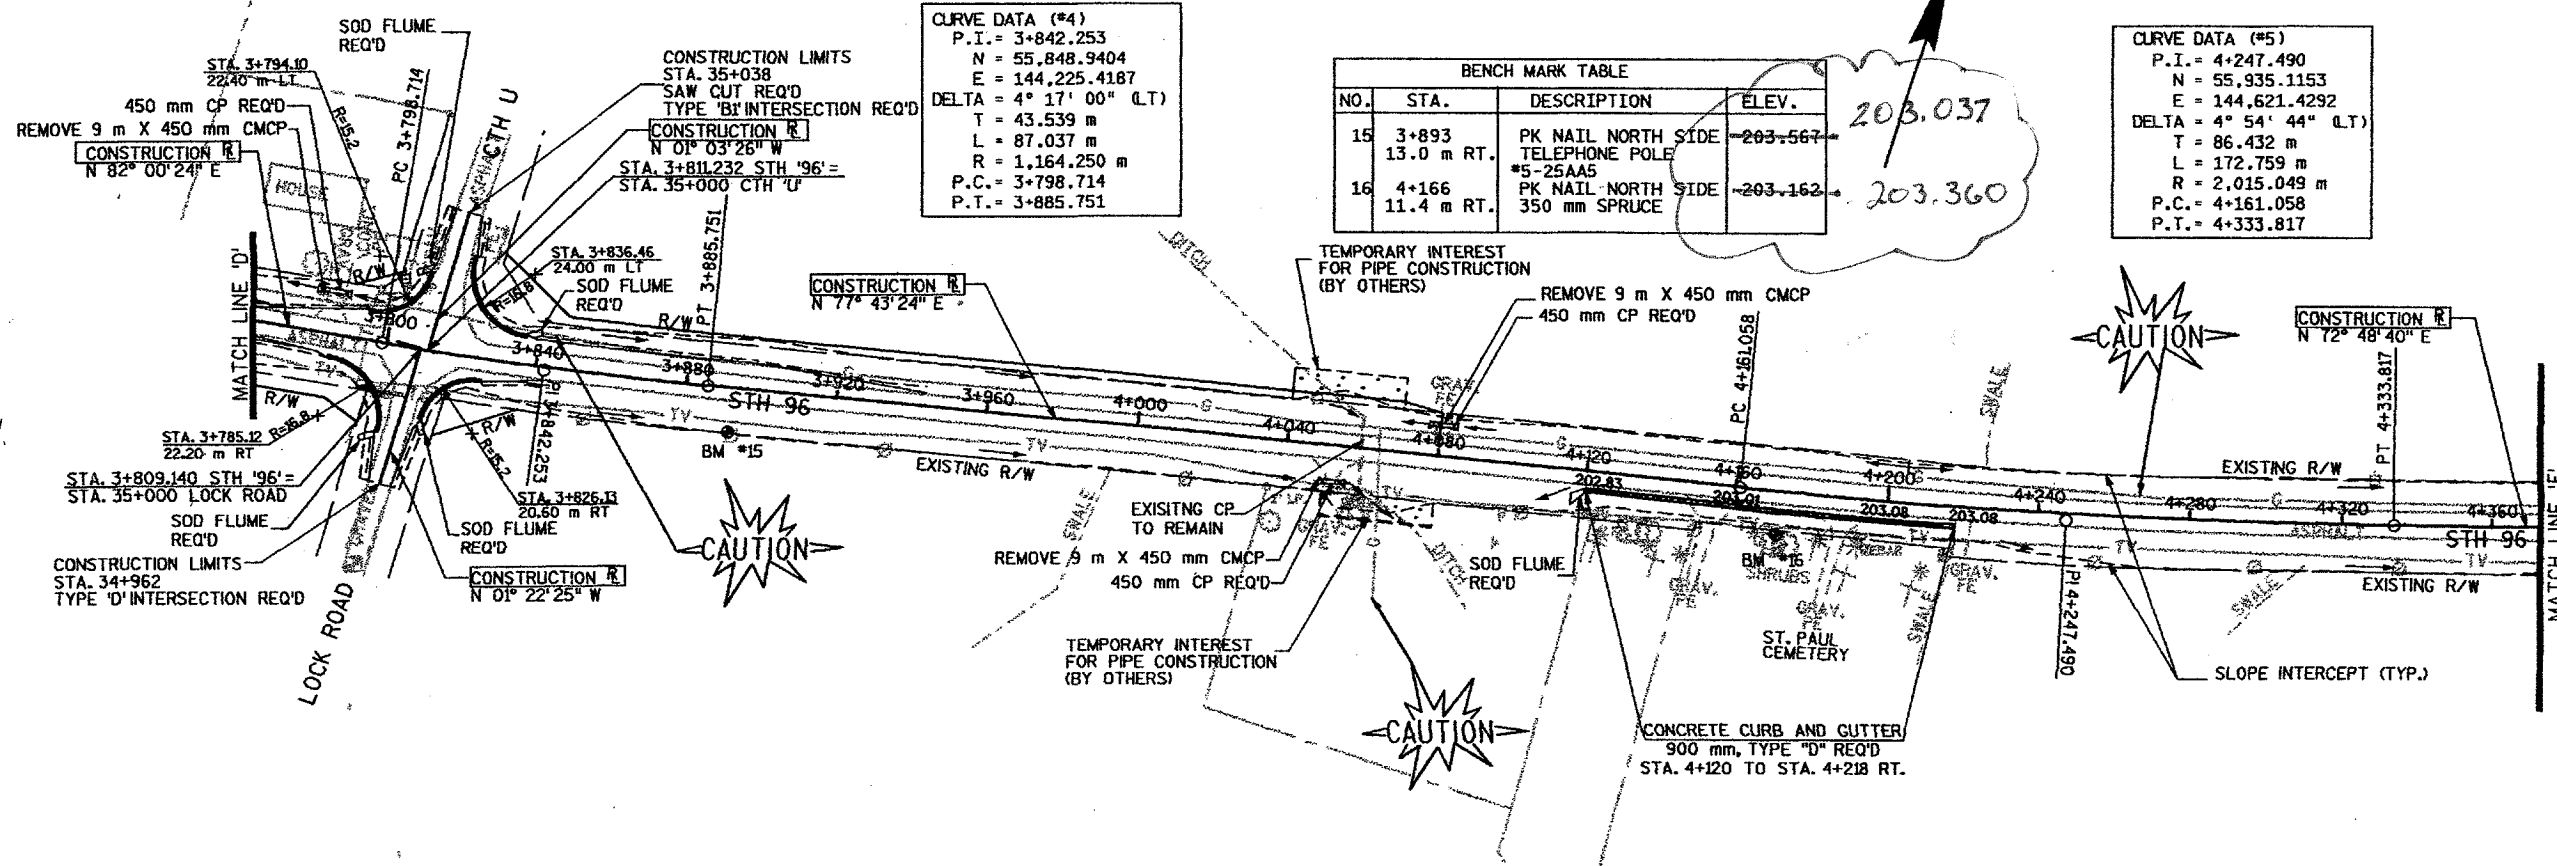

PLAN AND PROFILE SCALE: 1:1000 HWY: STH '96' COUNTY: OUTAGAMIE/BROWN STATE PROJECT NO: 4095-05-71(72) SHEET NO: 55


PLOT SCALE:

PLOT NAME:


REV. DATE:

ORIGINATOR:

BENCH MARK TABLE			
NO.	STA.	DESCRIPTION	ELEV.
17	4+414 12.1 m RT.	PK NAIL NORTH SIDE TELEPHONE POLE	202.235

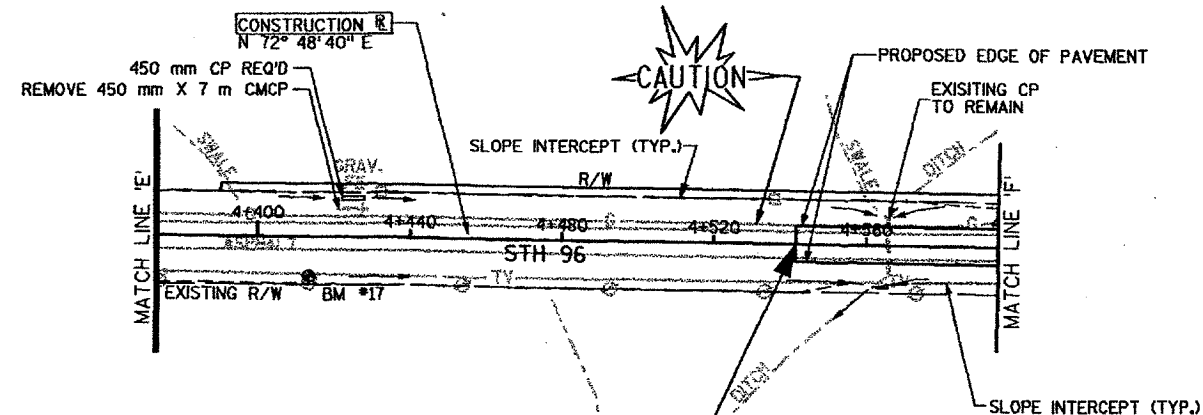

END REHABILITATION
BEGIN RECONSTRUCTION
STA. 4+541.520

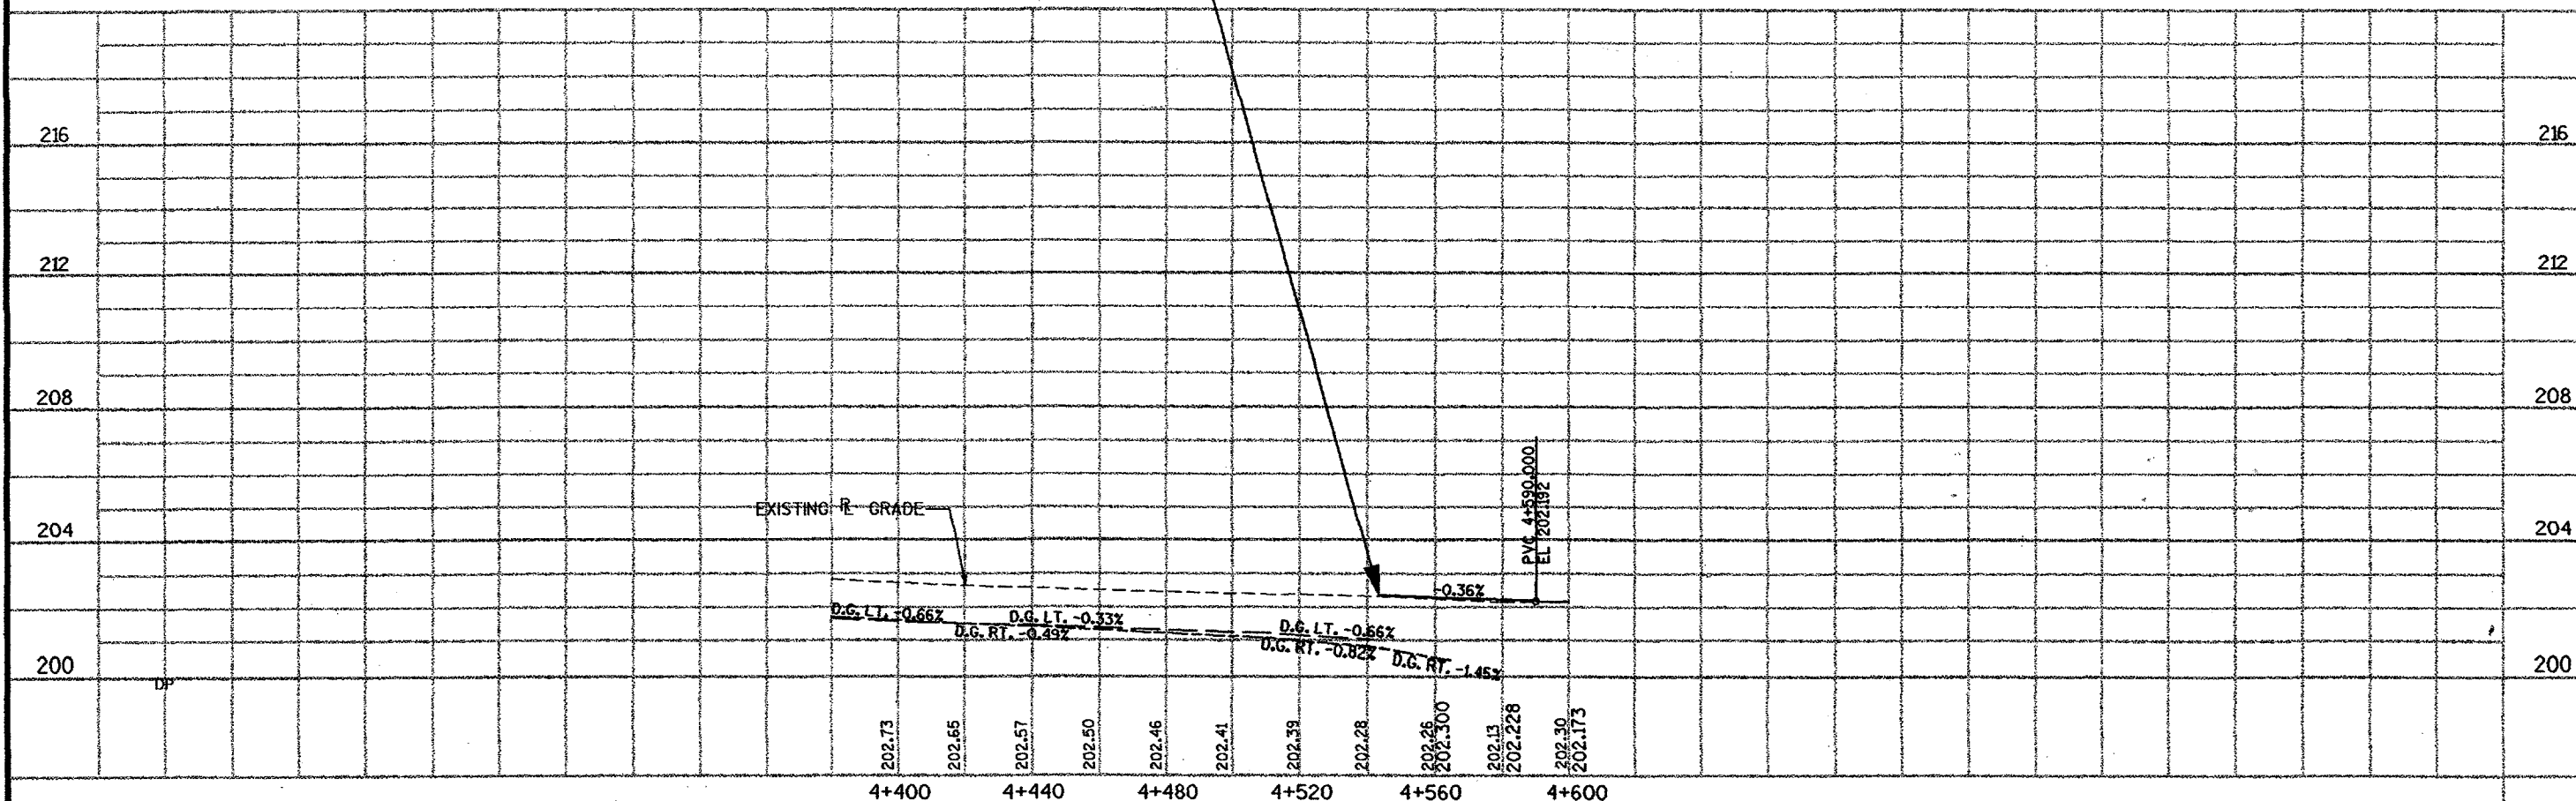

PLAN AND PROFILE

SCALE: 1:1000 HWY: STH '96'

COUNTY: BROWN

STATE PROJECT NO: 4095-05-71

SHEET NO: 5.6

M

P.I. = 4+652.061
N = 56 054.7058
E = 145 008.0308
DELTA = 7° 56' 22" (LT)
T = 51.939 m
L = 103.712 m
R = 748.447 m
P.C. = 4+600.122
P.T. = 4+703.834
SE = NC

P.I. = 10+020.530
N = 56 075.6448
E = 145 001.1541
DELTA = 9° 56' 22" (RT)
T = 10.000 m
L = 19.950 m
R = 115.000 m
P.C. = 10+010.530
P.T. = 10+030.480
SE = NC

BENCH MARK TABLE			
NO.	STA.	DESCRIPTION	ELEV.
19	4+794 9.1 m RT	EAST "BURY BOLT" HYDRANT HOUSE #1136	202.186
20	4+932 8.2 m RT	EAST "BURY BOLT" HYDRANT	202.046



BENCH MARK TABLE			
NO.	STA.	DESCRIPTION	ELEV.
19	4+794R	NW CAP BOLT HYDRANT	202.478
20	4+932R	NW CAP BOLT HYDRANT	202.226
19A	VANDYKE + "96"	NW POWER POLE	202.114

PLOT SCALE:

PLOT NAME:



REV. DATE:

ORIGINATOR:

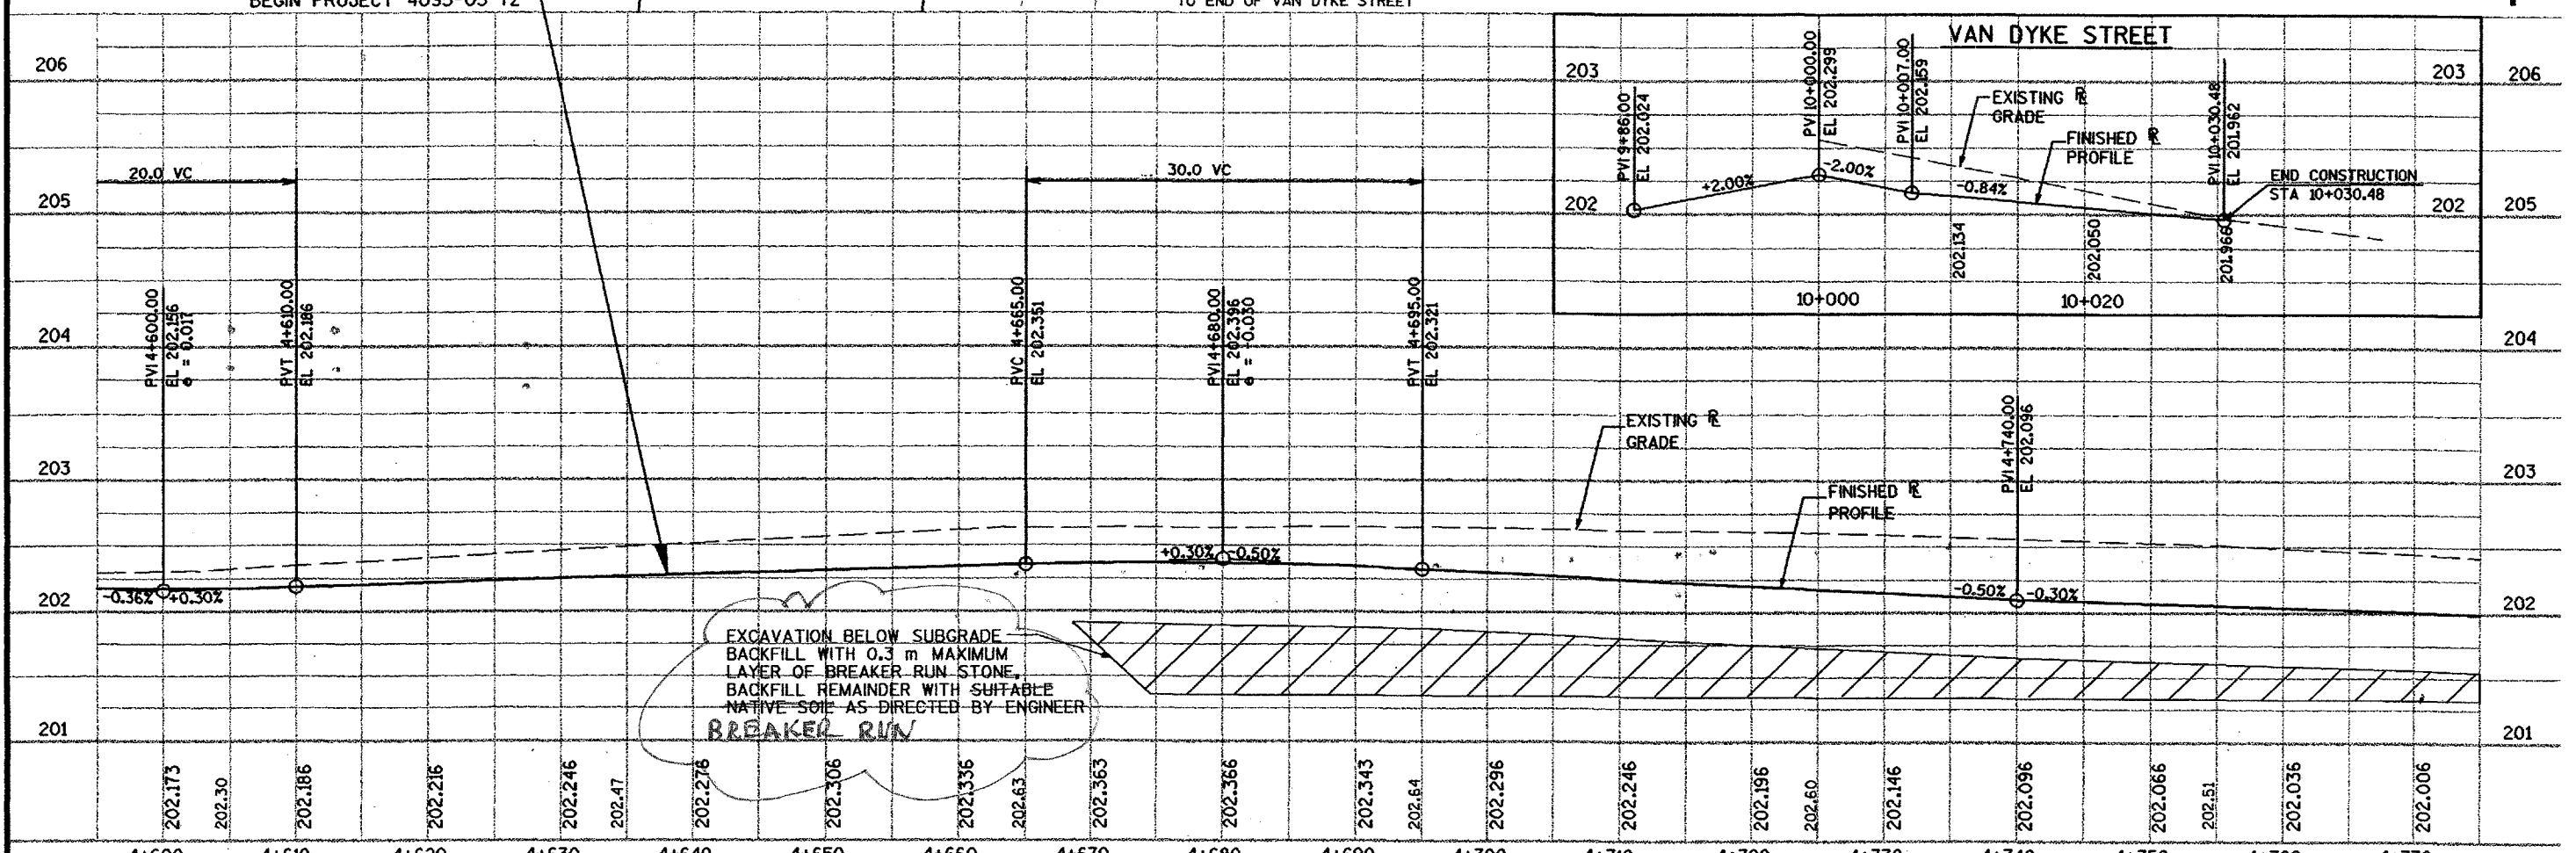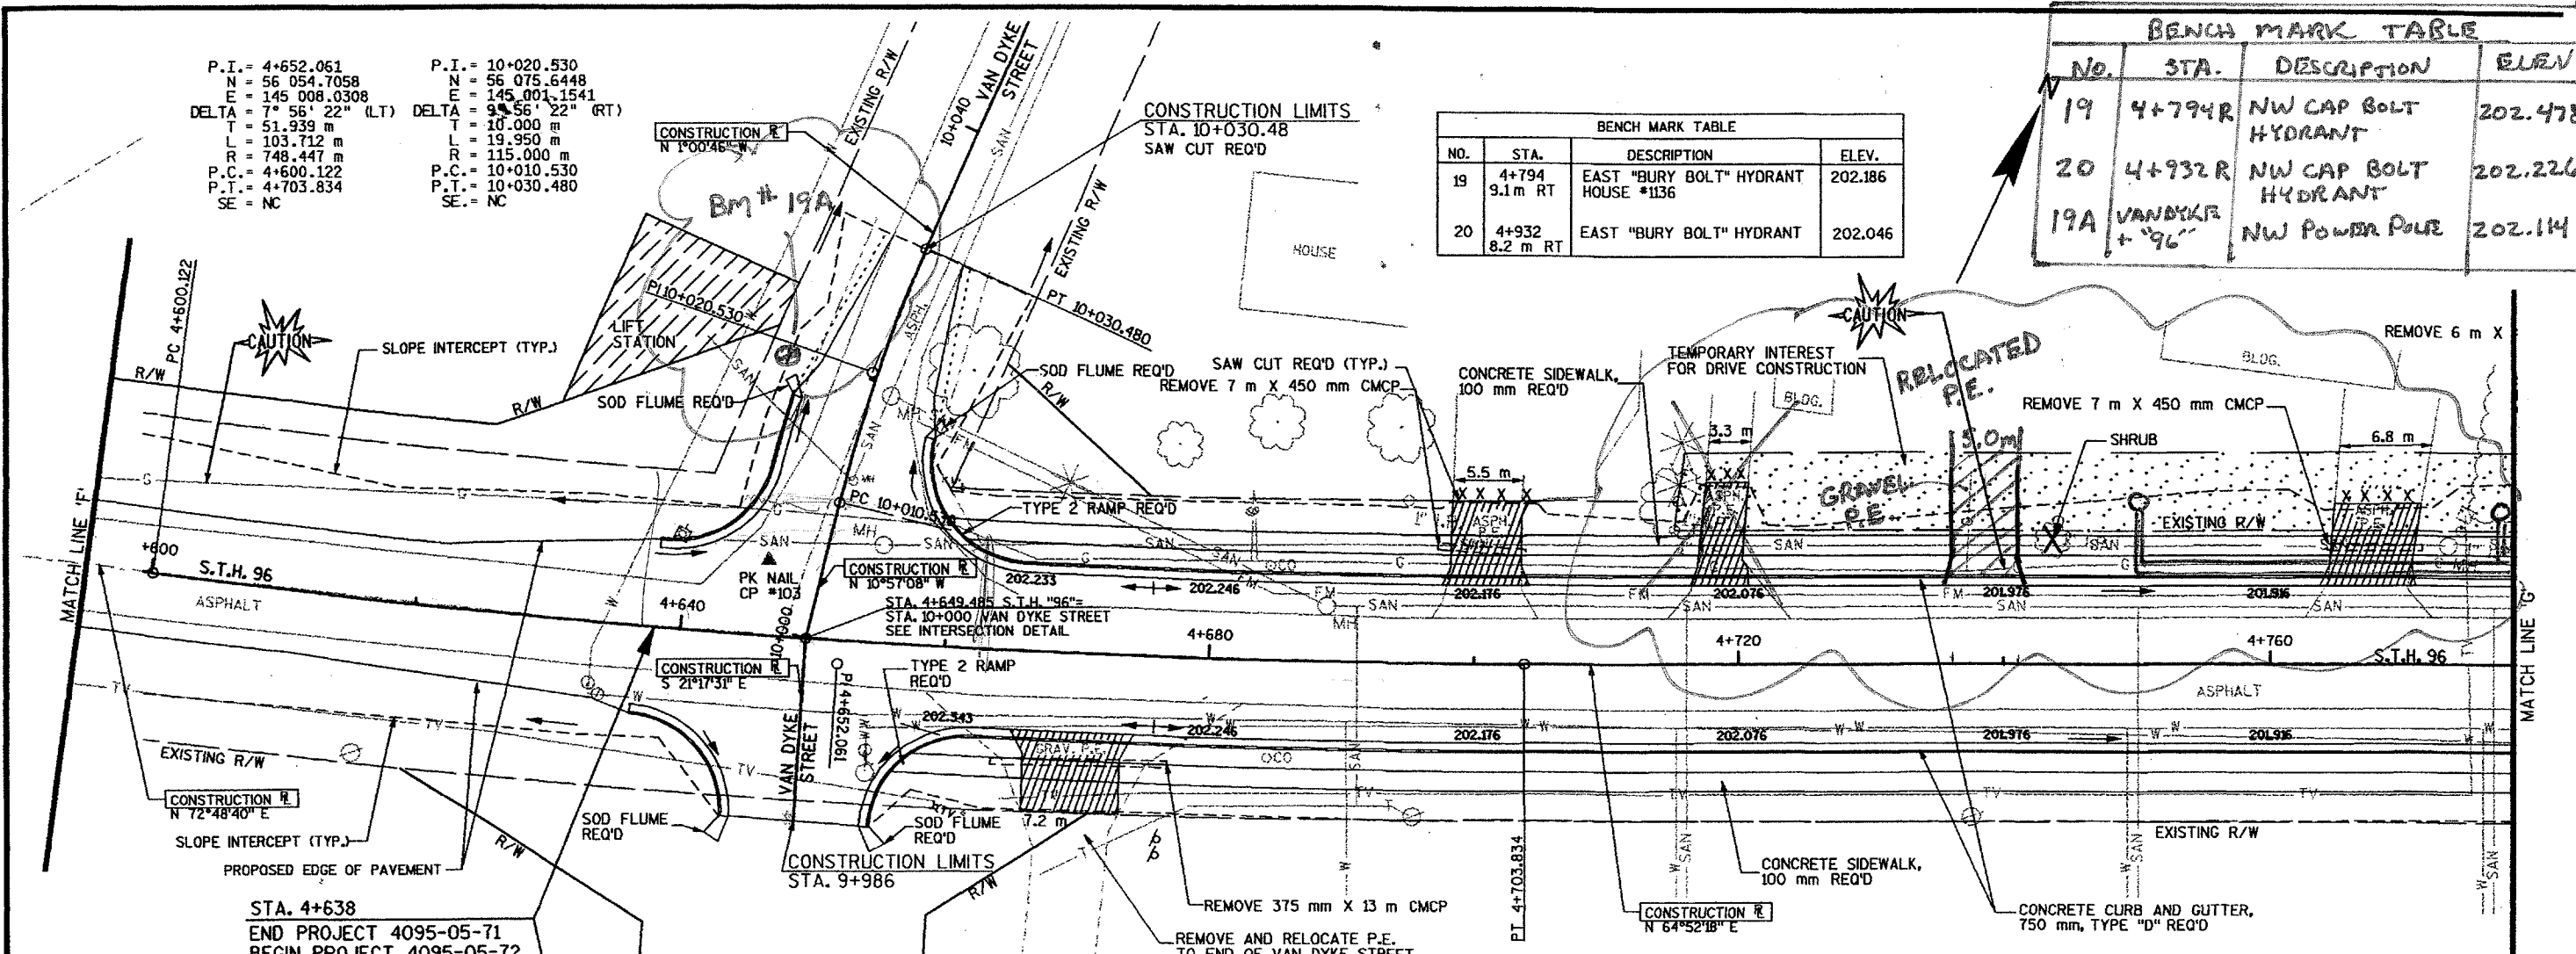

BENCH MARK TABLE			
NO.	STA.	DESCRIPTION	ELEV.
19	4+794R	NW CAP BOLT - HYDRANT	202.478
20	4+932R	NW CAP BOLT - HYDRANT	202.226
19A	VANDYKE	BM POWERPOLE NW 96 INT.	202.184

BENCH MARK TABLE			
NO.	STA.	DESCRIPTION	ELEV.
19	4+794 9.1m RT	EAST "BURY BOLT" HYDRANT HOUSE #1136	202.186
20	4+932 8.2m RT	EAST "BURY BOLT" HYDRANT	202.046

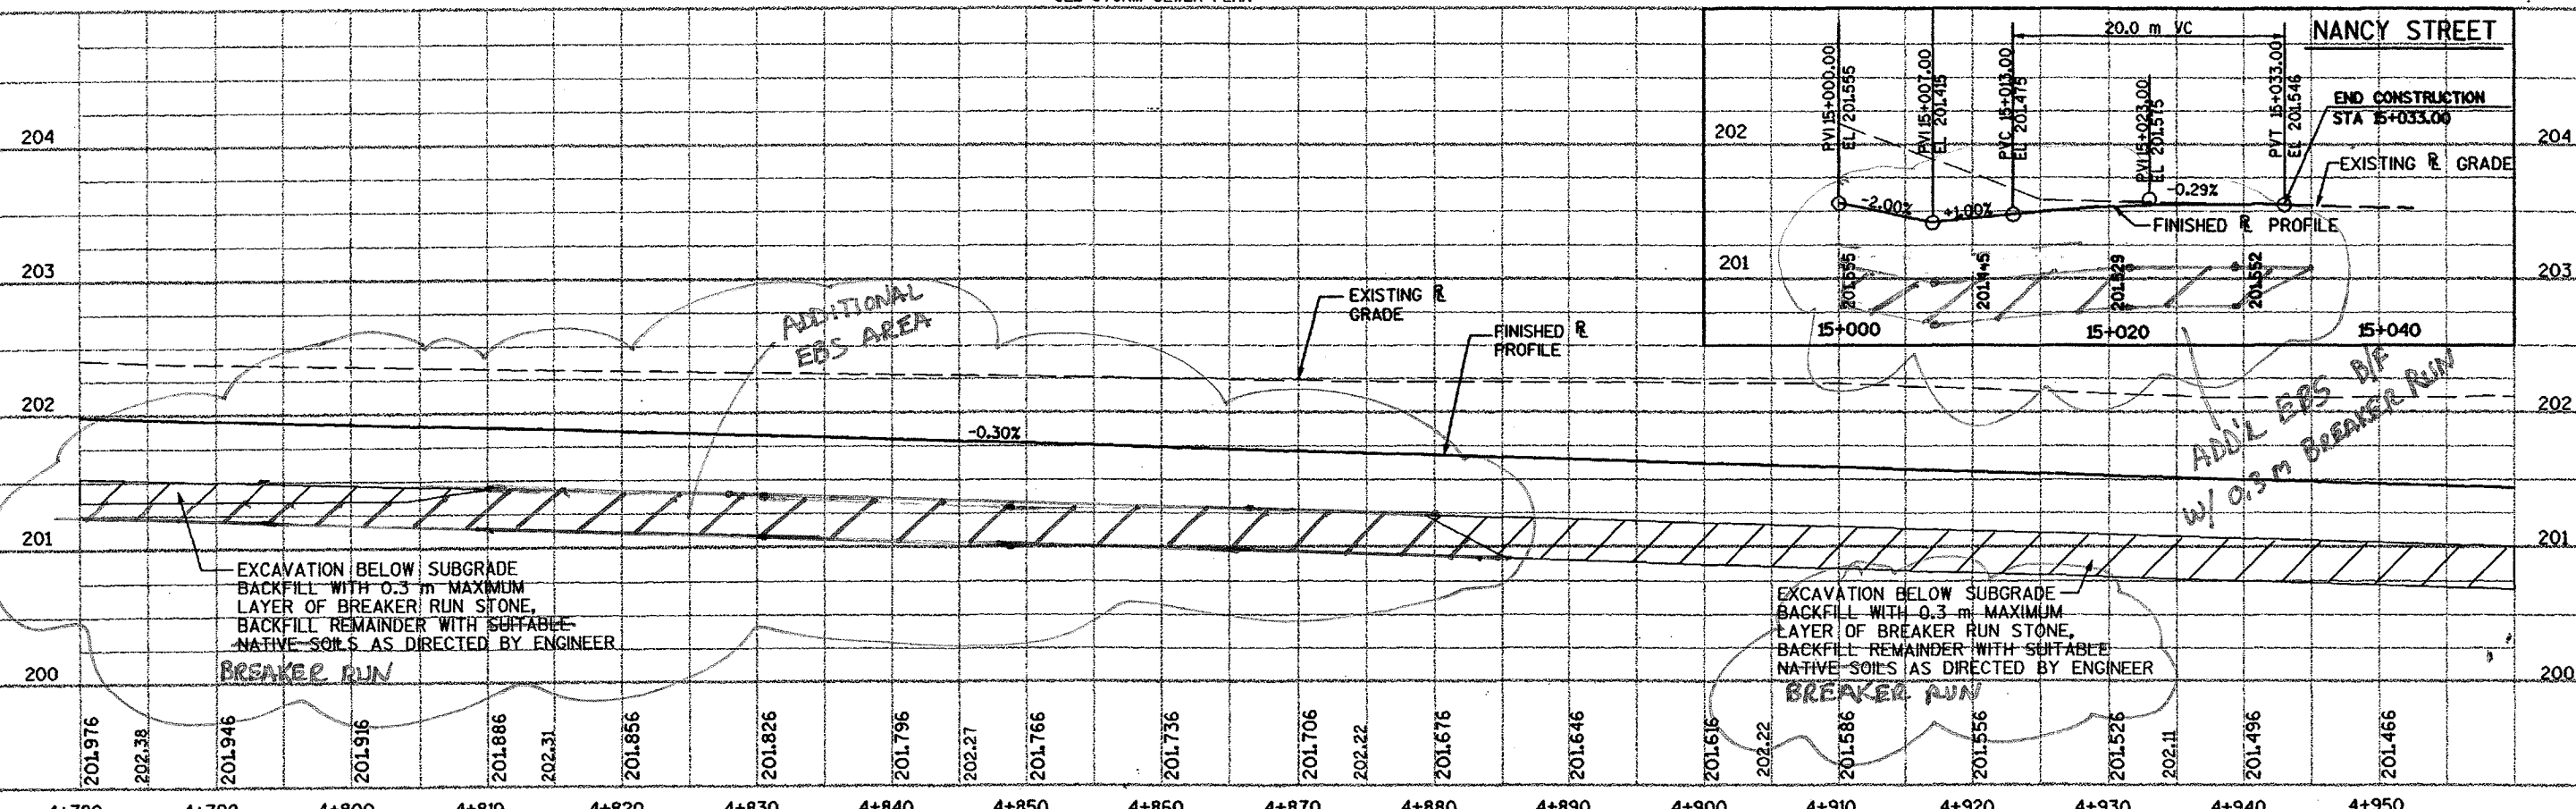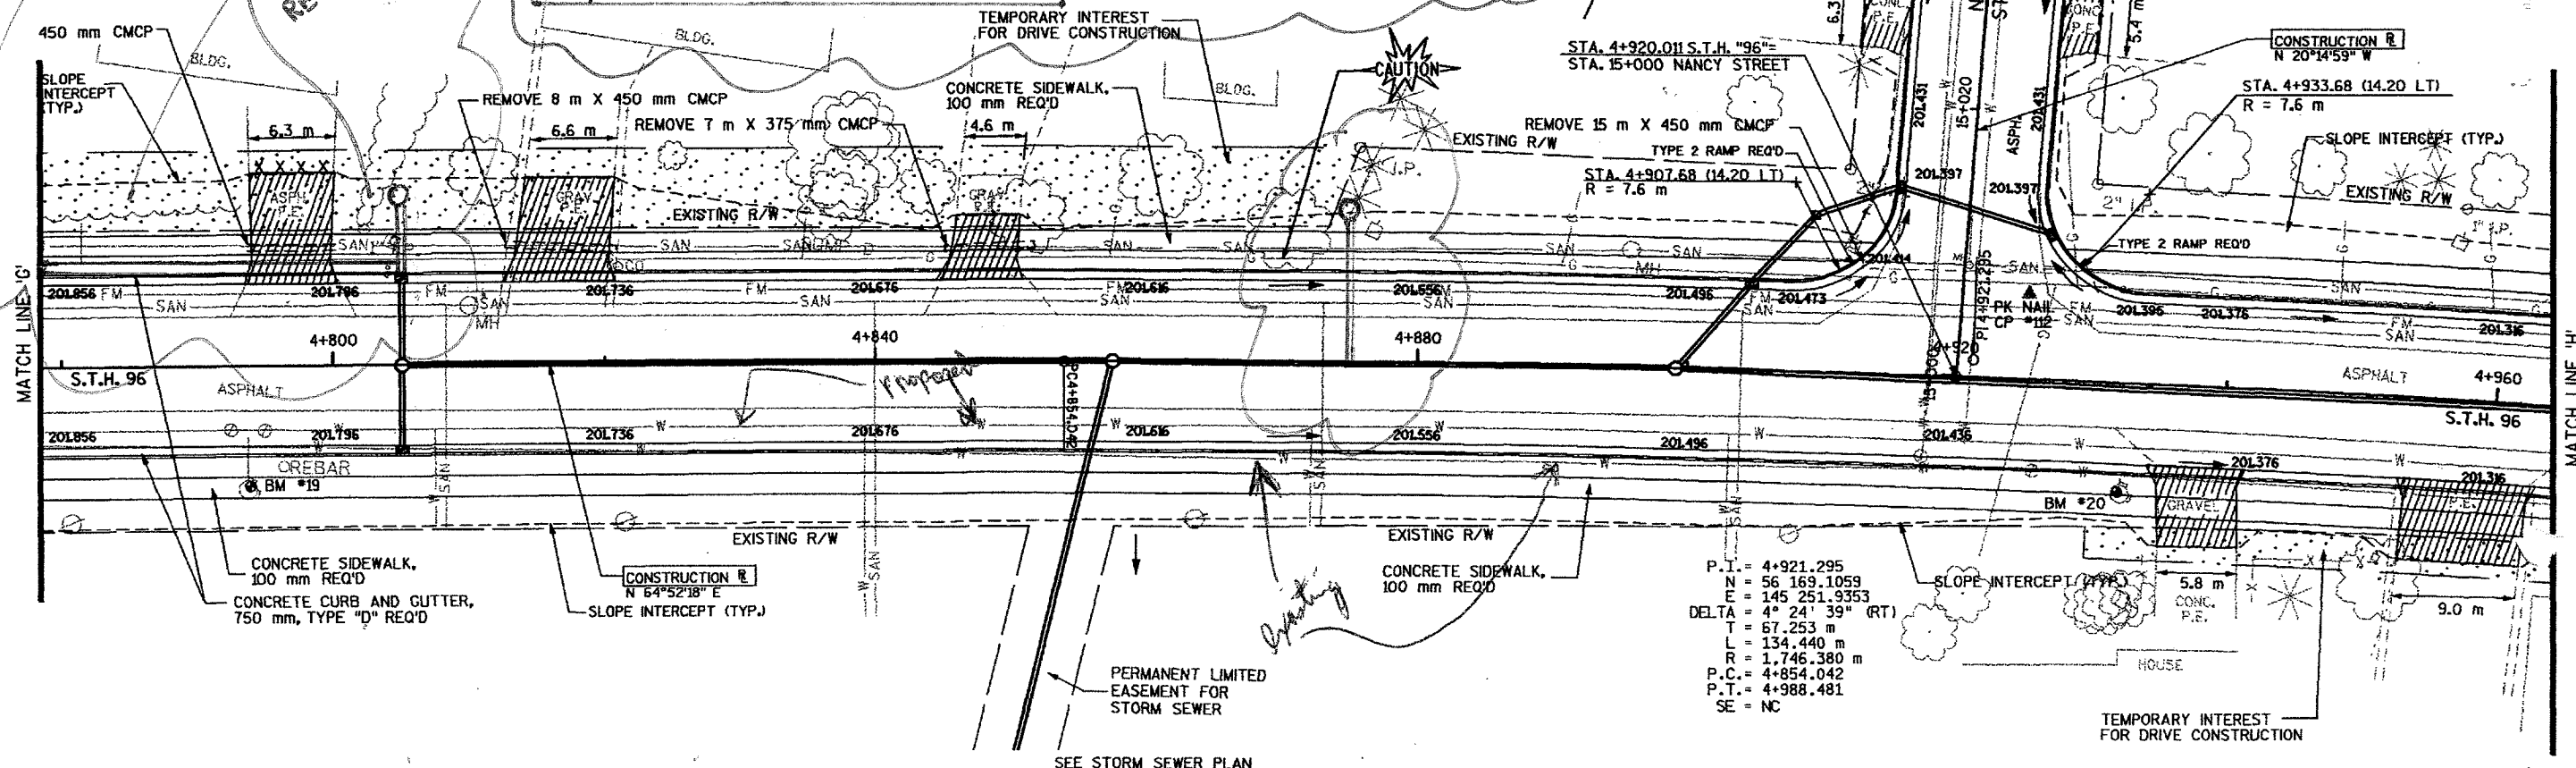


PLOT SCALE:

PLOT NAME:

REV. DATE:

ORIGINATOR:

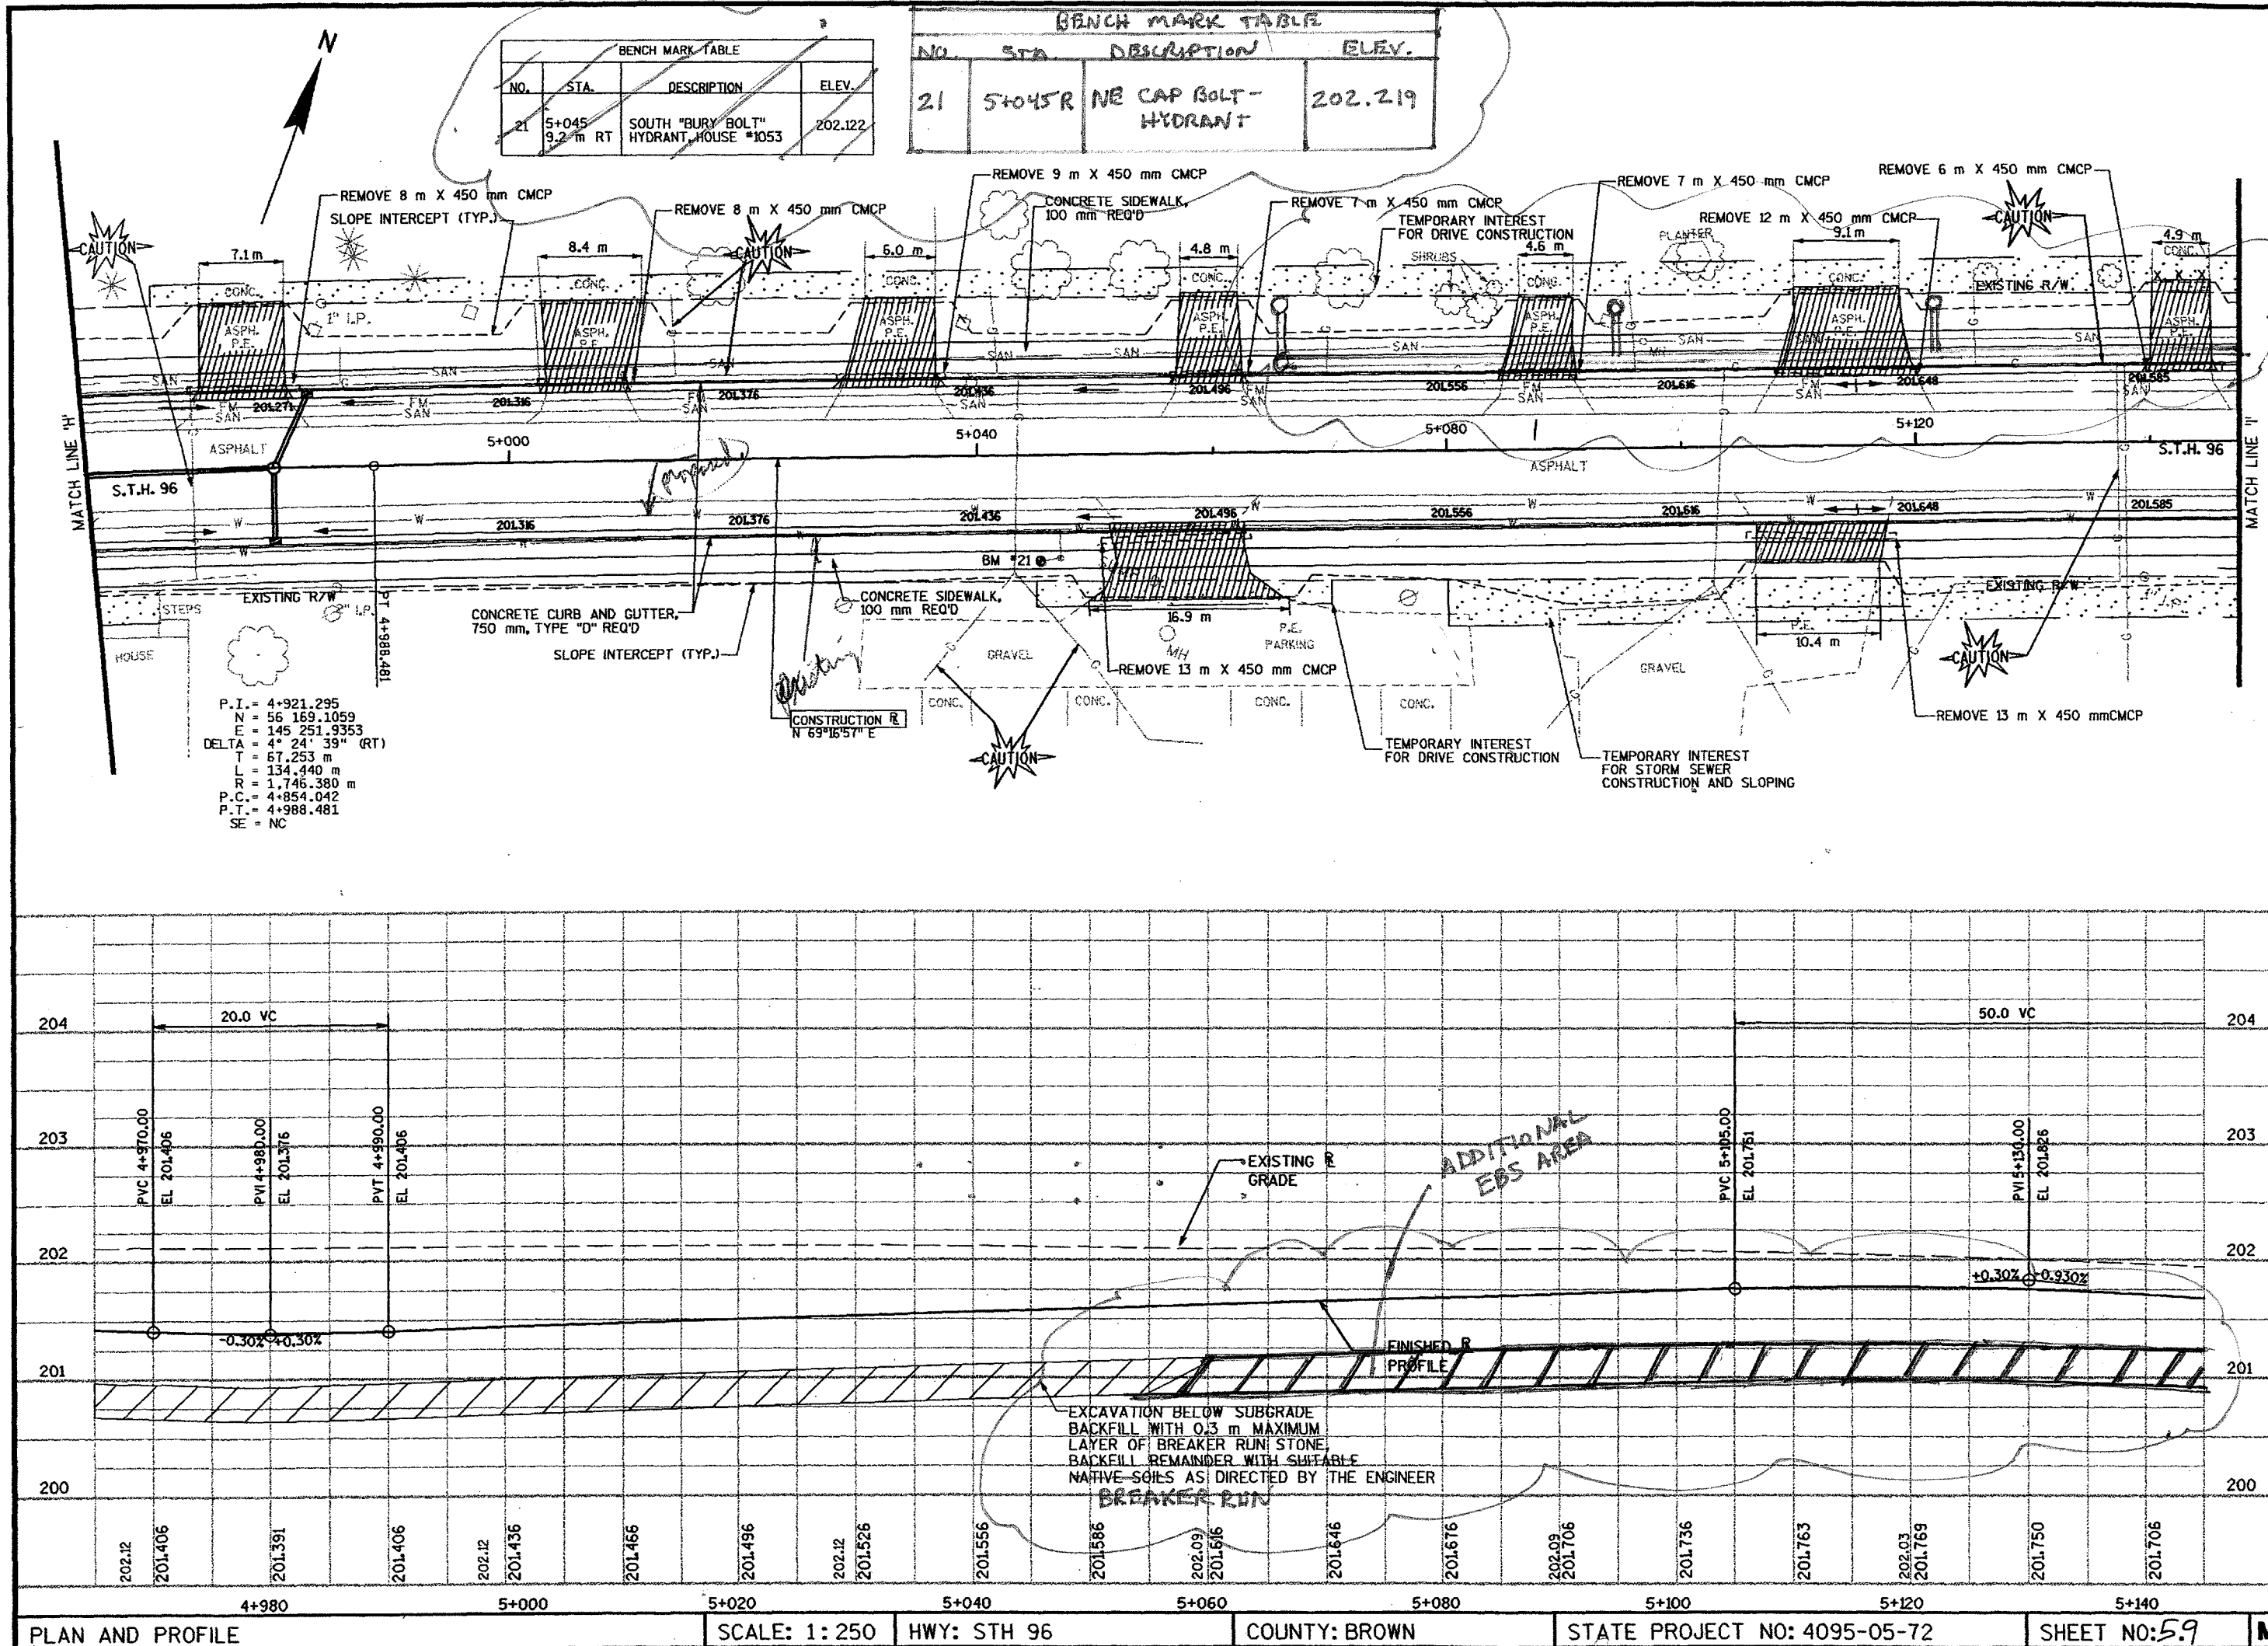

PLOT SCALE:

PLOT NAME:

REV. DATE:

ORIGINATOR:

19+978 - 20+020

BENCH MARK TABLE

NO.	STA.	DESCRIPTION	ELEV.
22	5+170 R	NE CAP BOLT - HYDRANT	202.006

BENCH MARK TABLE

NO.	STA.	DESCRIPTION	ELEV.
22	5+170 9.8 m RT	SOUTH "BURY BOLT" HYDRANT SE QUAD LINDA ST. & '96"	201.693
23	5+275 9.7 m RT	TOP OF HYDRANT ACROSS FROM SE CORNER OF AMERICAN LEGION	201.363

N

STA 5+279

BEGIN TAPER TO EXISTING

CONC. P.C.

SS

ASPH

EXISTING R/W

CONC. P.C.

SS

ASPH

EXISTING R/W

CONC. P.C.

SS

ASPH

TEMPORARY INTEREST FOR DRIVE CONSTRUCTION

STA. 5+185.197 S.T.H. "96"
STA. 20+000 LINDA STREET
5+172.22 (14.20 LT)
R = 7.6 m

S.T.H. 96

ASPH

EXISTING R/W

CONC. P.C.

SS

ASPH

EXISTING R/W

CONC. P.C.

SS

ASPH