

STATE OF WISCONSIN
DEPARTMENT OF TRANSPORTATION

PLAN OF PROPOSED IMPROVEMENT

U.S.H. 41 - WRIGHTSTOWN MAIN ST., VILLAGE OF WRIGHTSTOWN
U.S.H. 41 - VAN DYKE ST. VAN DYKE ST. - LINDA ST.
S.T.H. 96 S.T.H. 96
OUTAGAMIE/BROWN COUNTIES BROWN COUNTY

STATE PROJECT NUMBER
4095-05-71

STATE PROJECT NUMBER
4095-05-72

PLAN REVISION
February 4, 2000
Sheet 3.C Revised

INDEX OF SHEETS

Sheet No.	Title
Sheet No. 1	Typical Sections and Details
Sheet No. 2.1-2.11	Estimate of Quantities
Sheet No. 3.1-3.4	Miscellaneous Quantities
Sheet No. 3A-3E	Right of Way Plat
Sheet No. 4.1-4.9	Plan and Profile
Sheet No. 5.1-5.10	Standard Detail Drawings
Sheet No. 6.1-6.21	Sign Plates
Sheet No. 7.1-7.2	Structure Plans
Sheet No. 8.1-8.2	Computer Earthwork Data
Sheet No. 9.1-9.34	Cross Sections

TOTAL SHEETS = 95




DESIGN DESIGNATION

	U.S.H. 41 - VAN DYKE ST.	VAN DYKE ST. - LINDA ST.
A.D.T. (2000)	2890	3660
A.D.T. (2020)	3395	4370
D.	60/40	60/40
T.	8.7%	8.7%
DESIGN SPEED	100 km/hr	60 km/hr
ESALS	635,100	817,600

CONVENTIONAL SIGNS

COUNTY LINE	
CORPORATE LIMITS	
PROPERTY LINE	
LOT LINE	
TEMPORARY INTEREST	
EXISTING RIGHT OF WAY	
PROPOSED OR NEW R/W LINE	
SURVEY LINE	
SLOPE INTERCEPT	
ORIGINAL GROUND	
MARSH OR ROCK PROFILE	
EXISTING CULVERT	
PROPOSED CULVERT (Box or Pipe)	
CULVERT (Profile View)	
TURBIDITY BARRIER	
SILT FENCE	
TELEPHONE JUNCTION BOX	
EXISTING BEAM GUARD	
PROPOSED BEAM GUARD	
RIVER	
BENCH MARK	
EROSION MAT	

COMBUSTIBLE FLUIDS	
UNDERGROUND UTILITIES	
GAS	
ELECTRIC	
TELEPHONE OR TELEGRAPH	
CABLE TELEVISION	
SERVICE PEDESTAL	
CABLE MARKER	
POWER POLE	
TELEPHONE POLE	
RAILROAD	
MARSH AREA	
WOODED OR SHRUB AREA	
CONIFEROUS TREE	
DECIDUOUS TREE	
MAILBOX	
STORM SEWER	
SANITARY SEWER	
WATER	
FORCE MAIN	
CONTROL POINT	
RAILROAD SIGNAL	
GRAVESTONE	

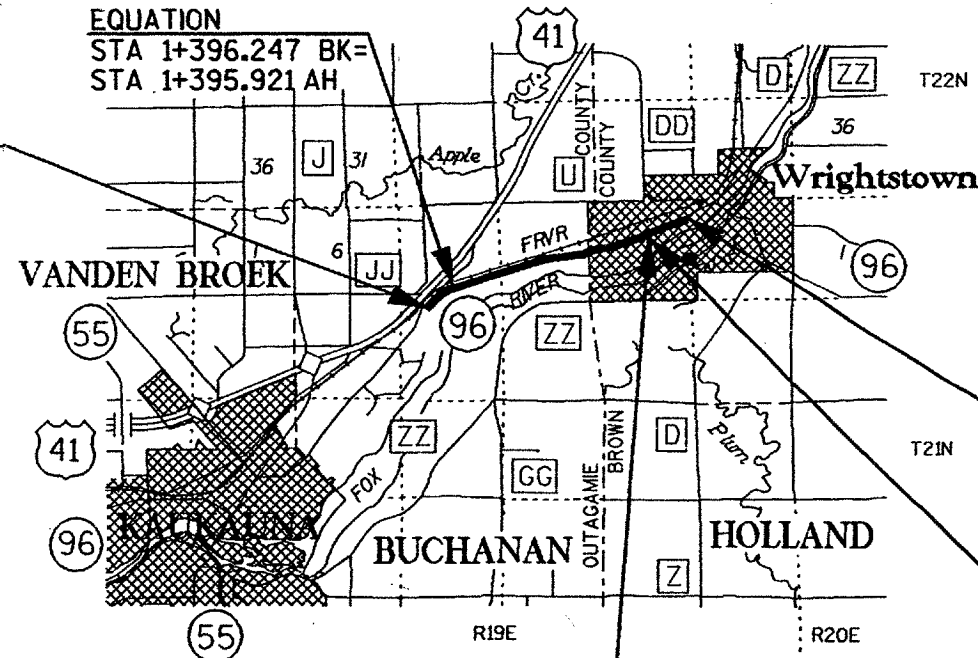


END PROJECT 4095-05-71
STA 4+638

END PROJECT 4095-05-72
STA 5+288

BEGIN PROJECT 4095-05-72
STA 4+638

AS BUILT PLAN
NO.
SUPERVISOR Jim Lamers
RESIDENT Kevin Derenne
CONTRACTOR Degroot Inc.
COMPLETED 10/09/00

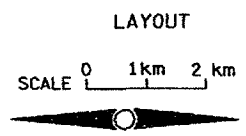


TOTAL NET LENGTH OF CENTERLINE = 3.736 km (RURAL) I.D. 4095-05-71
0.650 km (URBAN) I.D. 4095-05-72
4.386 km

COORDINATES ON THIS PLAN ARE GROUND COORDINATES
AND ARE ORIENTED TO THE WISCONSIN COORDINATE SYSTEM
CENTRAL ZONE (NAD 27).

ALL ELEVATIONS ARE REFERENCED TO THE USGS DATUM.

ORIGINAL PLANS PREPARED BY

ENGINEERS & SCIENTISTS
GRAEF ANHALT SCHLOEMER
and Associates Inc.
150 SPRINGHURST DRIVE, SUITE 201
GREEN BAY, WISCONSIN 54304
(920) 592-9440

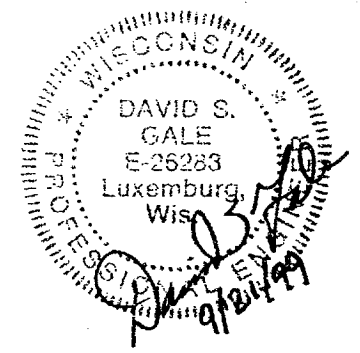

STATE OF WISCONSIN
DEPARTMENT OF TRANSPORTATION

PREPARED BY
Surveyor D.E. SCHULTZ, M.S. BIX
Designer D.S. GALT
District Examiner M.H. PRIJE
District Supervisor M.J. BERG
Proj. Dev. Engineer
C.O. Examiner N.R. AFFELDT

APPROVED FOR DISTRICT OFFICE
DATE: 9/28/99 Michael J. Berg
(Signature)

AUTHORIZED FOR BUREAU OF HIGHWAY DEVELOPMENT
DATE: 11/11/99 Nathan R. Galt
(Signature)

Jan. 2000 letting
4095-05-71, 72

OUTAGAMIE & BROWN COUNTIES