

SUB TOTAL - MILE
SHEET TOTAL


8392

[illegible]

FINAL
SURVEY
NOTED
10/1/50

M.W.F. 1-30
W.T.M. 9-37
G.L.J.
C.B.S.D.
B.S.D.

ORIGINAL
SURVEY
NOTE BOOK
8392

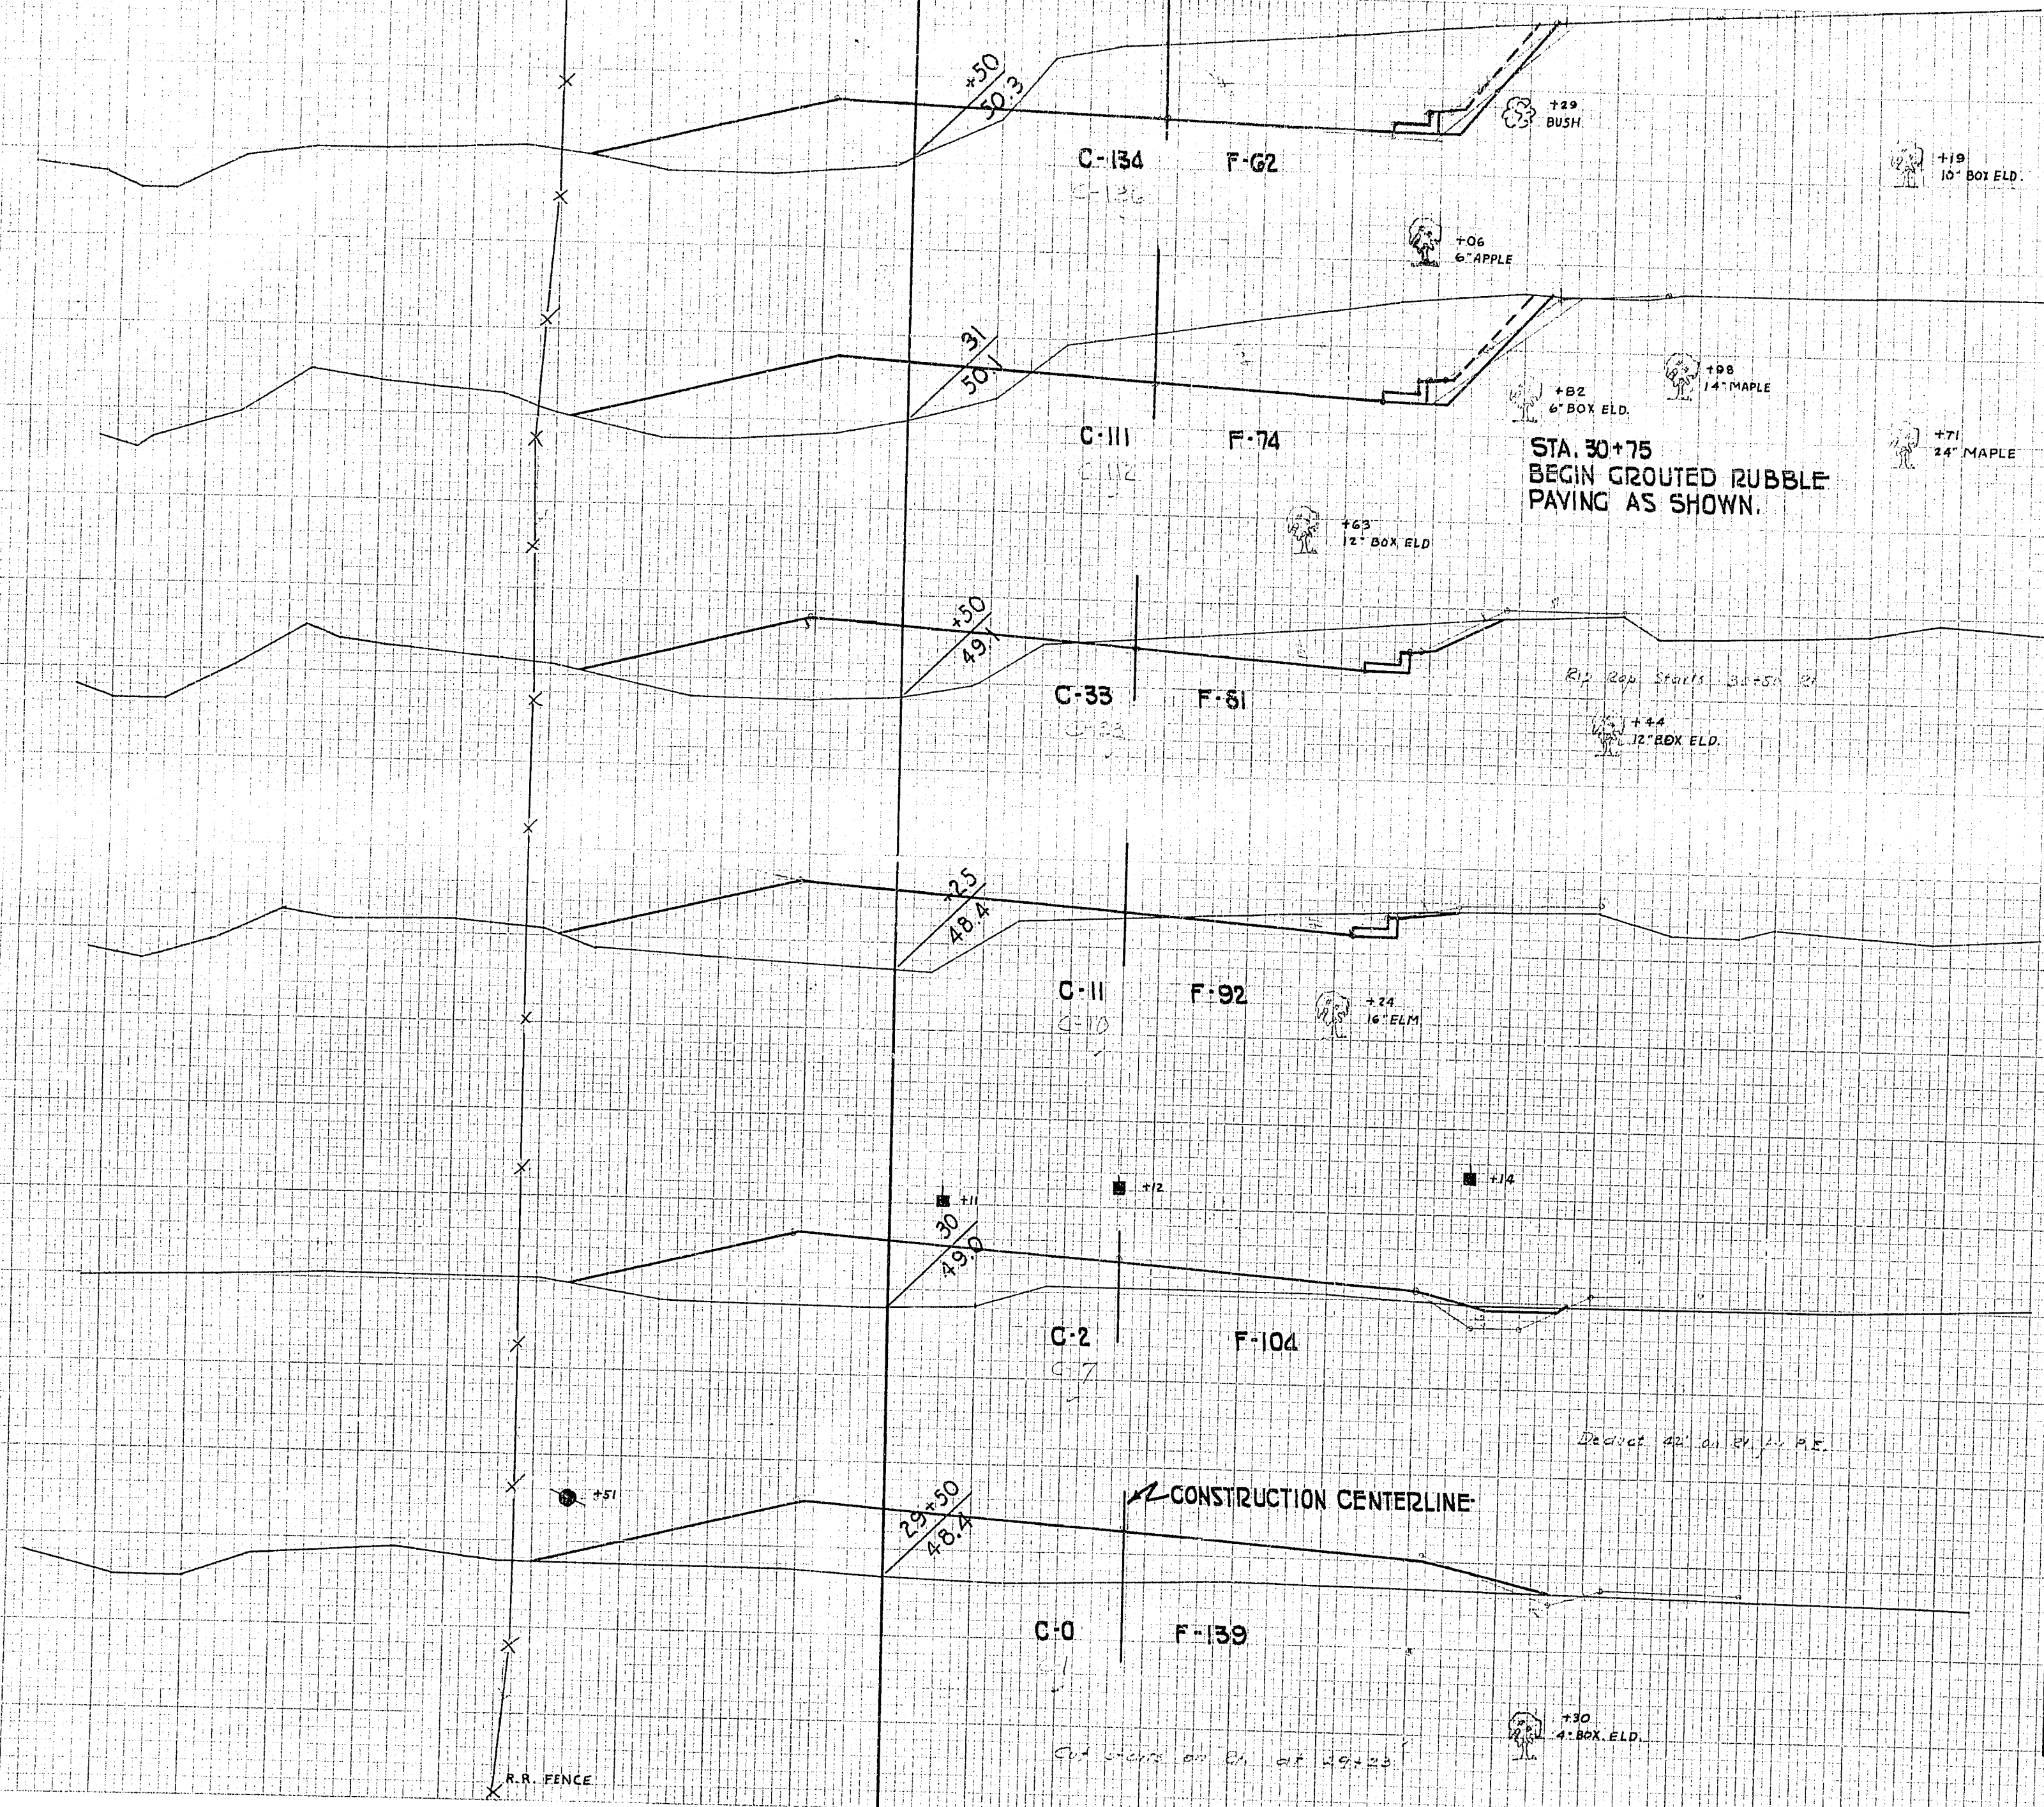

+38
14' BOX ELD.

FED. ROAD DIST. NO.	STATE	STATE PROJ. NO.	SHEET NO.	TOTAL SHEETS
4	WISC.	3754	14	37


DIVISION JOB NO. 3754

DIVISION JOB NO. 3754

C.Y. STEP: SLOPES	STATION	END AREA			DISTANCE	YARDAGE				
		EXCAVATION		FILL		EXCAVATION				TOTAL FILL
		COMMON	ROCK			COMMON	ROCK	TOTAL		
	29	0								
	+50	0				0				278
	30	2				2				226
	+25	11				6				91
	+50	33				20				80
	31	111				133				144
	+50	134				228				126


SUB TOTAL - MILE	_____
SHEET TOTAL	_____

389				945
-----	--	--	--	-----

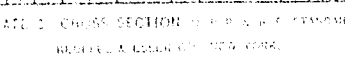

ORIGINAL
SURVEY
M. W. F.
S. L. J.
E. S. D.
W. T. M
I-37
9-37
" "
" "

SUB TOTAL - MILE	_____
SHEET TOTAL	_____

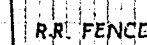

ORIGINAL SURVEY

M. W. F.
C. L. T.
L. J. J.
P. L. J.

W. T. M. 9-37

1-37

DIVISION JOB NO. 3754




[illegible]

SUB TOTAL - MILE
SHEET TOTAL

ORIGINAL	M. W. F.	W. T. M	1-37
SURVEY	C. L. F.		9-37
NOTE BOOK	P. L. J.		" "
8392	P. A.		" "

ORIGINAL
SURVEY
NOTE BOOK
8392

DIVISION JOB NO. 3754

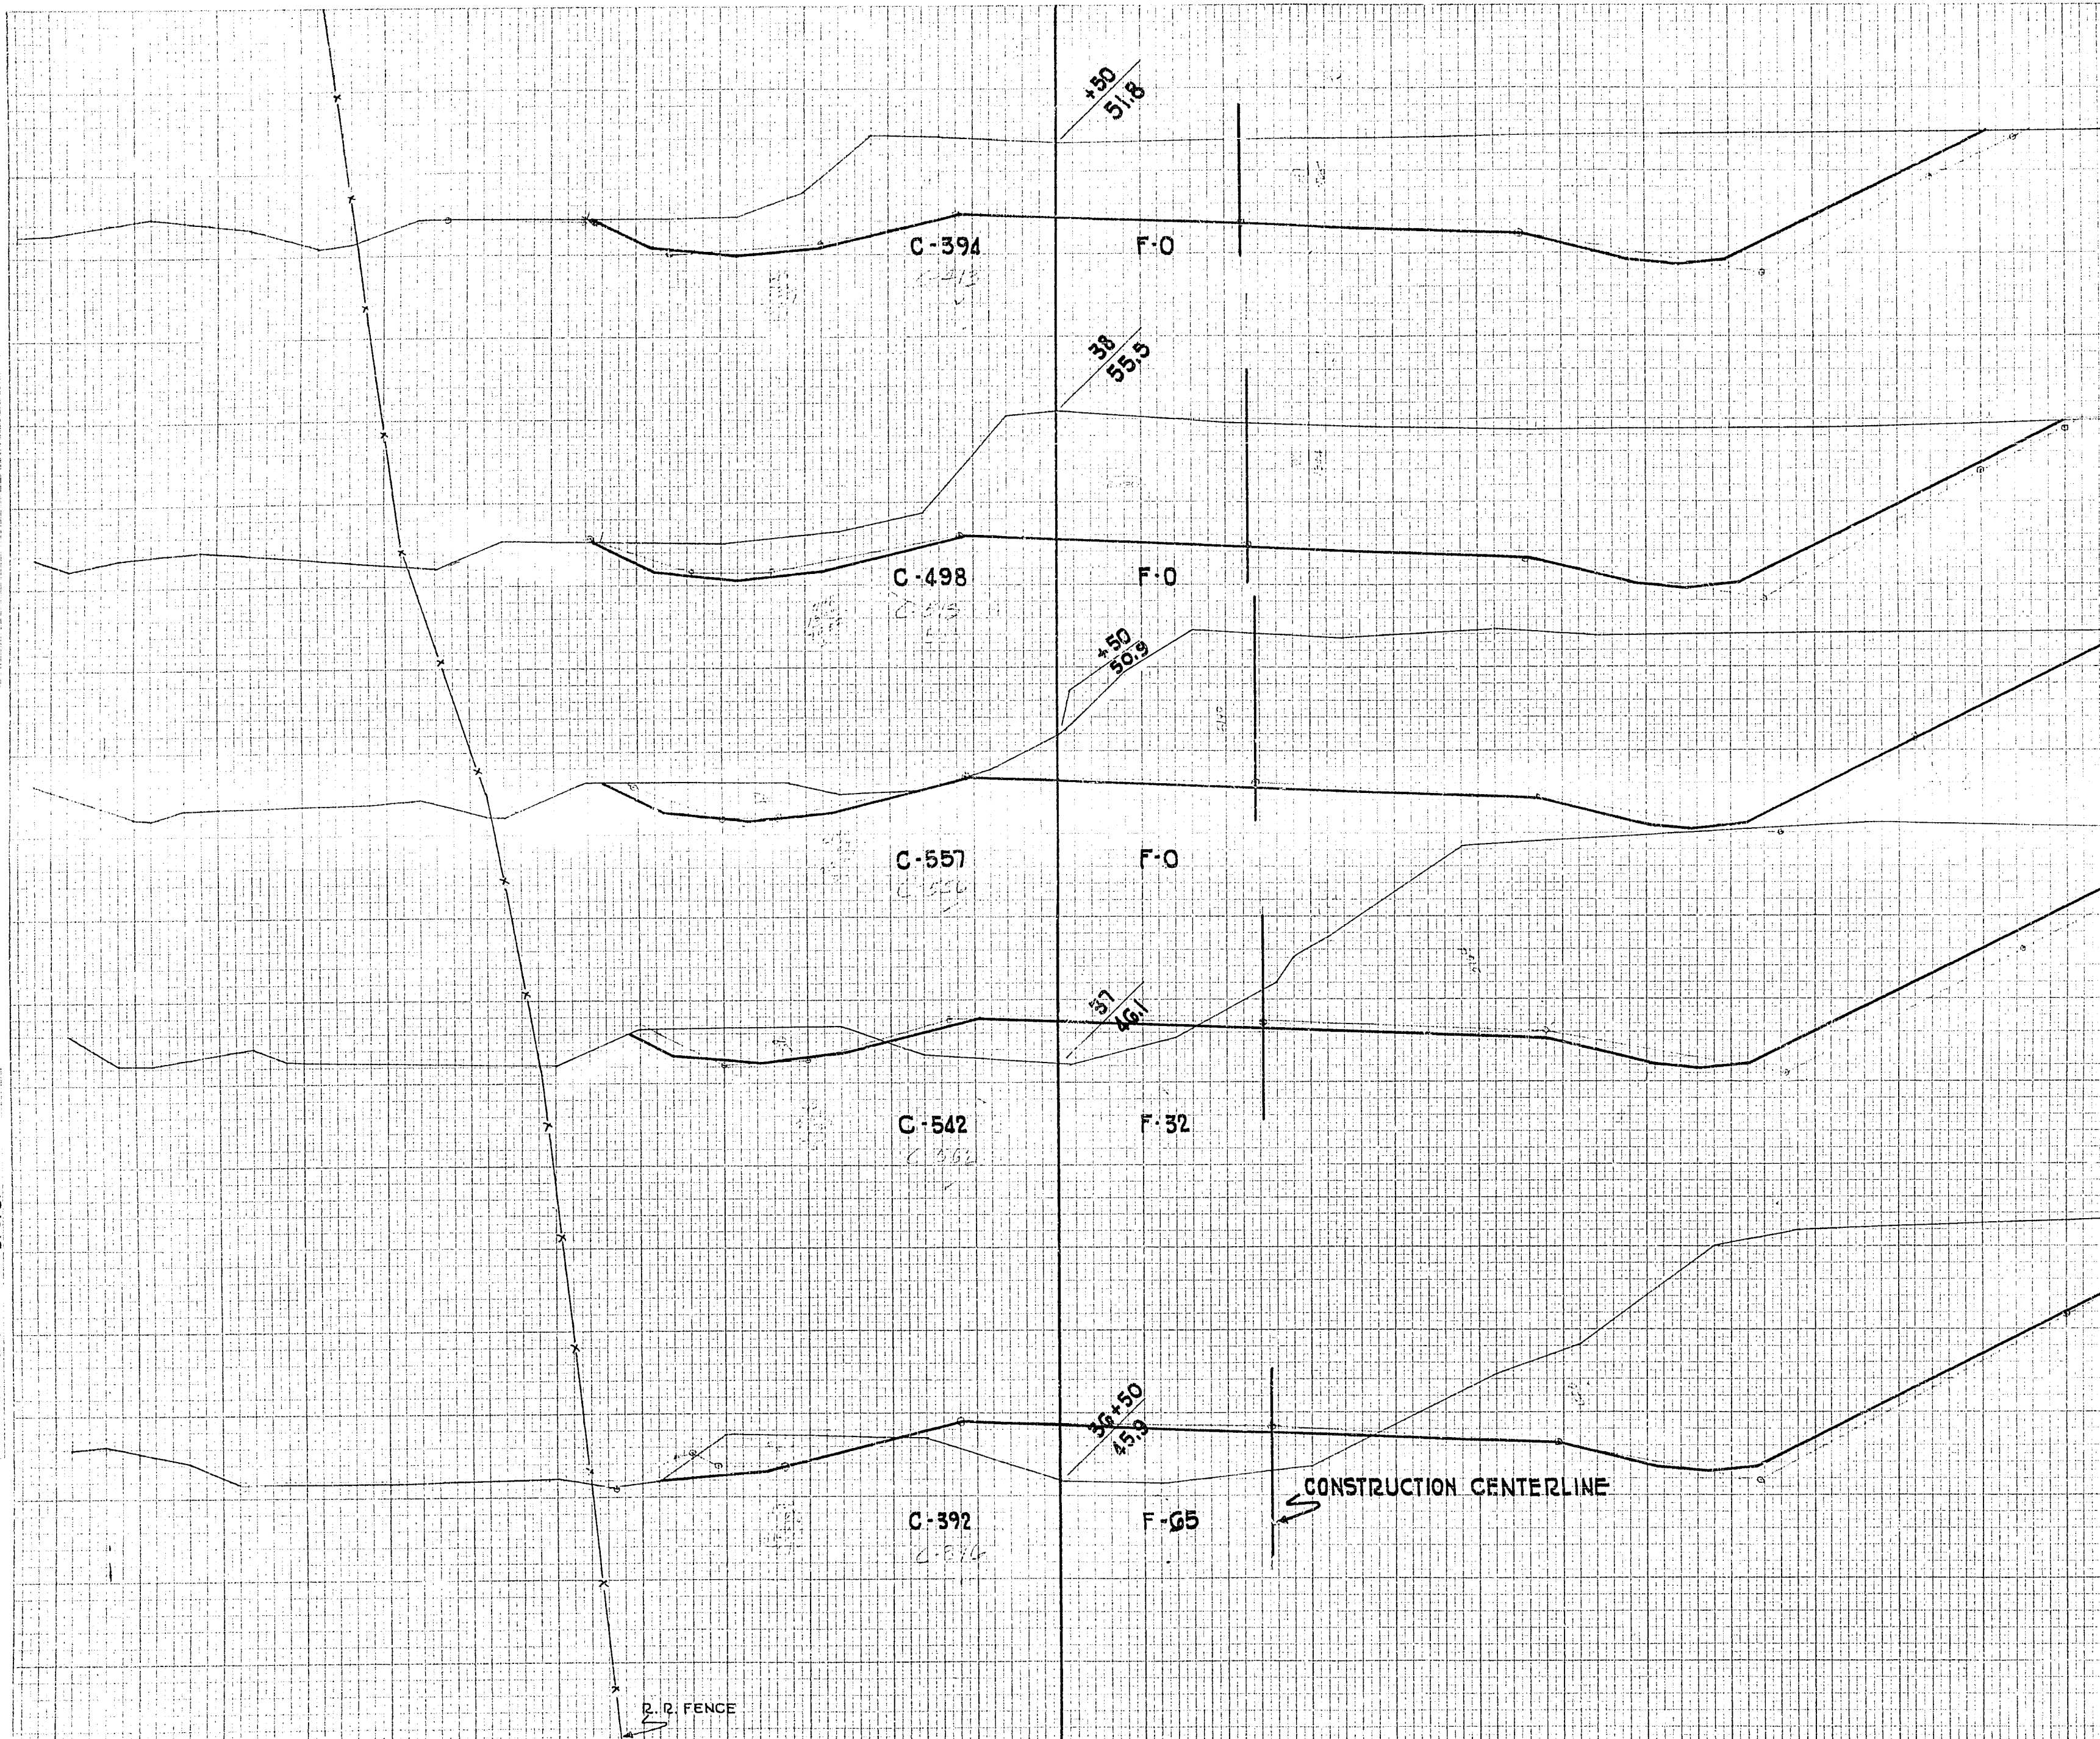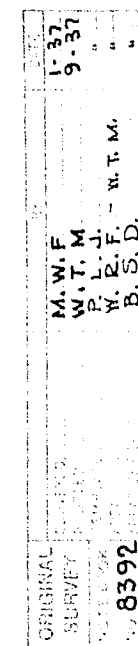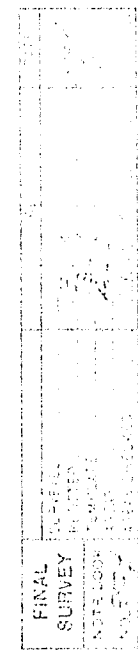[illegible]

DIVISION JOB NO. 3754

SUB TOTAL - MILE _____
SHEET TOTAL _____

1352				65
------	--	--	--	----

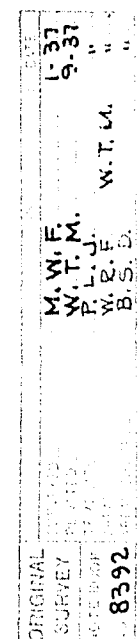


PLATE 10 - CROWN SECTION OF B&B STANDARDS
EXHIBIT 1-6-1978


SUB TOTAL - MILE
SHEET TOTAL

SUB TOTAL - MILE
SHEET TOTAL

1444

8592

DIVISION JOB NO. **3754**

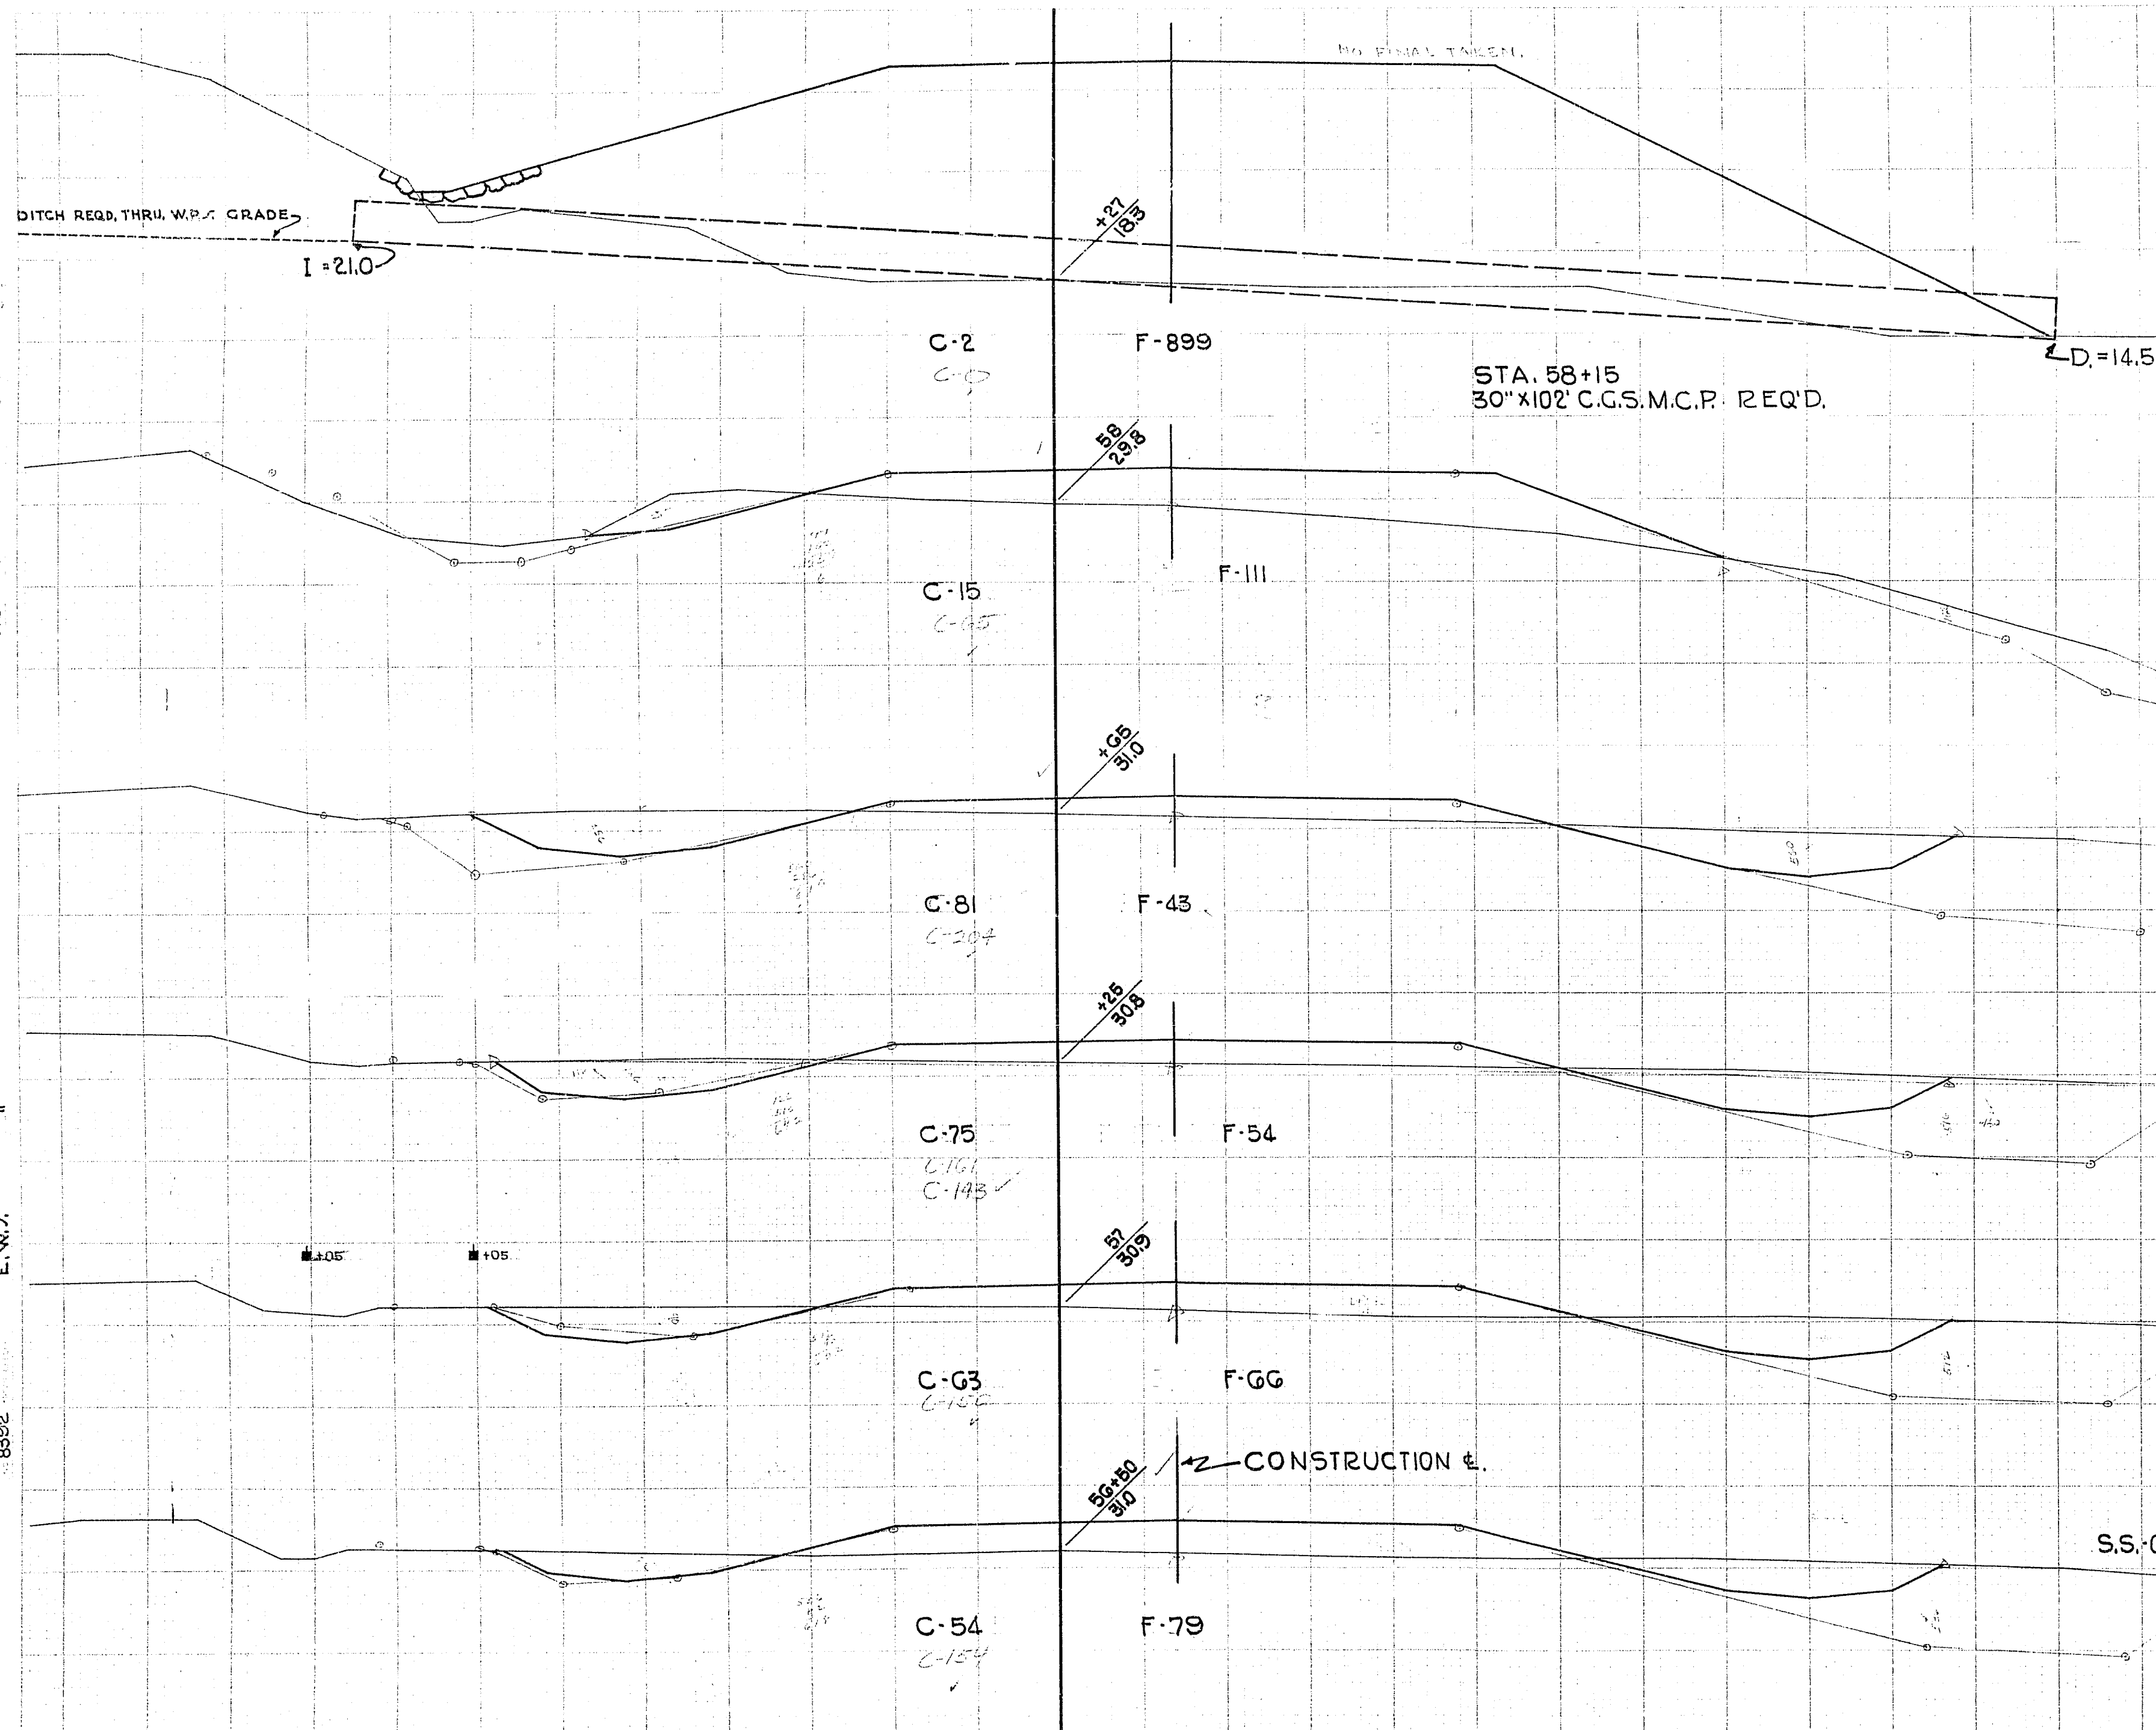[illegible]


2692



SUB TOTAL - MILE
SHEET TOTAL

SUB TOTAL - MILE
SHEET TOTAL

DIVISION JOB NO. 3754

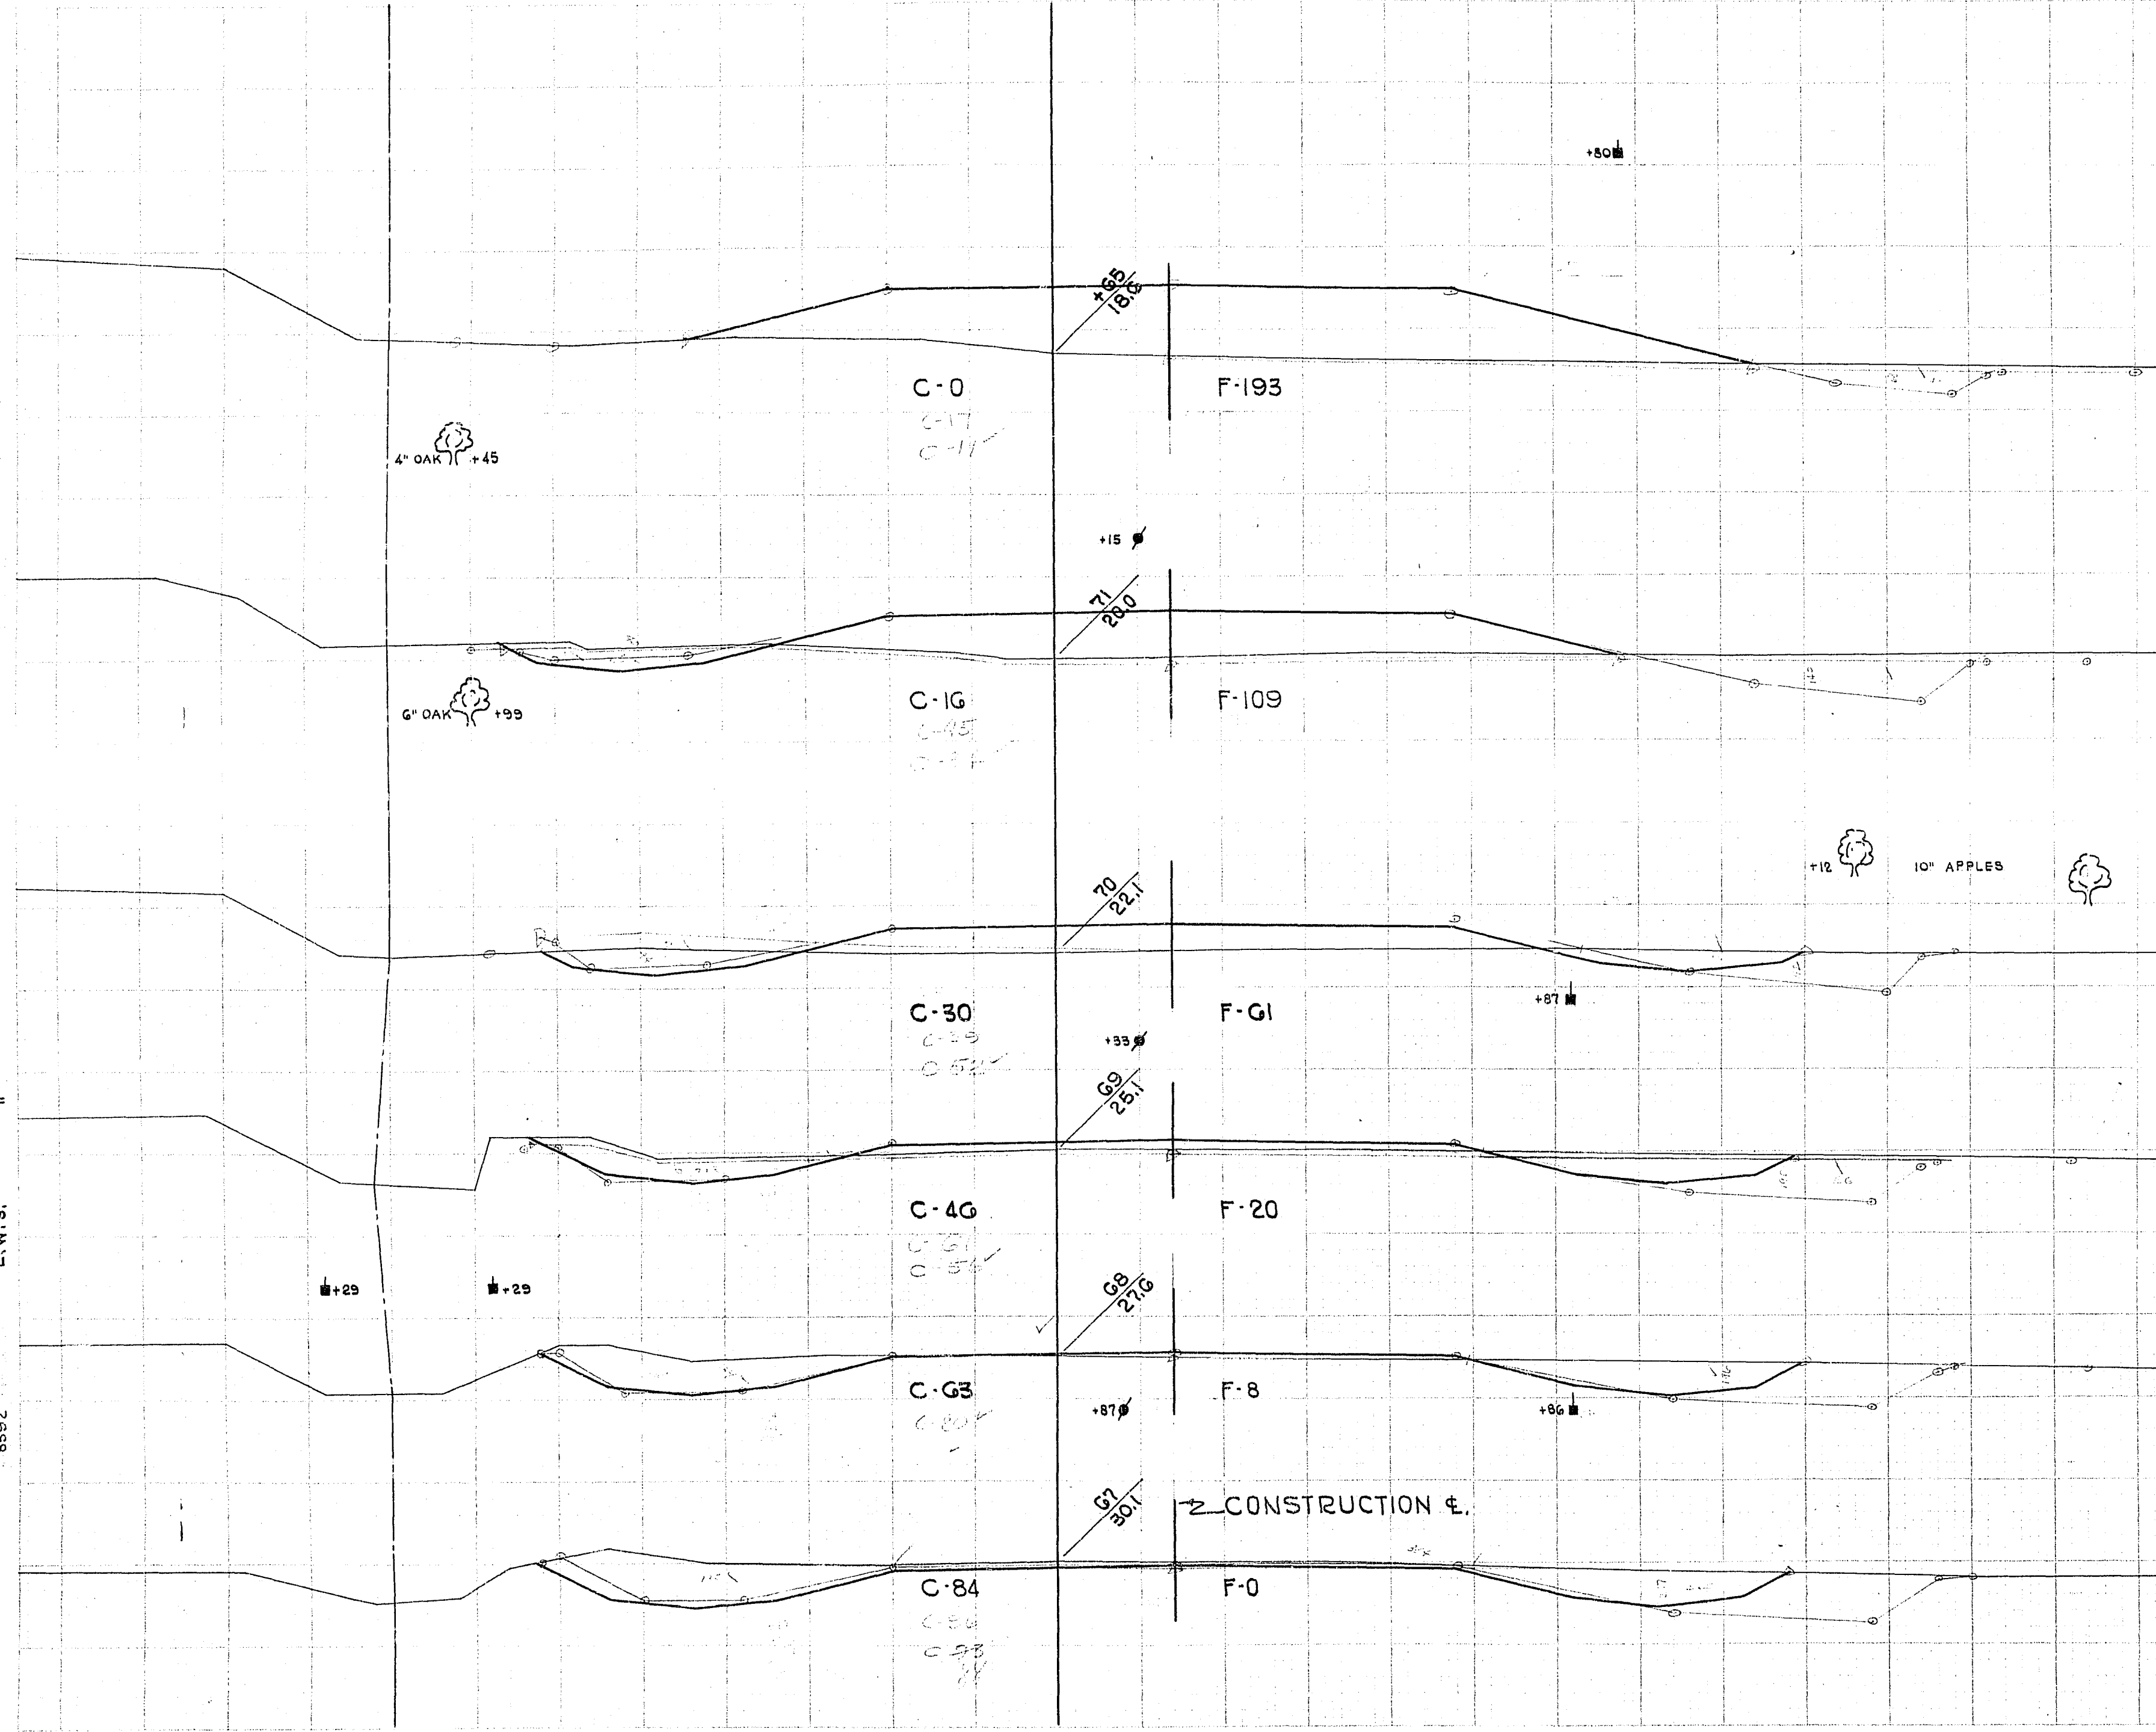

C.Y. STEP SLOPES		END AREA				YARDAGE			
STATION		EXCAVATION		FILL	DISTANCE	EXCAVATION			TOTAL FILL
		COMMON	ROCK			COMMON	ROCK	TOTAL	
	+50	99		0					
	G7	84		0		109			0
	G8	63		8		272			15
	G9	46		20		202			52
	SUB-TOTAL					643			67
74	TOTAL MILE ①					15,885			1,083
						15,885			11,083
	G9	46		20					
	70	30		61		141			150
	71	16		109		85			315
	+65	0		193		19			365

SUB TOTAL - MILE
SHEET TOTAL

DIVISION JOB NO. **3754**


SUB TOTAL - MILE _____
SHEET TOTAL

3392

2 CONSTRUCTION &

DEDUCT 60' FROM RT. DITCH CUT FOR SIDE ROAD.

SUB TOTAL - MILE _____
SHEET TOTAL

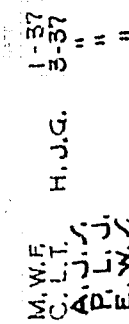

SUB TOTAL - MILE _____
SHEET TOTAL

DIVISION JOB NO. **3754**

[illegible]

SUB TOTAL - MILE	
SHEET TOTAL	

DIVISION JOB NO. **3754**

[illegible]

SUB TOTAL - MILE
SHEET TOTAL

1196


916

M. W. F.
C. L. T.
A. J. J.
P. J. J.
H. J. G
I-37
3-37
" " "

2023




SUB TOTAL - MILE
SHEET TOTAL

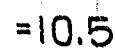SUB TOTAL - MILE

SHEET TOTAL

DIVISION JOB NO. **3754**

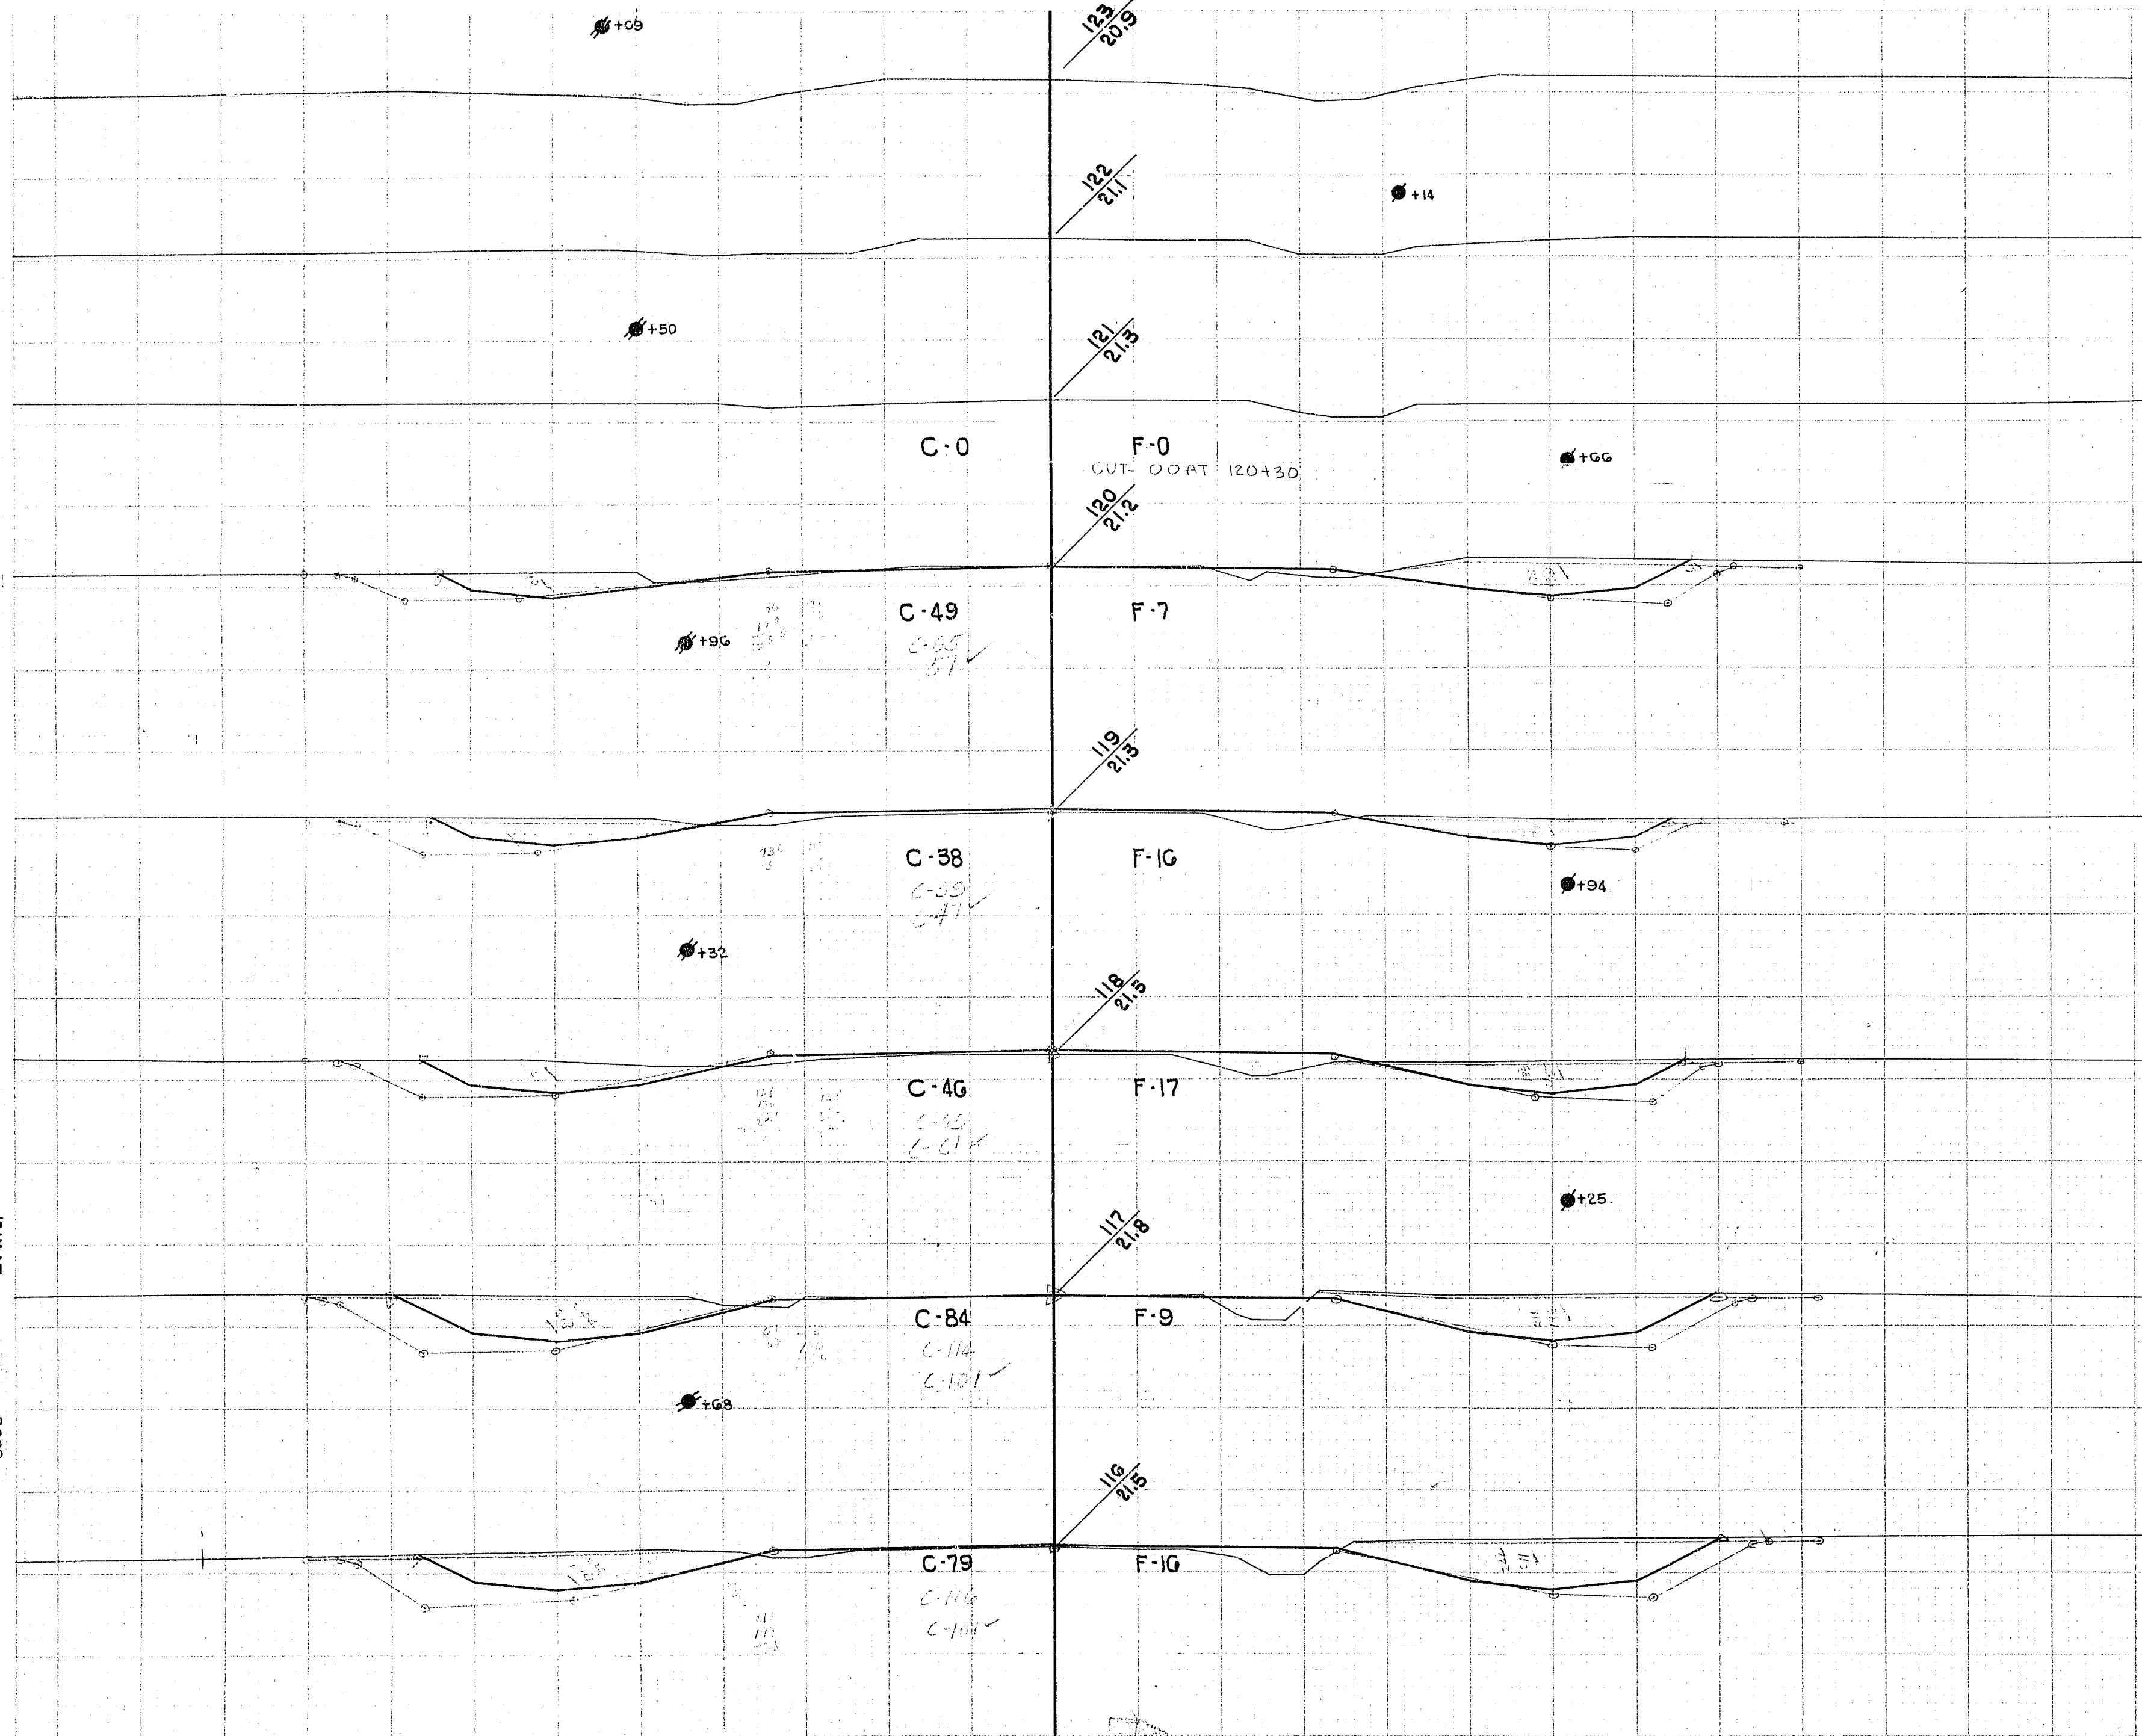[illegible]

DIVISION JOB NO.

C.Y. STEP SLOPES										END AREA										YARDAGE																																																																																																																																																																																																																																																																																																																																																																																																																																																																																																																																																																																																																																																																																																																																																																																																																																																																																																																																																																																																																																																																																																																																																																																																																																																																																																																																																						
STATION										EXCAVATION										EXCAVATION																																																																																																																																																																																																																																																																																																																																																																																																																																																																																																																																																																																																																																																																																																																																																																																																																																																																																																																																																																																																																																																																																																																																																																																																																																																																																																																																																						
										COMMON					ROCK					FILL					COMMON					ROCK					TOTAL																																																																																																																																																																																																																																																																																																																																																																																																																																																																																																																																																																																																																																																																																																																																																																																																																																																																																																																																																																																																																																																																																																																																																																																																																																																																																																																																							
										0										0																																																																																																																																																																																																																																																																																																																																																																																																																																																																																																																																																																																																																																																																																																																																																																																																																																																																																																																																																																																																																																																																																																																																																																																																																																																																																																																																																						

5-37
" " " "

M. W. F.
C. L. T.
A. J. S.
F. W. S.
R. J. B.

339!

DIVISION JOB NO. 3754

[illegible]

SUB TOTAL - MILE
SHEET TOTAL