
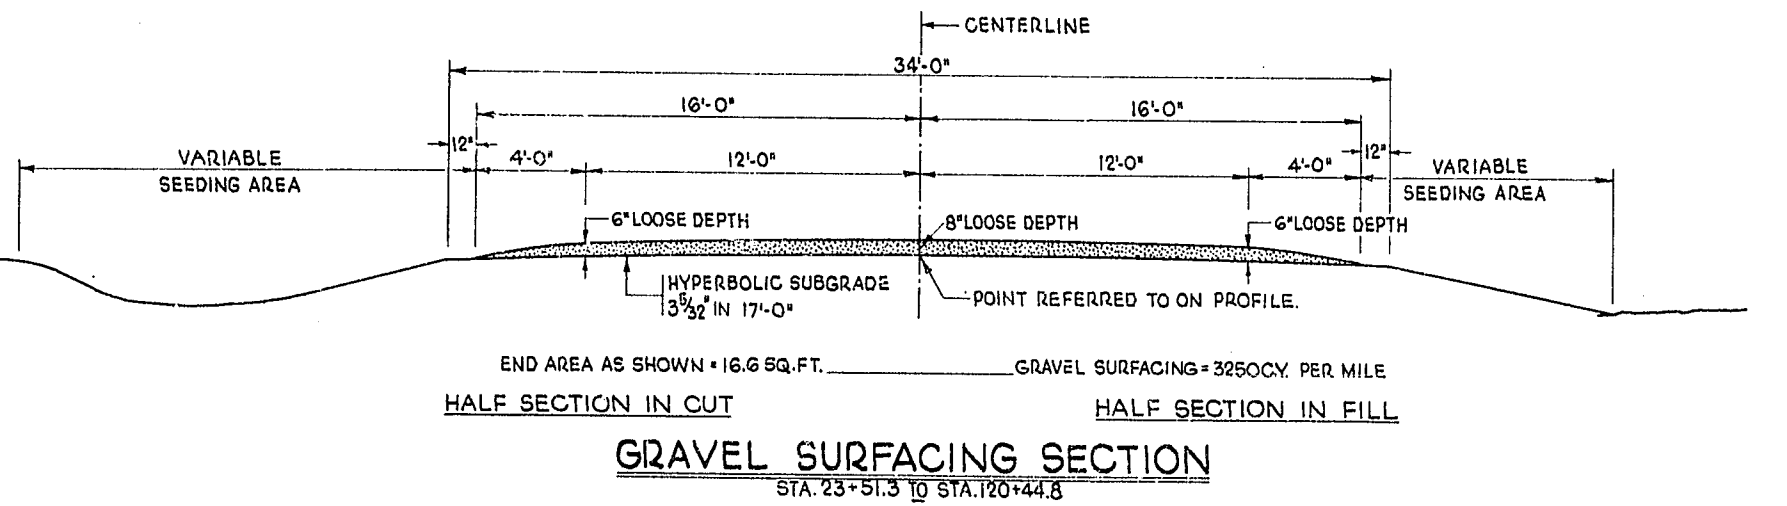
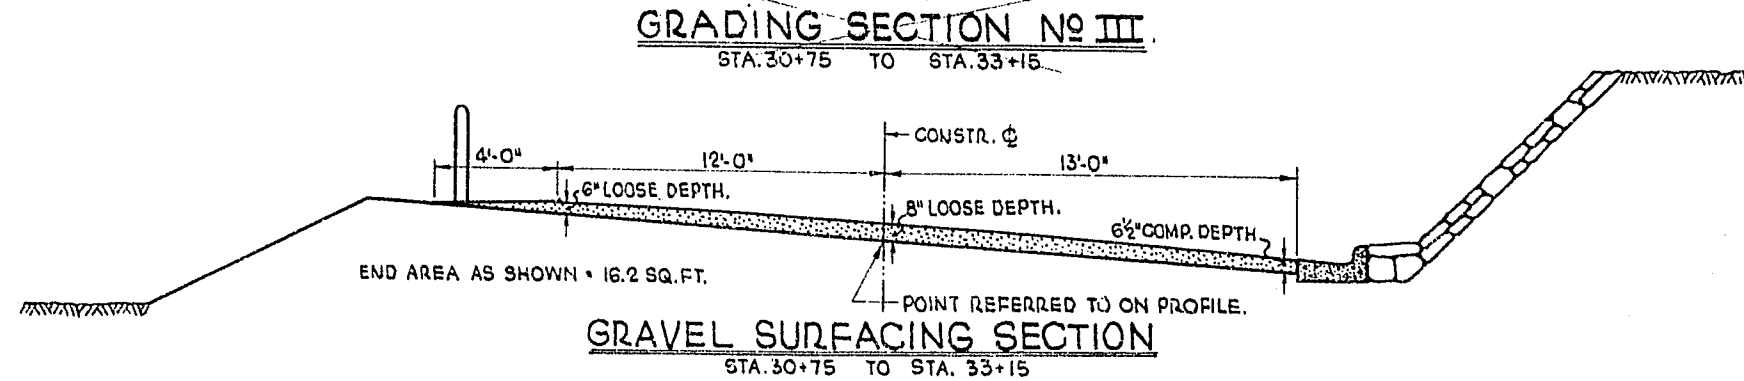
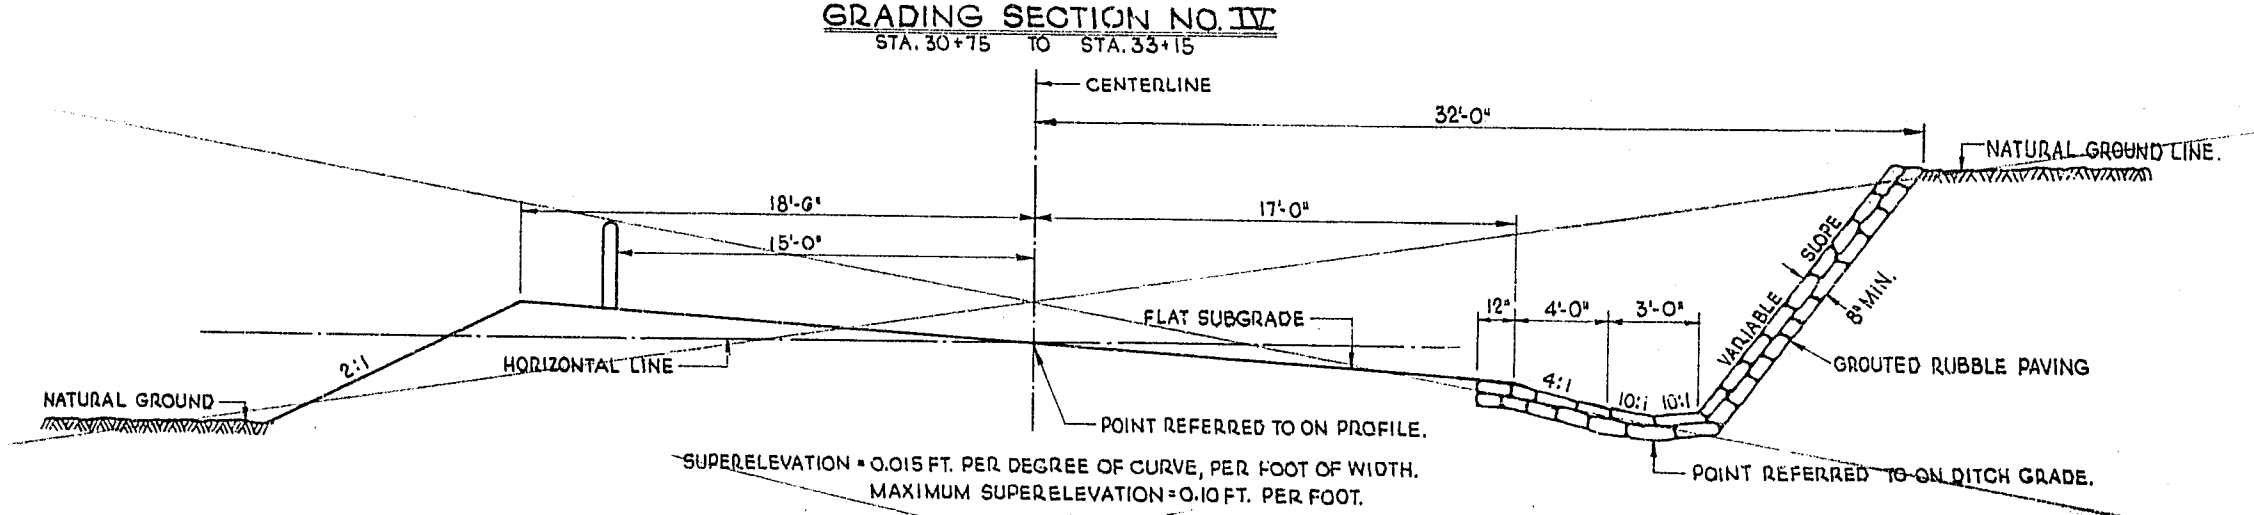
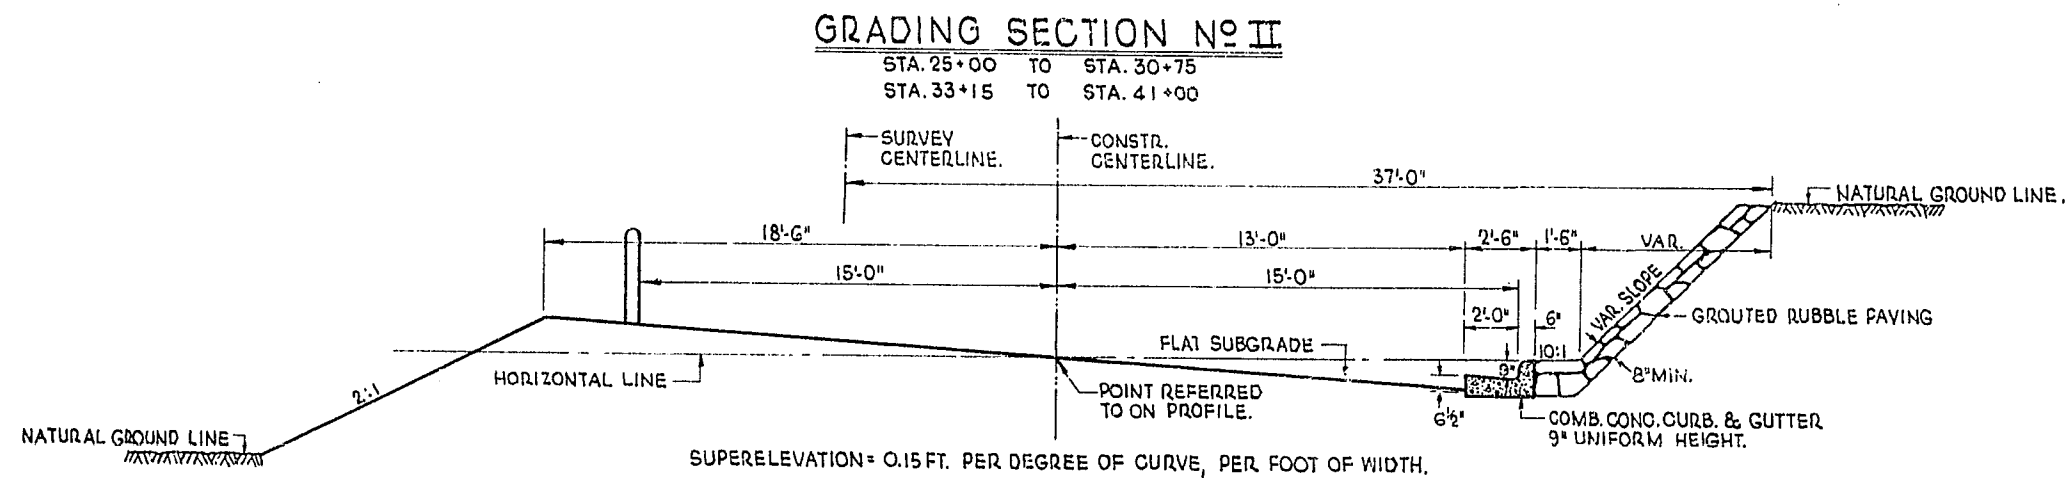
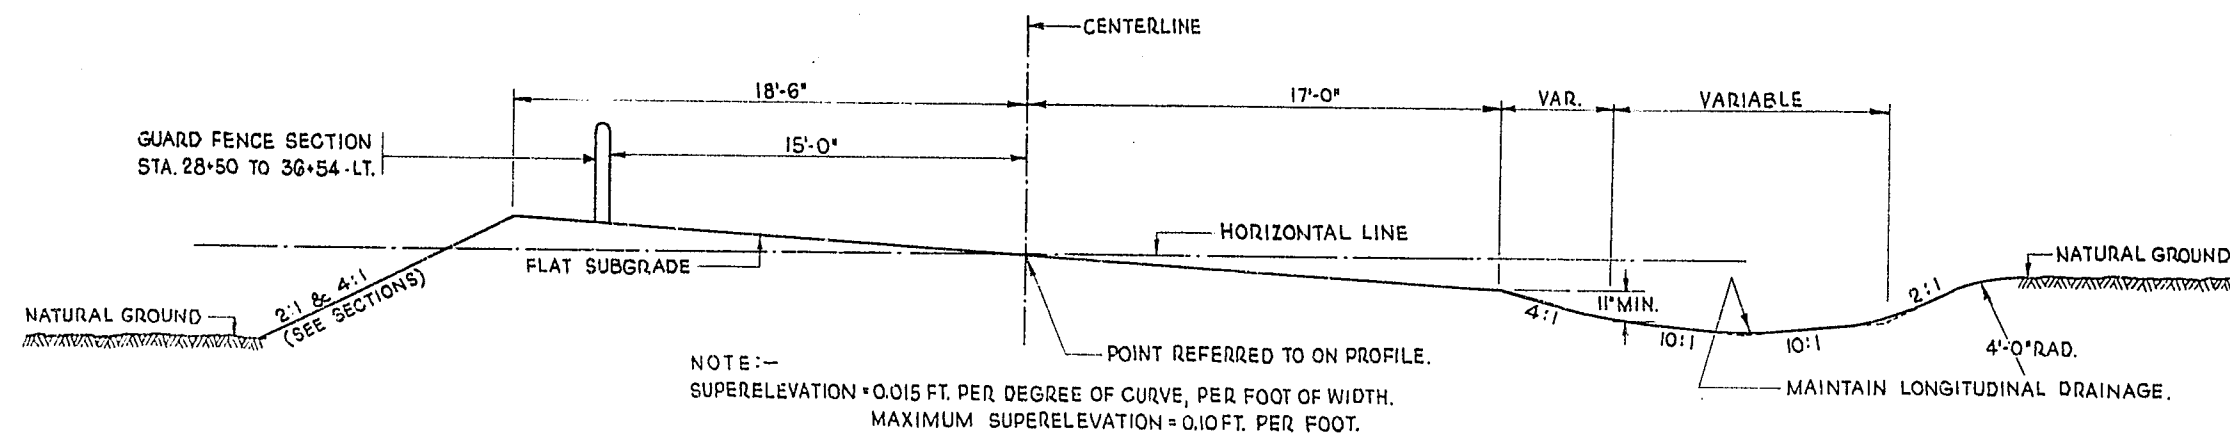
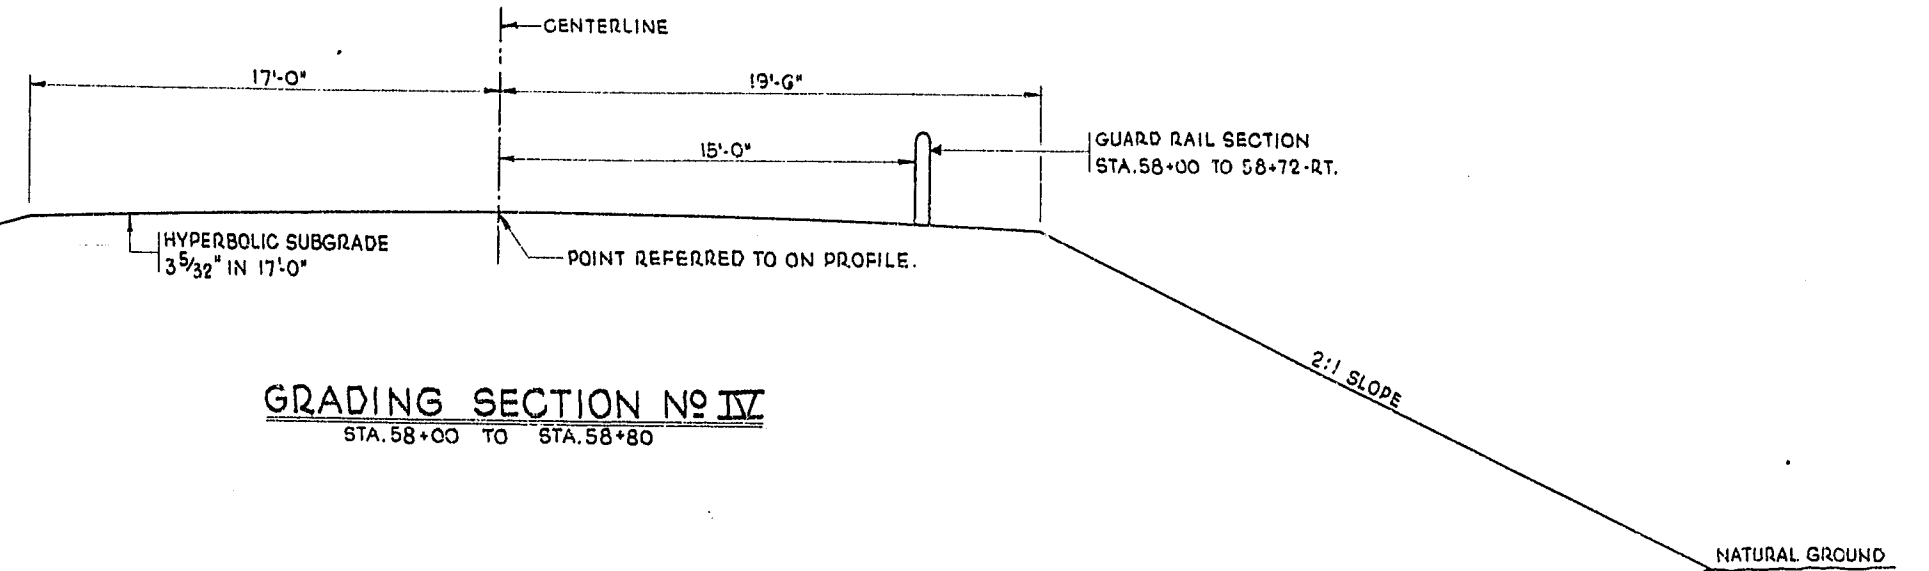
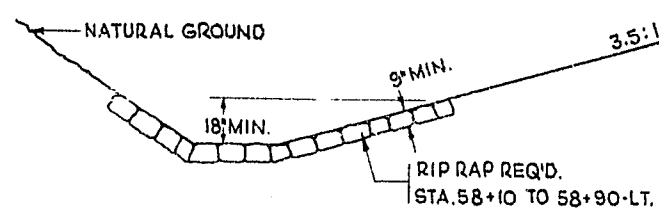


FED. ROAD DIST. NO.	STATE	STATE PROJ. NO.	SHEET NO.	TOTAL SHEETS
4	WIS.	3754	2	37

DIVISION JOB NO. 3754

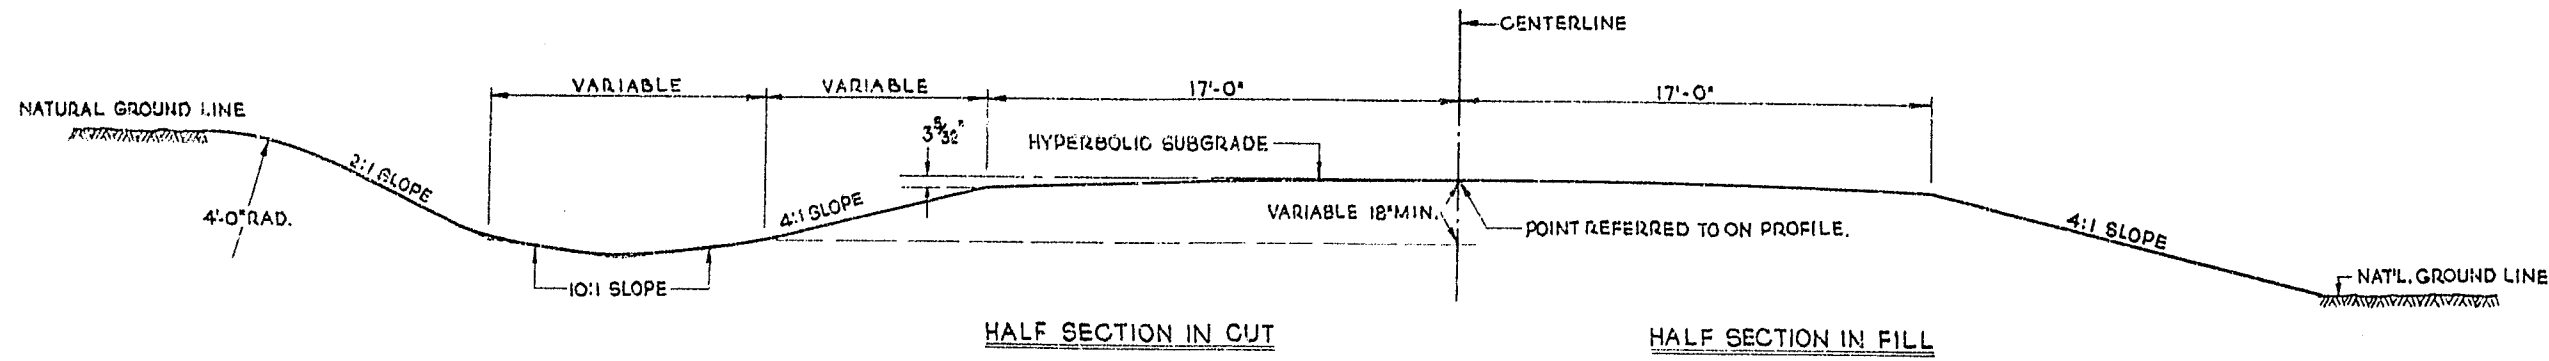

APPROVED DETAIL DRAWINGS ARE AS FOLLOWS:

MARKER POSTS S.D. 12-1

THREE-WIRE CABLE GUARD FENCE S.D. 13

CONSTRUCTION BARRICADE S.D. 16

CONC. CURB, GUTTER, COMB. CURB & GUTTER, S.D. 6-1







SURFACE DRAIN & DRIVEWAYS.

TYPICAL CROSS SECTION FOR

34'-0" ROADBED

32'-0" GRAVEL SURFACING

SCALE (VARIABLE)

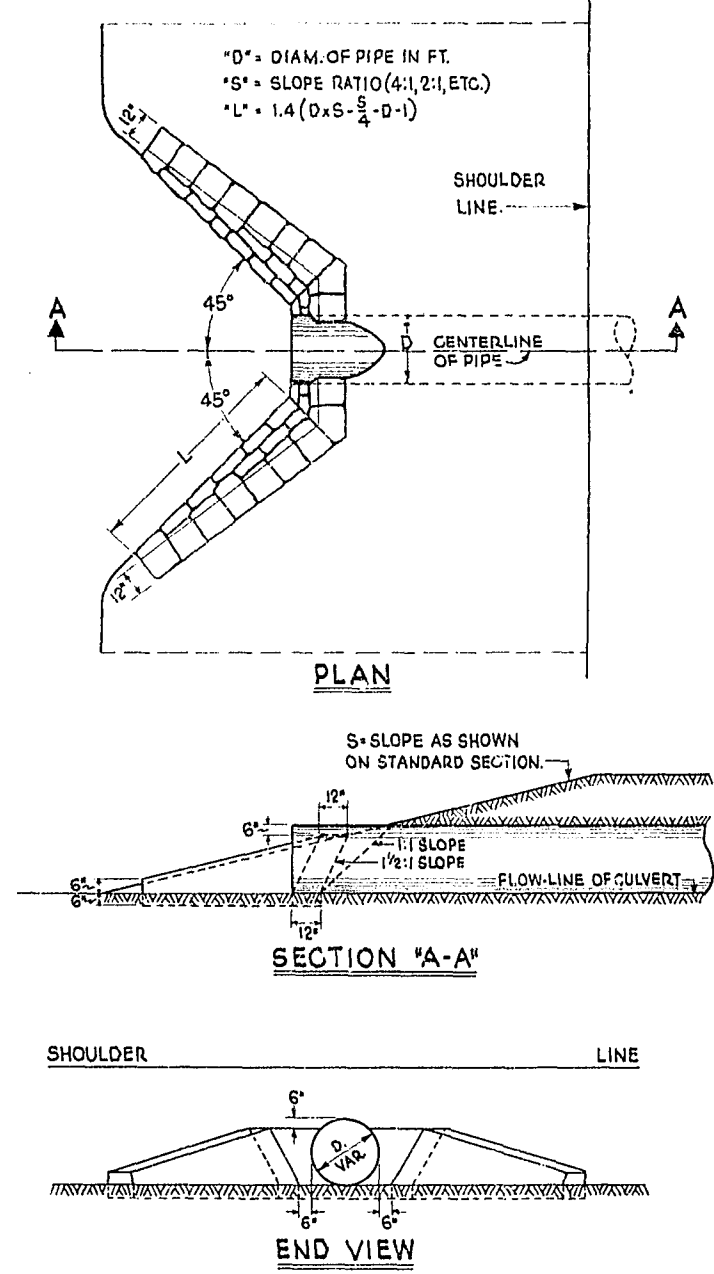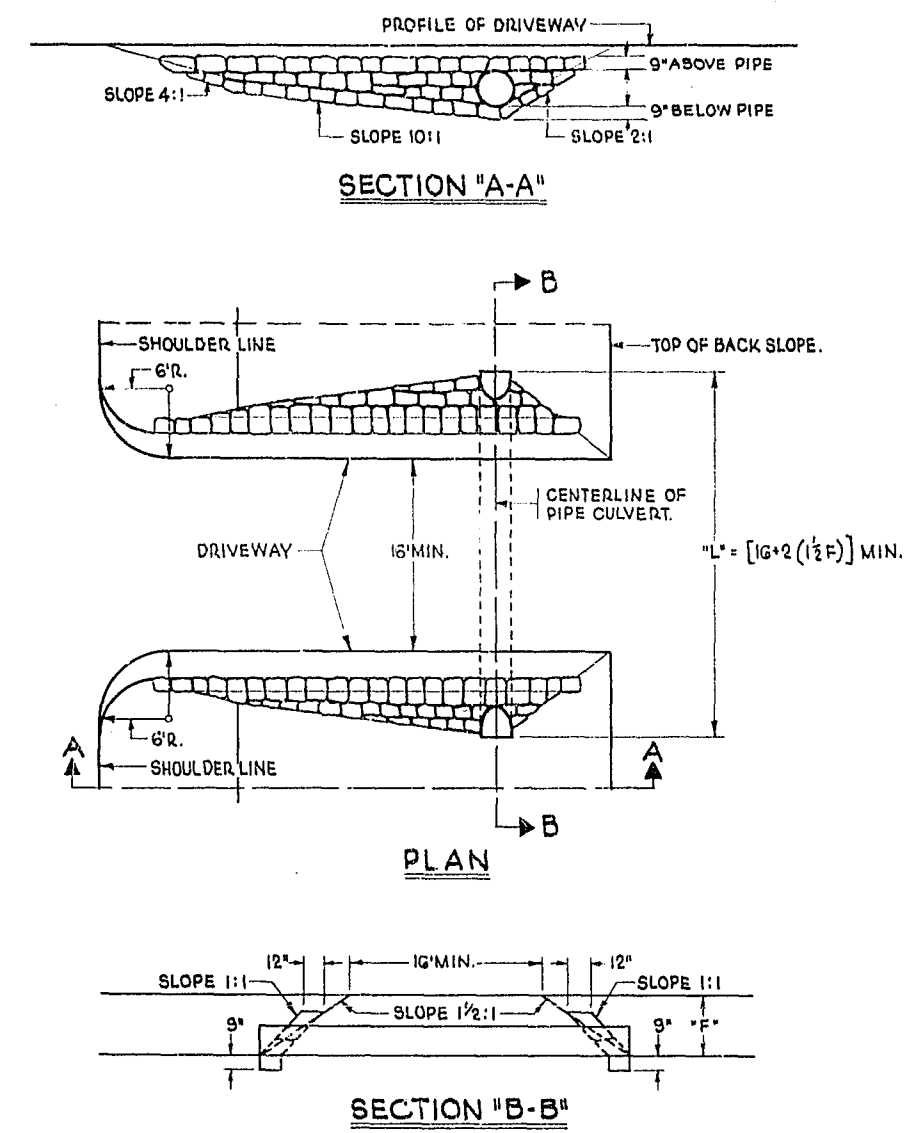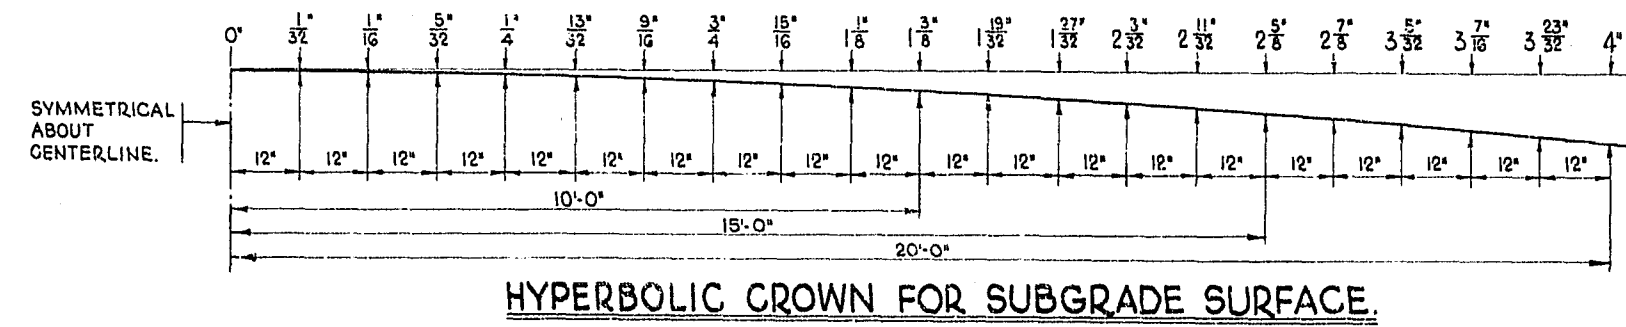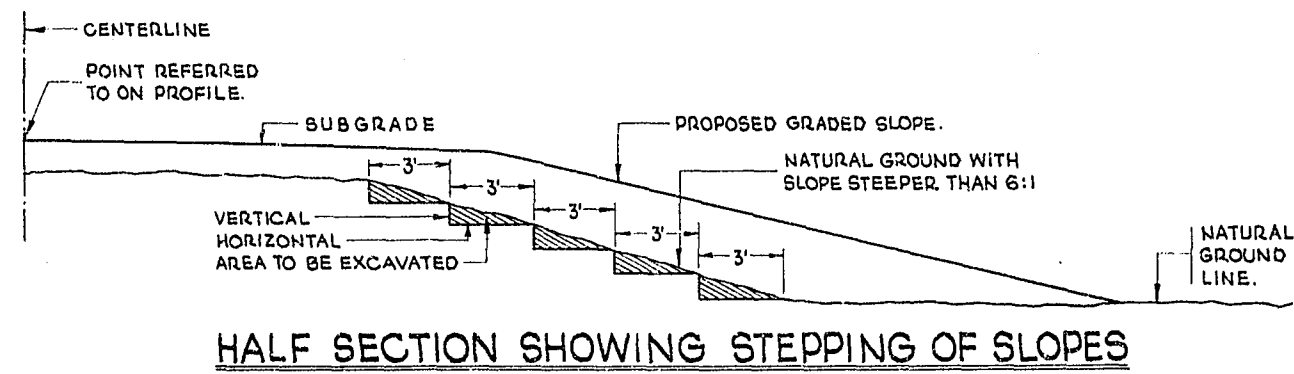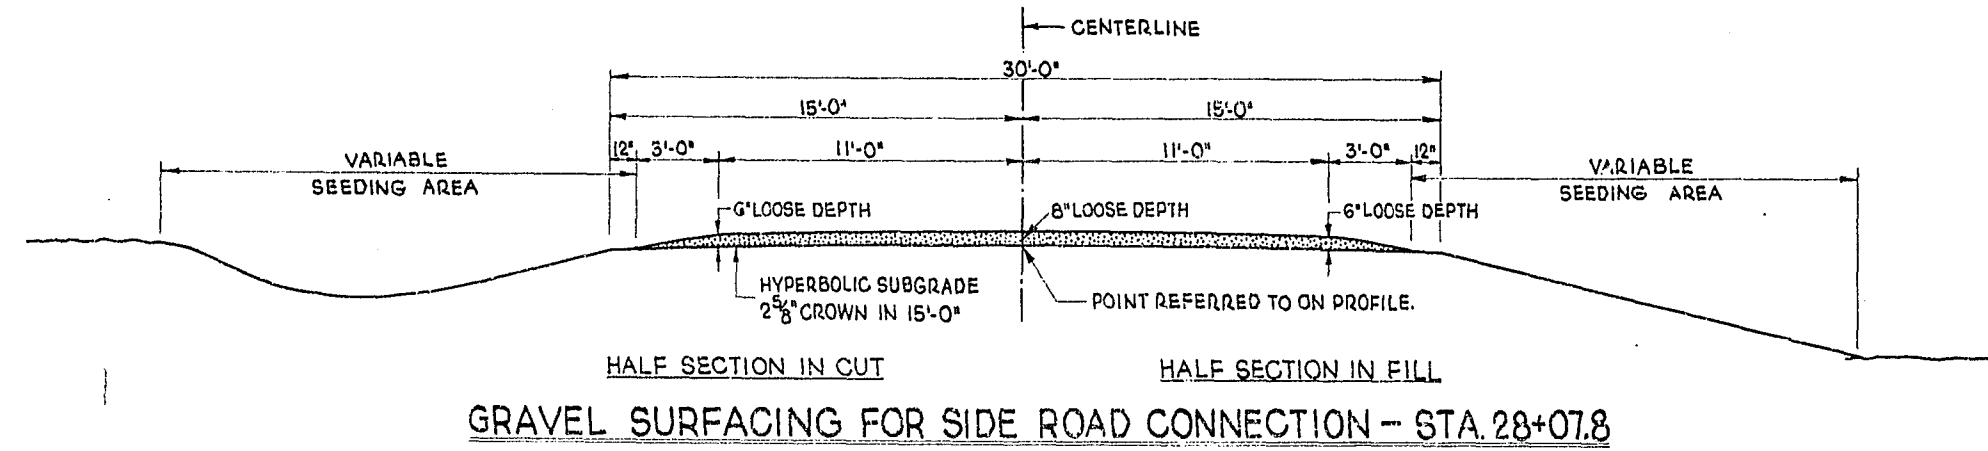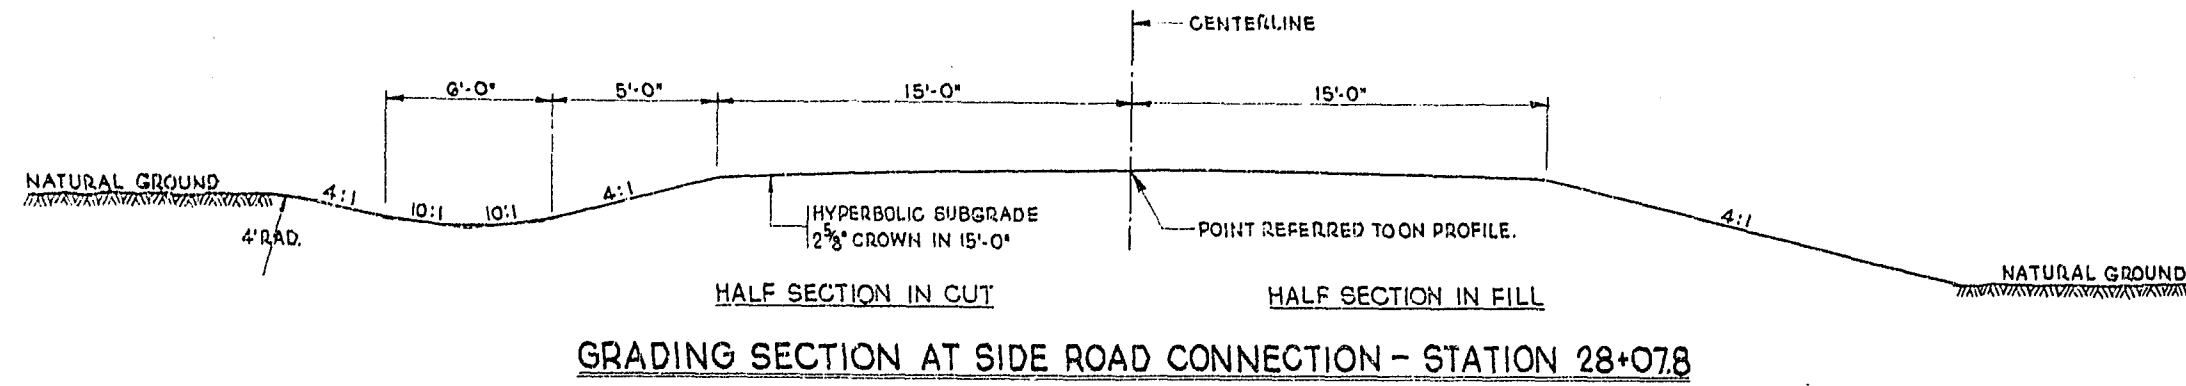

TYPICAL CROSS SECTION
FOR
34'-0" ROADBED
32'-0" GRAVEL SURFACING
SCALE
(VARIABLE)