

PROJECT ID: 1154-01-76
WITH: N/A

COUNTY: OCONTO

FILE NAME : S:\DOT\DOT_NEN\06431 Oconto\DGN\PSE3\010103_T1.dgn

GRE NOV 08

ORDER OF SHEETS

- Section No. 1 Title
- Section No. 2 Typical Sections and Details
- Section No. 3 Estimate of Quantities
- Section No. 3 Miscellaneous Quantities
- Section No. 4 Right of Way Plat
- Section No. 5 Plan and Profile
- Section No. 6 Standard Detail Drawings
- Section No. 7 Sign Plates
- Section No. 8 ~~Structure Plans~~
- Section No. 9 Computer Earthwork Data
- Section No. 9 Cross Sections

TOTAL SHEETS = 490




DESIGN DESIGNATION

- A.A.D.T. 2007 = 12000 - 12650
- A.A.D.T. 2027 = 10700 - 15700
- D.H.V. 2027 = 12840 - 18840
- D.D. = 60 - 40
- T. (% ADT) = 17.3%
- DESIGN SPEED = 70 MPH
- ESALS = N/A

CONVENTIONAL SYMBOLS

- PLAN
- CORPORATE LIMITS
- PROPERTY LINE
- LOT LINE
- LIMITED HIGHWAY EASEMENT
- EXISTING RIGHT OF WAY
- PROPOSED OR NEW R/W LINE
- SLOPE INTERCEPT
- REFERENCE LINE
- EXISTING CULVERT
- PROPOSED CULVERT (Box or Pipe)
- COMBUSTIBLE FLUIDS
- MARSH AREA
- WOODED OR SHRUB AREA

- PROFILE
- GRADE LINE
- ORIGINAL GROUND
- MARSH OR ROCK PROFILE (To be noted as such)
- SPECIAL DITCH
- GRADE ELEVATION
- CULVERT (Profile View)
- UTILITIES
- ELECTRIC
- FIBER OPTIC
- GAS
- SANITARY SEWER
- STORM SEWER
- TELEPHONE
- WATER
- UTILITY PEDESTAL
- POWER POLE
- TELEPHONE POLE

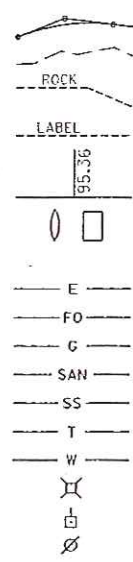

STATE OF WISCONSIN
DEPARTMENT OF TRANSPORTATION

PLAN OF PROPOSED IMPROVEMENT.


OCONTO - PESHTIGO

FROG POND RD - CTH S

USH 41

OCONTO COUNTY

STATE PROJECT NUMBER
1154-01-76

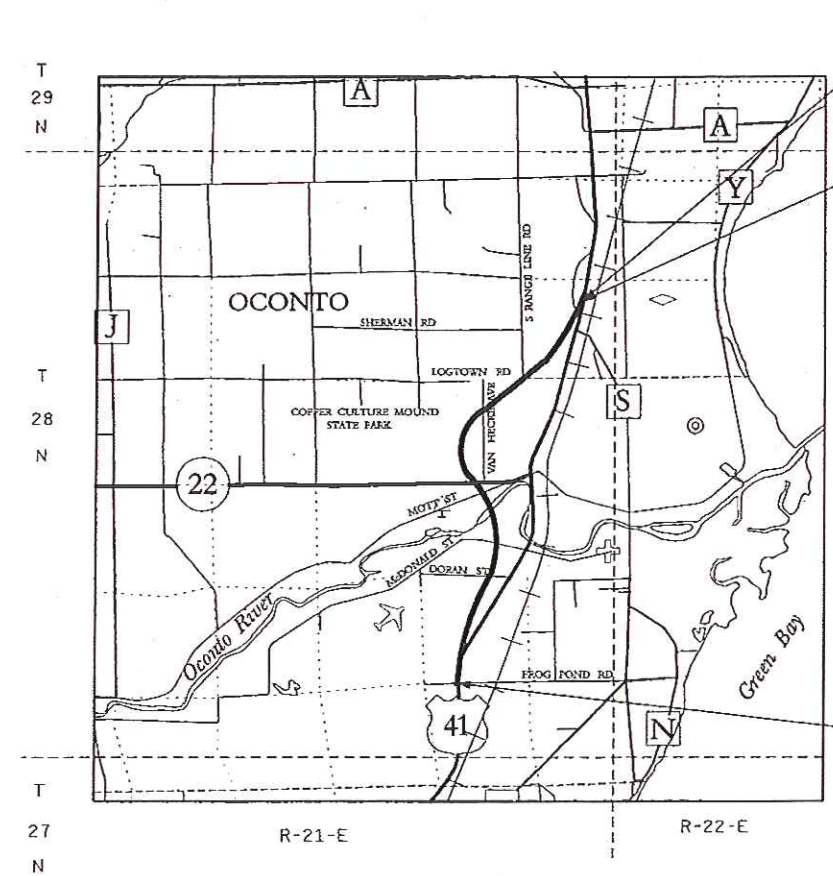

AS BUILT PLAN NO.

SUPERVISOR STEVE NOEL
RESIDENT KEITH NIKOLAY
CONTRACTOR ZIGNECO CORPORATION, INC.
COMPLETED 12/17/09

END PROJECT 1154-01-76
STA 849+11.96

STATION EQUATION
STA 836+43.55 BK =
STA 836+00.00 AH

BEGIN PROJECT 1154-01-76
STA 582+85.13
X = 602,380.199
Y = 170,232.214

LAYOUT
SCALE 0 1 MI.

TOTAL NET LENGTH OF CENTERLINE = 5.051 MI. (RURAL)

Coordinates on this plan are referenced to the Wisconsin County Coordinate System (WCCS), Oconto County. Elevations are based on NAVD 29

STATE PROJECT	FEDERAL PROJECT	
	PROJECT	CONTRACT
1154-01-76	NH 2008601	1

ADDENDUM
ATTACHED
TO BACK

REVISED PLAN SHEETS: 176,
190, & 193

NEW PLAN SHEETS: 37A, 37B,
& 204A

ORIGINAL PLANS PREPARED BY
KAPUR & ASSOCIATES, INC.
CONSULTING ENGINEERS
MILWAUKEE, WISCONSIN
414.351.6668



Justin M. Arndt

11/06/2007
(Date) (Signature)

STATE OF WISCONSIN
DEPARTMENT OF TRANSPORTATION

PREPARED BY
Surveyor NE REGION
Designer KAPUR & ASSOC./NE REGION
Project Manager PAUL ZOELLNER
District Examiner
District Supervisor STEVE NOEL
C.O. Examiner GUEST INC.

APPROVED FOR DISTRICT OFFICE
DATE: 11/6/07 *Ribera & Roopke, P.E.*
(Signature)

E