

GRE FEB 11  
ORDER OF SHEETS

PROJECT ID: 9280-04-72  
WITH: N/A

COUNTY: BROWN

Section No.	Title
1	Typical Sections and Details
2	Estimate of Quantities
3	Miscellaneous Quantities
4	Right of Way Plat
5	Plan and Profile
6	Standard Detail Drawings
7	Sign Plates
8	Structure Plans
9	Computer Earthwork Data
9	Cross Sections

TOTAL SHEETS = 354

Section No. 2 Sheet 13 replaced with 13a&13b



#### DESIGN DESIGNATION

A.D.T. 2006	=	12,000
A.D.T. 2026	=	17,500
D.H.V.	=	945
D.	=	58 - 42%
T.	=	5.4
DESIGN SPEED	=	50 MPH
ESALS	=	6.8%

#### CONVENTIONAL SYMBOLS

PLAN	
CORPORATE LIMITS	PL ± 53.1
PROPERTY LINE	
LOT LINE	
LIMITED HIGHWAY EASEMENT	
EXISTING RIGHT OF WAY	
PROPOSED OR NEW R/W LINE	
SLOPE INTERCEPT	
REFERENCE LINE	
EXISTING CULVERT	
PROPOSED CULVERT (Box or Pipe)	
COMBUSTIBLE FLUIDS	CAUTION
MARSH AREA	
WOODED OR SHRUB AREA	

#### PROFILE

GRADE LINE	
ORIGINAL GROUND	
MARSH OR ROCK PROFILE (To be noted as such)	
SPECIAL DITCH	
GRADE ELEVATION	
CULVERT (Profile View)	
UTILITIES	
ELECTRIC	E
FIBER OPTIC	FO
GAS	G
SANITARY SEWER	SAN
STORM SEWER	SS
TELEPHONE	T
WATER	W
UTILITY PEDESTAL	
POWER POLE	
TELEPHONE POLE	


#### BEGIN PROJECT

STA 1+00.00  
X= 56924.843  
Y= 561588.224

STA 0+75  
X=56906.5594  
Y=561571.1738

# STATE OF WISCONSIN DEPARTMENT OF TRANSPORTATION PLAN OF PROPOSED IMPROVEMENT STH 54 - PACKERLAND DRIVE AIRPORT ENTRANCE & STH 54 INT STH 172 BROWN COUNTY

STATE PROJECT NUMBER  
9280-04-72

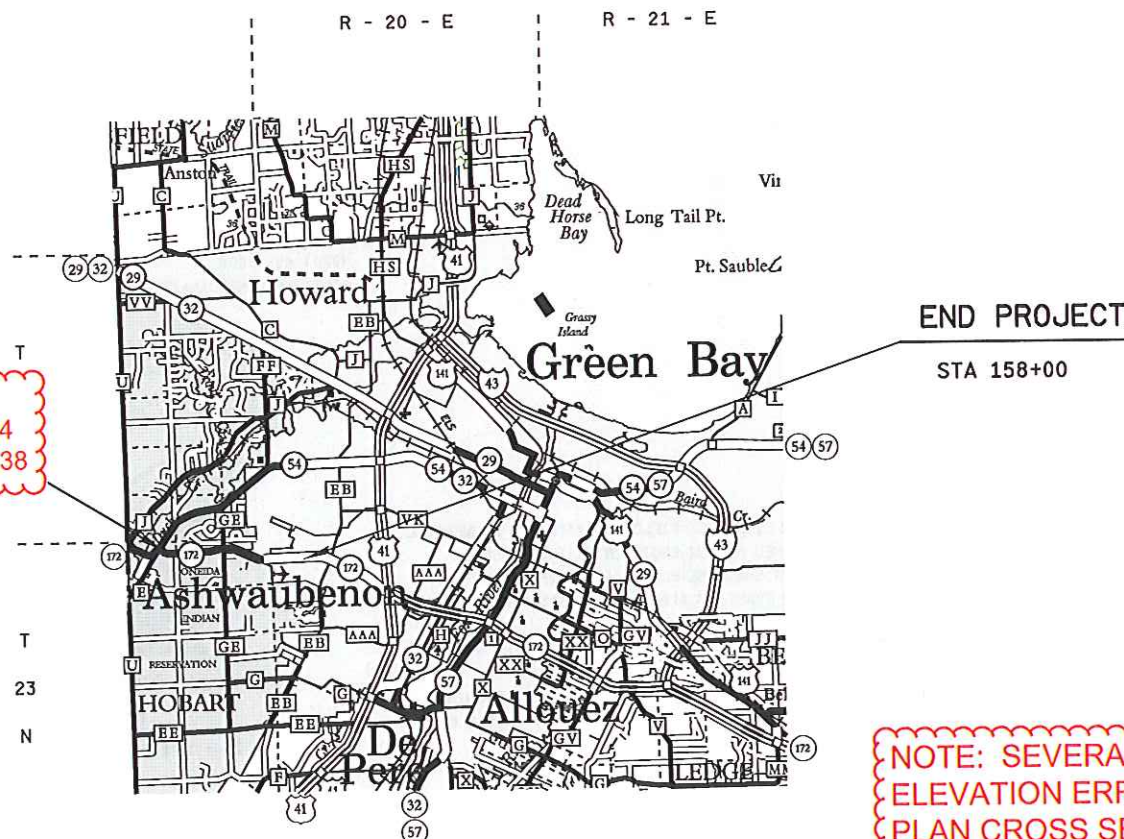

#### END PROJECT

STA 158+00

NOTE: SEVERAL  
ELEVATION ERRORS IN  
PLAN CROSS SECTIONS.  
HAVE SURVEY PERFORMED  
PRIOR TO USING ANY DATA  
FROM CROSS SECTIONS

COORDINATES ON THIS PLAN ARE REFERENCED TO  
THE WISCONSIN COUNTY COORDINATE SYSTEM  
(WCCS), BROWN COUNTY NAD 83 (1991).

#### STATE PROJECT

9280-04-72

#### FEDERAL PROJECT

PROJECT

WISC 2011131

CONTRACT

1

## AS-BUILT PLAN

SUPERVISOR: Steve Noel  
PROJECT LEADER: Bryan Learst  
CONTRACTOR: RC Excavating, Inc.  
WORK COMPLETED: 09/30/2011

#### Subcontractor List

Bodart Electric Service, INC.  
Century Fence Company  
Choice Construction Companies, INC.  
Double D Landscape, LLC  
Martell Construction, INC.  
Mid-State Concrete Cutting CO.  
Northeast Asphalt, INC.  
Warning Lites of Appleton, INC.  
Wisconsin Land Surveying, INC  
MCM Excavation and Landscaping  
Snowden, INC.  
MCC, INC.  
Vinton Construction Company

#### STATE OF WISCONSIN DEPARTMENT OF TRANSPORTATION

##### PREPARED BY

Surveyor  
Designer E. J. HOEFFERLE  
Project Manager D. J. SEGERSTROM  
District Examiner  
District Supervisor S. C. NOEL  
C.O. Examiner

##### APPROVED FOR DISTRICT OFFICE

DATE: 11/1/10 Ed Hoeflerle  
(Signature)