

SURVEY 1

STATE PROJECT NUMBER

4140-2-71

970

50

25

25

50

12

125-14" STUMP

125-18" BEACH

125-18" BEACH

106-22" MAPLE

655-18" MAPLE

125-18" MAPLE
125-18" MAPLE

176-20" MAPLE

WOODS

N.W.

50

25

25

50

656+50.0

650

656+00.0

655

655+82.0

655

655+71.0

655

655+50.0

655

655+00.0

655

SHEET NO. 2

1 - OS. HOR

1 - OS. VER


3185

STATE PROJECT NUMBER 111

1110-2-71

911


SURVEY 1

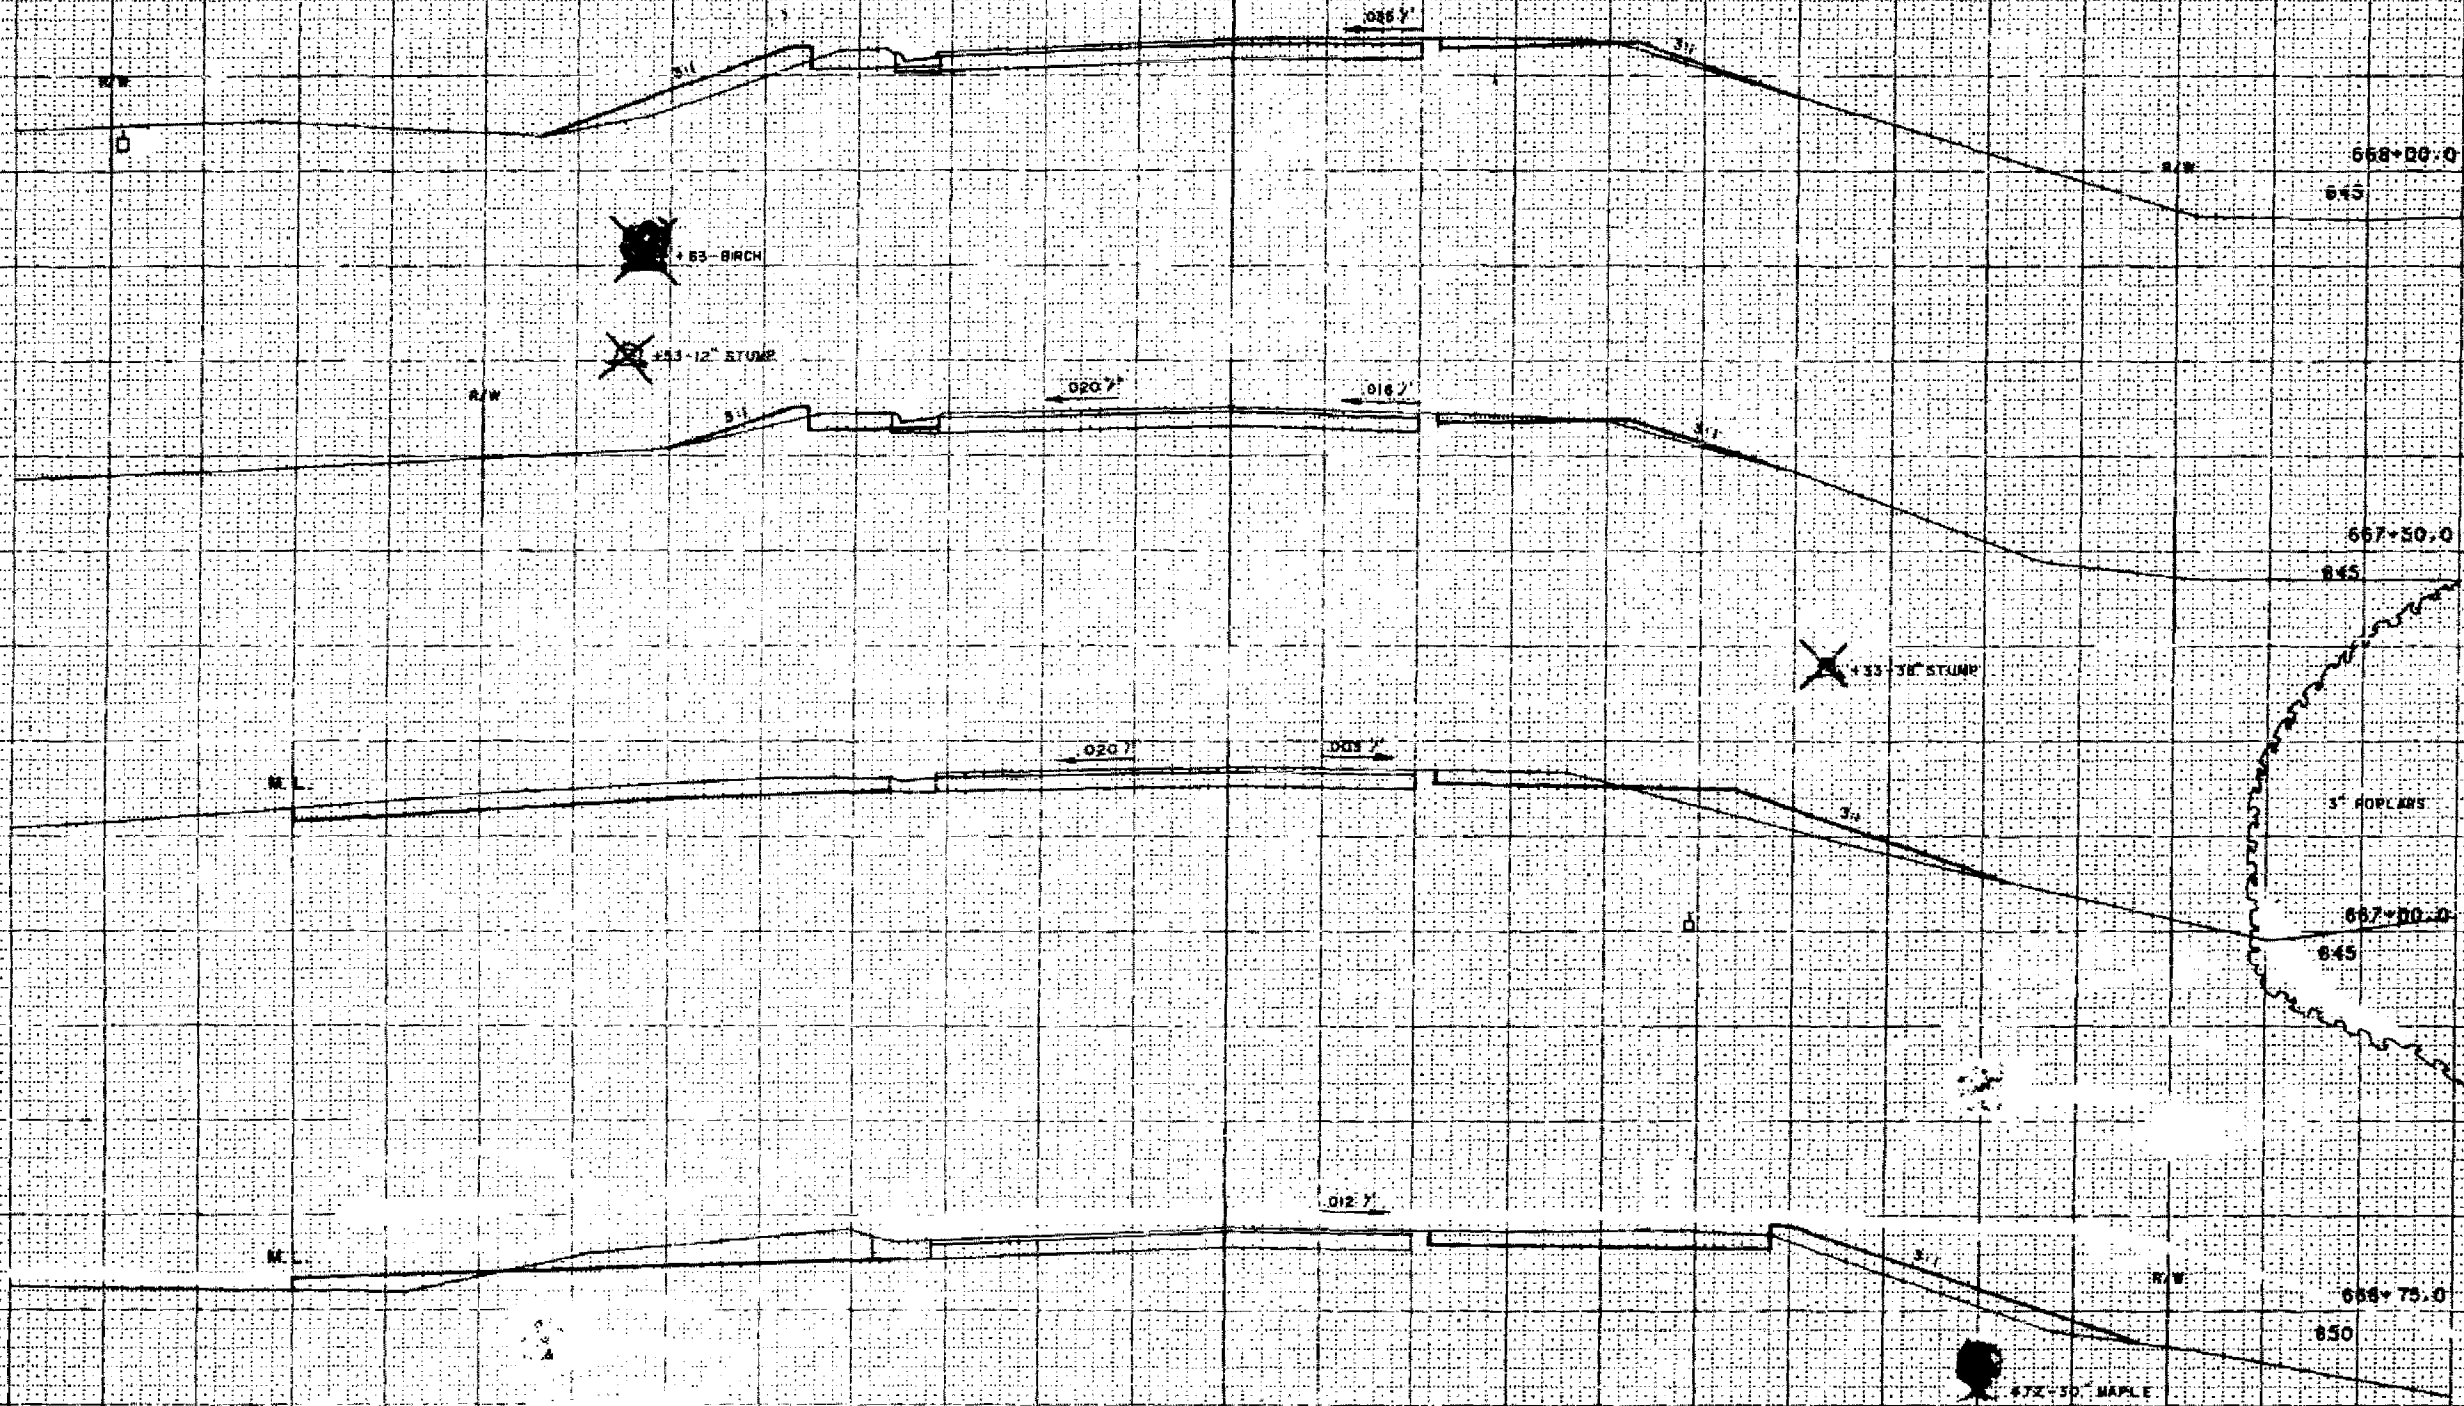

1 = OS HOR
1 = OS VER
SHEET NO 1 1110-2-71

SURVEY 1

STATE PROJECT NUMBER
4140-2-71
9/2

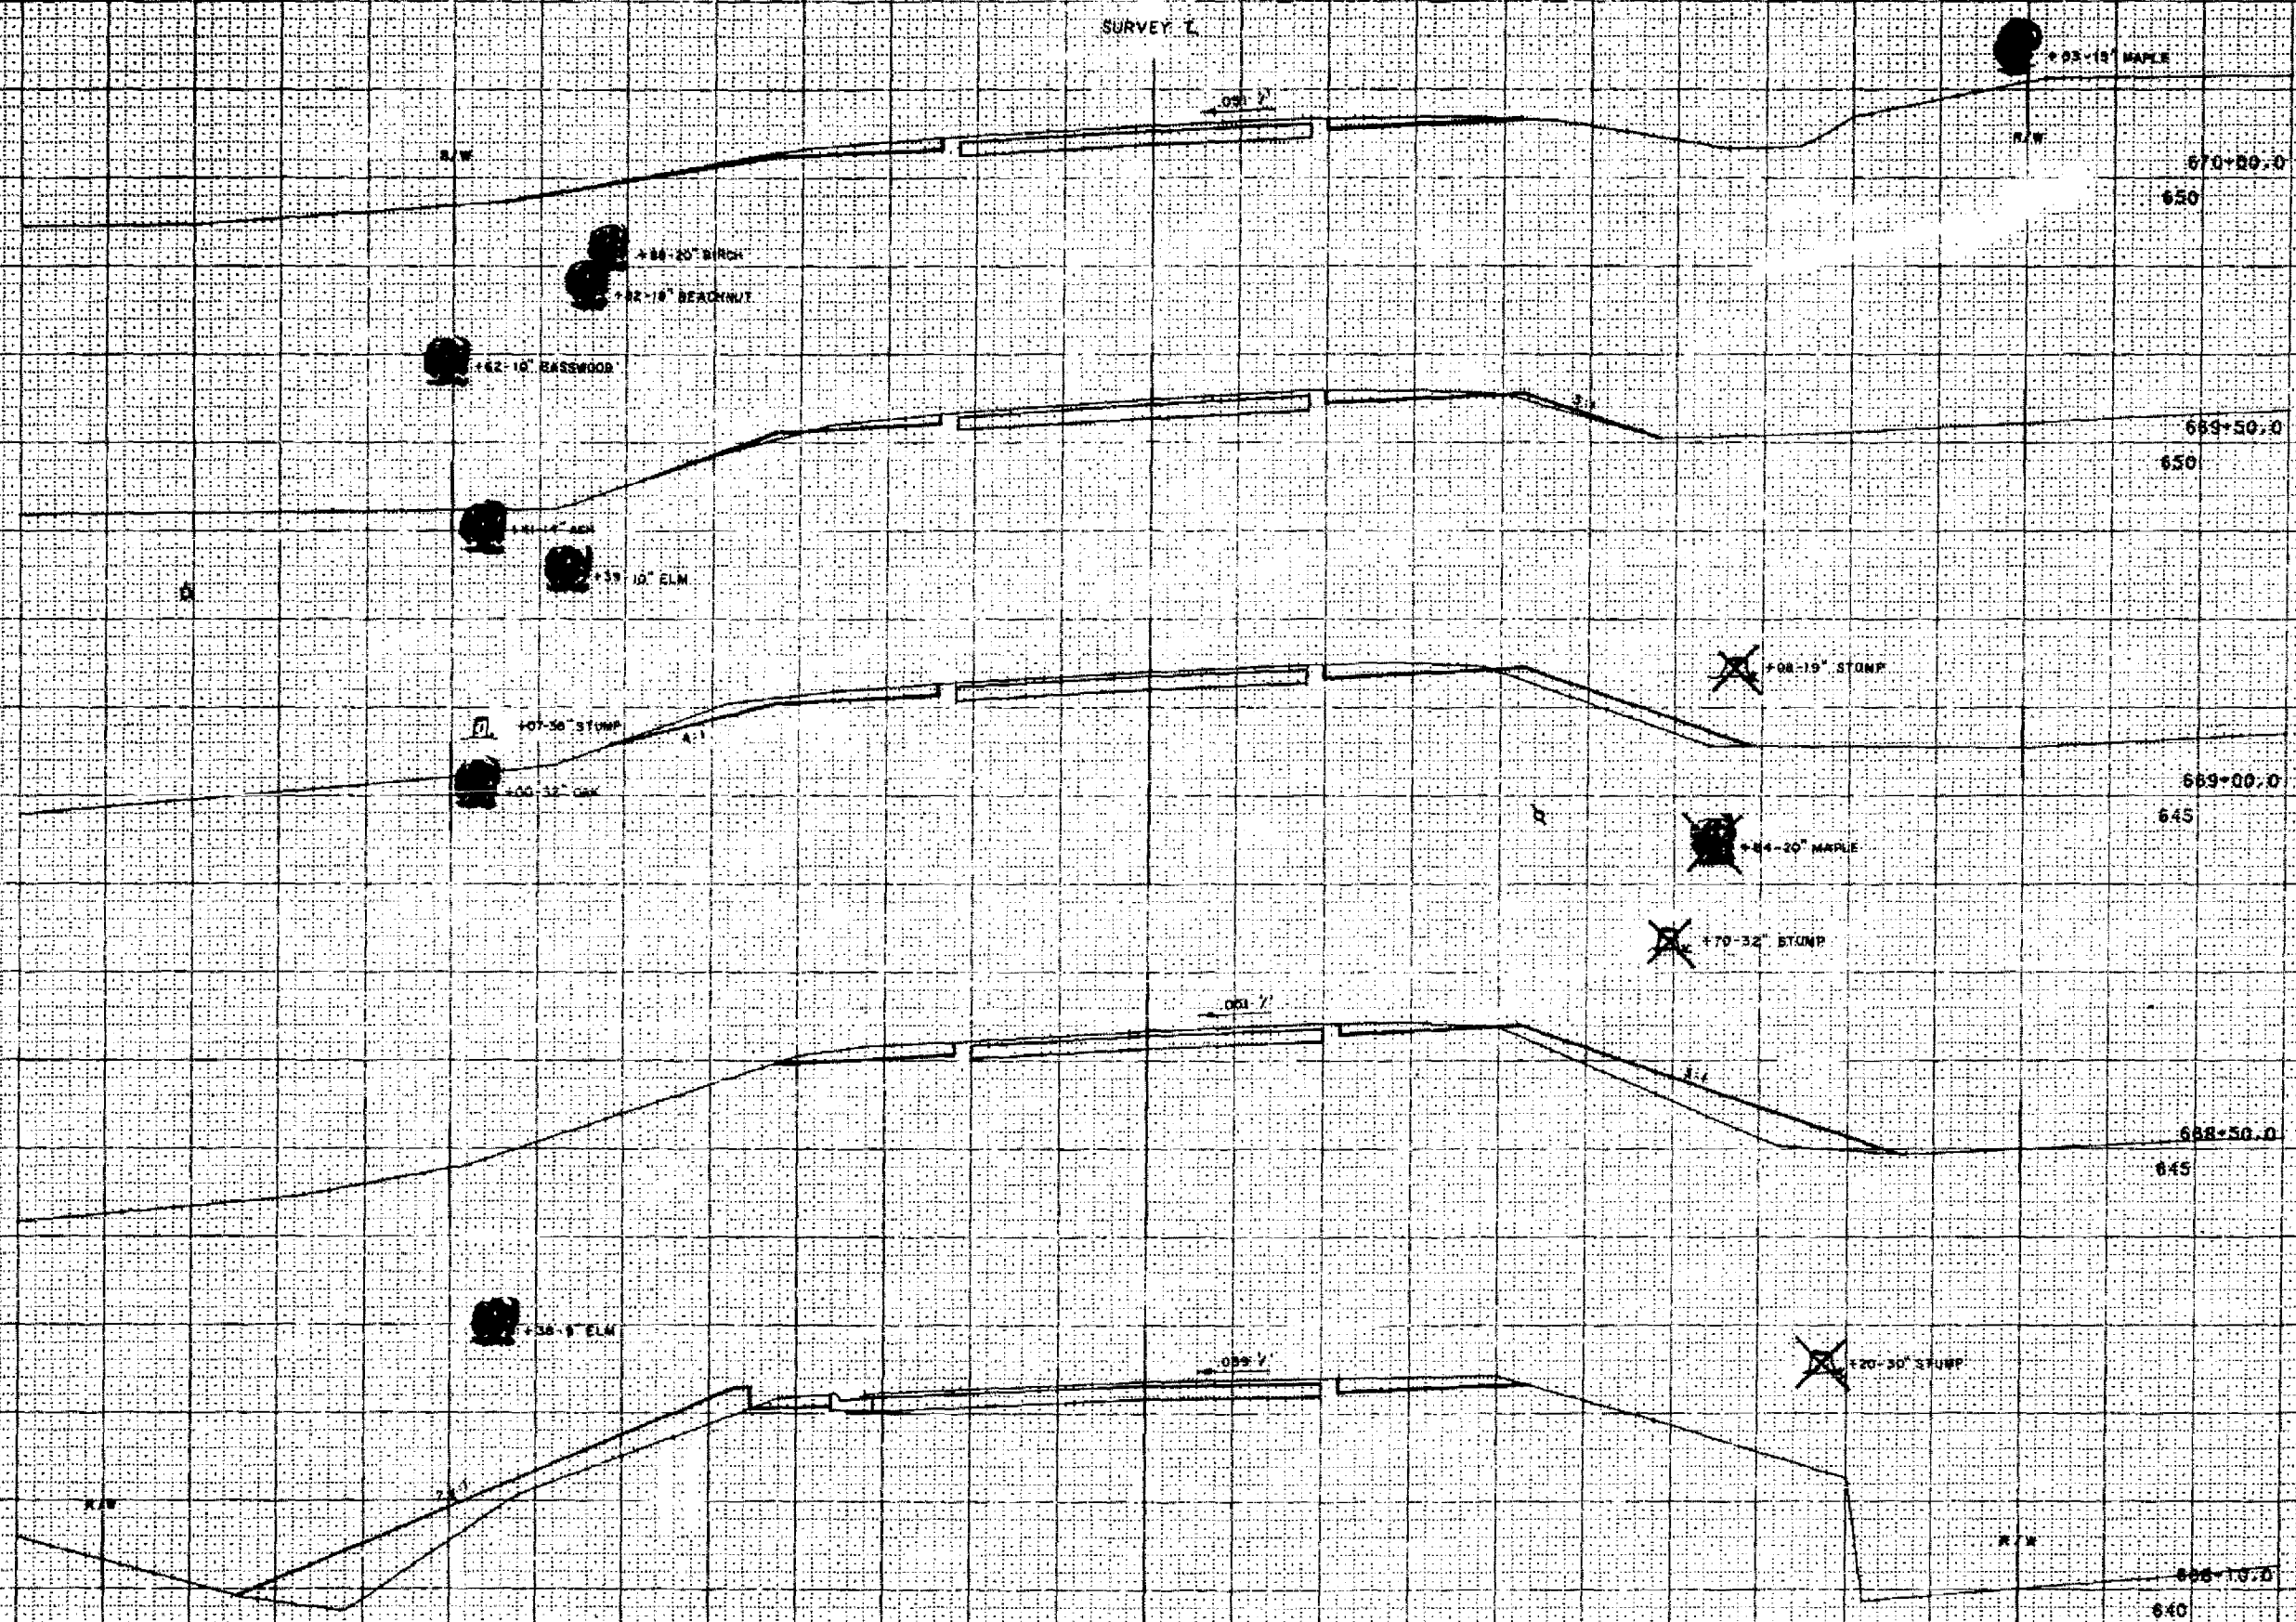

SURVEY 1

STATE PROJECT NUMBER

4160-2-71

9/13

673+00.0

655

+82-55' 41.8

672+50.0

655

672+00.0

655

+45-16' SPRUCE

+77-CEGAR HEDGE

+63-14' MAPLE

+4-10' MAPLE

+48-35' MAPLE 671+50.0

655

+25-4' FLOWERING
OAKS

SHRUBS

671+00.0

655


+78-2' CHERRY


+79-18' BEACHNUT

+50-5' BOX ELDER

670+50.0

630

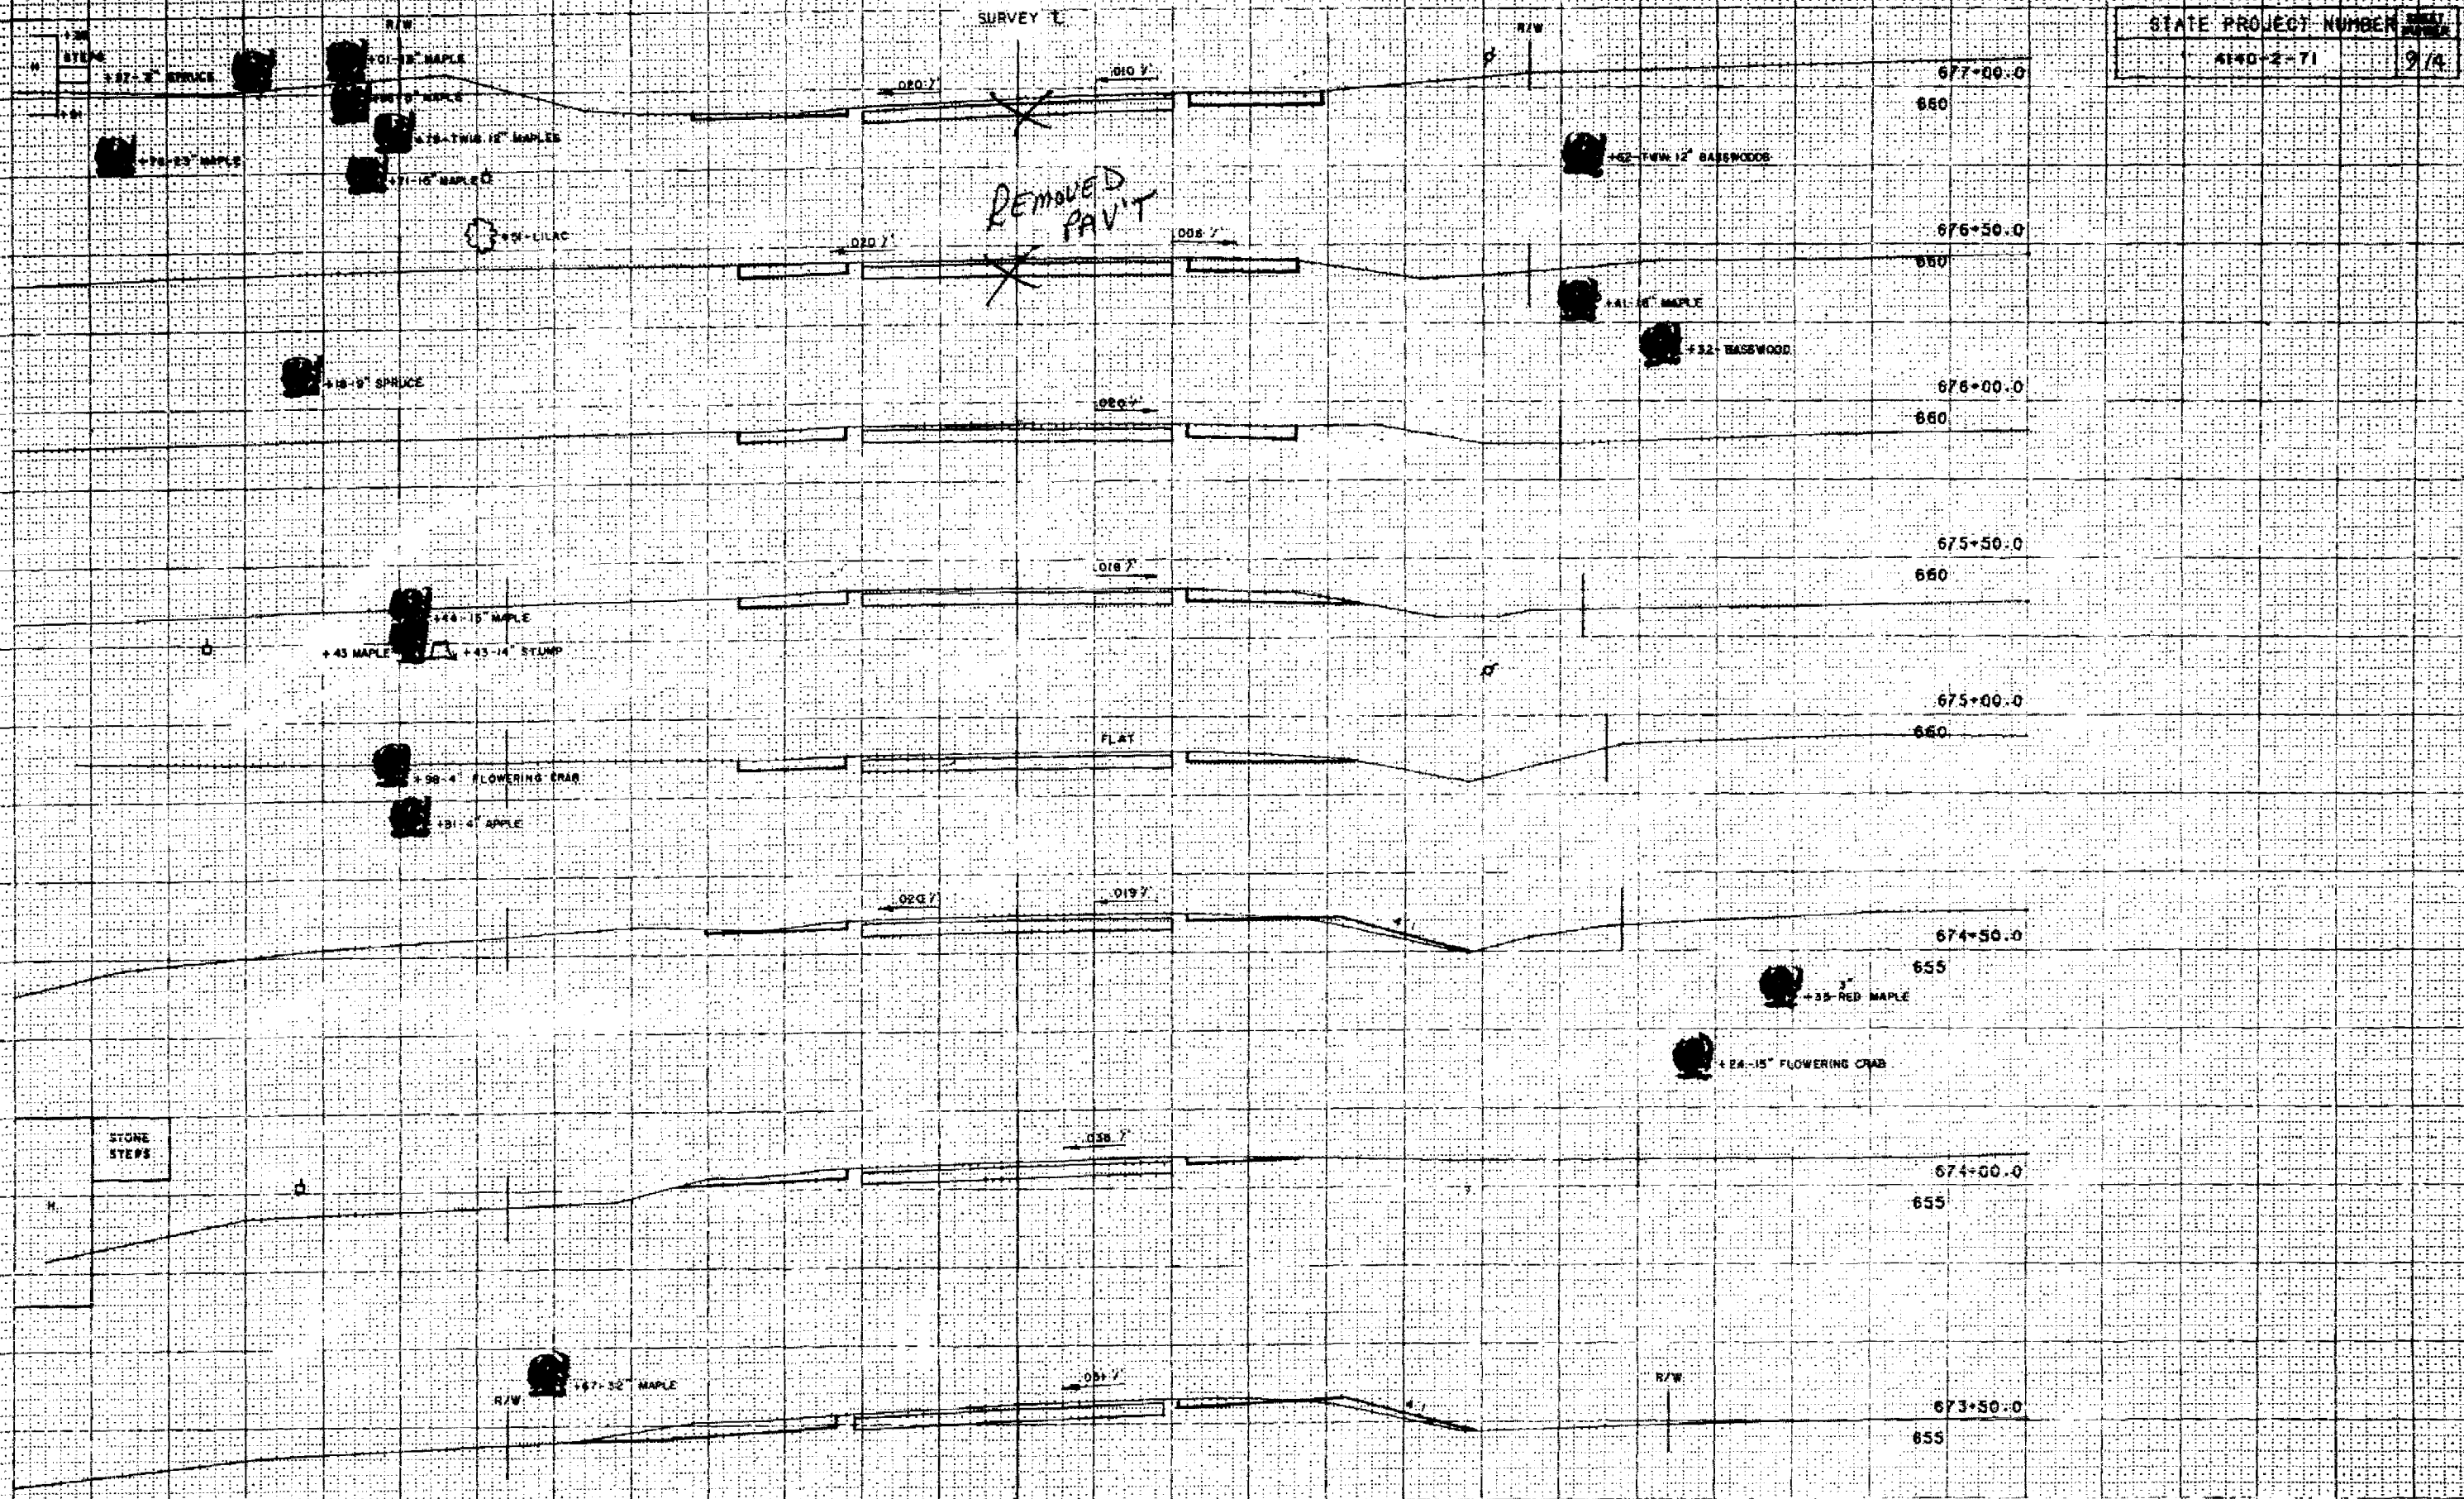

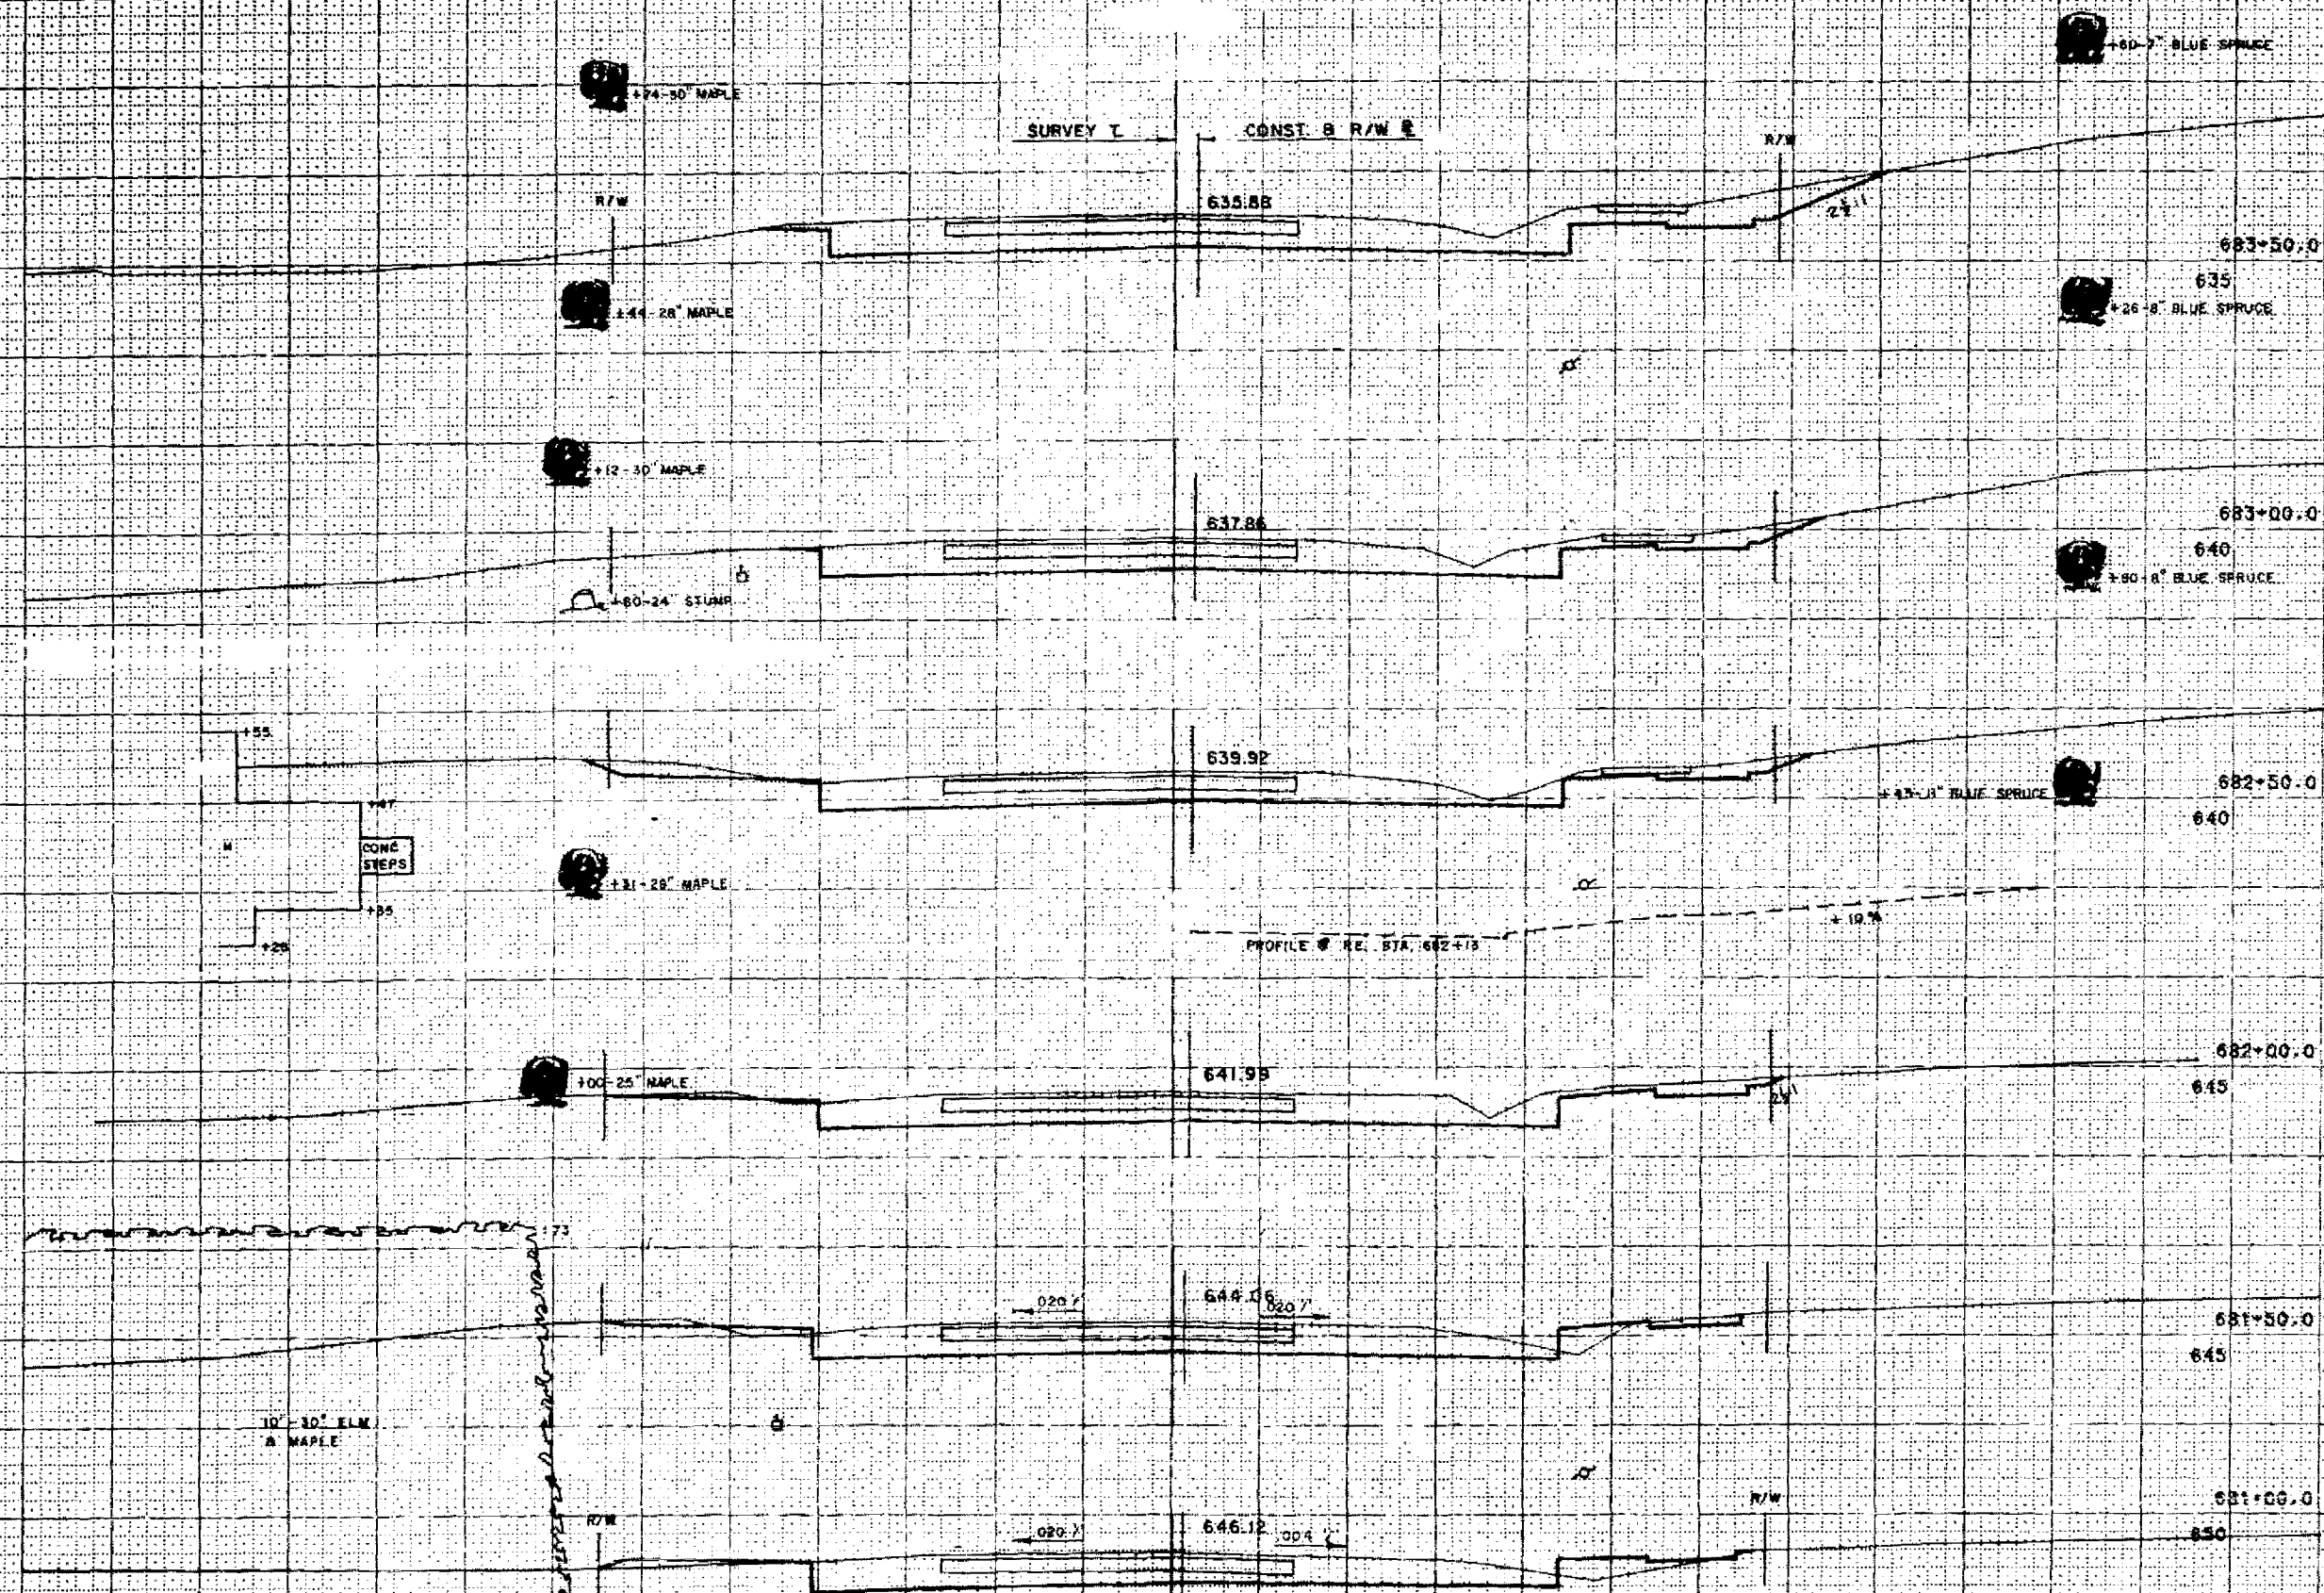

1 = OS HOR
1 = OS VER

STATE PROJECT NUMBER

4140-2-71

2.17

4'-30" MAPLES

SURVEY E

CONST. E. R/W. E

631.05

48'-24" STUMP

686+50.0

635

686+00.0

635

631.29

631.41

686+75.0

635

4'-36" 50" MAPLE

631.55

685+50.0

635

4'-27" 24" MAPLE

631.77

685+25.0

635

4'-19" 27" MAPLE

632.09

685+00.0

635

4'-15" 12" STUMP

4'-08" 64" LOCUST CLUMP

4'-01" 50" PINE

4'-05" 24" LOCUST

M.L.

4'-10" 50" MAPLE

632.99

684+50.0

635

4'-42" 21" MAPLE

4'-27" 25" MAPLE

4'-09" 09" MAPLE

634.25

684+00.0


635

4'-17" 12" BLUE SPRUCE

4'-10" 10" BLUE SPRUCE


1" = 20' HOR.
1" = 20' VER.

SHEET NO. 3 3183

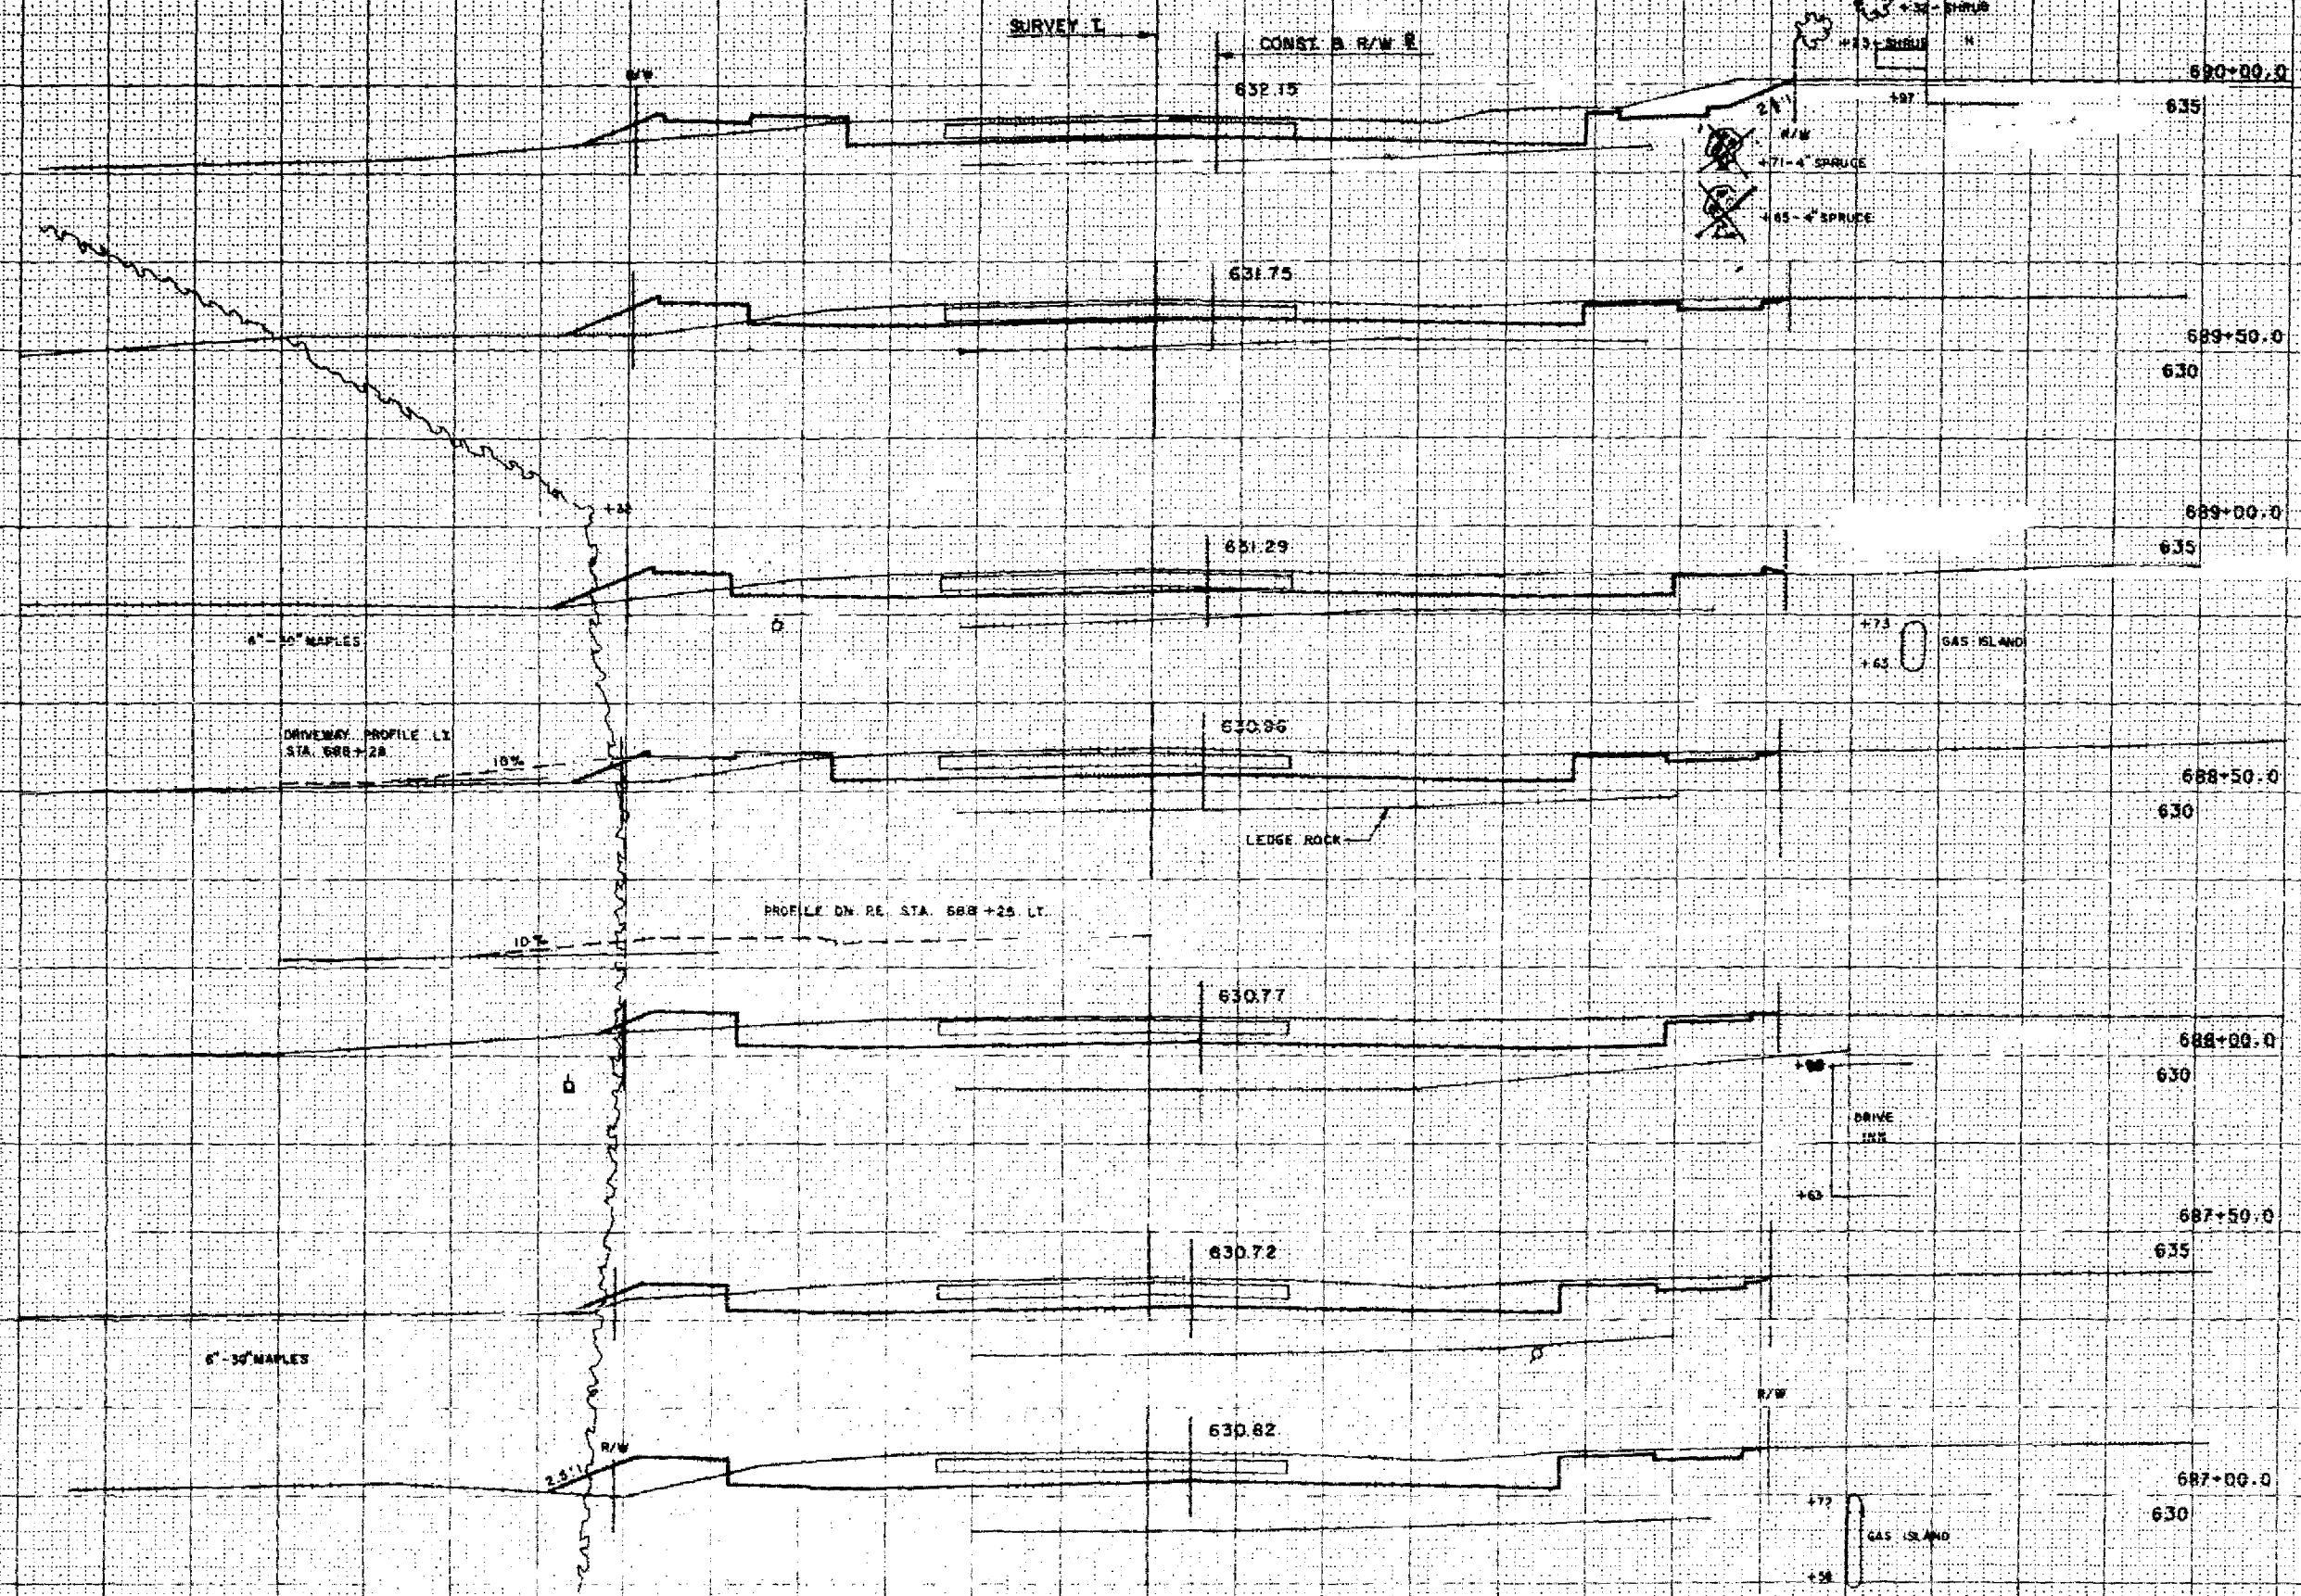


STATE PROJECT NUMBER 11

4E40-2-71 1979

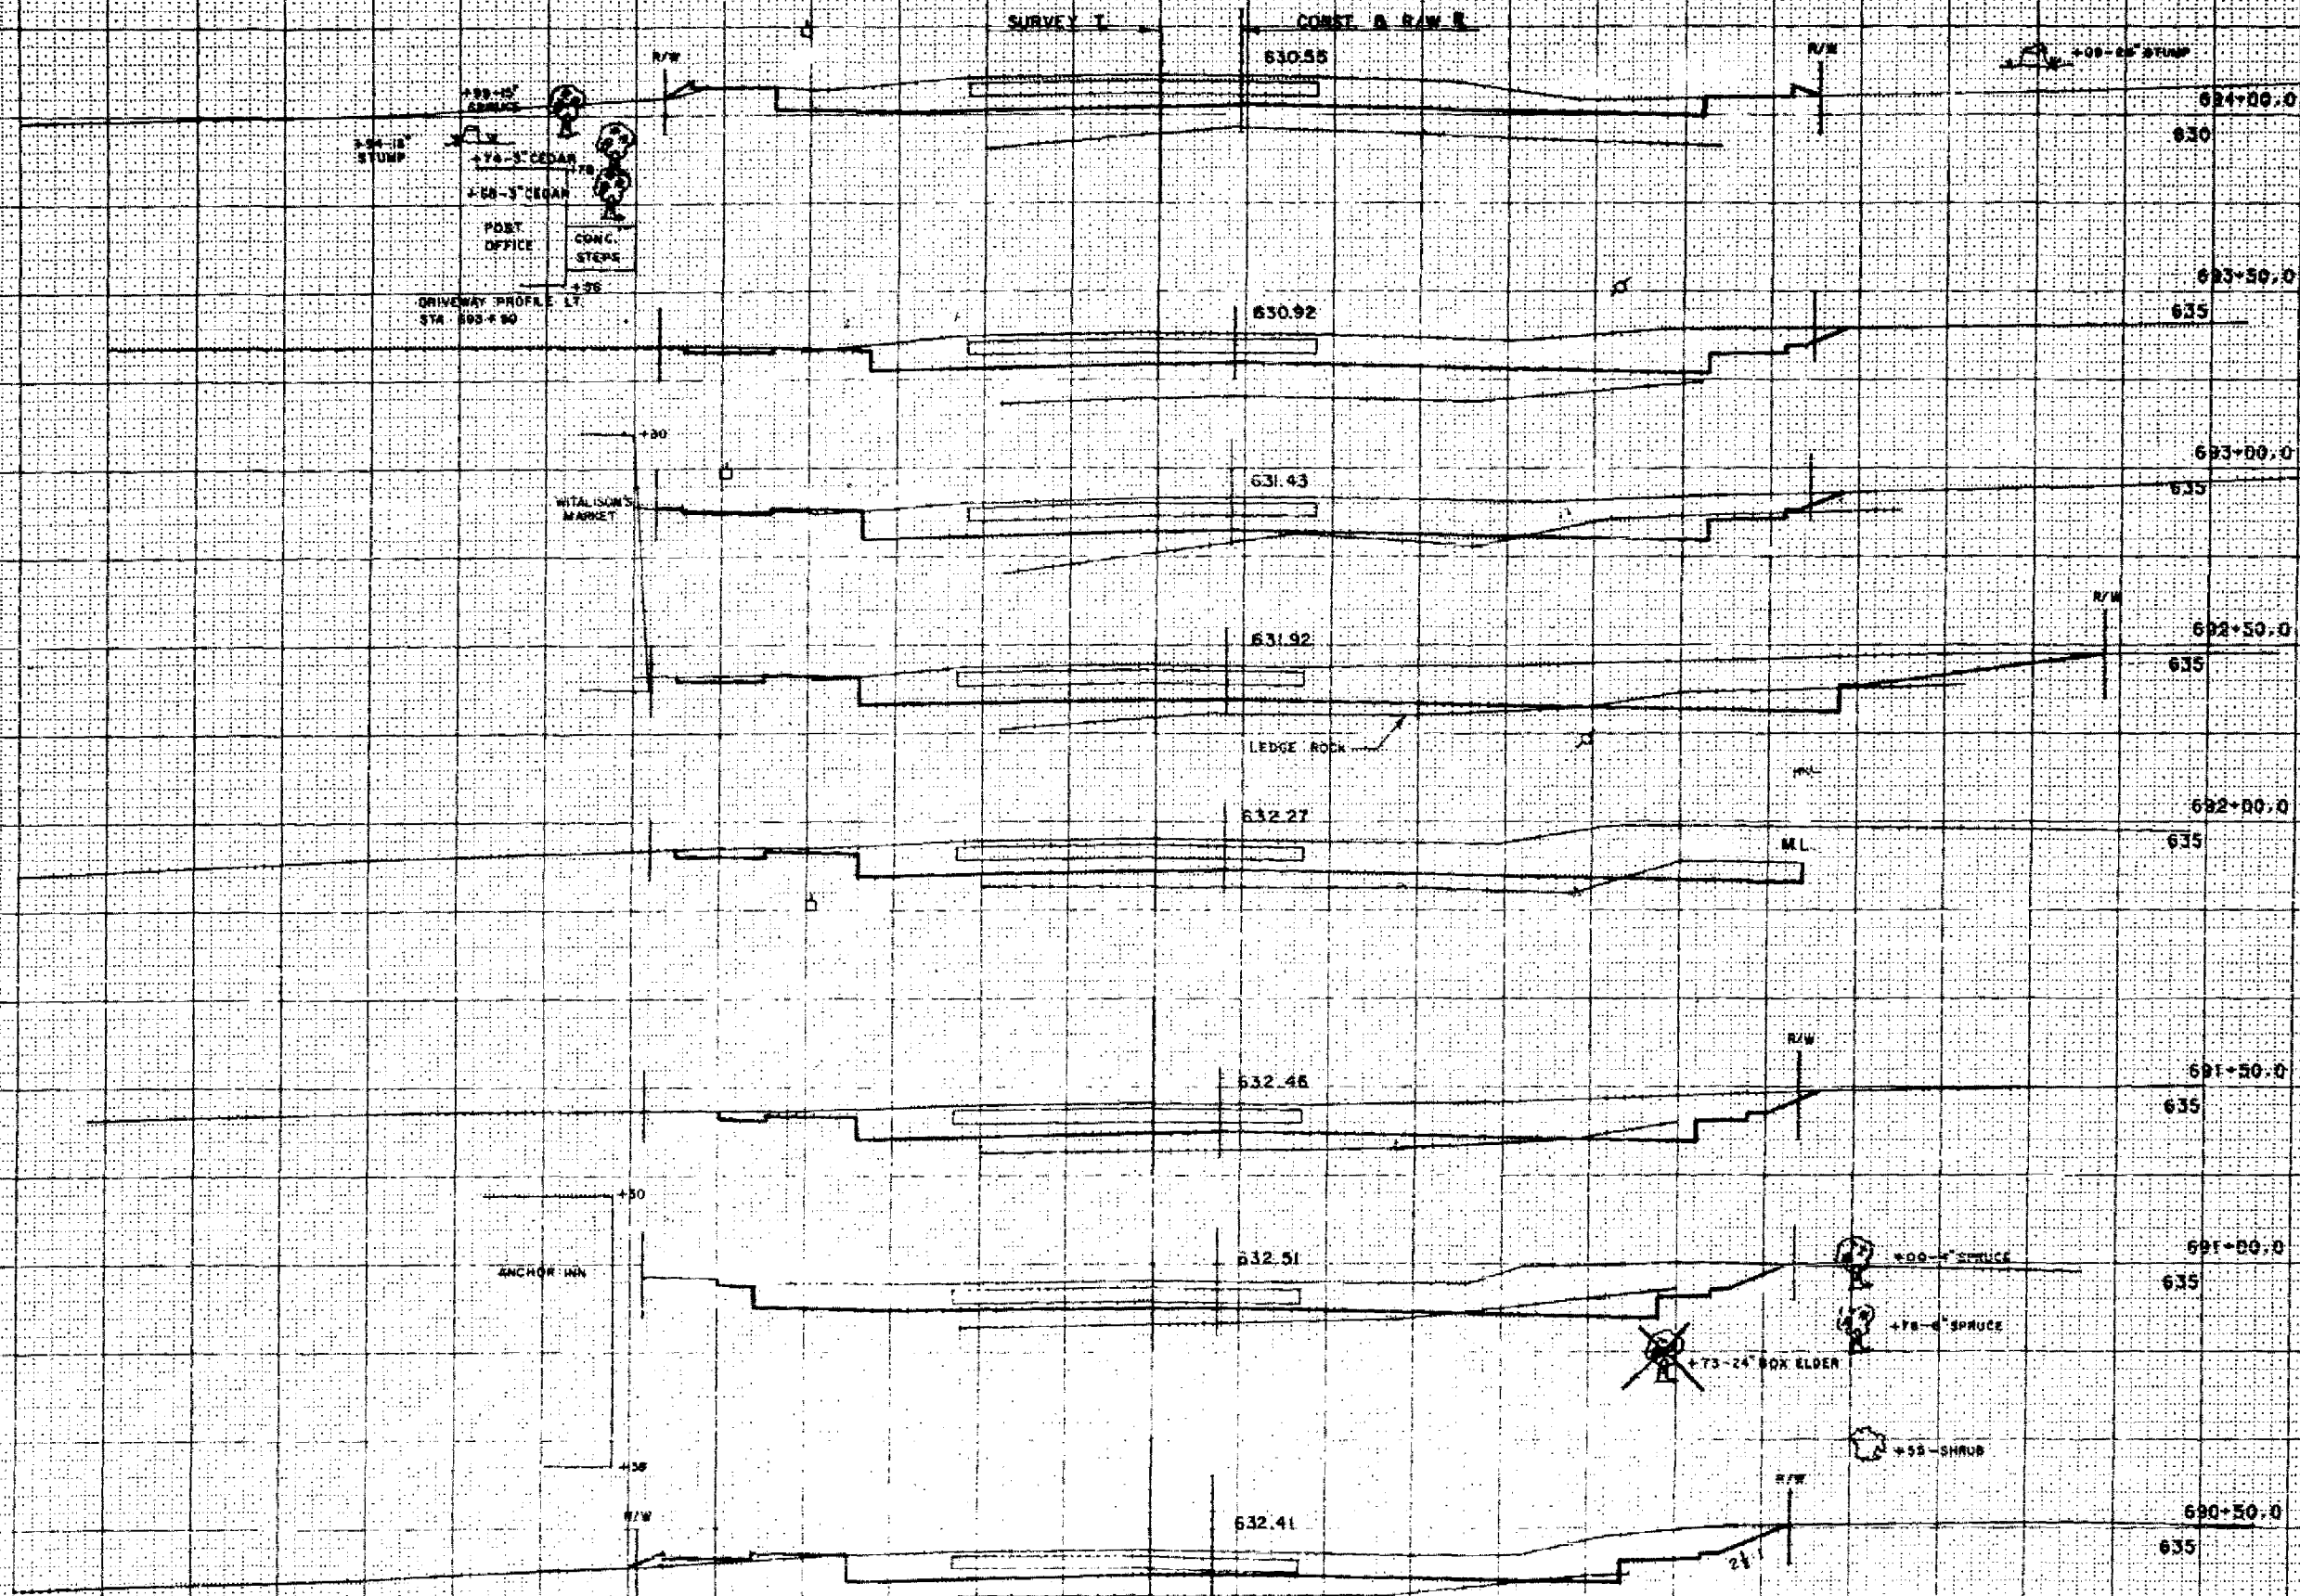


SHEET NO 11
1 - 05 HOR
1 - 05 VER
3153

STATE PROJECT NUMBER
4140-2-71 910

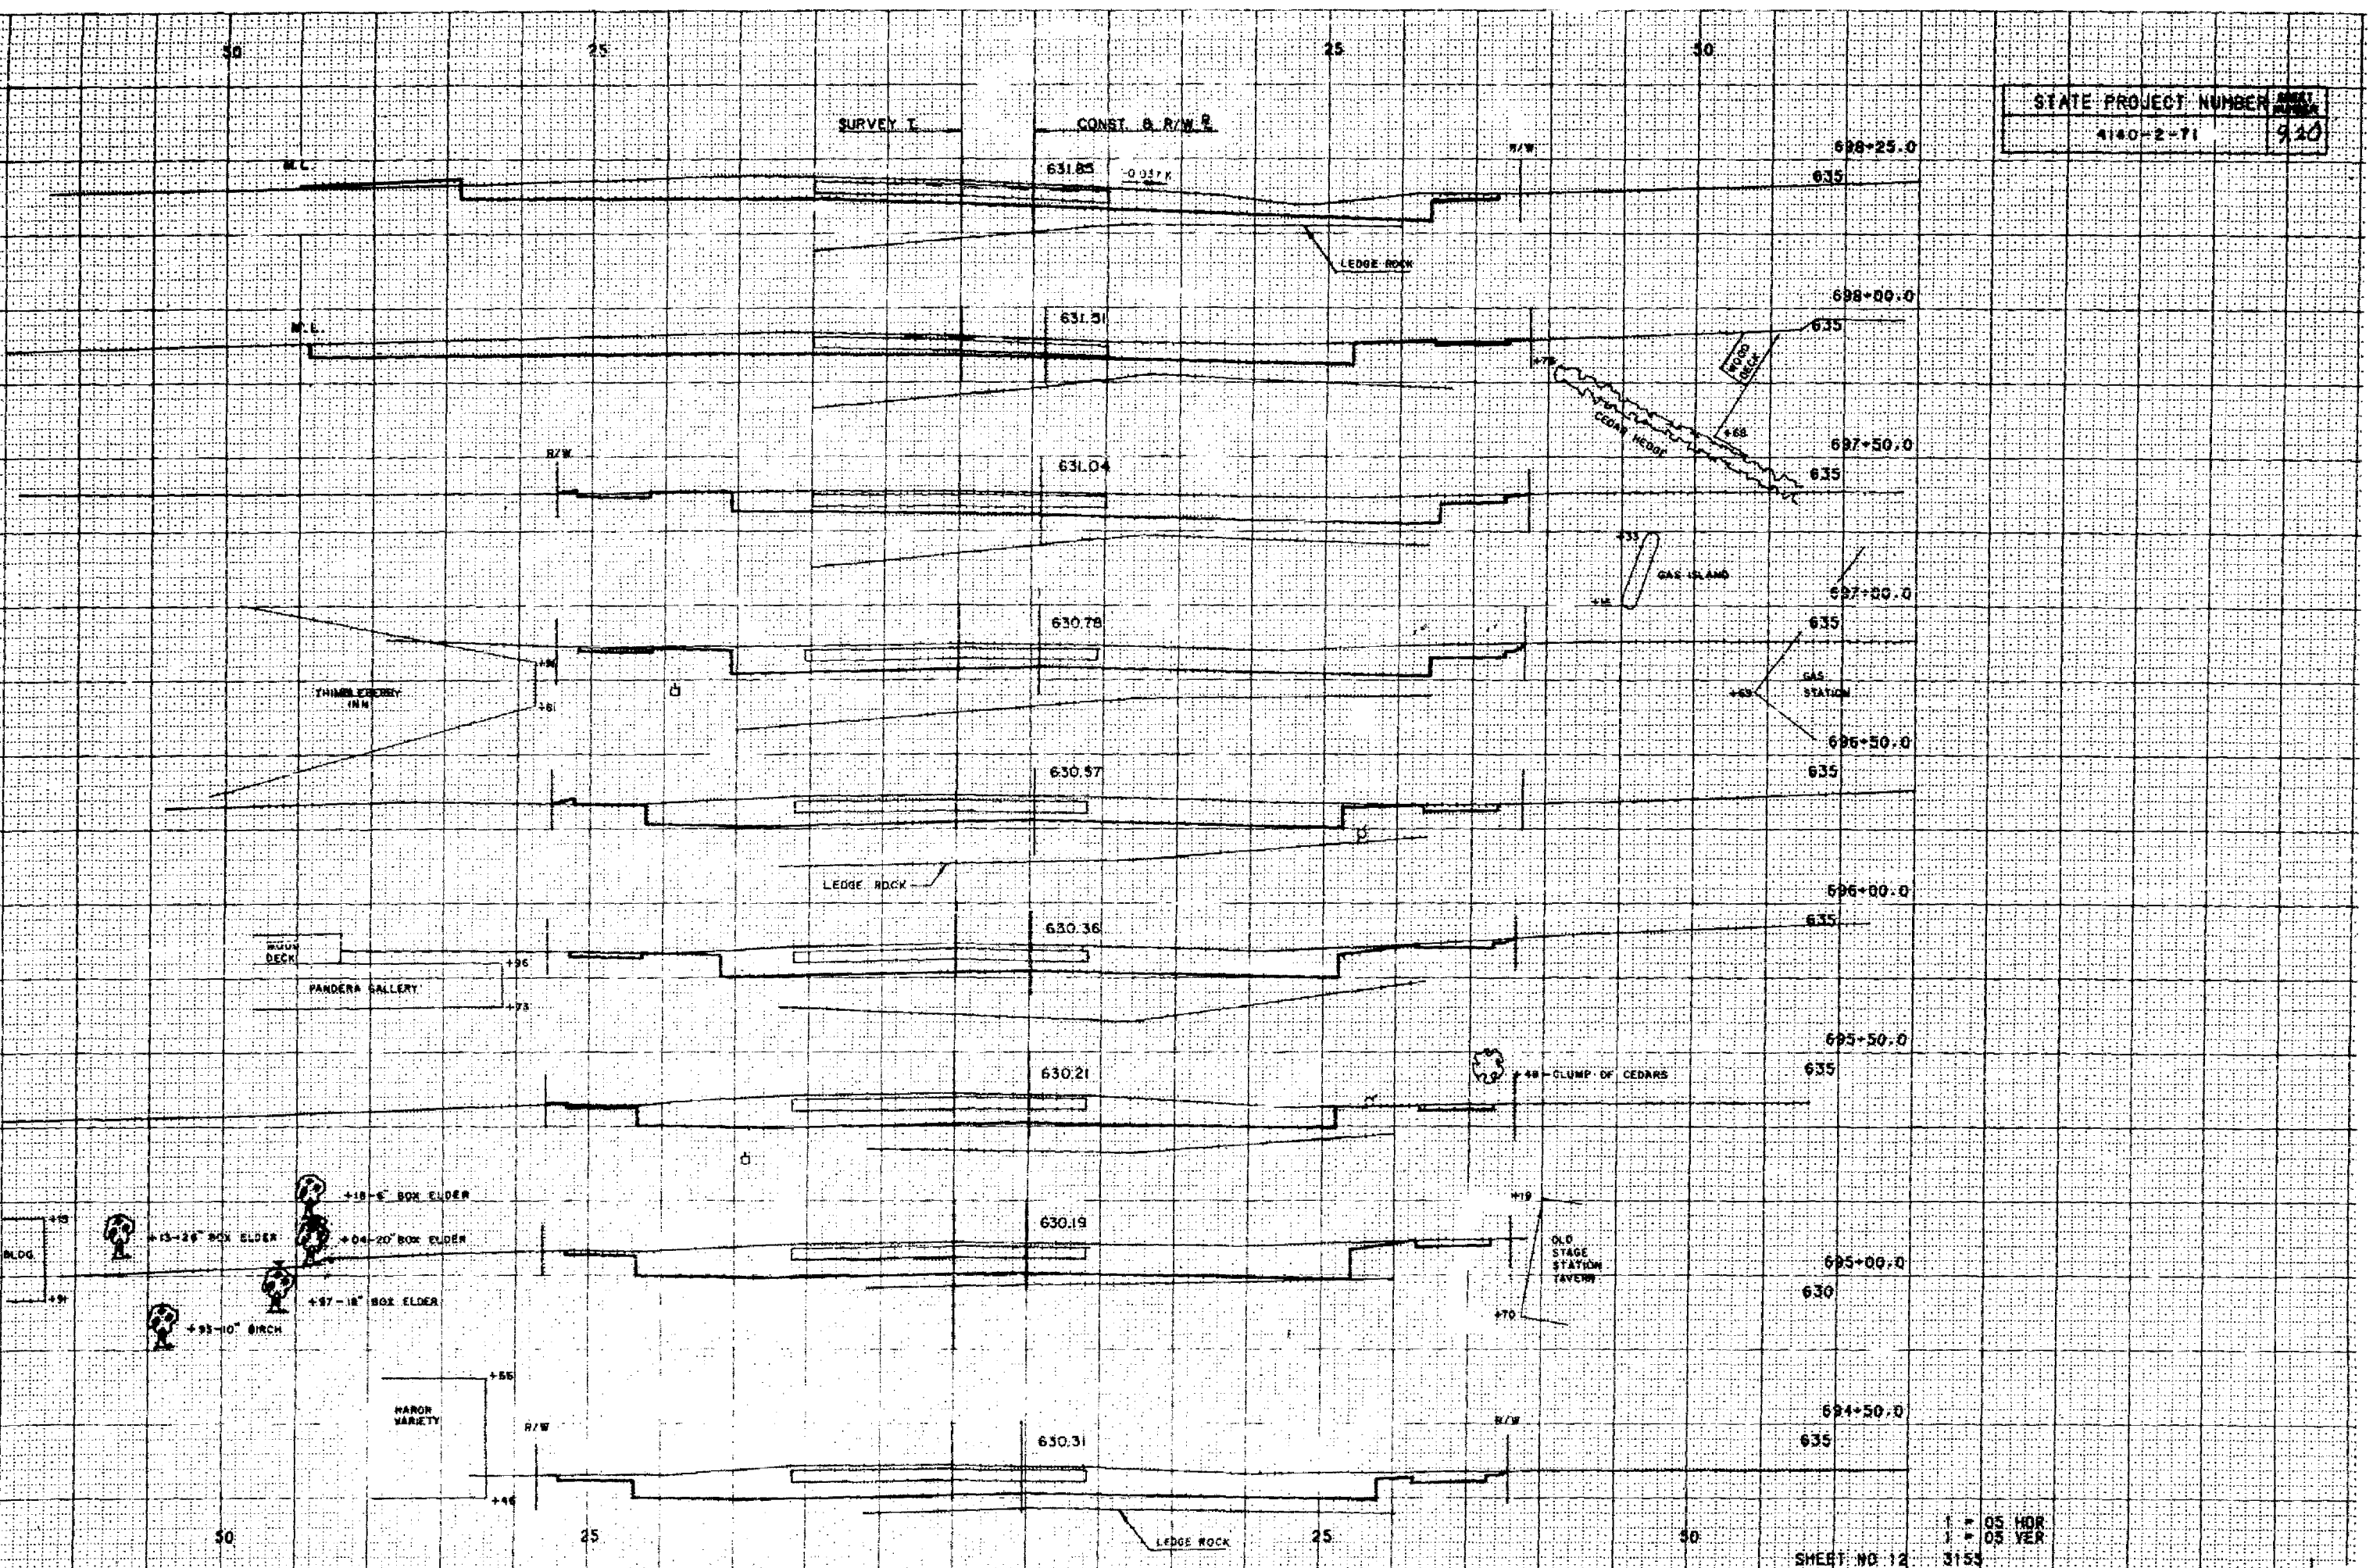


SURVEY T CONST. & R/W E

STATE PROJECT NUMBER
4140-2-71 921

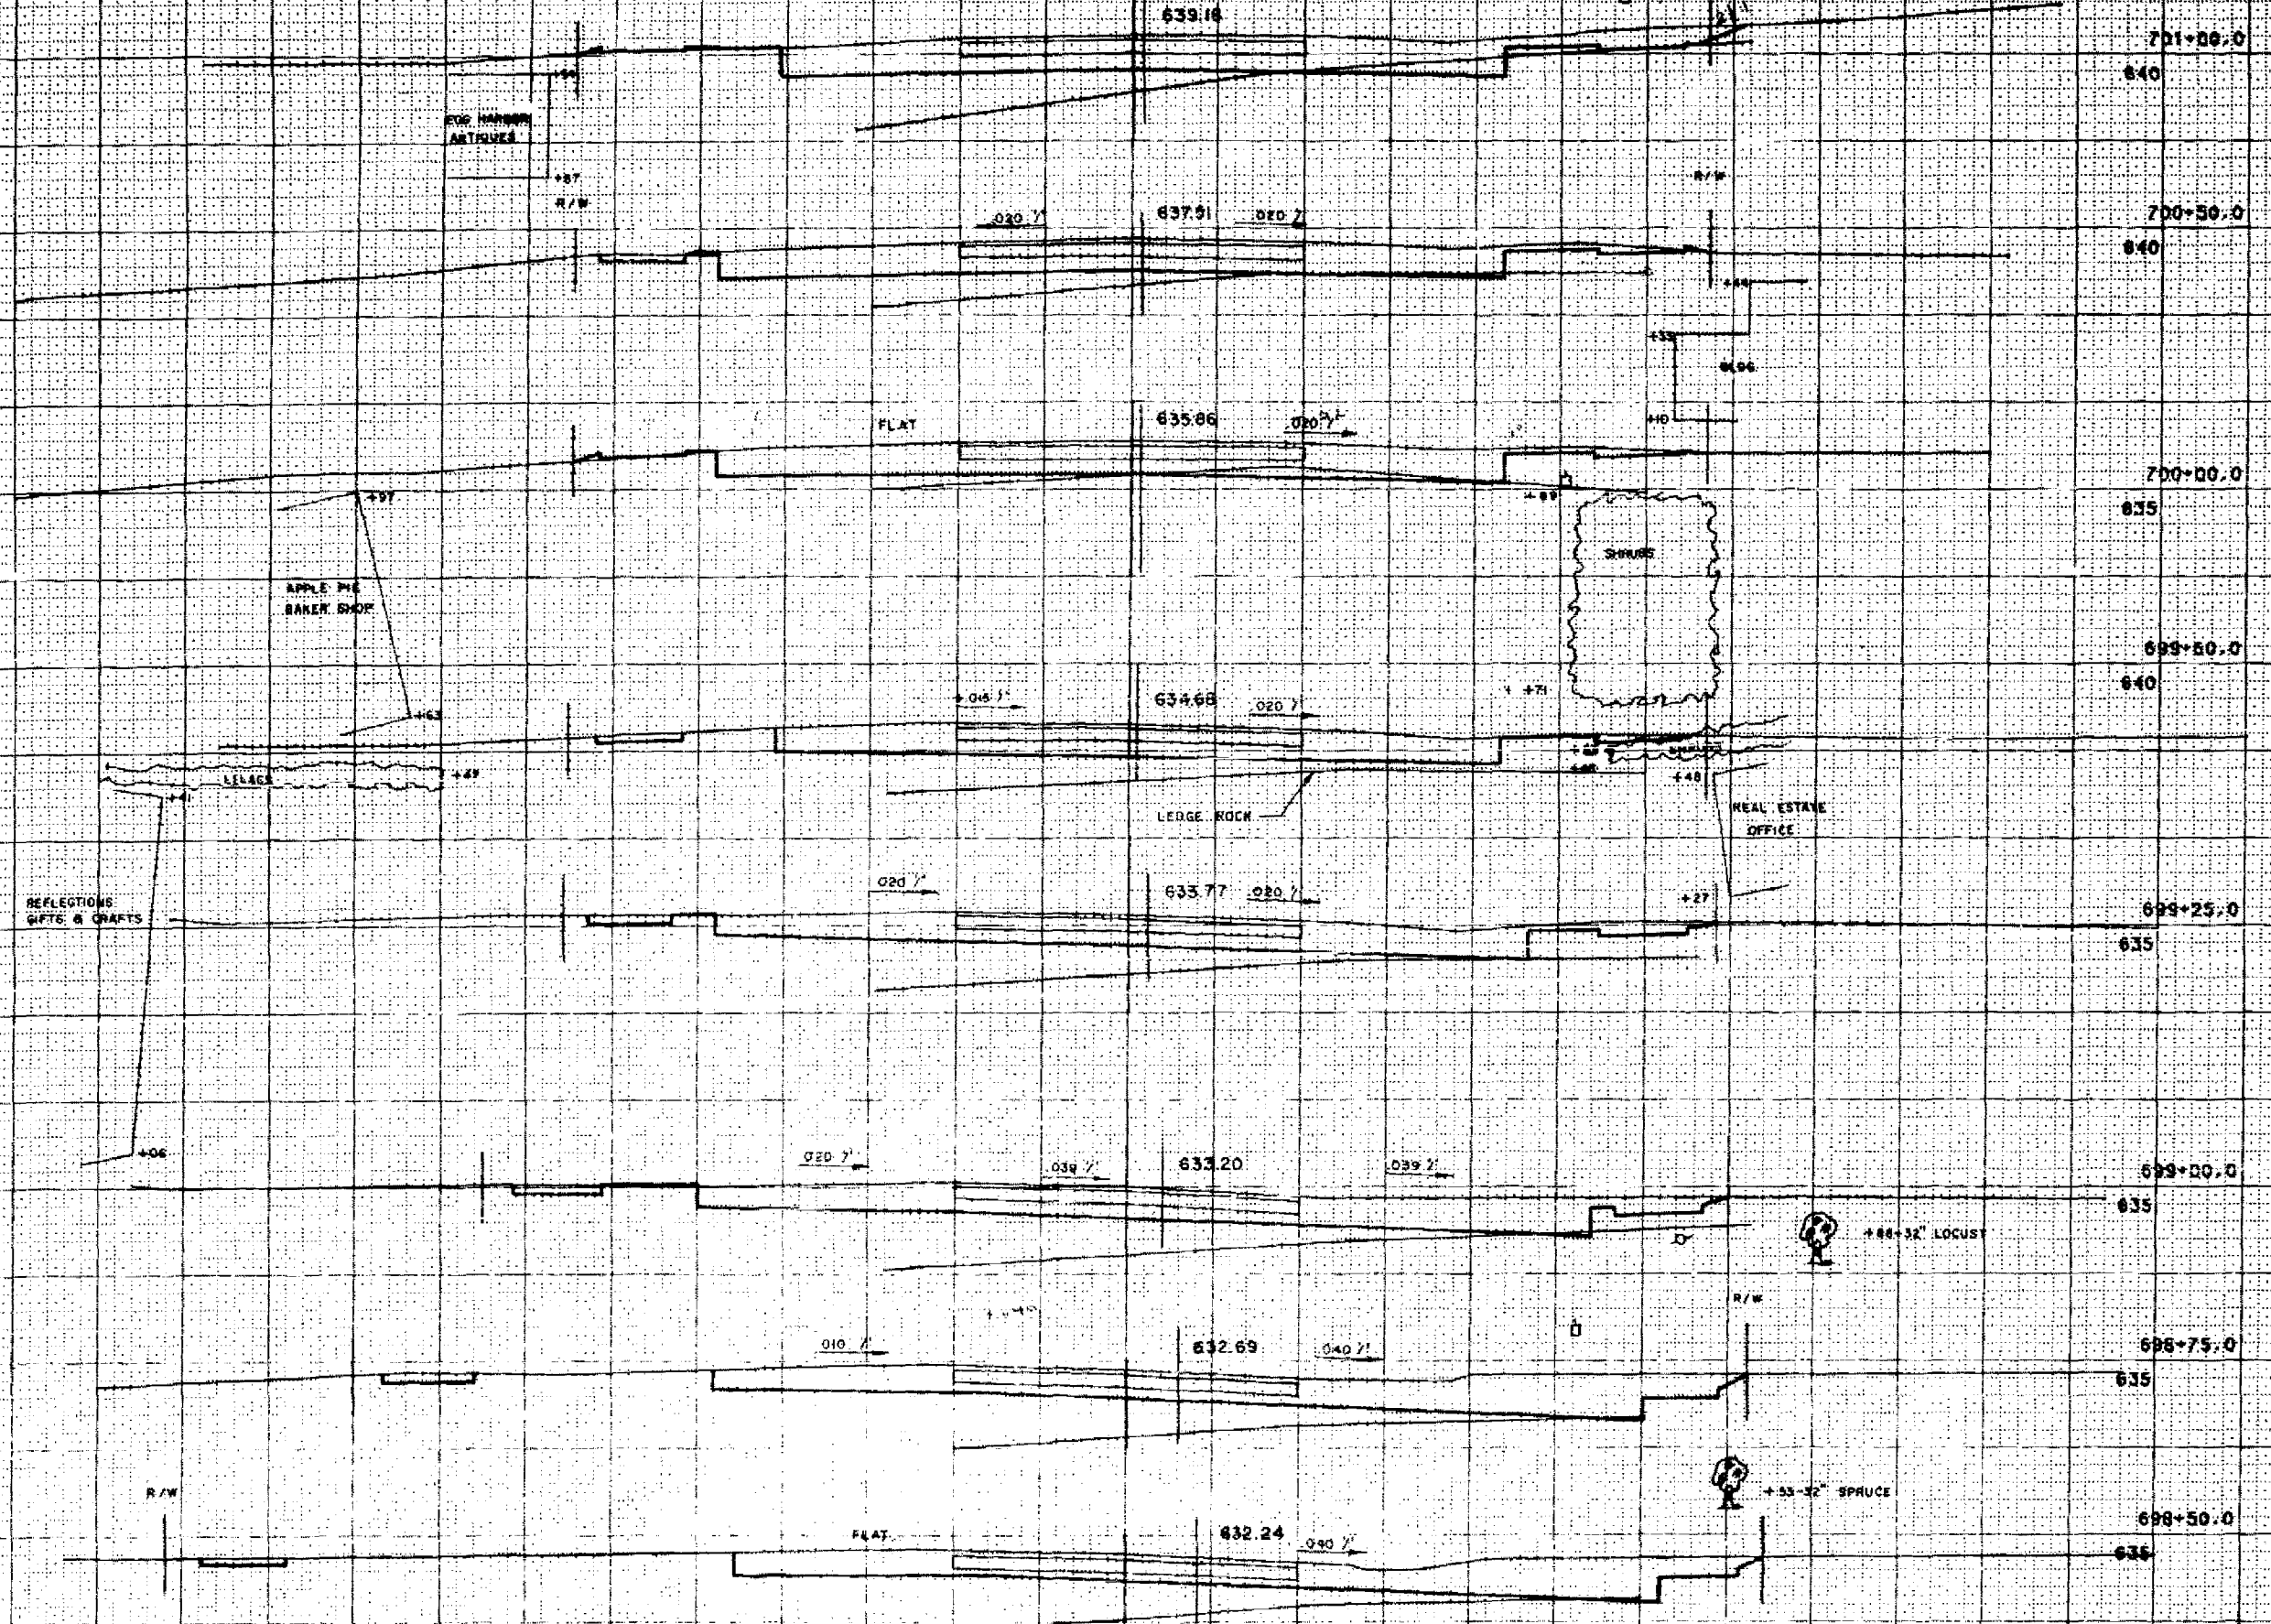



1" = 25' HOR
1" = 5' VER
SHEET NO 13 3153

STATE PROJECT NUMBER
4140-2-71
922

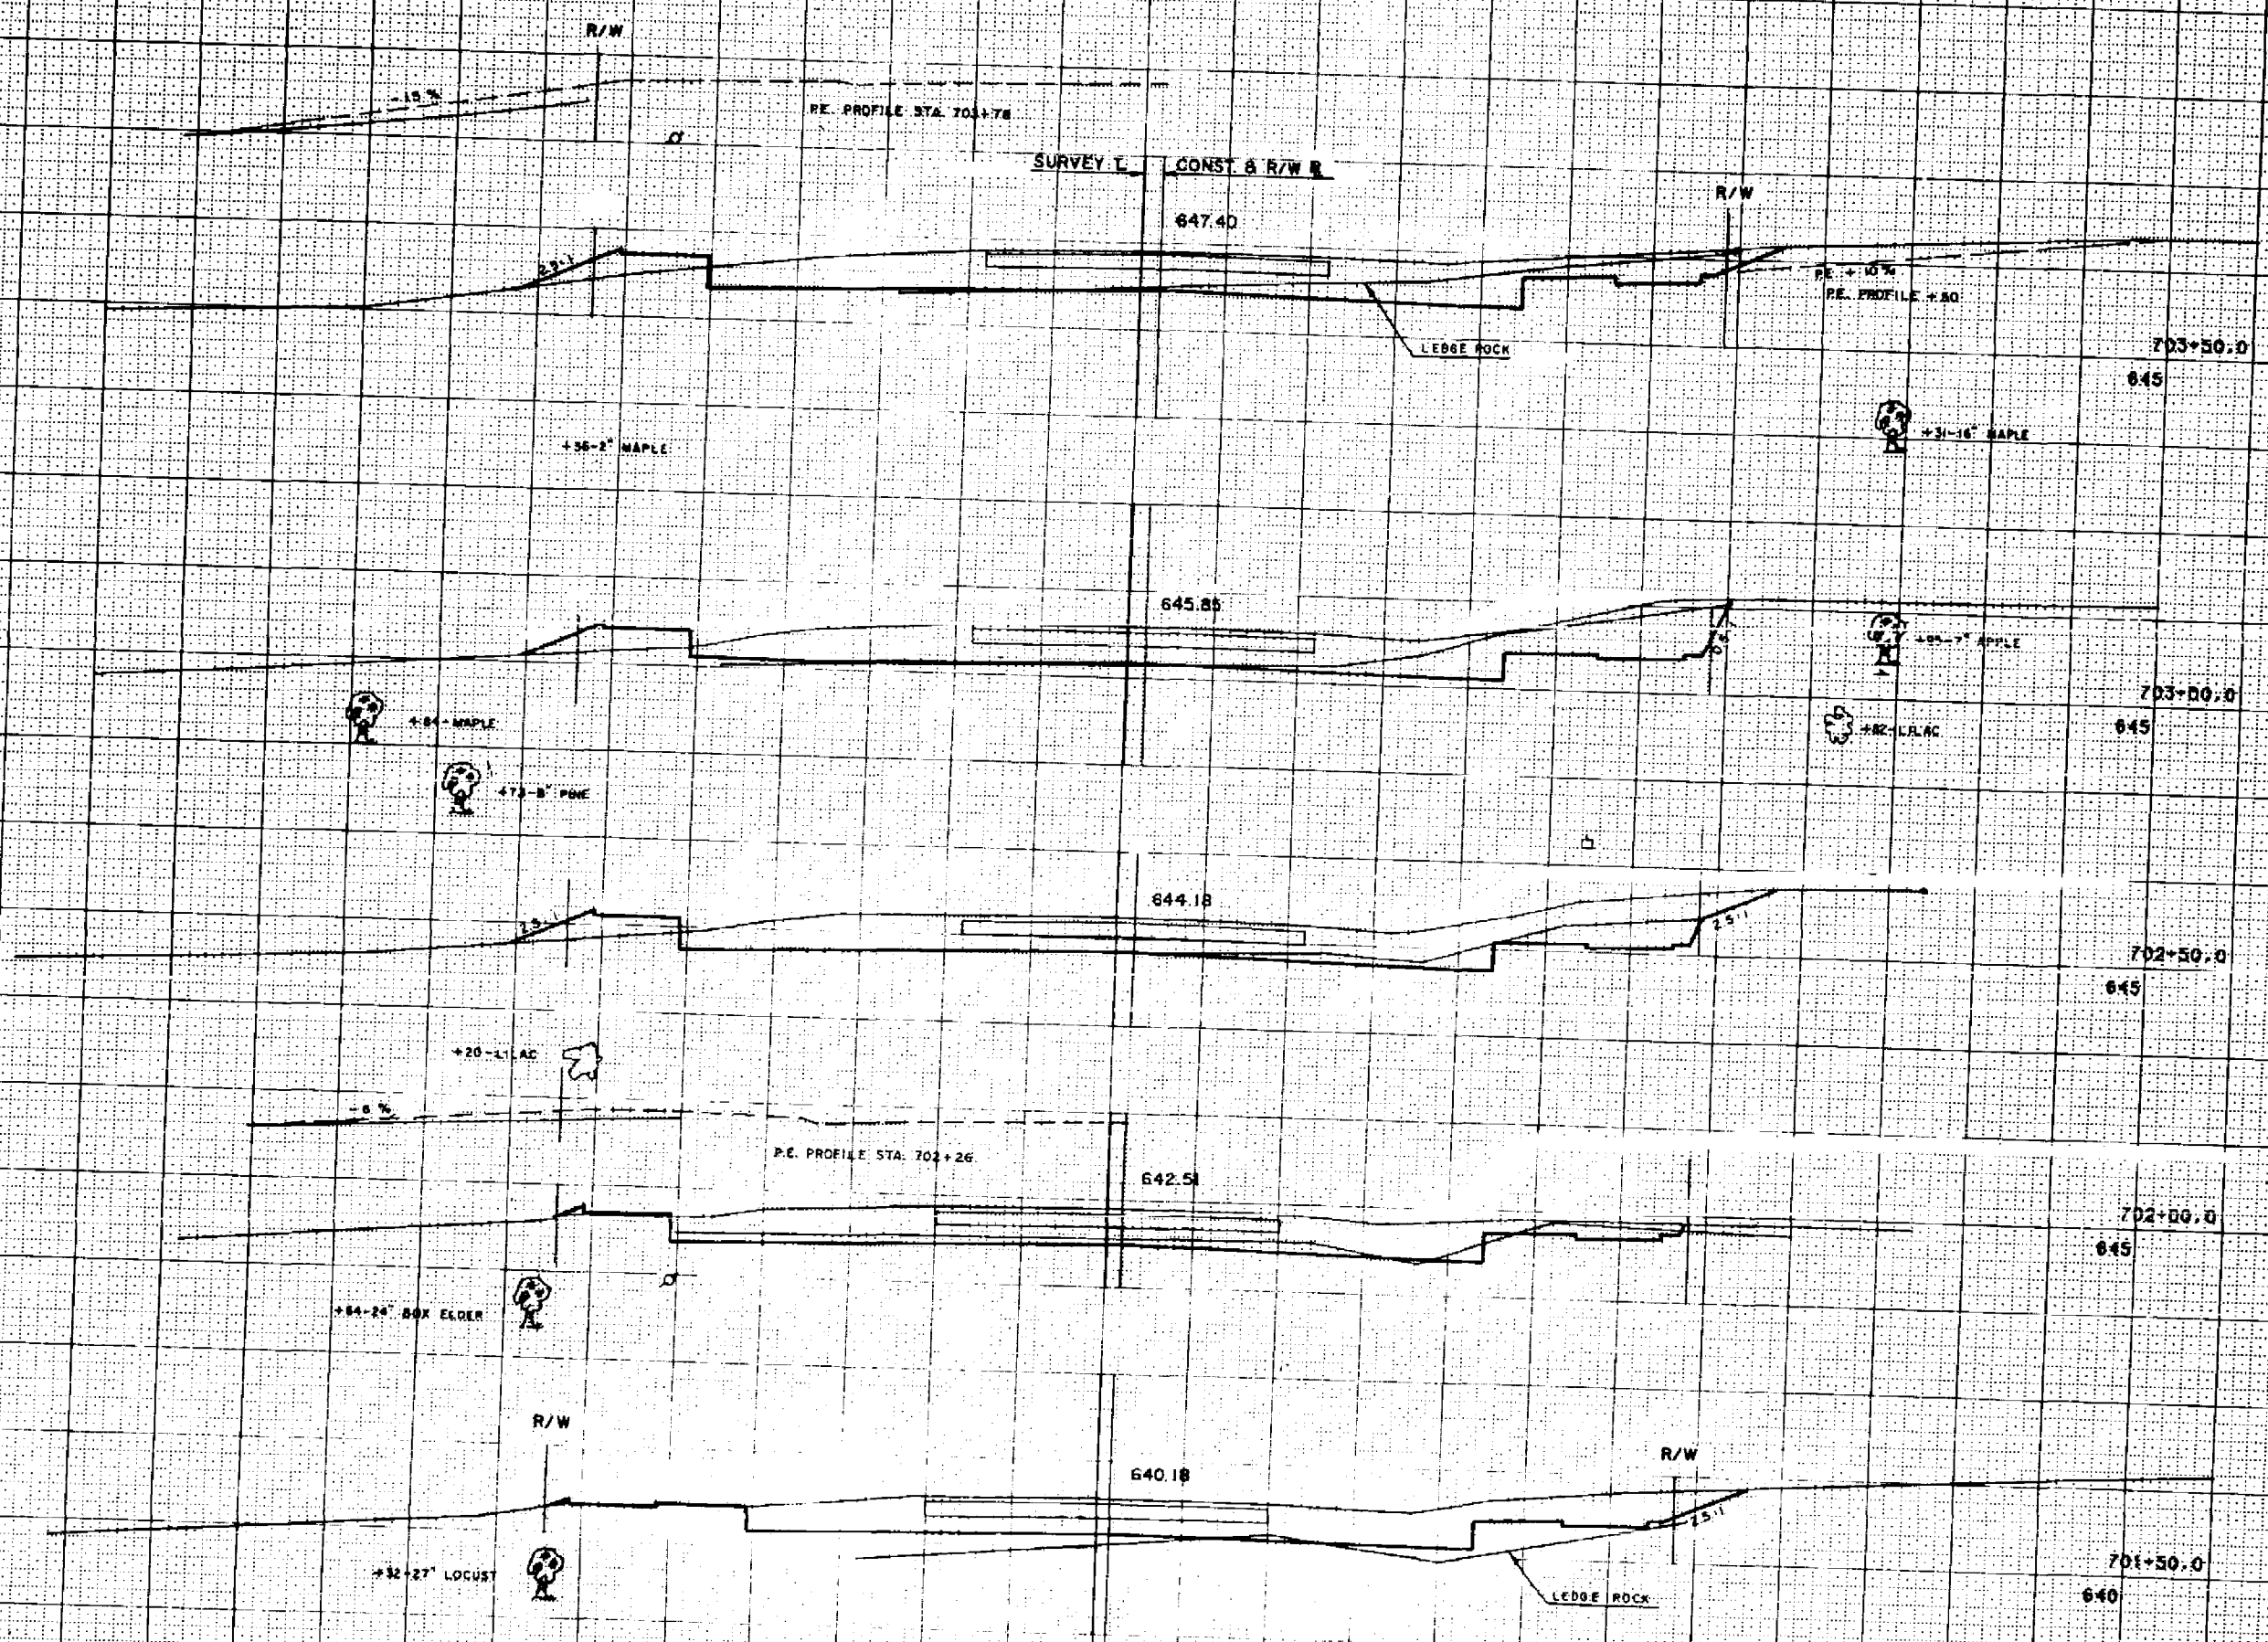

SHEET NO. 14
1155
1 - 05 HOR
1 - 05 VER

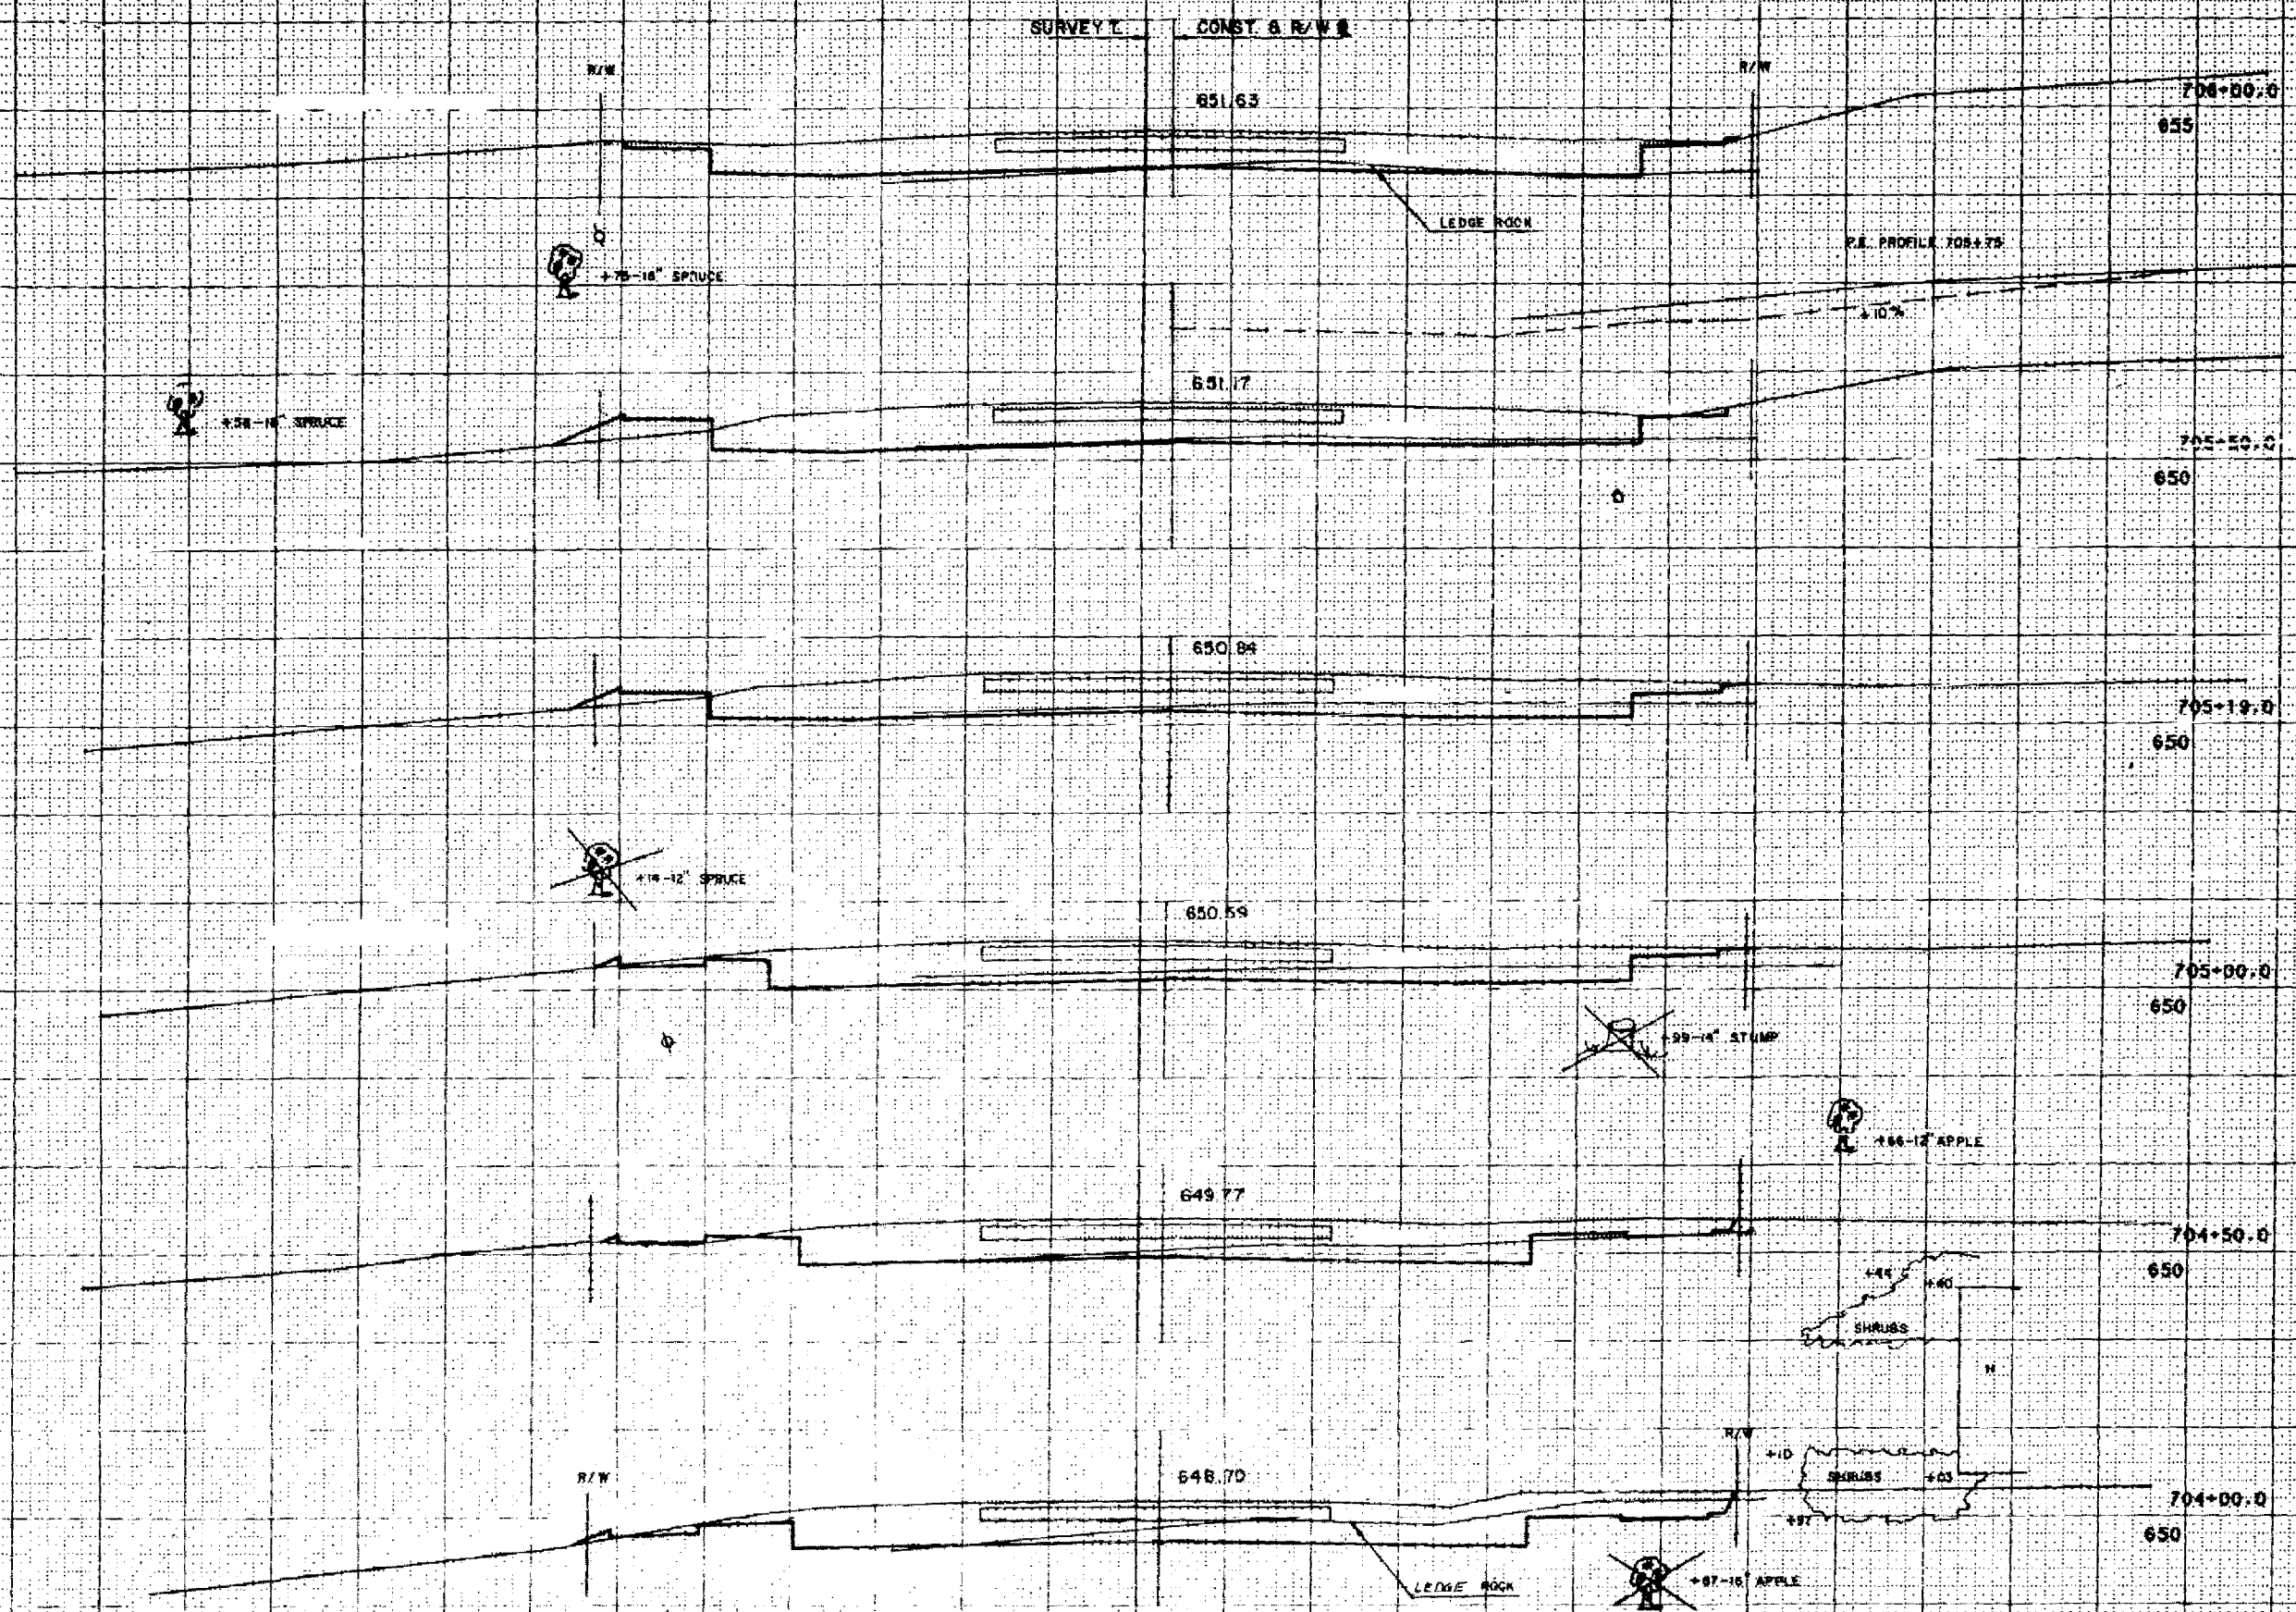

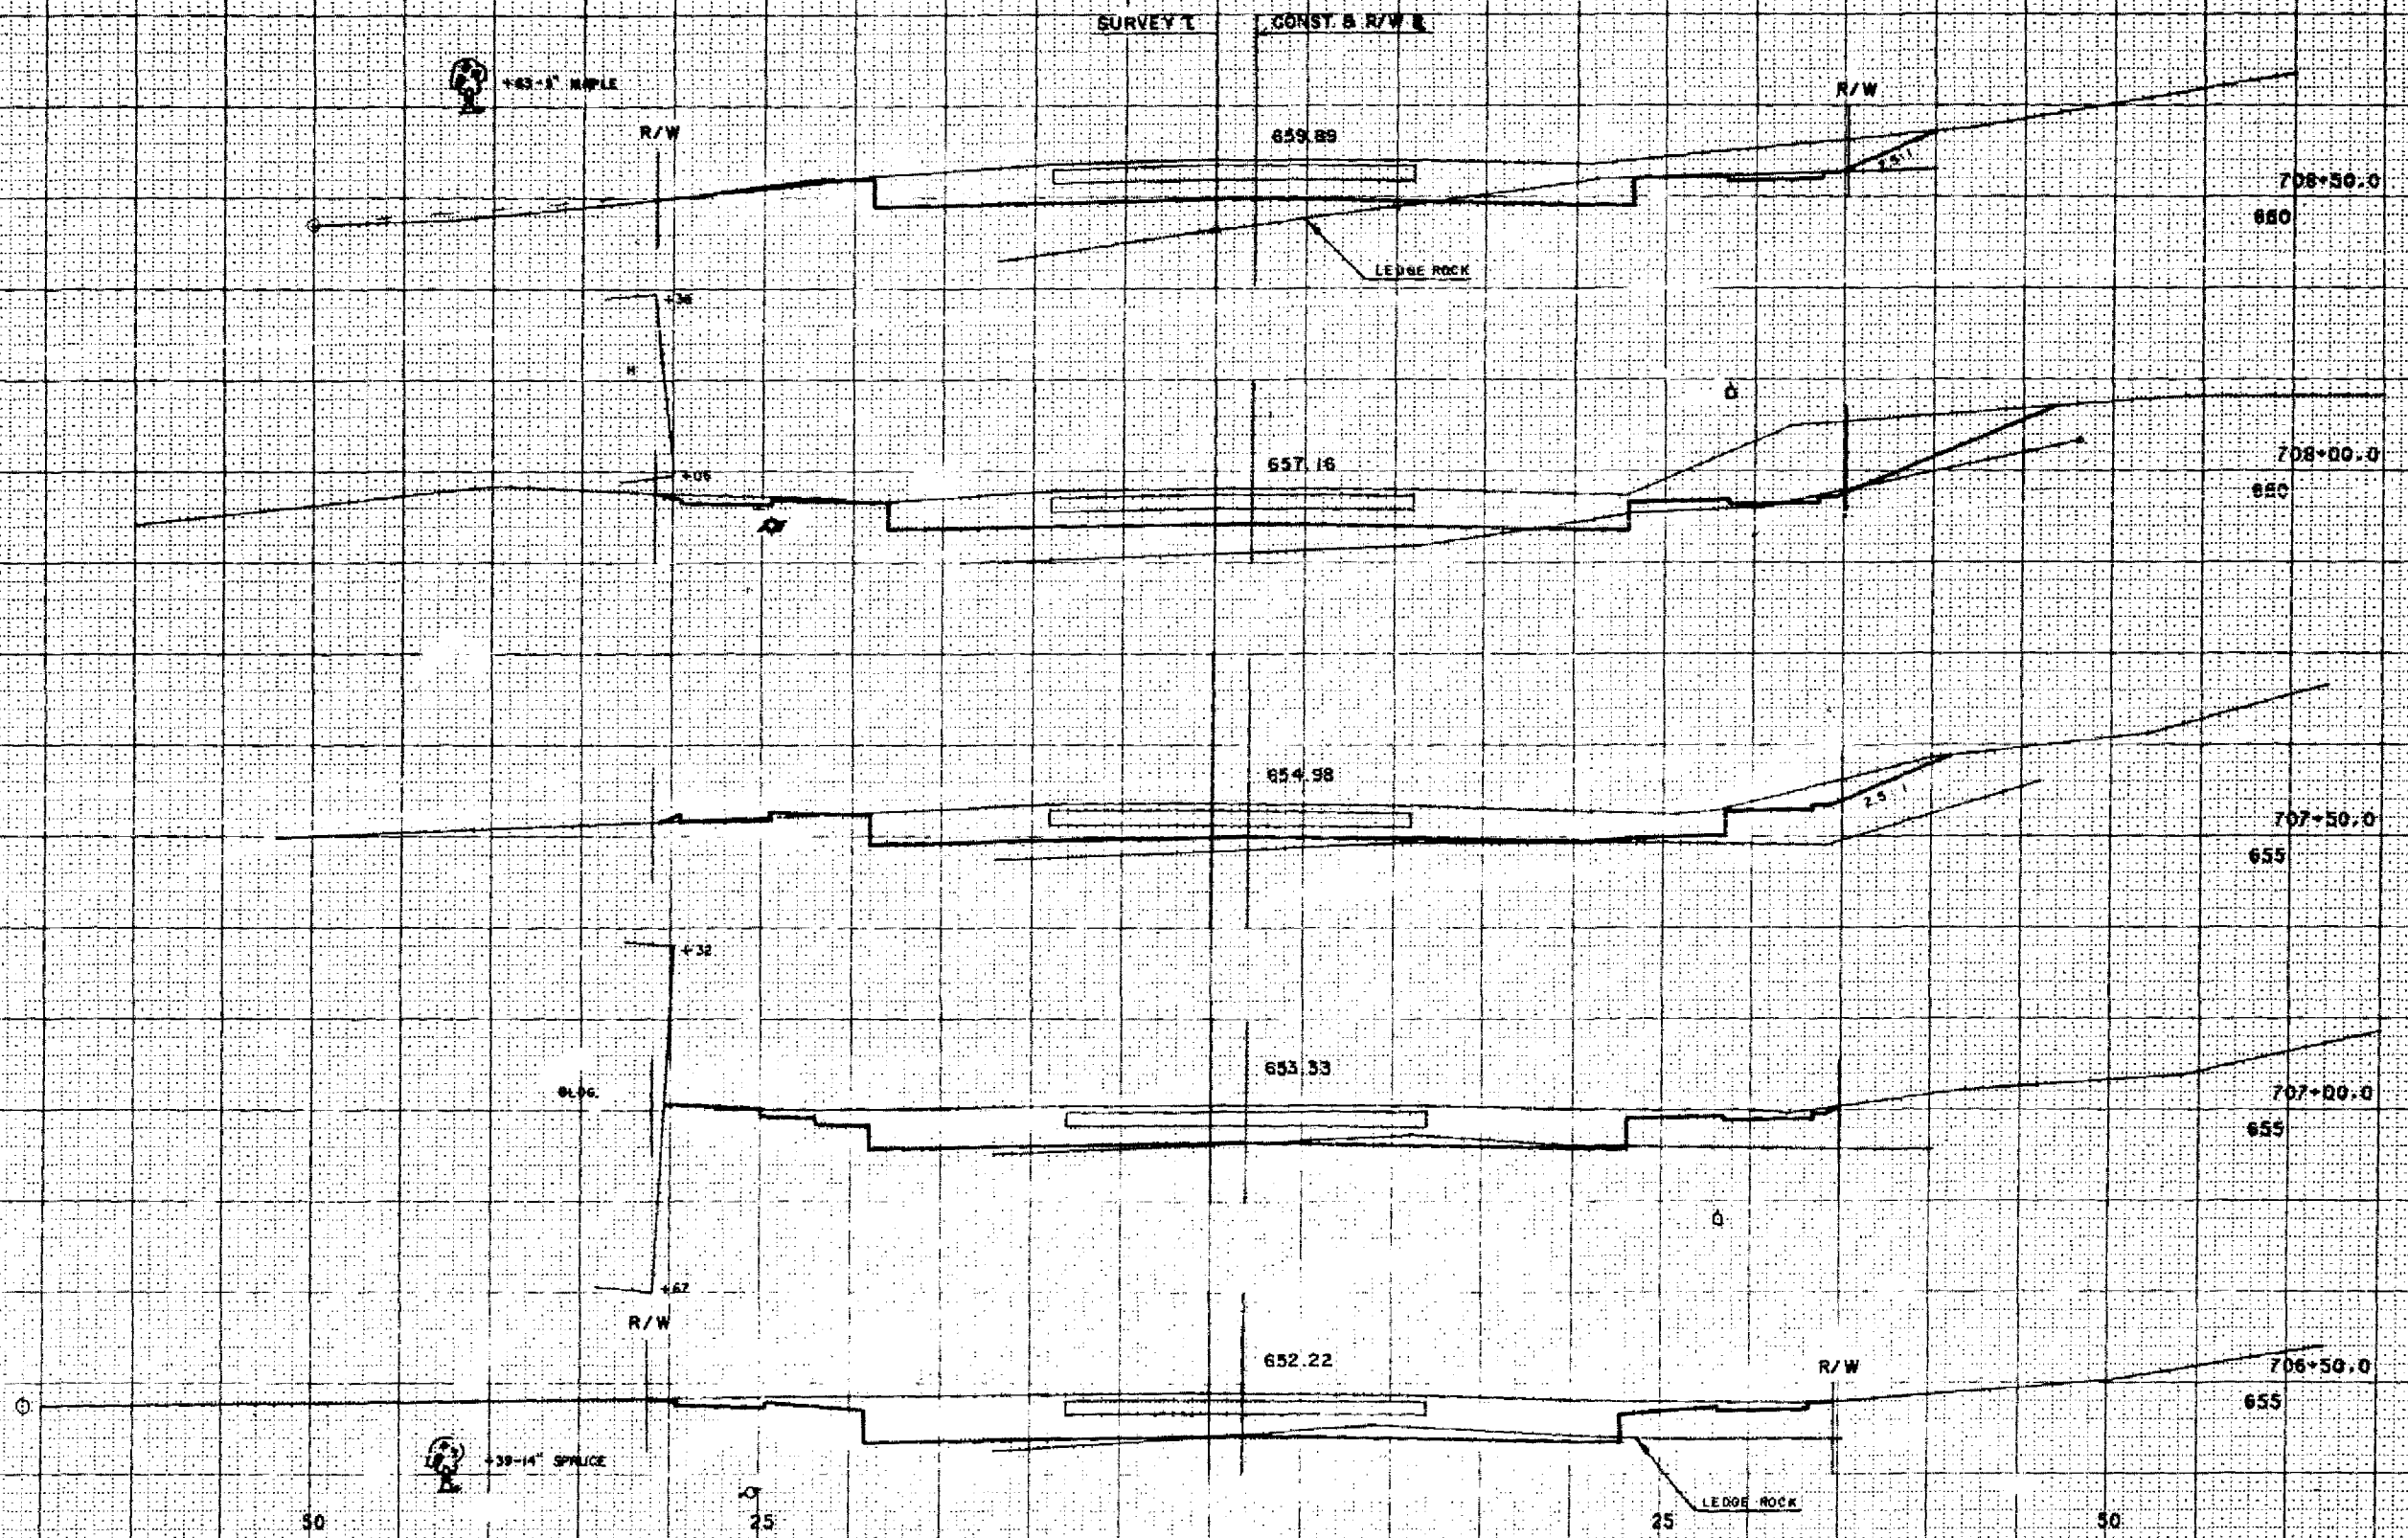

SURVEY L

CONST. & R/W E

STATE PROJECT NUMBER

4140-2-71

925

+55-16' ASH

+38-30' CEDAR CLUMP

+32-20' MAPLE

+12-21' BASSWOOD

+07-14' MAPLE

+25-28' BLACK WALNUT

669.22

LEGE ROCK

710+50.0

665

+57-14' MAPLE

+52-14' MAPLE

+55-17' ASH

+52-10' MAPLE

710+00.0

665

CONE STEPS

+78-12' MAPLE

+78-8' MAPLE

+18-8' ASH

+70-12' MAPLE

669.19

709+50.0

660

+42-10' ELM

+41-12' BOX ELDER

+28-2' MAPLE

+21

+14

R/W

+98

663.02

709+00.0

665

50


25


25

50

SHEET NO 17


1 - 05 HOR
1 - 05 VER
3154

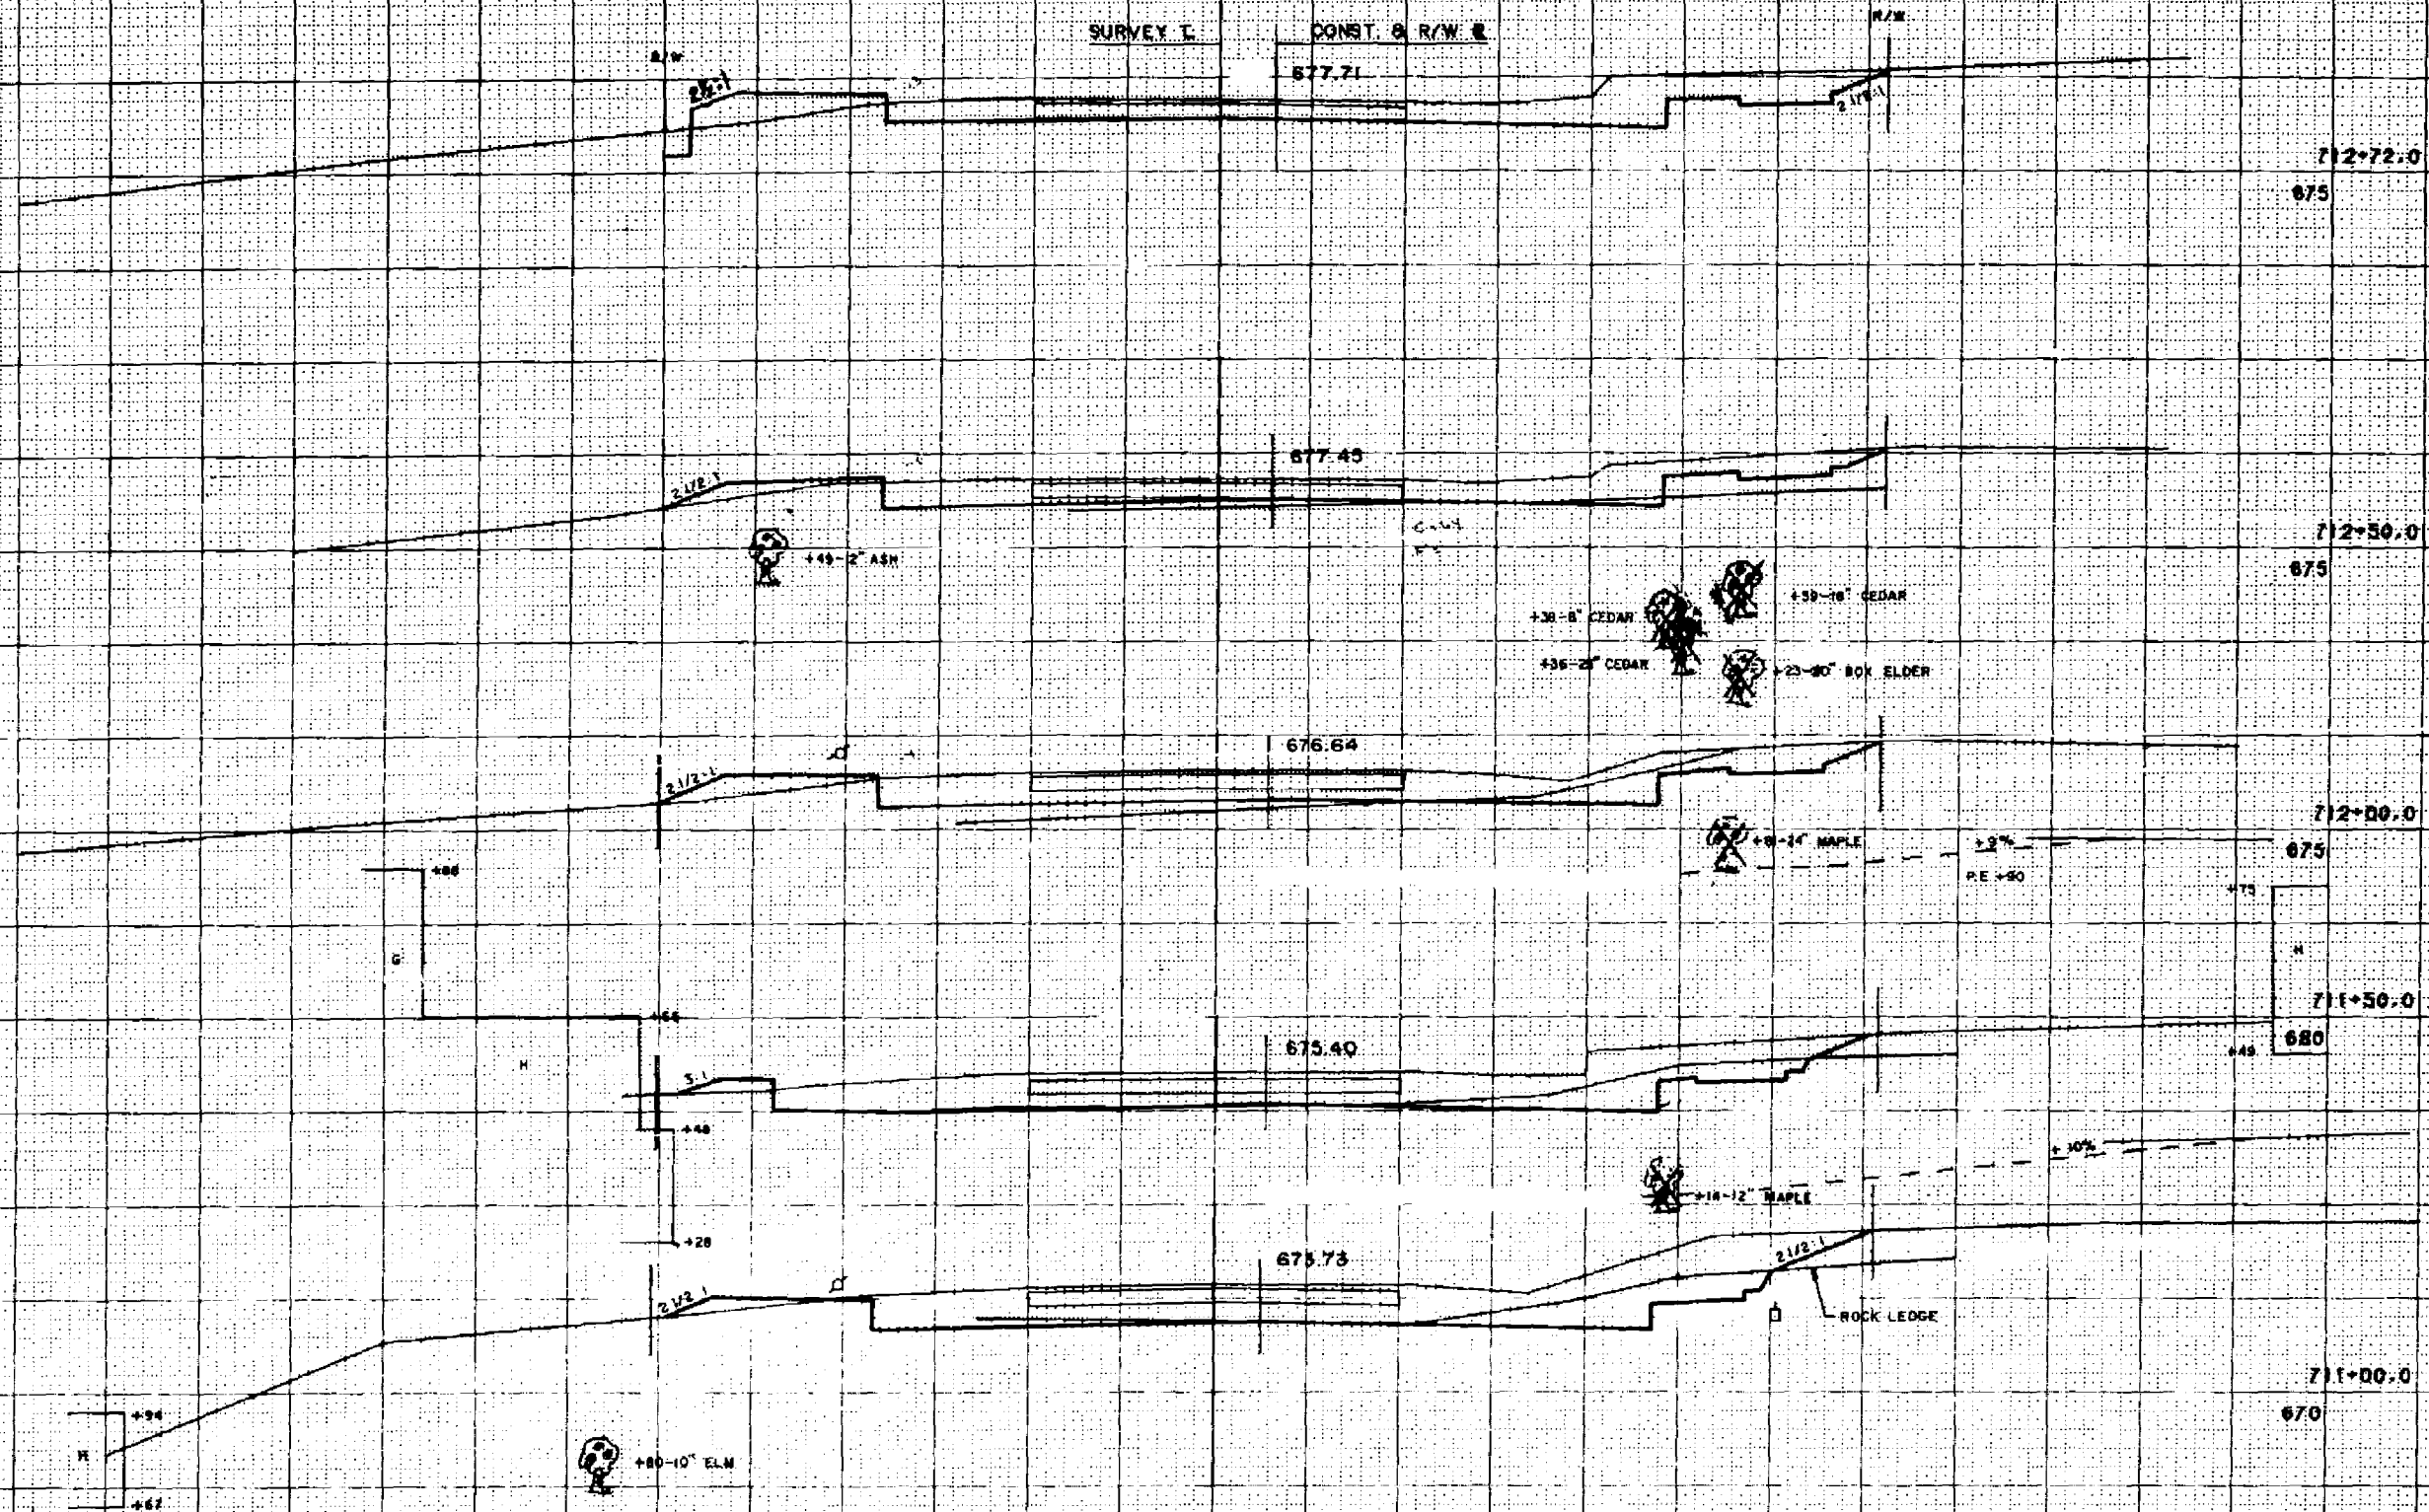

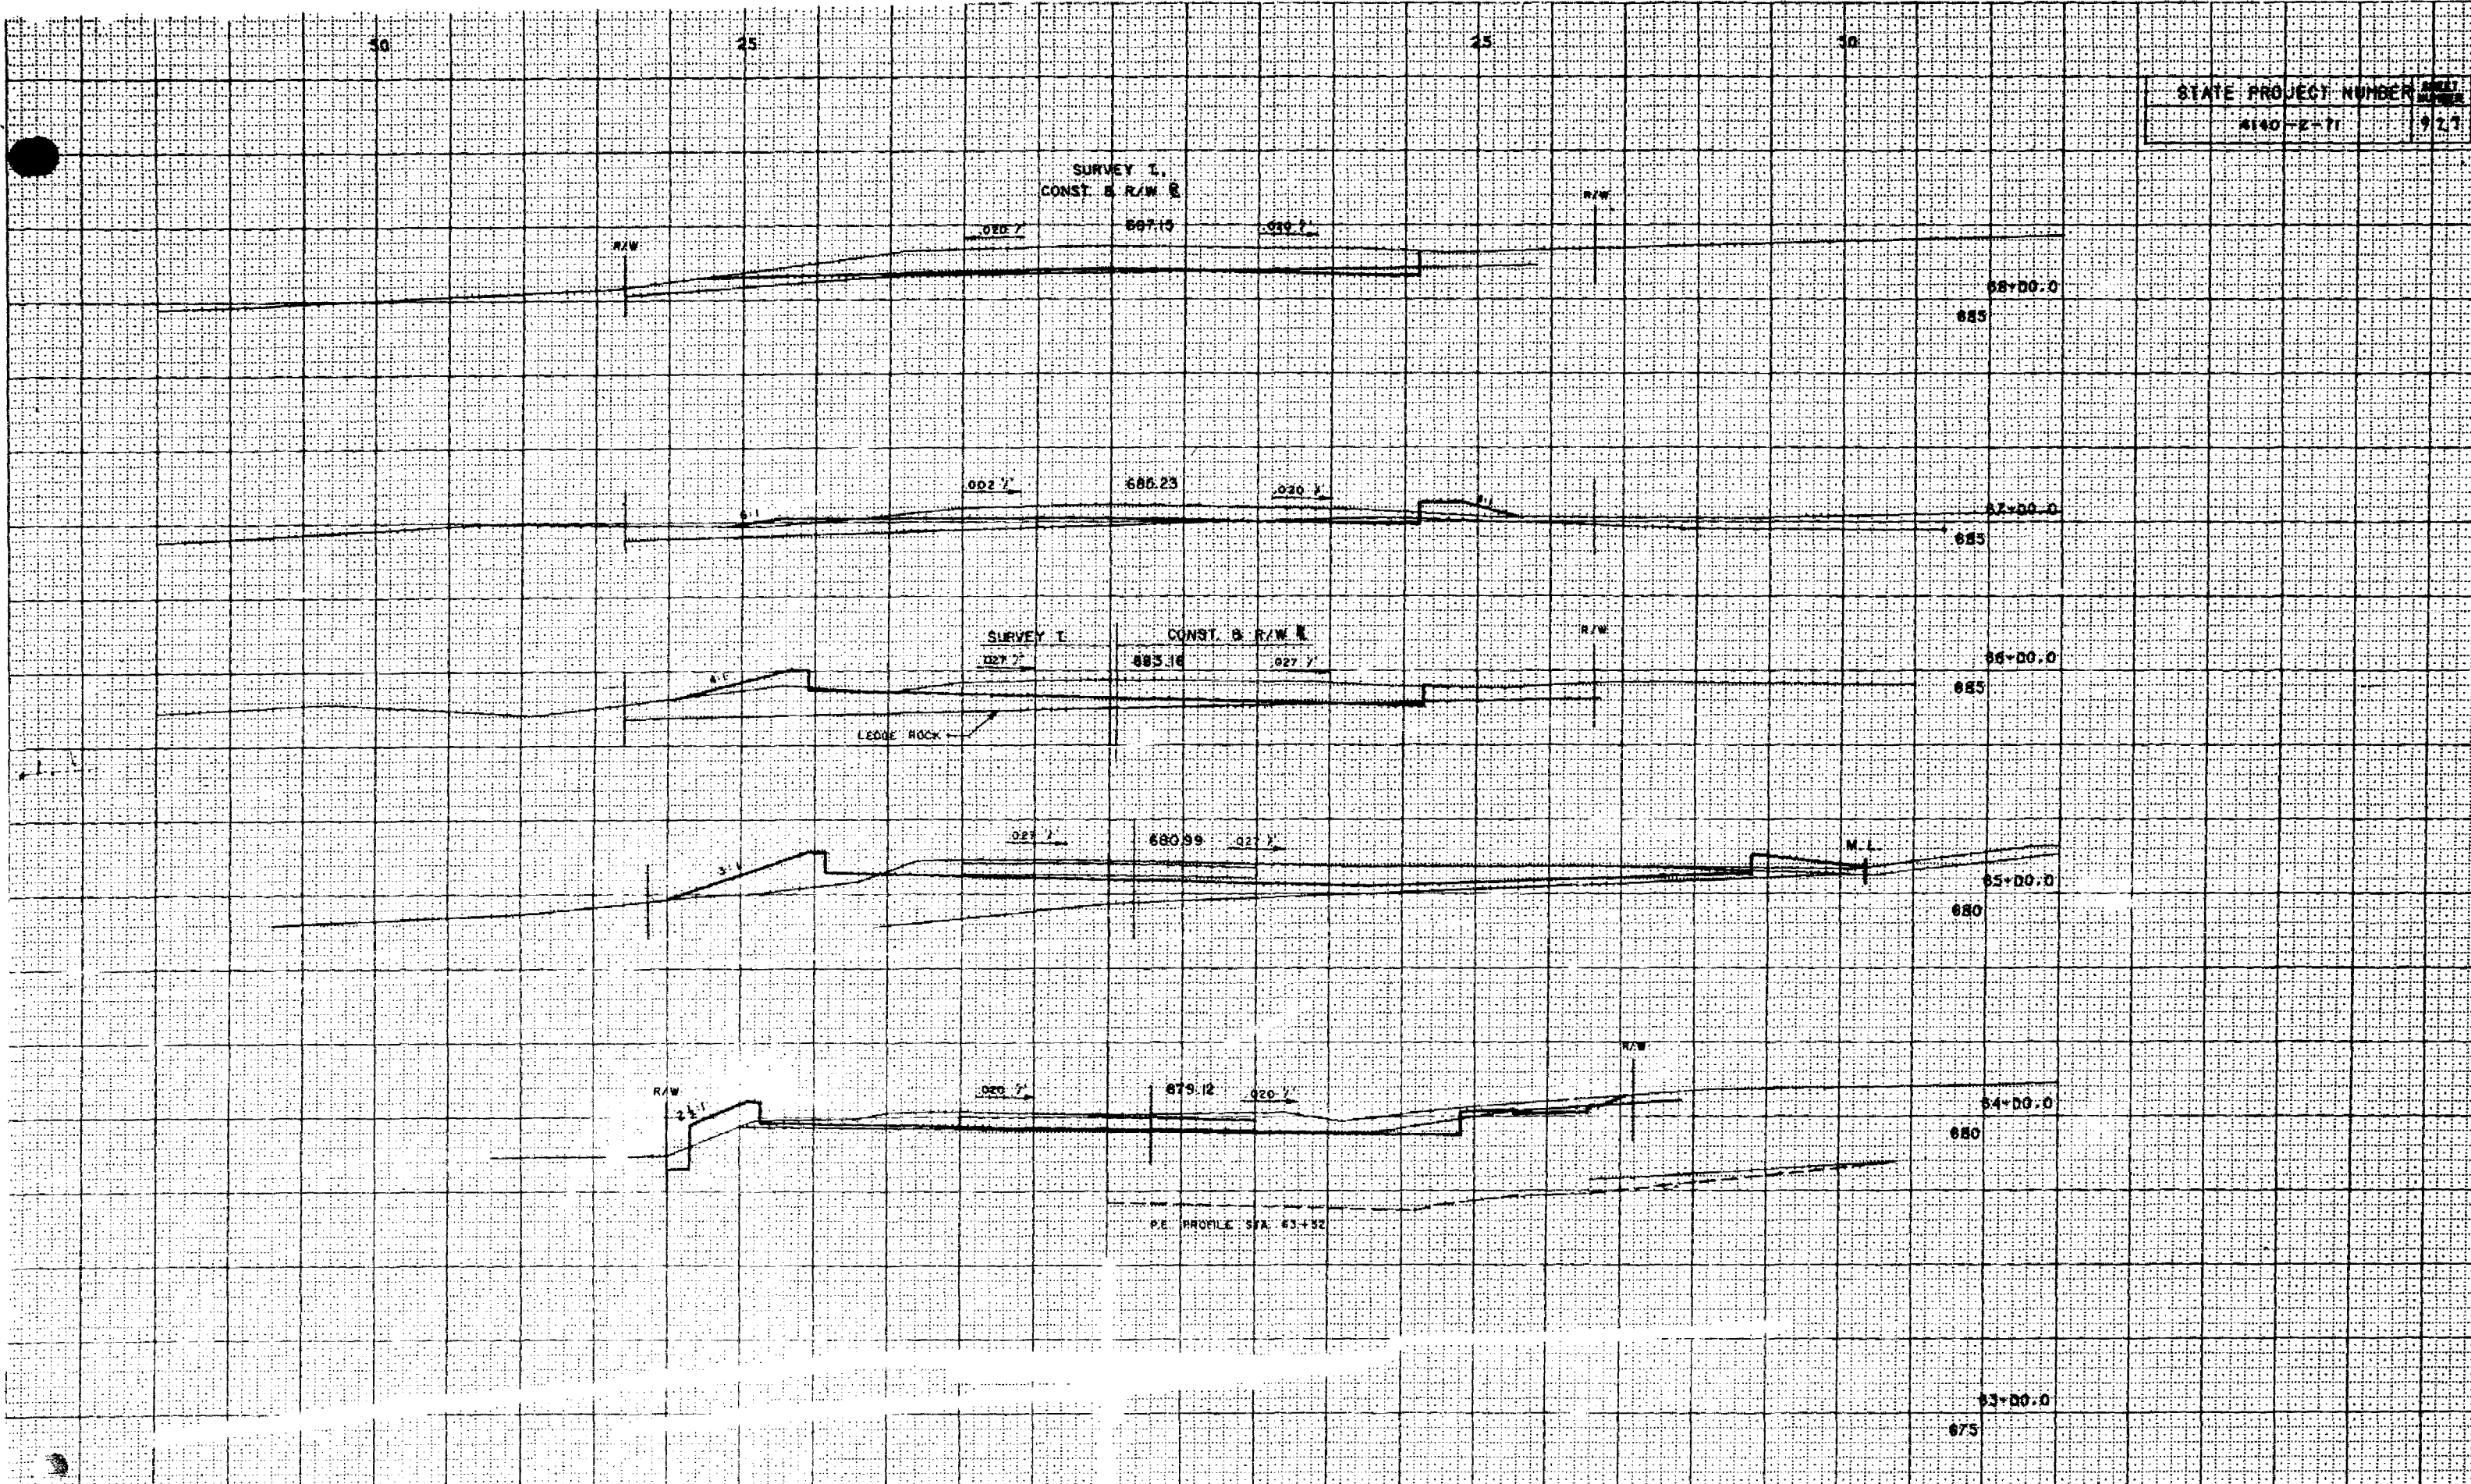


STATE PROJECT NUMBER	MSA
MSD-2-71	9.18

SURVEY 1


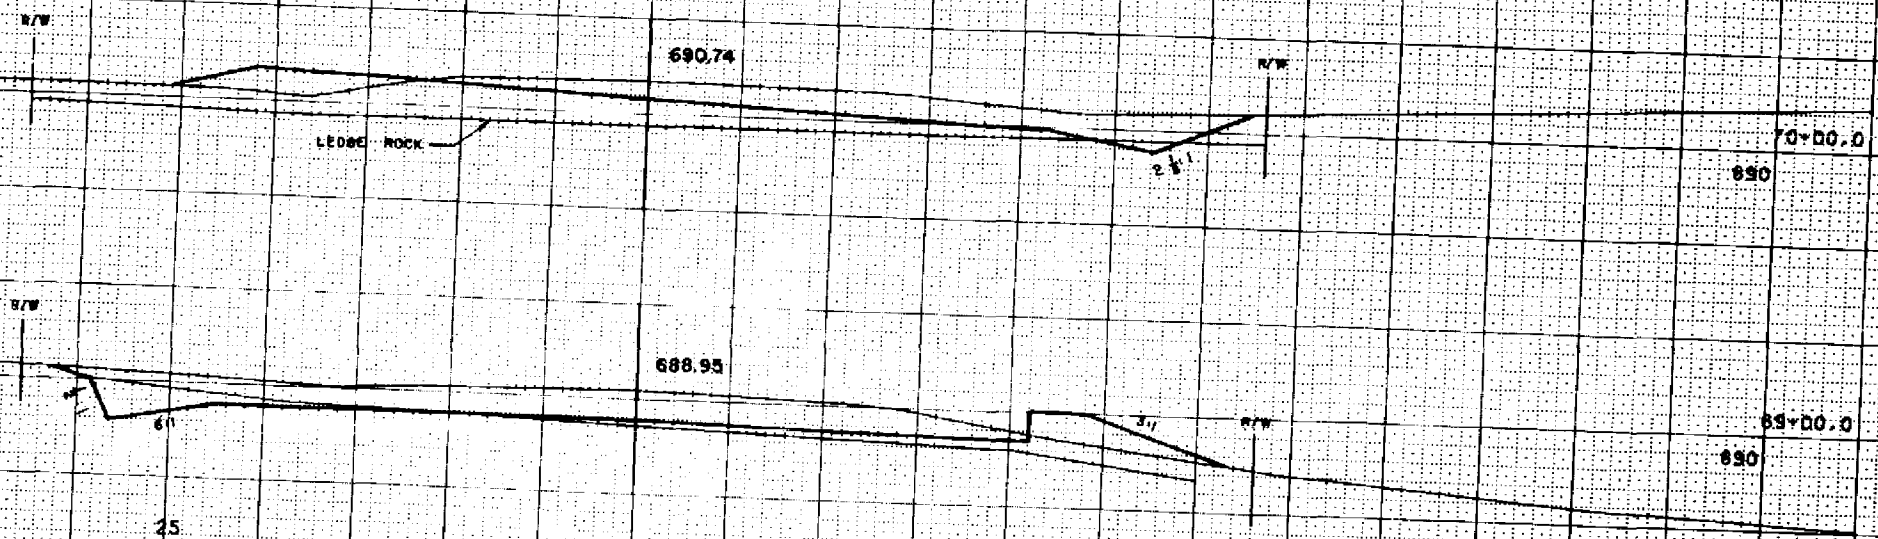


1 = OS HOR.
1 = OS VER.
SHEET NO. 2 3152

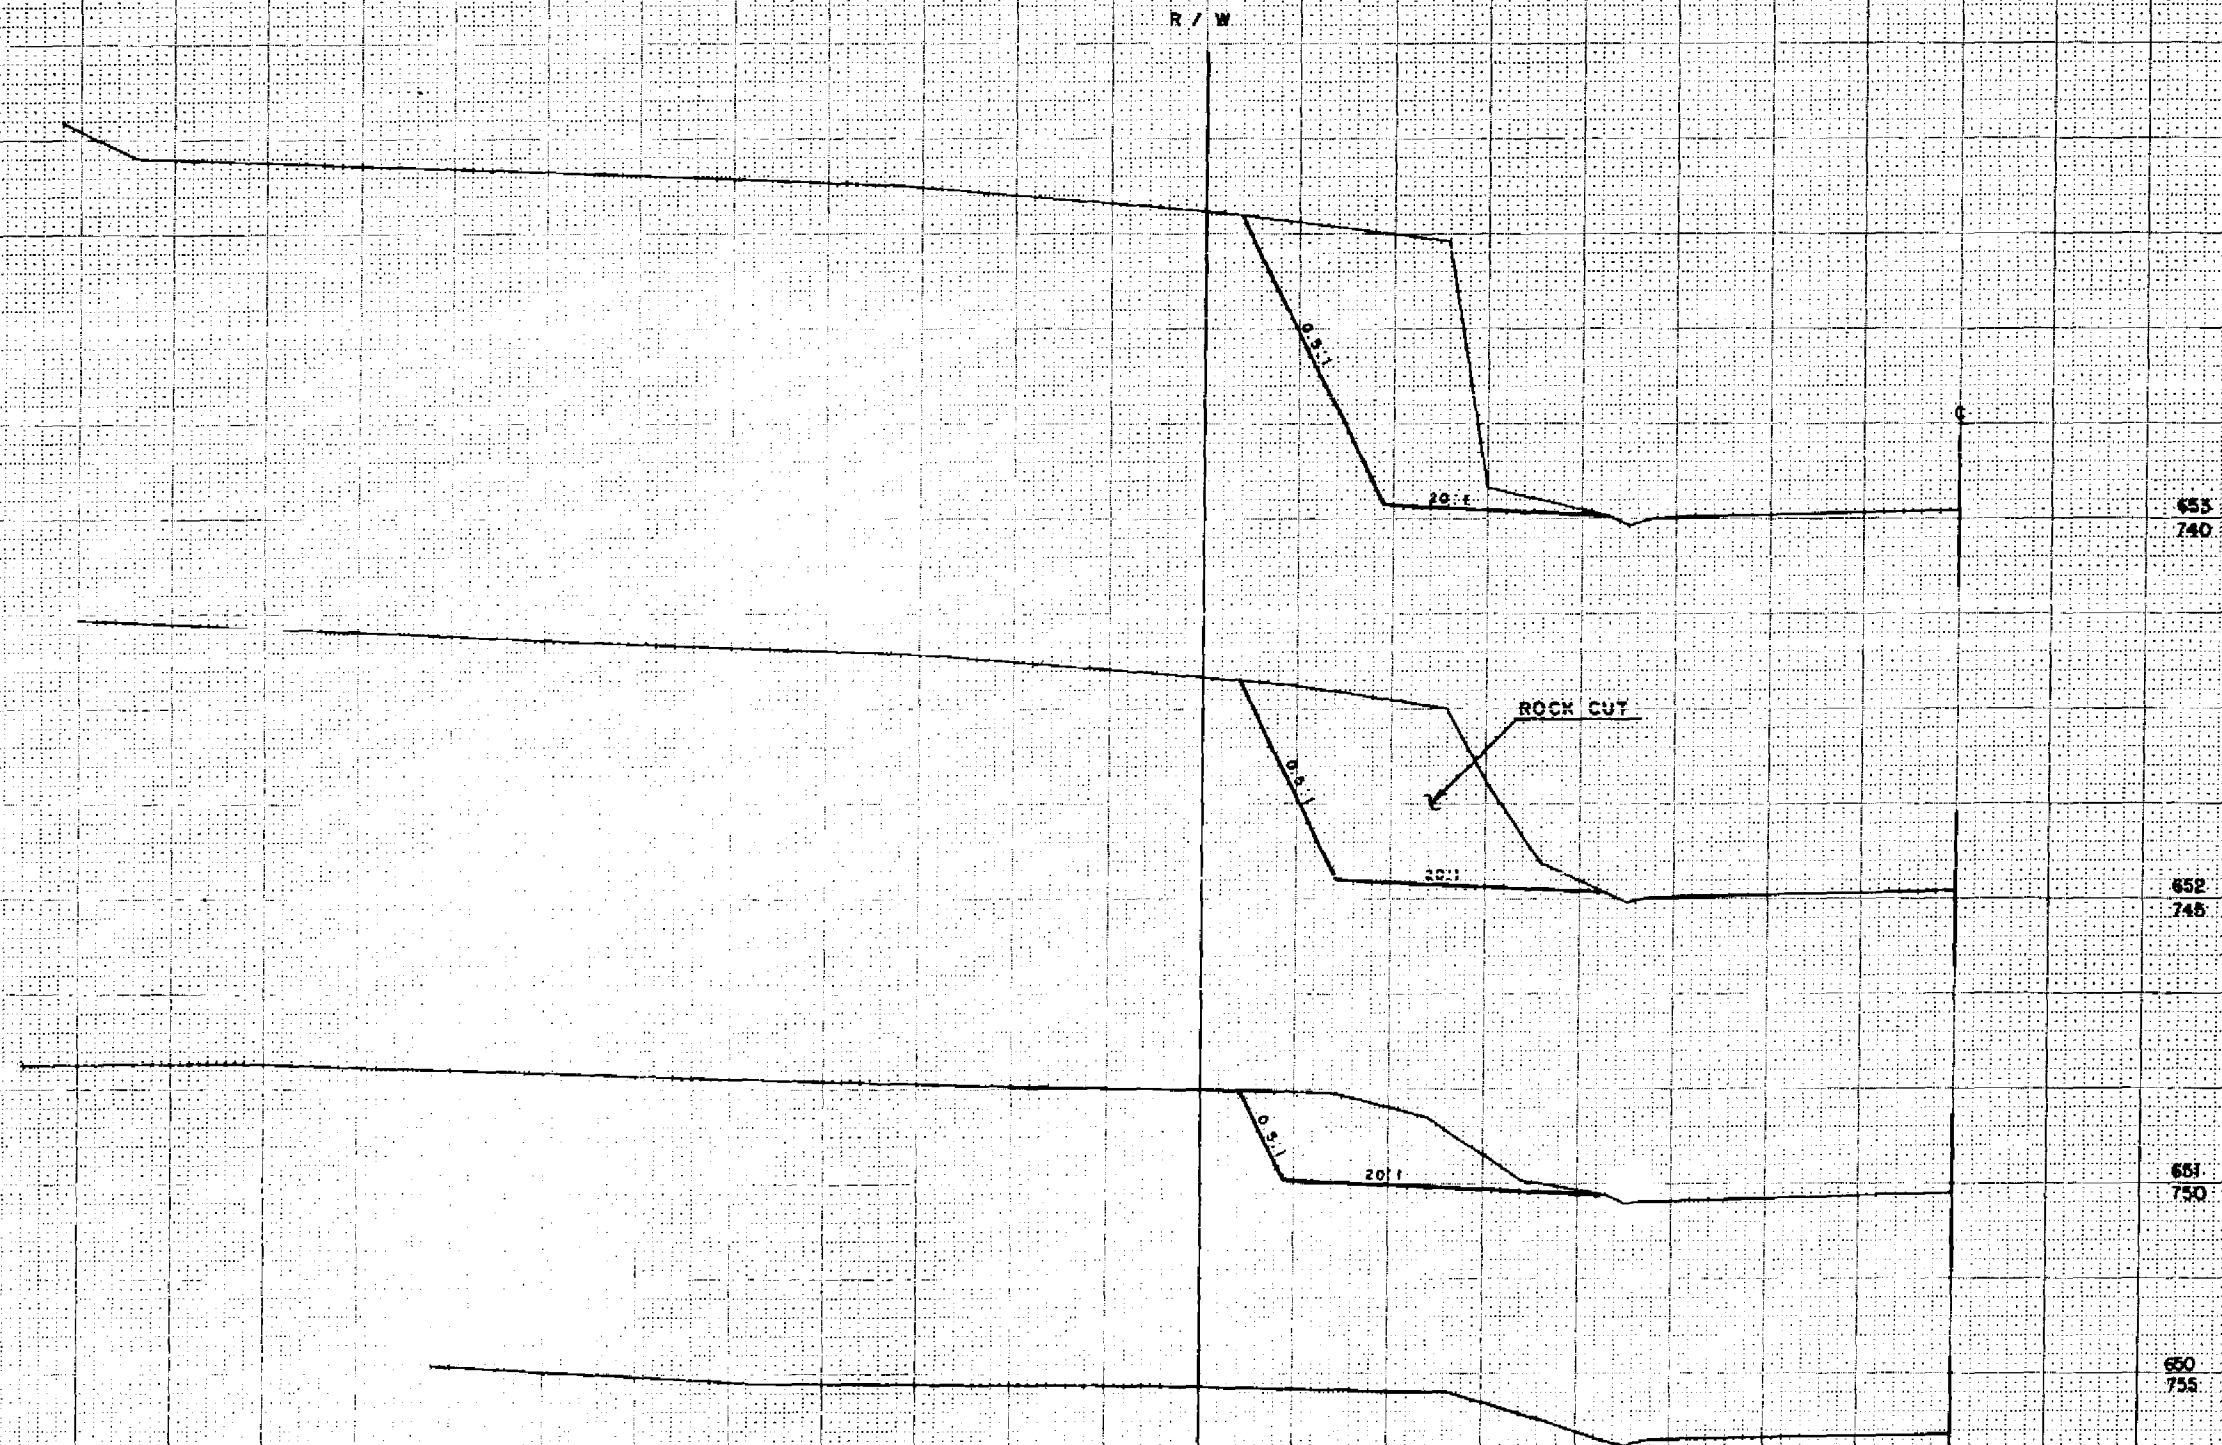

ROCK CUT AT
EGG HARBOR

HOR 1" = 50'
VER 1" = 5'

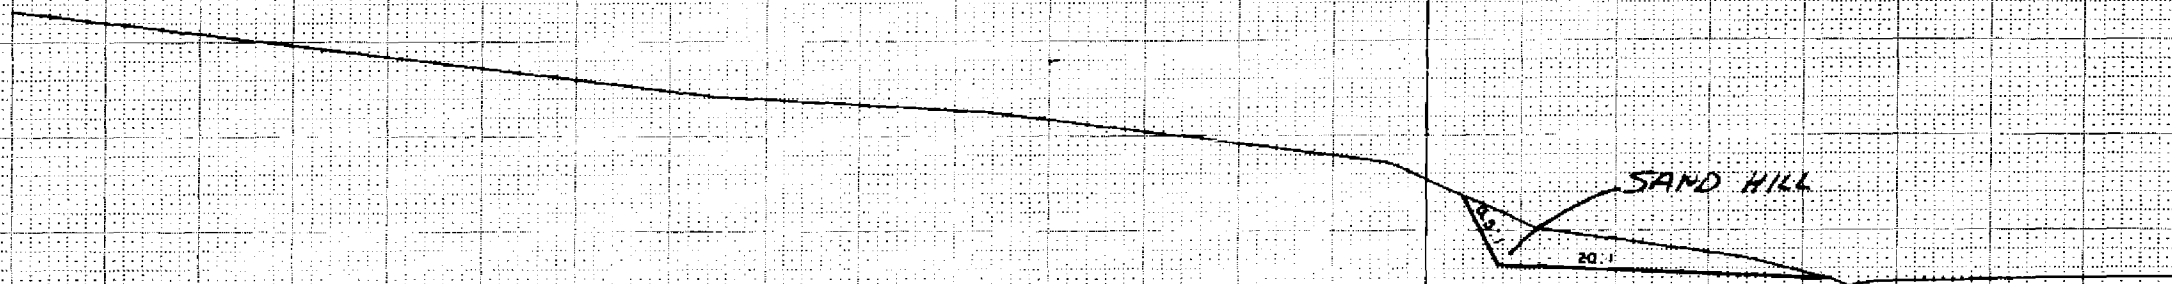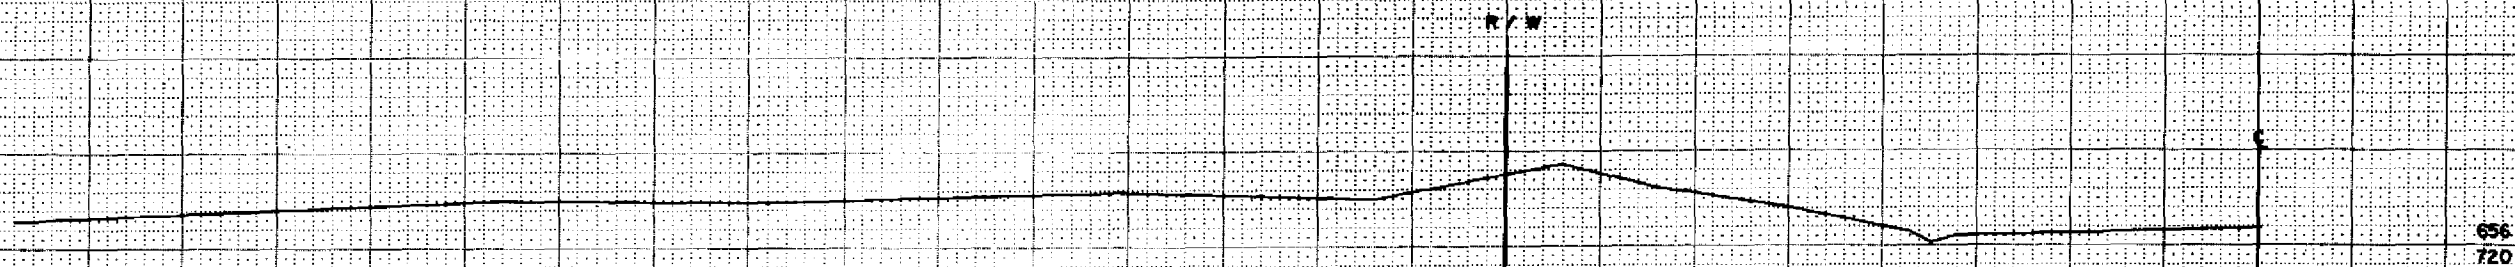

656
720

655
720

ROCK CUT AT
EGG HARBOR

654
730

HOR 1" = 5'
VER 1" = 5'

SURVEY I

STATE PROJECT NUMBER	SWAT NUMBER
----------------------	-------------

4145-2-71



SOUTH TRAIL

CONST

65-82

650.65

64930

648.5

3" TO 20" ASH & MAPLE

CONST. R

645.84

E46

	1	08	MOR
	1	08	YER
SHEET NO. 1	3157		

1	05	MOR
1	05	VER
3157		

3152

SURVEY T. CONST. 2

653.69

STATE PROJECT NUMBER

440-2-71

9.22

C.T.H. 171

R/W

51+00.0

650

5' TO 8' FORLARS

7.2'

654.05

M.L.

50+75.0

650



+ 66-10" BIRCH

+ 64-10" STUMP



+ 53-8" BIRCH

R/W

M.L.



+ 42-22" BIRCH

11.6'

654.28

50+50.0

650

16.0

50+25.0

650

50+00.0

650

1" = 10' HOR

1" = 10' VER

SHEET NO. 1

3155

SURVEY 1

MEET EXISTING

4" 91 STUMP
4" 87-18" SASSWOOD

14" TO 22" MAPLES & BIRCH

CONST. 8
0+20'
653.76

WEDGE

WOODS

VARIES

53+00.0
655

52+50.0
655


52+00.0
655

51+50.0
650

SURVEY I

STATE PROJECT NUMBER	SHEET NUMBER
440-2-7	9/34

SCHOOL ROAD

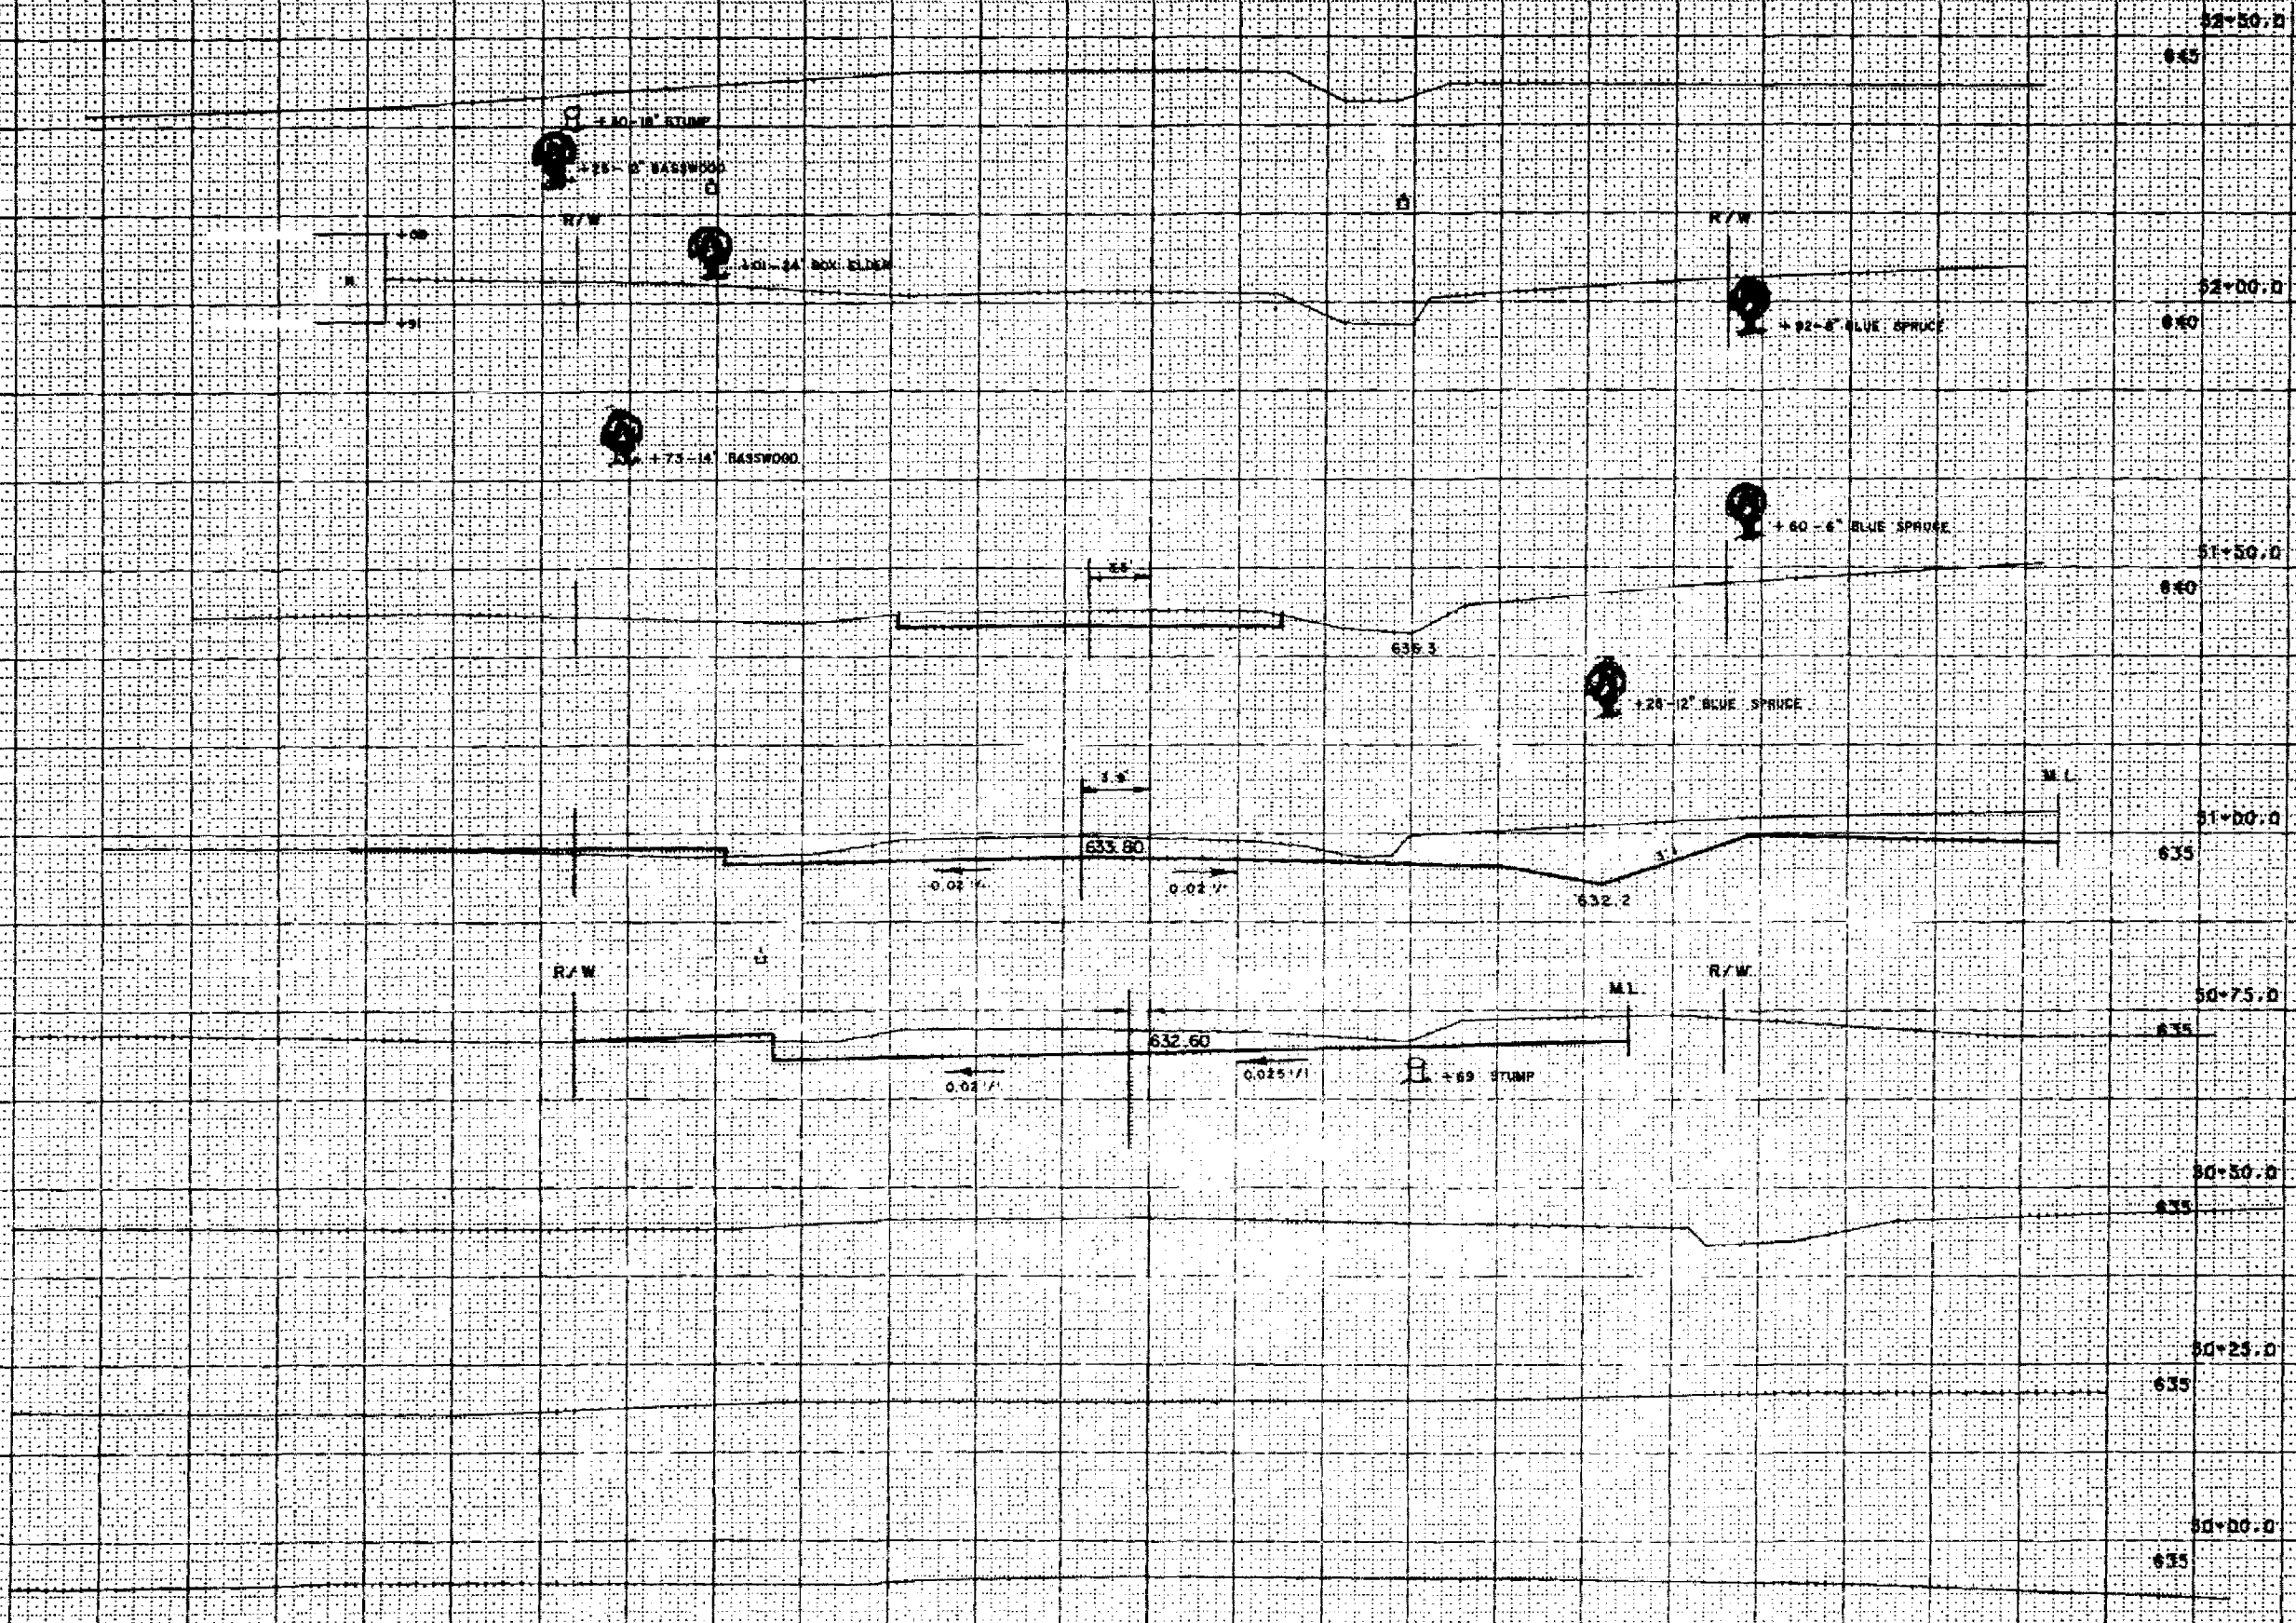

30

25

25

20

STATE PROJECT NUMBER		SHEET NUMBER
440-B-71		933
SCHOOL ROAD		

SURVEY 1

R/W

R/W

13+00.0

645

195-1A' P.P.M.A.

30

25

25


30

SHEET NO. 2

1" = 03' HOR
1" = 03' VER

3154

SURVEY 1
CONSTRUCTION 1

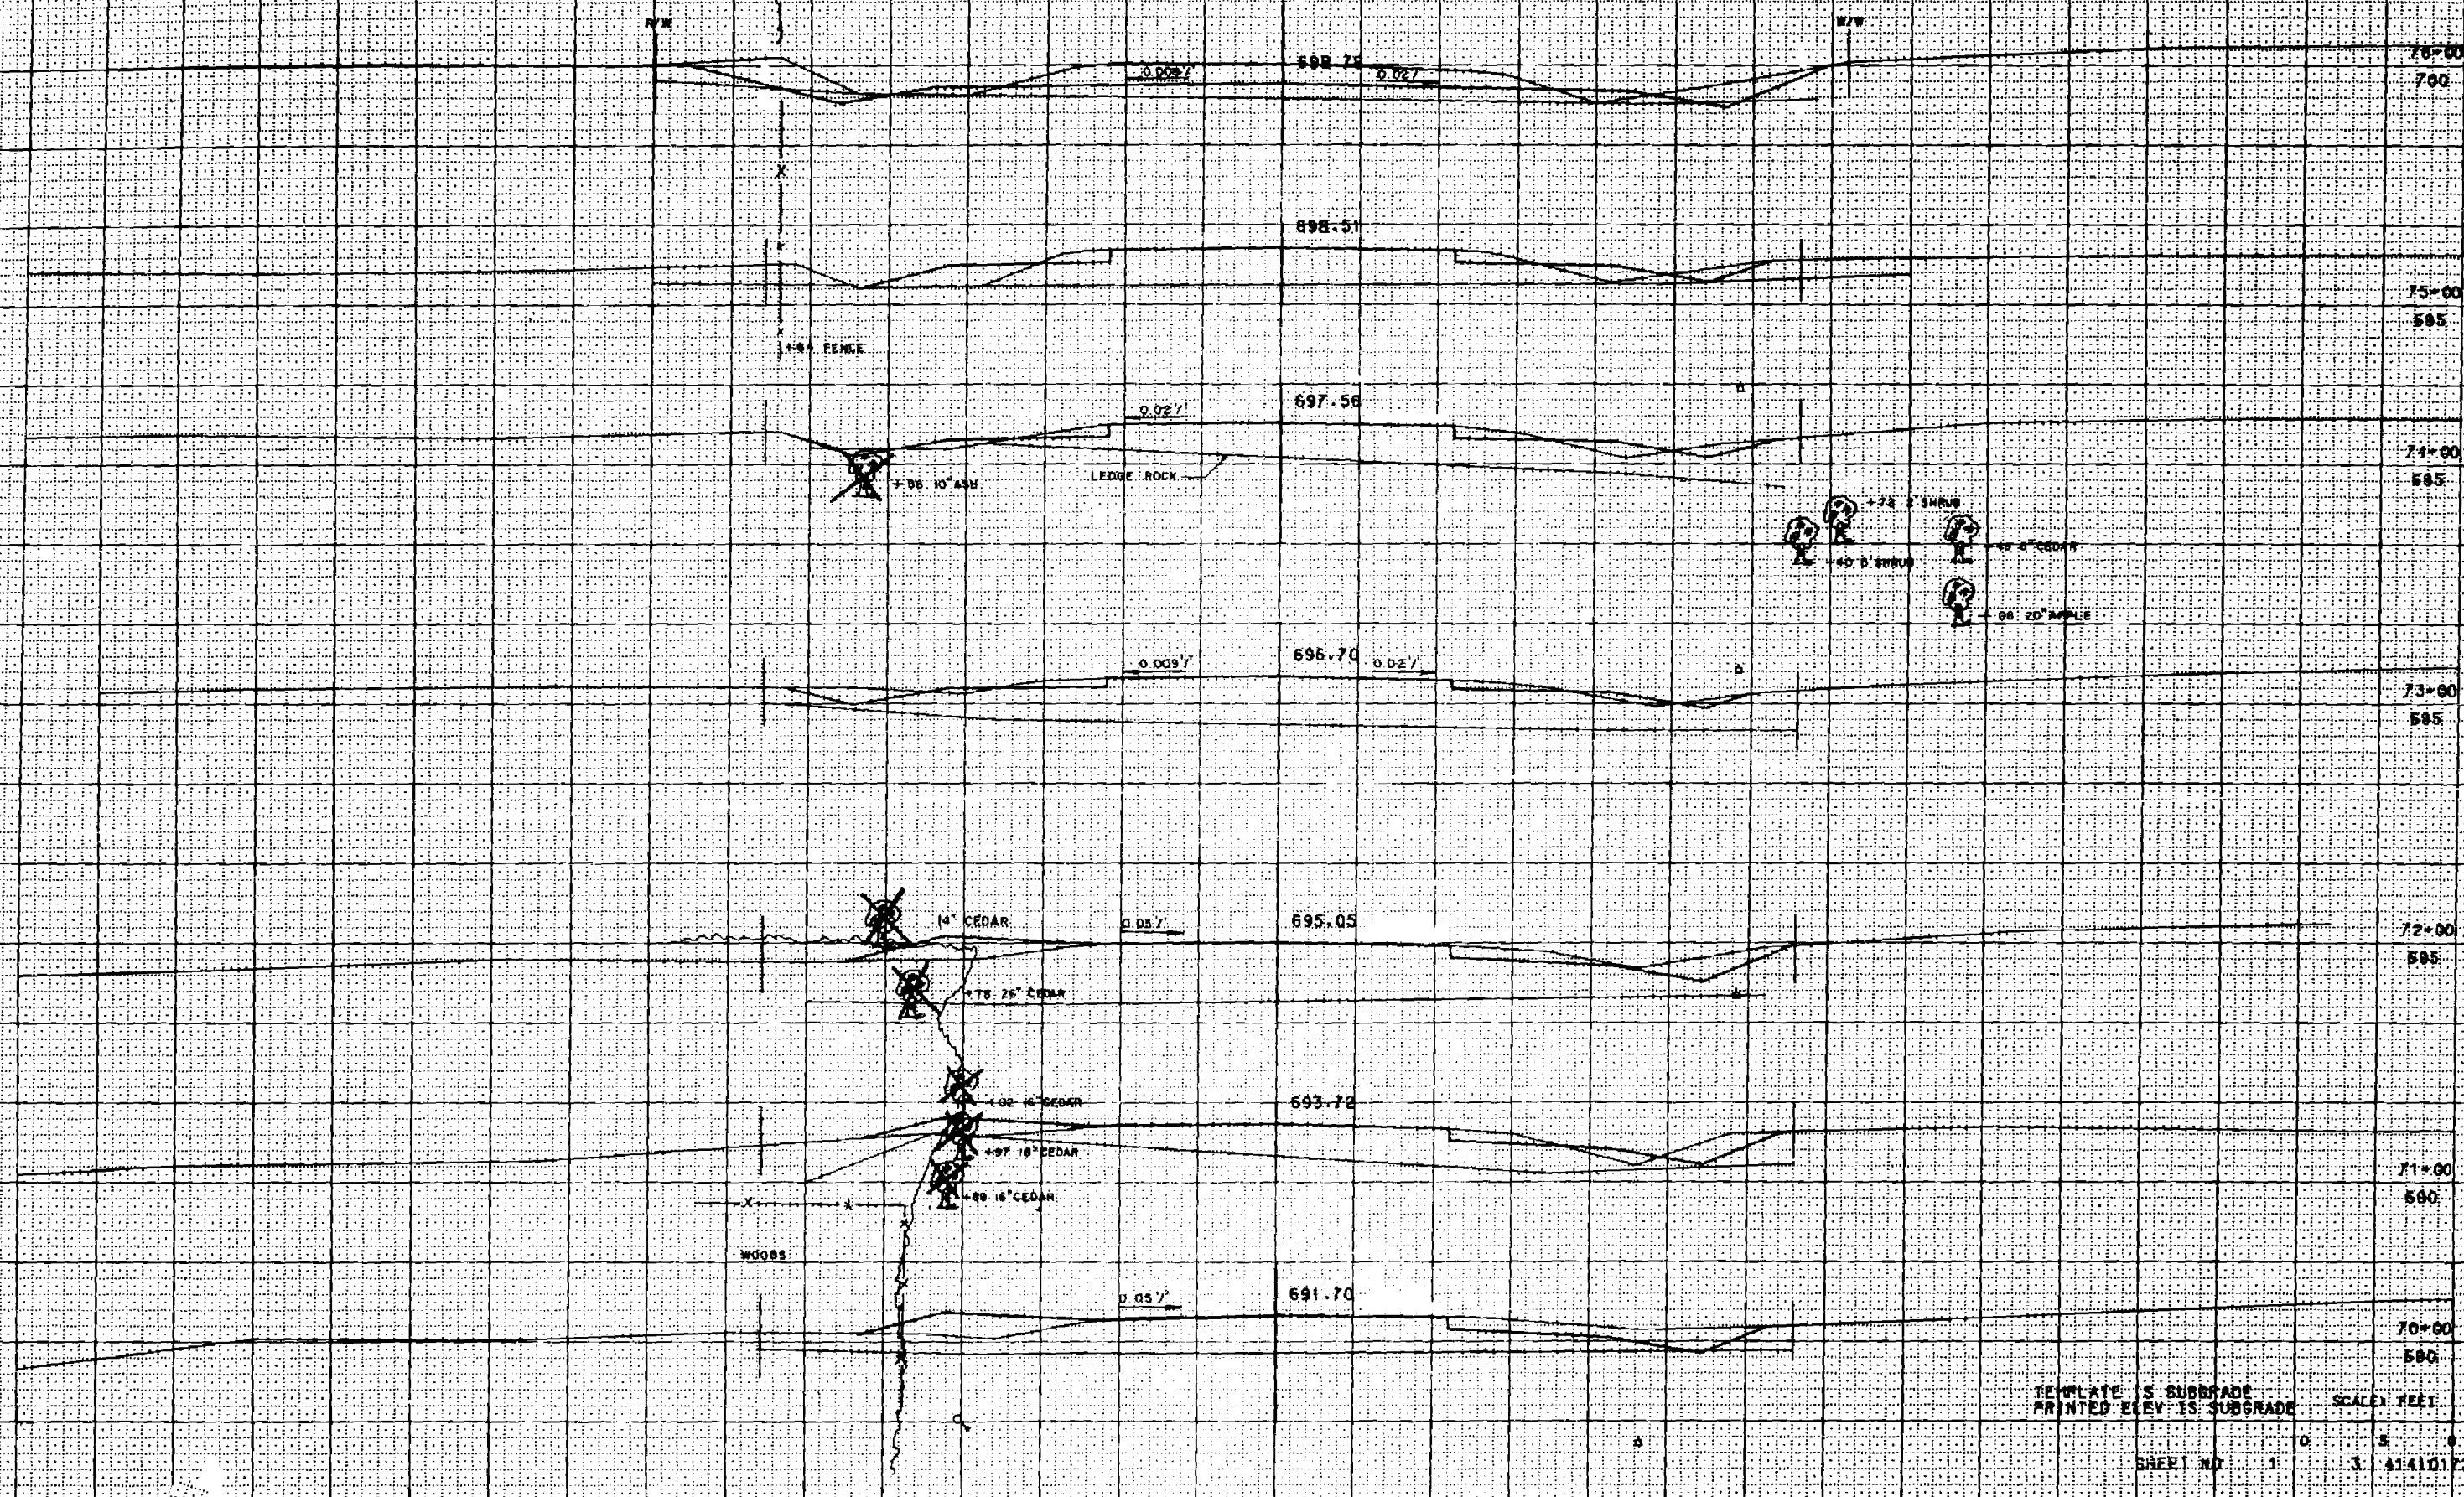

SURVEY I

CONSTRUCTION II

STATE PROJECT NUMBER	SHEET NUMBER
4141-1-72	937

710.38

710

707.55

82+00

705

SURVEY I
CONSTRUCTION II

705.20

81+00

705

DECORATIVE
ENTRANCE WALL

703.29

80+00

705

LEDGE ROCK

701.83

79+00

705

700.78

78+00

705

699.78

77+00

700

WOODS

TEMPLATE IS SUBGRADE
PRINTED ELEV IS SUBGRADE

SCALE: FEET

SHEET NO. 2 3 4141.01/238

SURVEY I
B CONSTRUCTION

STATE PROJECT NUMBER	SHEET NUMBER
4141-1-1A	738

STONE MASONRY WALL

STONE MASONRY WALL

LEDGE ROCK

SURVEY I
CONSTRUCTION R

WEDGES

CLUMP BE

+23 36" BASSWOOD

+60 12" B.E.

+55 12" B.E.

+39 22" OAK

+16 8" MAPLE

+99 5" MAPLE

+04 8" OAK

+37 28" TWIN BIRCH

+20 16" MAPLE

+53 8" ASH

+97 5" MAPLE

+04 10" MAPLE

+11 6" MAPLE

+75 24" BUTTERNUT

+80 9" MAPLE

+54 15" TWIN MAPLE

+42 12" TWIN MAPLE

+24 24" TWIN BASSWOOD

+32 10" BASSWOOD

+54 8" ASH

+85 25" BEECH

713.59

717.11

720.34

722.82

724.85

726.34

727.37

83.99

84.98

85.98

87.00

88.00

89.00

90.00

TEMPLATE IS SUBGRADE
PRINTED ELEV IS SUBGRADE

SCALE: FEET

SHEET NO 3 414101238

SURVEY T.
CONSTRUCTION

STATE PROJECT NUMBER	4141-72	97-00
----------------------	---------	-------

WOODS

726.38 0.01% 0.01%

726.12 0.01% 0.01%

726.11 0.01% 0.01%

LEDGE ROCK

726.35 0.02% 0.02%

726.83

WOODS

727.48

727.64

12" MAPLE
(SAVE)
12" MAPLE


12" MAPLE STUMP
12" MAPLE
12" MAPLE
12" MAPLE

TEMPLATE IS SUBGRADE
PRINTED ELEV IS SUBGRADE

SCALE: FEET

SHEET NO. 4141017238

SURVEY 1
A. CONSTRUCTION

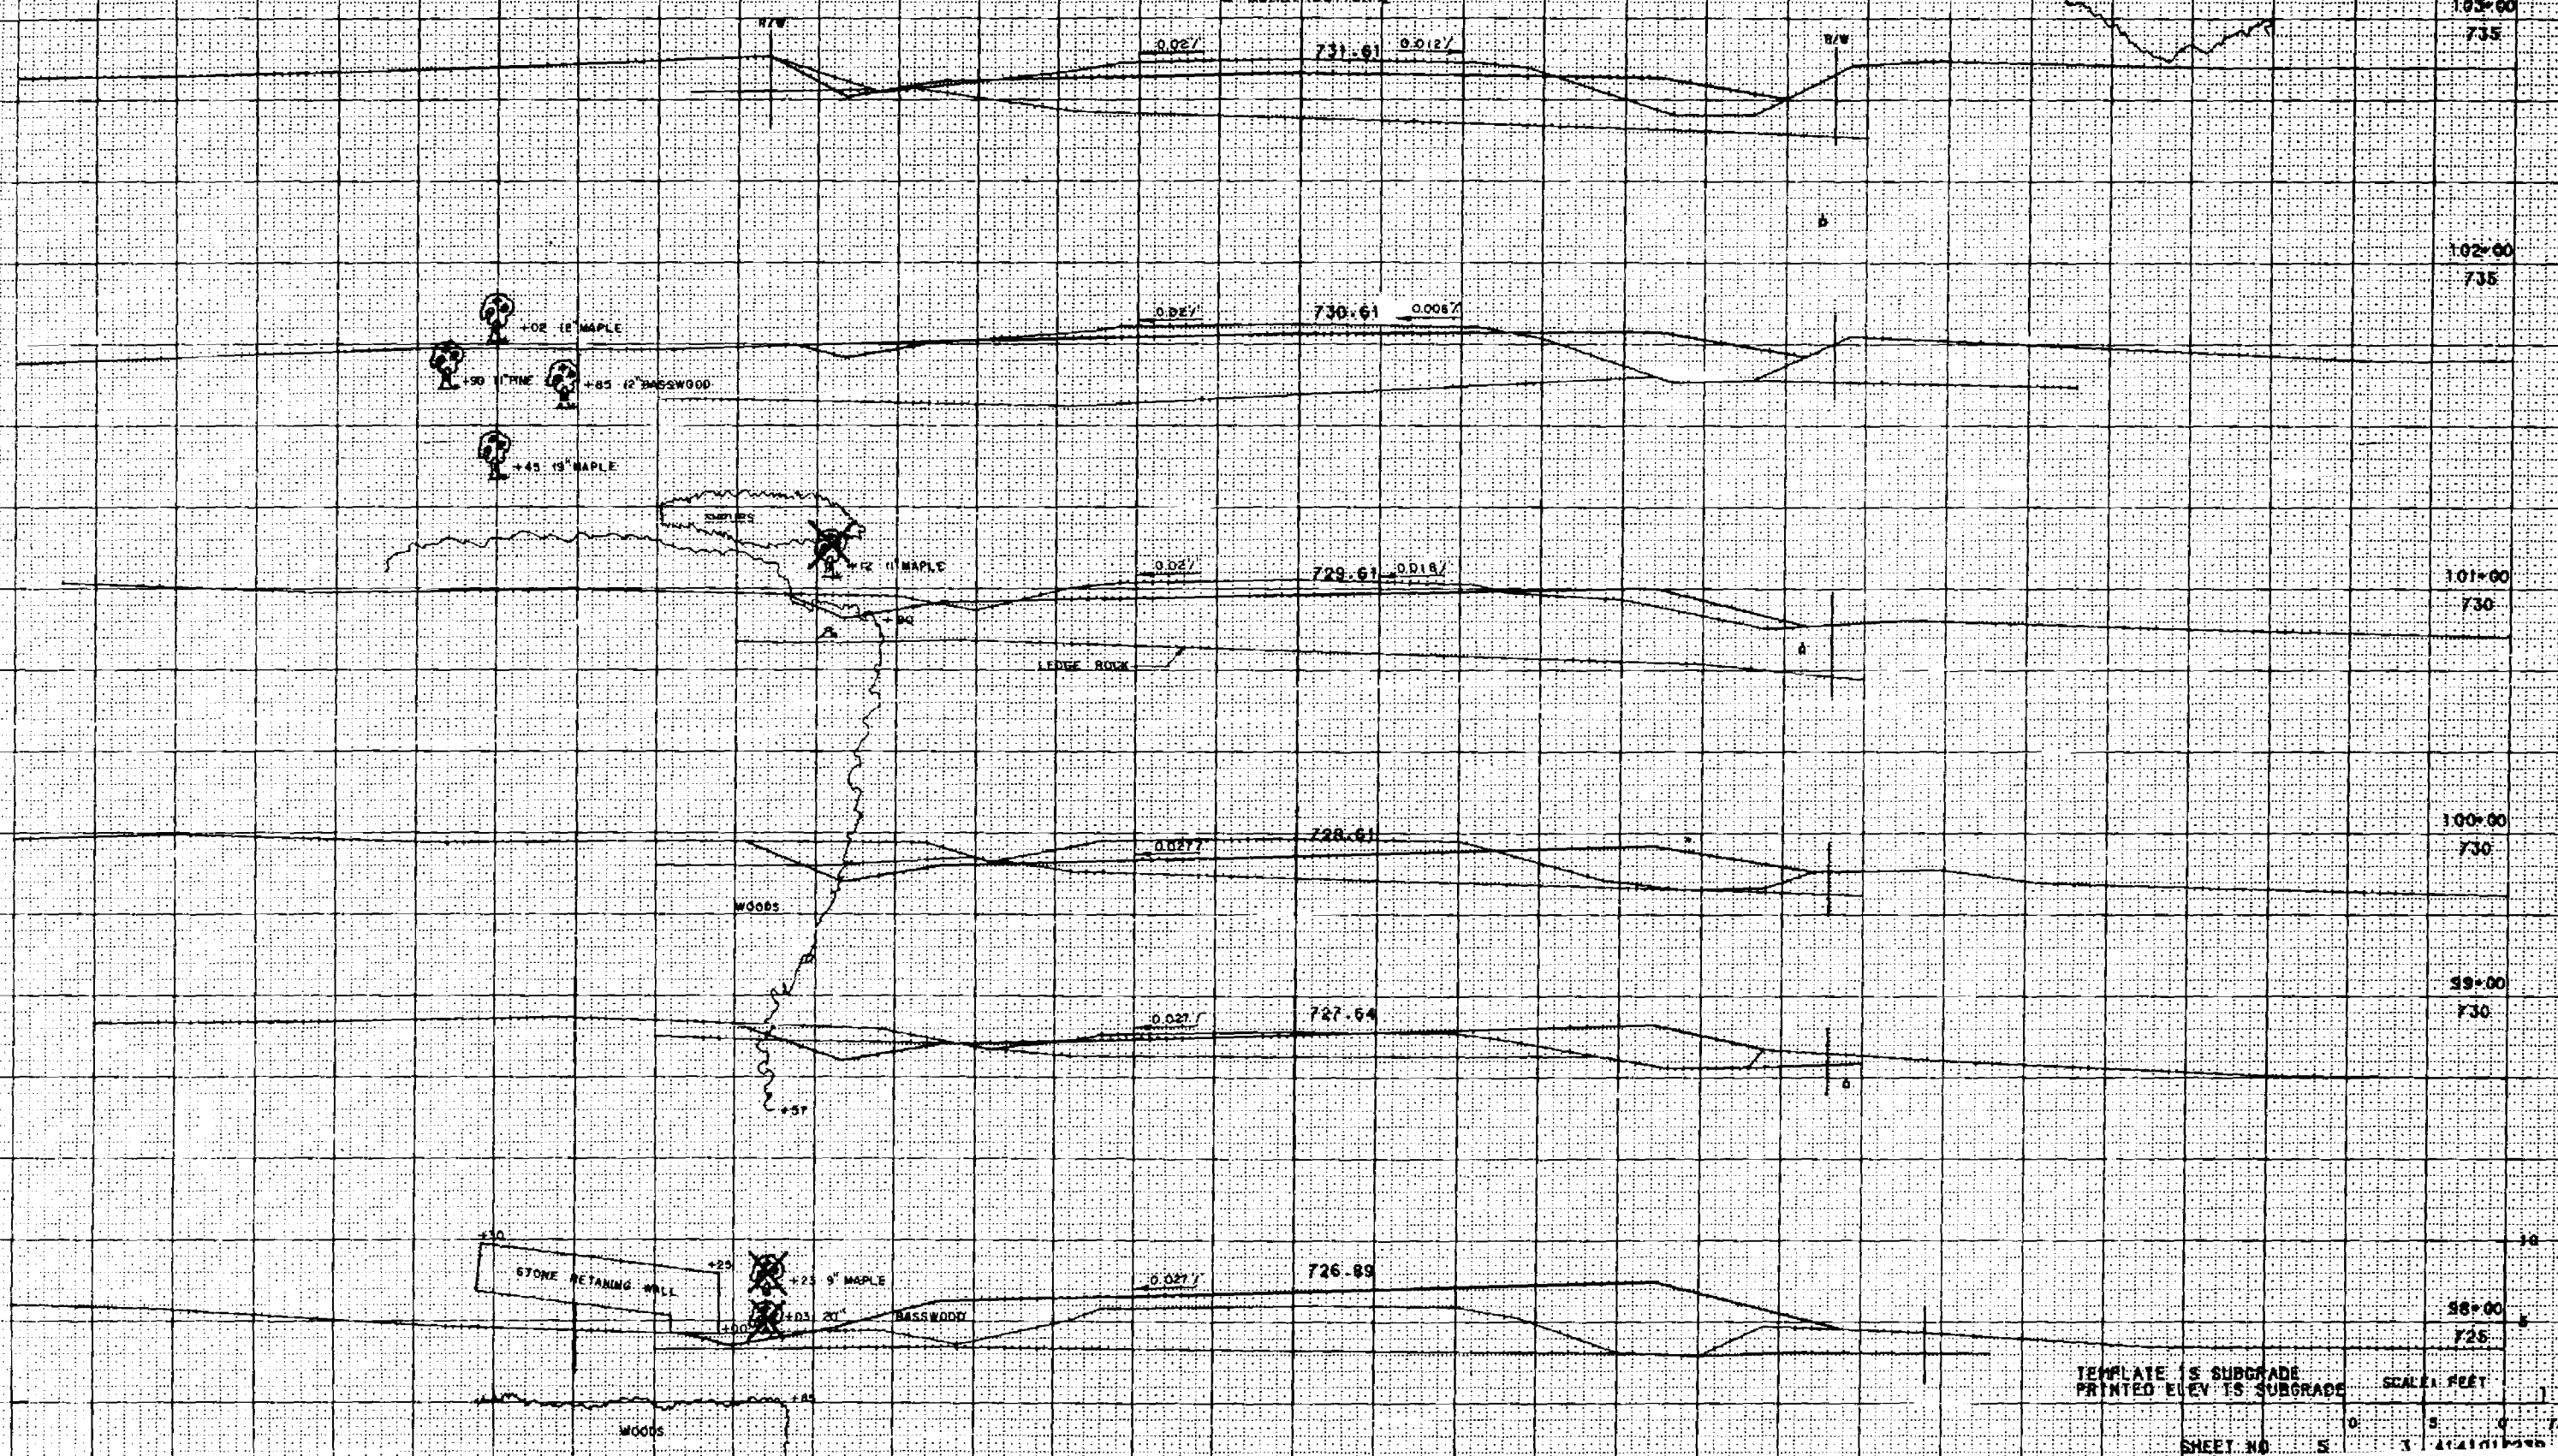

PINE PLANTATION

SURVEY 1
A. CONSTRUCTION

APPLE ORCHARD

0.02% 738.72 0.01%

CONCRETE PAVEMENT
DISPOSAL AREA

0.02% 737.20 0.001%

LEDGE ROCK

0.02% 735.18 0.02%


733.67

732.61

APPLE ORCHARD

TEMPLATE'S SUBGRADE
PRINTED ELEV IS SUBGRADE

SCALE: FEET

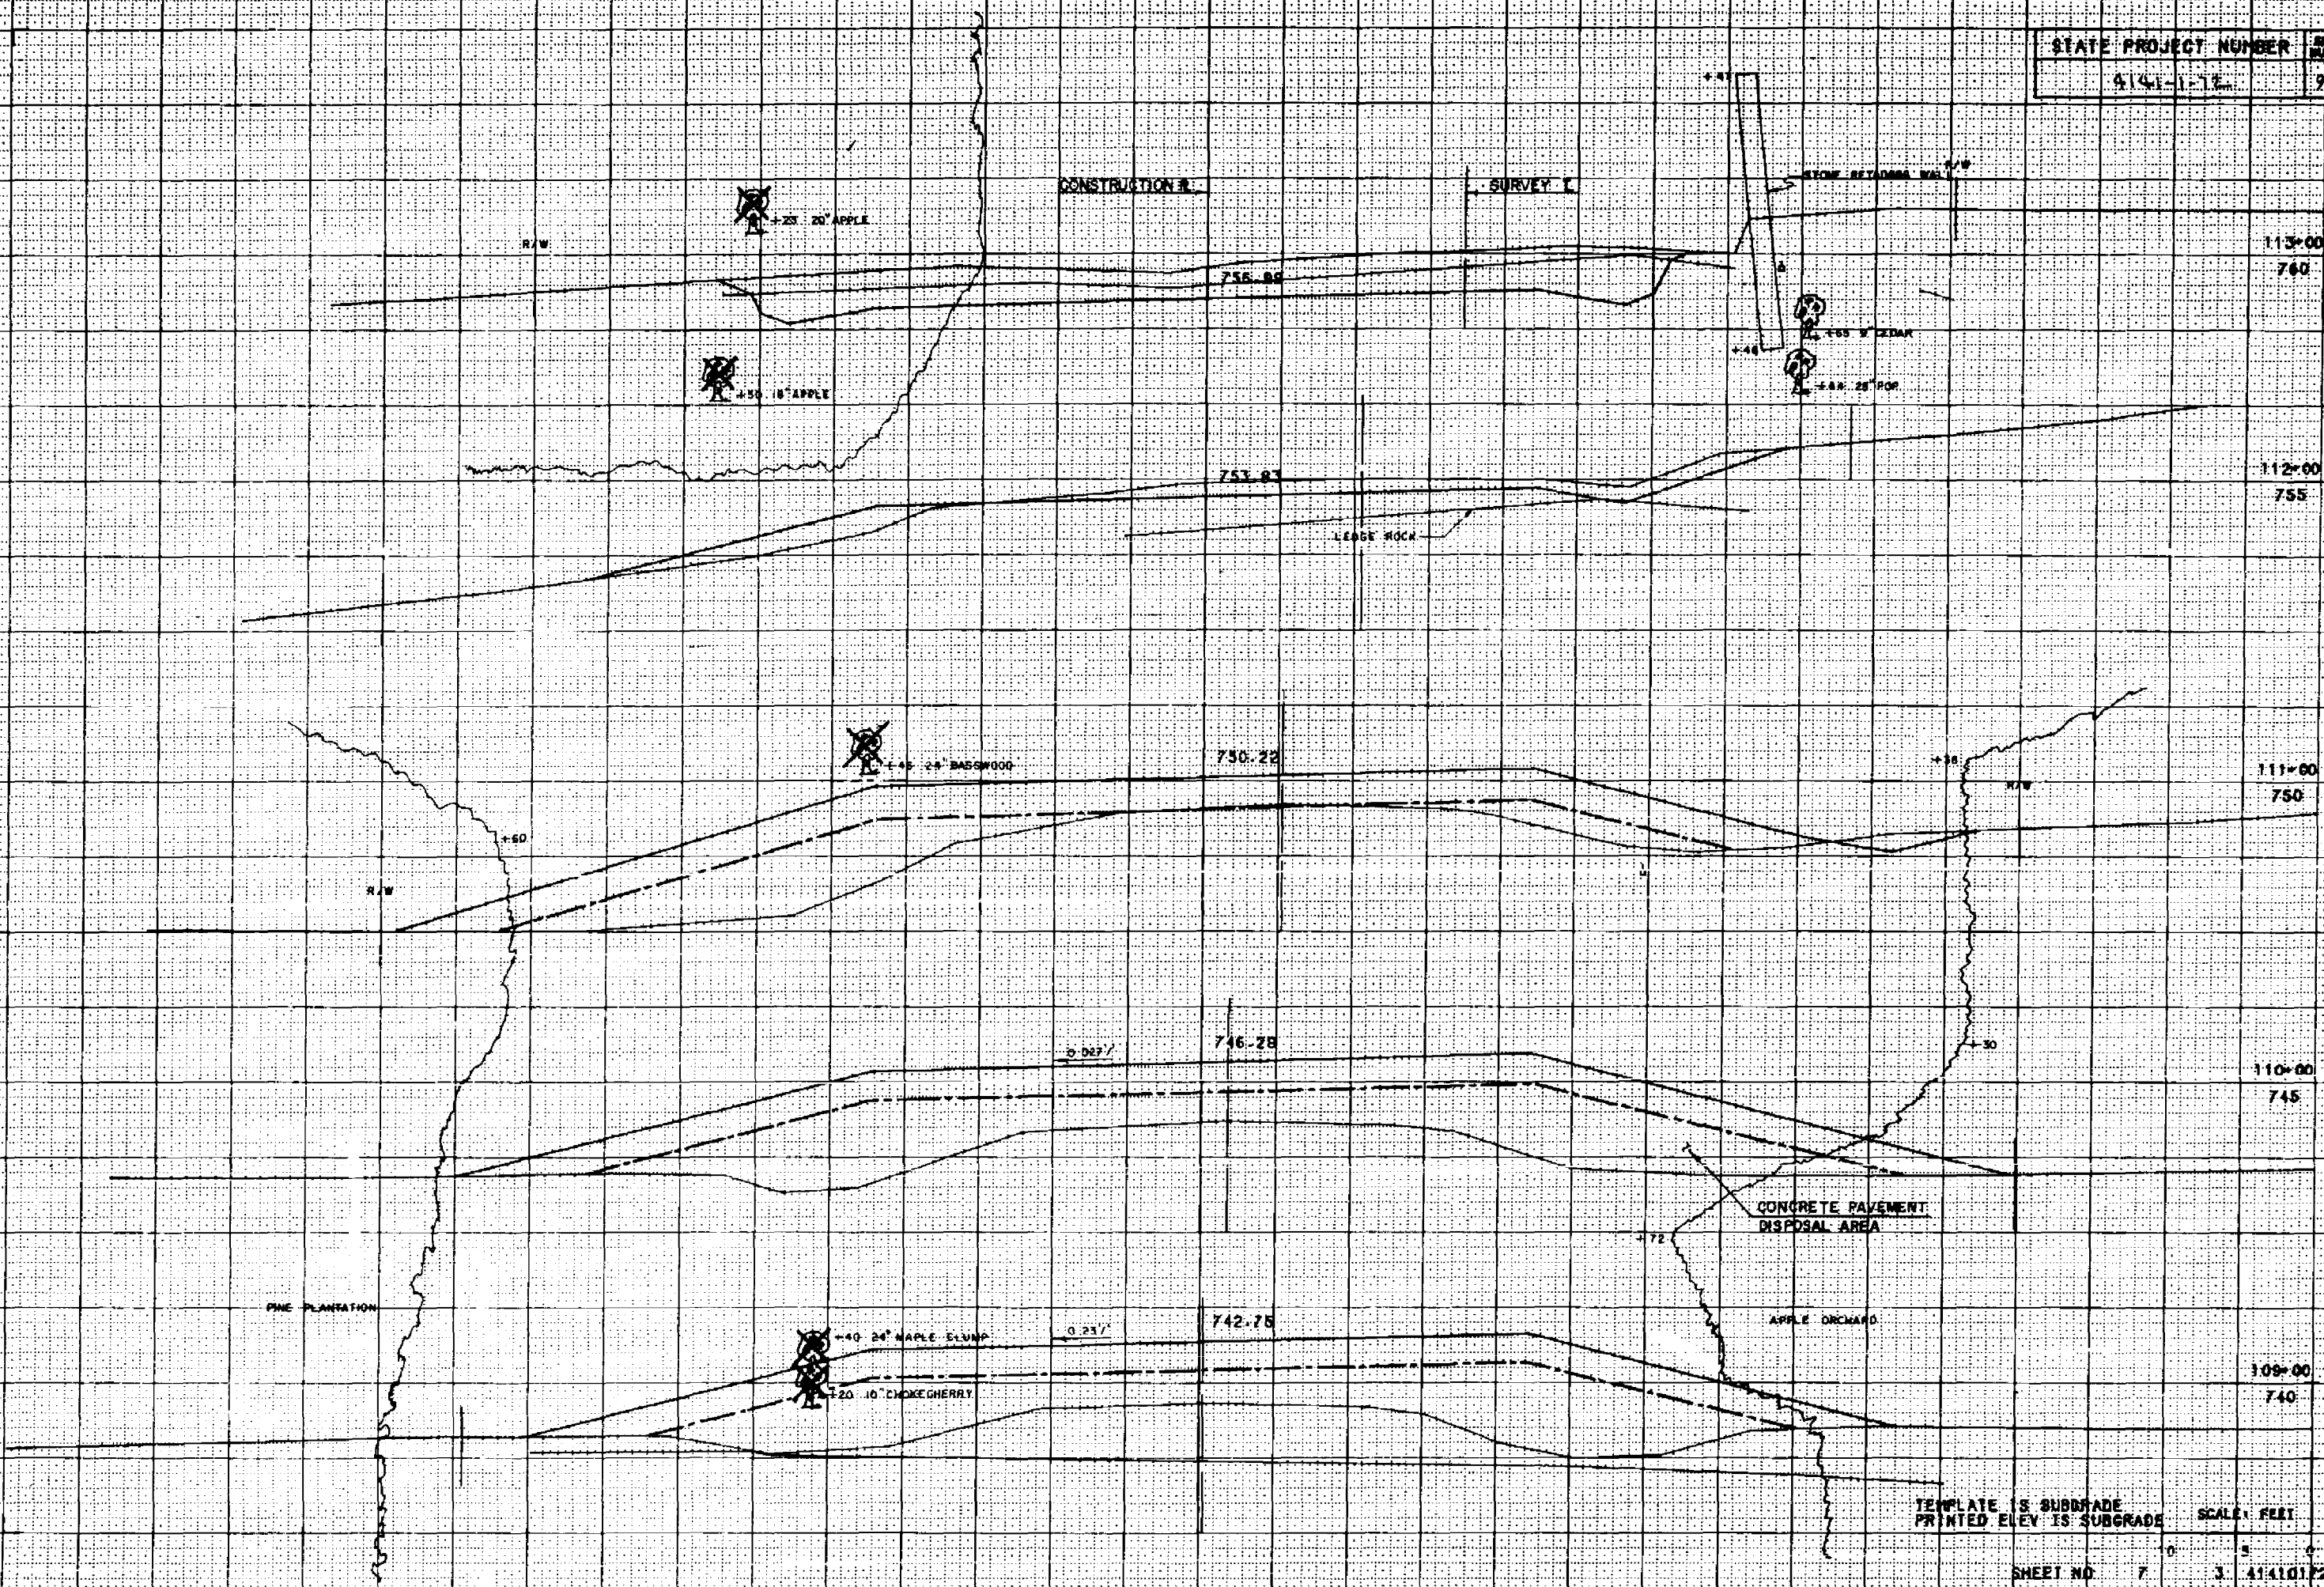

TEMPLATE IS SUBGRADE
PRINTED ELEV IS SUBGRADE

SURVEY 1
CONSTRUCTION 2

STATE PROJECT NUMBER
4141-172
SHEET
245

CONSTRUCTION 2
SURVEY 1
766.12

LEDGE ROCK

APPLE ORCHARD

11' 18" APPLE

15' 22" APPLE

18' 24" APPLE

10' 18" APPLE

14' 18" APPLE

APPLE ORCHARD

STONE RETAINING WALL


BAR

TEMPLATE IS SUBGRADE
PRINTED EVERY IS SUBGRADE

SCALE: FEET

SHEET NO. 2 4141017230

CONSTRUCTION E SURVEY E

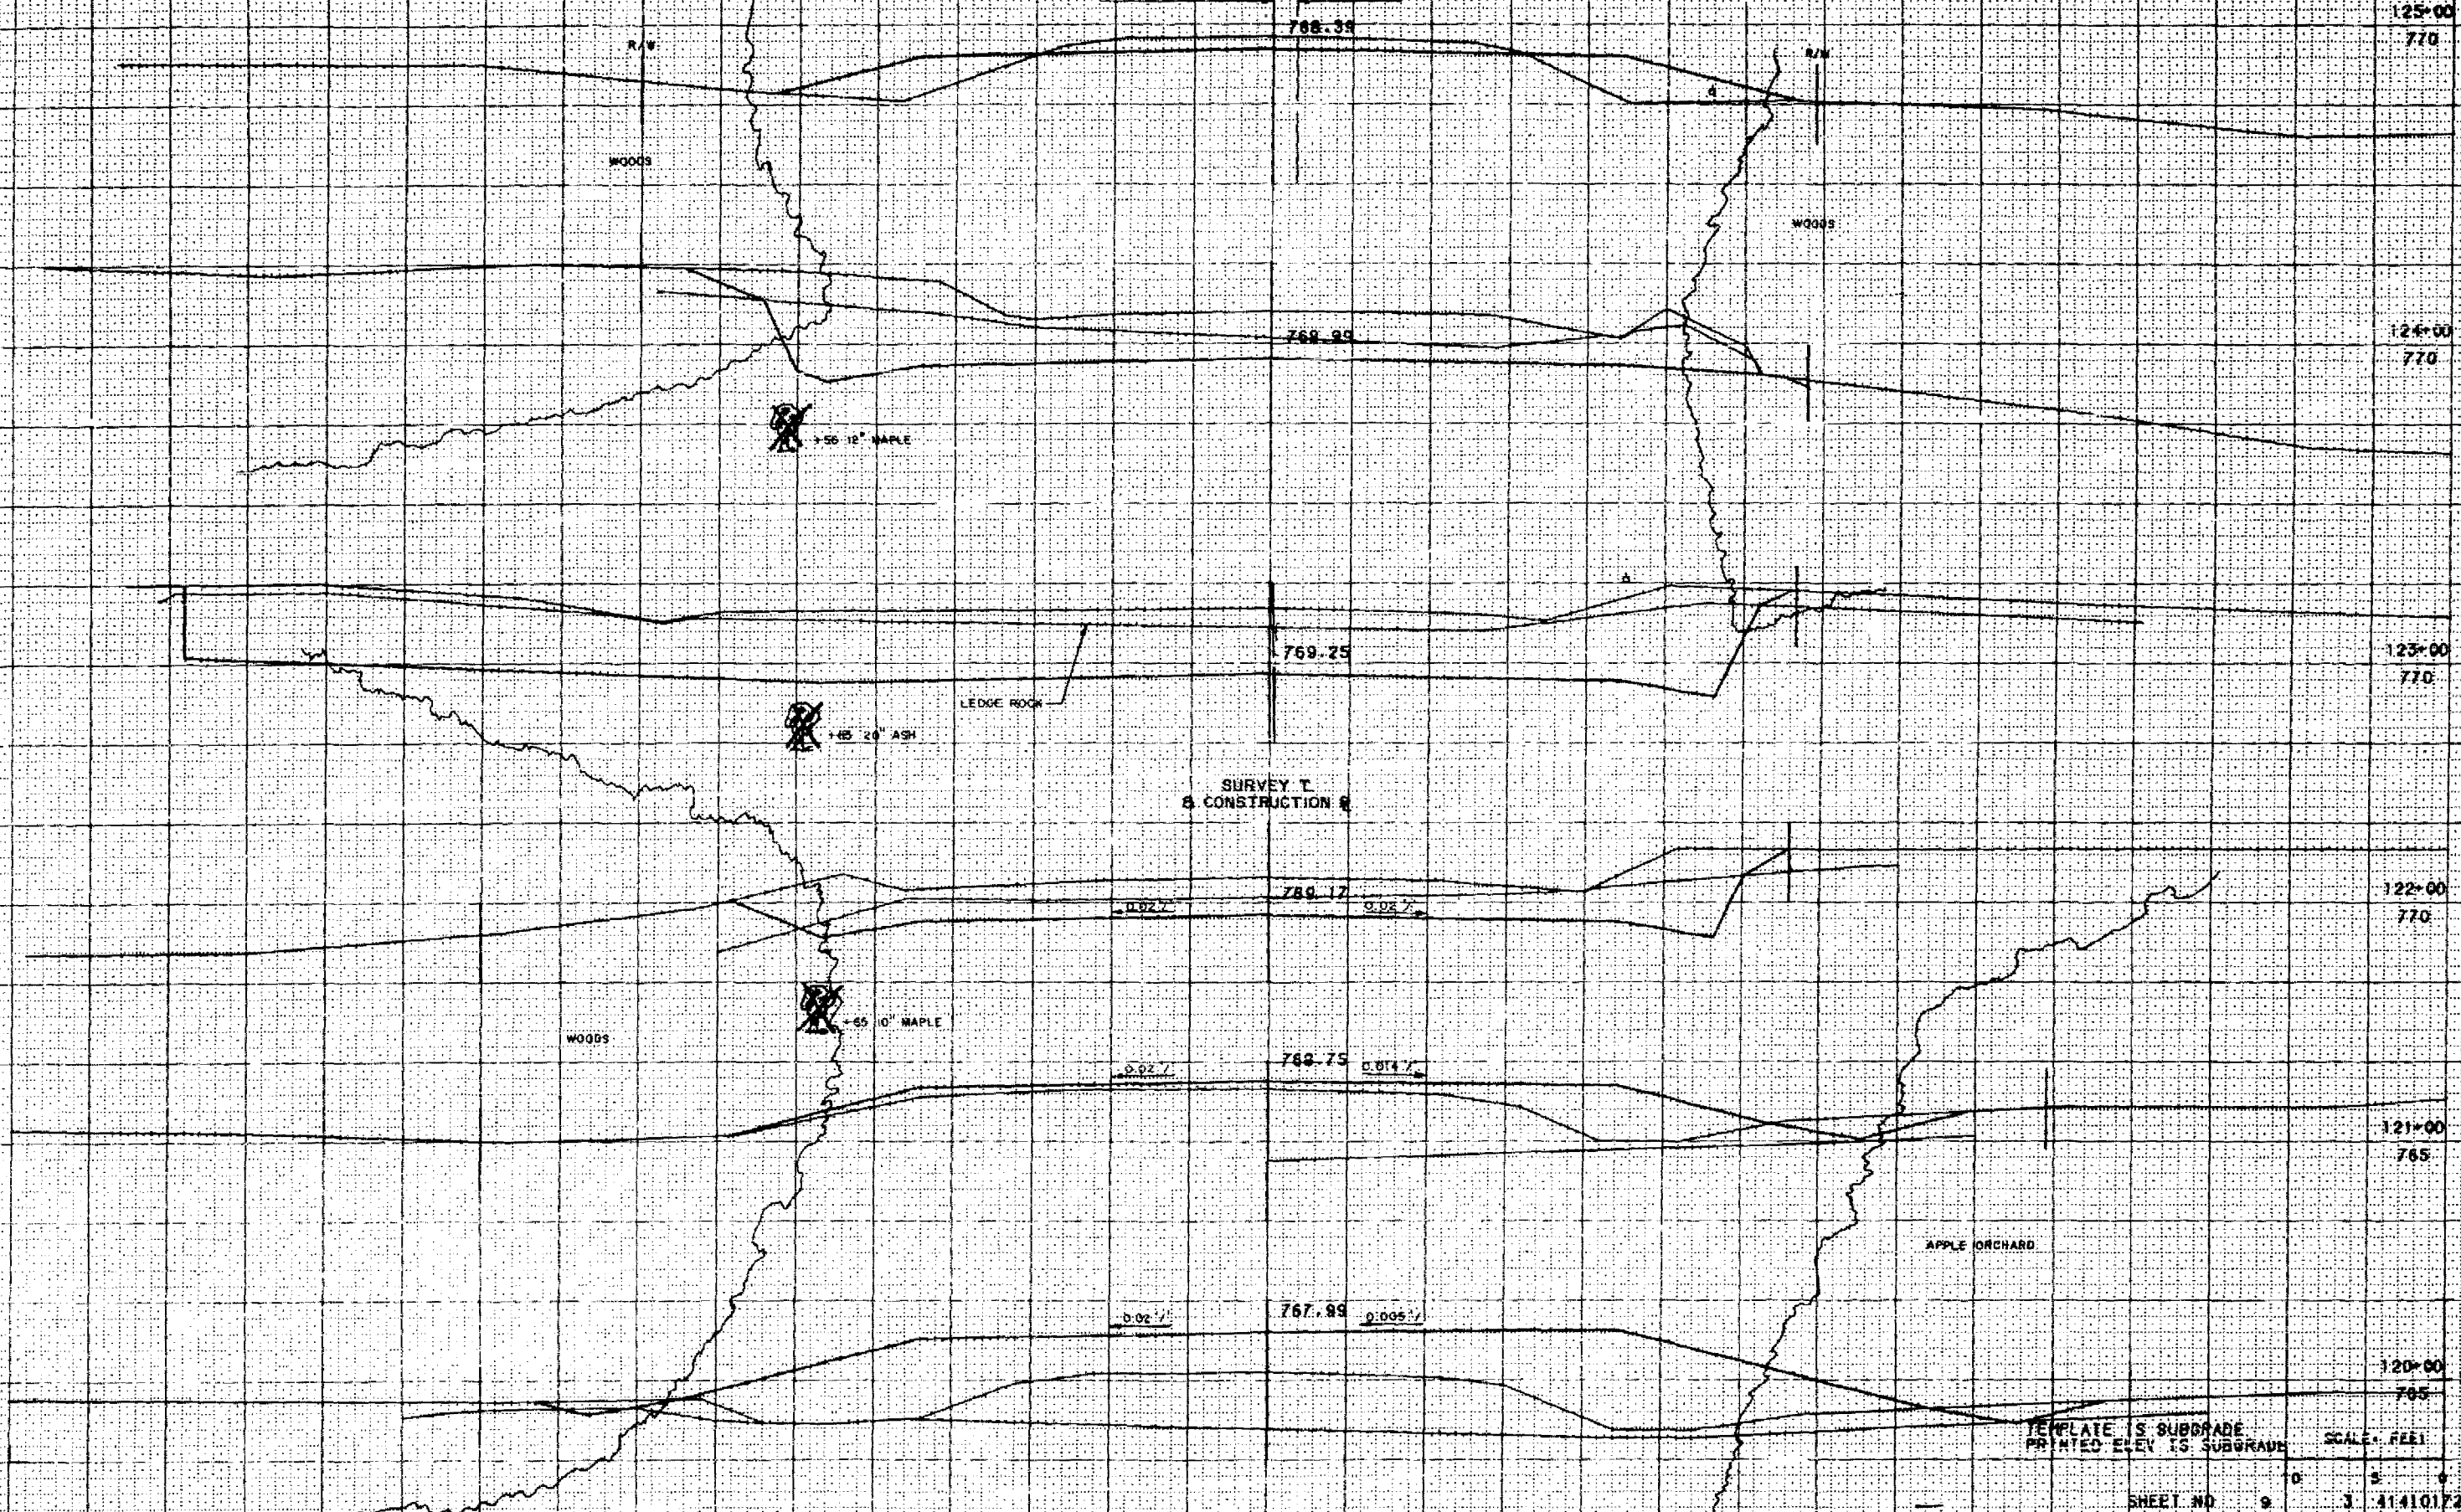


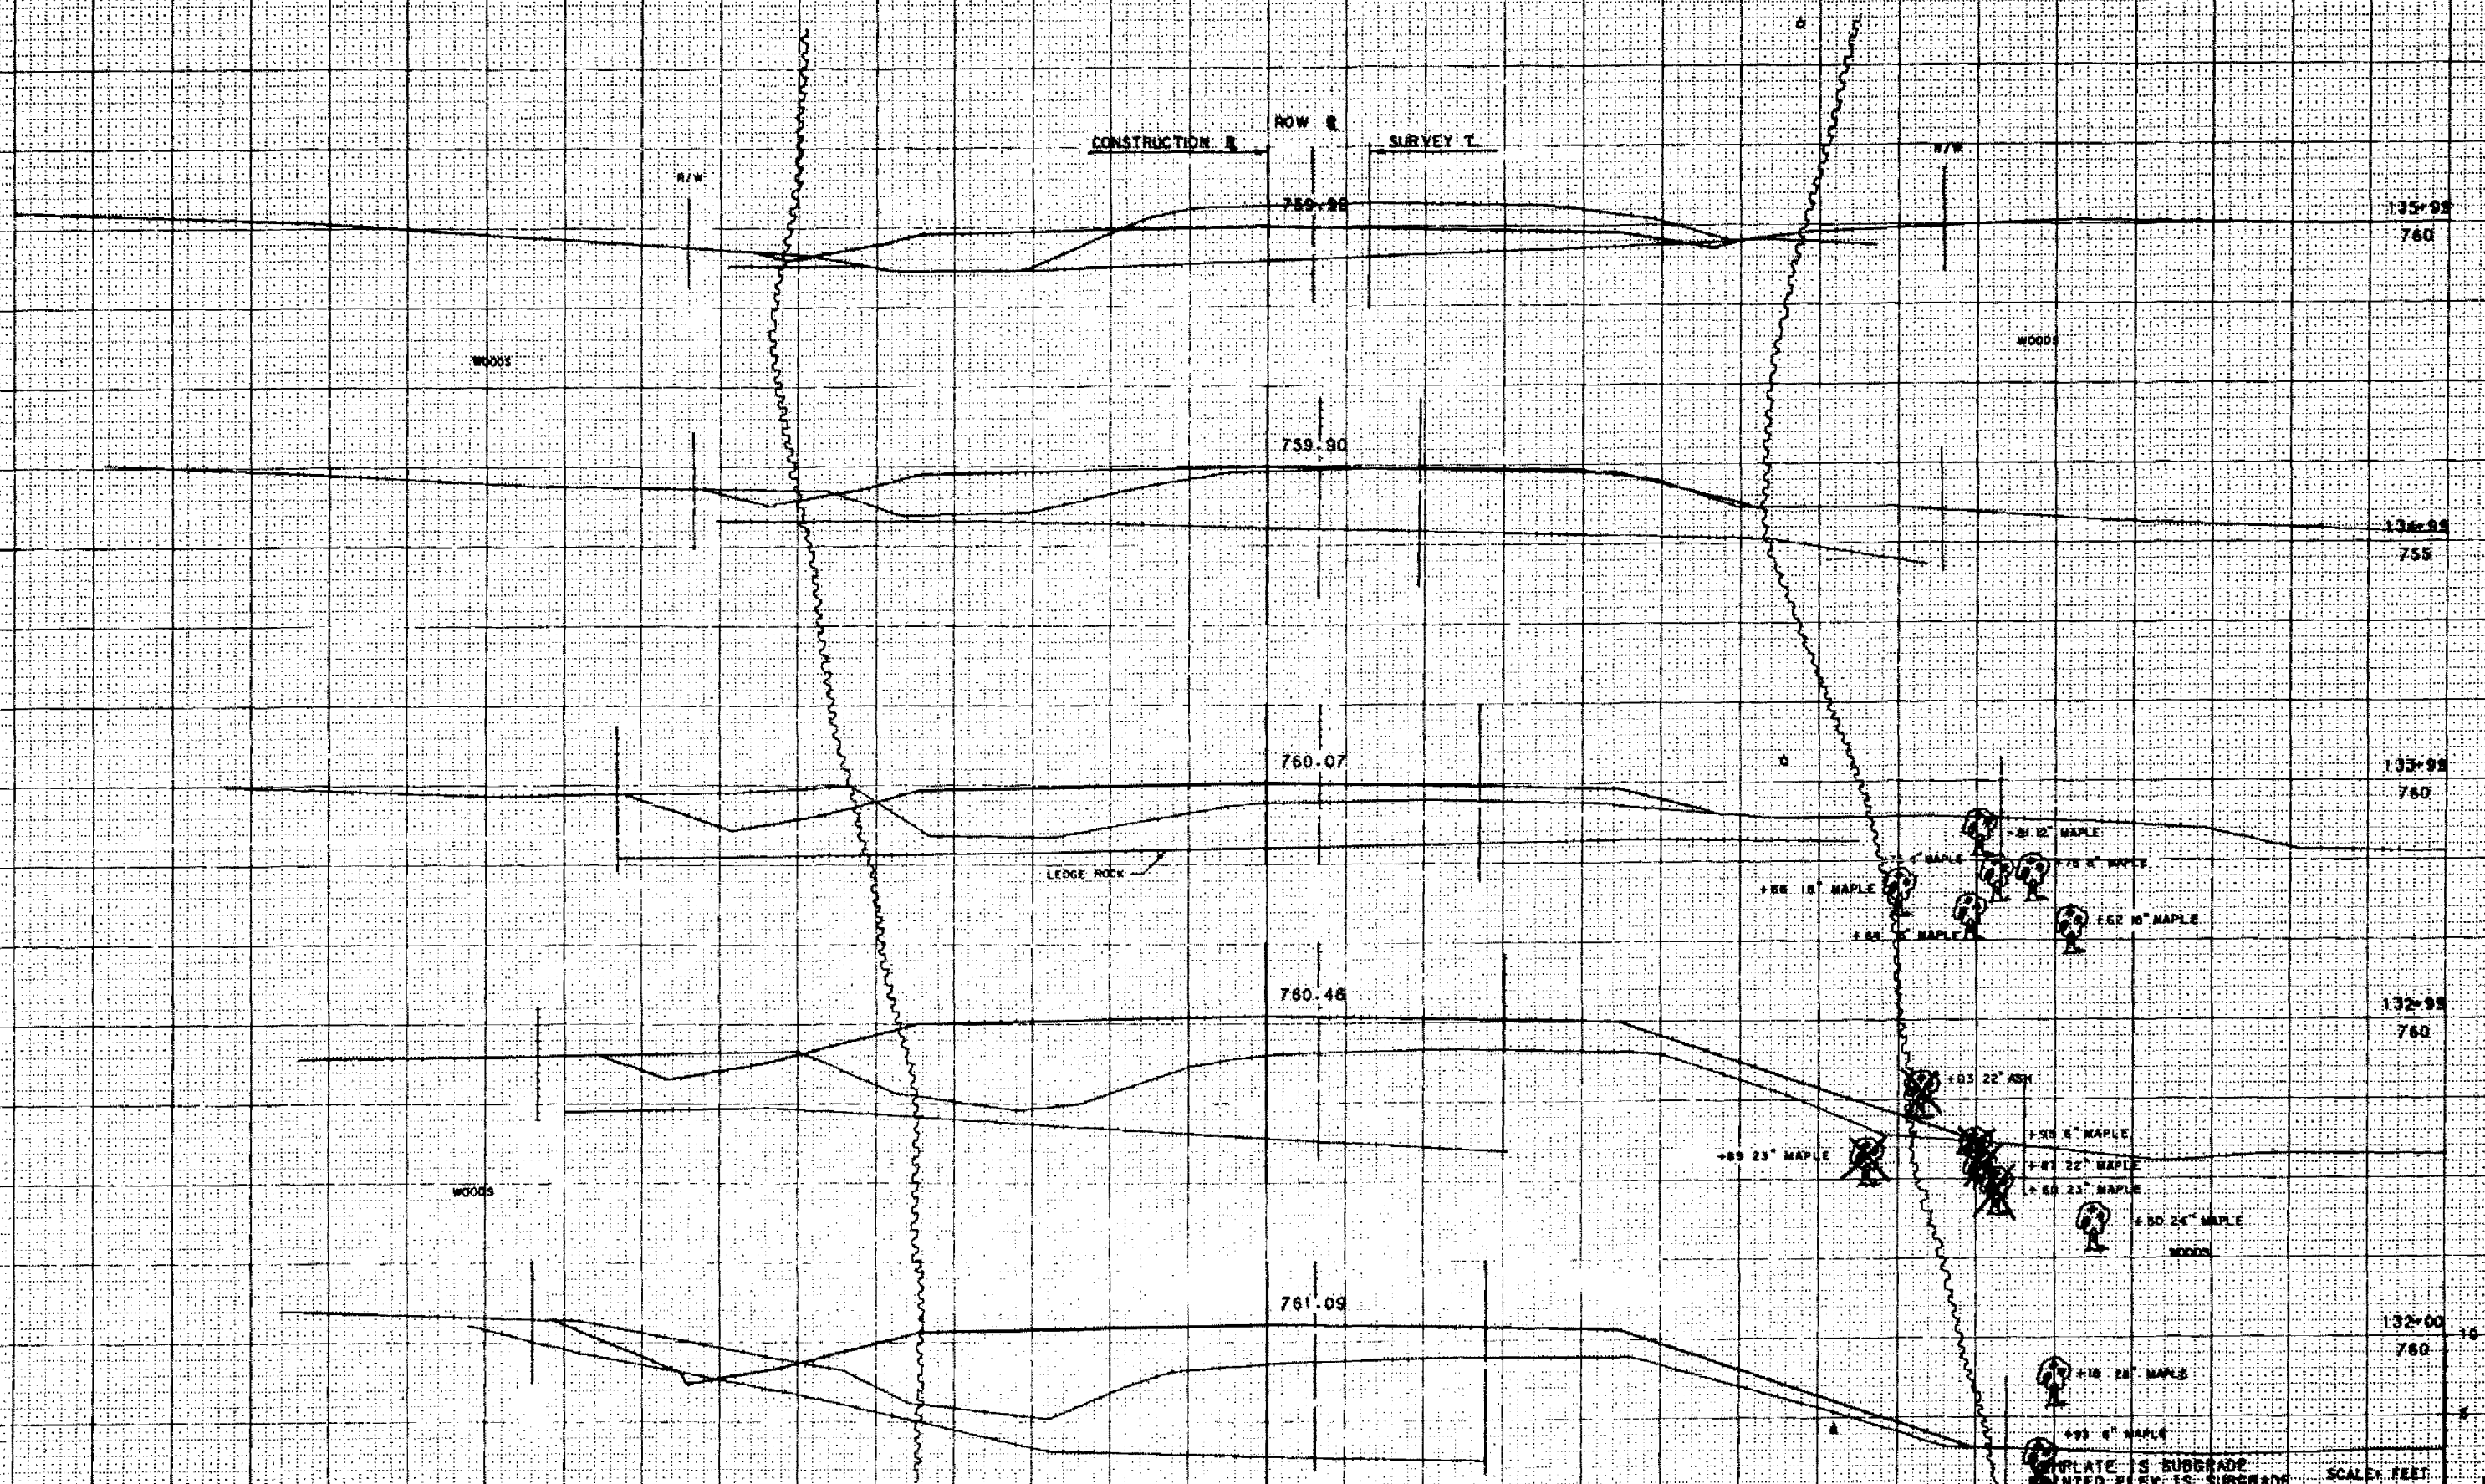



PLATE IS SUBGRADE
 PAINTED ELEV IS SUBGRADE
 SCALE: FEET
 SHEET NO. 11 3 414101258

STATE PROJECT NUMBER	471-1-72
DATE	4-47

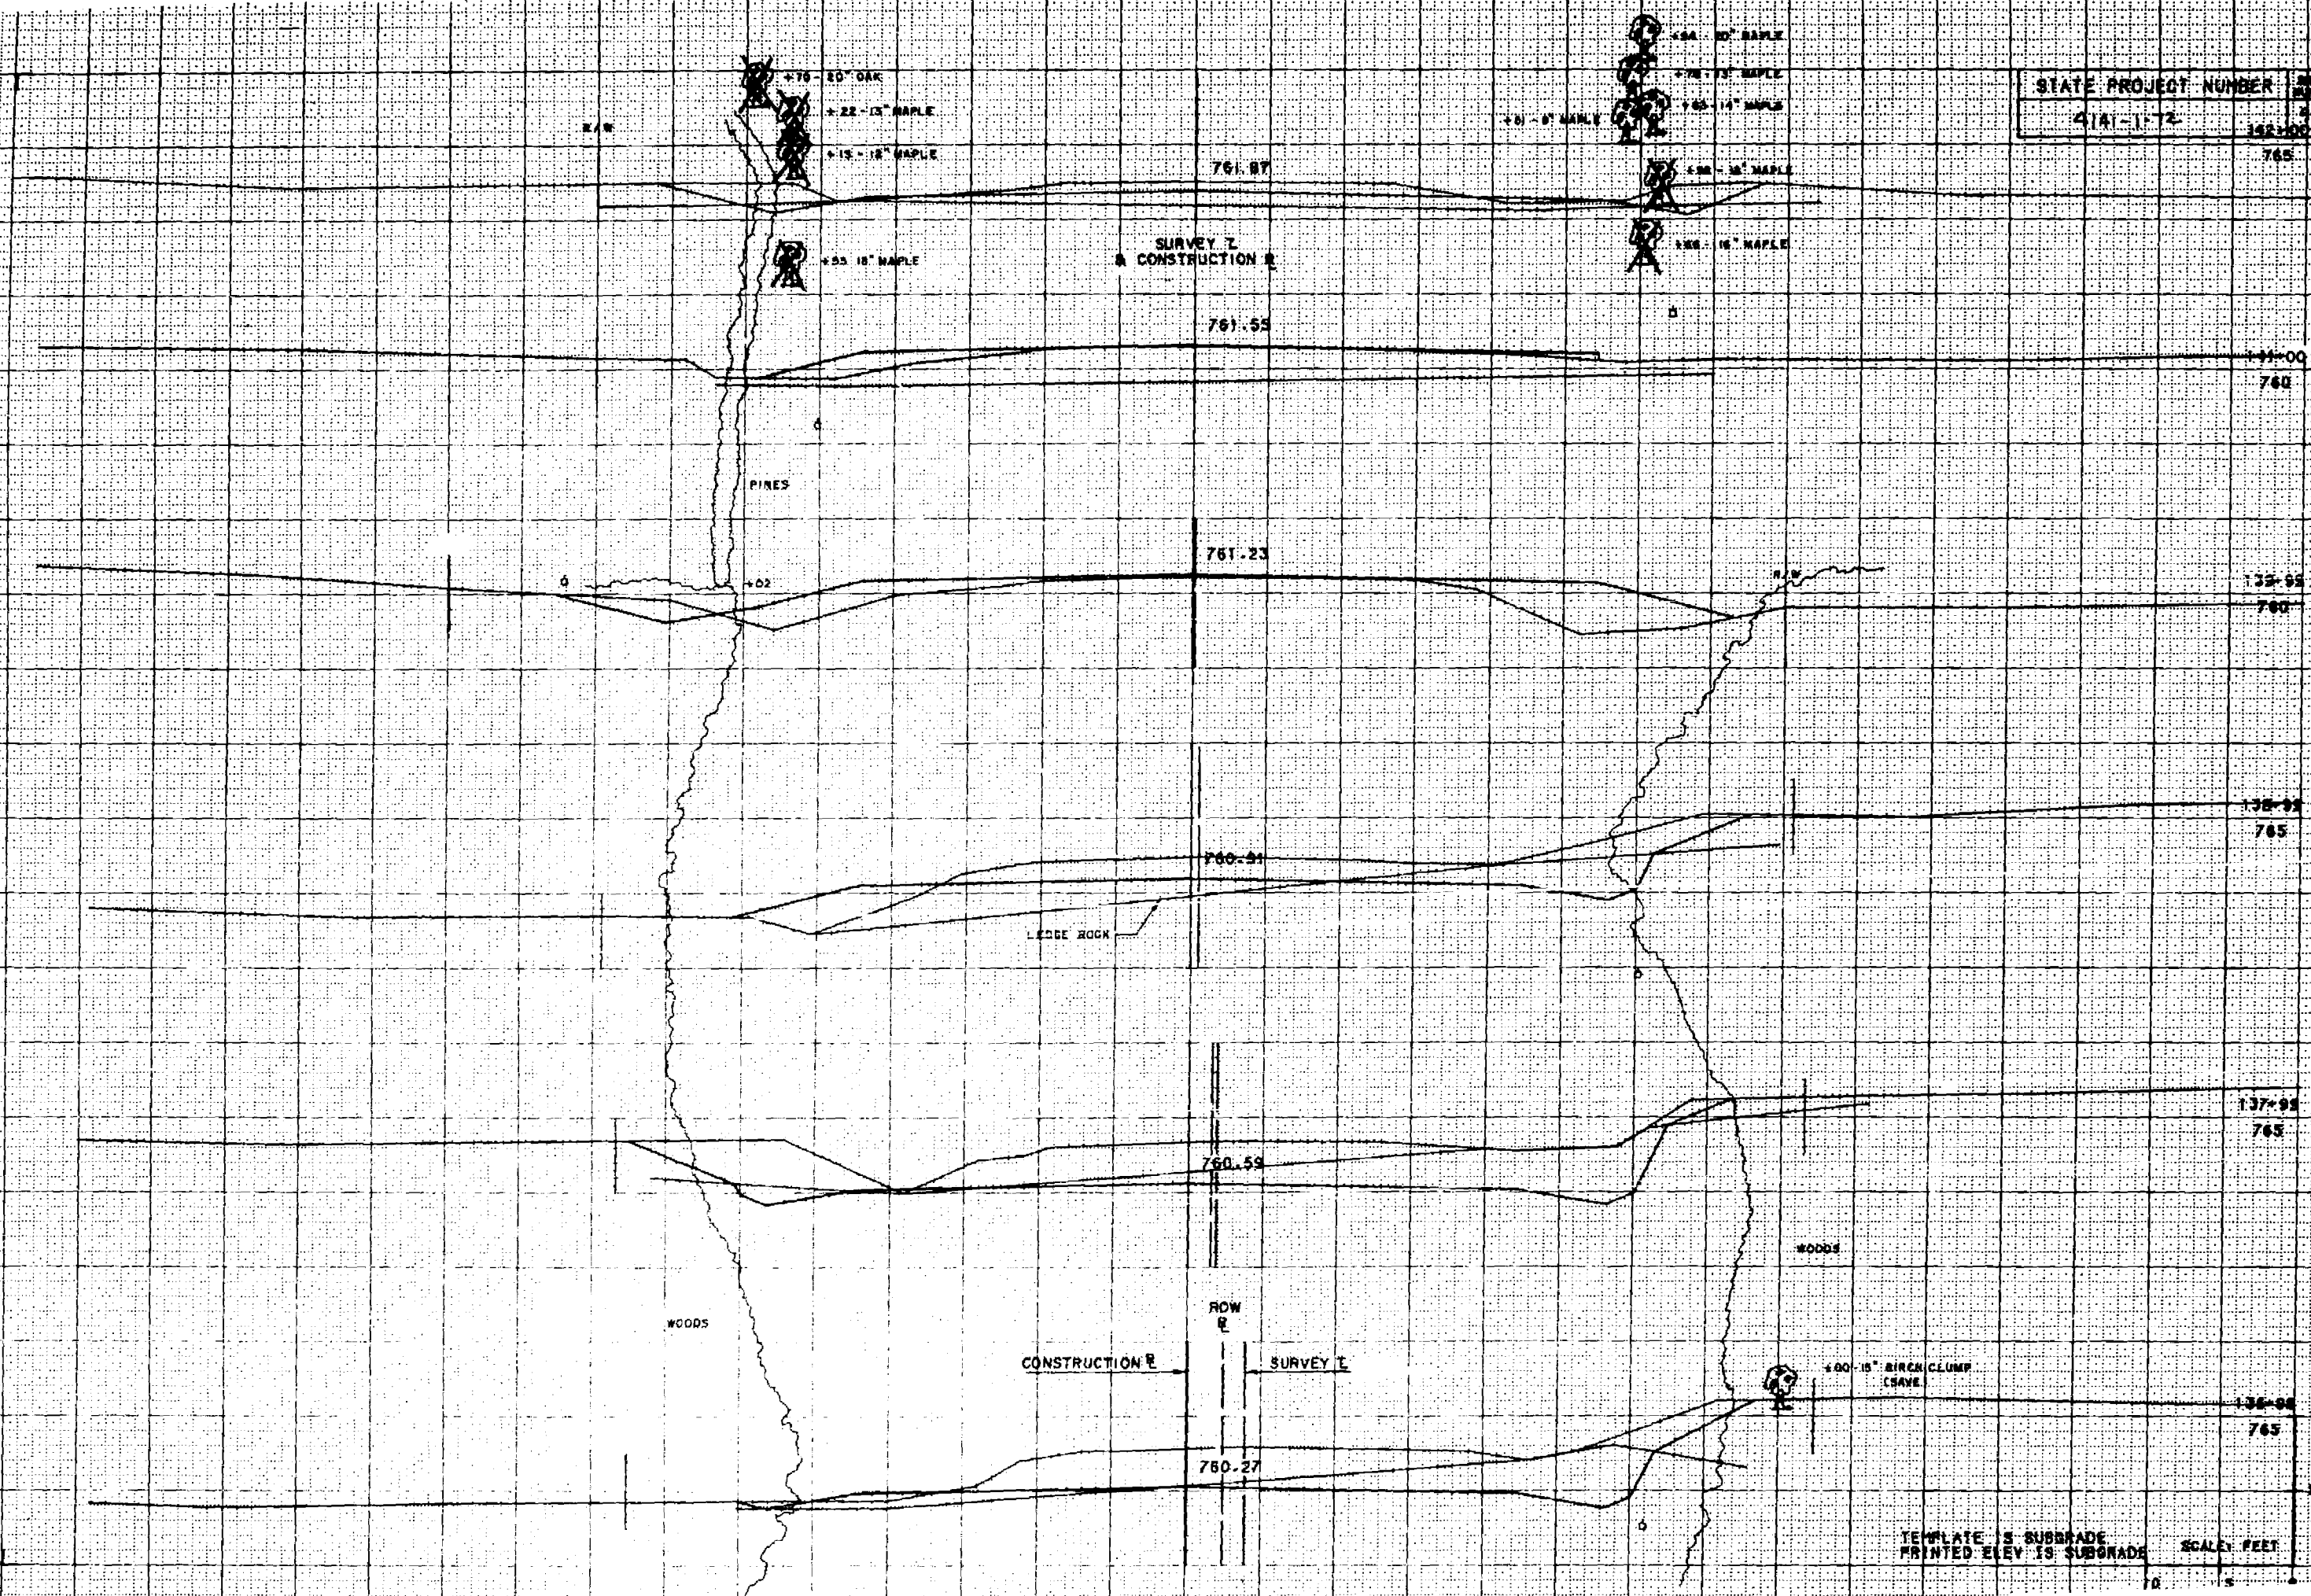

TEMPLATE IS SUBGRADE
 PRINTED ELEV IS SUBGRADE
 SCALE: FEET
 1" = 10'

SURVEY 1
CONSTRUCTION

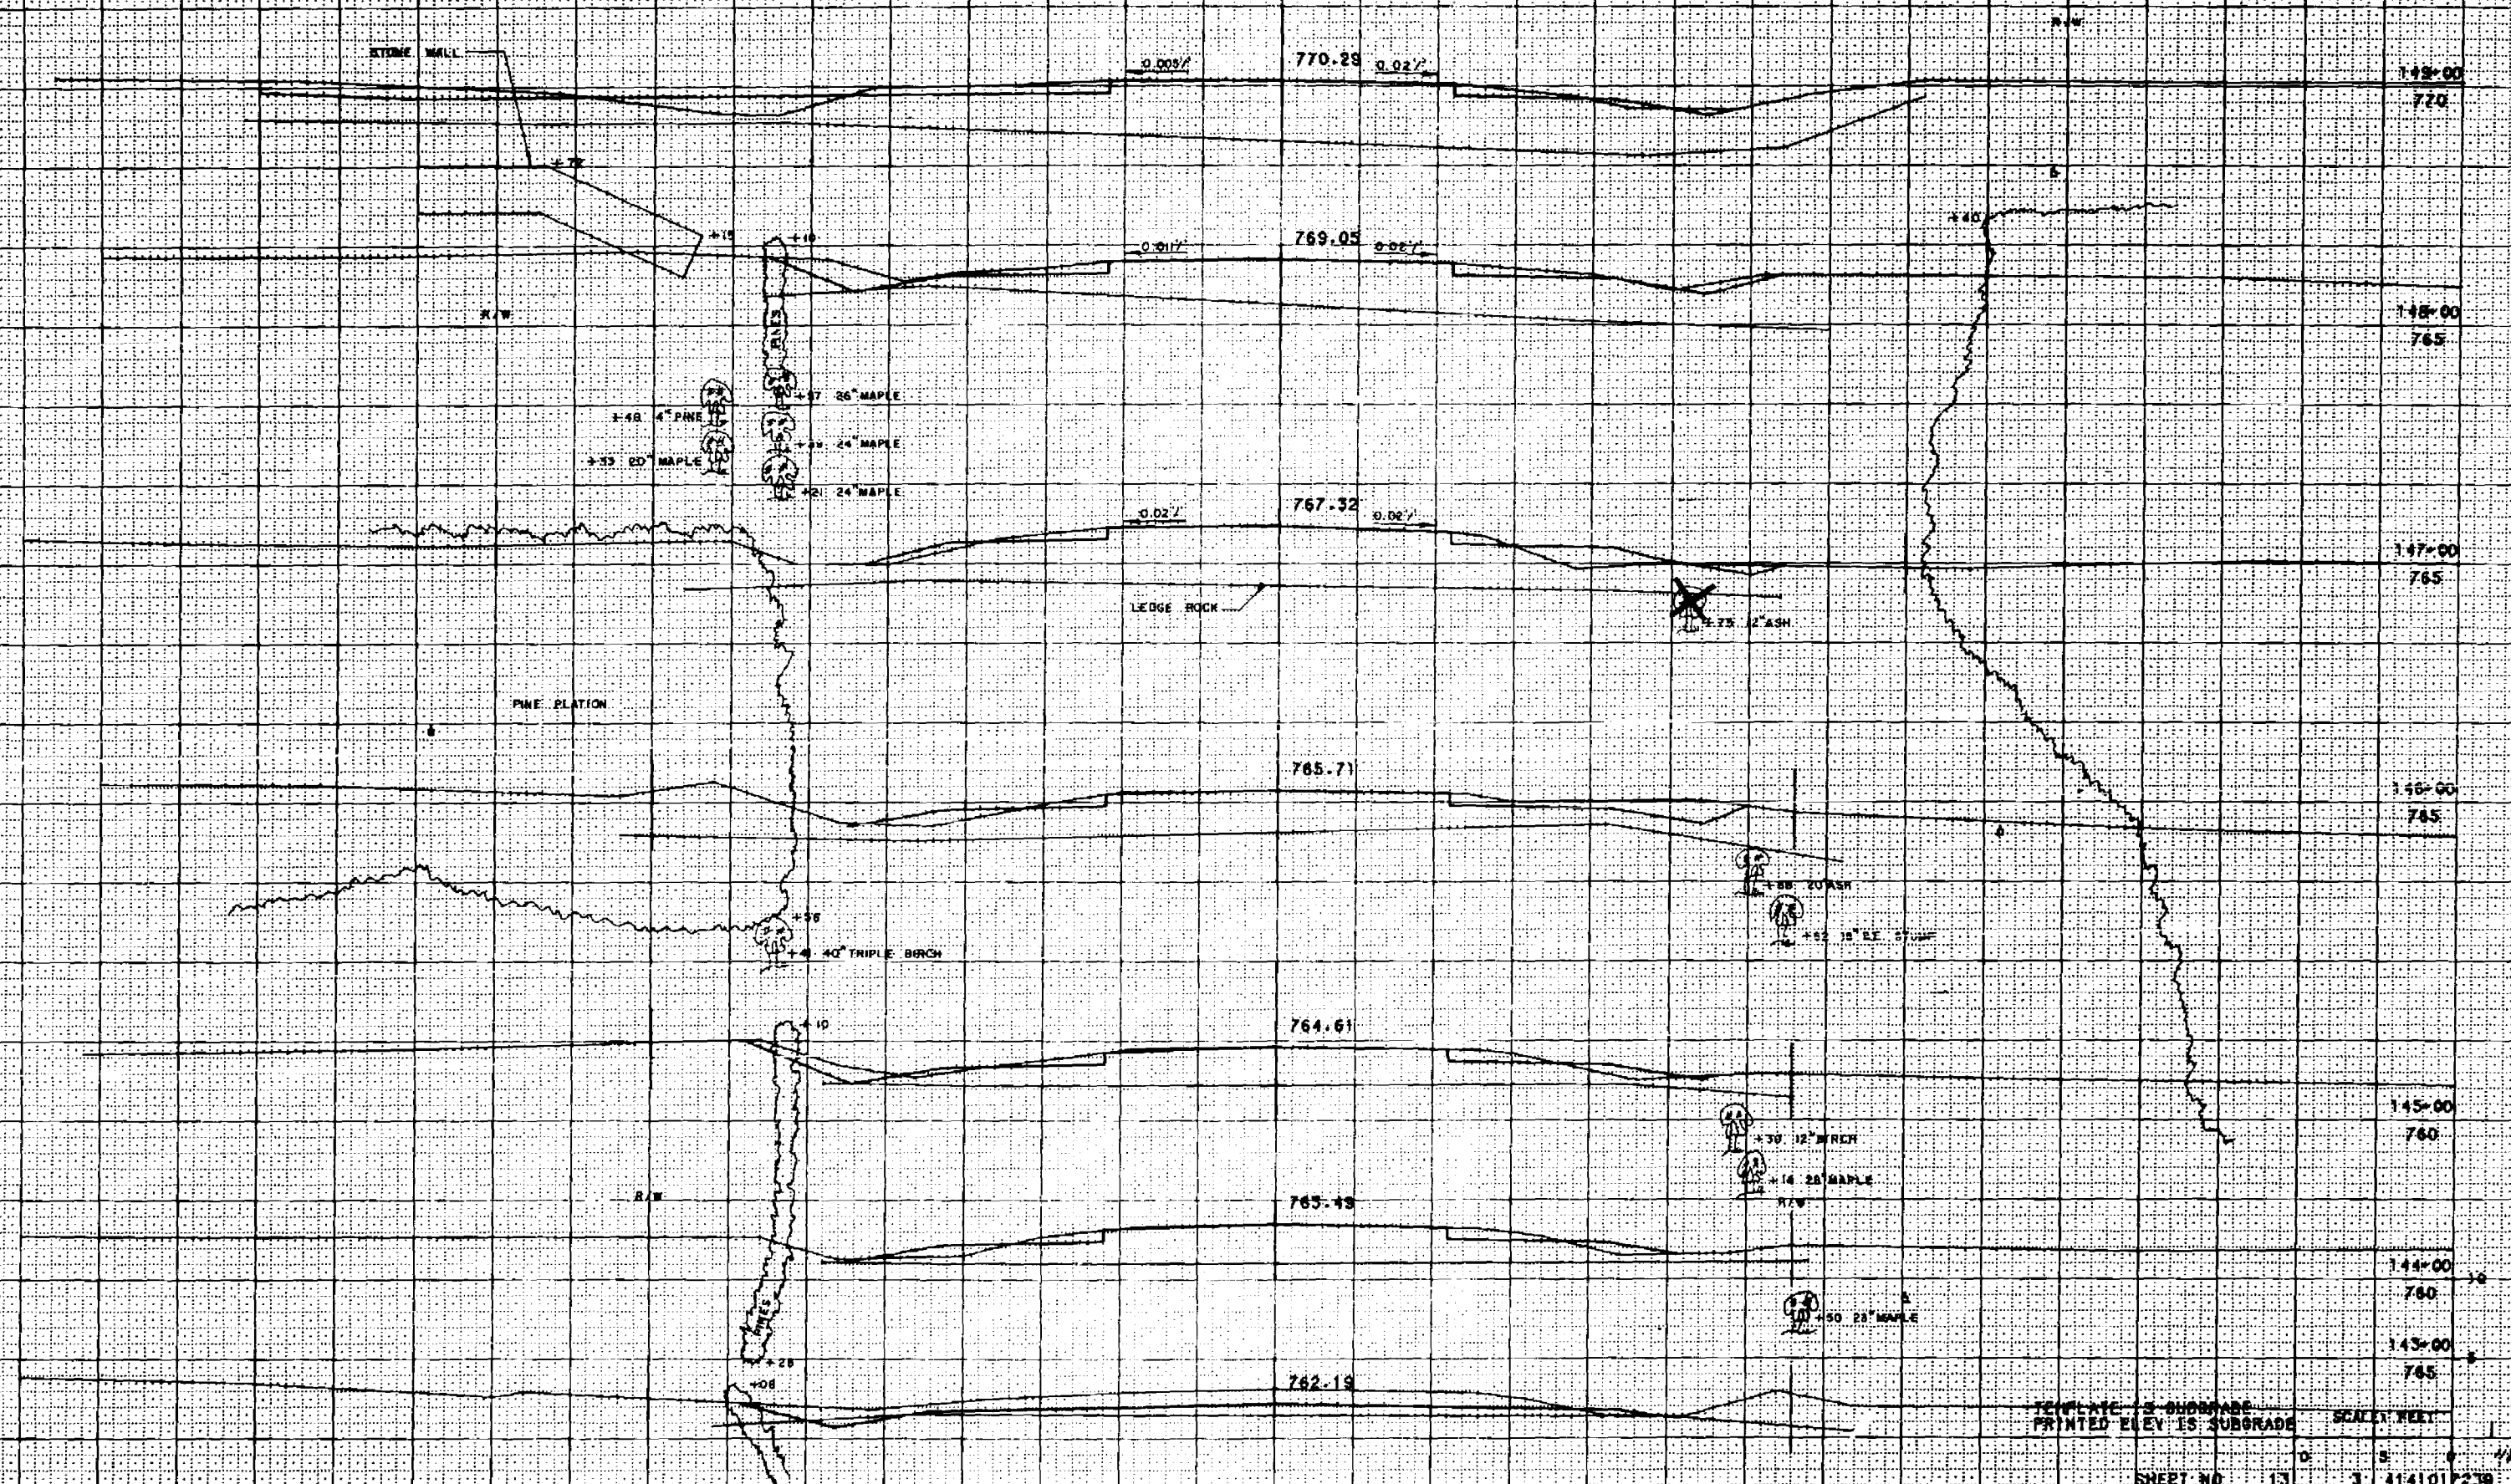

SURVEY 1.
B. CONSTRUCTION 2.

STATE PROJECT NUMBER
4141-1-712 156-00

772.77

0.02%

770

773.01

155+00

770

773.06

CHERRY ORCHARD

154+00

770

773.08

153+00

770

772.94

152+00

770

772.44

0.02%

LEDGE ROCK

151+00

770

771.44

0.03%

0.02%

150+00

770

TEMPLATE IS SUBGRADE
PRINTED ELEV IS SUBGRADE

SCALE: FEET

SHEET NO. 14 3 4141D1P230

+44 2" SPRUCE

+38 4" CEDAR

+00 4" CEDAR

+82 4" CEDAR

+43 5" CEDAR

+21 5" CEDAR

+74 4" WILLOW

+34 50" WILLOW

+82 15" PINE

+98 7" CHERRY CHERRY

+95 12" PINE

+61 5" PINE

+52 4" DE

+49 5" DE

+37 5" MAPLE

STONE FENCE

+97

+90


+63

STONE FENCE

+04

STATE PROJECT NUMBER
4141-1-72 9.50

SURVEY 1
B. CONSTRUCTION

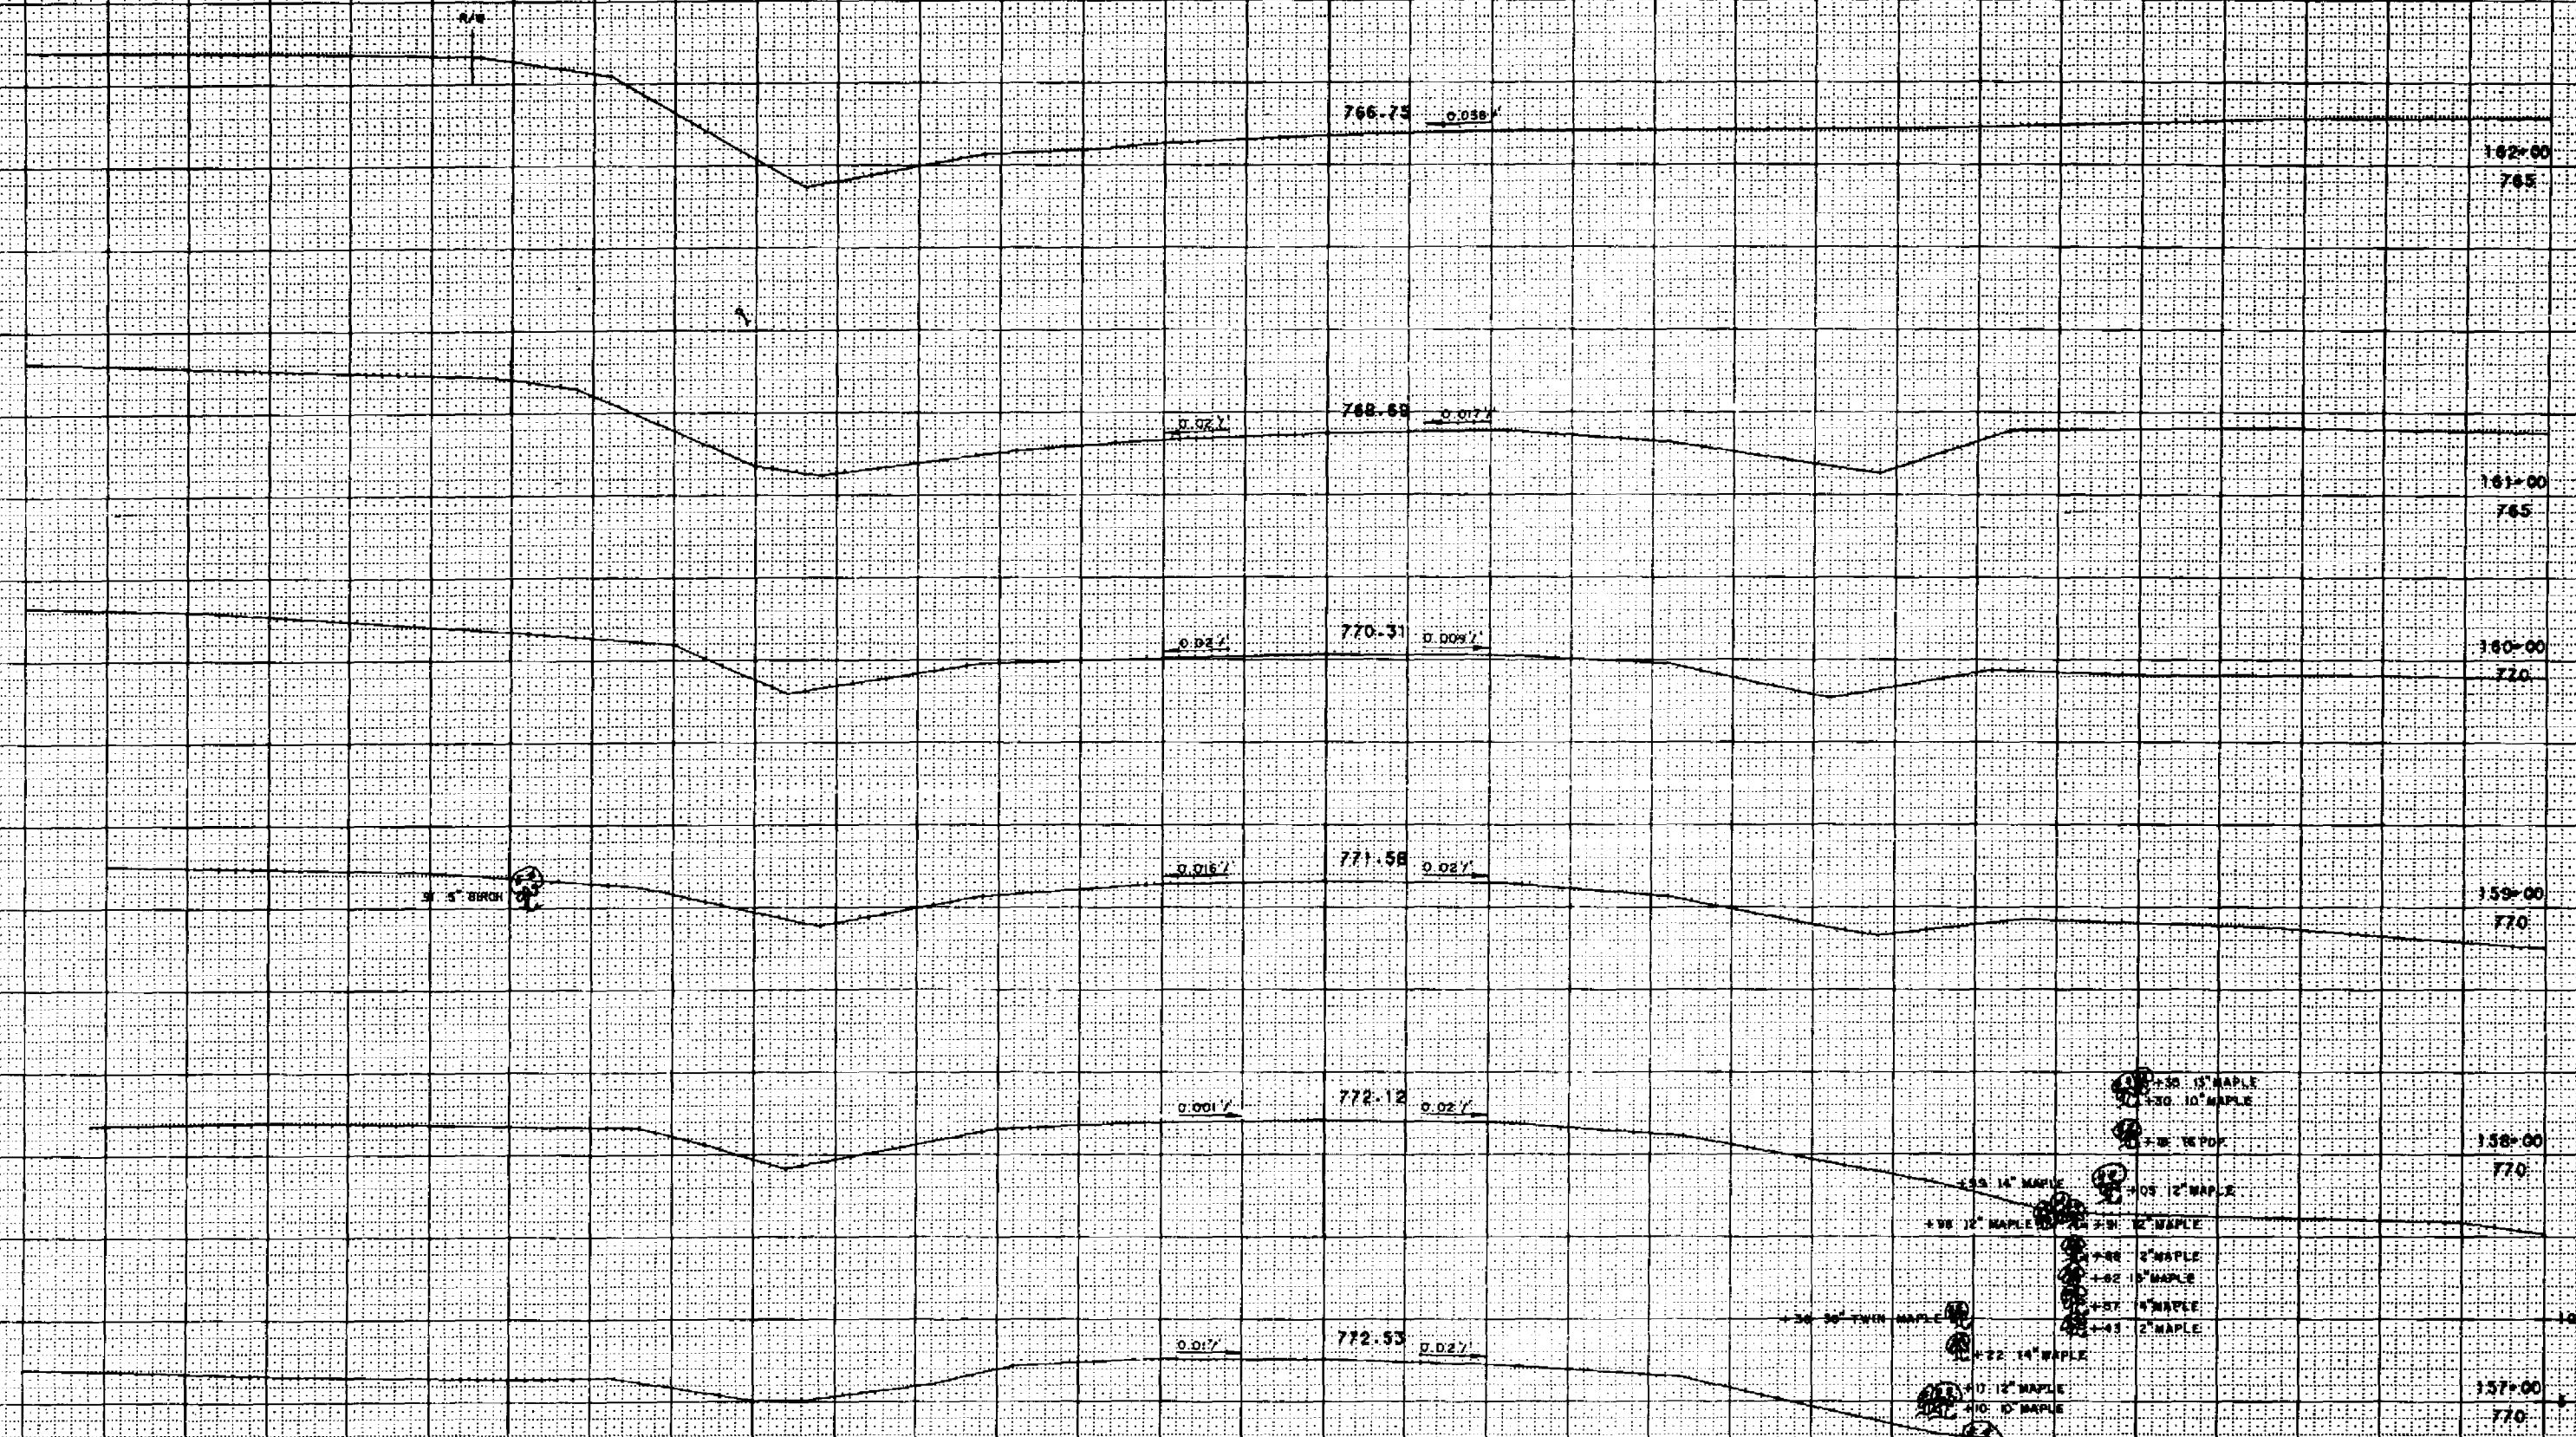

REMARKS: 1.5 SUBGRADE
PRINTED ELEV IS SUBGRADE

SHEET NO 15 3 4141.01 238

SURVEY 2
CONSTRUCTION 2

STATE PROJECT NUMBER
4141-114

9.51

748.72

167+00

745

753.68

168+00

750

757.24

169+00

755

761.40

170+00

760

764.42

171+00

765

0.0437


TEMPLATE IS SUBGRADE
PRINTED ELEV IS SUBGRADE

SCALE 1"=20'

SHEET NO. 16 3 4141017259

STATE PROJECT NUMBER	SHEET NUMBER
44-1-72	252

SURVEY 1
B. CONSTRUCTION

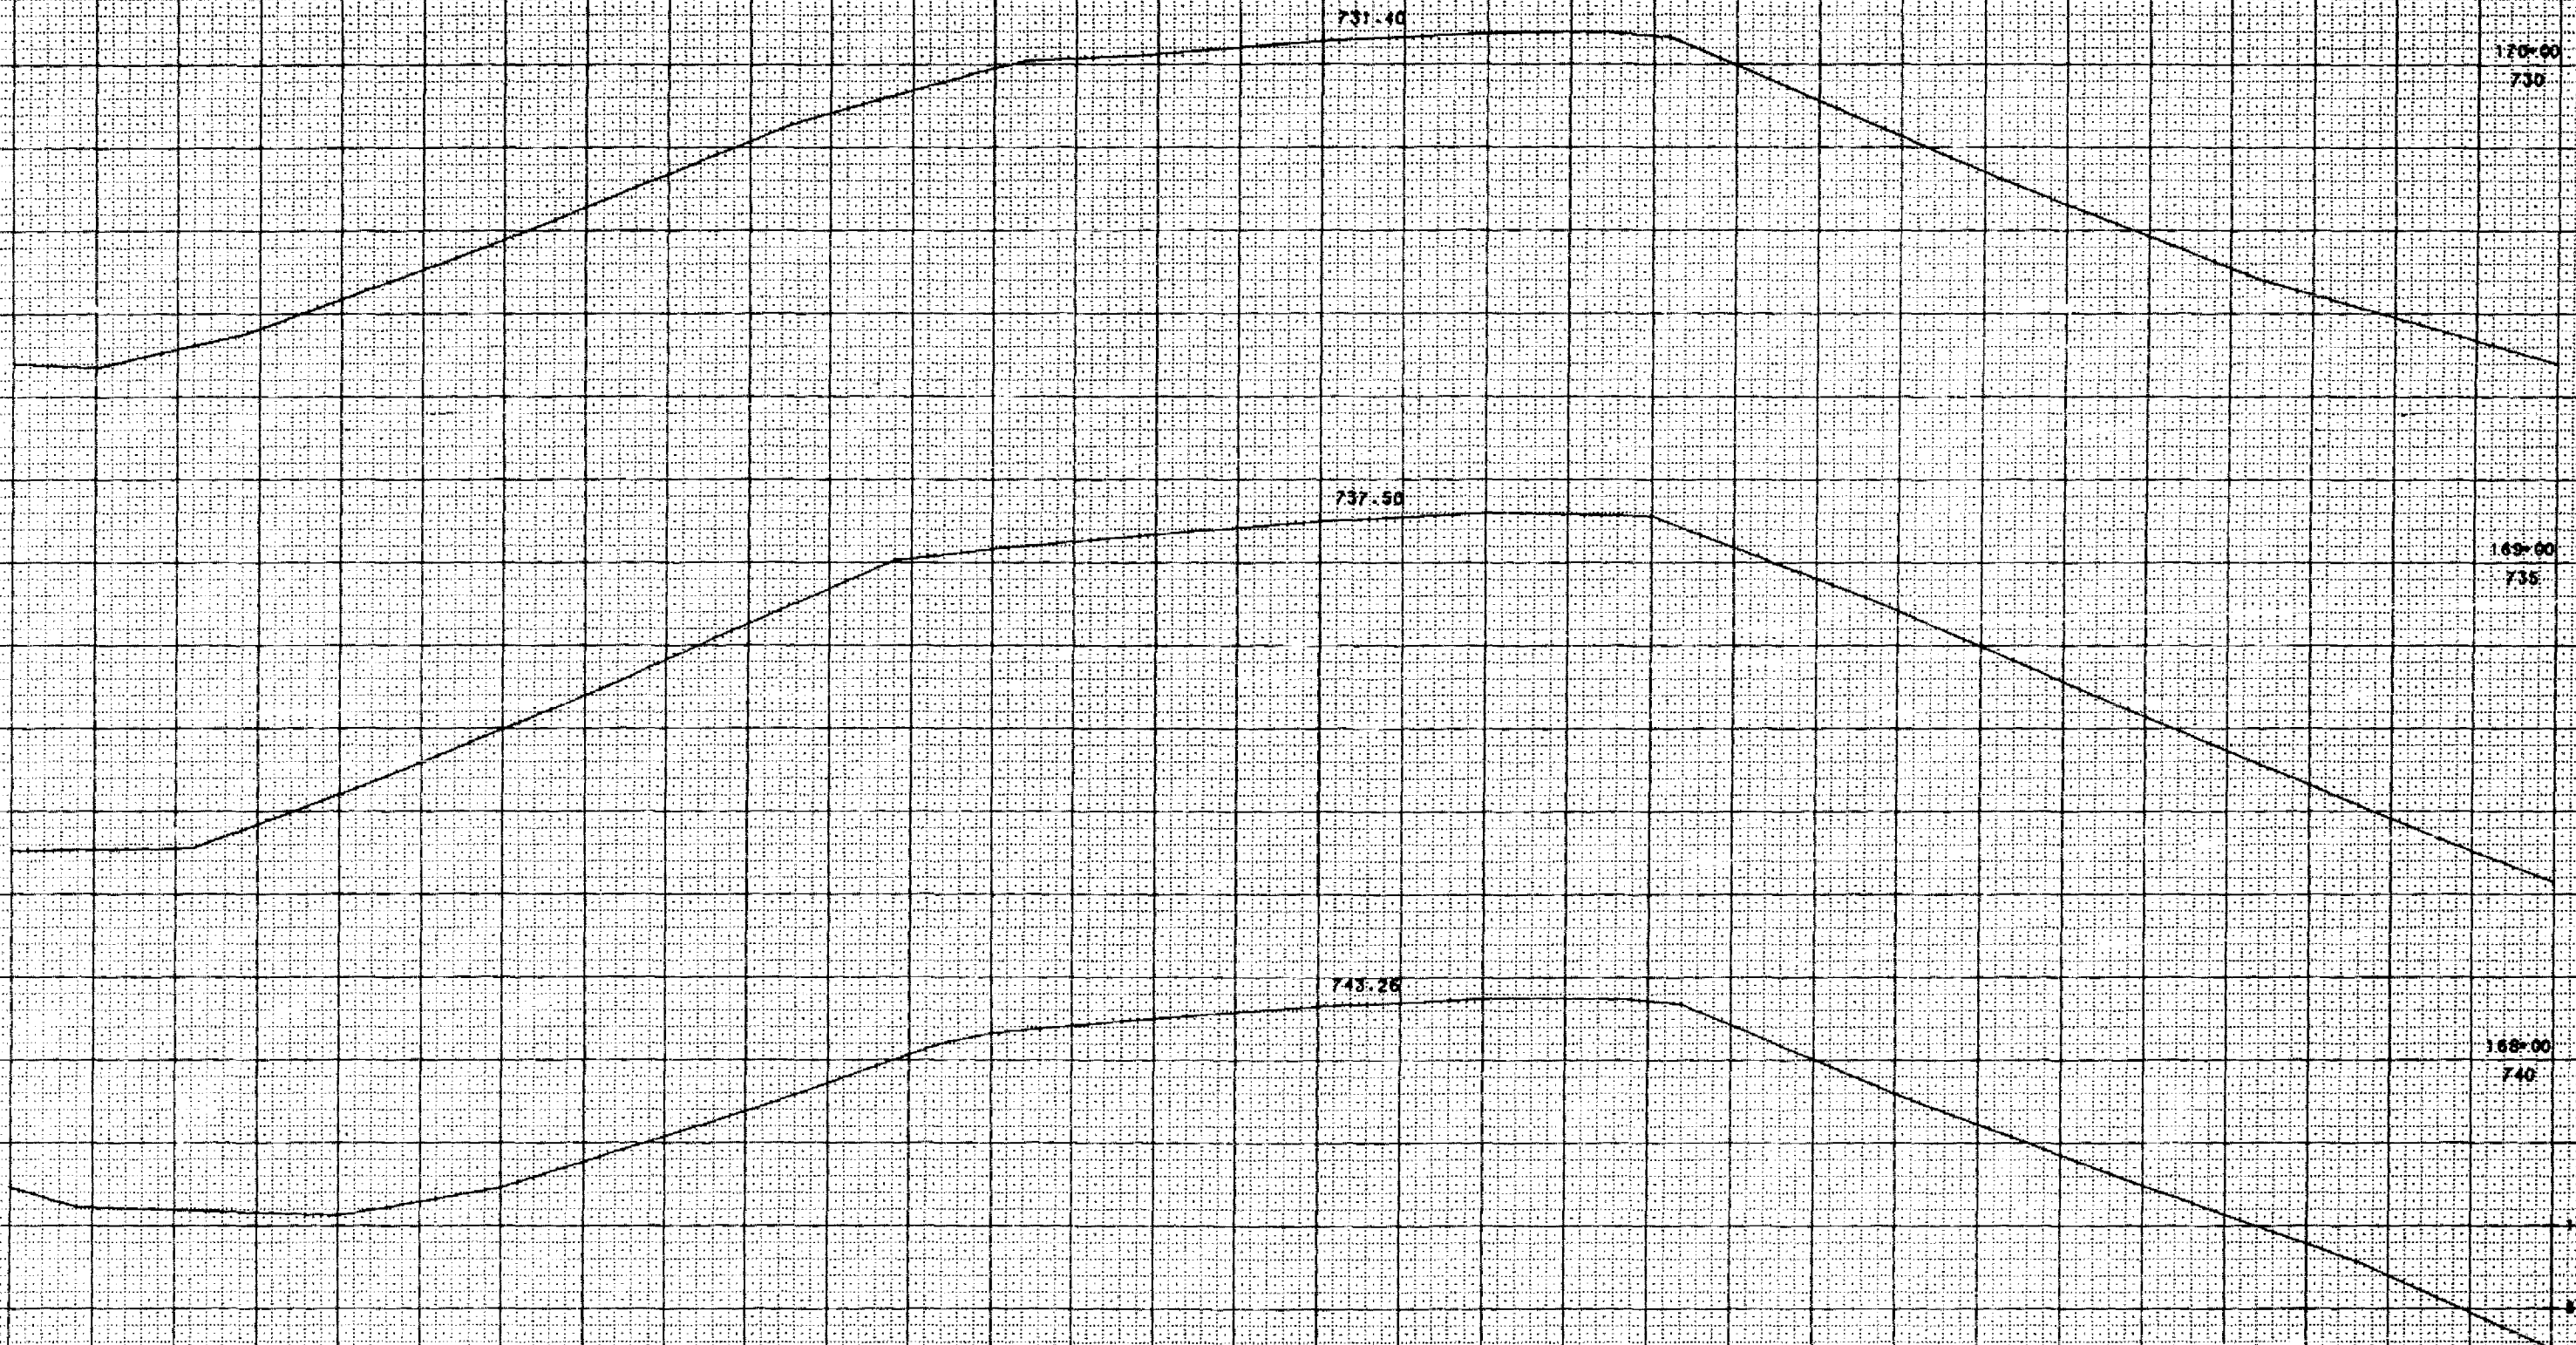

TEMPLATE IS SUBGRADE
PRINTED ELEV IS SURGRADE

SHEET NO. 17 SCALE: FEET
1 414101/239

STATE PROJECT NUMBER 1001
41411-12-1751

SURVEY C
B. CONSTRUCTION B

0.0457

714.63

175-00
710

719.36

172-00
715

725.18

171-00
725


10

TEMPLATE 15 SUBGRADE
PRINTED ELEV IS SUBGRADE

SCALE: FEET

SHEET NO 12 1 4141017238

SURVEY I
B. CONSTRUCTION

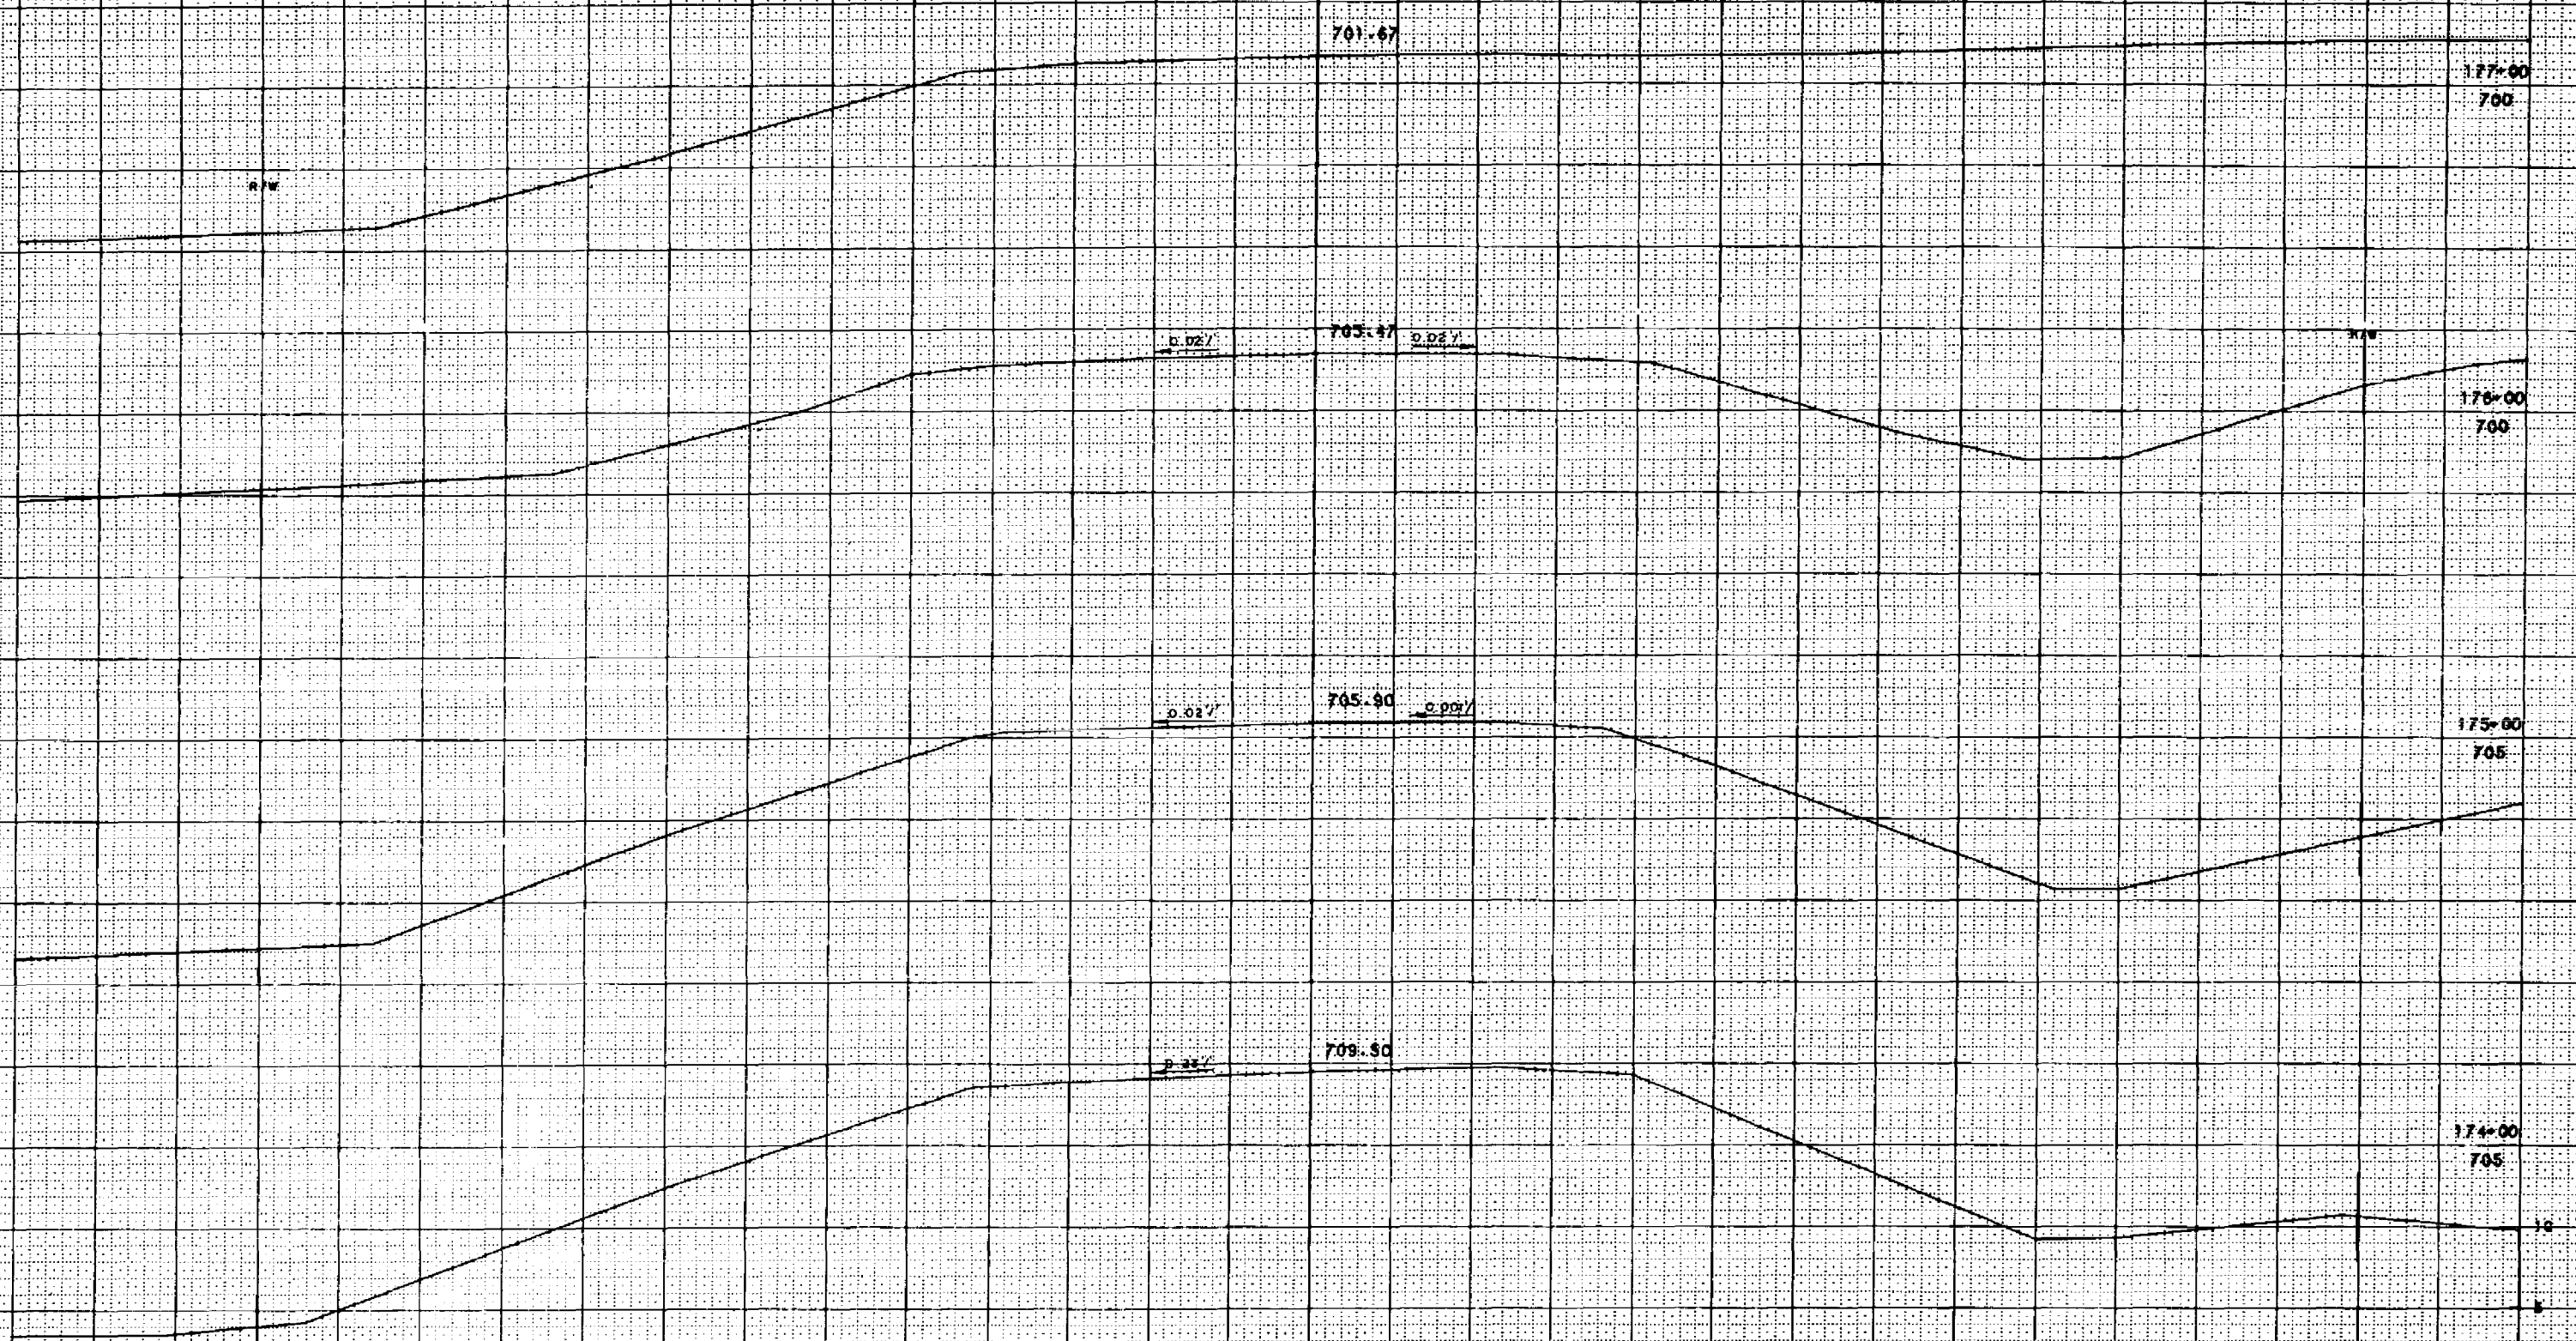

STATE PROJECT NUMBER
414-1-2 753

SURVEY 1
CONSTRUCTION 2

RTW

RTW

699.65

172.00

595

699.58

182.00

595

699.65

181.00

595

699.80

180.00

595

700.13

179.00

700

700.84

178.00

700


TEMPLATE IS SUBGRADE
PRINTED ELEV IS SUBGRADE

SCALE: FEET

SHEET NO. 24

SURVEY 1
A. CONSTRUCTION

STATE PROJECT NUMBER	SHEET NUMBER
4141-1-72	956

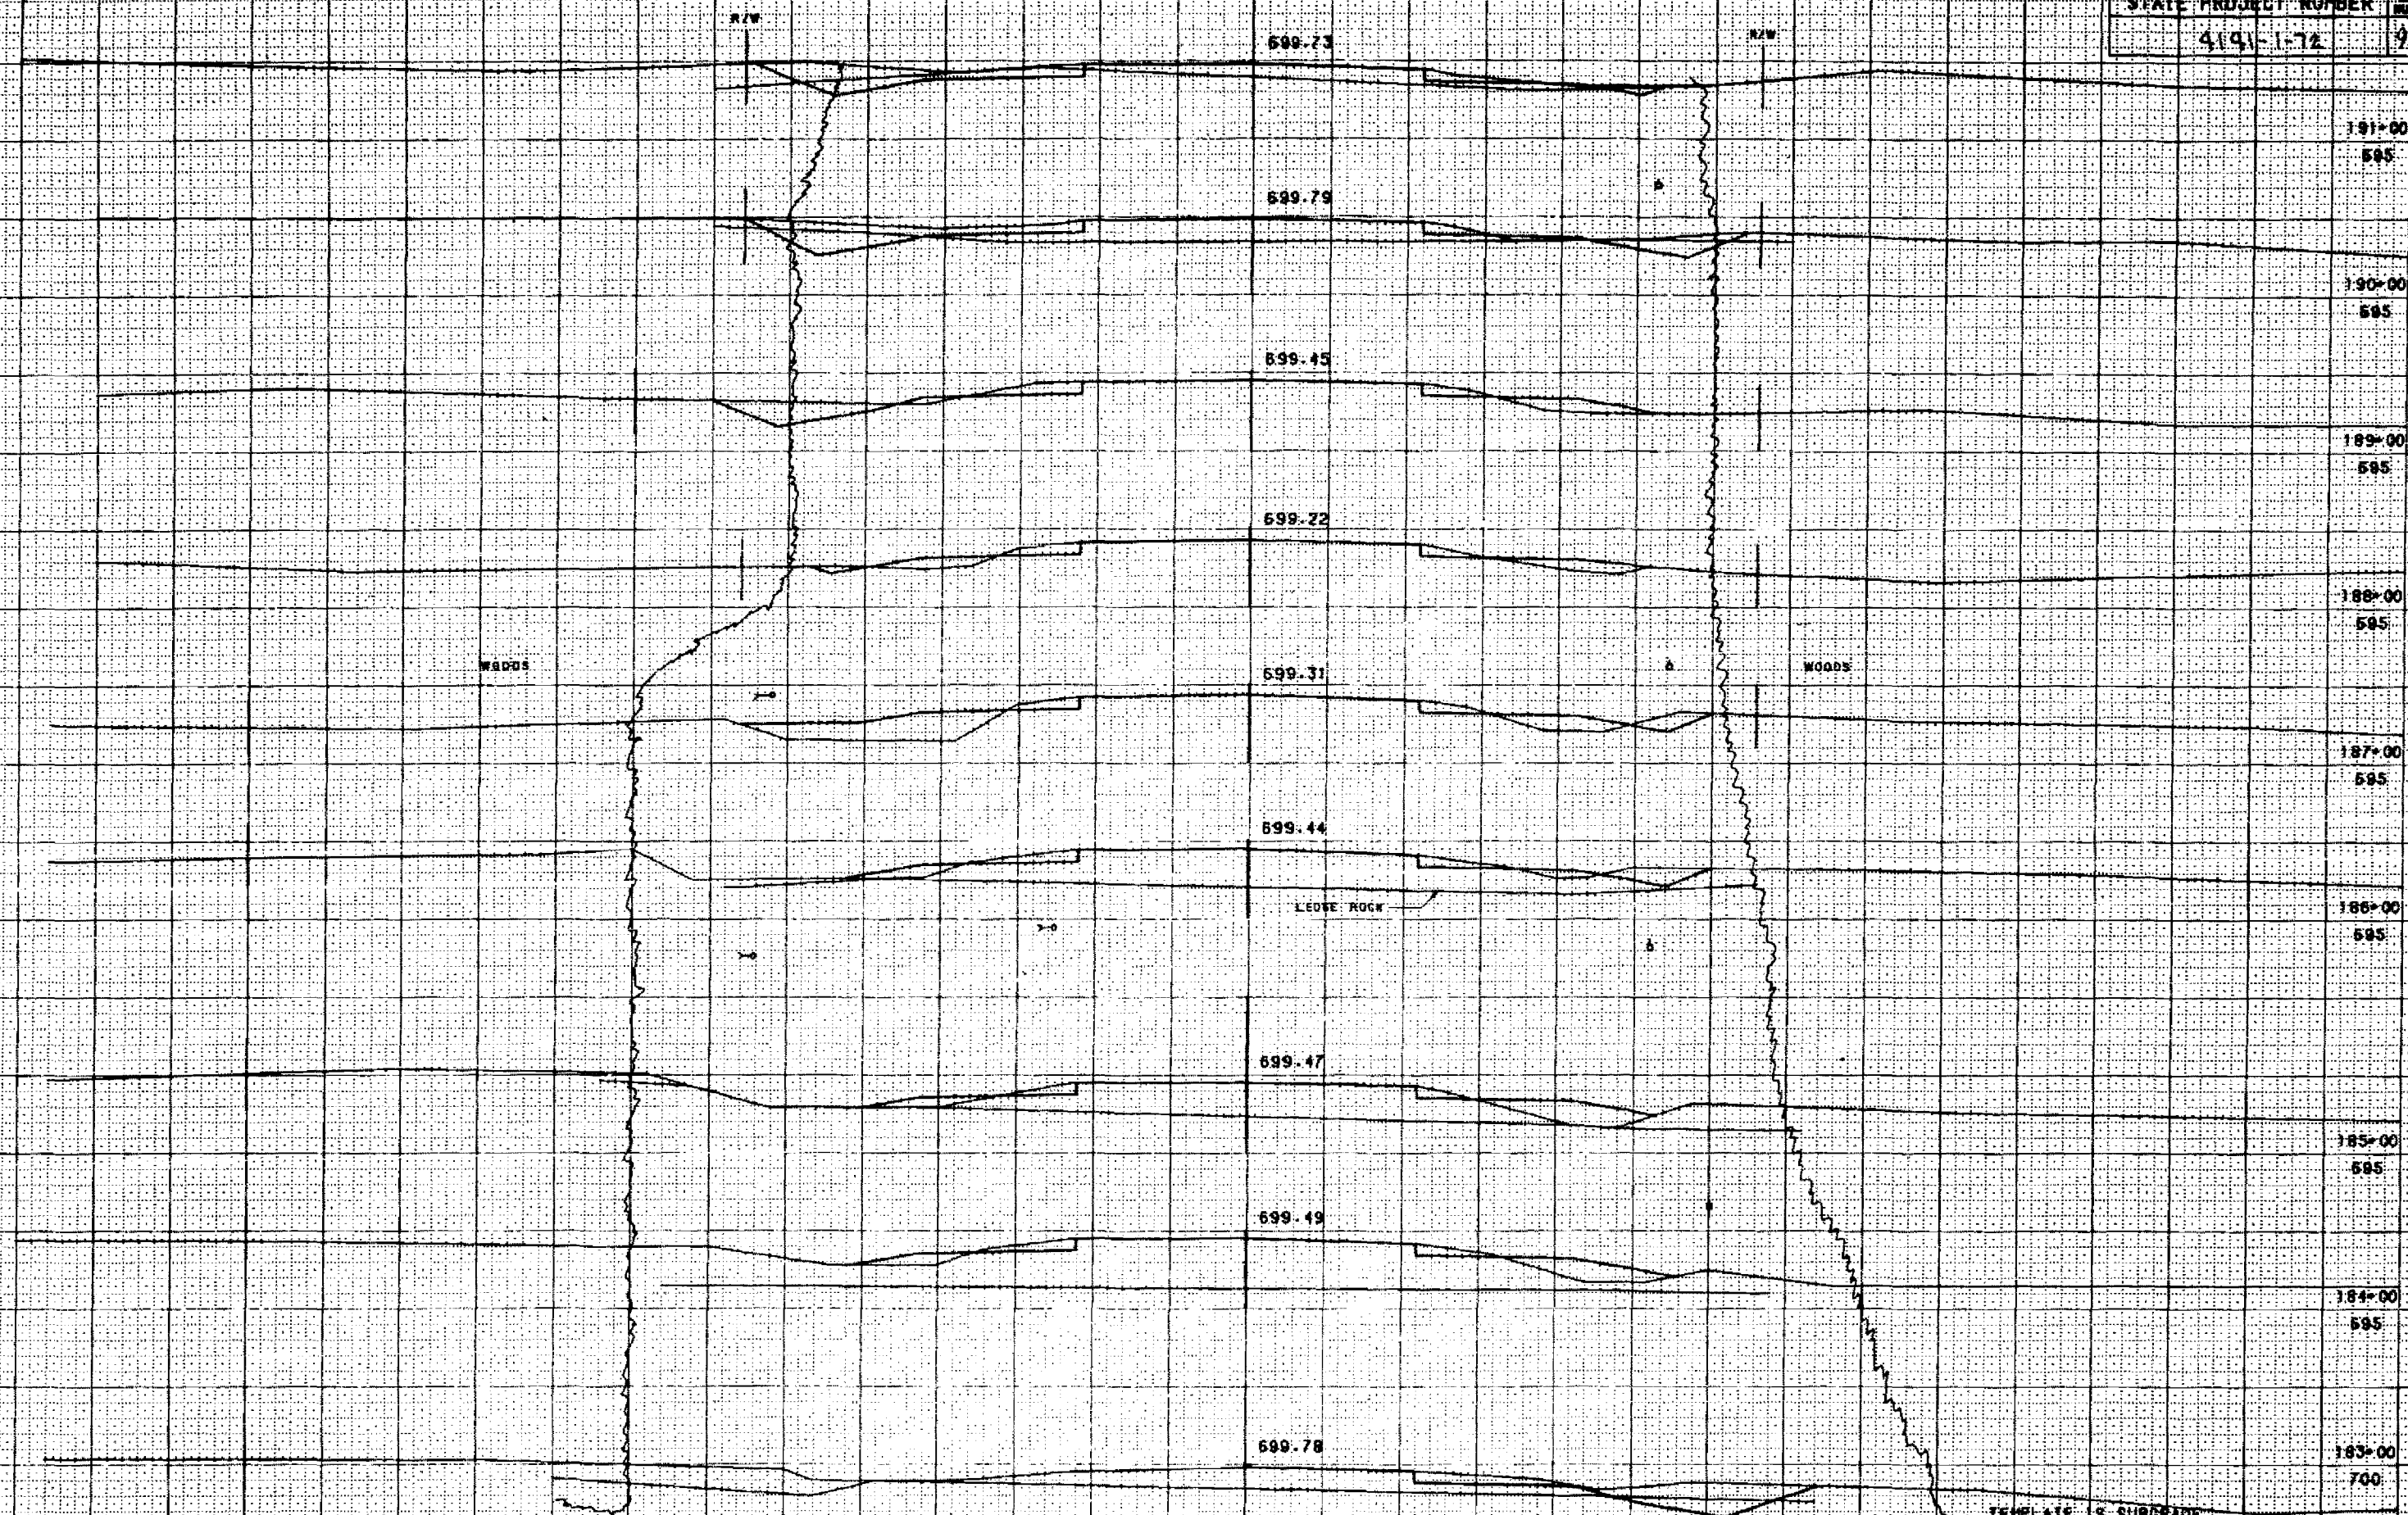


TEMPLATE & SUBGRADE
PRINTED ELEV IS SUBGRADE

SCALE: FEET

SHEET NO 21 3 4141Q17238

SURVEY I
B. CONSTRUCTION

STATE PROJECT NUMBER	SHEET NUMBER
414-1-12	458

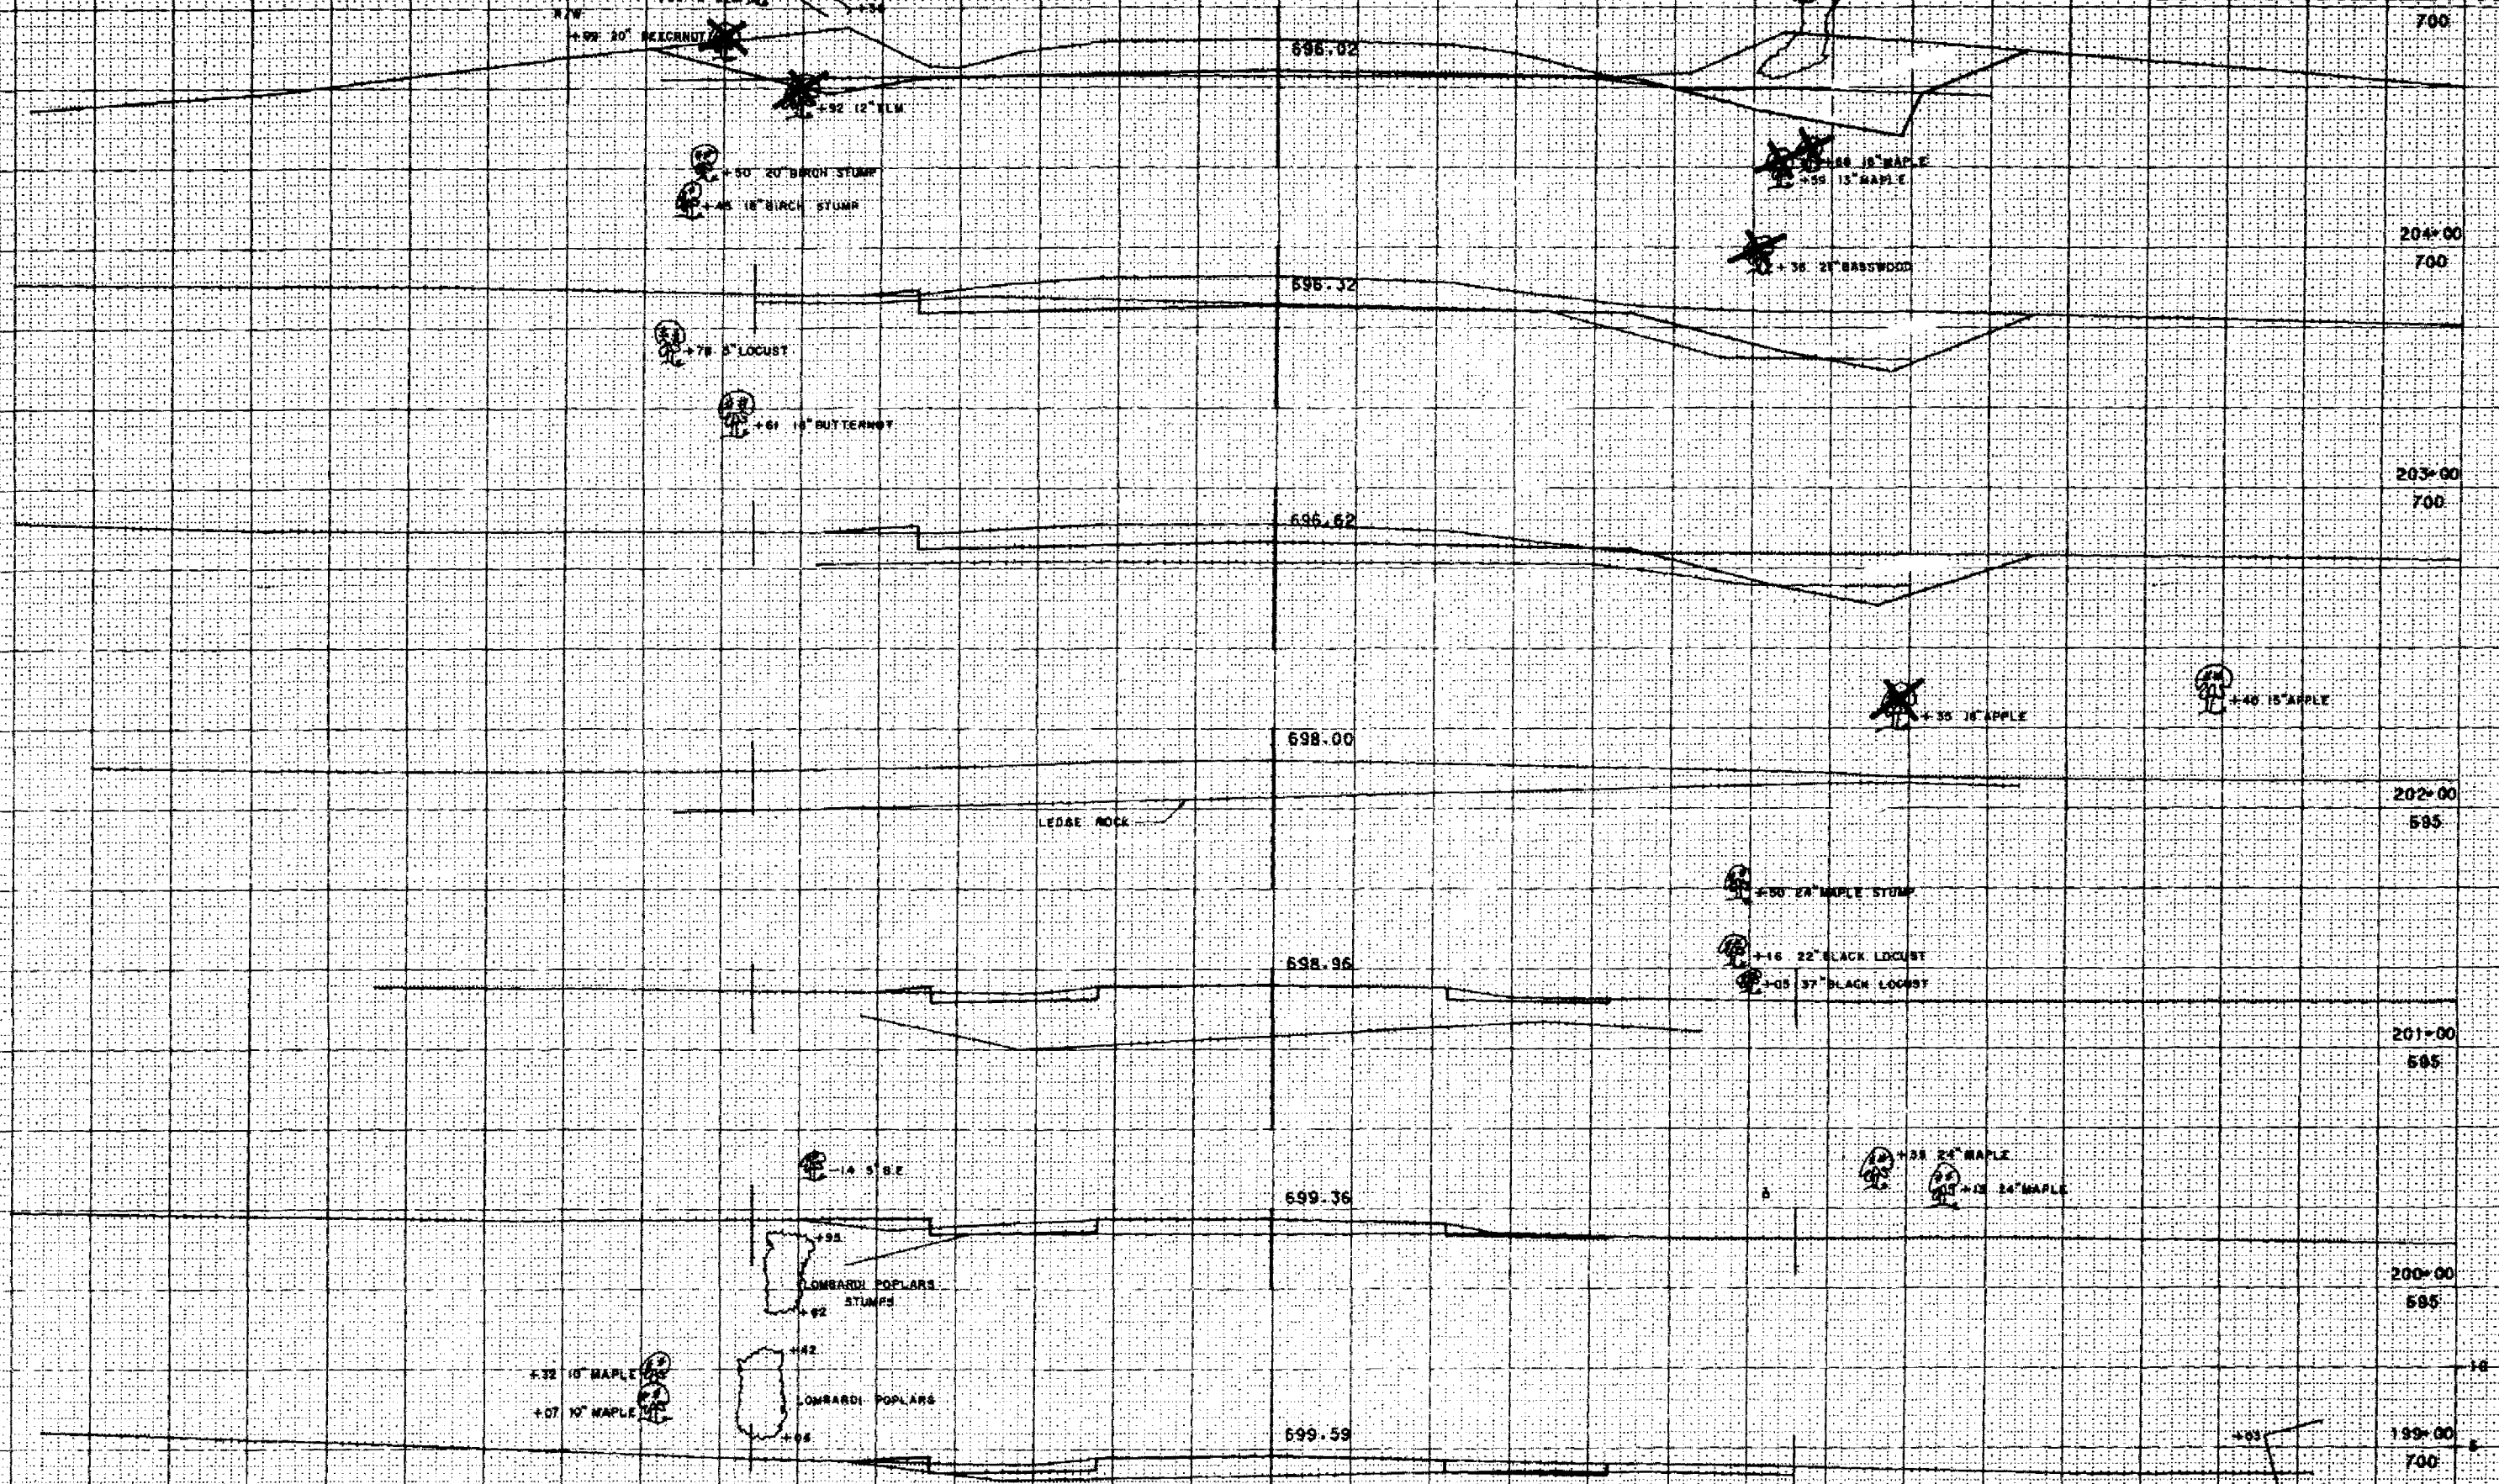

TEMPLATE IS SUBGRADE
 PRINTED ELEV IS SUBGRADE
 SCALE: FEET
 SHEET NO. 27

SURVEY T
CONSTRUCTION

594.80

210+00
590

594.89

209+00
590

695.12

208+00
595

695.42

207+00
595

695.72

206+00
595

+58 20' LOMBARDI POPLAR

+56 23' BEECH

+57 24' BEECH

+57 1' LOMBARDI POPLAR

+05 20' LOMBARDI POPLAR

+80 22' LOMBARDI POPLAR

LEDGE ROCK

+36 18' LOMBARDI

+26 12' LOMBARDI POPLAR

APPLE TREES

+8 22' BASSWOOD

+10 10' LOMBARDI POPLAR

+36 10' LOMBARDI POPLAR

+8 12' BASSWOOD

+03 28' TWIN ASH

+50 20' TWIN MAPLE
+80 18' BASSWOOD

+72 12' ASH

+35 30' TWIN BASSWOOD (SAVE)
+37 23' MAPLE (SAVE)
+41 14' MAPLE (SAVE)

TEMPLATE 1'S SUBGRADE
PRINTED ELEV IS SUBGRADE SCALE: FEET

STATE PROJECT NUMBER	SHEET
4141-1-77	260

OLD CHERRY YARD

SURVEY 1
CONSTRUCTION 1

MAPLE & BASSWOOD TREES
5' - 20'

R/W

216+00

700

WOODS

215+00

700

R/W

214+00

700

LEDGE ROCK

213+00

695

WOODS

212+00

695

488 24" YOUNG BASSWOOD
442 23" CLUMP BIRCH
436 12" BLACK CHERRY

694.85

211+00

690

TEMPLATE IS SUBGRADE
PRINTED ELEV IS SUBGRADE

SCALE: FEET

SHEET NO 25

3 4141017239


STATE PROJECT NUMBER
9191-1-72
SHEET NUMBER
9.61


SURVEY 1
A. CONSTRUCTION E.


OLD CHERRY YARD

TEMPLATE IS SUBGRADE
PRINTED ELEV IS SUBGRADE

SHEET NO. 26 3 414101239

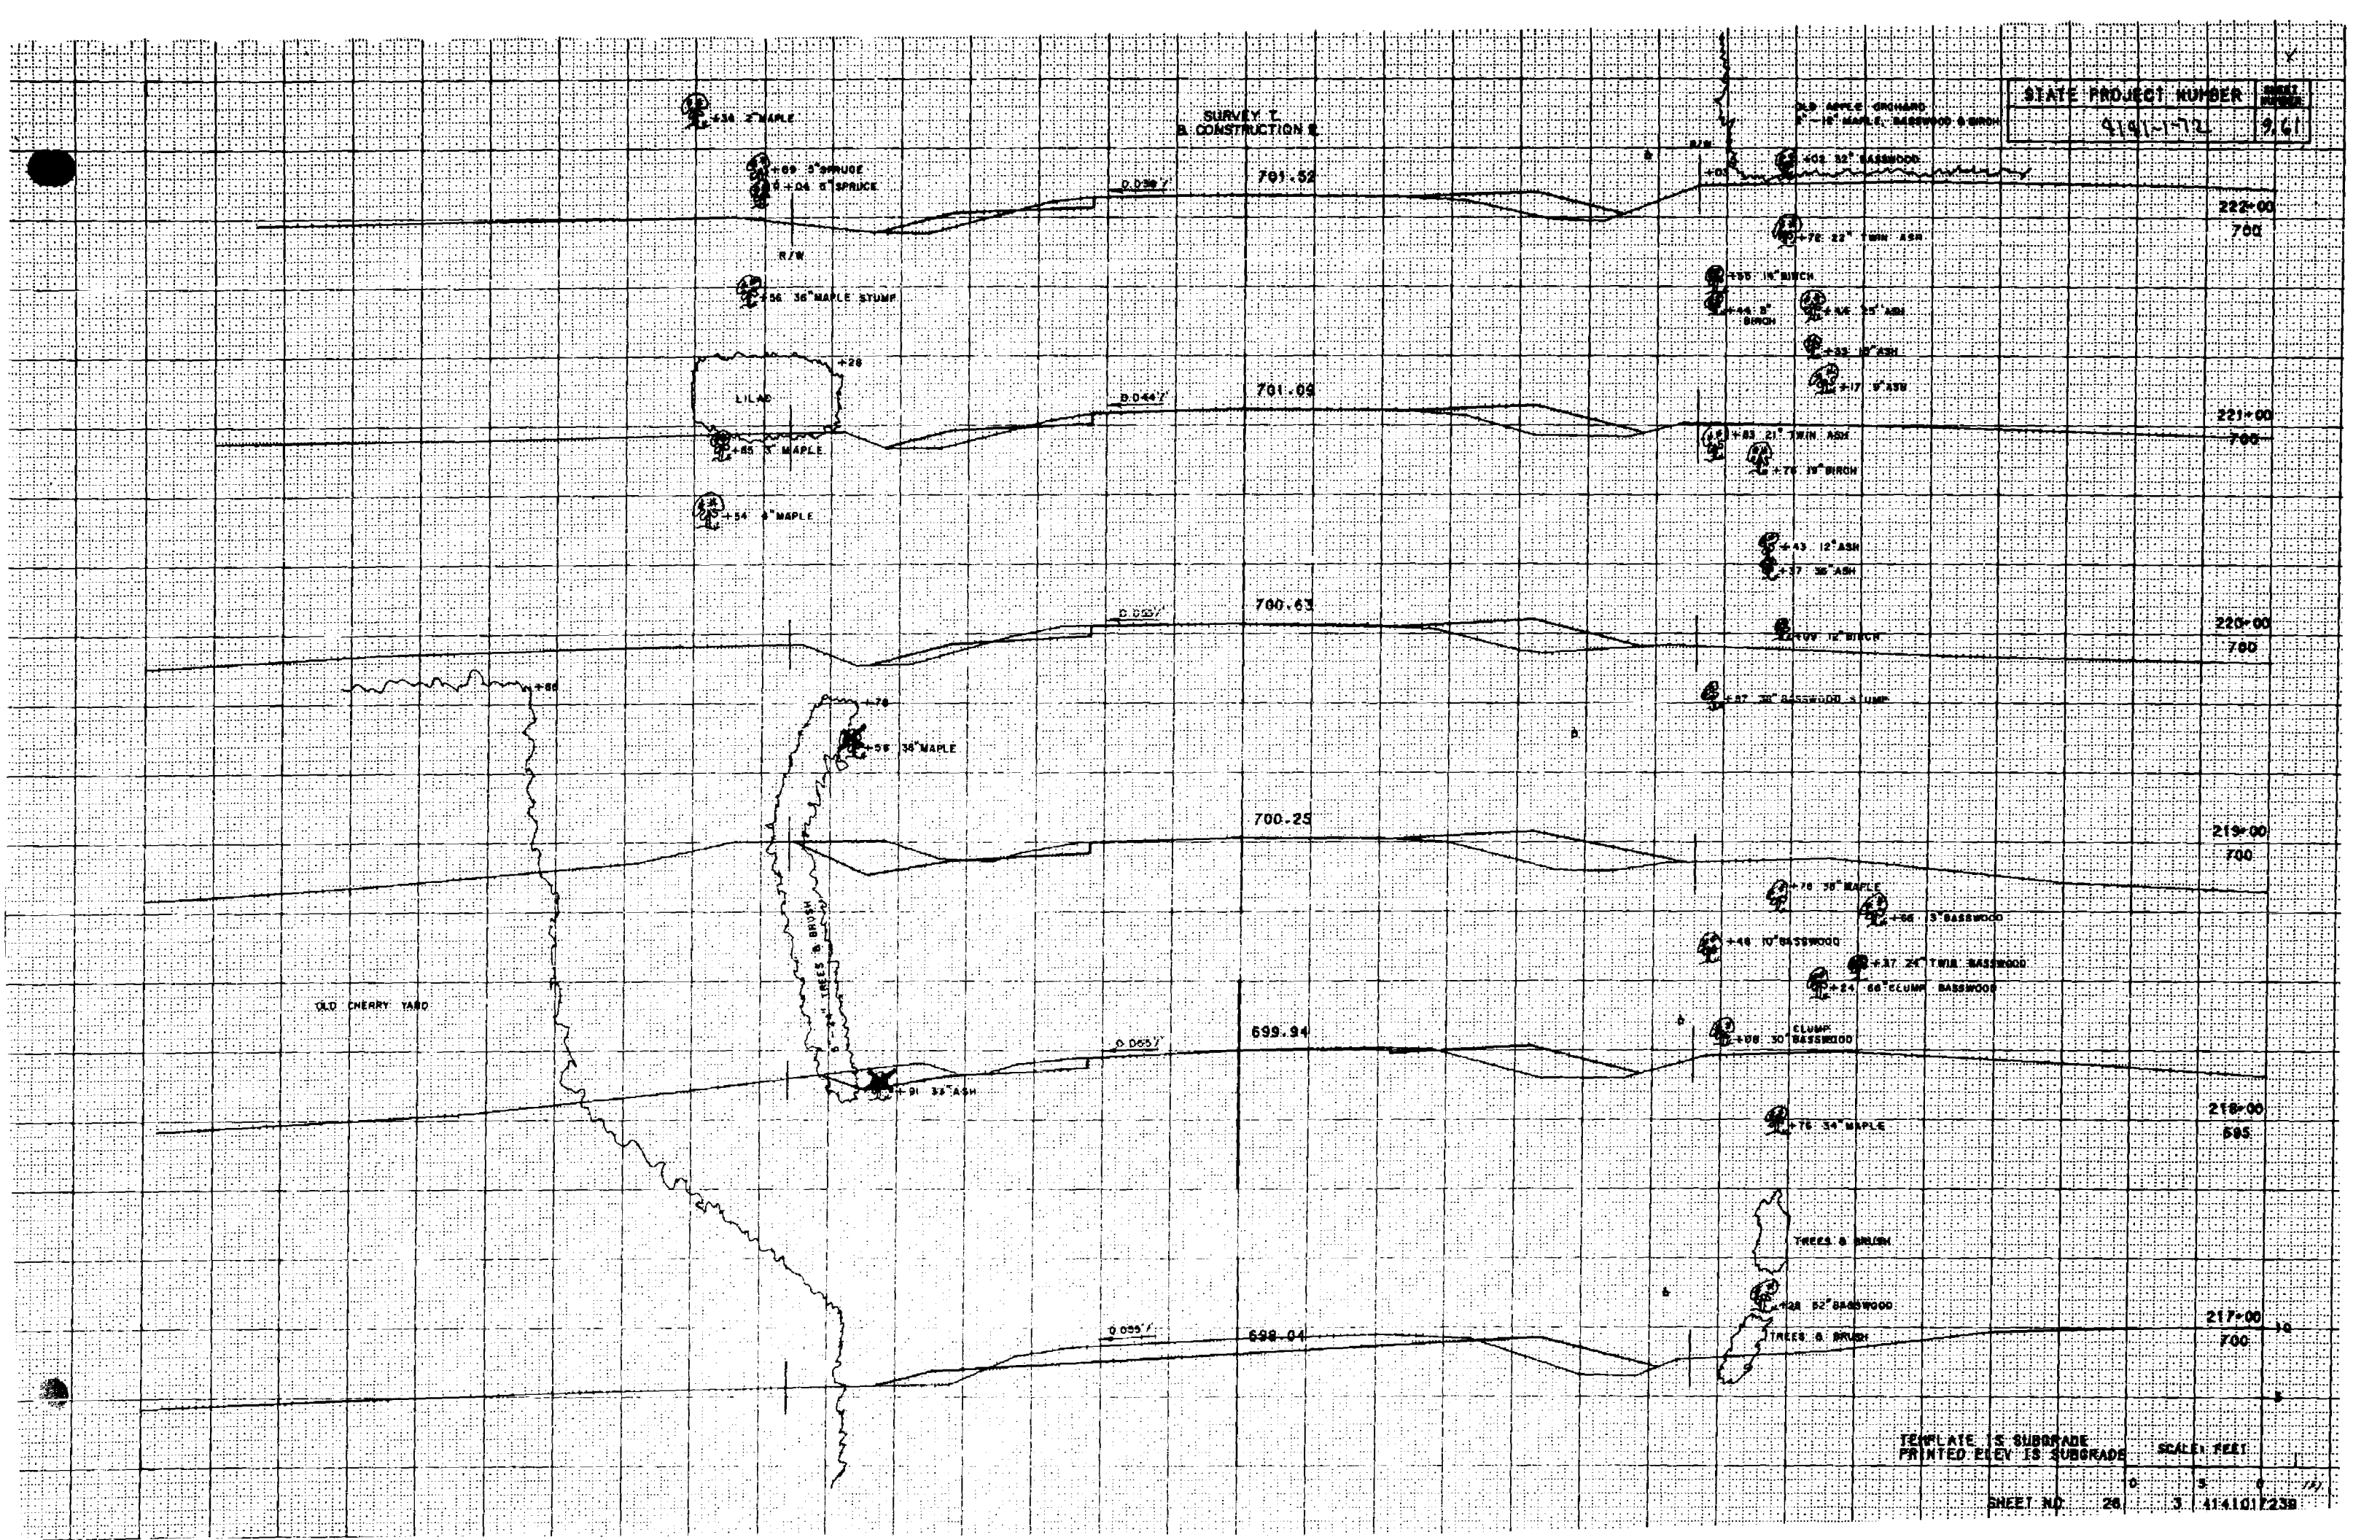

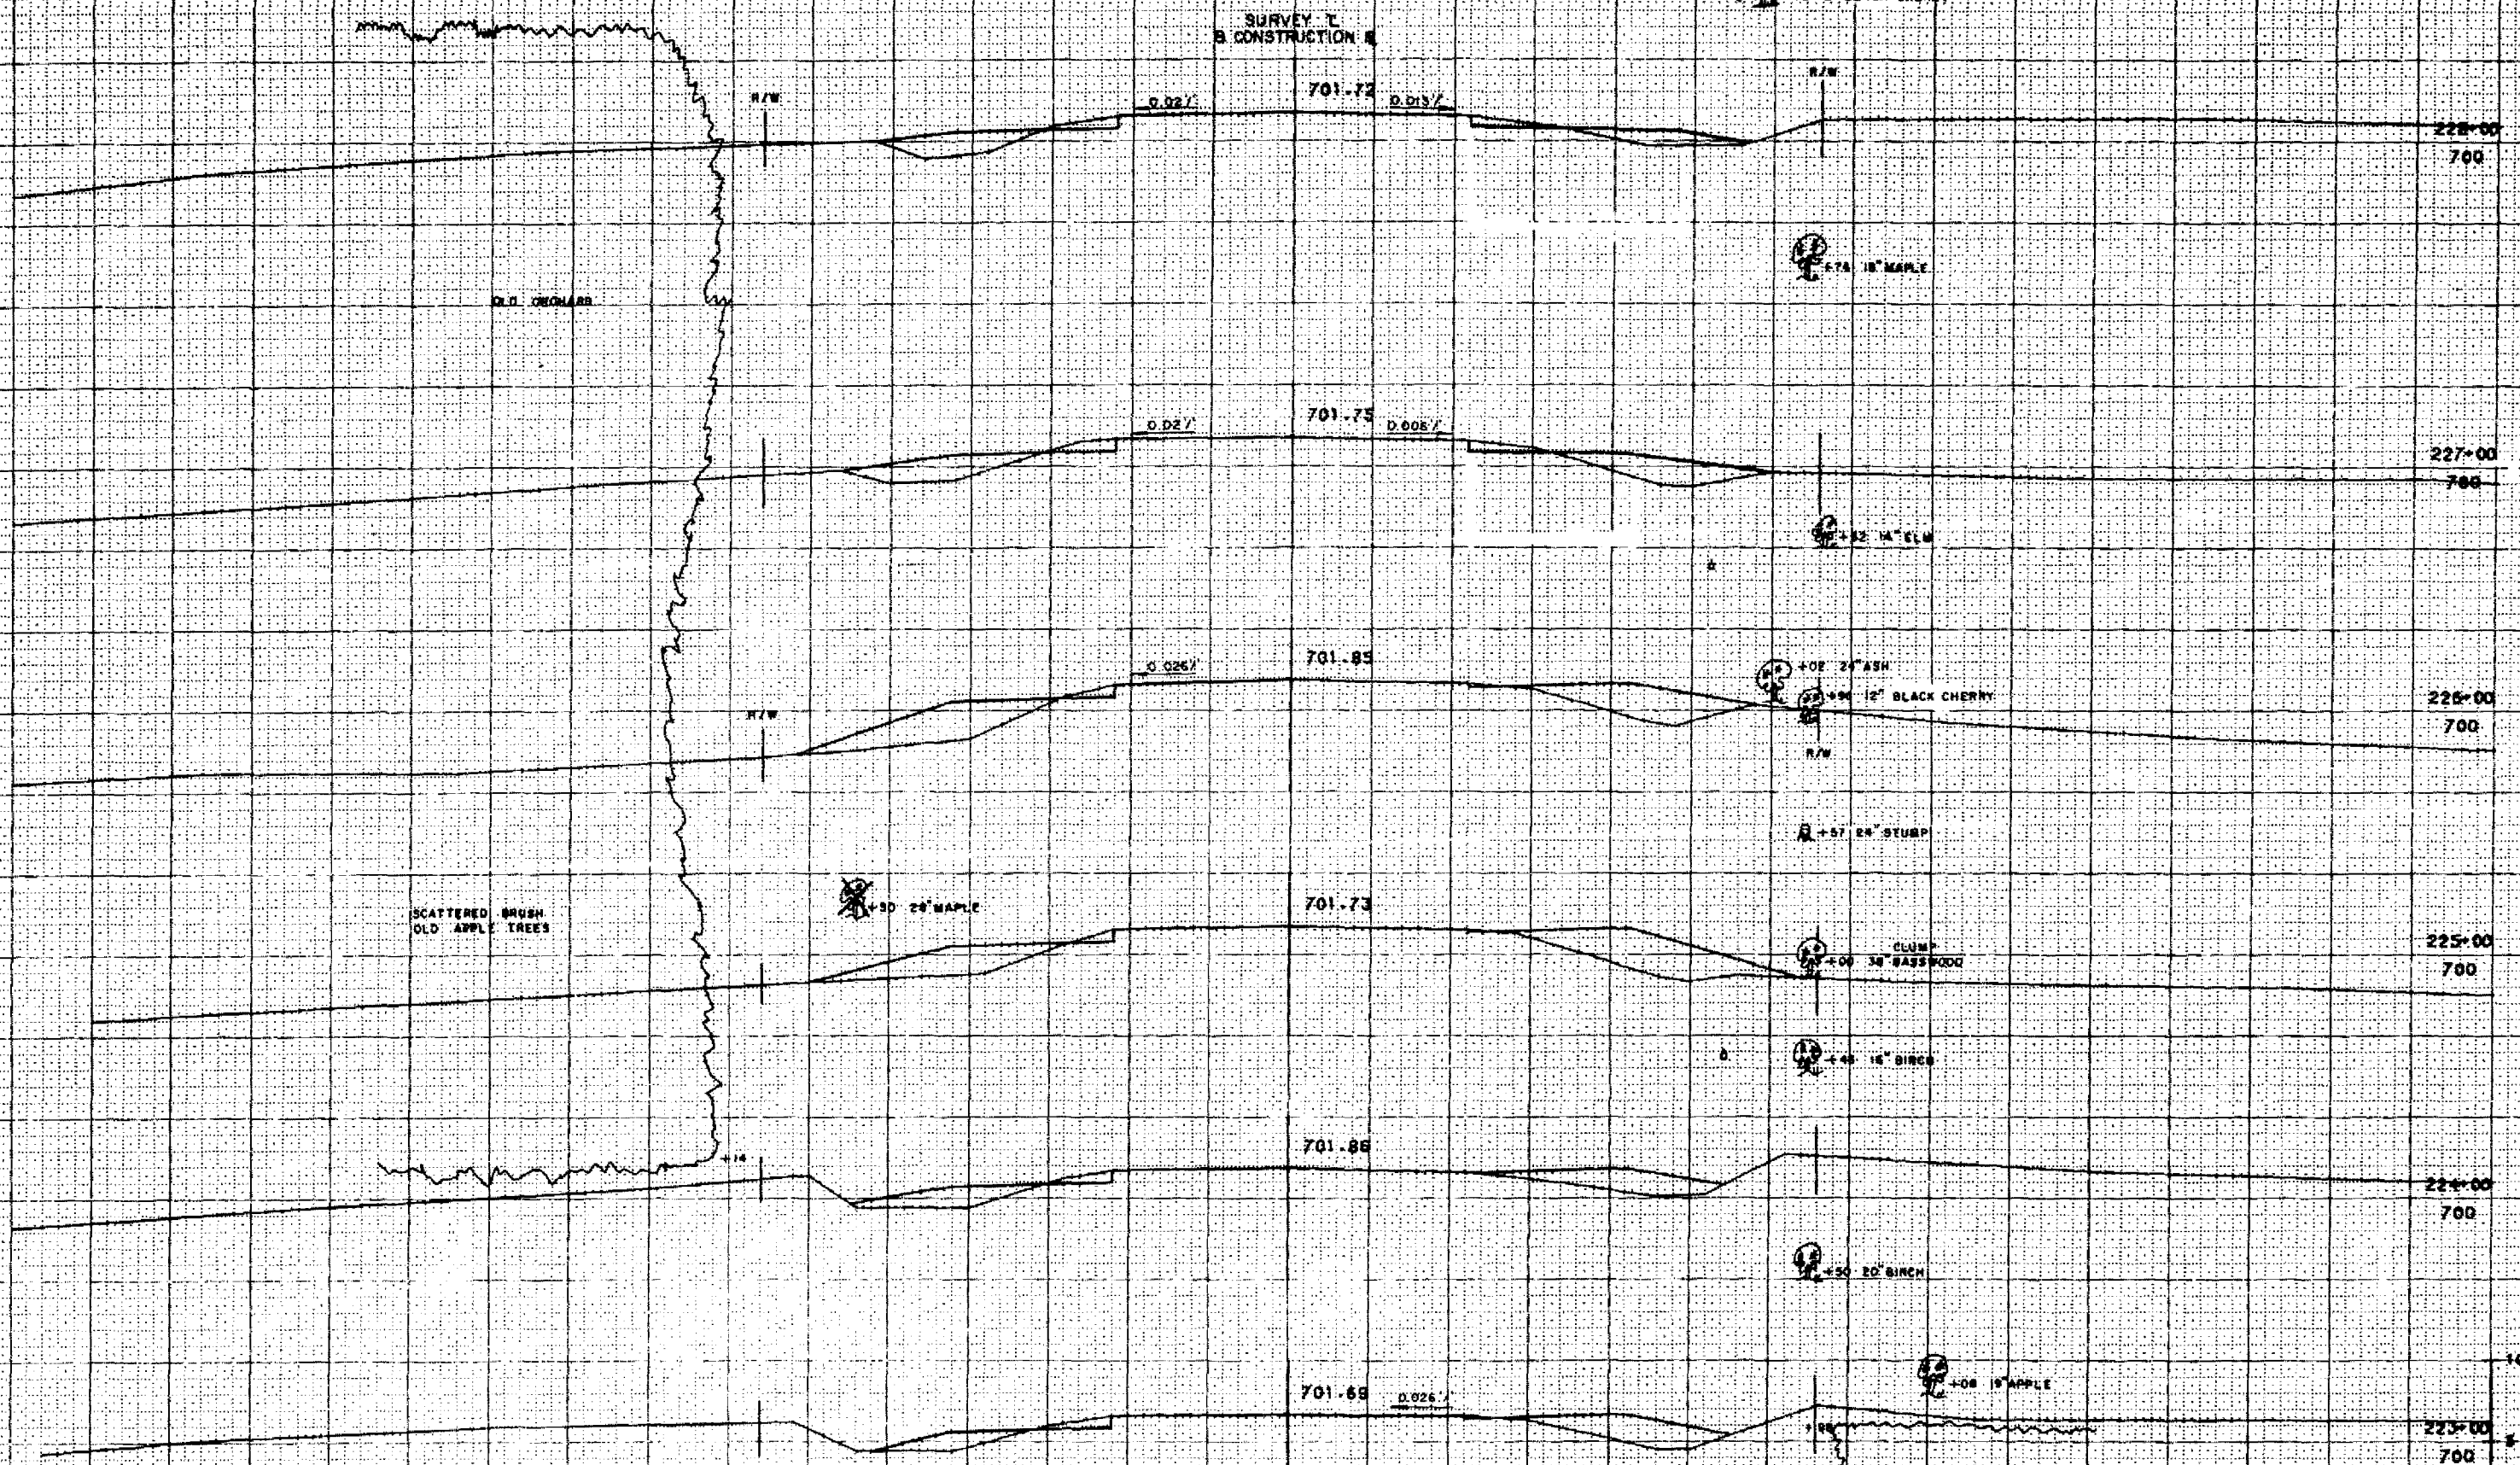

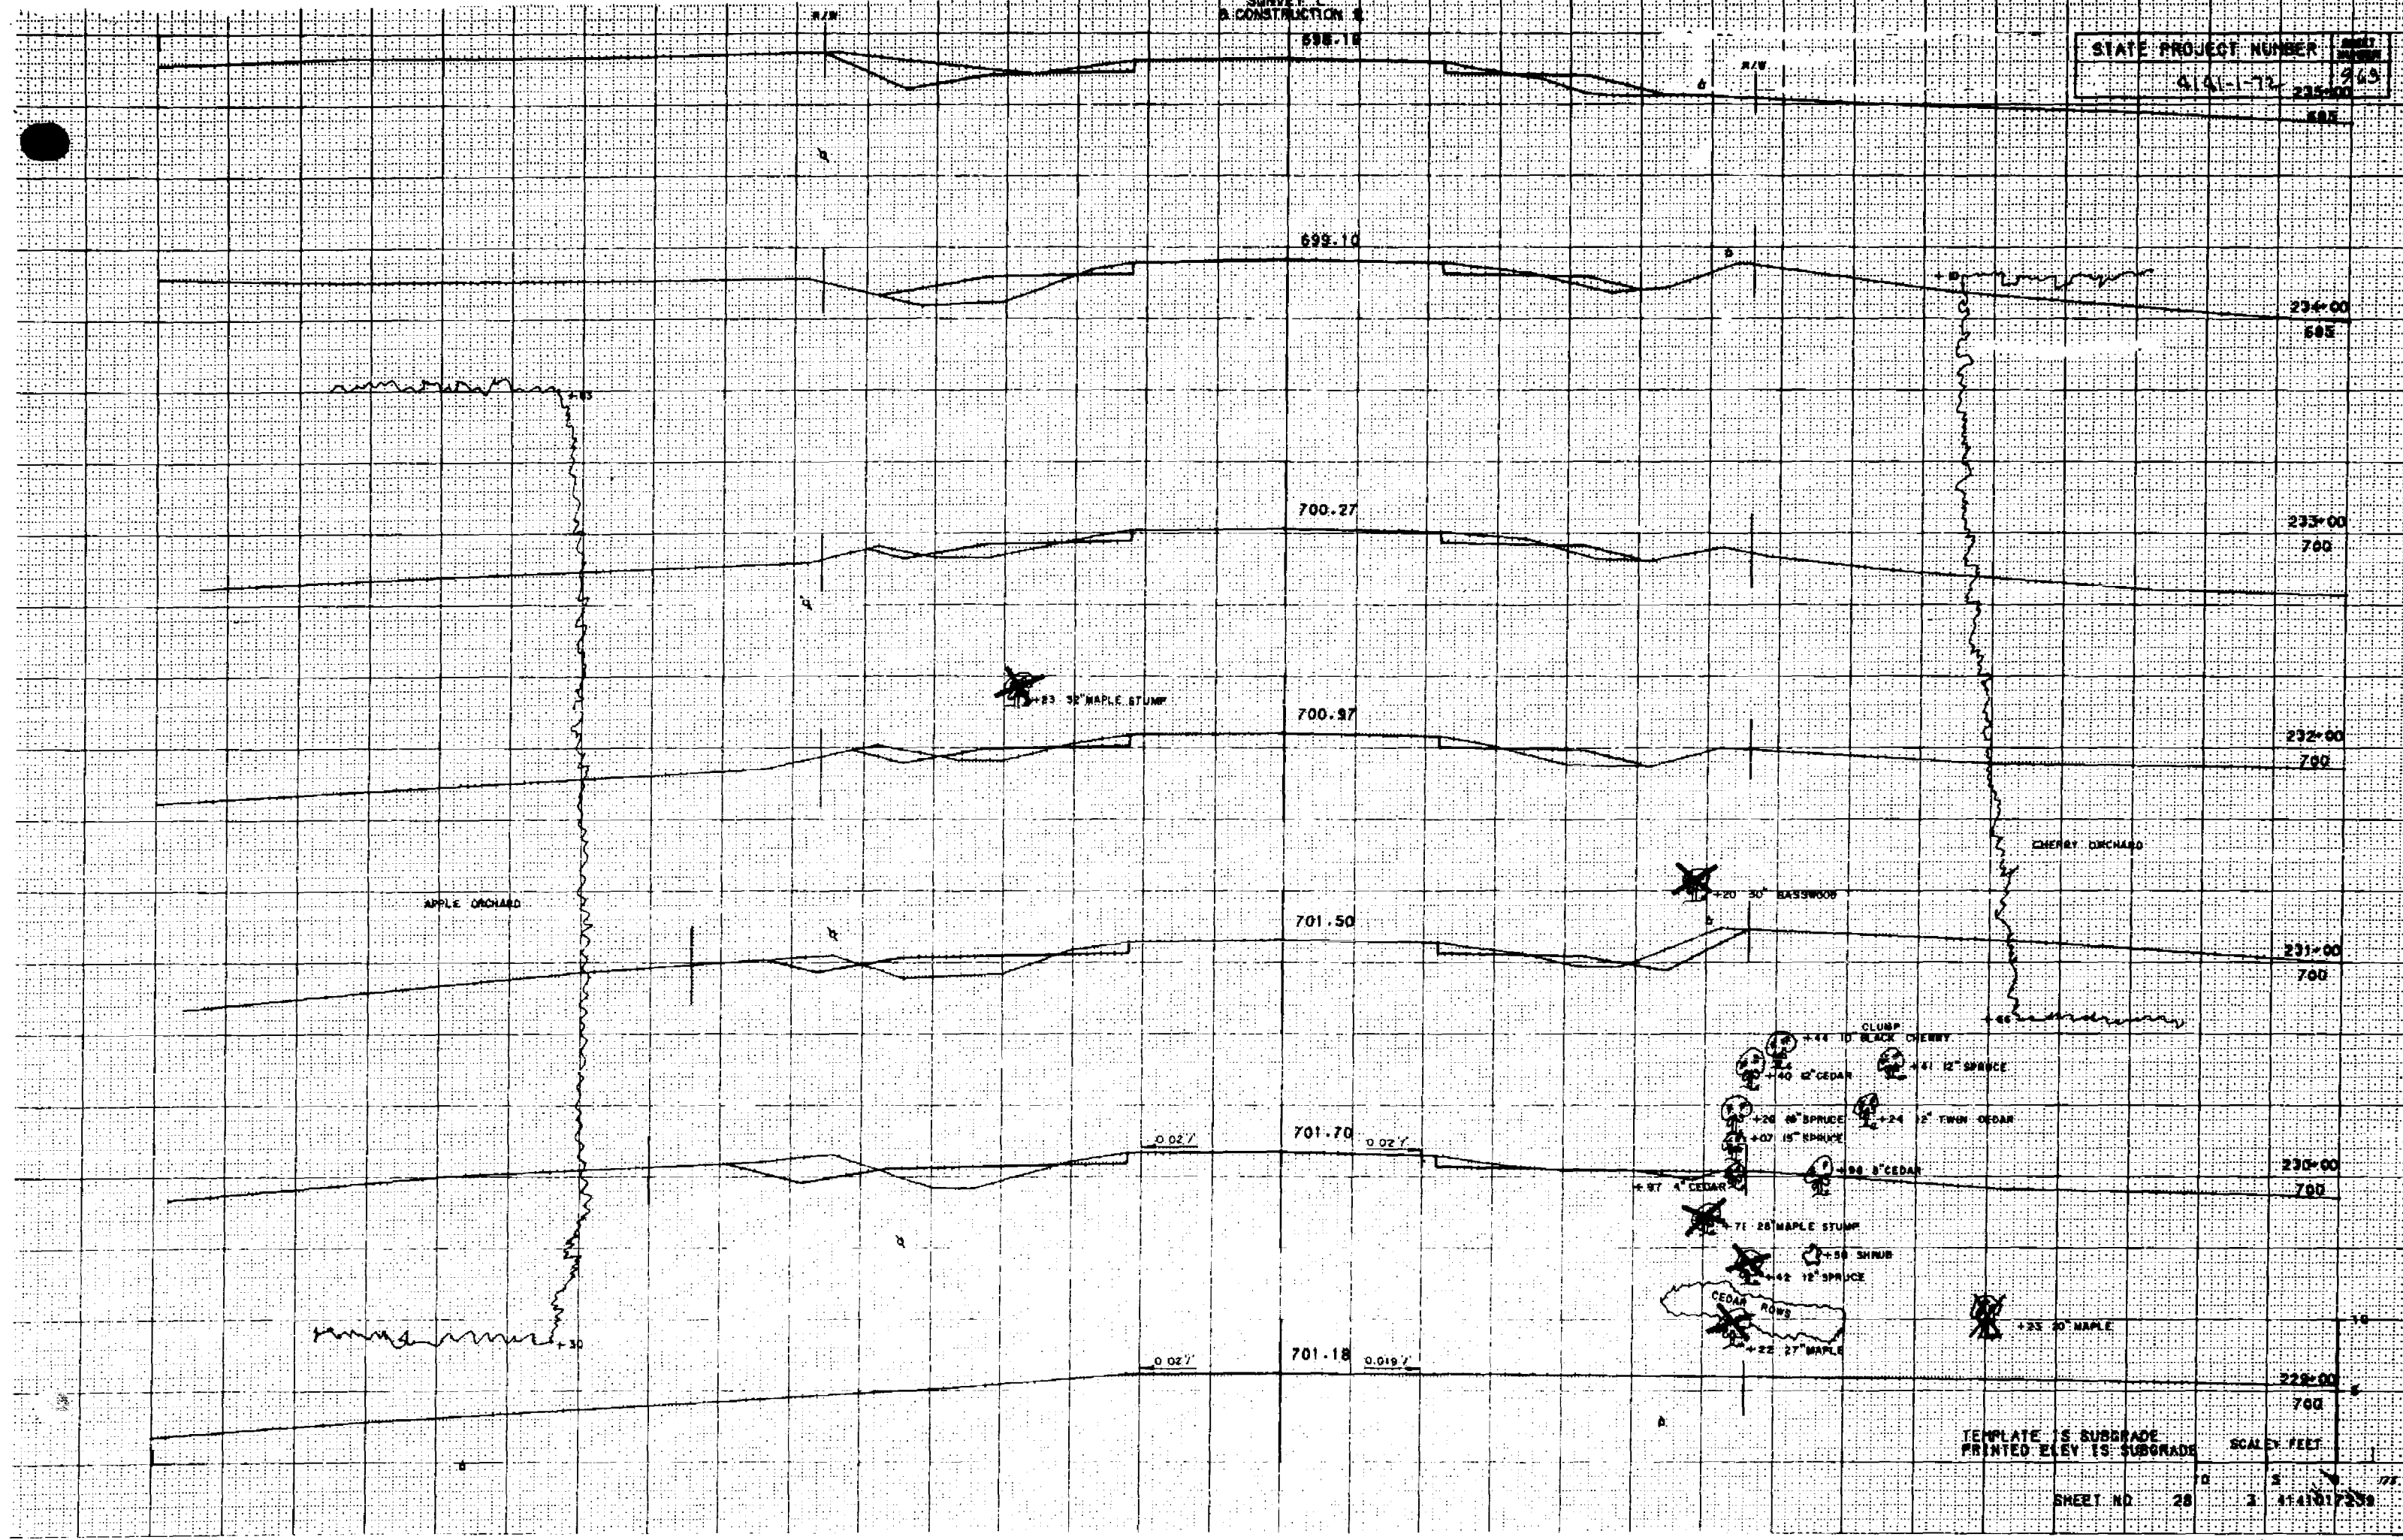

SURVEY 1
CONSTRUCTION

STATE PROJECT NUMBER
4161-E-72

DATE
9-64

595

596.51

596.93

597.00

596.70

596.60

596.96

597.45

241+00

240+00

239+00

238+00

237+00

236+00

+56 8" MAPLE STUMP

+25 14" MAPLE STUMP

APPLE ORCHARD

LOG BUILDING

TEMPLATE IS SUBGRADE
PRINTED ELEV IS SUBGRADE

SCALE: FEET

SHEET NO. 29

416101P239

SURVEY 1
B. CONSTRUCTION

STATE PROJECT NUMBER
4141-1-72
254-00
700

0.001% 702.00 0.02%

0.009% 700.93 0.02%

700.34

16" BASSWOOD STUMP

LEDGE ROCK

15" BASSWOOD STUMP

APPLE ORCHARD

699.69

WOODS

698.48

697.02

253-00

252-00

251-00

250-00

249-00

TEMPLATE IS SUBGRADE
PRINTED ELEV IS SUBGRADE

SCALE: FEET

SHEET NO. 31 1 414101238

SURVEY 1
A CONSTRUCTION

R/W

R/W

0.02% 705.85 0.02%

258+00
705

+33 20" HICKORY

0.014% 704.75 0.02%

LEOGE ROCK

258+00
700

+04 34" MAPLE (SAVE)

+22 28" BLACK CHERRY (SAVE)

0.006% 703.85 0.02%

257+00
700

+11 40" MAPLE (SAVE)

LILAC

+68
+65 25" BASSWOOD CLUMP

0.045% 703.04

256+00
700

0.045% 702.65


255+00
705

TEMPLATE IS SUBGRADE
PRINTED ELEV IS SUBGRADE

SCALE: FEET


SURVEY C.
B. CONSTRUCTION

STATE PROJECT NUMBER 414-1-12
DATE 9/68

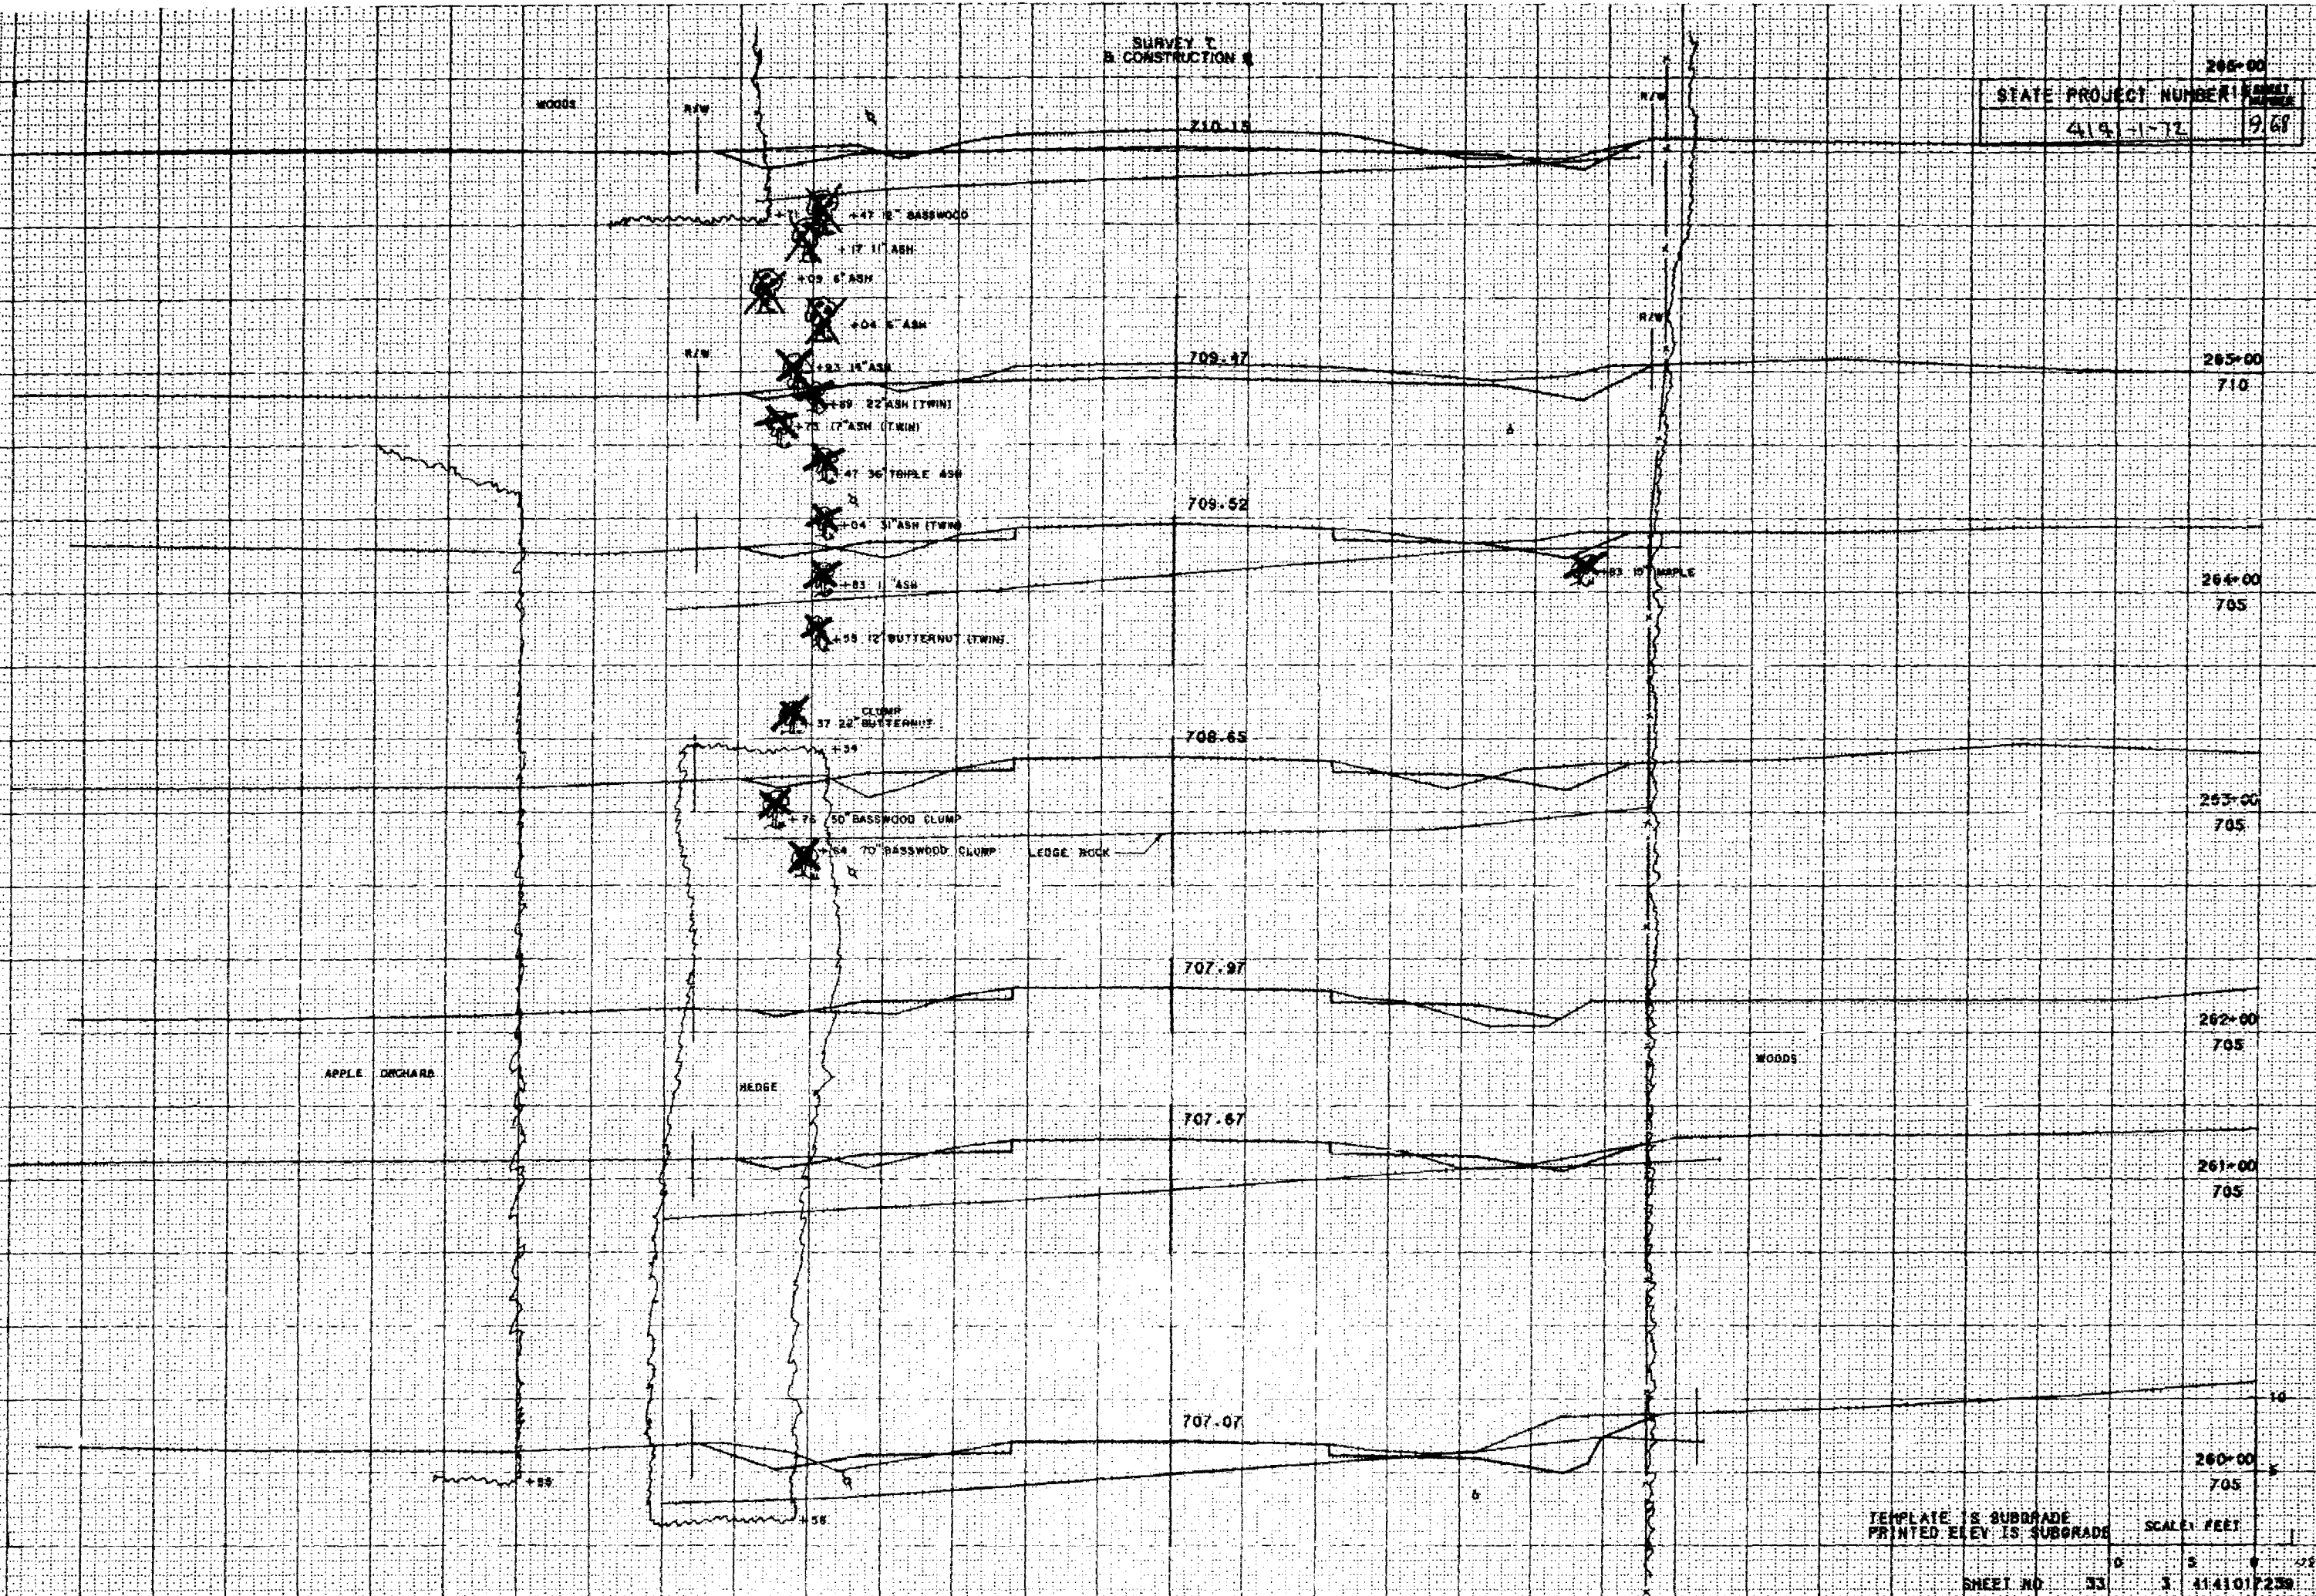

TEMPLATE IS SUBGRADE
PRINTED ELEV IS SUBGRADE
SCALE: FEET
SHEET NO 33 3 414101230

SURVEY I
B. CONSTRUCTION II

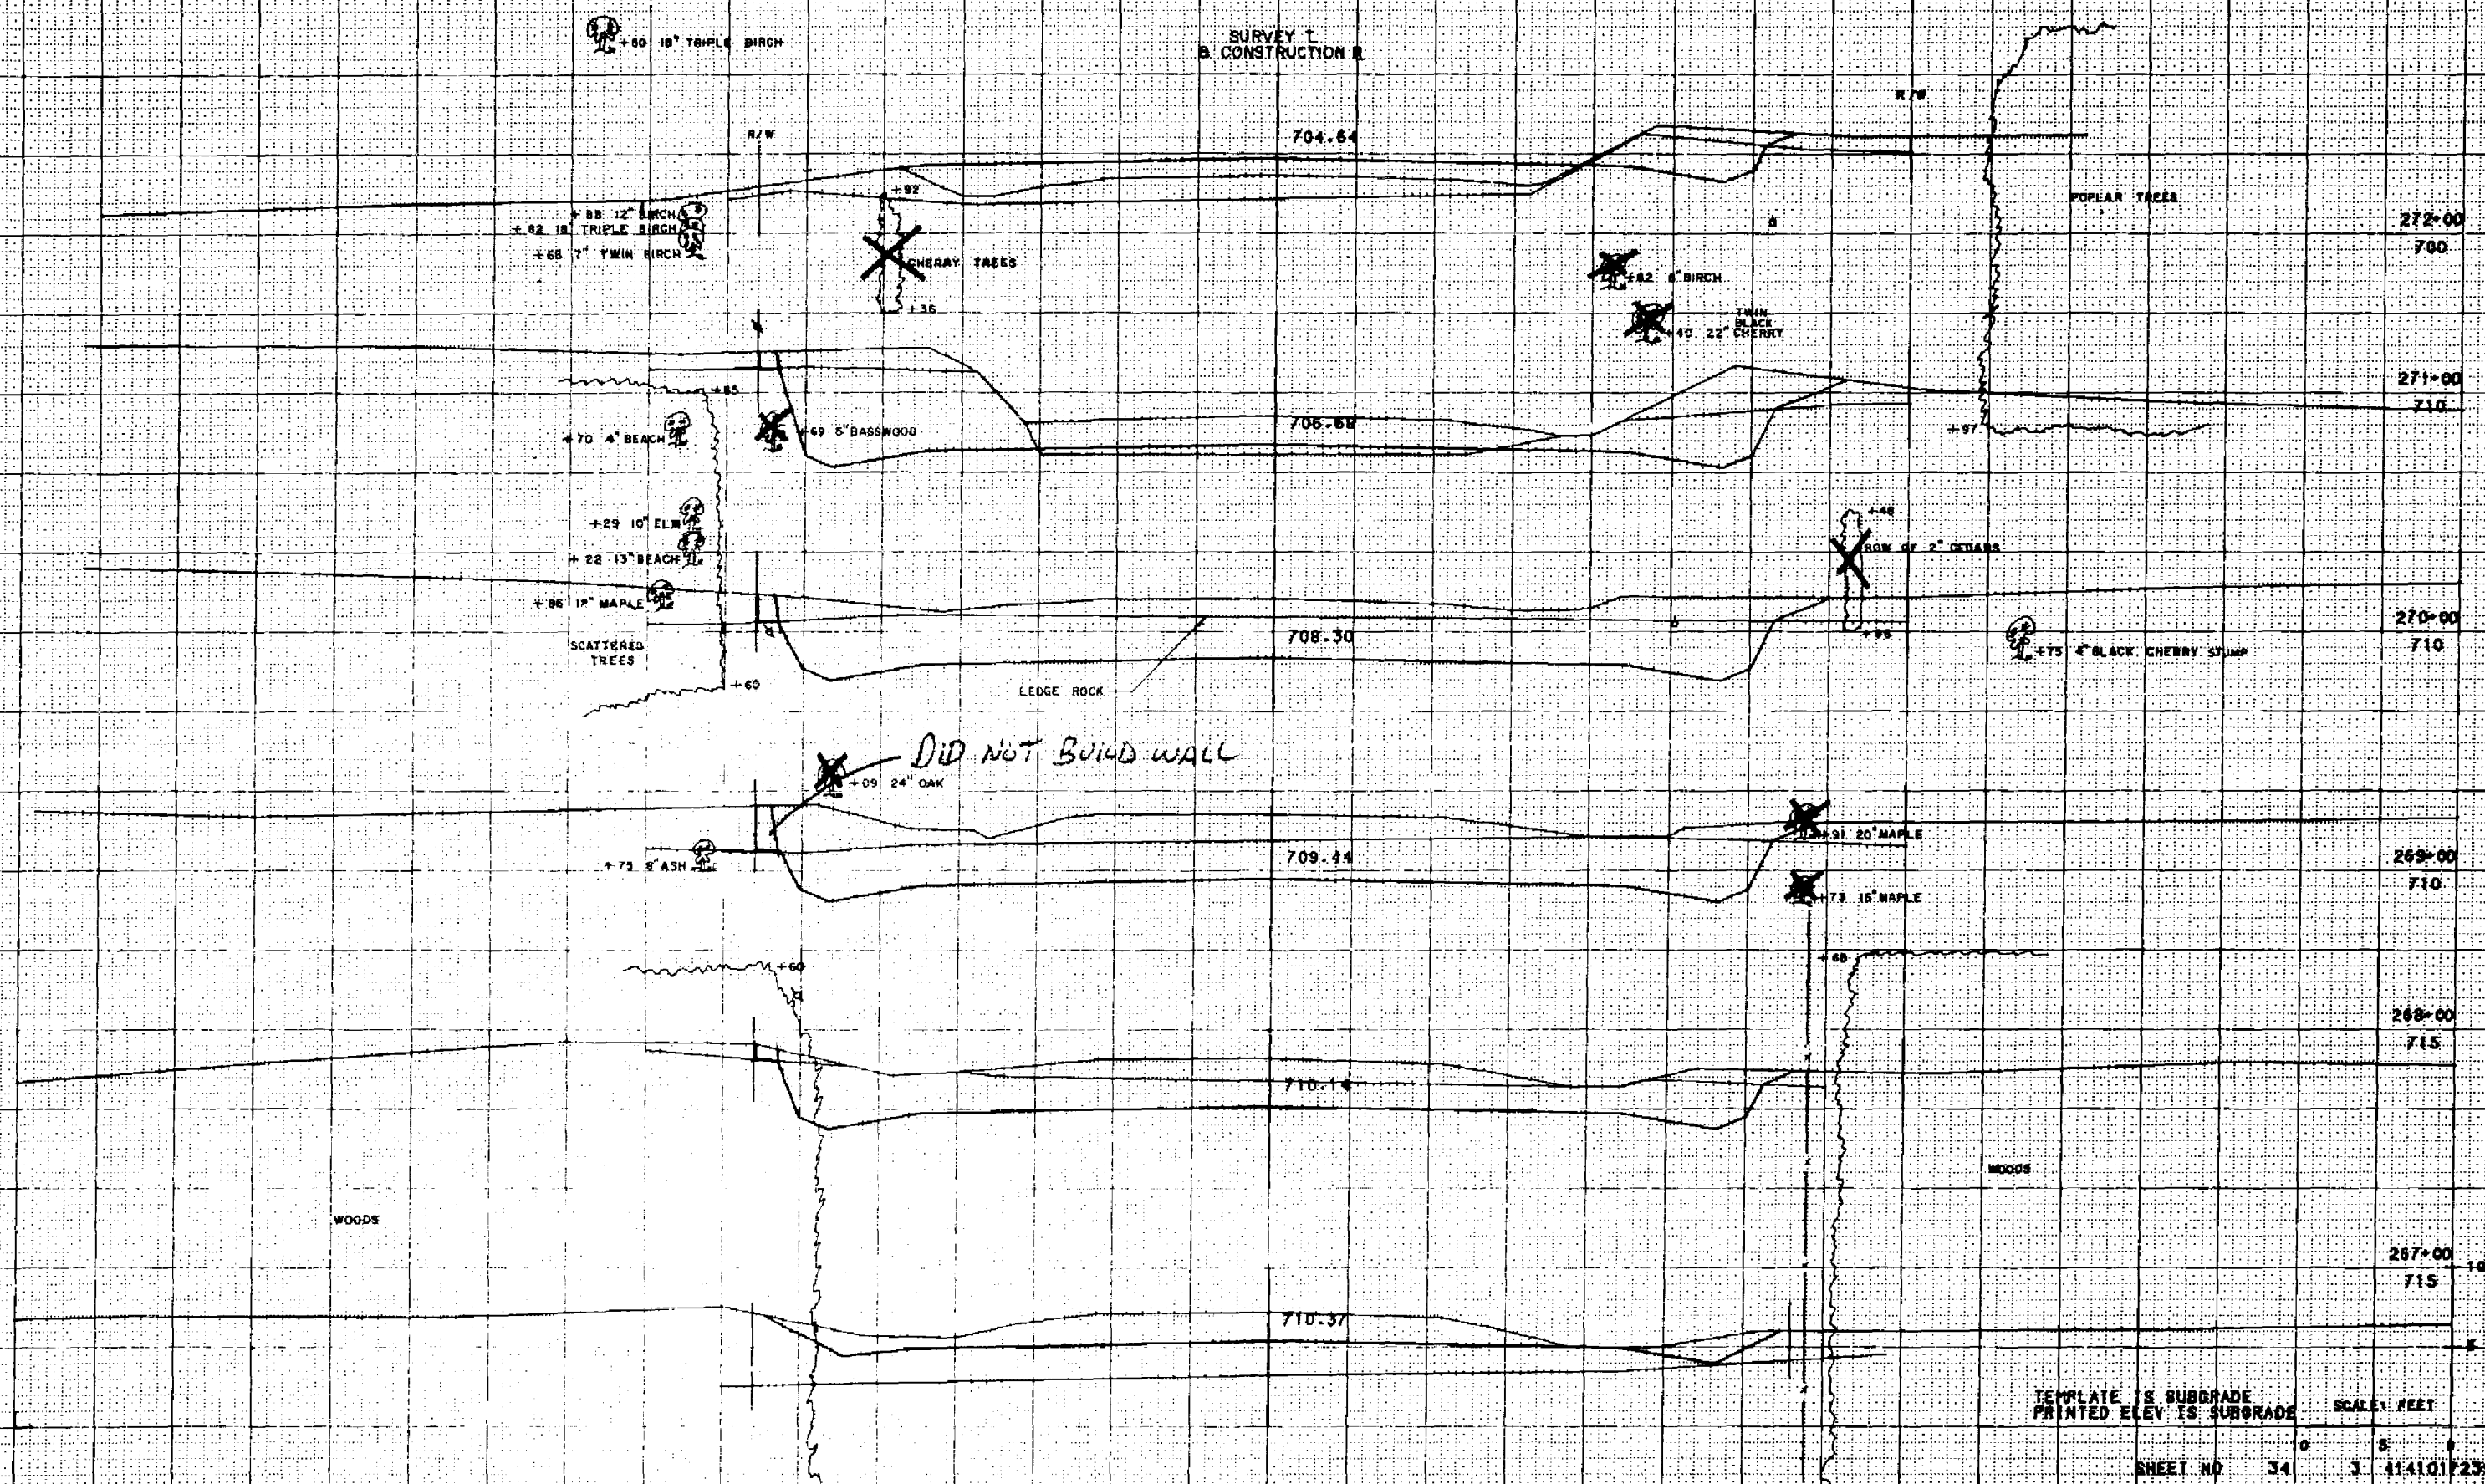

APPLE ORCHARD

SURVEY I
A. CONSTRUCTION

STATE PROJECT NUMBER	SHEET NUMBER
9191-1-72	970

APPLE ORCHARD

APPLE ORCHARD

LEDGE ROCK

476 25" MAPLE
478 27" MAPLE

482 24" MAPLE

482 22" 34" ASH
482 15" MAPLE

480 14" BIRCH CLUMP

477 17" POPLAR

484 12" BEE


492 10" APPLE

491 1" STUMP

TEMPLATE IS SUBGRADE
PRINTED ELEV IS SUBGRADE
SCALE: FEET
SHEET NO. 35 1 4141017239

SURVEY T.
A. CONSTRUCTION E.

STATE PROJECT NUMBER
4191-1-72
9.71

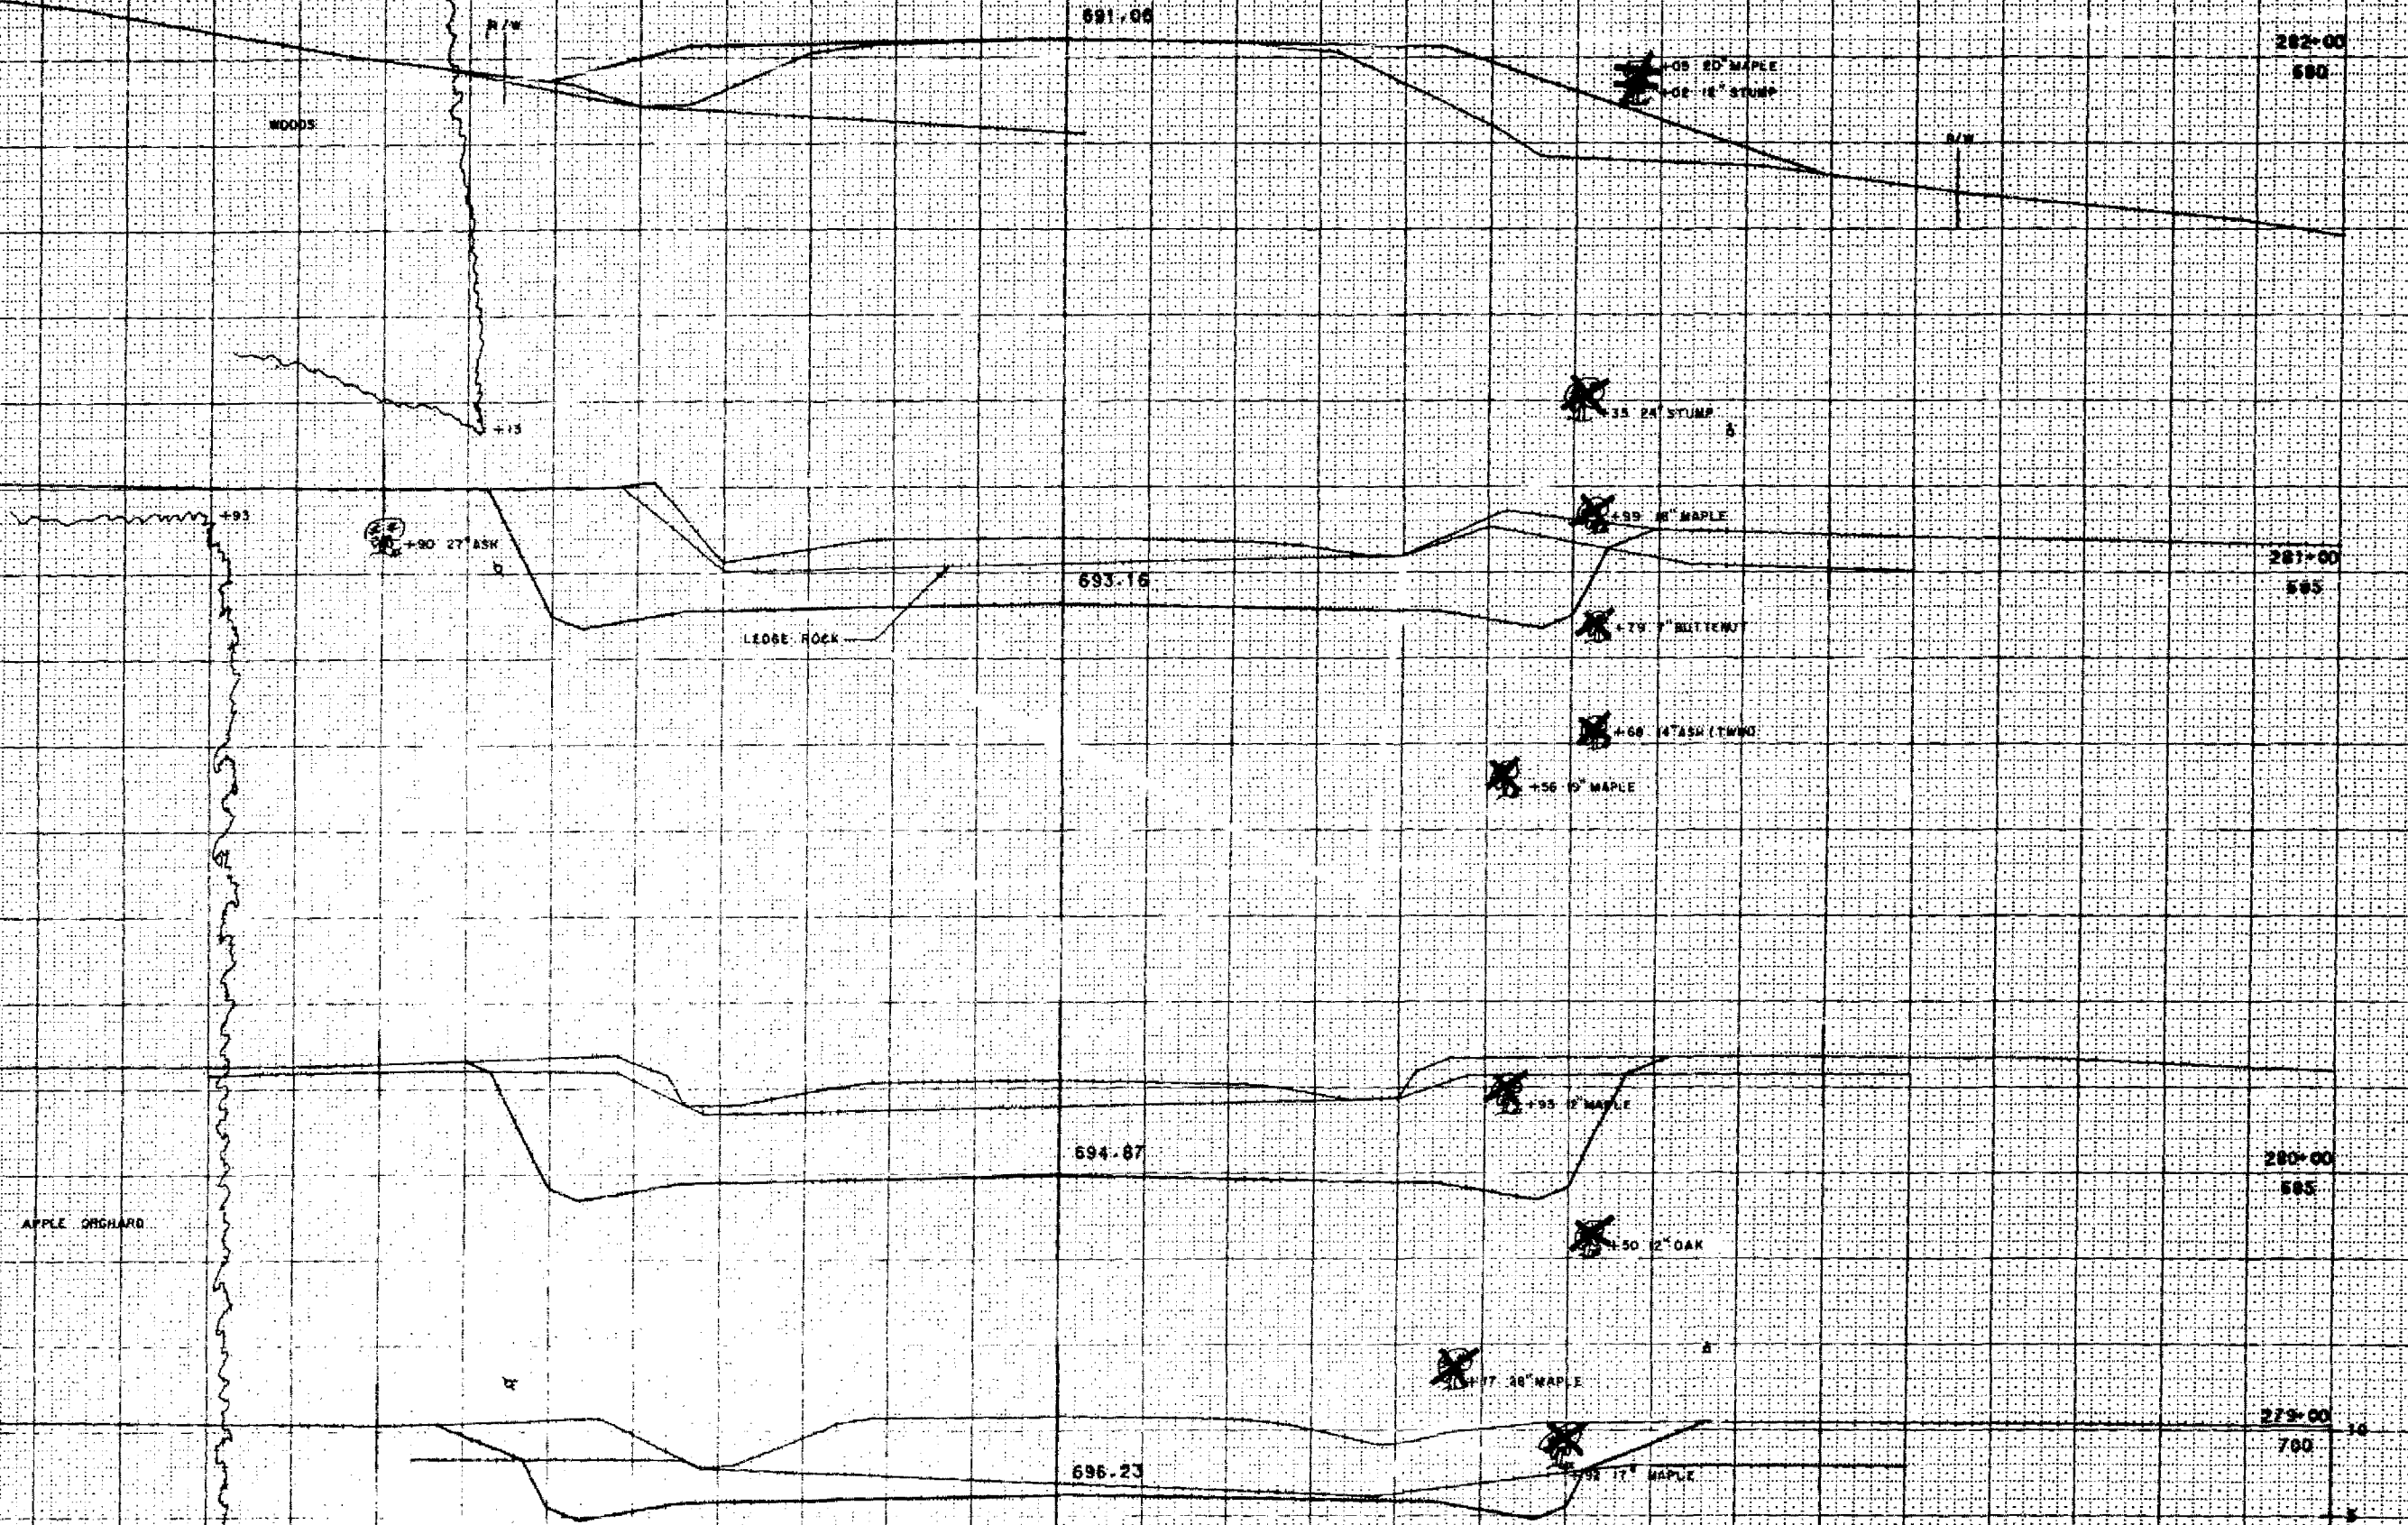

TEMPLATE IS SUBGRADE
PRINTED ELEV IS SUBGRADE
SCALE: FEET
SHEET NO. 36
414101238

SURVEY T.
B. CONSTRUCTION

686.16

285+00
585

R/W LEDGE ROCK

687.37

284+00
585

689.00

283+00
585

WOODS

SURVEY C
CONSTRUCTION C

30' CLEAR

288+00
580

288+00
580

287+00
580

286+00
585

16

TEMPLATE IS SUBGRADE
PRINTED ELEV IS SUBGRADE

SCALE: 1"=20'

SHEET NO 38 1 4141017233

SURVEY 1
B. CONSTRUCTION 2
688.52

STATE PROJECT NUMBER

414-1-72 9.74

585

687.60

294+00

585

687.45

0.028%

LEDGE ROCK

293+00

585

687.35

0.027%

0.026%

292+00

585

687.32

0.002%

291+00

585

687.18

0.018%

290+00

585

3" CEDARS

+85 1" CEDAR

+77 1" CEDAR

+72 1" CEDAR

+68 1" CEDAR

+47 1" CEDAR

+35 1" CEDAR

TEMPLATE IS SUBGRADE
PRINTED ELEV IS SUBGRADE


SCALE: FEET

SHEET NO 39

4141017259

STATE PROJECT NUMBER	SHEET NUMBER
4141-1-72	9.75

SURVEY 1
B. CONSTRUCTION 2

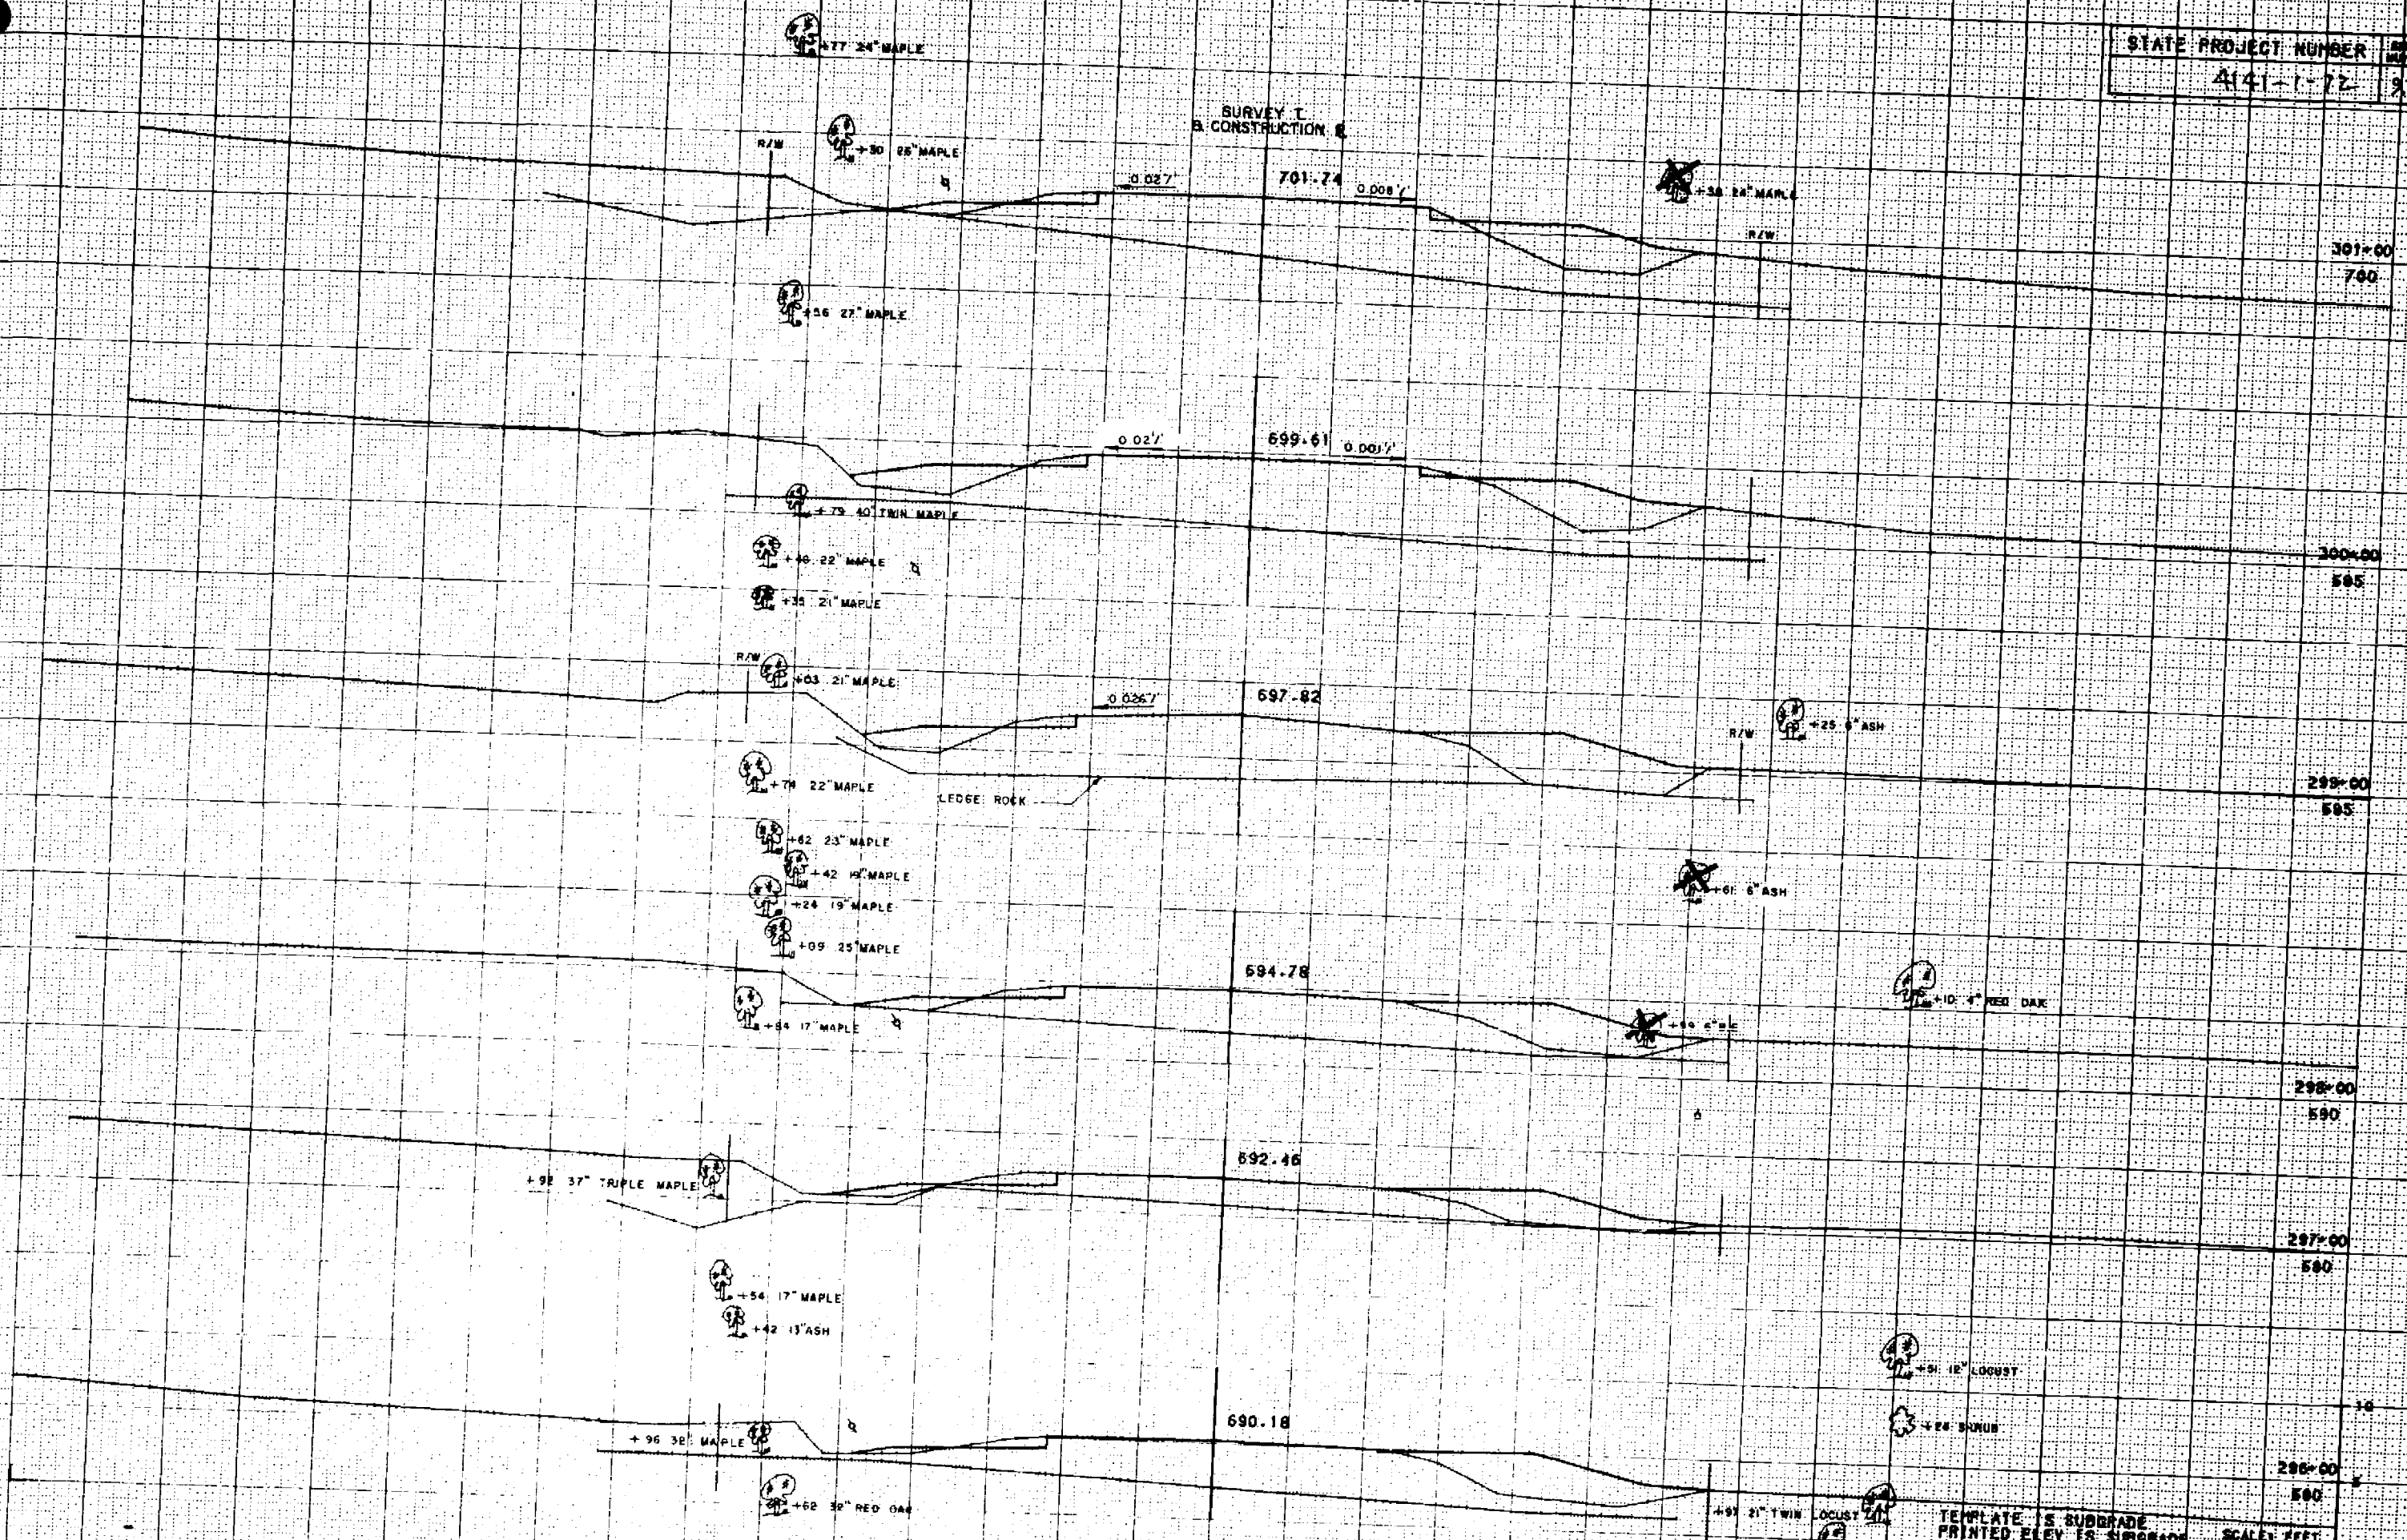


TEMPLATE IS SUBGRADE
PRINTED ELEV IS SUBGRADE

SCALE: FEET
SHEET NO. 40

SURVEY I
B. CONSTRUCTION

STATE PROJECT NUMBER	4141-1-72	SHEET NUMBER	476
----------------------	-----------	--------------	-----

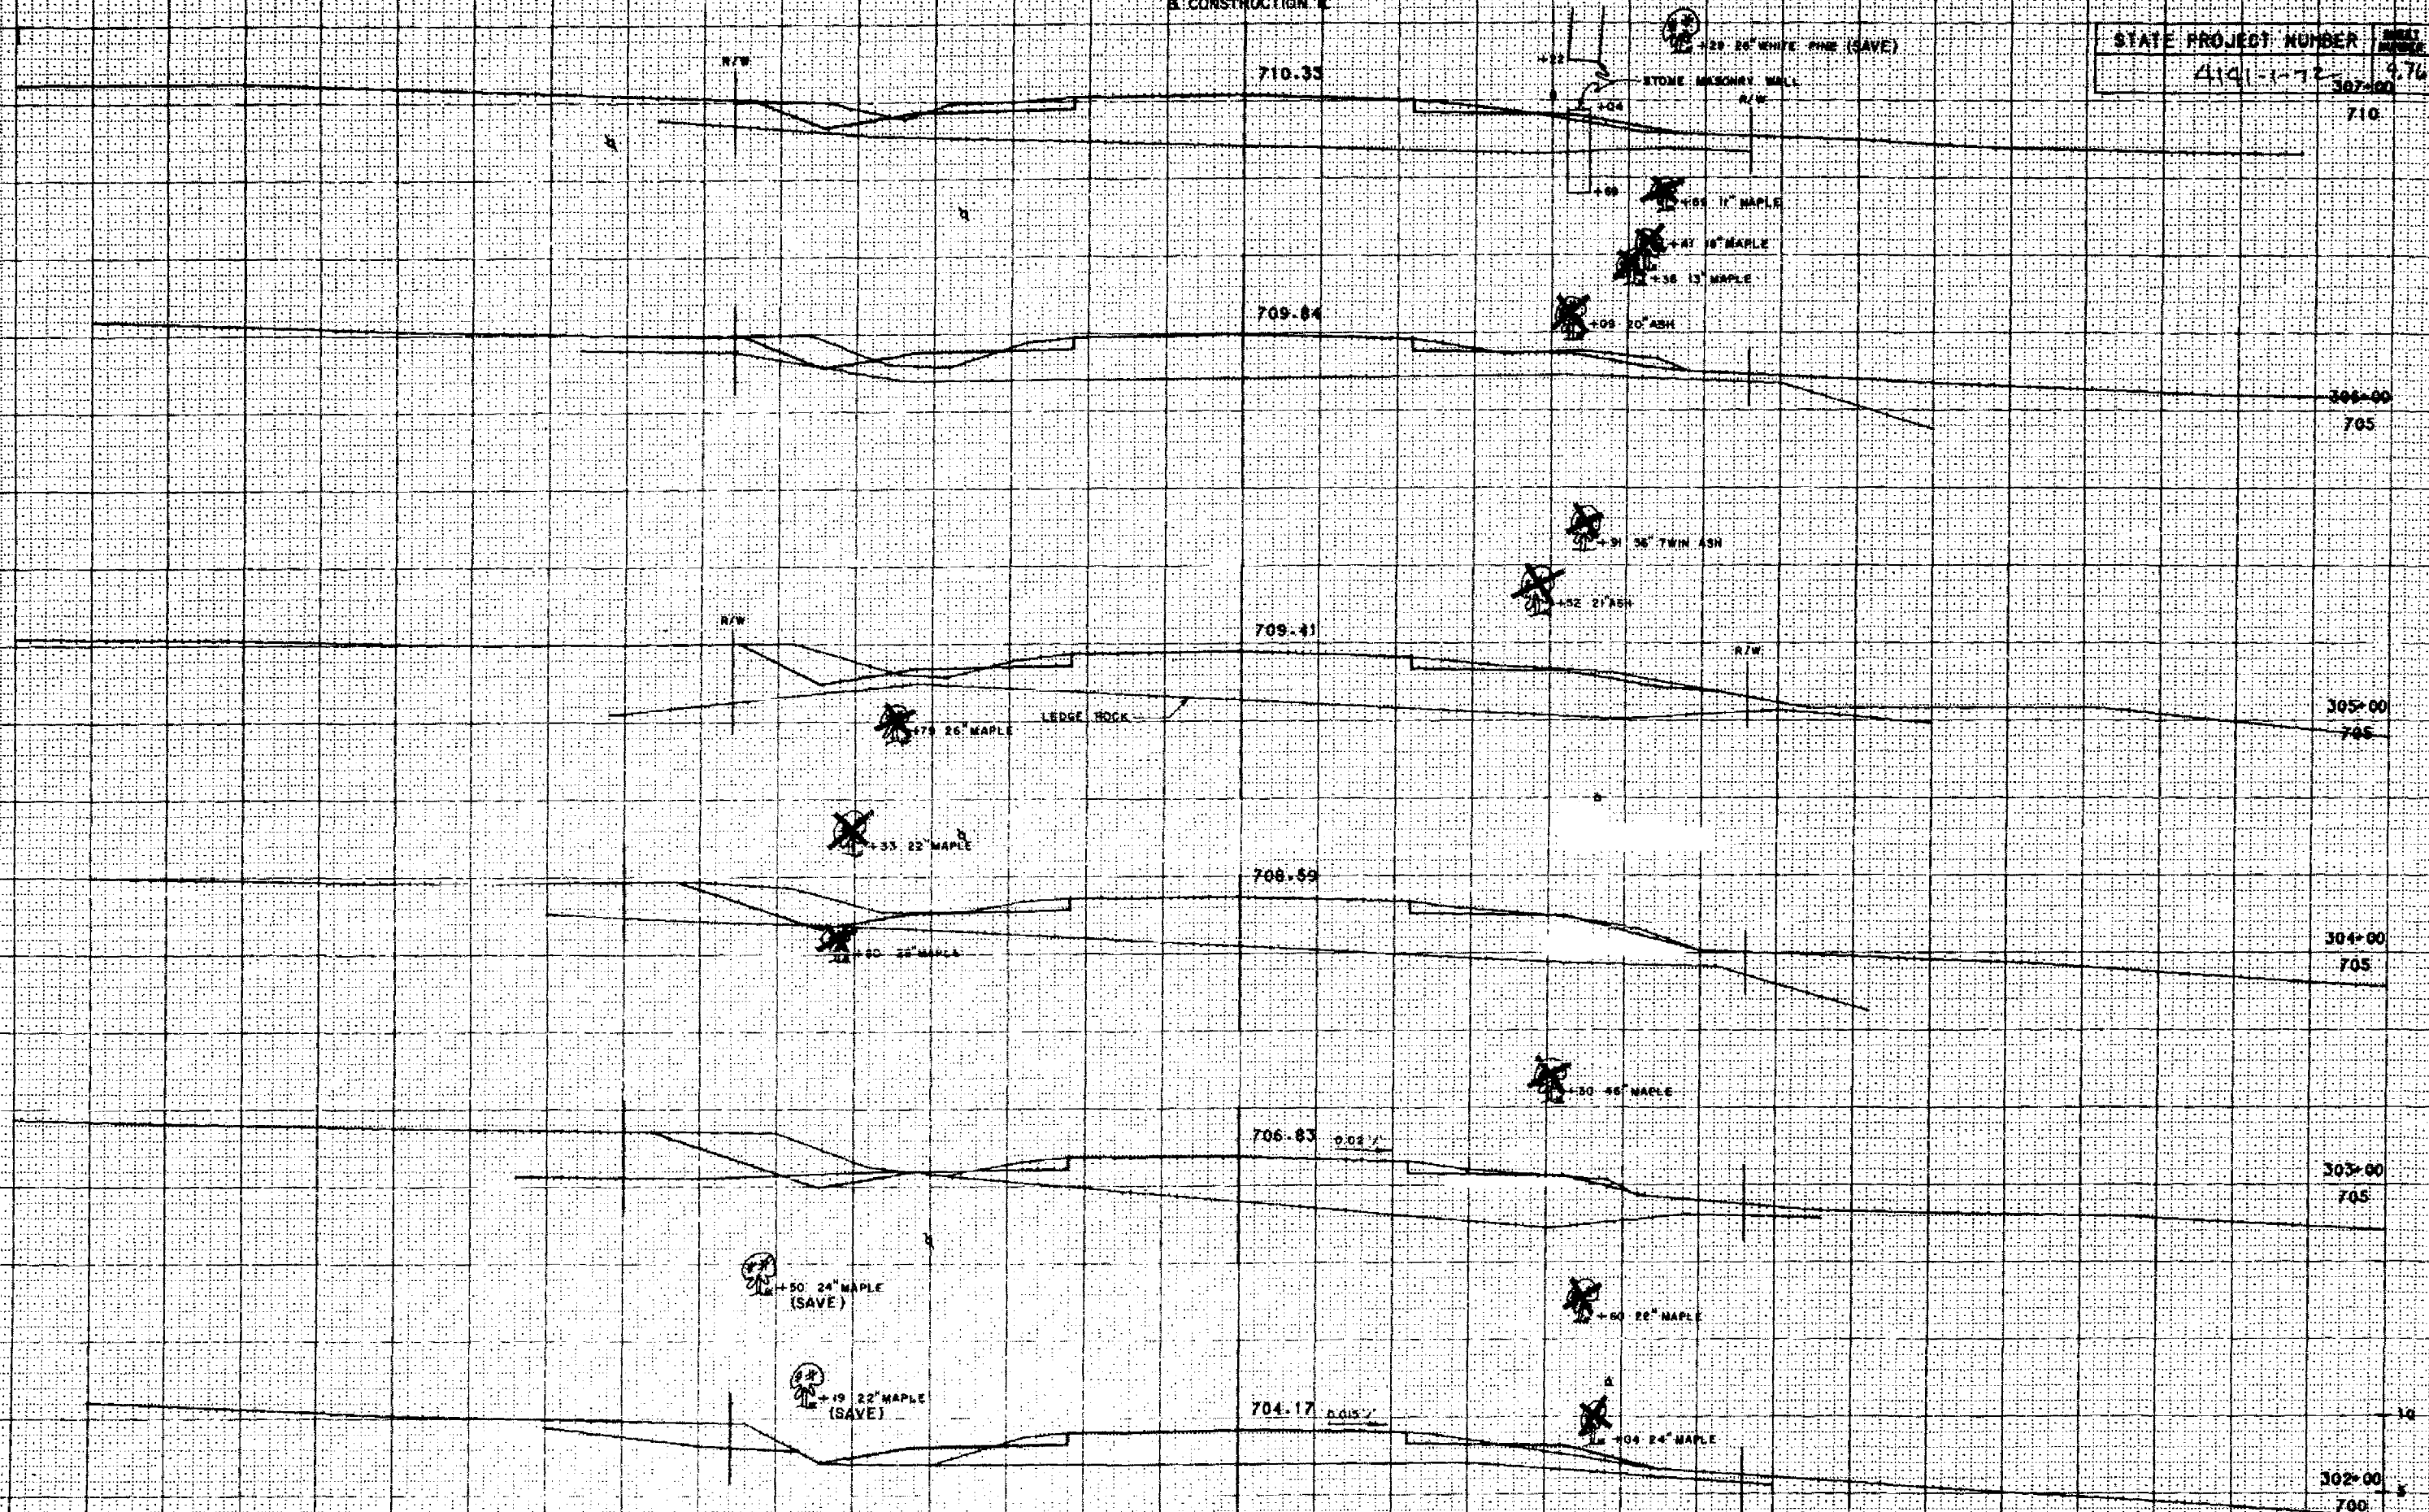

TEMPLATE IS SUBGRADE
PRINTED ELEV IS SUBGRADE

SCALE: FEET

SHEET NO 41 3 414101239

SURVEY 1
A CONSTRUCTION

STATE PROJECT NUMBER 1001
9.6.1.1.72-315.00

715.33

715

714.08

314.00

710

713.19

313.00

710

712.68

312.00

710

712.33

311.00

710

711.71

310.00

710

711.03

309.00

710

710.52

308.00

710

LEDGE ROCK

STONE MASONRY WALL

TEMPLATE'S SUBGRADE
PRINTED ELEV IS SUBGRADE

SCALE: FEET

SHEET NO. 42

4141017230

SURVEY 1
A. CONSTRUCTION 2

STATE PROJECT NUMBER	4141-1-7L
DATE	9/78

721.62

R/W

+42 14" ASH

+73 14" MAPLE

+45 MAPLE

721.70

+50 20" MAPLE

+47 20" RED OAK

+03 19" MAPLE (SAVE)

+72 18" MAPLE (SAVE)

+46 26" MAPLE

721.34

R/W

+05 7" TREE STUMP

+05 5" STUMP

+75 5" STUMP

+06 23" MAPLE

+32 15" MAPLE

+41 12" MAPLE

+96 5" MAPLE

+89 28" BASSWOOD CLUMP

+12 18" MAPLE

+34 13" MAPLE

+31 20" RED OAK

720.53

+07 27" RED OAK

R/W

+47 20" MAPLE

+05 15" MAPLE

+47 20" MAPLE

+05 15" MAPLE

+67 26" MAPLE

+06 20" MAPLE

+80 25" MAPLE

+52 25" MAPLE

+64 27" MAPLE

+73 20" MAPLE

719.34

R/W

+94 19" MAPLE

+27 17" RED OAK

+02 17" MAPLE

719.06

+83 25" MAPLE

+82 15" MAPLE

+81 18" MAPLE

+30 21" MAPLE

+05 30" MAPLE

+87 7" MAPLE

+86 21" MAPLE

+33 27" MAPLE

+19 15" MAPLE

+02 21" MAPLE

717.91

+48 19" MAPLE

+24 13" MAPLE

+08 27" RED OAK

+91 27" MAPLE

716.69

+73 20" MAPLE

+48 19" MAPLE

+24 13" MAPLE

+08 27" RED OAK


+91 27" MAPLE

TEMPLATE IS SUBGRADE
PRINTED ELEV IS SUBGRADE

SCALE: FEET

SHEET NO. 43 1 4141017238

STATE PROJECT NUMBER 4141-1-71
 9-79

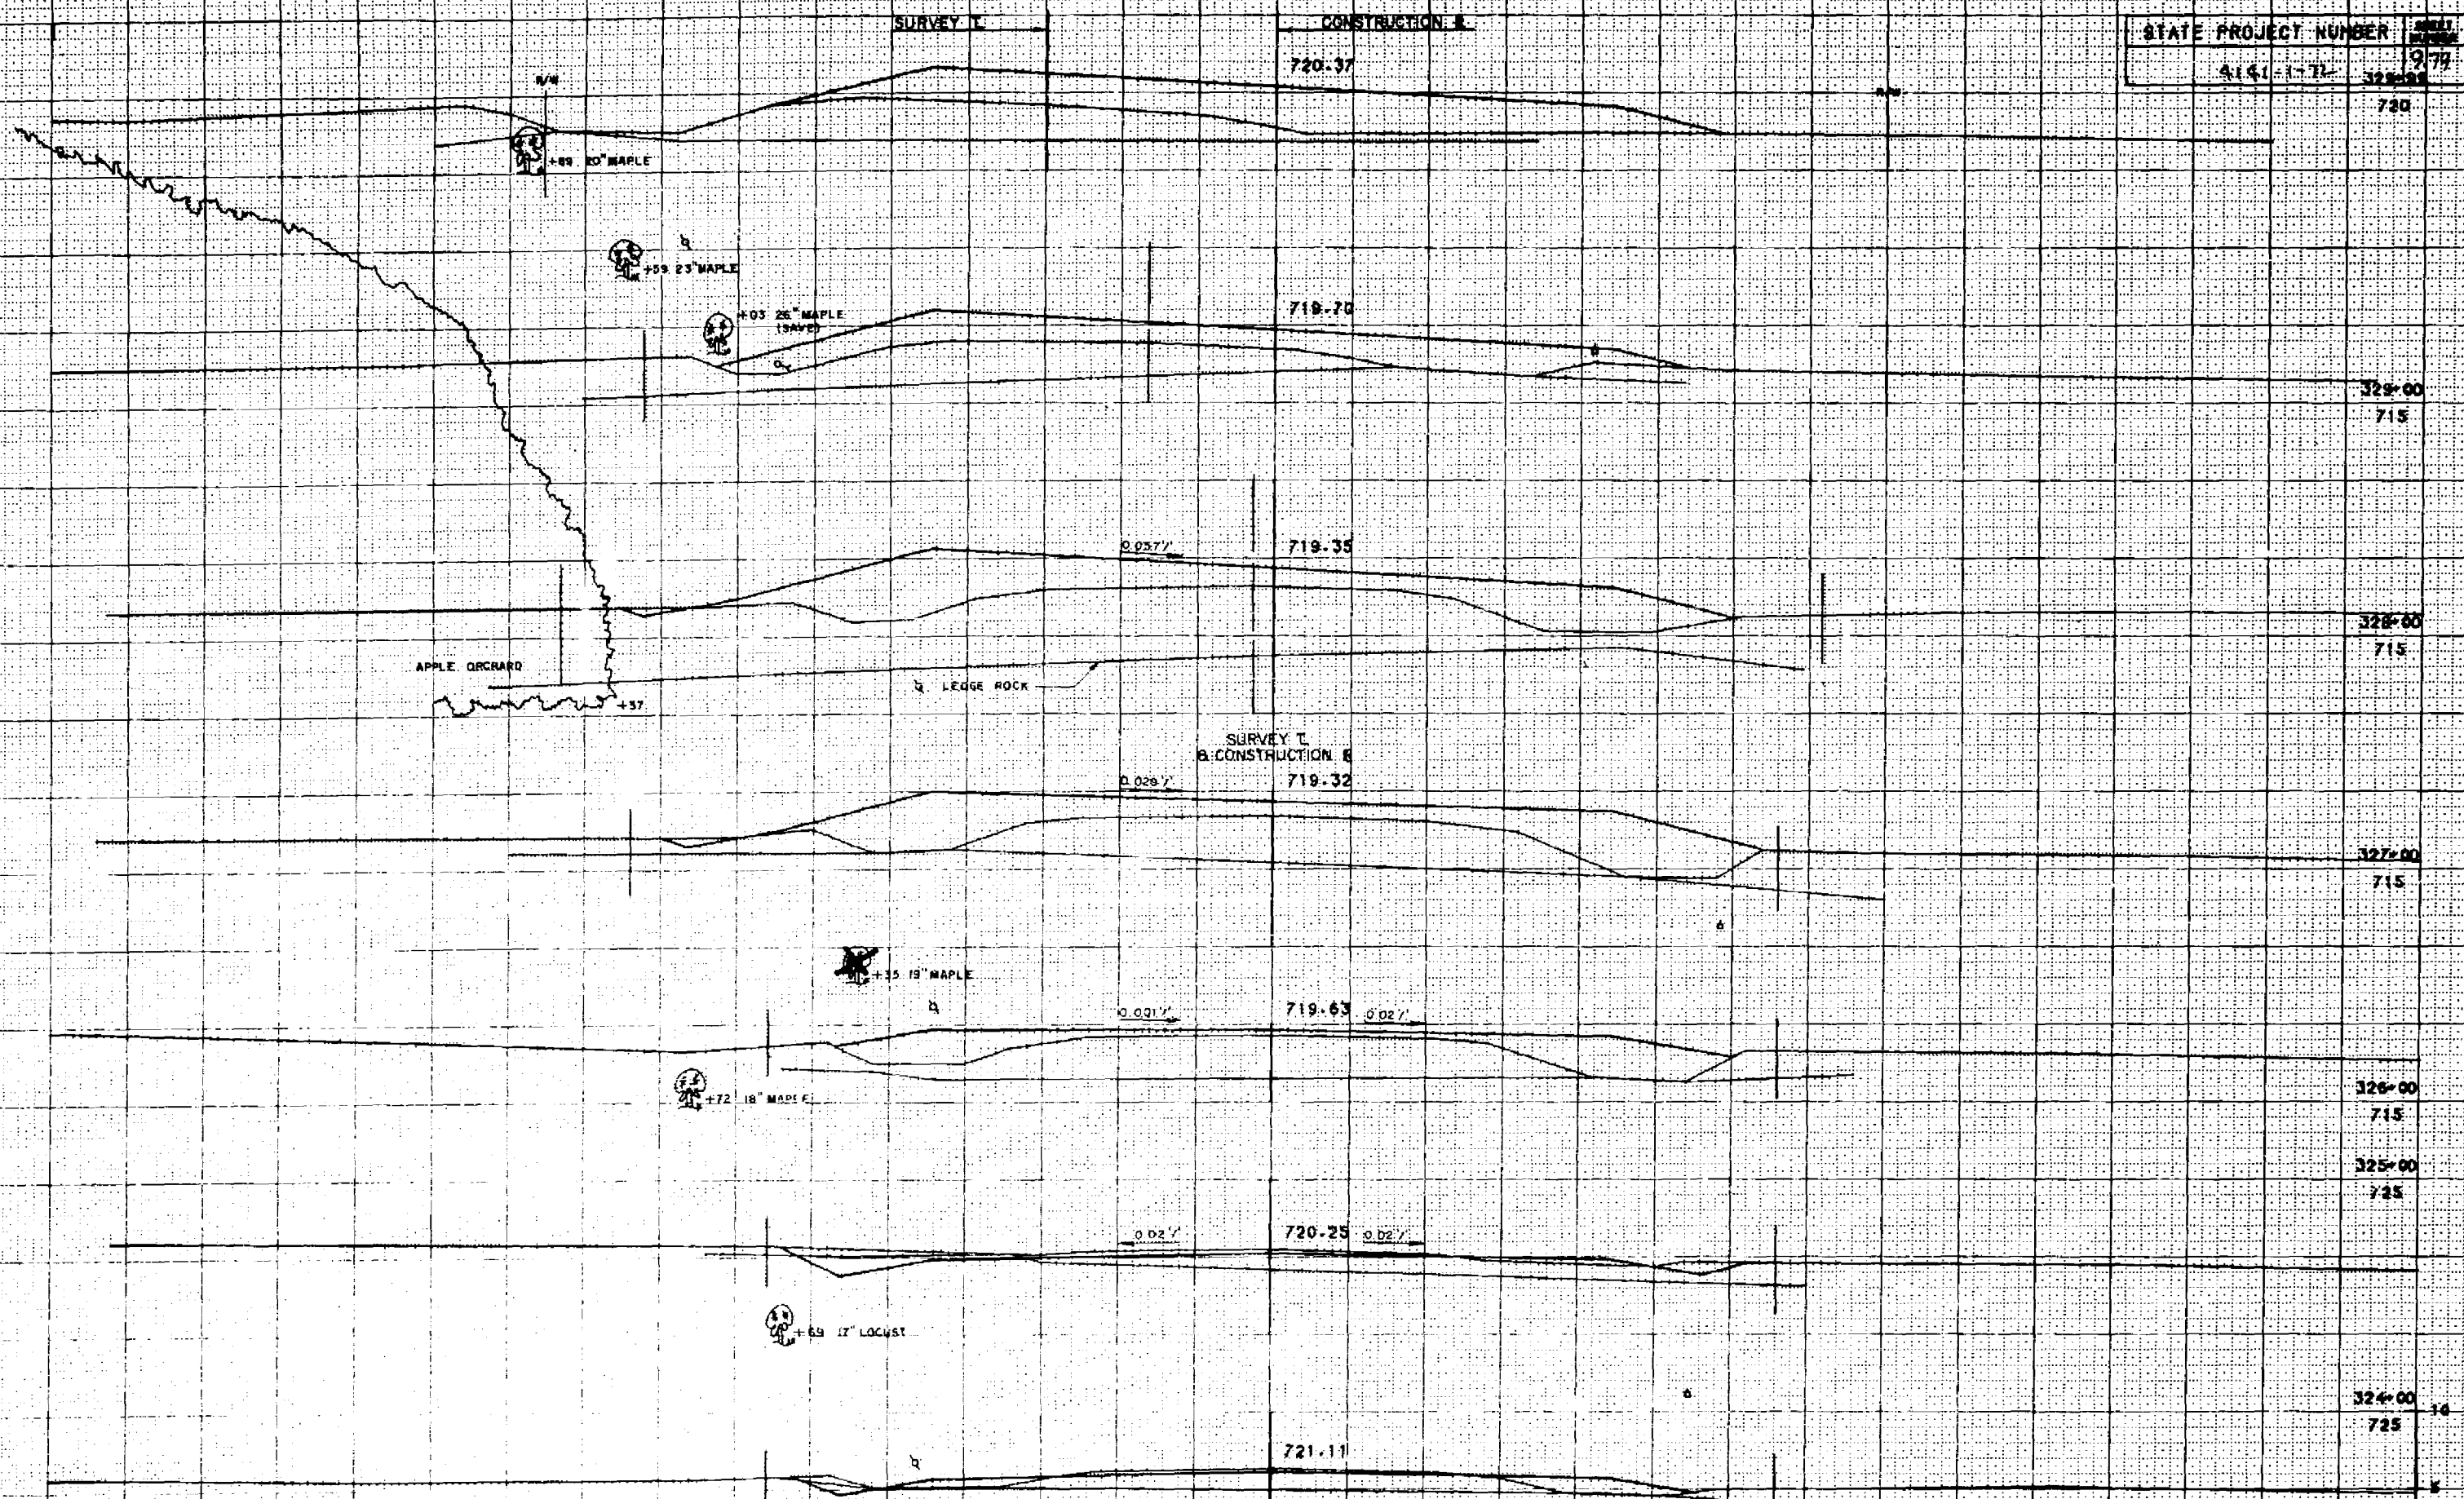

SURVEY L
CONSTRUCTION R

STATE PROJECT NUMBER
4141-1-72
338400

735

730.28

335.00

730

728.48

333.96

725

726.28

OLD APPLE ORCHARD

ROW OF 8 CEDARS

147 BLUE SPRUCE

141 BLUE SPRUCE

142 8" PINE

143 24" MAPLE

ROW OF 8 LOCUST

332.96

720

724.30

331.96

720

722.66

330.97

720

721.36

TEMPLATE IS SUBGRADE
PRINTED ELEV IS SUBGRADE

SCALE: FEET

SHEET NO. 45
3 414101238

SURVEY 1.
A. CONSTRUCTION 2.

STATE PROJECT NUMBER
414-1-72 98

1/2" = 1' BLACK CHERRY

0.04%

728.02

0.02%

N/A

735

728.28

342+00

735

OLD APPLE ORCHARD

730.22

342+00

730

731.18

341+00

730

LEDGE ROCK

732.03

340+00

735

732.40

339+00

735

732.23

338+00

735

731.53

337+00

735


TEMPLATE IS SUBGRADE
PRINTED ELEV IS SUBGRADE

SCALE: FEET

SHEET NO. 46 1 4141017238

STATE PROJECT NUMBER
4141-72 912


SURVEY T.
B. CONSTRUCTION

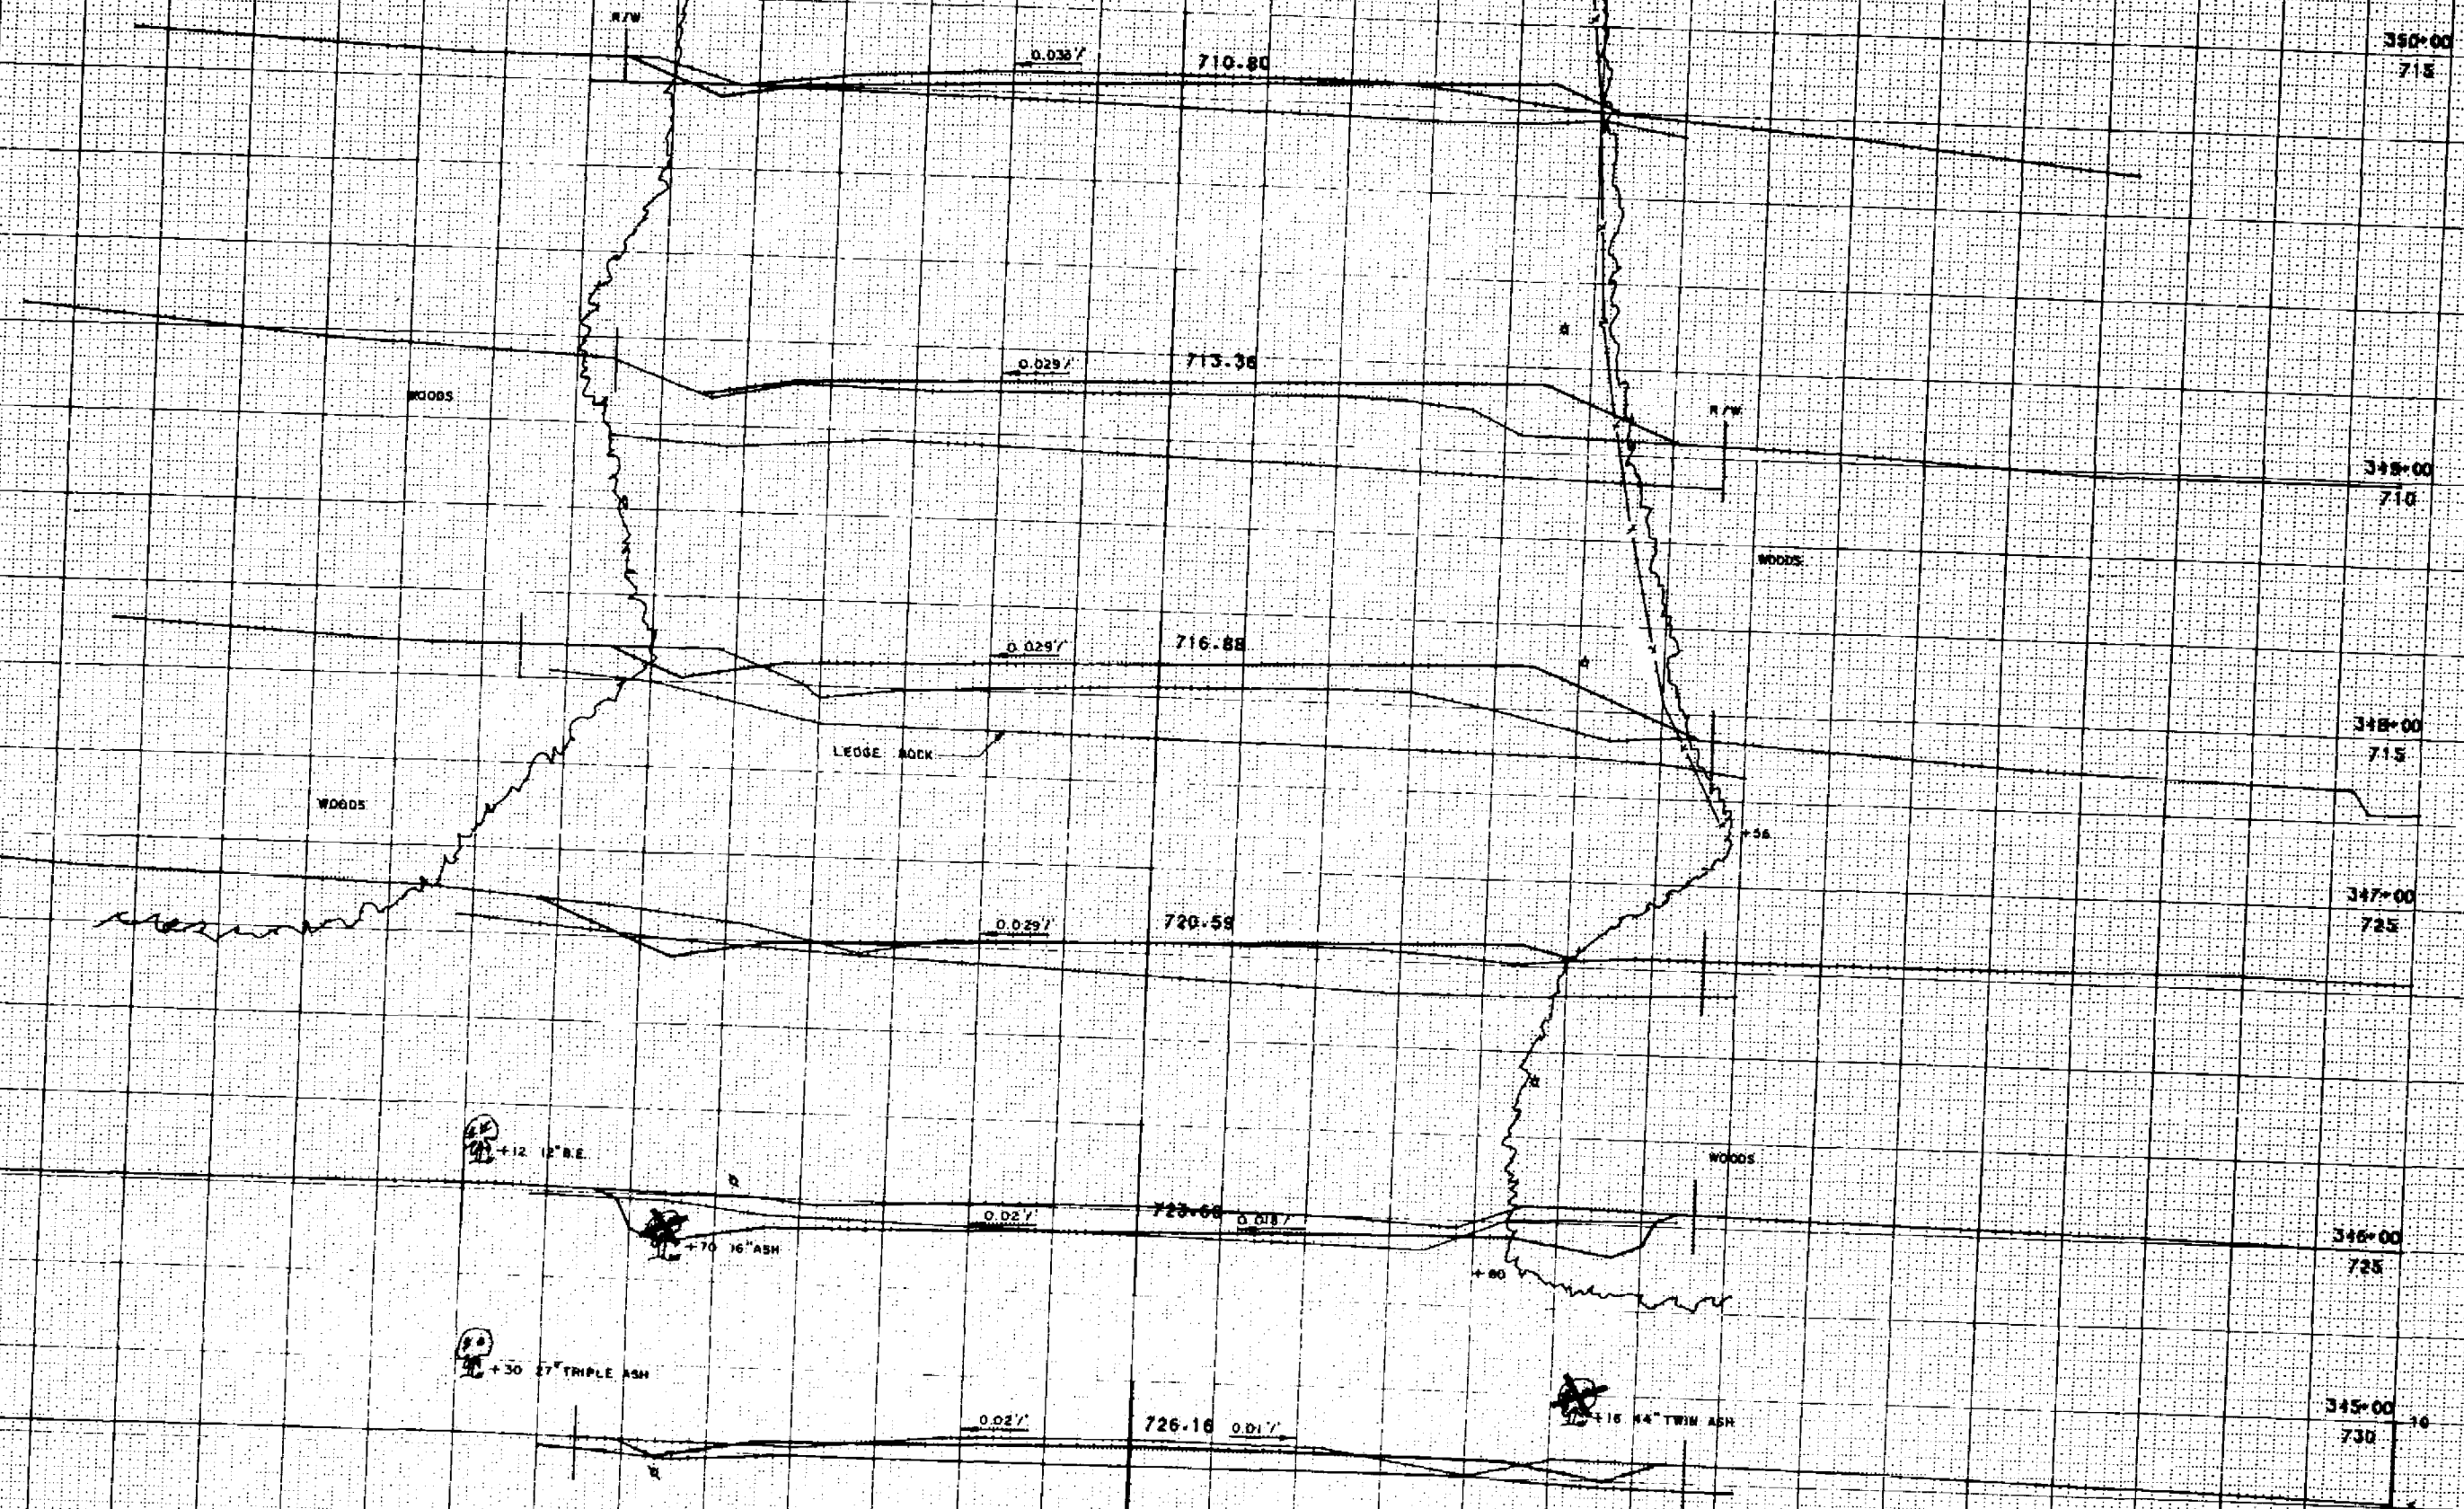

TEMPLATE IS SUBGRADE
PRINTED ELEV IS SUBGRADE
SCALE: FEET


SHEET NO. 47


STATE PROJECT NUMBER	SHEET NUMBER
4141-1-72	914

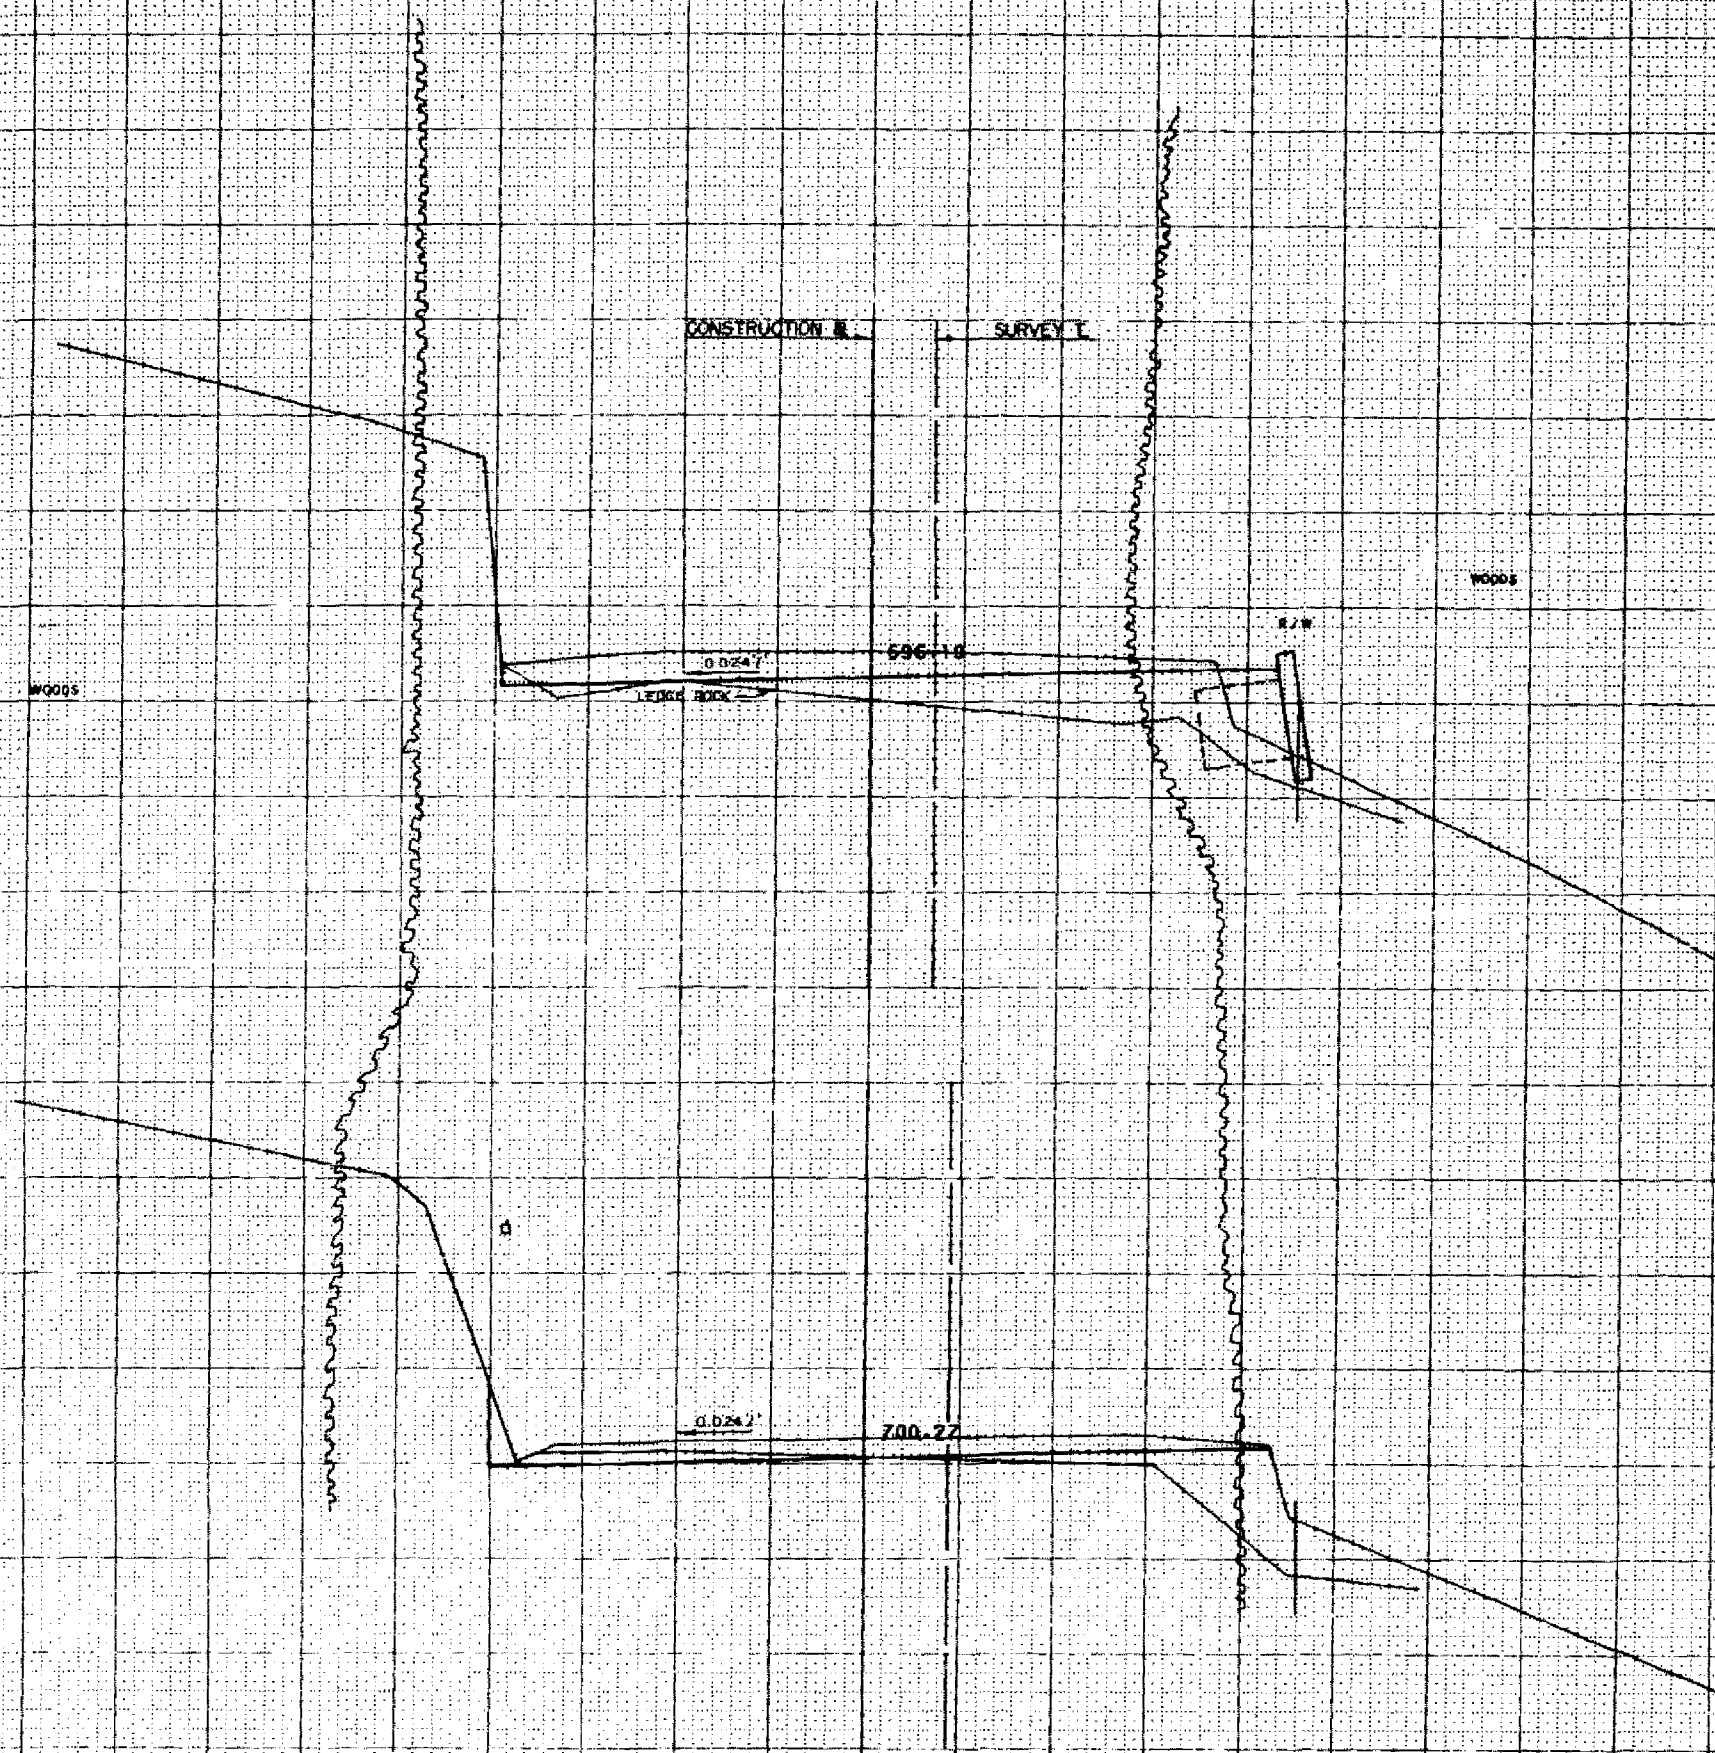



355+96
700


354+97
705

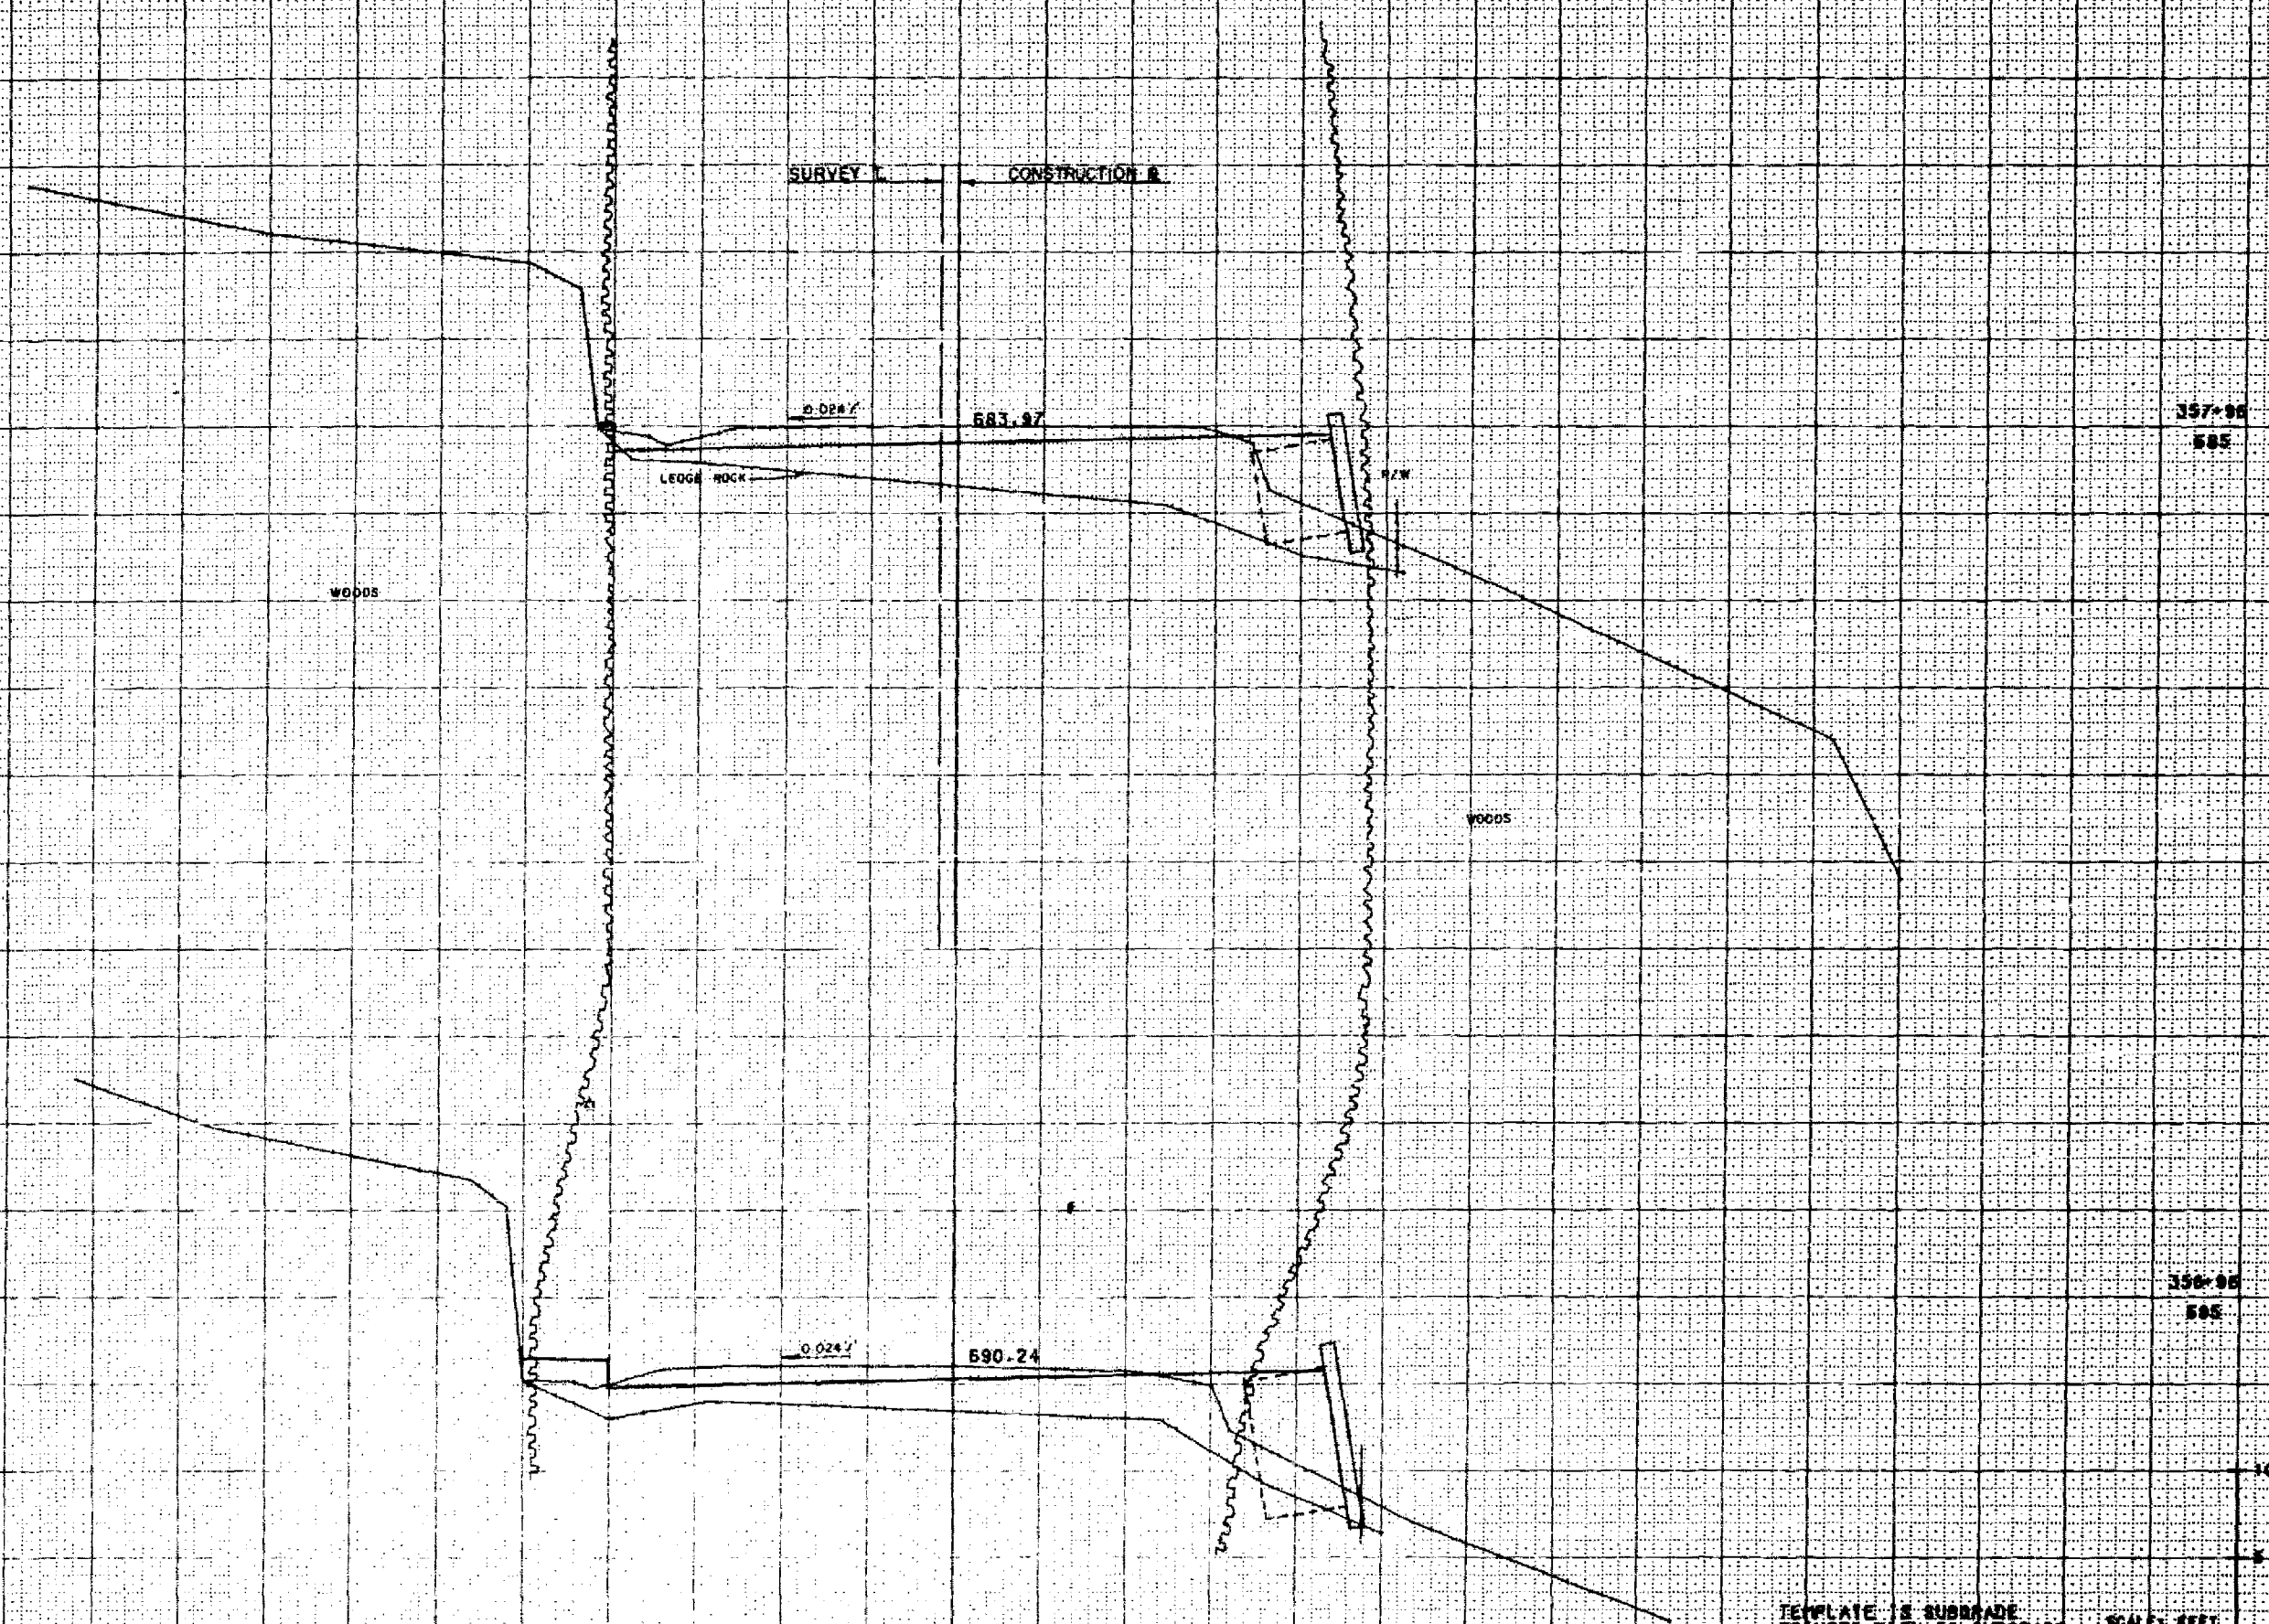

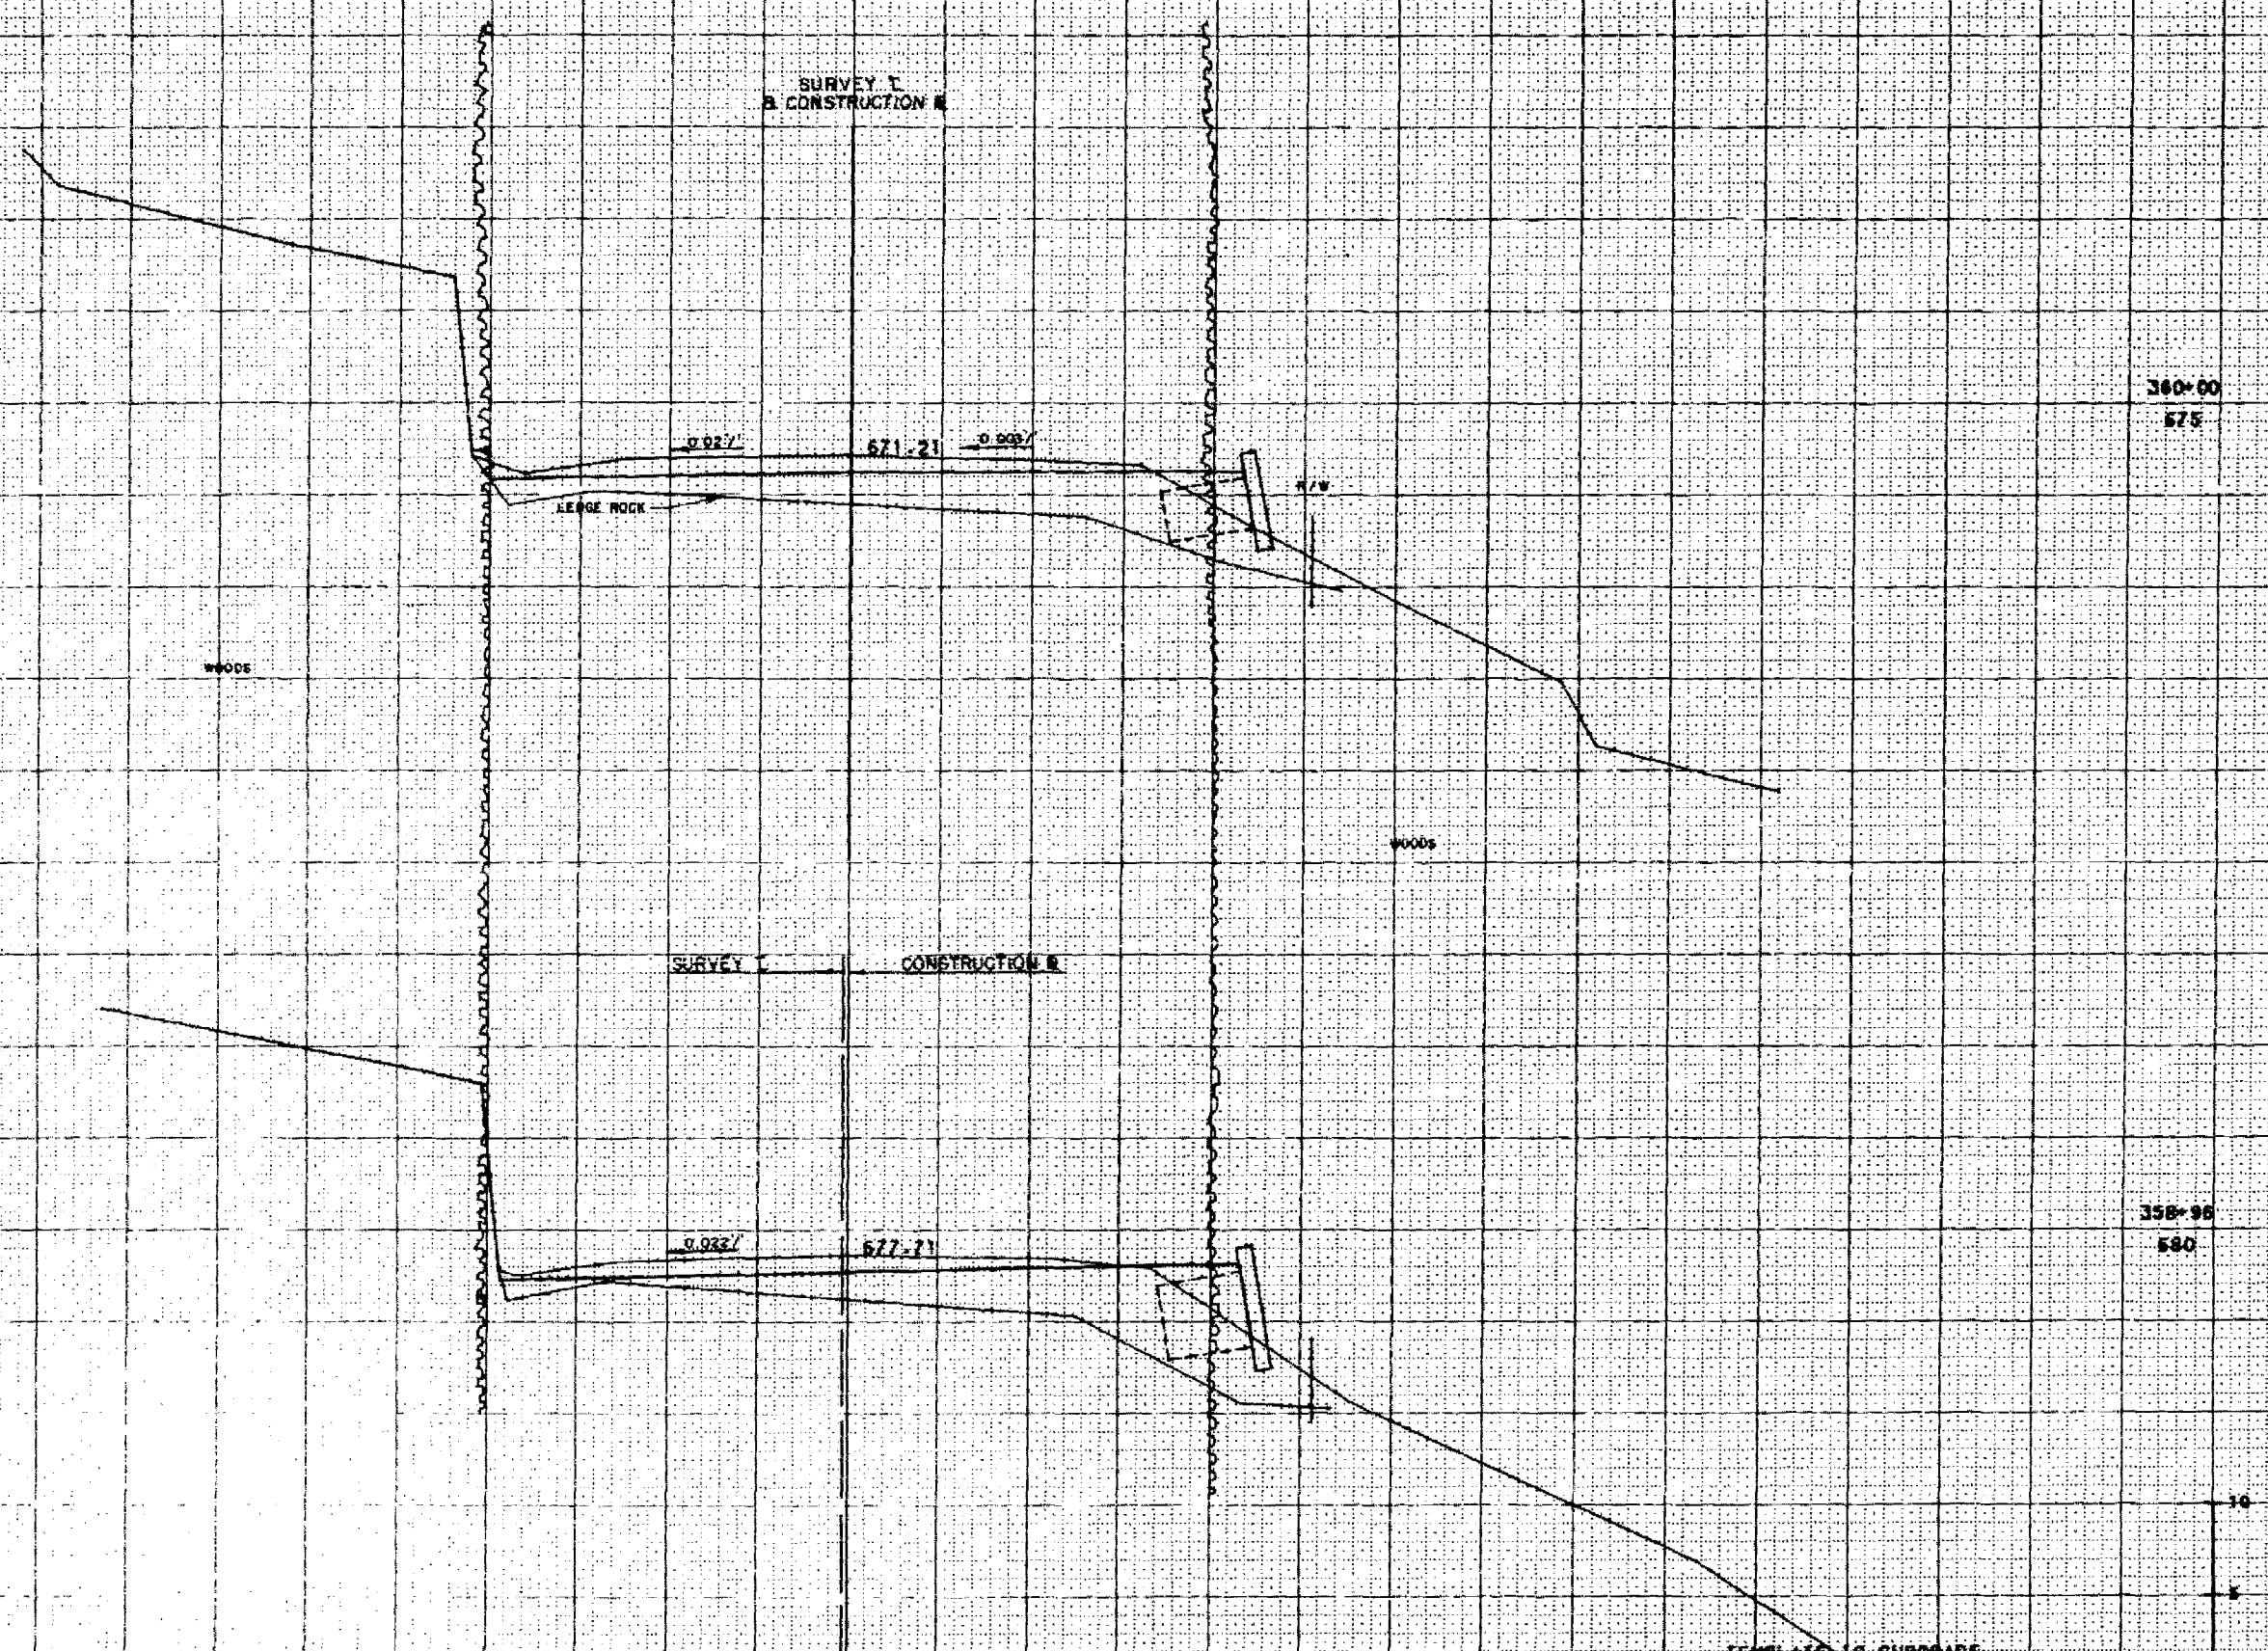

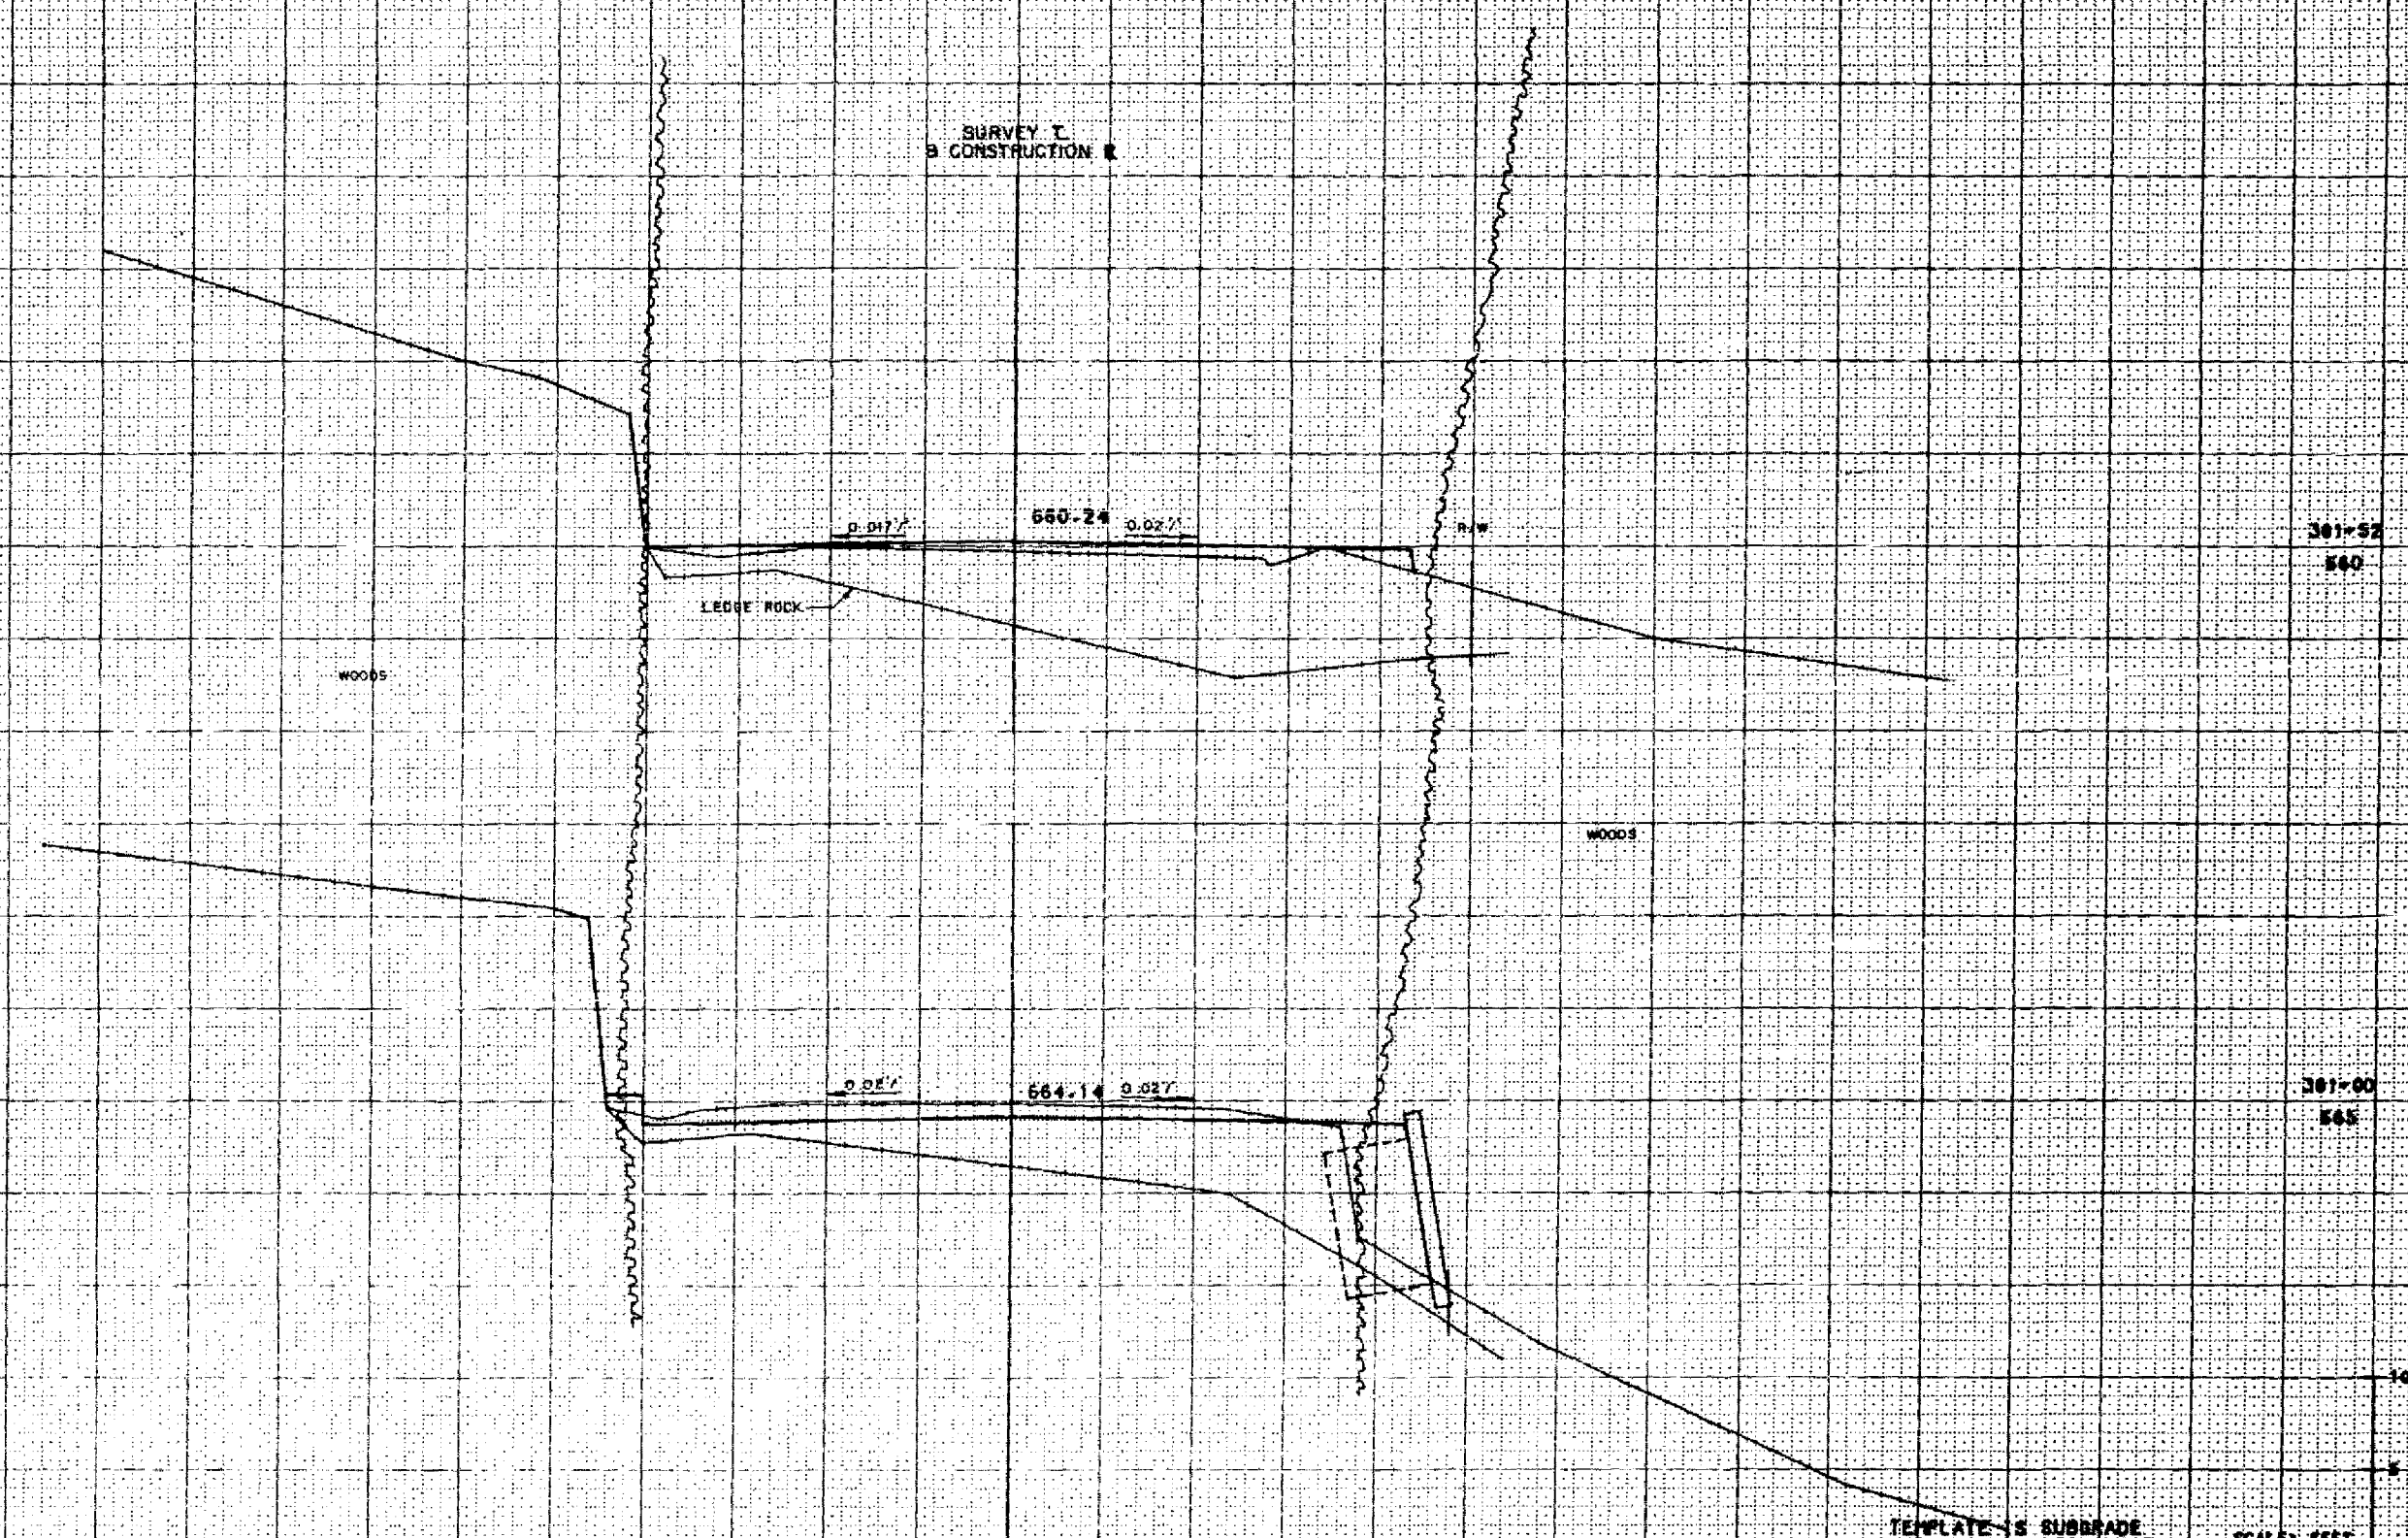

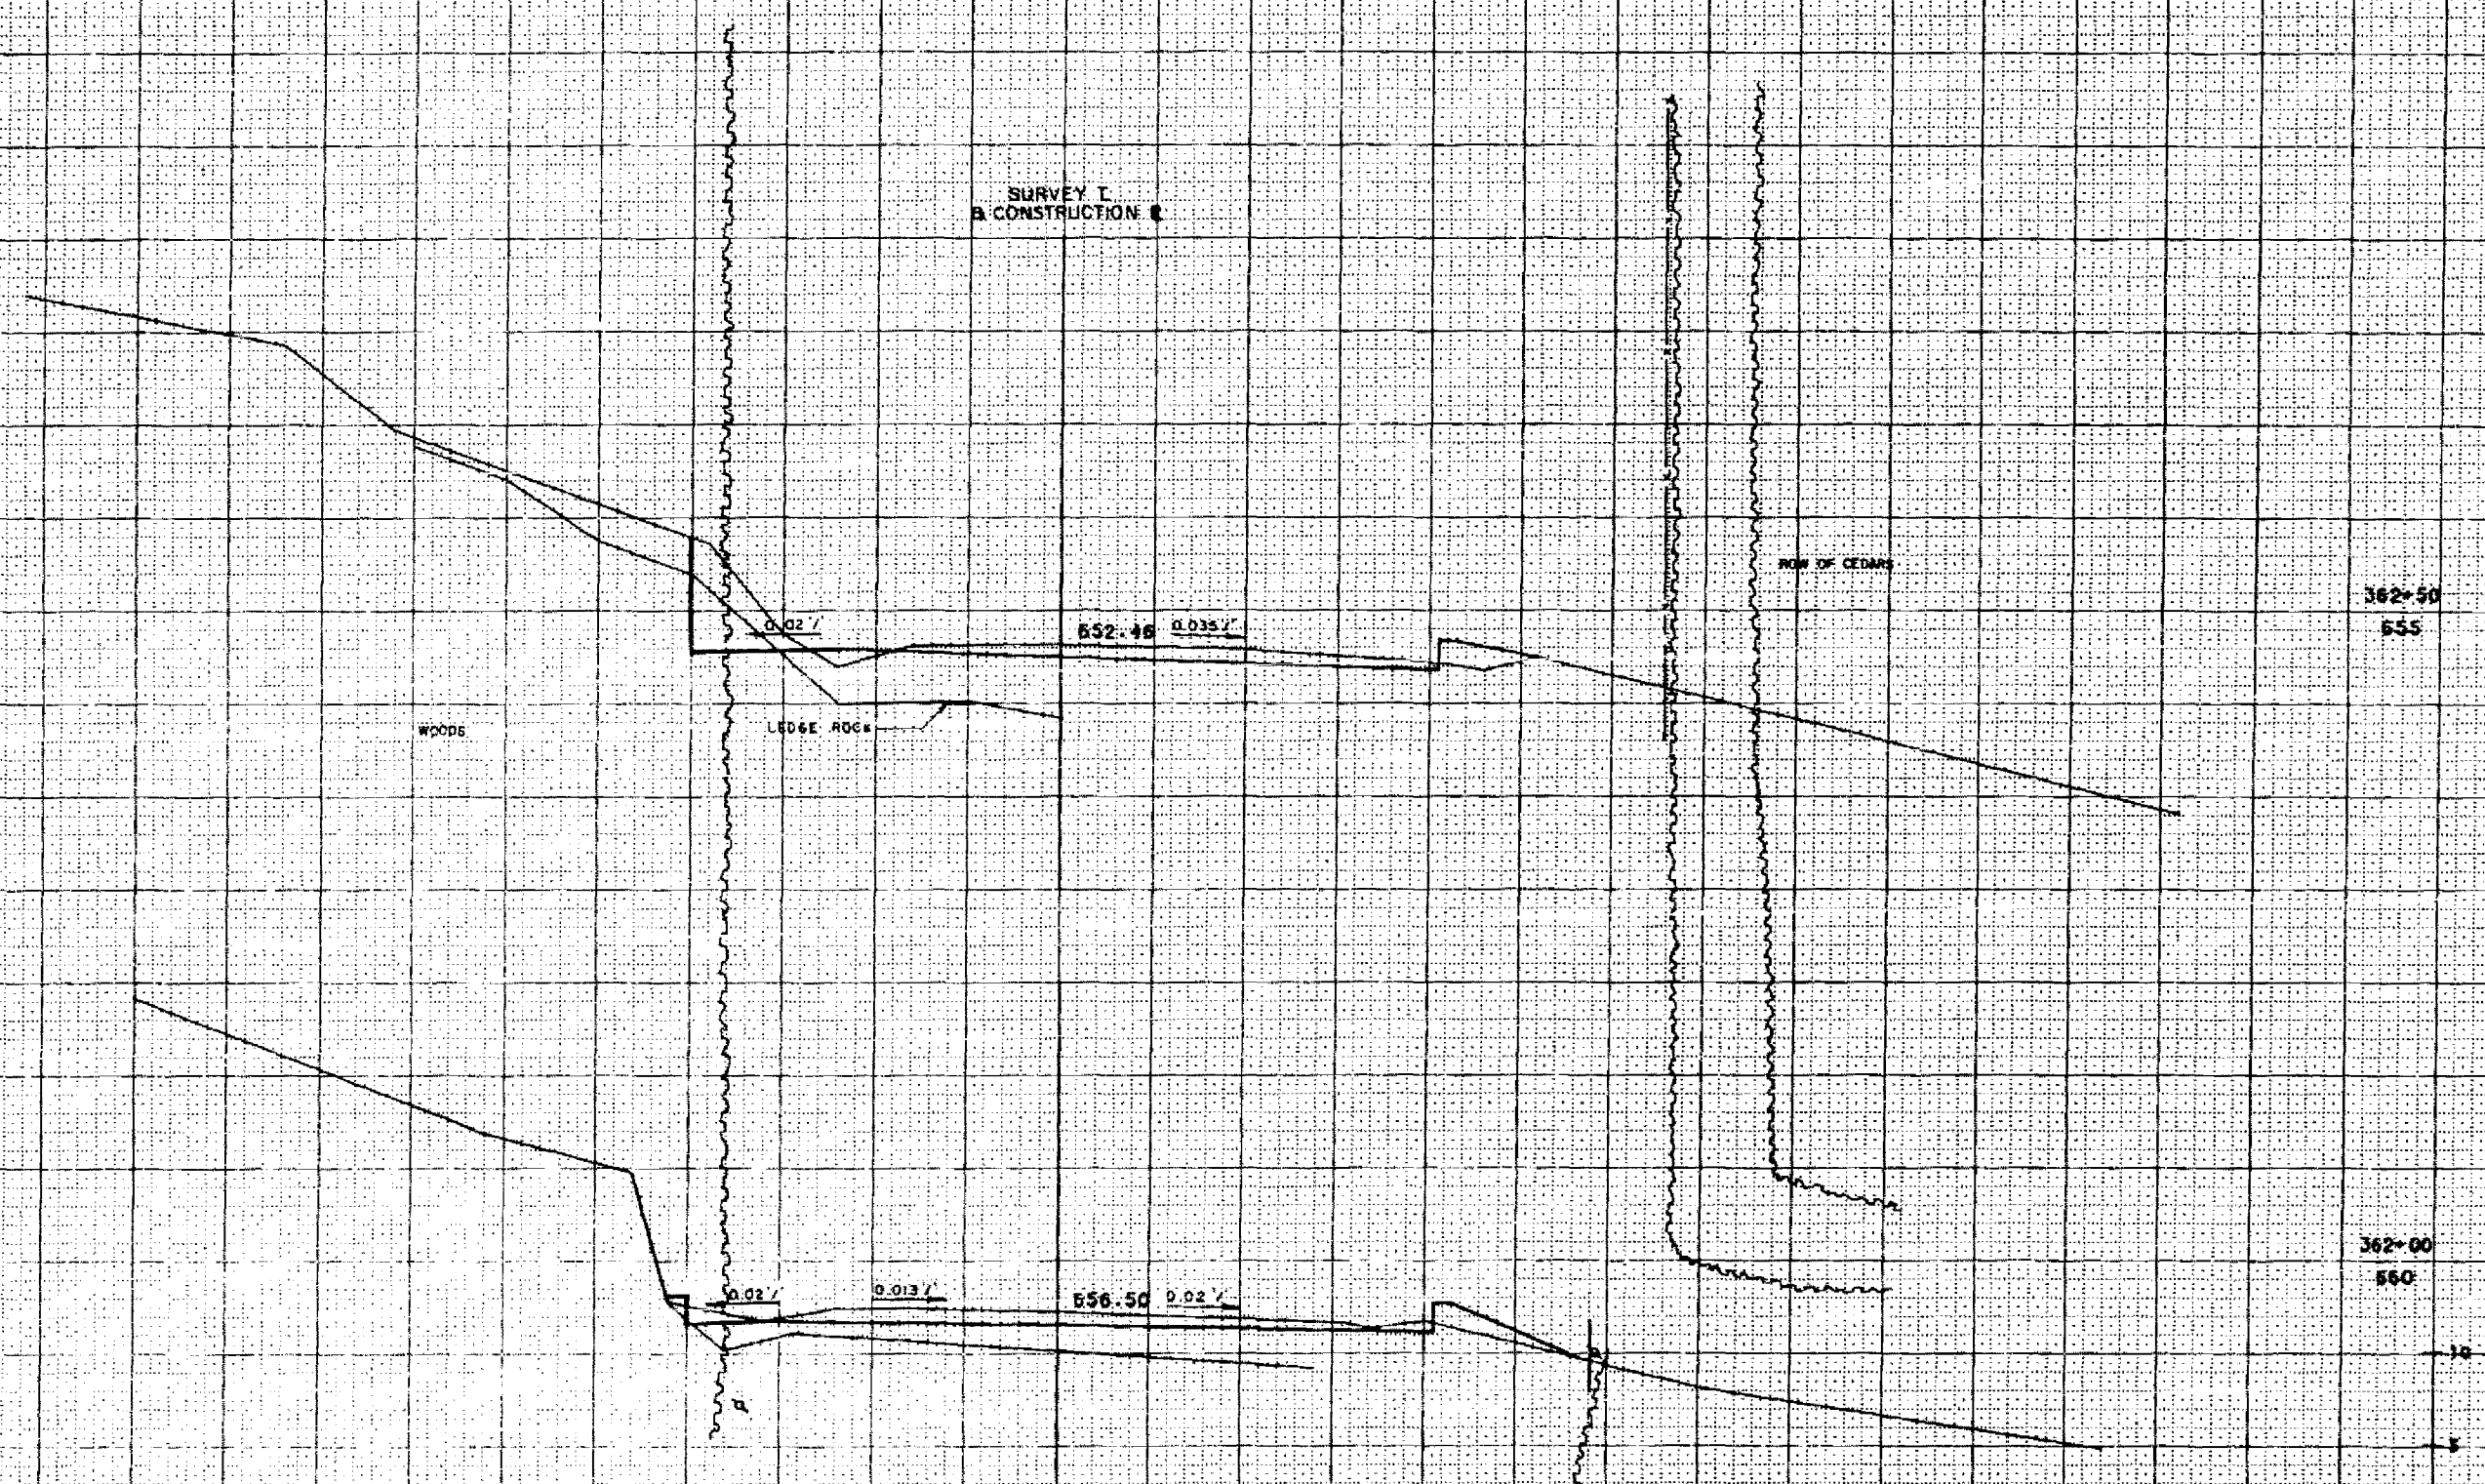

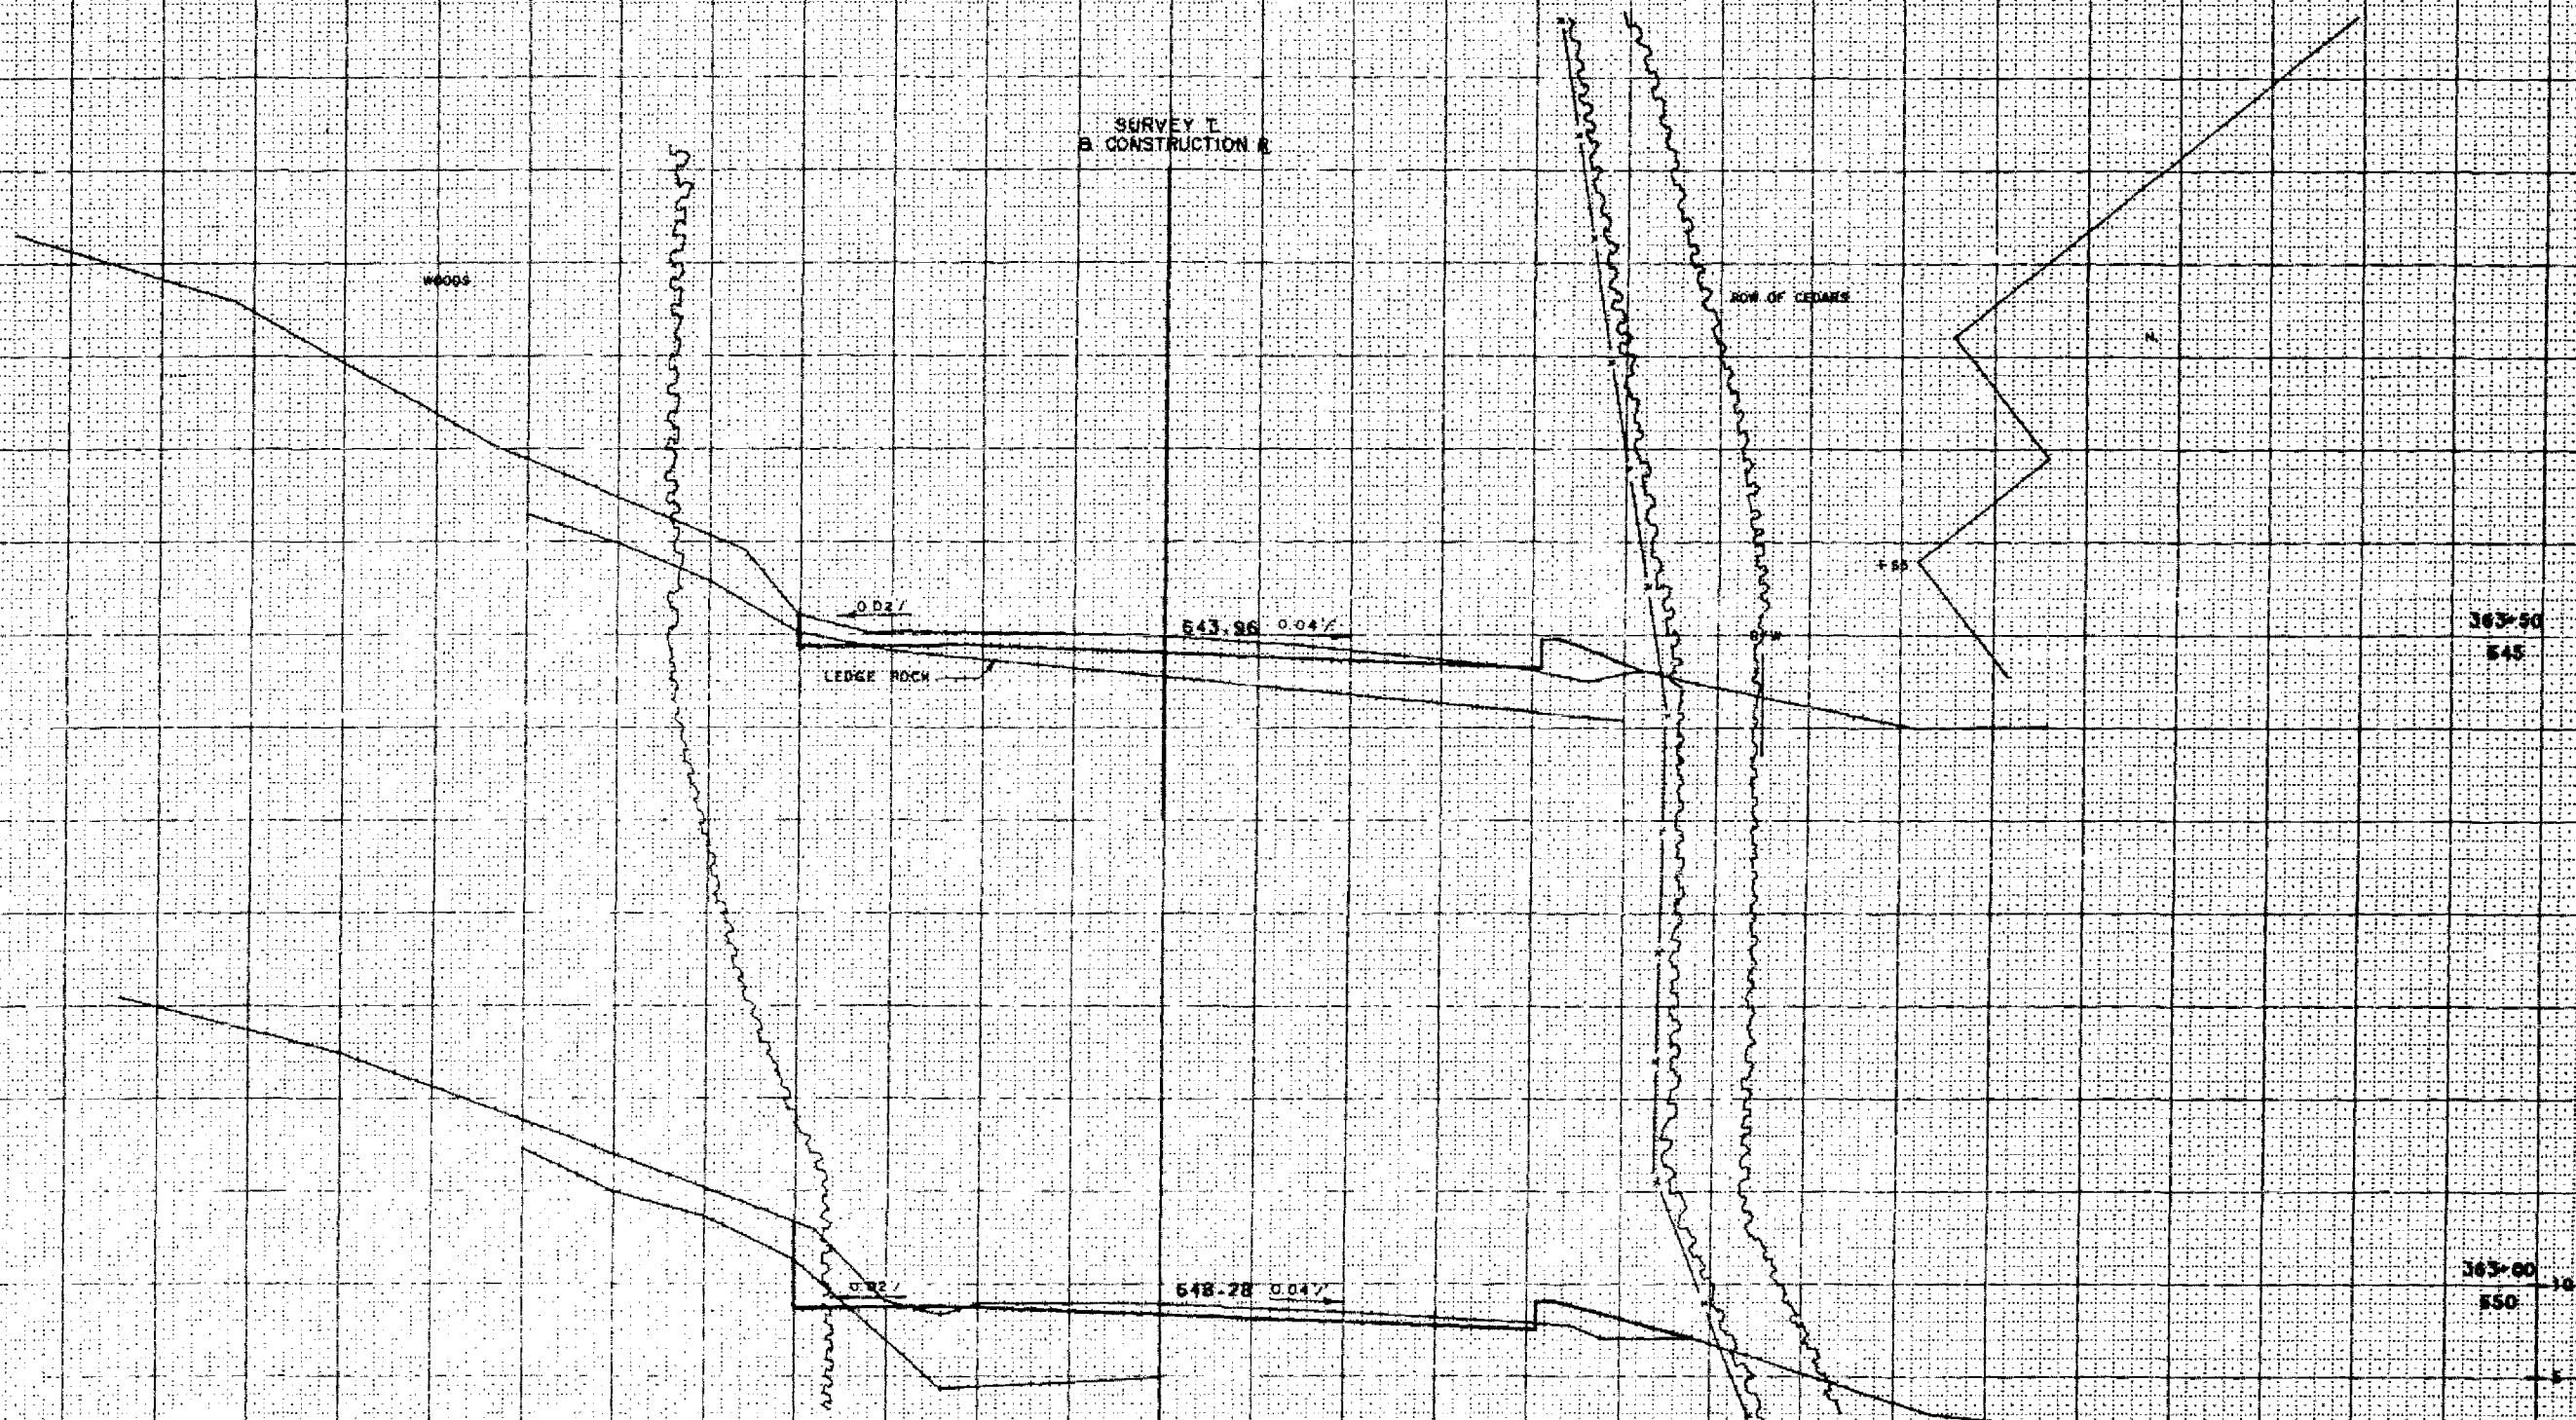

SURVEY I
B. CONSTRUCTION

STATE PROJECT NUMBER
4141-1-72-385-50
SHEET NUMBER
990

530

385+00

535

384+50

535

384+00

540

TEMPLATE IS SUBGRADE
PRINTED ELEV IS SUBGRADE

SCALE: FEET

SHEET NO. 55 1141017259

