

INDEX OF SHEETS

Sheet No. 1 Title
 Sheet No. 2-2.22 Typical Sections and Details
 Sheet No. 3-3.6 Estimate of Quantities
 Sheet No. 3A-3P Miscellaneous Quantities
 Sheet No. 4-4.18 Right of Way Plat
 Sheet No. 5-5.20 Plan and Profile
 Sheet No. 6-6.24 Standard Detail Drawings
 Sheet No. 7-7.2 Sign Plates
 Sheet No. 8-8.2 Structure Plans
 Sheet No. 9-9.9 Computer Earthwork Data
 Sheet No. 9.10-9.92 Cross Sections

TOTAL SHEETS = 210



STATE OF WISCONSIN DEPARTMENT OF TRANSPORTATION

PLAN OF PROPOSED IMPROVEMENT

C.T.H. "T" - C.T.H. "E" EGG HARBOR - FISH CREEK

(VILLAGE OF EGG HARBOR)



S.T.H. 42
DOOR COUNTY

S.T.H. 42
DOOR COUNTY

STATE PROJECT NUMBER
4140-2-71

STATE PROJECT NUMBER
4141-1-72

**AS
BUILT**

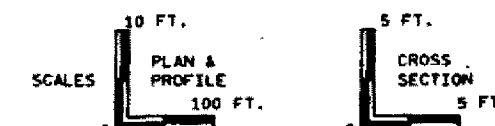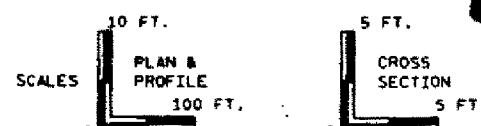



DESIGN DESIGNATION

	4141-1-72	4140-2-71
A.D.T. (1989)	4,870	4,020
A.D.T. (2009)	6,240	5,150
D.M.V.	555	458
D.	60/40%	60/40%
T.	5.6%	5.6%
V.	55 M.P.H.	35 M.P.H.

CONVENTIONAL SIGNS

COUNTY LINE
 CORPORATE LIMITS
 PROPERTY LINE
 LOT LINE
 LIMITED HIGHWAY EASEMENT
 EXISTING RIGHT OF WAY
 NEW RIGHT OF WAY
 REFERENCE LINE
 SLOPE INTERCEPT
 ORIGINAL GROUND
 MARSH OR ROCK PROFILE
 CULVERT IN PLACE
 CULVERT REQUIRED
 CULVERT REQUIRED (Profile)

COMBUSTIBLE FLUIDS
(UNDER PRESSURE)
 UNDERGROUND UTILITIES
 GAS
 ELECTRIC
 TELEPHONE
 SERVICE PEDESTAL
 CABLE MARKER
 POWER POLE
 TELEPHONE POLE
 RAILROADS
 MARSH
 WOODED AREA

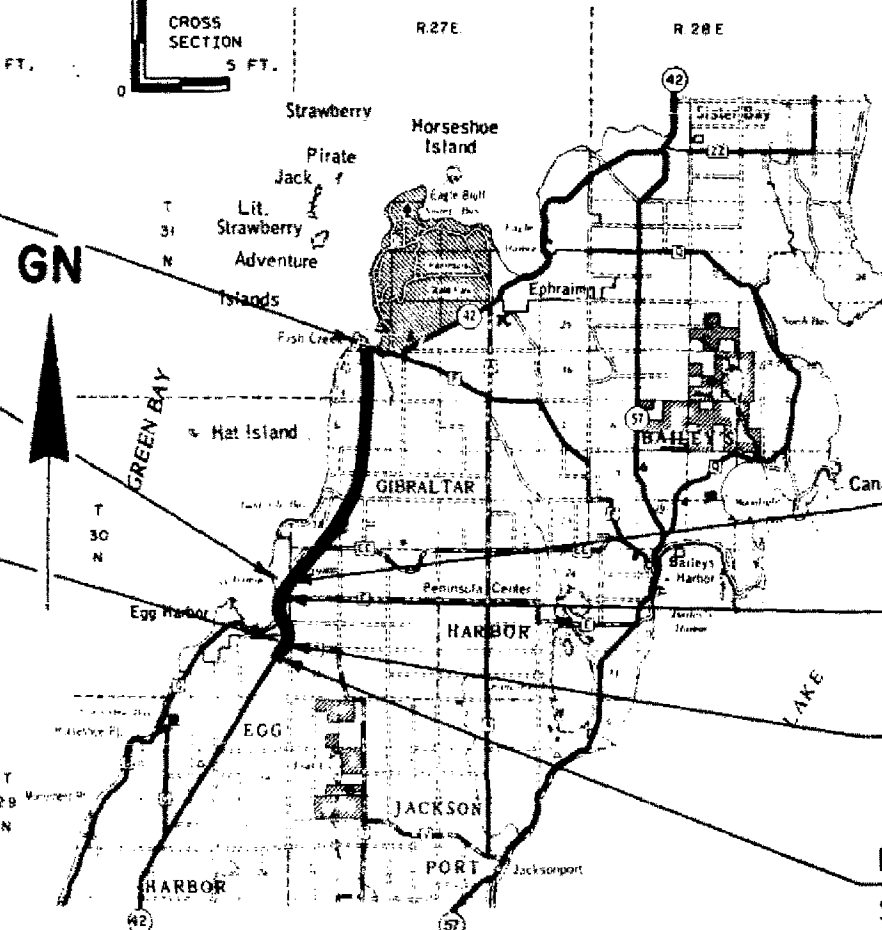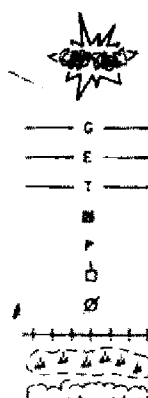

LAYOUT
SCALE 0 2 MI.

NET LENGTH OF CENTERLINE = 1.217 MI. PROJECT 4140-2-71
 NET LENGTH OF CENTERLINE = 5.834 MI. PROJECT 4141-1-72
 TOTAL NET LENGTH OF CENTERLINE = 7.051 MI.

NOTE: ALL COORDINATES SHOWN ON THE PLAN ARE REFERENCED TO THE WISCONSIN COORDINATE SYSTEM CENTRAL ZONE.
 SURVEY BOOK NO.'S 1145, 1146, 1286, & 1287

AS BUILT PLAN

SUPERVISOR DENNIS H. PAULI
 RESIDENT MICHAEL LEITZKE
 CONTRACTOR A.W. DAKES & SON, INC.
 COMPLETED 7-24-89

BEGIN SECTION 2 PROJECT 4141-1-72
 STA. 70+00

STA. 712+97.89 BK. -
 STA. 63+31.17

END SECTION 1 PROJECT 4141-1-72
 STA. 655+41.99

BEGIN PROJECT 4141-1-72
 STA. 647+00
 X = 2,702,884.601
 Y = 450,860.948

STATE OF WISCONSIN DEPARTMENT OF TRANSPORTATION	
Surveyor <u>K.L.T.</u>	District Checker <u>M.P. P.T.L.</u>
Designer <u>J.B.K.</u>	C.O. Plan Examiner <u>lee</u>
District Supervisor <u>B.L.S.</u>	C.O. Coordinator <u>lee</u>
APPROVED:	
DATE: <u>5/6/88</u>	<u>T.R. Clark</u> DISTRICT DIRECTOR
APPROVED:	
DATE: <u>6/1/88</u>	<u>James Smith</u> STATE DESIGN ENGINEER FOR HWYS.
U.S. DEPARTMENT OF TRANSPORTATION FEDERAL HIGHWAY ADMINISTRATION REGION 5 WISCONSIN DIVISION	
APPROVED:	
DATE:	DIVISION ADMINISTRATOR