DT1553 12/2010

APPLICATION / PERMIT

Wisconsin Department of Transportation

TO CONSTRUCT, OPERATE and MAINTAIN UTILITY FACILITIES ON HIGHWAY RIGHT-OF-WAY

s.66.0831, 84.08, 85.15, 86.07(2), 86.16, 182.017 and such other applicable Wis. Stats. 1. Applicant (Utility facility owner) Name and Address 3. Work Finish Date* 6. Location Description (1/4 section, section, town, range; provide plat map or location sketch) Work Start Date proval 5/31/2017 8/31/2017 Charter Communications Located in the NW 1/4 of SEC 24 T21N, R16E 4. Is the work due to a WisDOT highway project? 4125 N 124th St Suite D 🗌 Yes 🛛 No 7. Work Location (Check/list all that apply) Brookfield, WI 53005 5. Applicant Work Order (If any) 8. Highway (Check all that apply) 1462545 Town: <u>Greenville</u> 🖾 WIS 15 9. Facility Type (Check all that apply): Size (Diameter, kV, pressure, # fibers, etc.) 12. Proposed Work Methods (Check all that apply Village: □ Trench □ Plow City: Interstate _____ Telecom: 1 Fiber \boxtimes Casing Casing Electric: Open cut pavement County: Outagamie Gas/Oil: 13. Work Zone Description (Check all that apply) 15. Will any appurtenances be Water: Bore: installed with the facility? Hydraulic (Auger/Jack) Full road closure: detour San Sewer: (If yes, provide a description and/or specification of each Pneumatic (Mole) Full road closure: temporary item with this application.) Directional 1 (Manually tracked) Lane closure: without flagging Transmission Service: Std 🗌 Yes 🛛 No Lane closure: with flagging Directional 2 (Computer tracked) \boxtimes Distribution Service: Exp Unknown (At this time) Lane encroachment (2 feet or less) 16. Trans 401 project designation? Intersection/roundabout (For all Major projects, provide 10. Facility Orientation (Check all that apply) a formal erosion control plan Attach to poles/towers: Shoulder/parking lane closure Creasing DAM M Devellet DAM

Underground Overhead	📙 New 🖂 Existing 📋 Guys**	Off shoulder: within clear zone	<u>09-15-55</u>)
Structure attachment	<u>24-36"</u> WE Energies (Name of existing owner)	In R/W: outside clear zone	🛛 Minor 🔲 Major
11. Work Types (Check all that apply)	(** Provide details for all guy wires on plan sheets)	Near R/W line: within clear zone	
TT. Work Types (Check all that apply)		Near R/W line: outside clear zone	 Are any environmental permits, certifications or
New construction	Subsurface utility excavation:	Not applicable	approvals required from
Improve/repair existing	🗌 Water jetting 🔲 Vacuum	14. Is the proposed facility near a survey monument?	other regulatory agencies? (If yes, provide a copy
Removal	Tree/vegetation control:	(See <u>HMM 09-15-35</u>)	of each item or proof
Maintenance	\Box Cut and/or trim \Box Mow	Yes (Call: 1-866-568-2852 or	of agency coordination with this application.)
Discontinued, left in place	Chemically treat	e-mail: geodetic@dot.wi.gov)	
Joint installation		No	🗌 Yes 🖾 No

* NOTE: If the work described is not completed by the "Work Finish Date" specified, this permit is null and void, and the work shall not be completed unless authorized through a subsequent permit or an approved time extension. ANY PERMIT ISSUED IS REVOCABLE.

18. Utility Person Responsible for Construction	(Area Code) Telephone Number	19. Utility or Project 24/7 Emergency Contact	(Area Code) Telephone Number
Steve Cramer	(414) 277-4045		800-644-8328
20. Is the utility a member of Diggers Hotline?		It is understood and agreed that approva	al is subject to applicant's
Yes Do, provide line-locate numb	er	full compliance with the pertinent statute regulations of other jurisdictional agenc	
21. Provide additional project work details, if needed (Continue o	n back or include separate page)	restrictive, and with the Wisconsin Depa Utility Accommodation Policy (UAP), cur http://www.dot.wisconsin.gov/business/rule	artment of Transportation's rrent edition.
		Randy Wolfgram	5/27/2017
22. If not employed by applicant, authorized representative's com	pany name and address	Raudy Wolfgram (Signature of Authorized Representative – If filled via com	
22. If not employed by applicant, authorized representative's con KENDRA SANDBERG	pany name and address	, ,,	
	pany name and address	(Signature of Authorized Representative – If filled via com	

This permit does not transfer any land; nor give, grant or convey any land right, right in land, nor easement in WisDOT right-of-way. It is not assignable or transferrable. If ownership in a utility facility changes, WisDOT may void and supersede a permit and reissue it to the new owner upon request and with sufficient proof of ownership.

🕴 For Wisconsin DOT Use Only 🕴						
THE UTILITY SHALL NOTIFY WisDOT	X REVIEW ALL SUPPLEMENTAL PERMIT PROVISIONS	Date Application Received				
3 DAYS BEFORE STARTING WORK AT:	X REVISIONS MADE to DRAWINGS or OTHER PAGES	5/30/2017				
Region contact, title, office address, telephone number, and e-mail address	X Lane Closure System notification required: <u>HMM 09-15-60</u>	Date Application Completed				
	Insurance or performance bond required	Data Application Danied				
	Joint installation: See permit(s) #	Date Application Denied				
	Private utility (Non-public ownership and/or use)	Permit Issuance Date				
	Expedited Service Connection Permit	6/7/2017				
	This permit voids & supersedes # issued:	Permit Extension Date				
		Permit Number				
		2017167				

(WisDOT Authorized Representative Signature - If filled via computer, Brush Script font)

INDEMNIFICATION

This Applicant shall save and hold the State, its officers, employees, agents, and all private and governmental contractors and subcontractors with the State under Chapter 84 Wisconsin Statutes, harmless from actions of any nature whatsoever (including any by Applicant itself) which arise out of, or are connected with, or are claimed to arise out of or be connected with any of the work done by the Applicant, or the construction or maintenance of facilities by the Applicant, pursuant to this permit or any other permit issued by the State for location of property, lines or facilities on highway right-of-way, (1) while the Applicant is performing its work, or (2) while any of the Applicant's property, equipment, or personnel, are in or about such place or the vicinity thereof, or (3) while any property constructed, placed or operated by or on behalf of Applicant remains on the State's property or right-of-way pursuant to this permit or any other permit issued by the State for location of property, lines or facilities on highway right-of-way; including without limiting the generality of the foregoing, all liability, damages, loss expense, claims, demands and actions on account of personal injury, death or property loss to the State, its officers, employees, agents, contractors, subcontractors or frequenters; to the Applicant, its employees, agents, contractors, subcontractors, or frequenters; or to any other persons, whether based upon, or claimed to be based upon, statutory (including, without limiting the generality of the foregoing, worker's compensation), contractual, tort, or whether or not caused or claimed to have been caused by active or inactive negligence or other breach of duty by the State, its officers, employees, agents, contractors, subcontractors or frequenters; Applicant, its employees, agents, contractors, subcontractors or frequenters; or any other person. Without limiting the generality of the foregoing, the liability, damage, loss, expense, claims, demands and actions indemnified against shall include all liability, damage, loss, expense, claims, demands and actions for damage to any property, lines or facilities placed by or on behalf of the Applicant pursuant to this permit or any other permit issued by the State for location of property, lines or facilities on highway right-of-way in the past or present, or that are located on any highway or State property or right-of-way with or without a permit issued by the State, for any loss of data, information, or material; for trademark, copyright or patent infringement; for unfair competition or infringement of personal or property rights of any kind whatever. The Applicant shall at its own expense investigate all such claims and demands, attend to their settlement or other disposition, defend all actions based thereon and pay all charges of attorneys and all other costs and expenses of any kind arising from any such liability, damage, loss, claims, demands and actions.

Any transfer, whether voluntary or involuntary, of ownership or control of any property constructed, placed or operated by or on behalf of the Applicant that remains on the State's property or right-of-way pursuant to this permit shall not release Applicant from any of the indemnification requirements of this permit, unless the State is notified of such transfer in writing. Any acceptance by any other person or entity, whether voluntary or involuntary, of ownership or control of any property constructed, placed or operated by or on behalf of the Applicant that remains on the State's property or right-of-way pursuant to this permit, shall include acceptance of all of the indemnification requirements of this permit by the other person or entity receiving ownership or control.

Notwithstanding the foregoing, a private contractor or subcontractor with the State under Chapter 84 Wisconsin Statutes, that fails to comply with sections 66.0831 and 182.0175 Wisconsin Statutes (2007-2008), remains subject to the payment to the Applicant of the actual cost of repair of intentional or negligent damage by the contractor or subcontractor to any property, lines or facilities placed by or on behalf of the Applicant pursuant to this permit or any other permit issued by the State for location of property, lines or facilities on highway right-of-way, and remains subject to payment to the Applicant for losses due to personal injury or death resulting from negligence by the contractor or subcontractor.

Notwithstanding the foregoing, if the State, or its officers, employees and agents, fail to comply with sections 66.0831 and 182.0175 Wisconsin Statutes (2007-2008), the State or its officers, employees and agents, remain subject to the payment to the Applicant of the actual cost of repair of willful and intentional damage by the State, or its officers, employees and agents, to any property, lines or facilities placed by or on behalf of the Applicant pursuant to this permit or any other permit issued by the State for location of property, lines or facilities on highway right-of-way, and remain subject to payment to the Applicant for losses due to personal injury or death resulting from negligence by the State, its officers, employees and agents.

No indemnification of private contractors or subcontractors with the State under Chapter 84 Wisconsin Statutes, shall apply in the event of willful and intentional damage by such private contractors or subcontractors to the property, lines and facilities of the Applicant located on the highway right-of-way pursuant to this permit or any other permit issued by the State for the location of property, lines or facilities on highway right-of-way.



STANDARD SUPPLEMENTAL PERMIT

For Wisconsin Department of Transportation Utility Facility Permits

Acronyms used in this document:

- BMPs: Best Management Practices
- R/W: Right-of-Way
- UAP: Utility Accommodation Policy
- HMM: Highway Maintenance
 Manual
- WisDOT: Wisconsin Department of Transportation

1. GENERAL WORK REQUIREMENTS

- As required by Wisconsin Statute 182.0175, when filing your Diggers Hotline request ensure that this WisDOT Permit Number is in the Remarks Section of the Diggers Hotline Ticket.
- The Permittee shall bore under all driveways, private entrances, wetlands, culverts, and all roadways.
- The Permittee is responsible for obtaining any permits from the Department of Natural Resources, or any other agency that may have an interest in the area impacted by the construction of the utility facility.
- 2. WORK DUE TO A WISDOT HIGHWAY PROJECT. This approved permit constitutes acceptance that the work in this permit is compatible with permit requirements. This approved permit is NOT a Work Plan Approval/Start Work Notice as required by Trans 200.05(07). This approved permit is NOT a Work Plan Approval/Start Work Notice for a non-Trans 220 project. This approved permit does NOT approve or authorize an agreement between WisDOT and the Permittee for compensable work due to a WisDOT highway project.
- 3. **PERMIT TERM.** For as long as the Permittee continues to own, operate and maintain this utility facility within WisDOT R/W in accordance with the terms of its permit and WisDOT's *UAP*, this permit shall be valid.
- 4. REVOCATION BY WISDOT. WisDOT may revoke this permit if its own use of the R/W would be facilitated by the full or partial relocation of the Permittee utility facility, and shall provide the Permittee with written notice prior to revocation. At which time WisDOT shall work with the Permittee to find a suitable replacement area on R/W near the terminated location if possible. WisDOT shall not compensate the Permittee to move its utility facility in keeping with WisDOT's policy on compensable / non-compensable utility facility moves.
- 5. **TERMINATION BY PERMITTEE.** The Permittee may terminate this permit upon 60 days written notice to WisDOT. Upon such termination, the Permittee shall either remove its communication cable facility from the R/W, or abandon it in-place provided it does not constitute an environmental hazard.
- 6 **HOLIDAY WORK RESTRICTIONS for 2017.** The Permittee shall not work on January 1, May 29, July 4, September 4, and November 23, and December 25.
- 7. **WORK-TIME RESTRICTIONS.** Weekday work is from sunrise to sunset. Weekend work may be allowed upon prior approval from WisDOT. No work shall take place during nighttime hours unless authorized by WisDOT.
- 8. **TRAFFIC CONTROL.** All work zone traffic control will be in accordance with the Wisconsin Manual on Uniform Traffic Control Devices. Additional guidance is available from WisDOT through a booklet entitled, *Work Zone Safety, Guidelines for Construction, Maintenance, and Utility Operations* or from *HMM 09-15-60*.
- 9. WORK AREA PROTECTION DURING NON-WORK TIMES. The Permittee may store vehicles, equipment, or materials on the non-freeway R/W provided they are placed as close to the non-freeway R/W line as possible, but no less than 30 feet from the edge of the nearest travel lane. If vehicles, equipment, or materials must be parked or stored within an area that is less than 30 feet from the edge of the nearest travel lanes, appropriate temporary concrete or water-filled barriers, signing, and devices shall be utilized. The Permittee shall ensure that any excavations left open during non-work times are well marked and secured from public intrusion.

The primary objective will be maintenance of a safe traffic and working environment. No operation shall to any extent pose any hazard neither to, nor in any manner influence traffic at any time.

All vehicles used to conduct the work operations will be equipped with conspicuously visible roof-mounted revolving or strobe lights. These lights shall be in operation just prior to and during the time the work operations are being conducted. Hazard warning lights on the vehicles must also be operating.

10. **WORK RESTRICTIONS.** For the purposes of placement of these facilities, as stated with this permit request, the State security fence shall not be opened or damaged.

11. **CLEAR ZONE / DRAINAGE INTERFERENCE.** No topsoil or other excavated piles of soil shall be deposited in any manner that interferes with the clear zone or regular drainage patterns within the highway.

As much as possible, all equipment, operations, and spoil material should be situated or accomplished off of the highway.

12. **EROSION CONTROL.** The Permittee shall use the appropriate erosion control BMPs to contain soil directly at the site to prevent disturbed soil from getting into nearby waterways and wetlands. All appropriate erosion control devices shall be in place **prior to starting construction activities**. Temporary seeding shall be used as necessary after rough grading and before completion of the project. The Permittee shall ensure that erosion control BMPs used to protect restored areas remain in place until replacement vegetation achieves sustained growth.

The Permittee shall take all precautions necessary to prevent mud, dirt, or other debris from being deposited onto the shoulder or pavement of all access roads or highways. Any materials deposited on the shoulder or pavement shall be removed immediately. Ruts may remain as is if the Permittee is accessing the R/W from private property, but appropriate erosion control BMPs shall be used to contain disturbed soil at the site.

13. **R/W RESTORATION.** Upon completion of the project a variation of erosion control measures will be required to restore the area that has been disturbed allowing it to return to the manner it was in previous to the construction. All disturbed sites will require a seed mixture that includes a quick sprouting variety with fertilizer and mulch. Other possibilities that may have to be considered are Geotextile fabric, e-mat, and stone ditch checks.

The Permittee is responsible to assure that erosion control measures used to protect restored areas remain in place until replacement vegetation achieves sustained growth.

The basic drainage pattern of the highway shall remain undisturbed by the permitted work. Upon project completion, all spoils, debris, refuse, and waste resulting from the permitted work shall be removed from the work site. Should future maintenance work on the Permittee's utility facility result in the disturbance of the existing R/W, the Permittee shall restore the R/W to its original condition as soon as possible.

Any works or operations not in full compliance herewith shall justify an order by any inspecting officer of WisDOT to cease all further progress on the work, and to accomplish all restorations of disturbed areas, including full restorations of the pavement


Upon completion of the work, all disturbed areas shall be restored according to requirements stated in the Utility Accommodation Policy, HMM 09-15-65, and in a manner satisfactory to WisDOT

- 14. **NOTIFICATIONS / CONTACTS.** Notify Northeast Region permit coordinator/field inspector, by phone or email, three days prior to the start of construction. Notify Diggers' Hotline 800/242-8511 at least three working days prior to the start of any excavation. It is the obligation of the permittee to determine the location of, and avoid any damage to, the pre-existing lines and facilities of others.
- 15. **TREES.** Prevent the spread of oak wilt by treating all cut surfaces and abrasions sustained between April 1 and September 30 by healthy oak trees and saplings with a thorough application of tree paint immediately upon discovering a wound. Between these dates, also paint the cut surfaces of the stumps of all healthy oak trees and saplings immediately after cutting, whether remaining in place or grubbed.

This permit approves the installation of facilities as shown on the diagram provided. If the above assigned position is not feasible, an alternate location of facilities shall be approved prior to installing the facilities by contacting the permit coordinator approving the permit. If the facility is later discovered to be at a location other than that designated by the permit you may be required to relocate the facility at your expense.

This permit is subject to the attached drawings, these supplemental provisions, and WisDOT's Utility Accommodation Policy. New supplemental provisions may be added, or the existing ones deleted or amended in the future as different issues arise during the installation, operation and maintenance of the permittee's facilities.

Google Maps

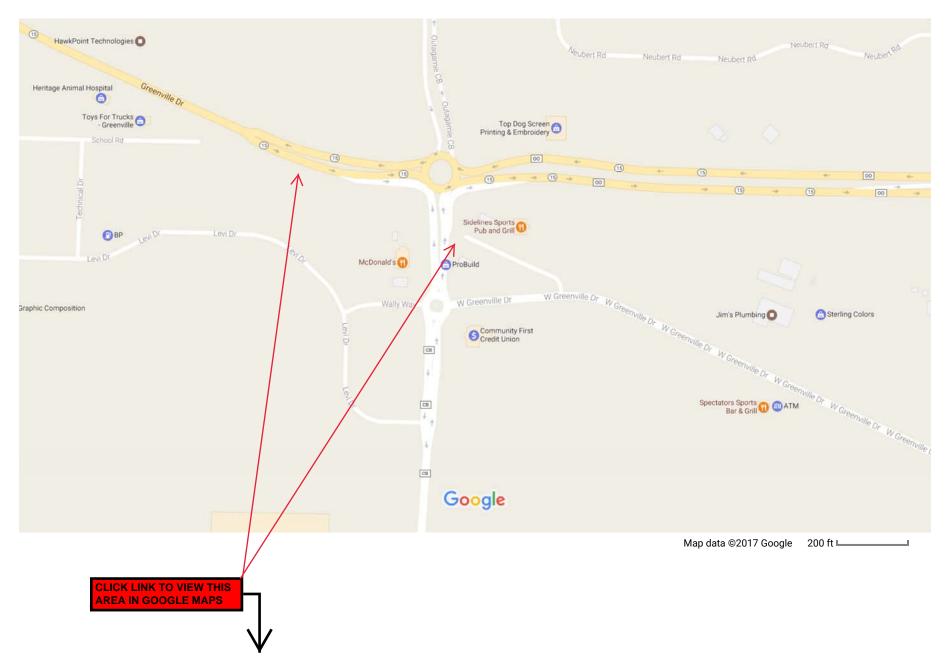

Work description Charter Communications #1462545, 6308 Greenville Dr Greenville, WI

Charter Communications proposes to over lash 1935' east to along the south side of W Northland Ave.

CHARTER COMMUNICATIONS FIBER AERIAL CABLE



Mİ-TECH	 S JOINT POLE NEW JOINT POLE POWER POLE NEW POWER POLE TELEPHONE POLE NEW TELEPHONE POLE EXISTING PEDESTAL NEW PEDESTAL 	LEG ANCHOR ANCHOR NEW ANCHOR JOINT ANCHOR JOINT ANCHOR FOREIGN ANCHOR DOWNGUY NEW DOWNGUY NEW DOWNGUY NEW DOWNGUY NEW DOWNGUY NEW DOWNGUY NEW DOWNGUY	MANHOLE 1007 EXISTING FIBER COIL 1007 NEW FIBER COIL EXISTING HAND HOLE NEW HAND HOLE SHRUBS	GROUND NEW GROUND PL PROPERTY LINE QL ROADWAY CENTERLINE FIBER WARNING SIGN HD TRAFFIC LIGHT HYDRANT SIGNS STREET LIGHT CONJECEDUIS THEE	LINETYPES PROPOSED FFFFF PROPOSED STRAND GAS GAS WATER WATER ELECTRICAL C STO STOT STOT SANITARY CABLE TV CATV CATV TELEPHONE TEL TEL TEL TEL TEL TEL TEL TEL	PROJECT # 1462545 PERMIT I.D. # 1462545STATE	N
		UTILITY VALVE	DECIDUOUS TREE	M CONIFEROUS TREE		AITLETON, WI 54515	

	ADDRESS		LOCATION	
	6308 GREEN	VILLE DR	GREENVI	LLE, WI
	FIELDED BY:	DATE:		
	DRAFTED BY:	DATE:		
	KIS	5/24/2017		
ĺ	DESIGNED BY:	DATE:		
	ASBUILTS BY:	DATE:		

EROSION/WETLAND CONTROL NOTES

(NOTES 1-6 APPLIES TO ALL WORK) (NOTES SHOWN ON DRAWING PLACED WITH A BOX AROUND THEM)

GENERAL NOTES:

- 1. ALL OF THE PERMIT CONDITIONS WILL BE MET DURING CONSTRUCTION OF THE PROJECT
- 2. NO STOCKPILING SPOILS ON ROADWAYS OR ON SHOULDER
- 3. IF ANY SPILLS(EX. GAS, OIL, HYDRAULIC FLUID) OCCUR ON SITE, STOP WORK AND CONTACT SUPERVISOR IMMEDIATELY

CONTAMINATED SOILS:

4. WHENEVER SOIL EXHIBITING OBVIOUS SIGNS OF CONTAMINATION IS ENCOUNTERED DURING EXCAVATION OR INSTALLATION, CEASE WORK IMMEDIATELY, TAKE APPROPRIATE IMMEDIATE PRECAUTIONS TO ENSURE WORKER HEALTH AND SAFETY, AND CONTACT OPERATIONS SUPERVISOR OR INSPECTOR.

EROSION CONTROL & DEWATERING:

- 5. EROSION CONTROL MEASURES WILL MEET OR EXCEED THE APPROVED WONR STORM WATER MANAGEMENT TECHNICAL STANDARDS AS OUTLINED IN : HTTP://DNR.WI.GOV/RUNOFF/STORMWATER/TECHSTDS.HTM.
- 6. DURING WINTER NO STOCKPLILING SPOILS ON GROUND

DEWATERING:

7. DEWATERING OF PITS OR TRENCHES SHALL BE DONE IN ACCORDANCE WITH STATE STANDARDS. USE AN APPROVED SEDIMENT BAG, A STRAW BALE DEWATERING BASIN, A COMBINATION OF BOTH, OR EQUIVALENT

WETLANDS:

- 8. NO WORK WILL BE PERFORMED WITHIN THE BANKS OR BELOW THE ORDINARY HIGH WATERMARK OF THE UNNAMED WATERWAY OR TRIBUTARIES
- 9. AS MUCH AS PRACTICABLE, THE MAJORITY OF WORK WILL BE STAGED FROM THE PUBLIC ROADWAYS AND ROAD SHOULDERS, KEEPING EQUIPMENT OUT OF ADJACENT WETLANDS 10. ALL WORK WILL BE CONDUCTED TO MINIMIZE SOIL DISTURBANCE. NO RUTTING WILL BE ALLOWED WITHIN THE WETLANDS
- 11. IF SOILS ARE NOT FROZEN OR STABLE TO A POINT THAT AVOIDS RUTTING, TIMBER MATS, MUD TRACKS, OR EQUIVALENT WILL BE UTILIZED TO ACCESS POLE LOCATIONS 12. EXCAVATED SPOILS WILL NOT BE STOCKPILED IN WETLANDS
- 13. ALL EXCESS SPOILS WILL BE REMOVED FROM WETLANDS AND PLACED IN A SUITABLE UPLAND LOCATION
- 14. TRENCHING AND PIT EXCAVATIONS WITHIN WETLANDS WILL INCLUDED SOIL SEGREGATION TO FACILITATE RESTORATION OF PRE-CONSTRUCTION SOIL STRATIFICATION, AND RESTORATION TO PRE-CONSTRUCTION ELEVATIONS.
- 15. ANY POLES SCHEDULED TO BE REMOVED, AND THAT OCCUR WITHIN WETLAND WILL BE CUT AT GROUND SURFACE
- 16. IF SOIL DISTURBANCE OCCURS ON SLOPES LEADING TO WETLANDS, OR WITHIN WETLAND, THE DISTURBED AREAS WILL BE STABILIZED AND APPROPRIATE EROSION CONTROL BEST MANAGEMENT PRACTICES WILL BE IMPLEMENTED

WATERWAYS:


- 17. NO WORK CAN BE PERFORMED WITHIN THE BANKS OR BELOW THE ORDINARY HIGH WATERMARK OF ANY NAVIGABLE WATERWAY OR STREAM
- 18. NO CROSSING OF NAVIGABLE WATERWAYS WITH EQUIPMENT CAN OCCUR.
- 19. ANY SOIL BEING DISTURBED WITHIN 75 FEET OF AN ORDINARY HIGH WATER MARK OF ANY NAVIGABLE WATERWAY OR STREAM TO BE STABILIZED WITHIN 24 HOURS OF CONSTRUCTION COMPLETION

FRAC-OUT CONTINGENCY PLAN

20. PLEASE SEE FRAC-OUT CONTINGENCY PLAN FOR ANY BORING BEING PERFORMED




ADDRESS		LOCATION		
6308 GREENVILLE DR		GREENVILLE, WI		
FIELDED BY:	DATE:			
		_		
DRAFTED BY:	DATE:			
KIS	5/24/2017			
DESIGNED BY:	DATE:		3	
ASBUILTS BY:	DATE:			

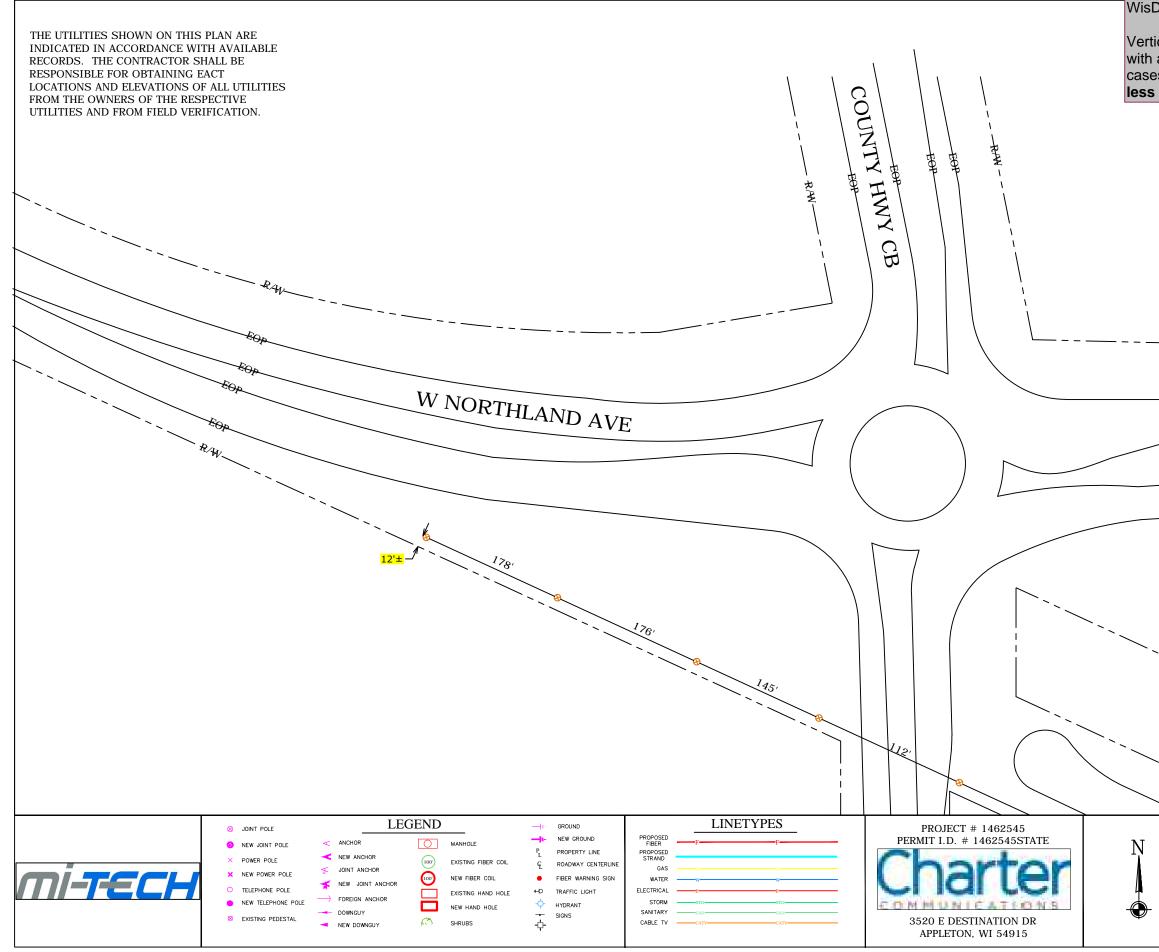

WisDOT Note:

all appl s, facili	icable state ties crossing	and nationa g over the h	al electrical c ighway shall	shall comply odes. In all at no time be traveled way.
			– – R/W – –	
			EOP	
			EOP	
			EOP	
			EOP	
_			-	
			-R∕₩	
``\				
``\	_			
	``\			
	ADDRESS			
	6308 GREEN		GREEN	VILLE, WI
	FIELDED BY:	DATE:		
	DRAFTED BY: KIS	DATE: 5/24/2017		
	DESIGNED BY:	DATE:		4
	ASBUILTS BY:	DATE:		
				http://www.com/com/com/com/com/com/com/com/com/com/

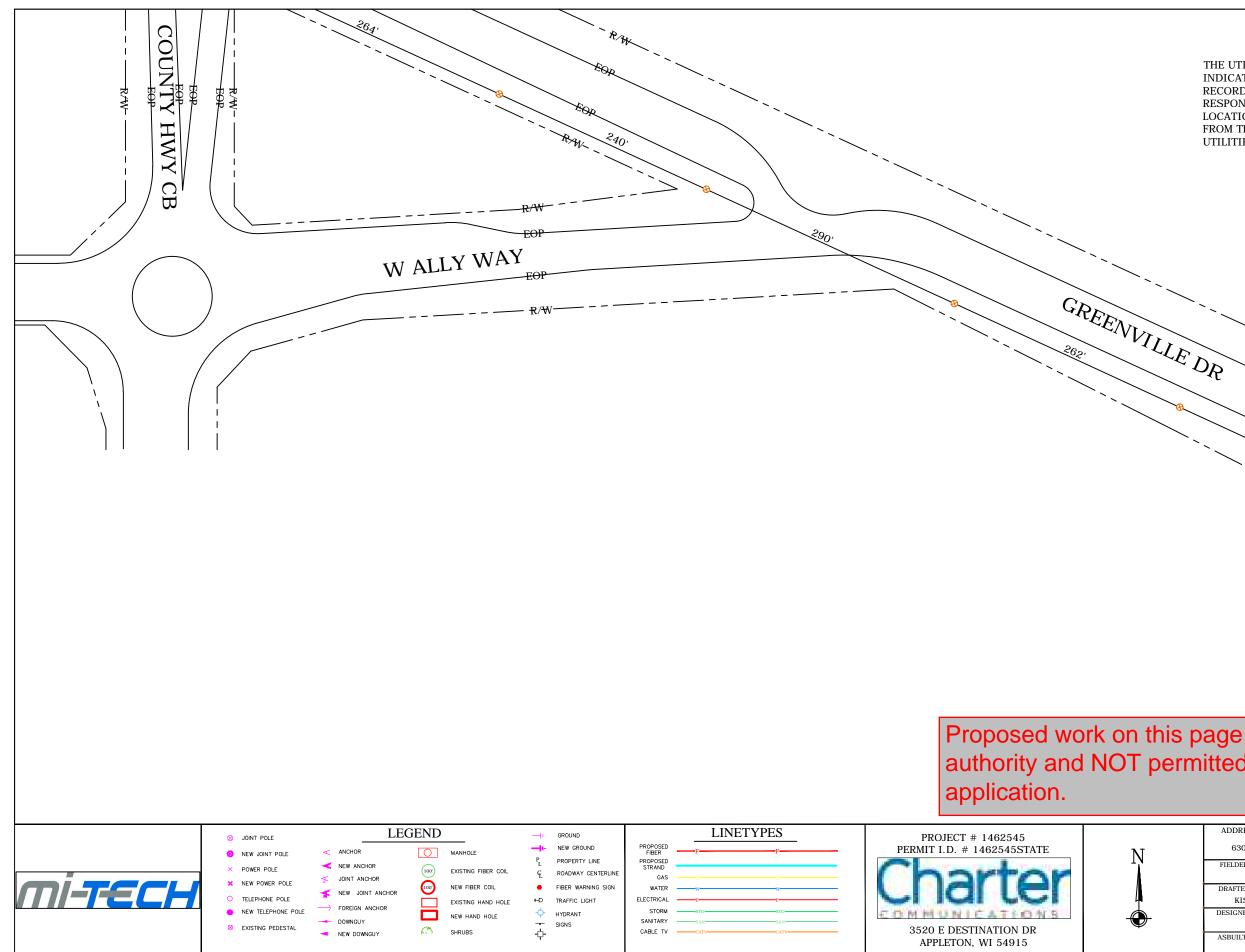



THE UTILITIES SHOWN ON THIS PLAN ARE INDICATED IN ACCORDANCE WITH AVAILABLE RECORDS. THE CONTRACTOR SHALL BE RESPONSIBLE FOR OBTAINING EACT LOCATIONS AND ELEVATIONS OF ALL UTILITIES FROM THE OWNERS OF THE RESPECTIVE UTILITIES AND FROM FIELD VERIFICATION.

Proposed work on this page is not within WisDOT authority and NOT permitted under this permit

ADDRESS		LOCATION		
6308 GREENVILLE DR		GREENVILLE, WI		,
FIELDED BY:	DATE:			
DRAFTED BY:	DATE:			
KIS	5/24/2017			E
DESIGNED BY:	DATE:		5	
ASBUILTS BY:	DATE:			



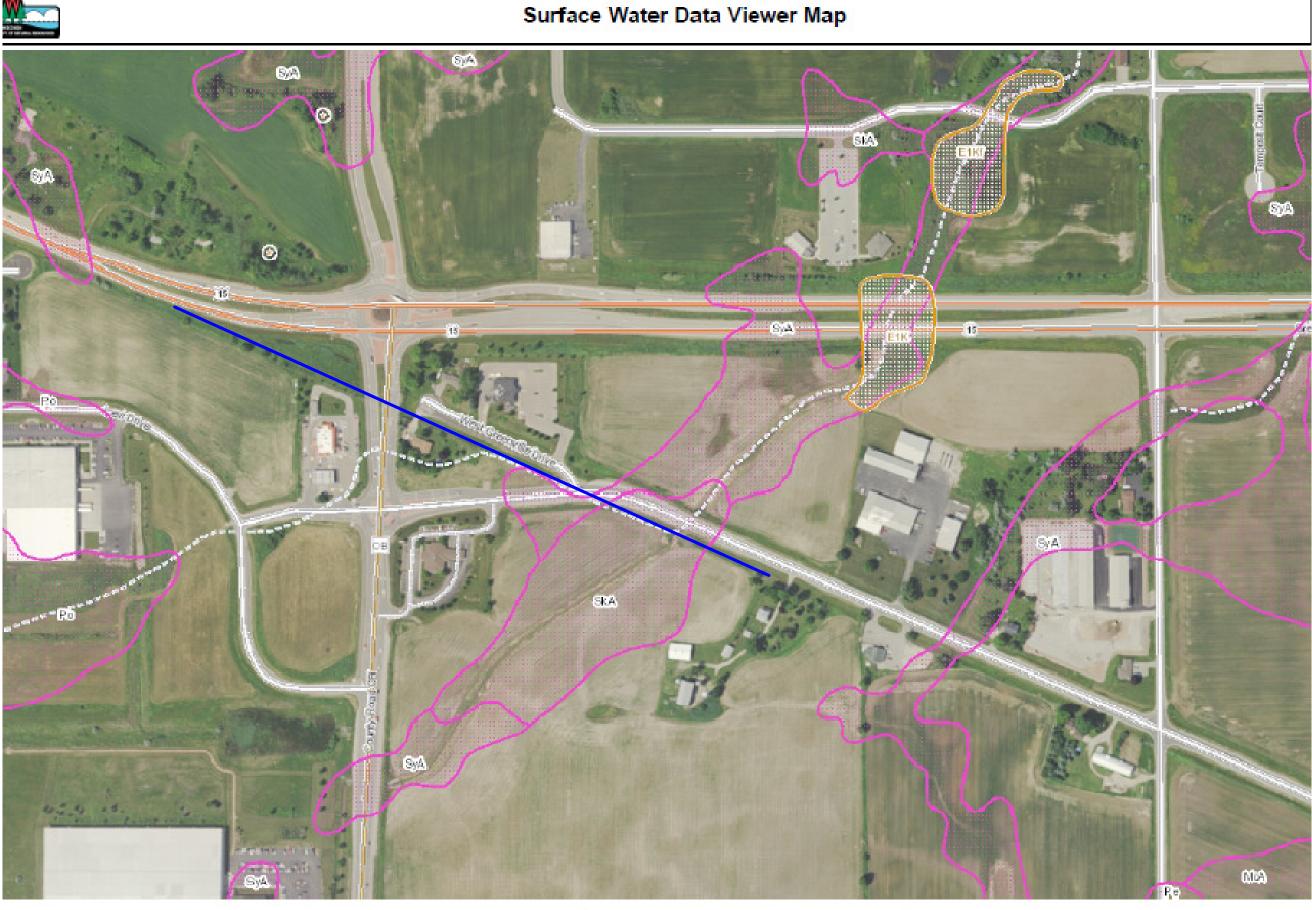

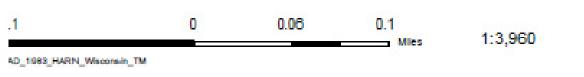

DISOLAIMER: The information shown on these maps has been obtained from various sources, and are of varying sos, reliability and resolution. These maps are not interned to be used for navigation, nor are these maps an authoritative source of information about legal land ownership or public access. No wemany, argoreses do implied, is made magsrding accursor, septicability for a particular use, completeness, or legality of the information depicted on this map. For more information, see the DNR Legal Notices: web page: http://dnr.wl.gov/legal/

Notes




Legend


	Wetland Class Points
	A Demmed poind
	Excevated pond
	Filled excavated pond
	A Filedidalited weband
	• Wetland too small to delineate
4	Filled Points
	Wetland Class Areas
	Wetland
	Upland
Z	Filled Areas
_	NRCS Wetspots
88	Wetland Indicators
	Municipality
	State Boundaries
	County Boundaries
	Major Roadis
	Intendate Highway
	- State Highway
	us Highway
	County and Local Roads
	- County HTWY
	Local Road
-+	Railroads
N.	Tribal Lands
	Rivers and Streams
	Internitient Streams
	Lakes and Open water

CHARTER COMMUNICATIONS FIBER AERIAL CABLE

THESE TRAFFIC CONTROLS MEASURES WILL BE USED WHERE INDICATED WITHIN THE JOB SKETCH

-IF UPON CONSTRUCTION FURTHER TRAFFIC CONTROL IS NECESSARY REFER TO WISCONSIN DEPARTMENT OF TRANSPORTATIONS WORK ZONE SAFETY POCKET GUIDELINES FOR CONSTRUCTION, MAINTENANCE, & UTILITY OPERATIONS

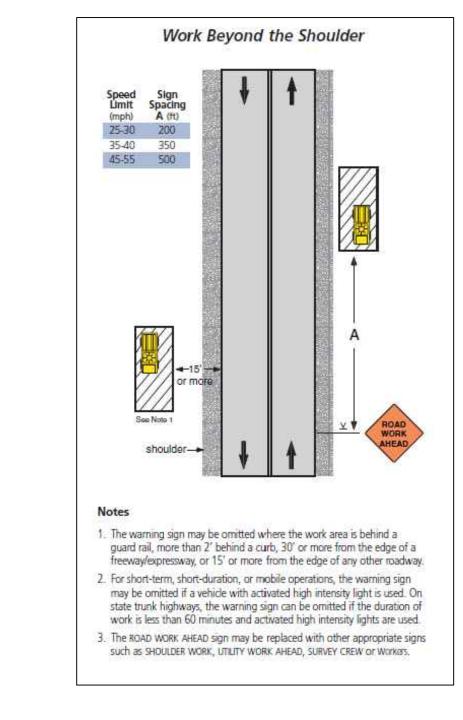

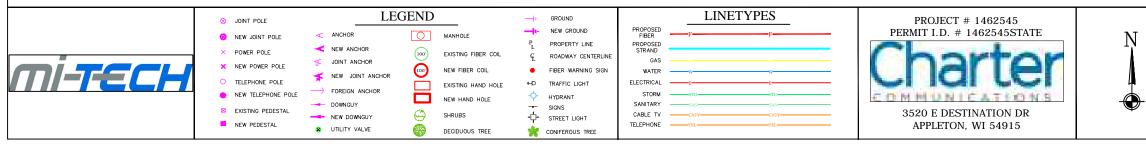

	ADDRESS 6308 GREENVILLE DR		GREENVILLE, WI		
	FIELDED BY:	DATE:			
	DRAFTED BY:	DATE:			
	KIS	5/24/2017			5
Ì	DESIGNED BY:	DATE:		2	
	ASBUILTS BY:	DATE:			