

NO CHANGES

INDEX OF SHEETS

Sheet No.	Title
Sheet No. 1	Details
Sheet No. 2.1-2.4	Estimate of Quantities
Sheet No. 3.1	Miscellaneous Quantities
Sheet No. 3.A	Right of Way Plat
Sheet No. -	Plan Sheets
Sheet No. 5.1 - 5.7	Standard Detail Drawings
Sheet No. -	Computer Earthwork Data
Sheet No. -	Cross Sections

TOTAL SHEETS = 14



DESIGN DESIGNATION

A.D.T.	=
A.D.T.	=
D.H.V.	=
D.	=
T.	=
V.	=
ESALS	=

CONVENTIONAL SIGNS

COUNTY LINE	---	COMBUSTIBLE FLUIDS (UNDER PRESSURE)	☠
CORPORATE LIMITS	////	UNDERGROUND UTILITIES	
PROPERTY LINE	---	GAS	G
LOT LINE	---	ELECTRIC	E
LIMITED EASEMENT	---	TELEPHONE	T
EXISTING RIGHT OF WAY	---	SERVICE PEDESTAL	☐
NEW RIGHT OF WAY	---	CABLE MARKER	☐
REFERENCE LINE	---	POWER POLE	☐
SLOPE INTERCEPT	---	TELEPHONE POLE	☐
ORIGINAL GROUND	---	RAILROADS	+
MARSH OR ROCK PROFILE	---	MARSH	~
CULVERT IN PLACE	---	WOODED AREA	+
CULVERT REQUIRED	---		
CULVERT REQUIRED (Profile)	---		

STATE OF WISCONSIN
DEPARTMENT OF TRANSPORTATION

PLAN OF PROPOSED IMPROVEMENT


MILWAUKEE - GREEN BAY ROAD

STH 96 - CTH MM

IH 43

BROWN COUNTY

STATE PROJECT NUMBER
1000-01-81

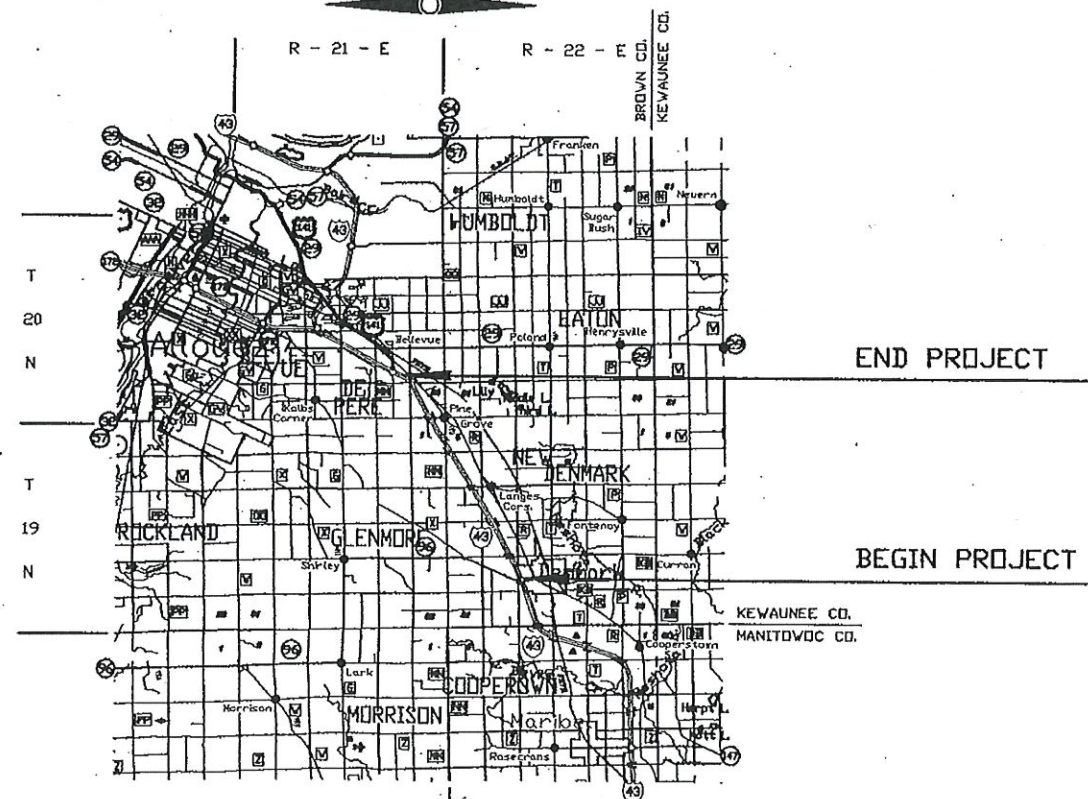

TOTAL NET LENGTH OF CENTERLINE = 0.0 MI.

STATE PROJECT	FEDERAL PROJECT	
	PROJECT	CONTRACT
1000-01-81	STP 2000 (545)	1

1916

No Changes
AS BUILT PLAN
NO.

SUPERVISOR Jill Michaelson
RESIDENT Mike Schmeltzer (Schmeltzer Design)
CONTRACTOR Williams Landscaping
COMPLETED 11-15-03

ORIGINAL PLANS PREPARED BY
Schmeltzer Design, Inc.
Landscape Planning/Consulting and Design
130 Cedar Drive
Oregon, Wisconsin 53575



STATE OF WISCONSIN
DEPARTMENT OF TRANSPORTATION

PREPARED BY
Surveyor
Designer SCHMELTZER DESIGN, INC.
District Examiner L.J. RINGBLOM
District Supervisor J.E. Michaelson
C.I. Coordinator
C.I. Examiner G. BUDANOWSKI

APPROVED FOR DISTRICT OFFICE
DATE 12/21/00 Jill Michaelson
(Signature)

AUTHORIZED FOR CENTRAL OFFICE DESIGN
DATE 4/23/01 John R. Klein
(Signature)

UTILITIES

DIGGER'S HOTLINE 1-800-242-8511 (TOLL FREE)

AMERITECH
JDE SYLVESTRE
205 SOUTH JEFFERSON STREET
PO BOX 10
GREEN BAY WI 54305-5010
920 433-4147
TELEPHONE

ANR PIPELINE CO
WILLIAM LAEHN
2717 N GRANDVIEW BLVD SUITE 300
PO BOX 149
WAUKESHA WI 53187
(414-547-5528)
GAS

AT&T
PAUL LUECK
1231 WEST SPENCER STREET
APPLETON WI 54904
414-521-7788, CELL 920-428-6551
COMMUNICATION FACILITIES

CENTURYTEL
RIE FAWBUSH
212 CHURCH AVENUE
PO BOX 126
CASCO WI 54205
(920-837-2789)
TELEPHONE

CITY OF DEPERE ENGINEER
LEE SCHLEY
925 SOUTH SIXTH STREET
DEPERE WI 54115
920-339-4060
SEWER

GTE NORTH
RICHARD DUCKETT
107 PLEASANTVIEW DRIVE
PLYMOUTH WI 53073
920-893-7434/893-7464
TELEPHONE

MCLEOD USA TELECOM INC.
WILLIAM H. SMALLEY DSP ENGINEER
3600 109TH STREET
URBANDALE IA 50322
1-888-404-6779
RON BERGMANN 515-251-3513 DR 1-800-289-1901
COMMUNICATION FACILITIES

QWEST
GENE BLEUEL
516A FIRST STREET
HARTFORD WI 53027
414-670-6472, Cell 920-960-6003
PAGER 888-714-3717
QWEST NETWORK CONSTRUCTION SERVICES
DENVER CO
303-445-7066
FIBER OPTIC

TOWN OF BELLEVUE/BELLEVUE SANITARY DISTRICT
JOSEPH R PIUMBRECK
PUBLIC WORKS SUPERVISOR
2828 ALLOUEZ AVENUE
GREEN BAY WI 54311
(920-468-5225)(FAX - 920-468-4196)
WATER AND SEWER

VILLAGE OF DENMARK
DAVID LARSEN
302 W. PINE STREET
DENMARK WI 54208
920-863-5169
WATER AND SEWER

WEPCO ELECTRIC OPERATIONS
MIKE JAMES
231 W MICHIGAN A440
MILWAUKEE WI 53201
414-221-2719
ELECTRIC

VISCONSIN PUBLIC SERVICE
MICHAEL CERKAS
700 NORTH ADAMS STREET
PO BOX 19001
GREEN BAY WI 54307-9001
920-433-4942 FAX 920-433-1360
ELECTRIC AND GAS

GENERAL NOTES

THE LOCATIONS OF EXISTING AND PROPOSED UTILITY FACILITIES
AS SHOWN ON THE PLAN ARE APPROXIMATE. THERE MAY BE OTHER
UTILITY FACILITIES WITHIN THE PROJECT AREA THAT ARE NOT SHOWN.

STATE PROJECT NUMBER: 1000-01-81

HWY: IH 43 - GREEN BAY

COUNTY: BROWN AND MANITOWOC

SCALE, FEET

SHEET NO: 2.1

E

FILE NAME: 201.DWG

PLOT DATE:

3-AUG-2000

DRG DATE:



PLOT NAME:

Originator:

PLOT SCALE: \$\$\$plotscale\$\$\$

WISDOT/CADD SHEET 42

PLANT BED DETAILS

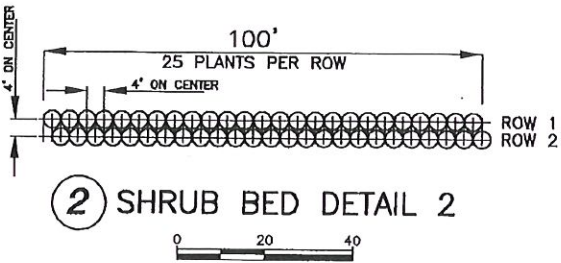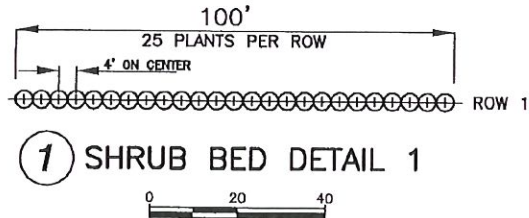

GENERAL


MULCH LIMITS - MULCH LIMITS ARE TO EXTEND BEYOND THE OTHER PLANTS A DISTANCE EQUAL TO OR GREATER THAN THE PLANT SPACING
BASE LINE - IF A BASE LINE IS SHOWN, AT LEAST THE FIRST ROW OF PLANTS SHALL FOLLOW THE LINE.

RANDOM PLANTS - INDIVIDUALLY LOCATED PLANTS WHICH FALL WITHIN THE PLANT BED LIMITS SHALL BE PLANTED IN THE PRESCRIBED MANNER FOR THE PLANT SPECIFIED AND THE PLANT BED PLANTING SHALL BE ADJUSTED ACCORDINGLY







PLANTING -
SHRUBS ARE TO BE PLANTED IN INDIVIDUAL HOLES OR IN A CONTINUOUS TRENCH AS SPECIFIED ON THE "PLANT DATA CHART." IF PLANTED IN A TRENCH, THE TRENCH SHALL BE AS DEEP AND AS WIDE AS THAT SPECIFIED FOR INDIVIDUAL HOLES ON THE "PLANT DATA CHART."
EXCESS EXCAVATED MATERIAL MAY BE DISPOSED OF BETWEEN THE HOLES OR TRENCH IF IN THE JUDGEMENT OF THE ENGINEER IT DOES NOT CAUSE EROSION OR DRAINAGE PROBLEMS. IF THIS IS DONE, PLANT ELEVATIONS WILL BE ADJUSTED ACCORDINGLY AND THE ENTIRE BED AREA WILL BE RAKED OR OTHERWISE FINISHED TO PRODUCE A UNIFORM SURFACE CONFORMING TO THE ORIGINAL SHAPE AND CONTOUR. THE ENTIRE BED AREA SHALL BE MULCHED.

SYMBOLS

xx INDIVIDUAL MEDIUM TO LARGE SHRUB





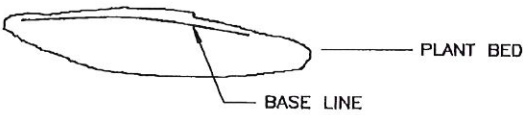


LEVELS: 0N1#3,4,5,6,7,8,9,10,11,12,13,14,15,16,17,18,19,20,21,22,23,24,25,26,27,28,29,30,31,32,33,34,35,36,37,38,39,40,41,42,43,44,45,46,47,48,49,50,51,52,53,54,55,56,57,58,59,60,61,62,63

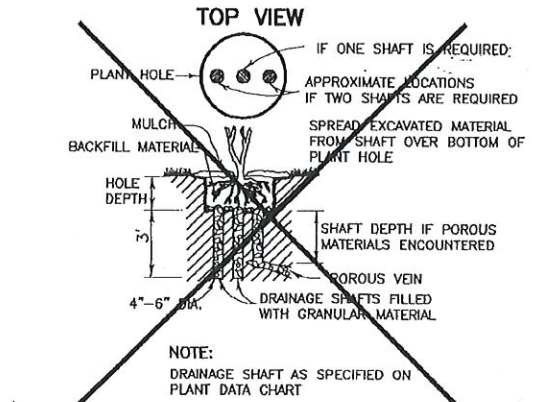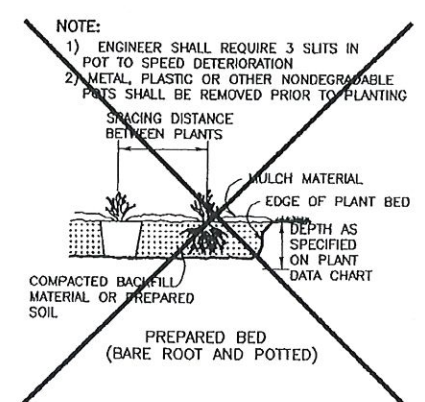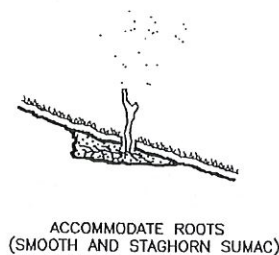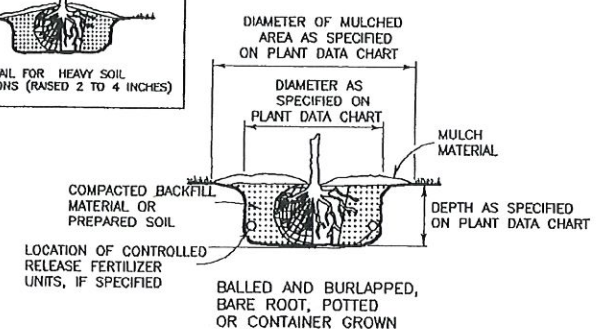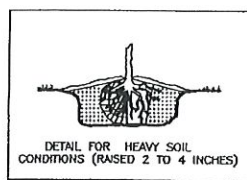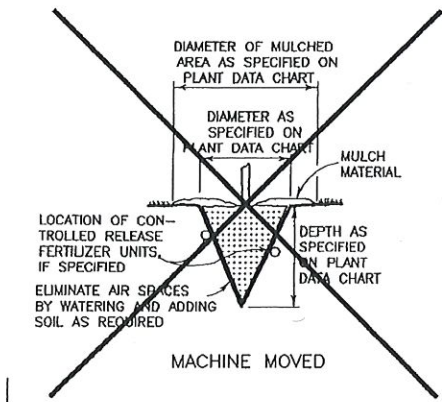



PLANTING

DRAINING

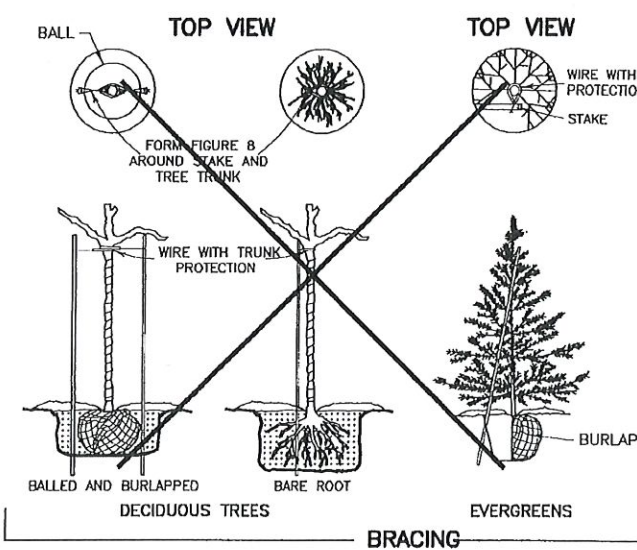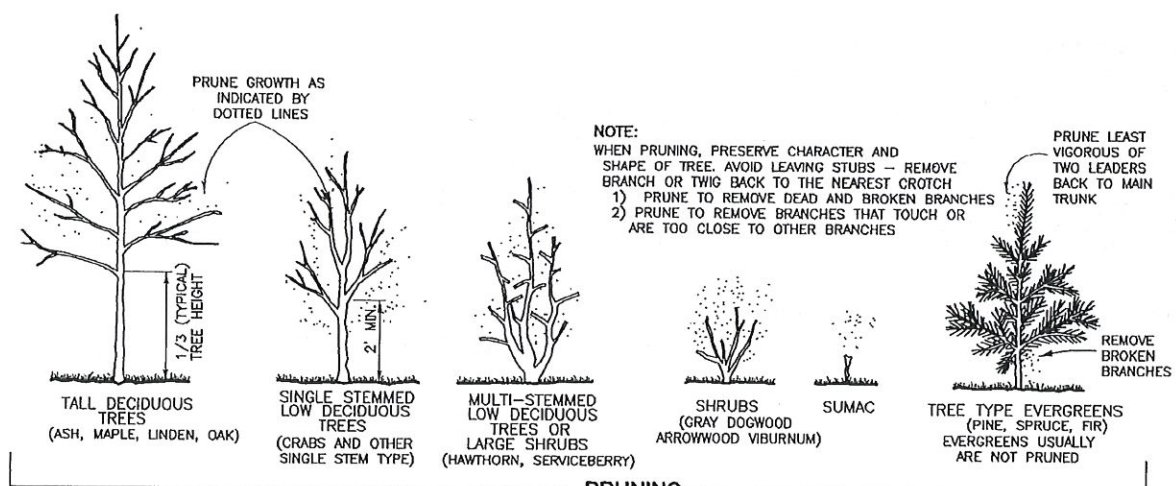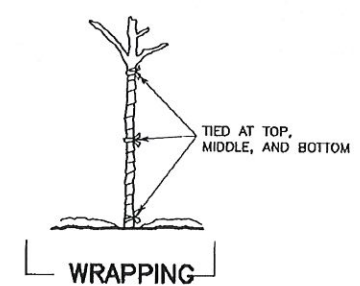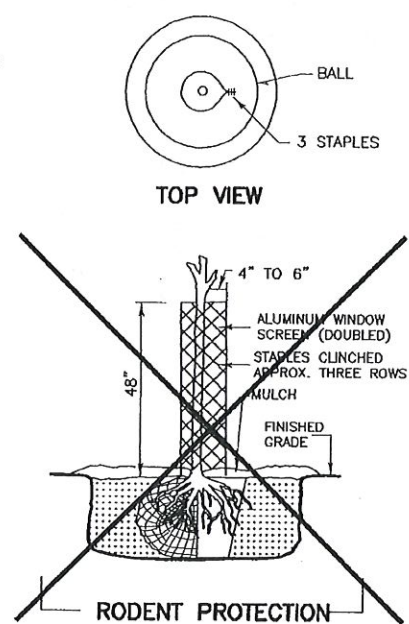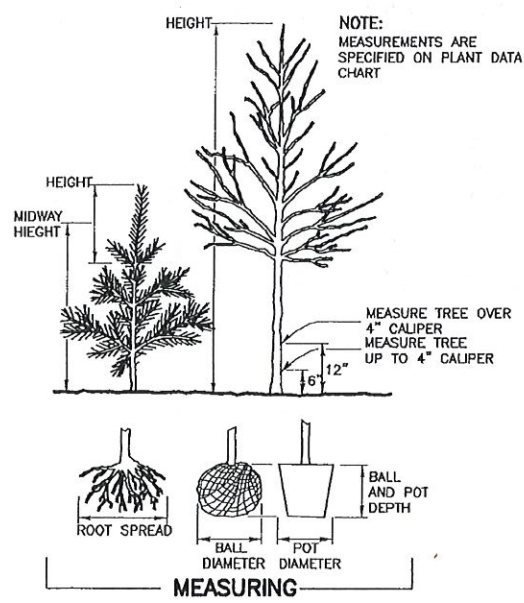

NOTE: BRACING STAKE

- SHALL BE DRIVEN INTO THE GROUND AS CLOSE TO THE TREE AS POSSIBLE WITHOUT DAMAGING THE BRANCHES.
- MAY BE DRIVEN AT SUCH AN ANGLE THAT IT DOES NOT PENETRATE THE BALL OR POT.
- SHALL NOT PROTRUDE ABOVE THE TOP OF THE TREE; AND
- SHALL HAVE A HOLE NEAR THE TOP TO HOLD THE WIRE IN PLACE.

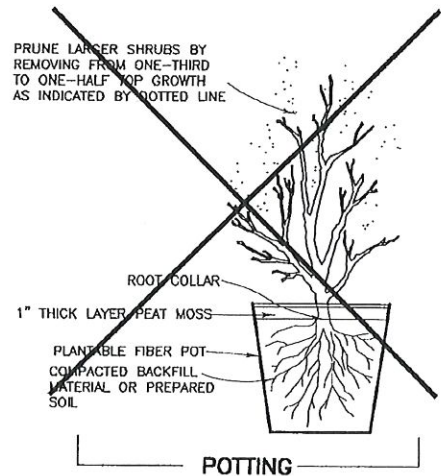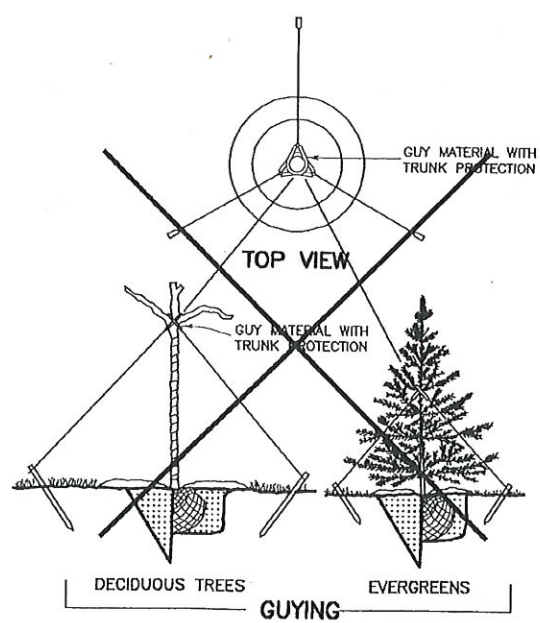

NOTES

DETAILS OF CONSTRUCTION NOT SHOWN ON THIS DRAWING SHALL CONFORM TO THE PERTINENT REQUIREMENTS OF THE STANDARD SPECIFICATIONS AND THE APPLICABLE SPECIAL PROVISIONS.

BRACING, WRAPPING, GUYING, RODENT PROTECTION, FERTILIZER AND MULCH SHALL BE USED ONLY WHEN SPECIFIED ON THE PLANT DATA CHART (PART OF PLAN) OR SPECIAL PROVISIONS.

LETTERS ON 1,2,3,4,5,6,7,8,9,10,11,12,13,14,15,16,17,18,19,20,21,22,23,24,25,26,27,28,29,30,31,32,33,34,35,36,37,38,39,40,41,42,43,44,45,46,47,48,49,50,51,52,53,54,55,56,57,58,59,60,61,62,63

PLANTING DATA

SYMBOL	COMMON NAME	SCIENTIFIC NAME	TYPE	AVE MATURE HEIGHT	SIZE WHEN PLANTED	ROOT ZONE MODE	MINIMUM SIZE					BRACE OR GUY	FERT. UNITS REQ'D	RODENT PROTCT REQ'D	MULCH RING DIA.	PLANT BED DETAIL
							BALL/POT		ROOT SPREAD	PLANT HOLE OR TRENCH						
							DIA.	DEPTH			DIA.	DEPTH				
Large Growing Deciduous Shrubs																
GD	Dogwood, Gray	Cornus racemosa	2	10 FT	15-18" HT.	BR	--	--	11"	23"	8"	No	2	No	BED	2
RD	Dogwood, Redosier	Cornus sericea	2	10 FT	15-18" HT.	BR	--	--	11"	23"	8"	No	2	No	BED	2
CN	Ninebark, Common	Physocarpus opulifolius	3	6 FT	15-18" HT.	BR	--	--	11"	23"	8"	No	2	No	BED	2
AV	Viburnum, Arrowwood	Viburnum dentatum	3	10 FT	15-18" HT.	BR	--	--	11"	23"	8"	No	2	No	BED	1&2
BV	Viburnum, Blackhaw	Viburnum prunifolium	3	10 FT	15-18" HT.	BR	--	--	11"	23"	8"	No	2	No	BED	2
ACV	Viburnum, Amer. Cranberrybush	Viburnum trilobum	3	12 FT	15-18" HT.	BR	--	--	11"	23"	8"	No	2	No	BED	2
NV	Viburnum, Nannyberry	Viburnum lentago	3	10 FT	15-18" HT.	BR	--	--	11"	23"	8"	No	2	No	BED	2
Medium Growing Deciduous Shrubs																
AF	Filbert, American	Corylus americana	2	10 FT	15-18" HT.	BR	--	--	11"	23"	8"	No	2	No	BED	2

ABBREVIATIONS LEGEND:

BR = Bare Root
CAL = Caliper
FT = Feet
HT = Height
-- = Not Applicable

NOTES:

1. Layout and staking of plant materials to be verified by engineer prior to installation.
2. See Plant Bed Details sheet for spacing of deciduous shrubs.
3. Groups of plantings to be mulched in their entirety.
4. All disturbed areas require Seed Mix No. 10.

DATE 06SEP00

ESTIMATE OF QUANTITIES


SHEET: 3.1

LINE NUMBER	ITEM	ITEM DESCRIPTION	UNIT	TOTAL	1000-01-81 QUANTITY
0010	61910	MOBILIZATION	LS	1.00	1.00
0020	63261	SHRUBS, DOGWOOD, GRAY, 15-18 INCH HT., BR	EACH	1,050.00	1,050.00
0030	63262	SHRUBS, DOGWOOD, REDOSIER, 15-18 INCH HT., BR	EACH	1,800.00	1,800.00
0040	63263	SHRUBS, NINEBARK, COMMON, 15-18 INCH HT., BR	EACH	1,800.00	1,800.00
0050	63264	SHRUBS, VIBURNUM, ARROWWOOD, 15-18 INCH HT., BR	EACH	2,375.00	2,375.00
0060	63265	SHRUBS, VIBURNUM, BLACKHAW, 15-18 INCH HT., BR	EACH	950.00	950.00
0070	63266	SHRUBS, VIBURNUM, AMERICAN CRANBERRYBUSH, 15-18 INCH HT., BR	EACH	1,200.00	1,200.00
0080	63267	SHRUBS, VIBURNUM, NANNYBERRY, 15-18 INCH HT., BR	EACH	900.00	900.00
0090	63268	SHRUBS, FILBERT, AMERICAN, 15-18 INCH HT., BR	EACH	450.00	450.00
0100	90005	MISC 90005A, LANDSCAPE PLANTING SURVEILLANCE AND CARE	EACH	20.00	20.00
0110	90005	MISC 90005B, SHRUB REJUVENATION	EACH	420.00	420.00

PLANT QUANTITIES BY SHEET

SYMBOL	COMMON NAME	SIZE WHEN PLANTED	SHEET NUMBER															TOTALS	
			5.0 (EACH)	5.1 (EACH)	5.2 (EACH)	5.3 (EACH)	5.4 (EACH)	5.5 (EACH)	5.6 (EACH)	5.7 (EACH)	5.8 (EACH)	5.9 (EACH)	5.10 (EACH)	5.11 (EACH)	5.12 (EACH)	5.13 (EACH)	5.14 (EACH)		5.15 (EACH)
Large Growing Deciduous Shrubs																			
GD	Dogwood, Gray	15-18 INCH HT.							450						600				1050
RD	Dogwood, Redosier	15-18 INCH HT.							600					900	300				1800
CN	Ninebark, Common	15-18 INCH HT.	500	100										1200					1800
AV	Viburnum, Arrowwood	15-18 INCH HT.		450					50	175		900	150		650				2375
BV	Viburnum, Blackhaw	15-18 INCH HT.														950			950
ACV	Viburnum, Amer. Cranberrybush	15-18 INCH HT.		300					300							600			1200
NV	Viburnum, Nannyberry	15-18 INCH HT.						600									300		900
Medium Growing Deciduous Shrubs																			
AF	Filbert, American	15-18 INCH HT.															75	375	450
PROJECT TOTALS:			500	850	0	0	0	600	1400	175	0	900	150	2100	1550	1550	375	375	10525


1212944561617 20, 21, 22, 23, 24, 25, 26, 27, 28, 29, 30, 31, 32, 33, 34, 35, 36, 37, 38, 39, 40, 41, 42, 43, 44, 45, 46, 47, 48, 49, 50, 51, 52, 53, 54, 55, 56, 57, 58, 59, 60, 61, 62, 63

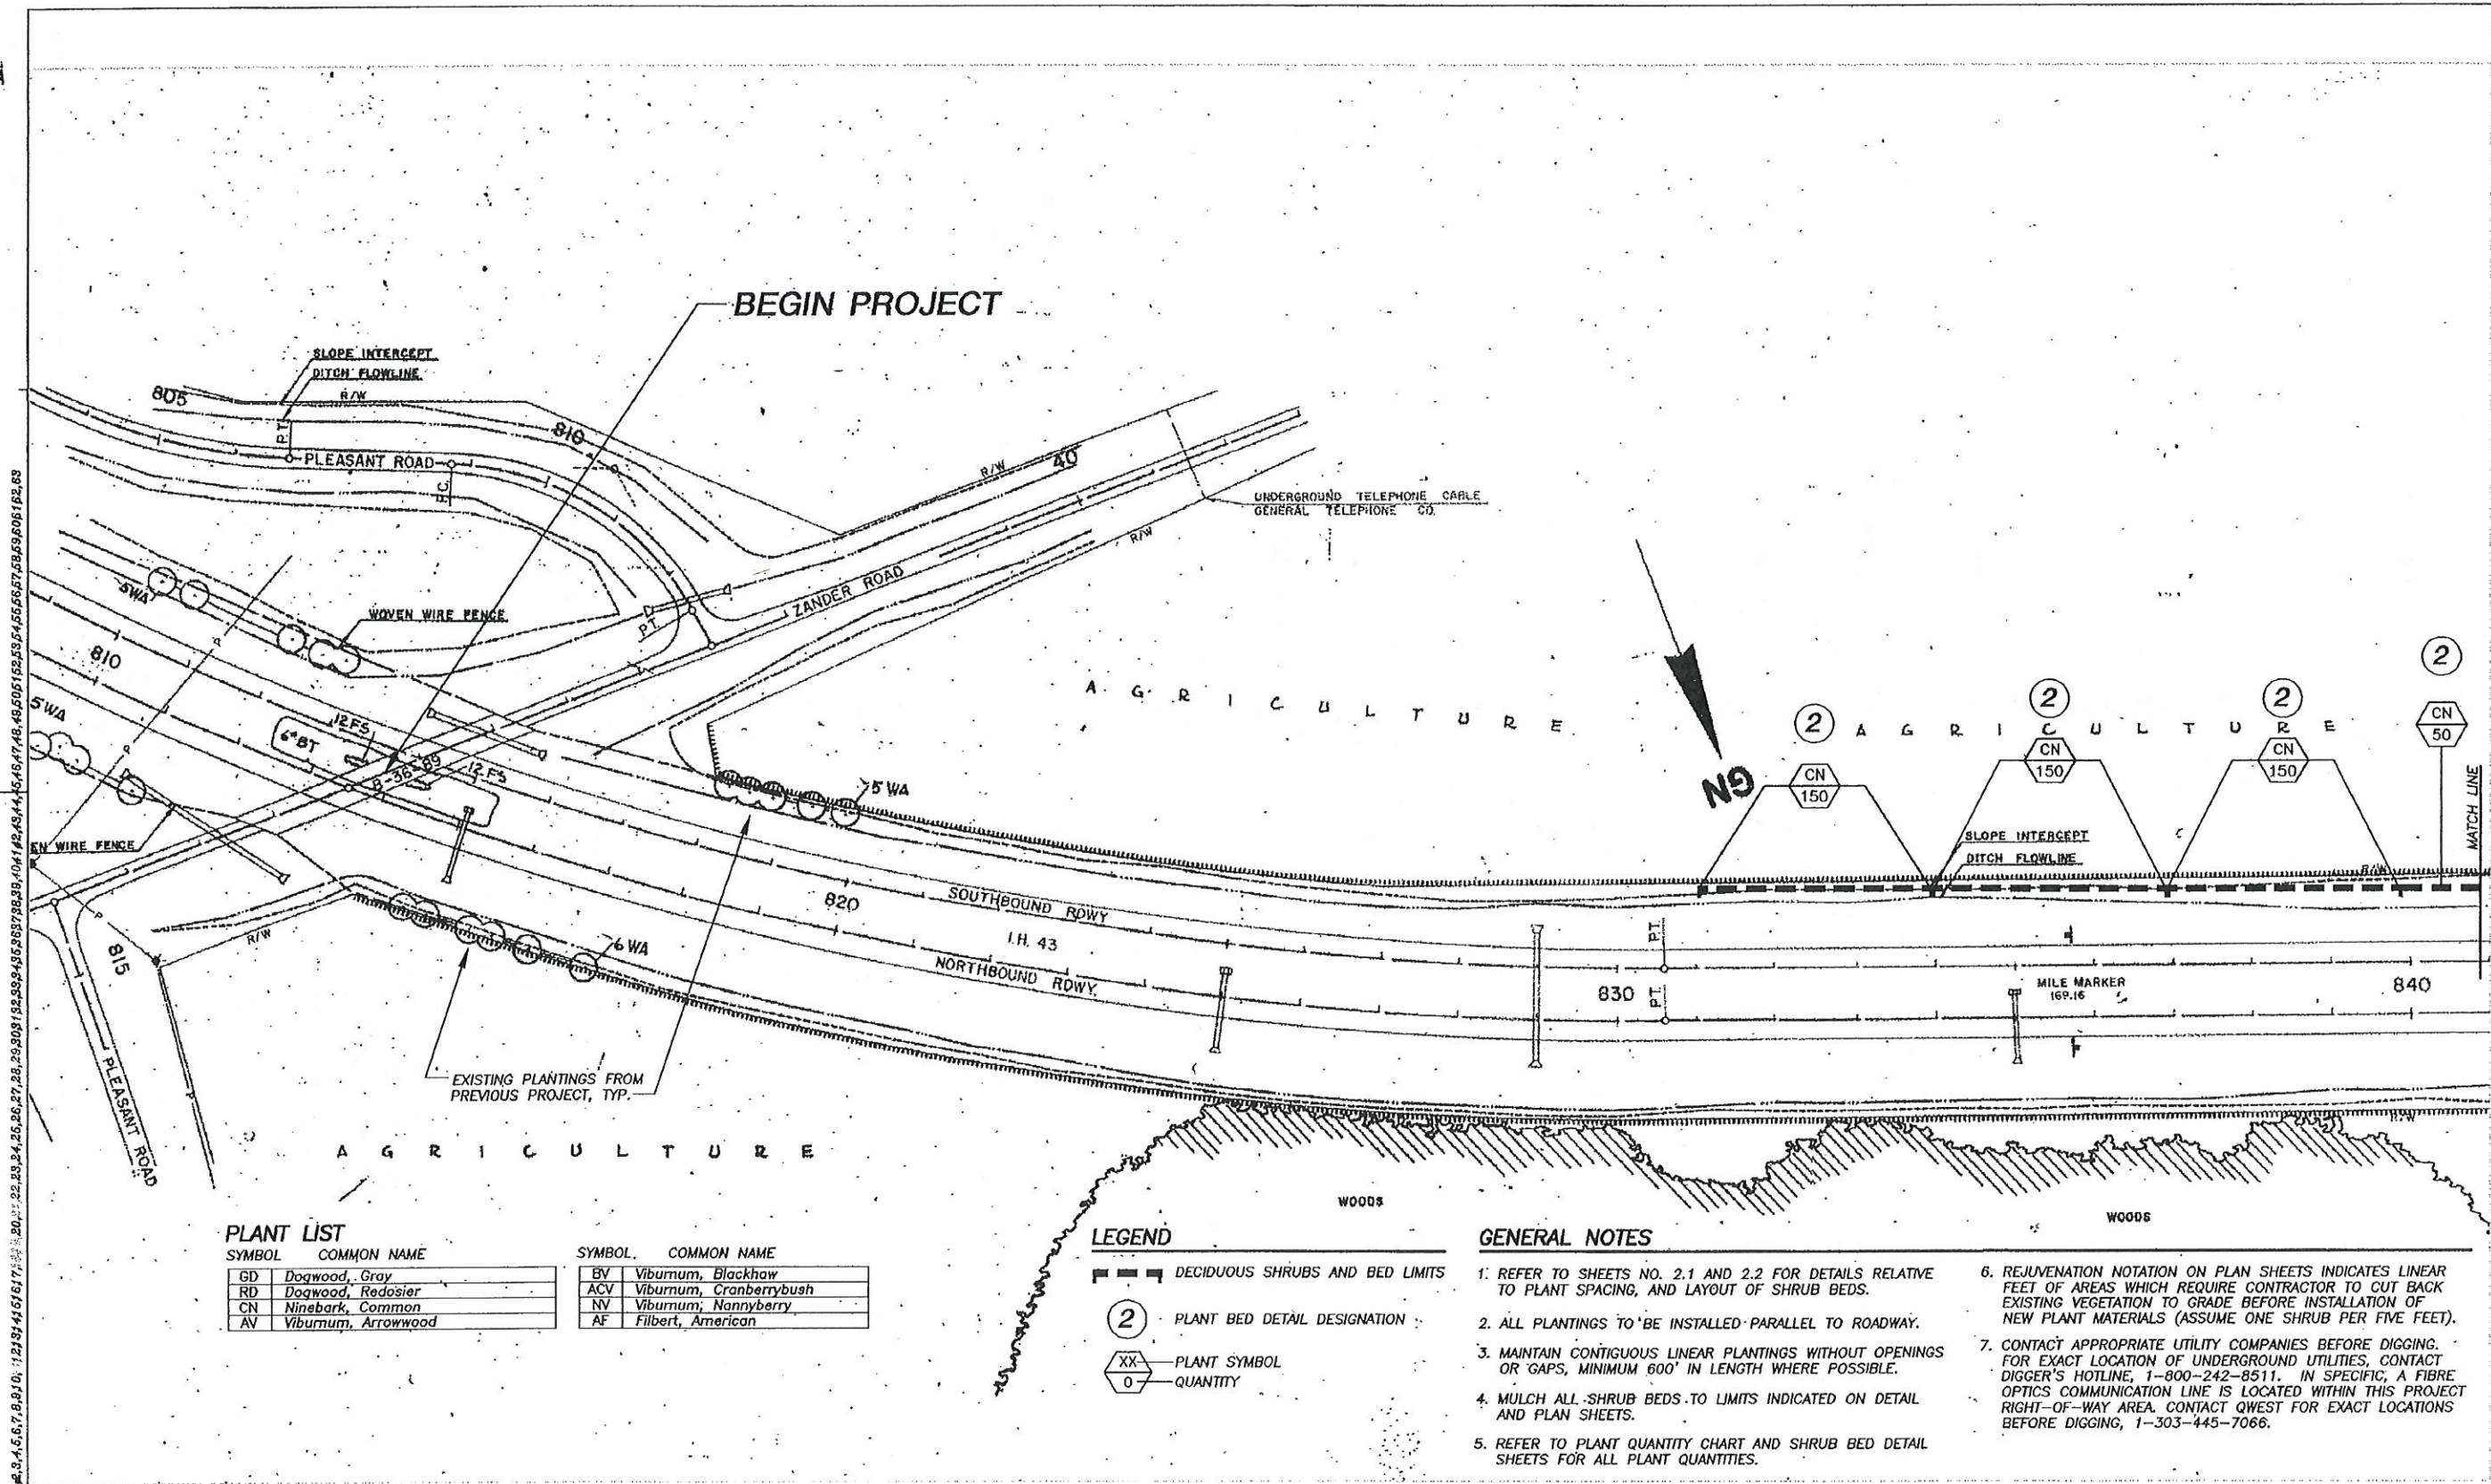

STATE PROJECT NUMBER: 1000-01-81 HWY: IH 43 - GREEN BAY COUNTY: BROWN AND MANITOWOC SCALE, FEET 0 100 200 SHEET NO: 5.0 E

FILE NAME: 5.0.DWG PLOT DATE: 8/3/00 ORG DATE: PLOT NAME: ORIGINATOR: PLOT SCALE: SCHMELTZER DESIGN, INC. PROJECT NO. 00010

LETTERS ON 1,2,3,4,5,6,7,8,9,10, 11,12,13,14,15,16,17,18,19,20,21,22,23,24,25,26,27,28,29,30,31,32,33,34,35,36,37,38,39,40,41,42,43,44,45,46,47,48,49,50,51,52,53,54,55,56,57,58,59,60,61,62,63

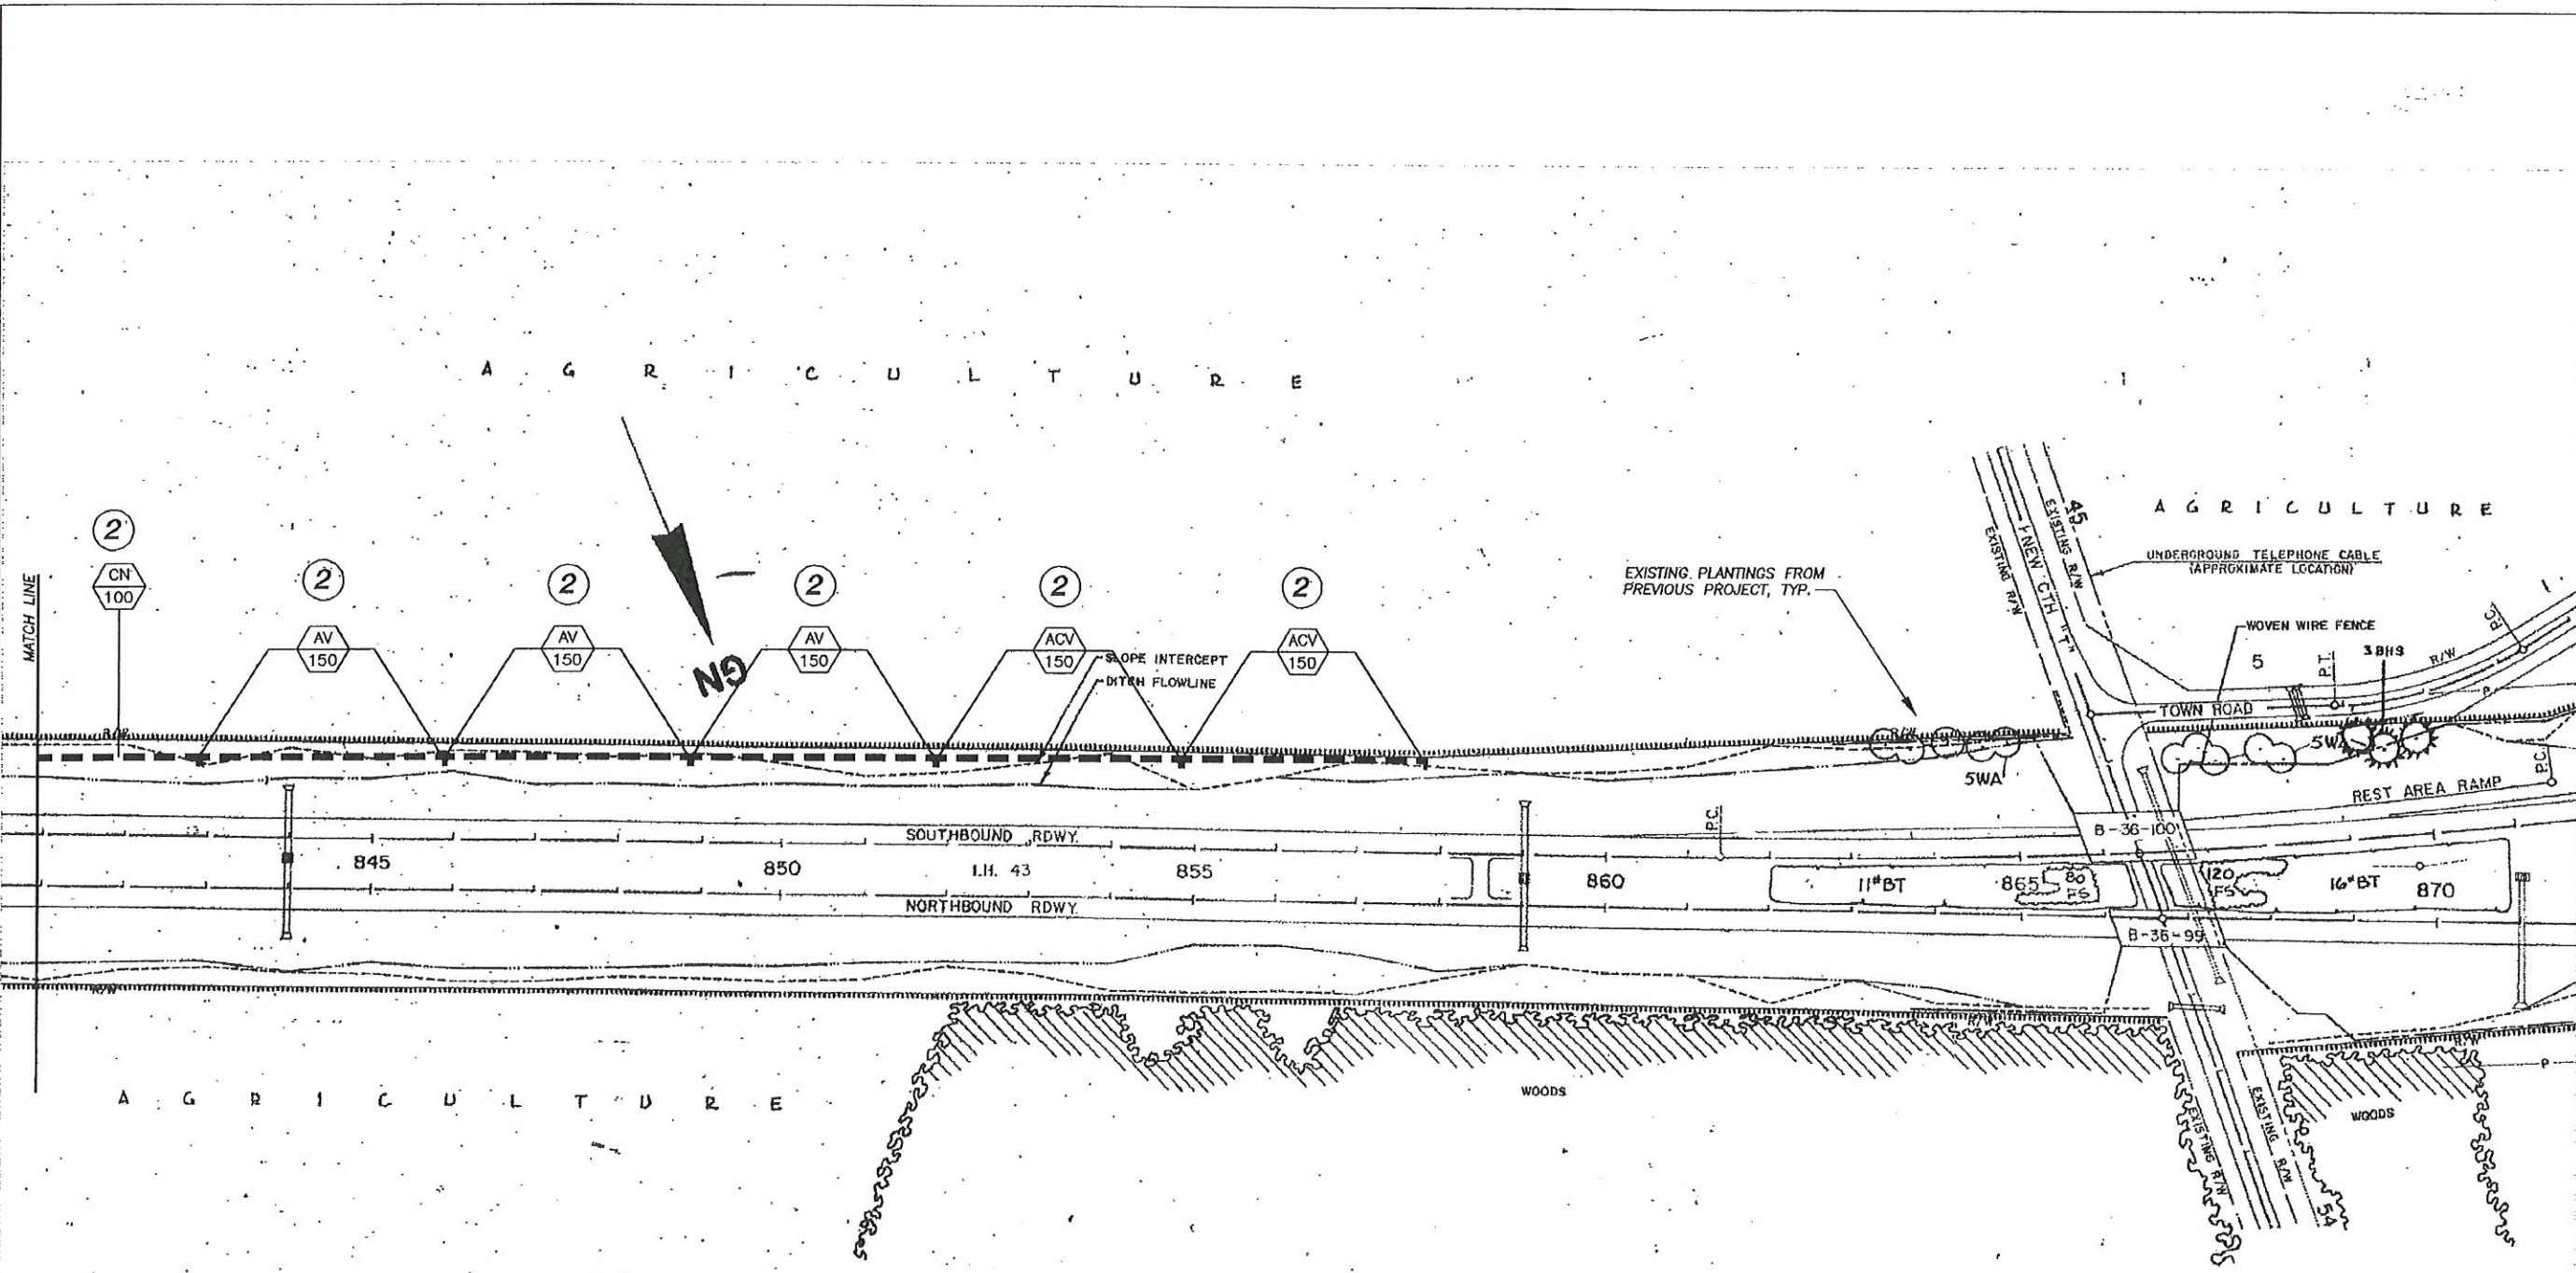

PLANT LIST

SYMBOL COMMON NAME

GD	Dogwood, Gray
RD	Dogwood, Redosier
CN	Ninebark, Common
AV	Viburnum, Arrowwood

SYMBOL COMMON NAME

BV	Viburnum, Blackhaw
ACV	Viburnum, Cranberrybush
NV	Viburnum, Nannyberry
AF	Filbert, American

LEGEND

DECIDUOUS SHRUBS AND BED LIMITS

2 PLANT BED DETAIL DESIGNATION

XX PLANT SYMBOL
0 QUANTITY

NOTES

1. REFER TO SHEET NO. 5.0 FOR GENERAL NOTES.

STATE PROJECT NUMBER: 1000-01-81

HWY: IH 43 - GREEN BAY

COUNTY: BROWN AND MANITOWOC

SCALE, FEET 0 100 200

SHEET NO: 5.1

E

FILE NAME: 5.1.DWG

PLOT DATE: 8/3/00

ORG DATE:

PLOT NAME:


ORIGINATOR: PLOT SCALE:

SCHMELTZER DESIGN, INC. PROJECT NO. 00010

LEVELS ON 1# 9.4, 5.5, 7.5, 9.10, 12.13, 14.15, 16.17, 18.19, 20.21, 22.23, 24.25, 26.27, 28.29, 30.31, 32.33, 34.35, 36.37, 38.39, 40.41, 42.43, 44.45, 46.47, 48.49, 50.51, 52.53, 54.55, 56.57, 58.59, 60.61, 62.63

PLANT LIST

SYMBOL	COMMON NAME	SYMBOL	COMMON NAME
GD	Dogwood, Gray	BV	Viburnum, Blackhaw
RD	Dogwood, Redosier	ACV	Viburnum, Cranberrybush
CN	Ninebark, Common	NV	Viburnum, Nannyberry
AV	Viburnum, Arrowwood	AF	Filbert, American

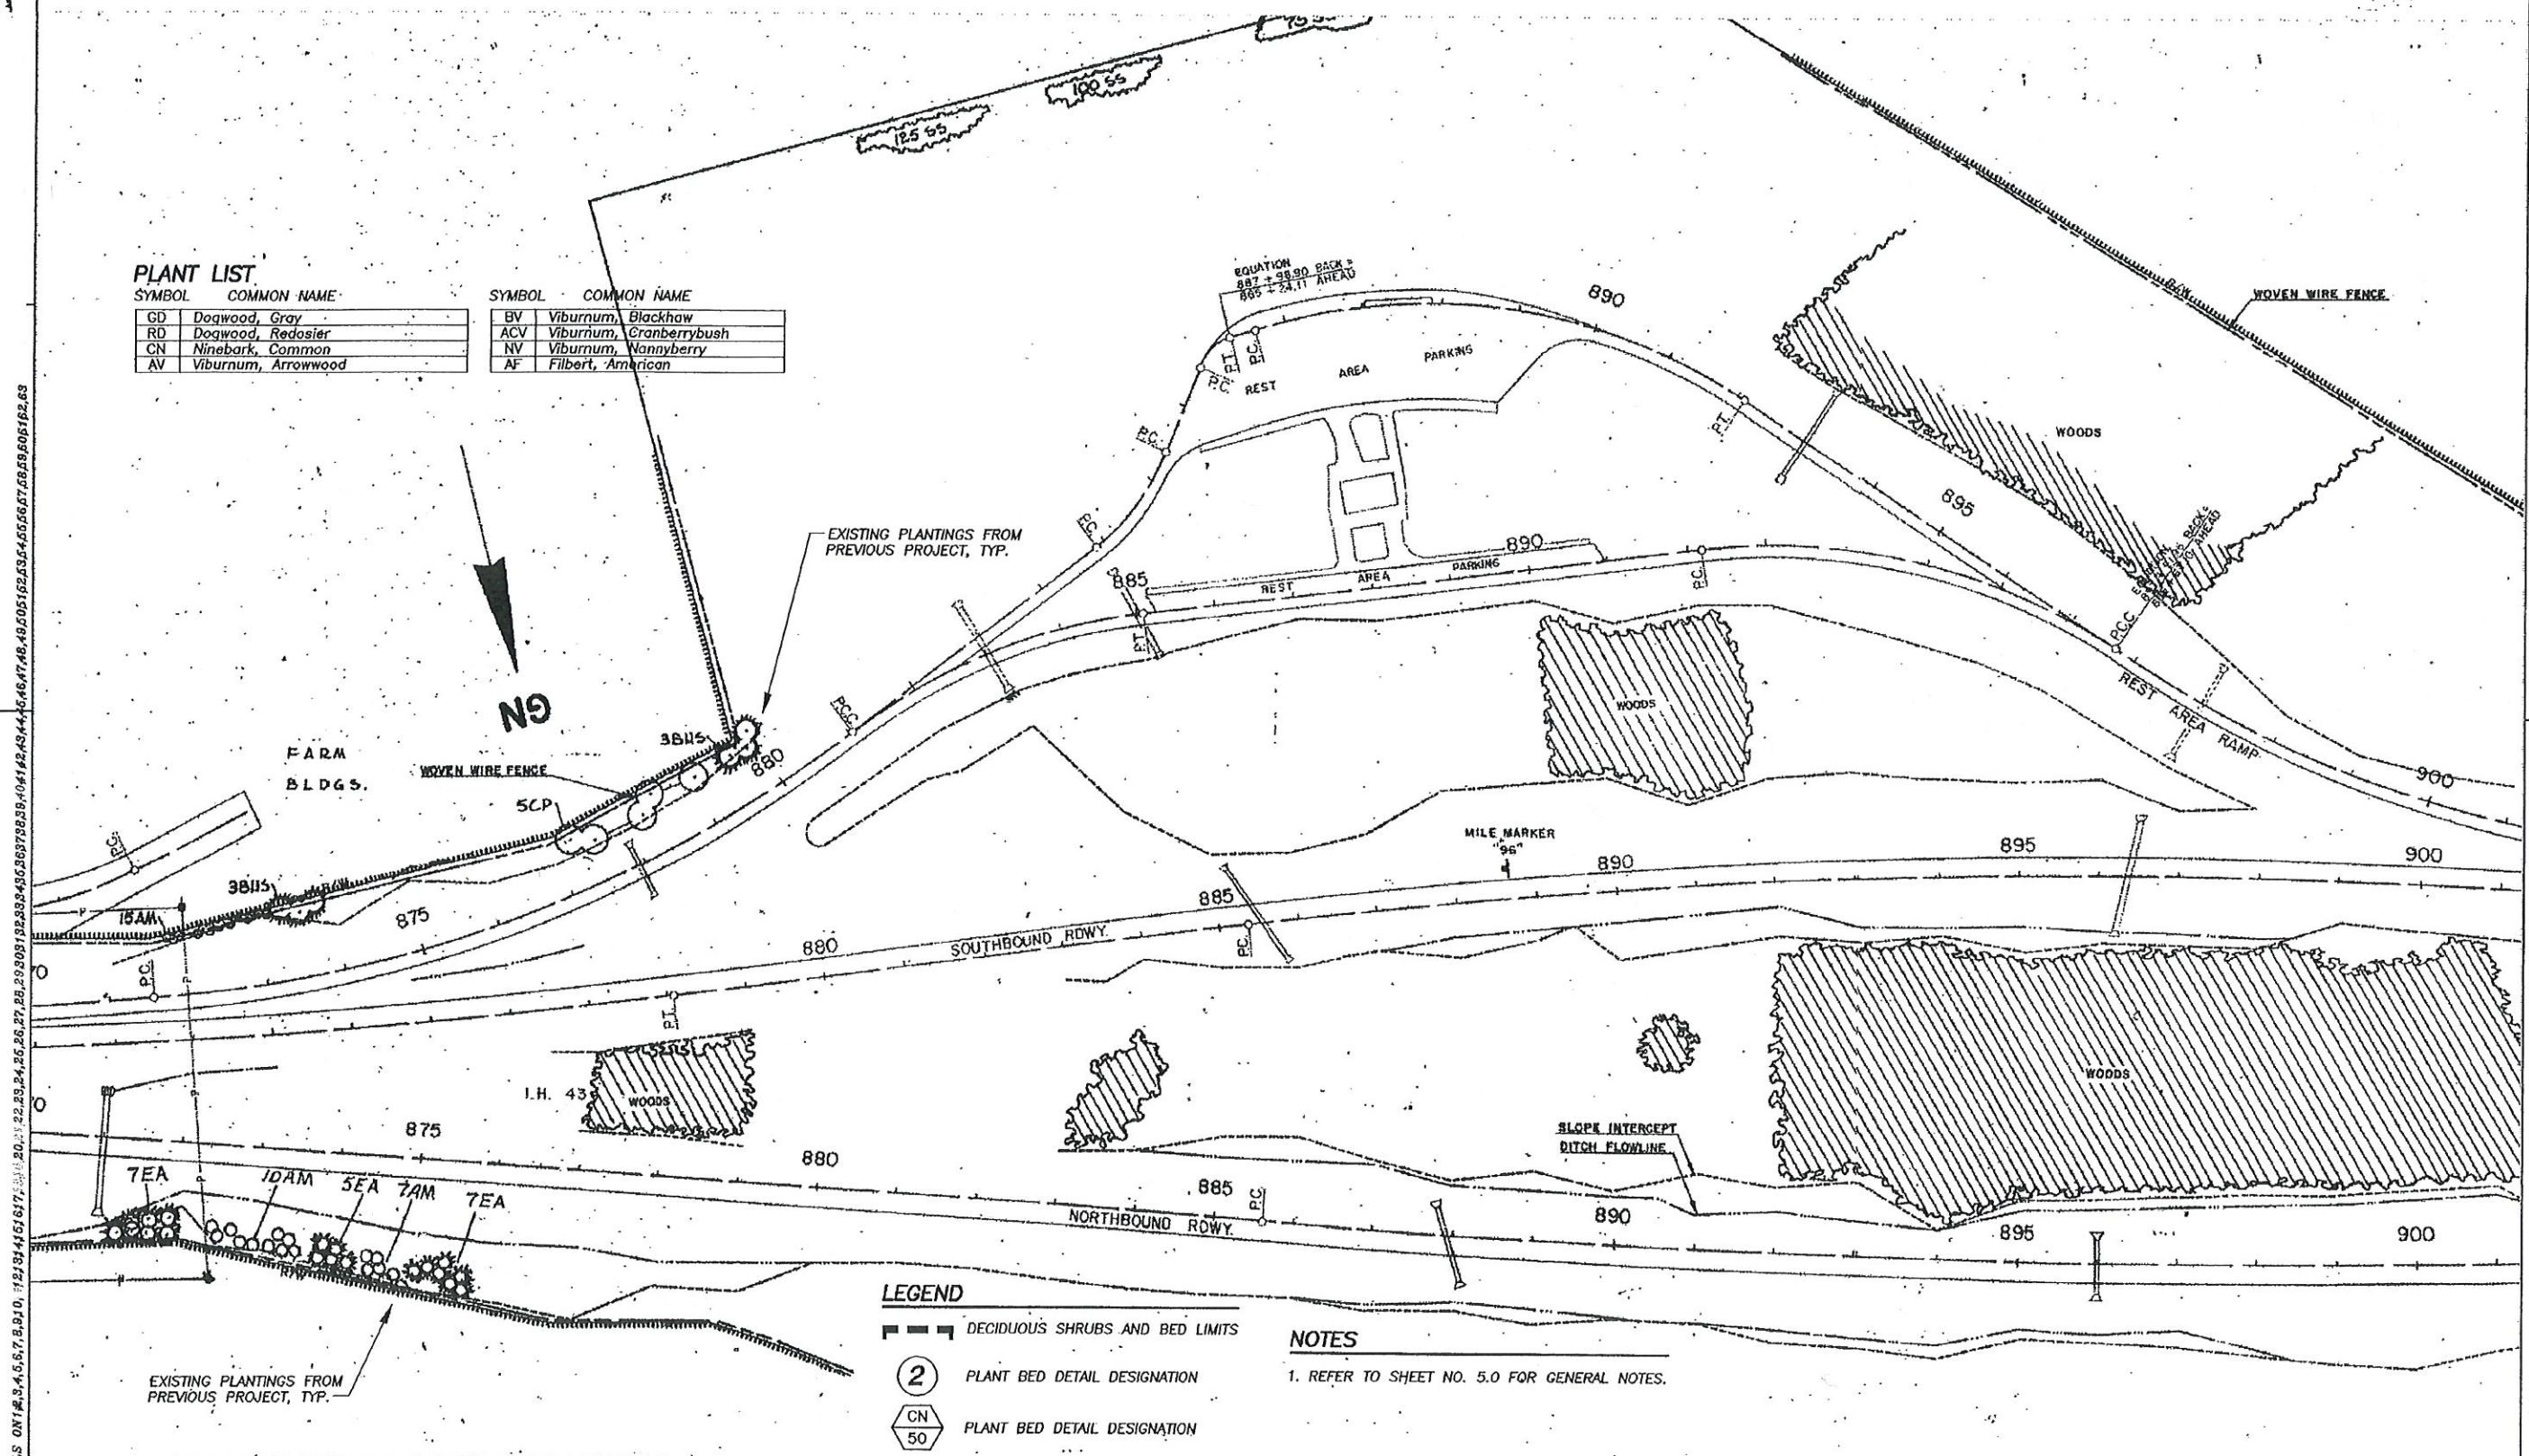

LEGEND

- DECIDUOUS SHRUBS AND BED LIMITS
- 2 PLANT BED DETAIL DESIGNATION
- CN 50 PLANT BED DETAIL DESIGNATION

NOTES

1. REFER TO SHEET NO. 5.0 FOR GENERAL NOTES.

STATE PROJECT NUMBER: 1000-01-81	HWY: IH 43 - GREEN BAY	COUNTY: BROWN AND MANITOWOC	SCALE, FEET 0 100 200	SHEET NO: 5.2	E
FILE NAME: 5.2.DWG	PLOT DATE: 8/3/00	ORG DATE:	PLOT NAME:	ORIGINATOR:	PLOT SCALE:


SCHMELTZER DESIGN, INC. PROJECT NO. 00010

PLANT LIST

SYMBOL	COMMON NAME
GD	Dogwood, Gray
RD	Dogwood, Redosier
CN	Ninebark, Common
AV	Viburnum, Arrowwood

SYMBOL	COMMON NAME
BV	Viburnum, Blackhaw
ACV	Viburnum, Cranberrybush
NV	Viburnum, Nannyberry
AF	Filbert, American

LETTERS ON 1# 3, 4, 5, 62, 63

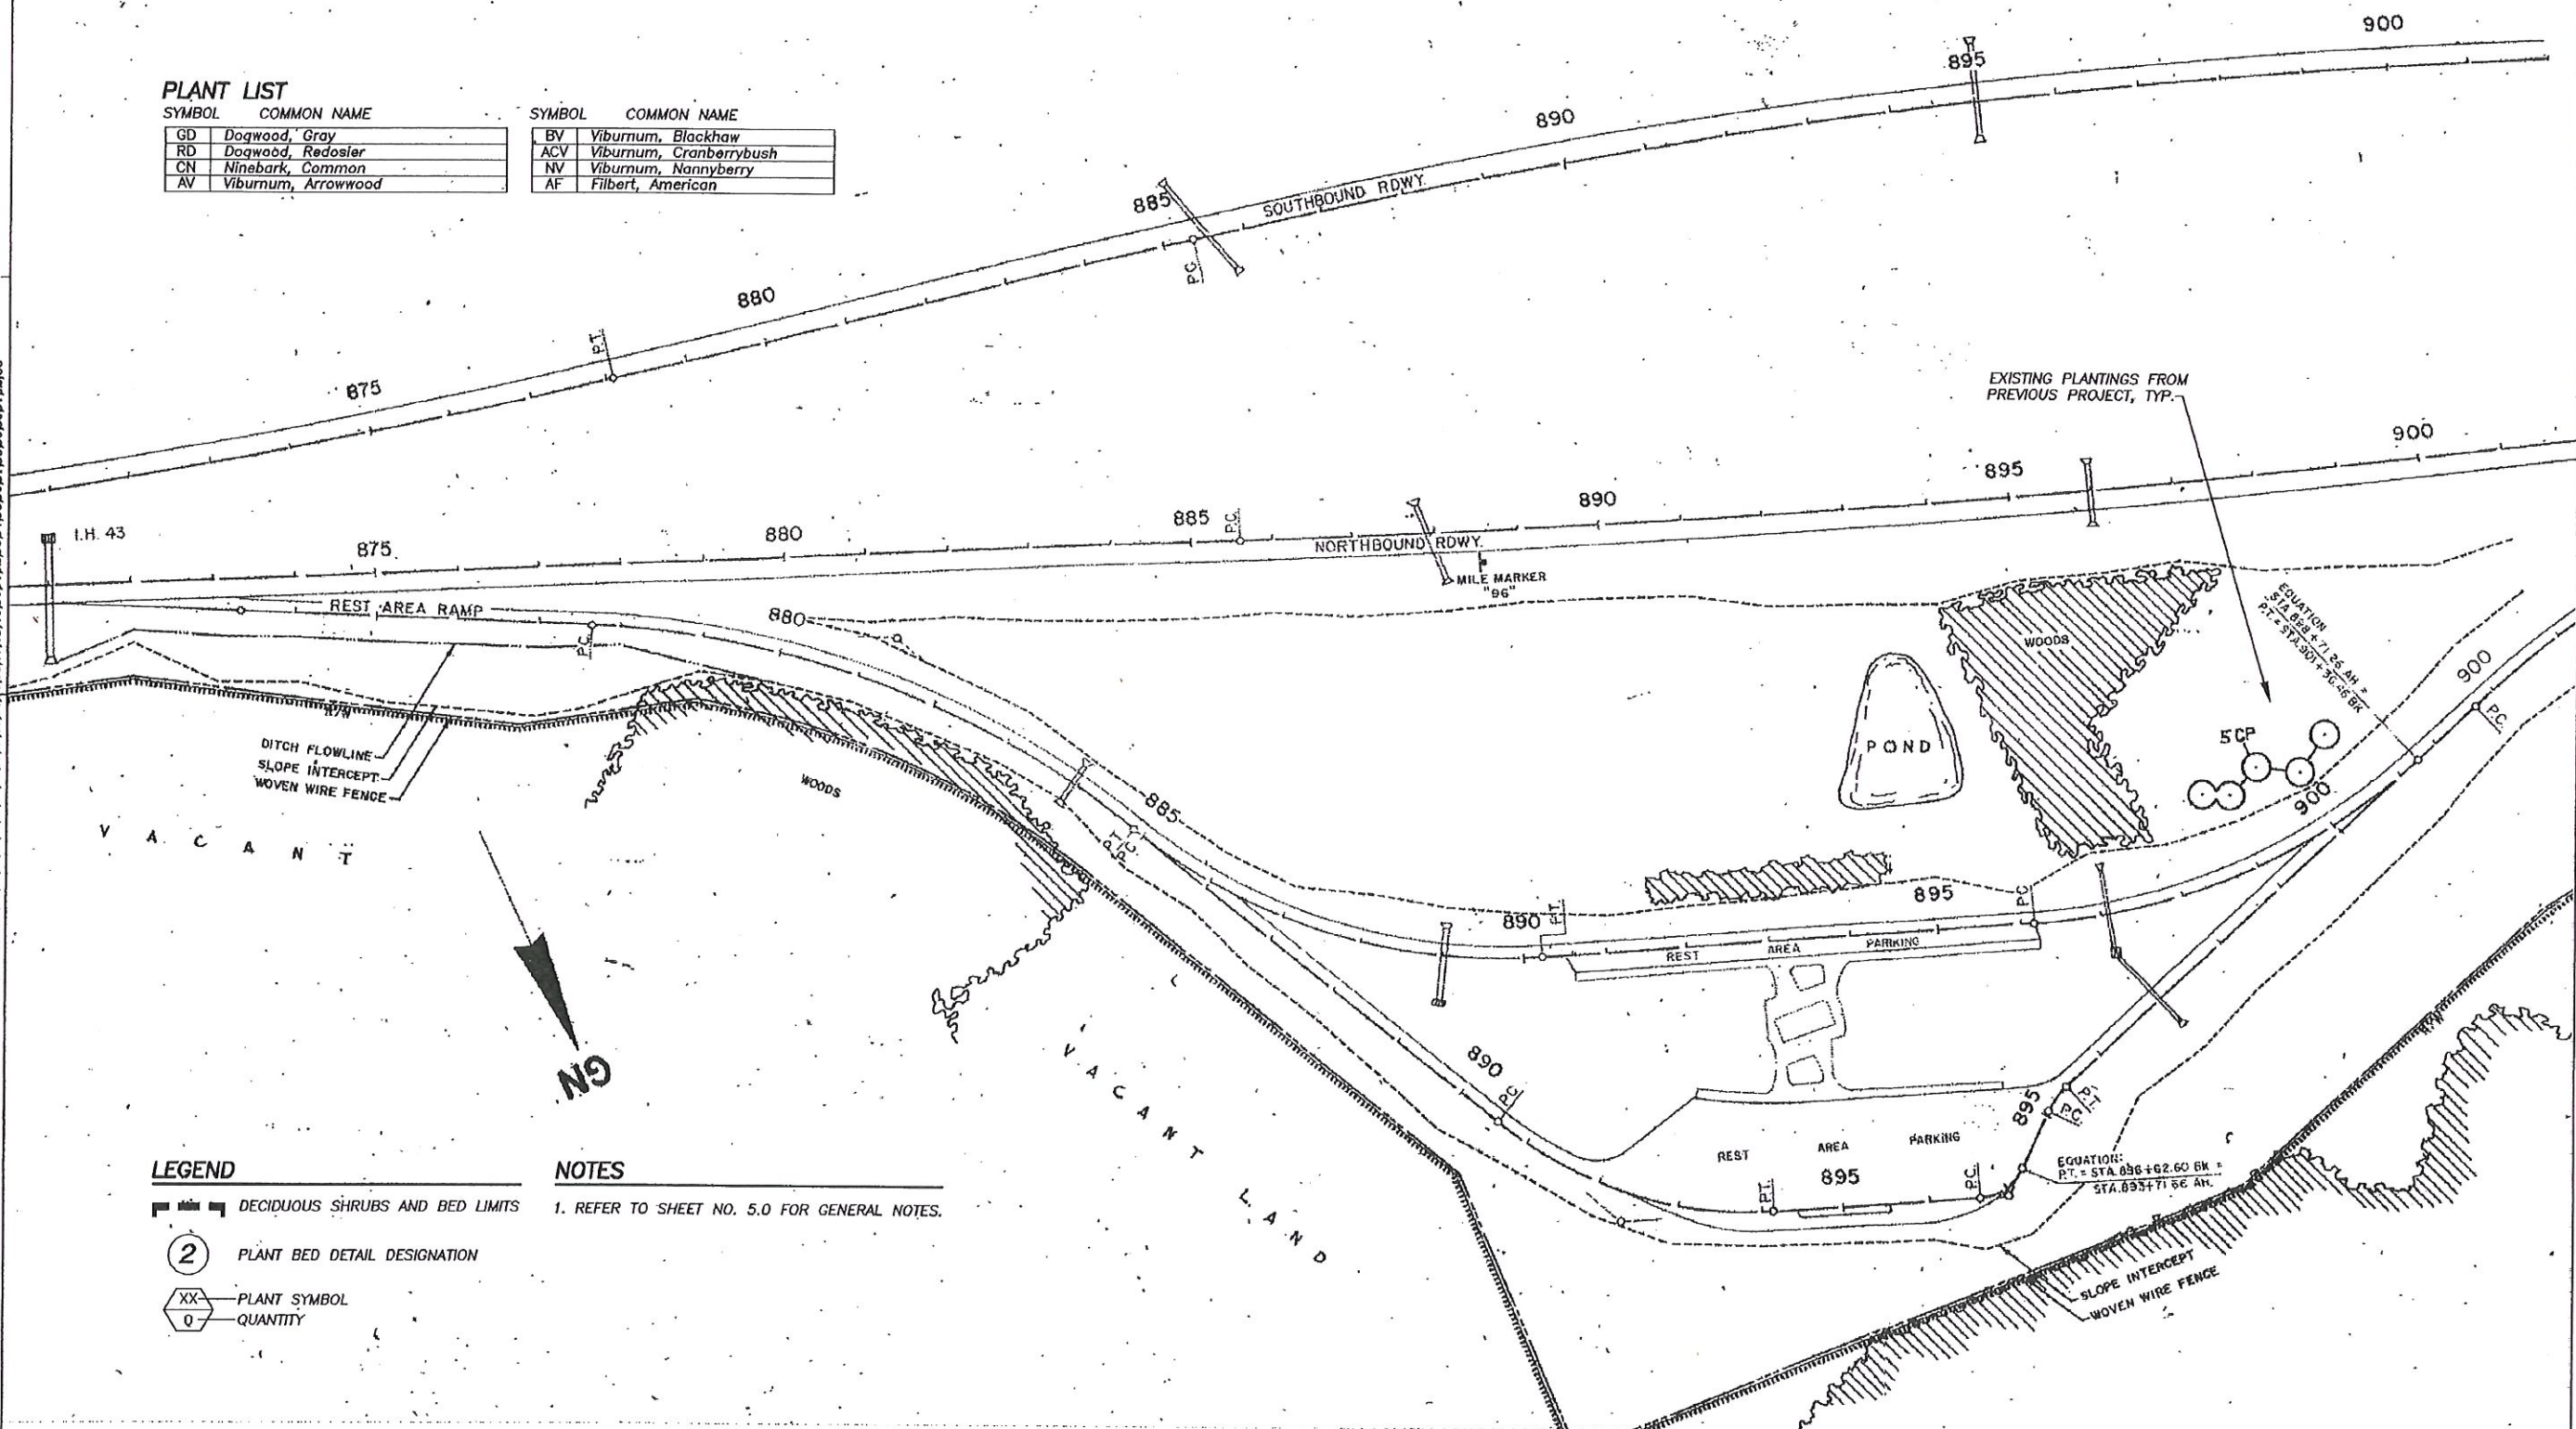

LEGEND

- DECIDUOUS SHRUBS AND BED LIMITS
- 2 PLANT BED DETAIL DESIGNATION
- XX PLANT SYMBOL
- Q QUANTITY


NOTES

1. REFER TO SHEET NO. 5.0 FOR GENERAL NOTES.

STATE PROJECT NUMBER: 1000-01-81	HWY: IH 43 - GREEN BAY	COUNTY: BROWN AND MANITOWOC	SCALE, FEET 0 100 200	SHEET NO: 5.3	E
FILE NAME: 5.3.DWG	PLOT DATE: 8/3/00	ORG DATE:	PLOT NAME:	ORIGINATOR:	PLOT SCALE:

SCHMELTZER DESIGN, INC. PROJECT NO. 00010

LETTERS ON 1, 2, 3, 62, 63

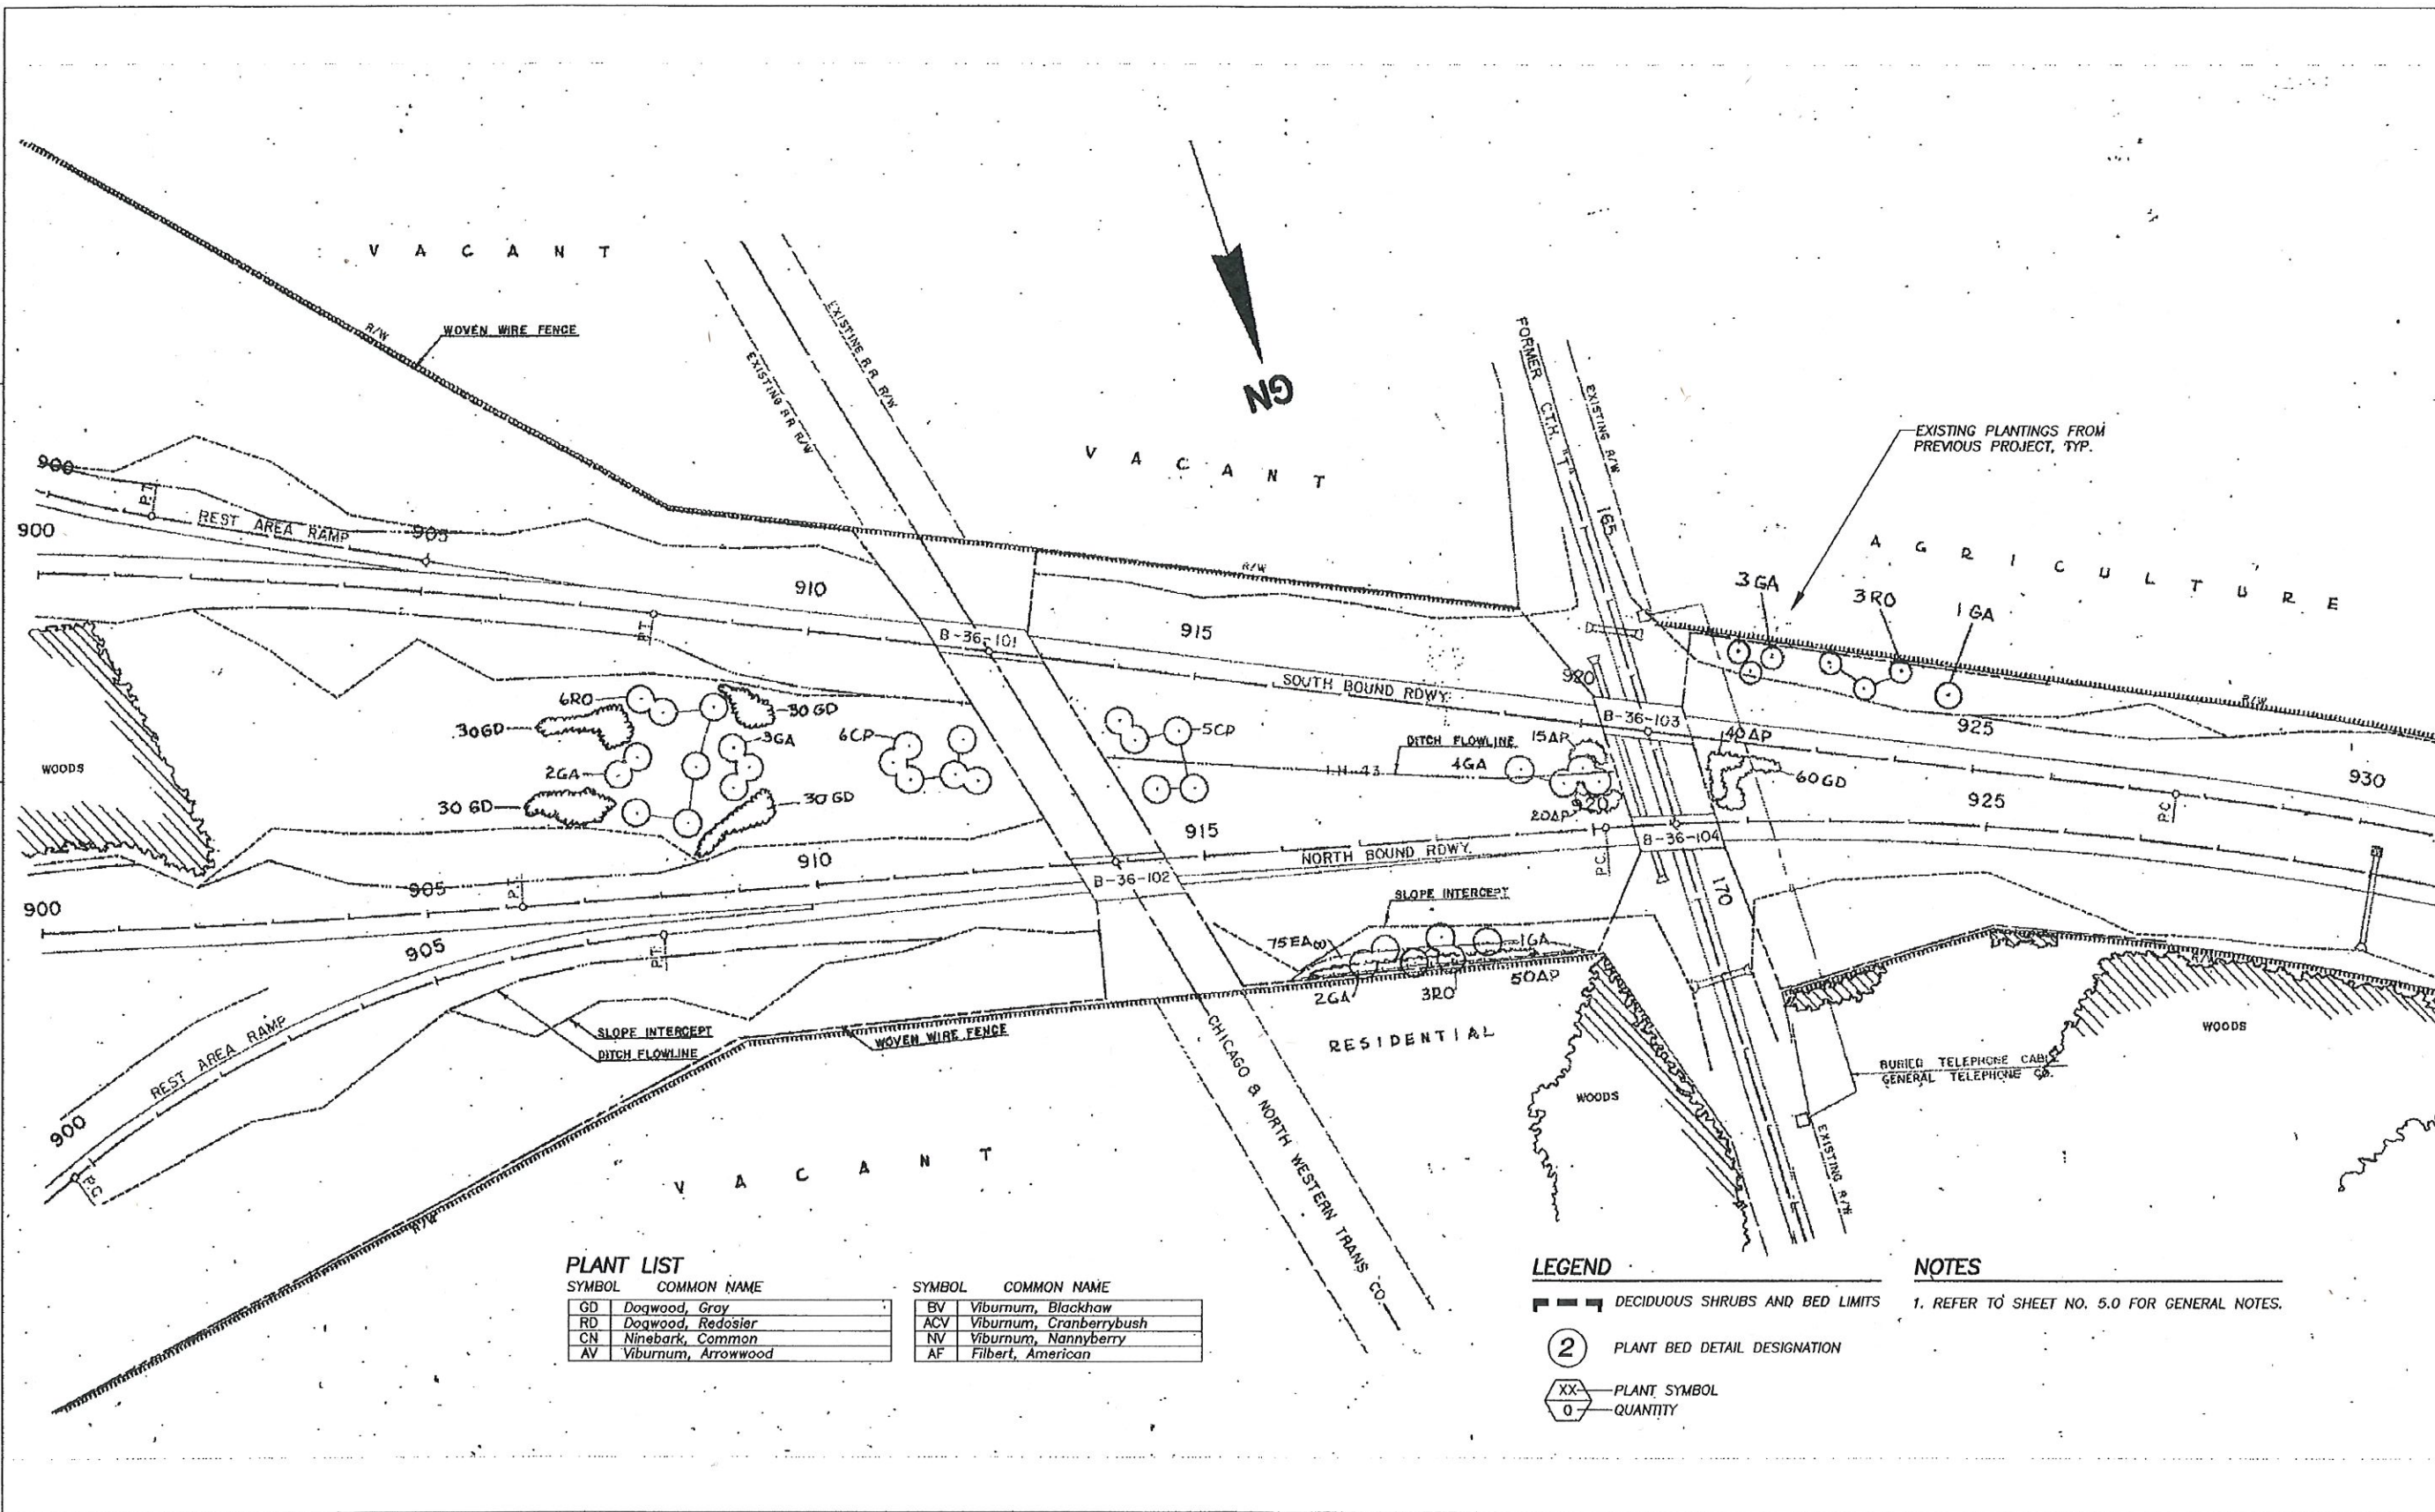

PLANT LIST

SYMBOL COMMON NAME

GD	Dogwood, Gray
RD	Dogwood, Redosier
CN	Ninebark, Common
AV	Viburnum, Arrowwood

SYMBOL COMMON NAME

BV	Viburnum, Blackhaw
ACV	Viburnum, Cranberrybush
NV	Viburnum, Nannyberry
AF	Filbert, American


LEGEND

- DECIDUOUS SHRUBS AND BED LIMITS
- 2 PLANT BED DETAIL DESIGNATION
- XX- PLANT SYMBOL
- 0- QUANTITY

NOTES

- 1. REFER TO SHEET NO. 5.0 FOR GENERAL NOTES.

STATE PROJECT NUMBER: 1000-01-81	HWY: IH 43 - GREEN BAY	COUNTY: BROWN AND MANITOWOC	SCALE, FEET 0 100 200	SHEET NO: 5.4	E
FILE NAME: 5.4.DWG	PLOT DATE: 8/3/00	ORG DATE:	PLOT NAME:	ORIGINATOR:	PLOT SCALE:
SCHMELTZER DESIGN, INC. PROJECT NO. 00010					

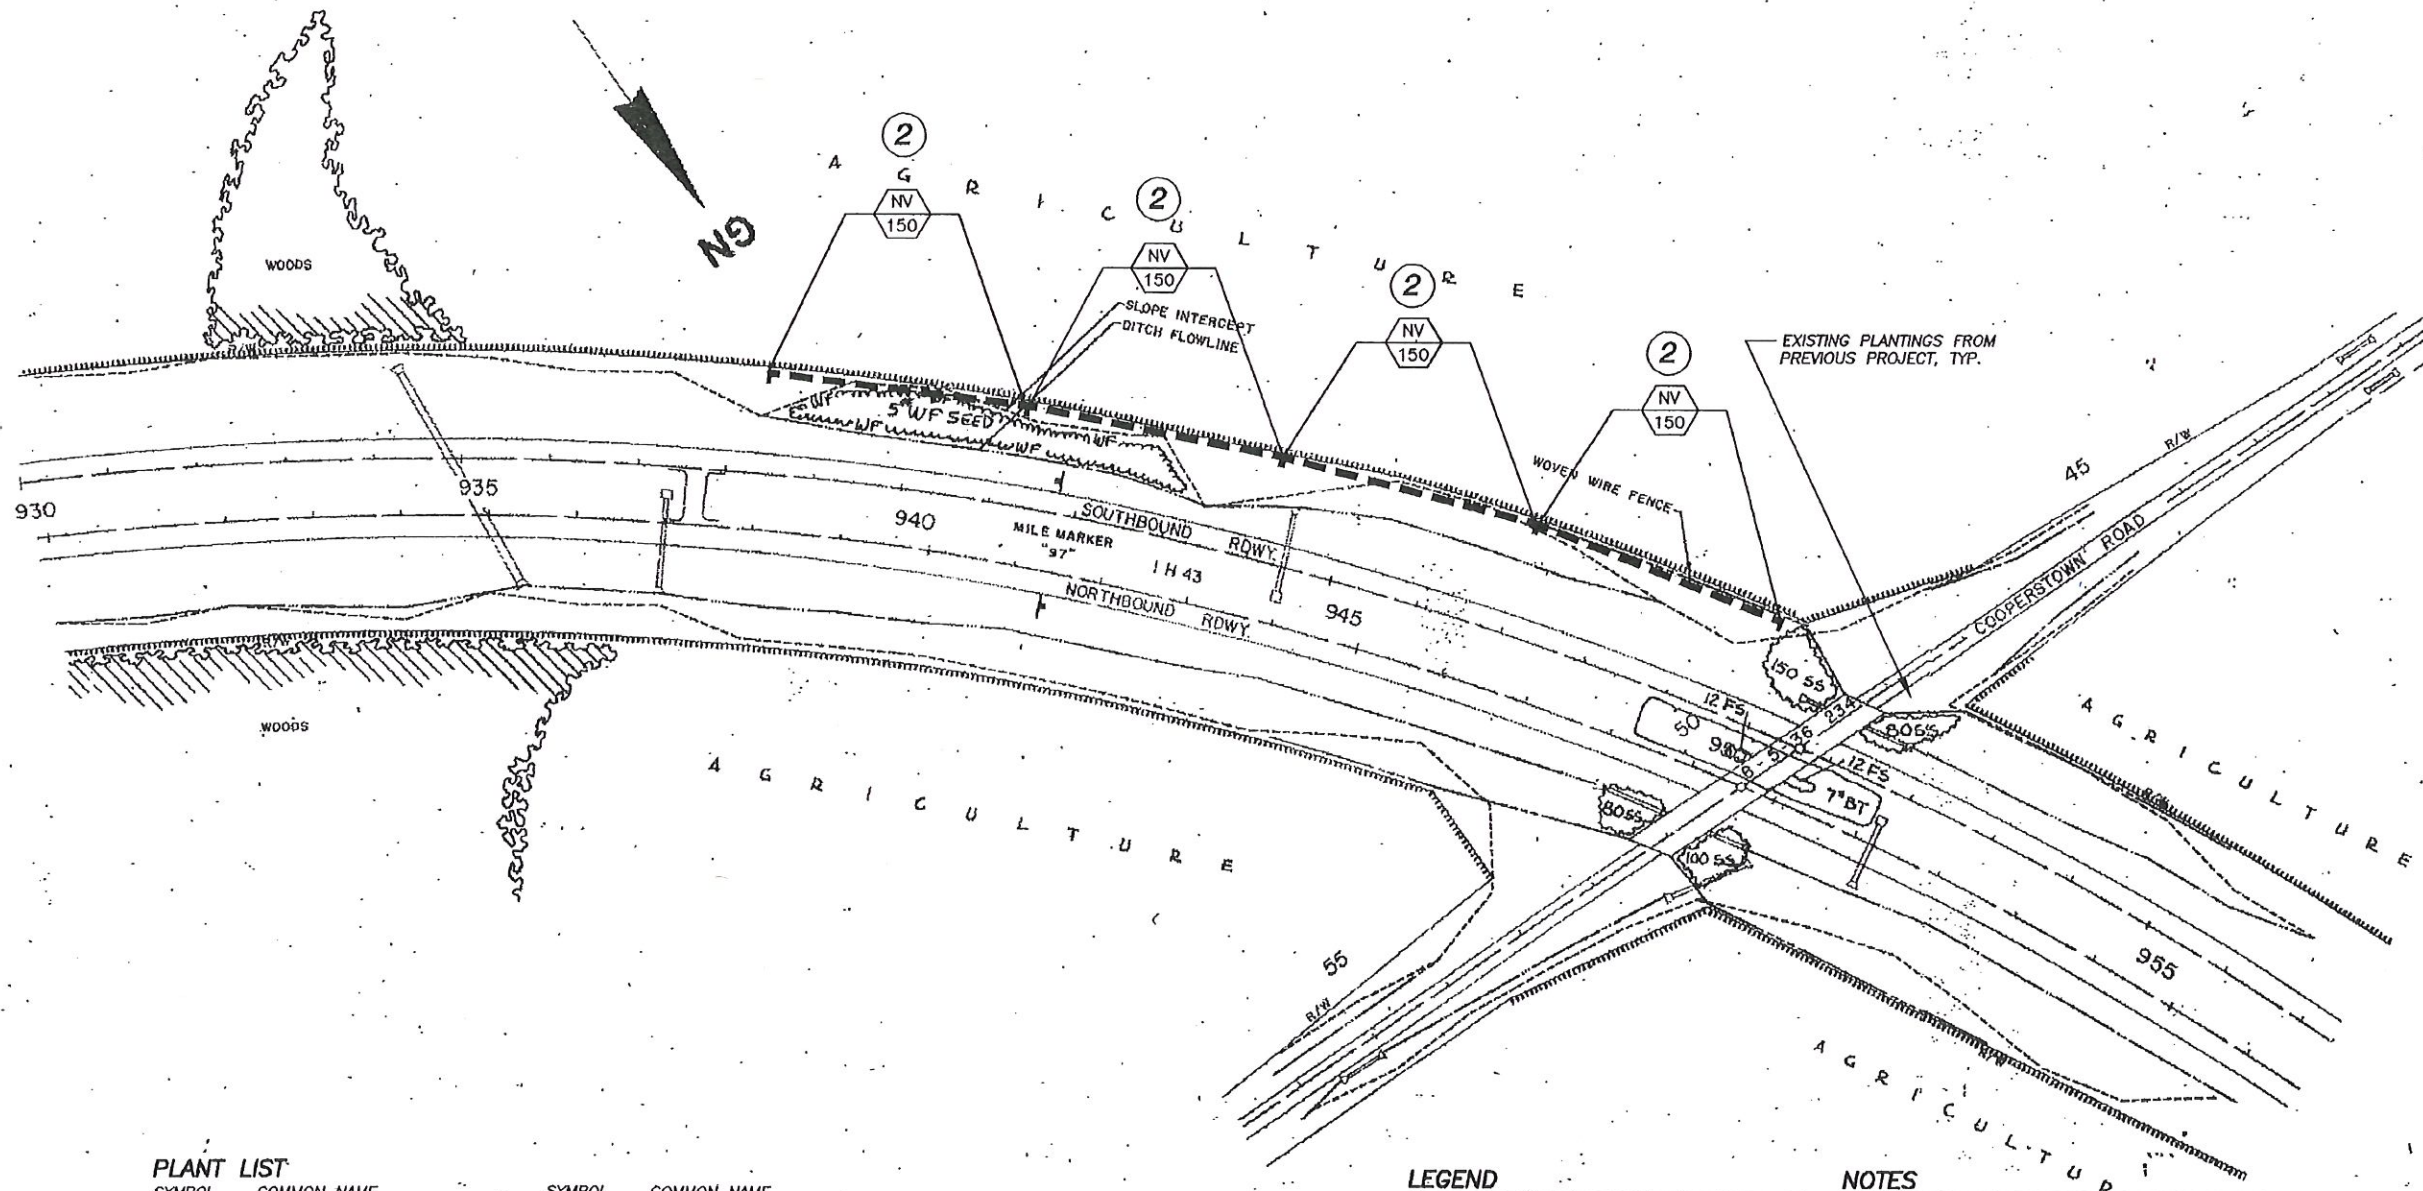

PLANT LIST

SYMBOL	COMMON NAME	SYMBOL	COMMON NAME
GD	Dogwood, Gray	BV	Viburnum, Blackhaw
RD	Dogwood, Redosier	ACV	Viburnum, Cranberrybush
CN	Ninebark, Common	NV	Viburnum, Nannyberry
AV	Viburnum, Arrowwood	AF	Filbert, American

LEGEND

- DECIDUOUS SHRUBS AND BED LIMITS
- 2 PLANT BED DETAIL DESIGNATION
- XX PLANT SYMBOL
- 0 QUANTITY

NOTES

1. REFER TO SHEET NO. 5.0 FOR GENERAL NOTES.

STATE PROJECT NUMBER: 1000-01-81	HWY: IH 43 - GREEN BAY	COUNTY: BROWN AND MANITOWOC	SCALE, FEET 0 100 200	SHEET NO: 5.5	E
FILE NAME: 5.5.DWG	PLOT DATE: 8/3/00	ORG DATE:	PLOT NAME:	ORIGINATOR:	PLOT SCALE:

SCHMELTZER DESIGN, INC. PROJECT NO. 00010

LEGEND

DECIDUOUS SHRUBS AND BED LIMITS

2 PLANT BED DETAIL DESIGNATION

XX PLANT SYMBOL
0 QUANTITY


NOTES

1. REFER TO SHEET NO. 5.0 FOR GENERAL NOTES.


PLANT LIST

SYMBOL	COMMON NAME	SYMBOL	COMMON NAME
GD	Dogwood, Gray	BV	Viburnum, Blackhaw
RD	Dogwood, Redosier	ACV	Viburnum, Cranberrybush
CN	Ninebark, Common	NV	Viburnum, Nannyberry
AV	Viburnum, Arrowwood	AF	Filbert, American

LETTERS ONLY: 2, 3, 4, 62, 63

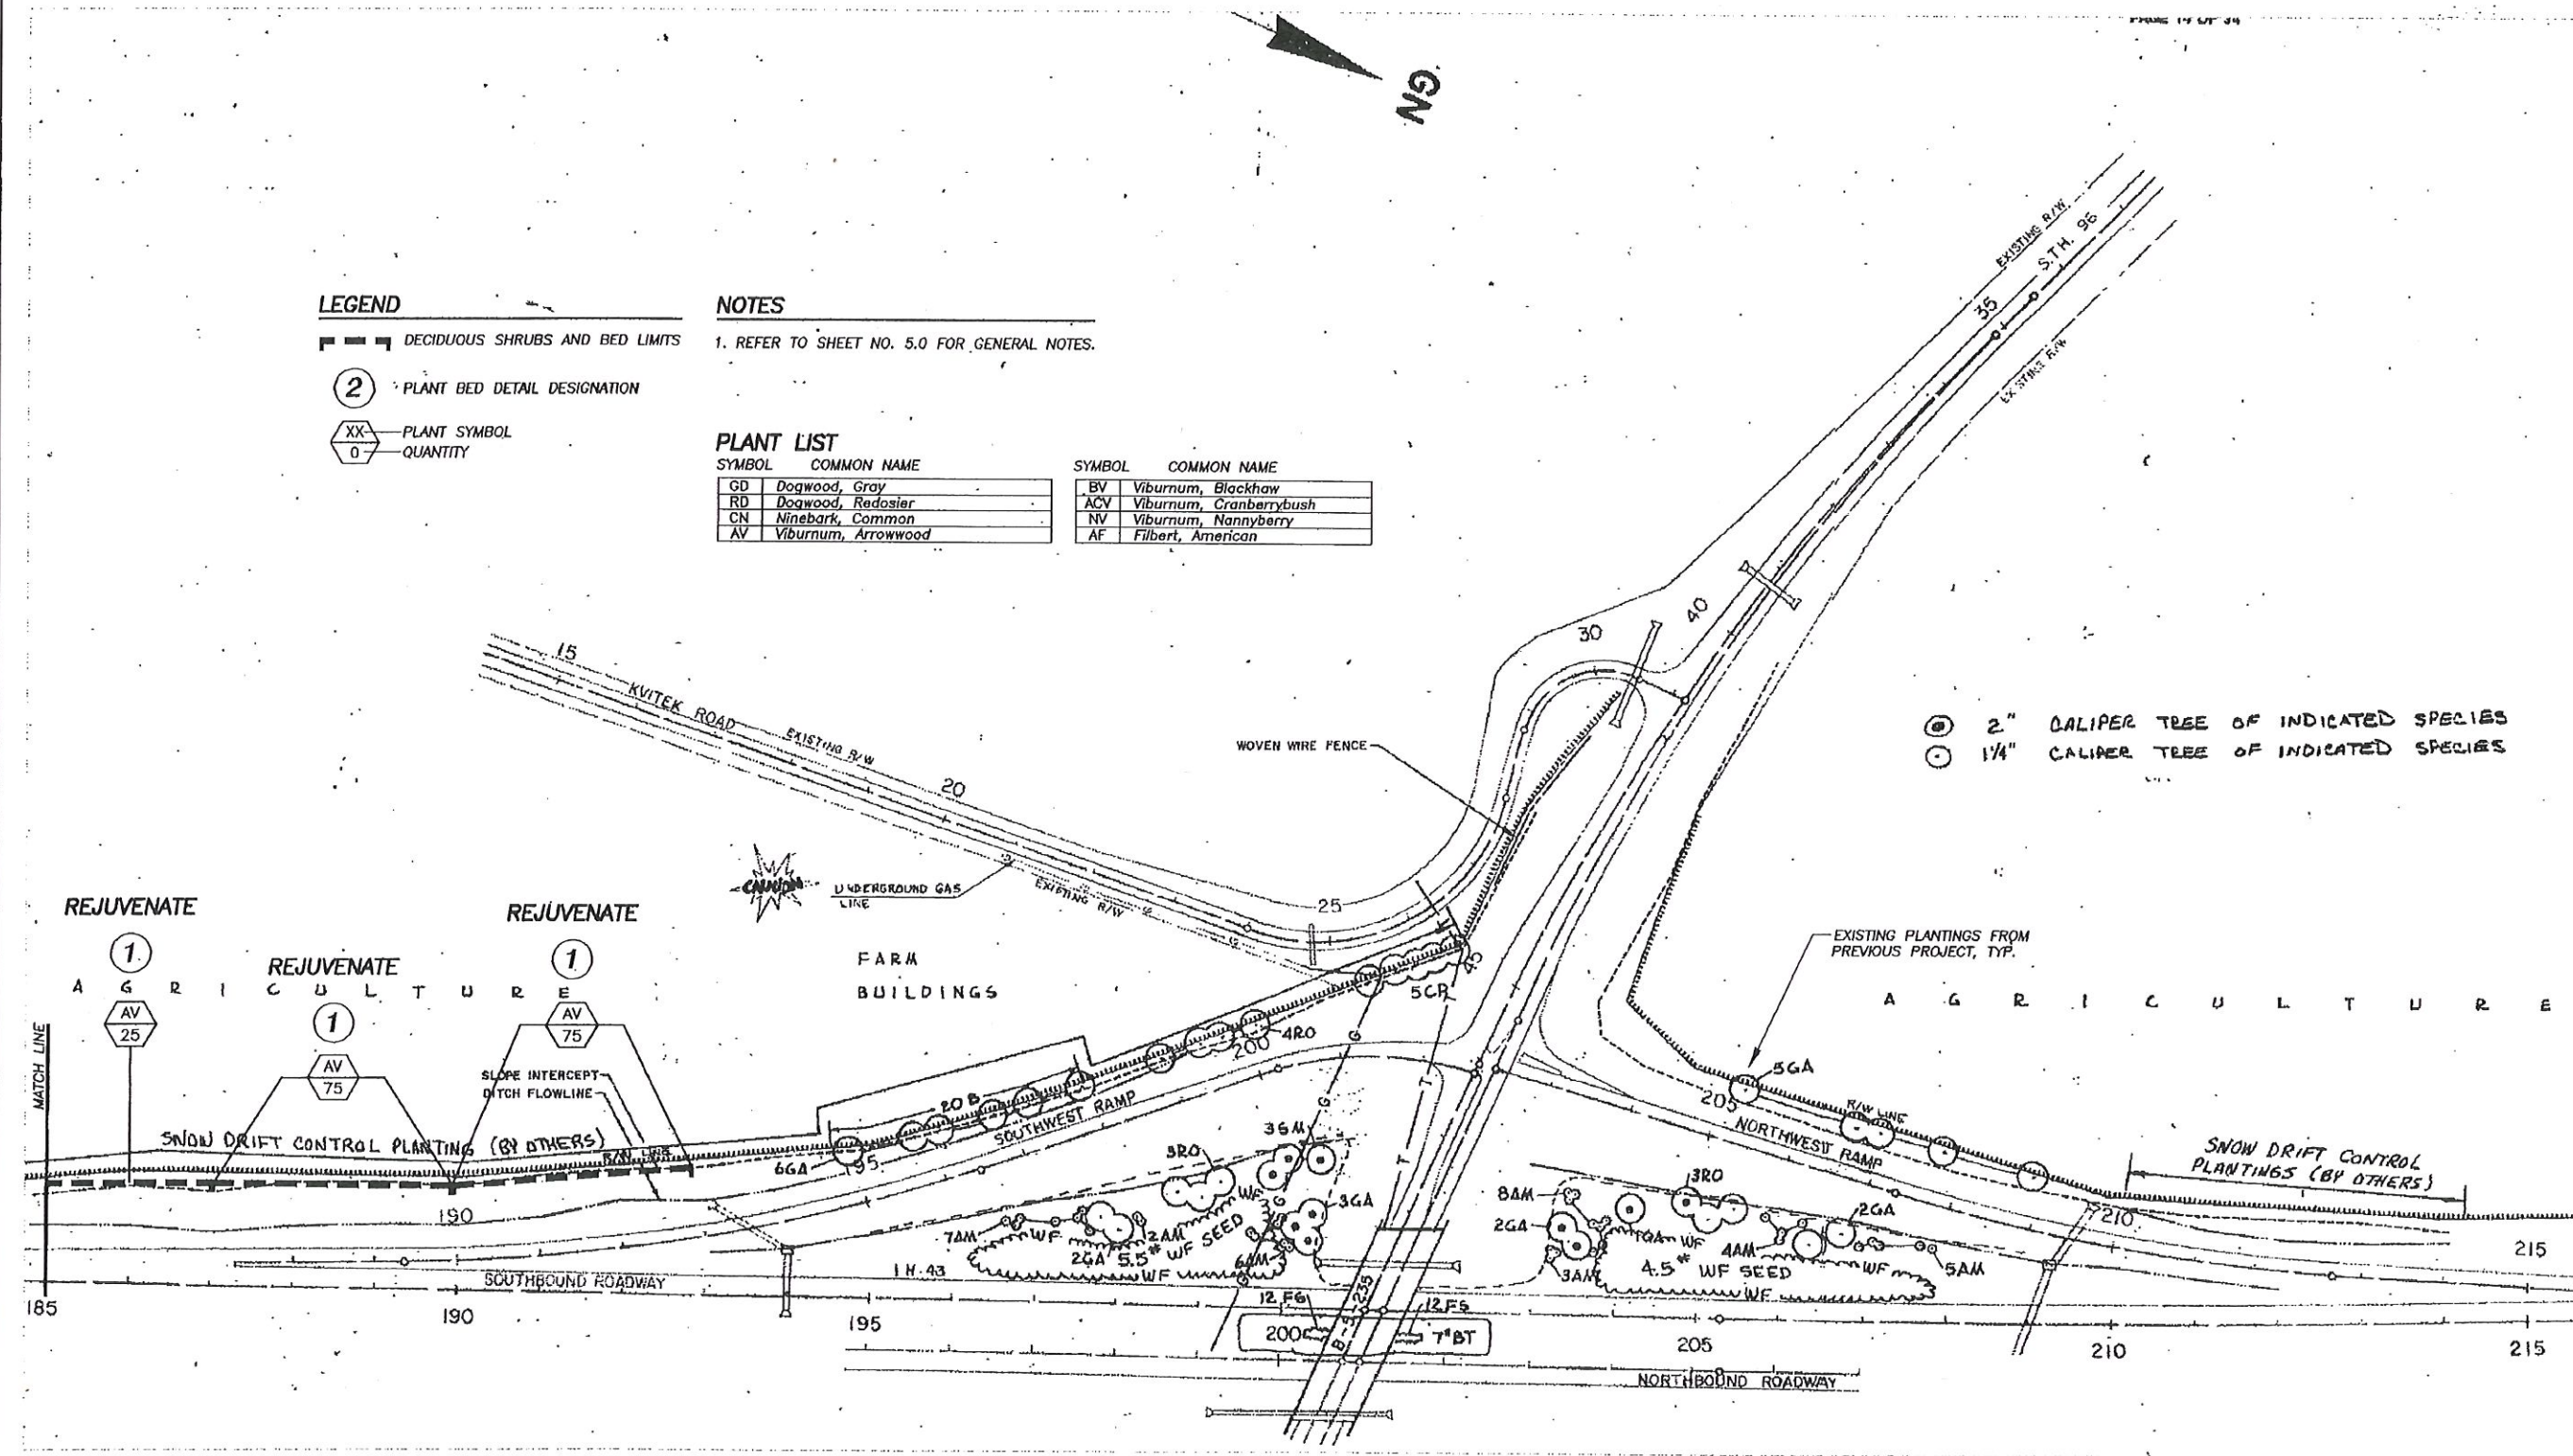

LETBLS ON 1# 3, 4, 6, 7, 8, 62, 63

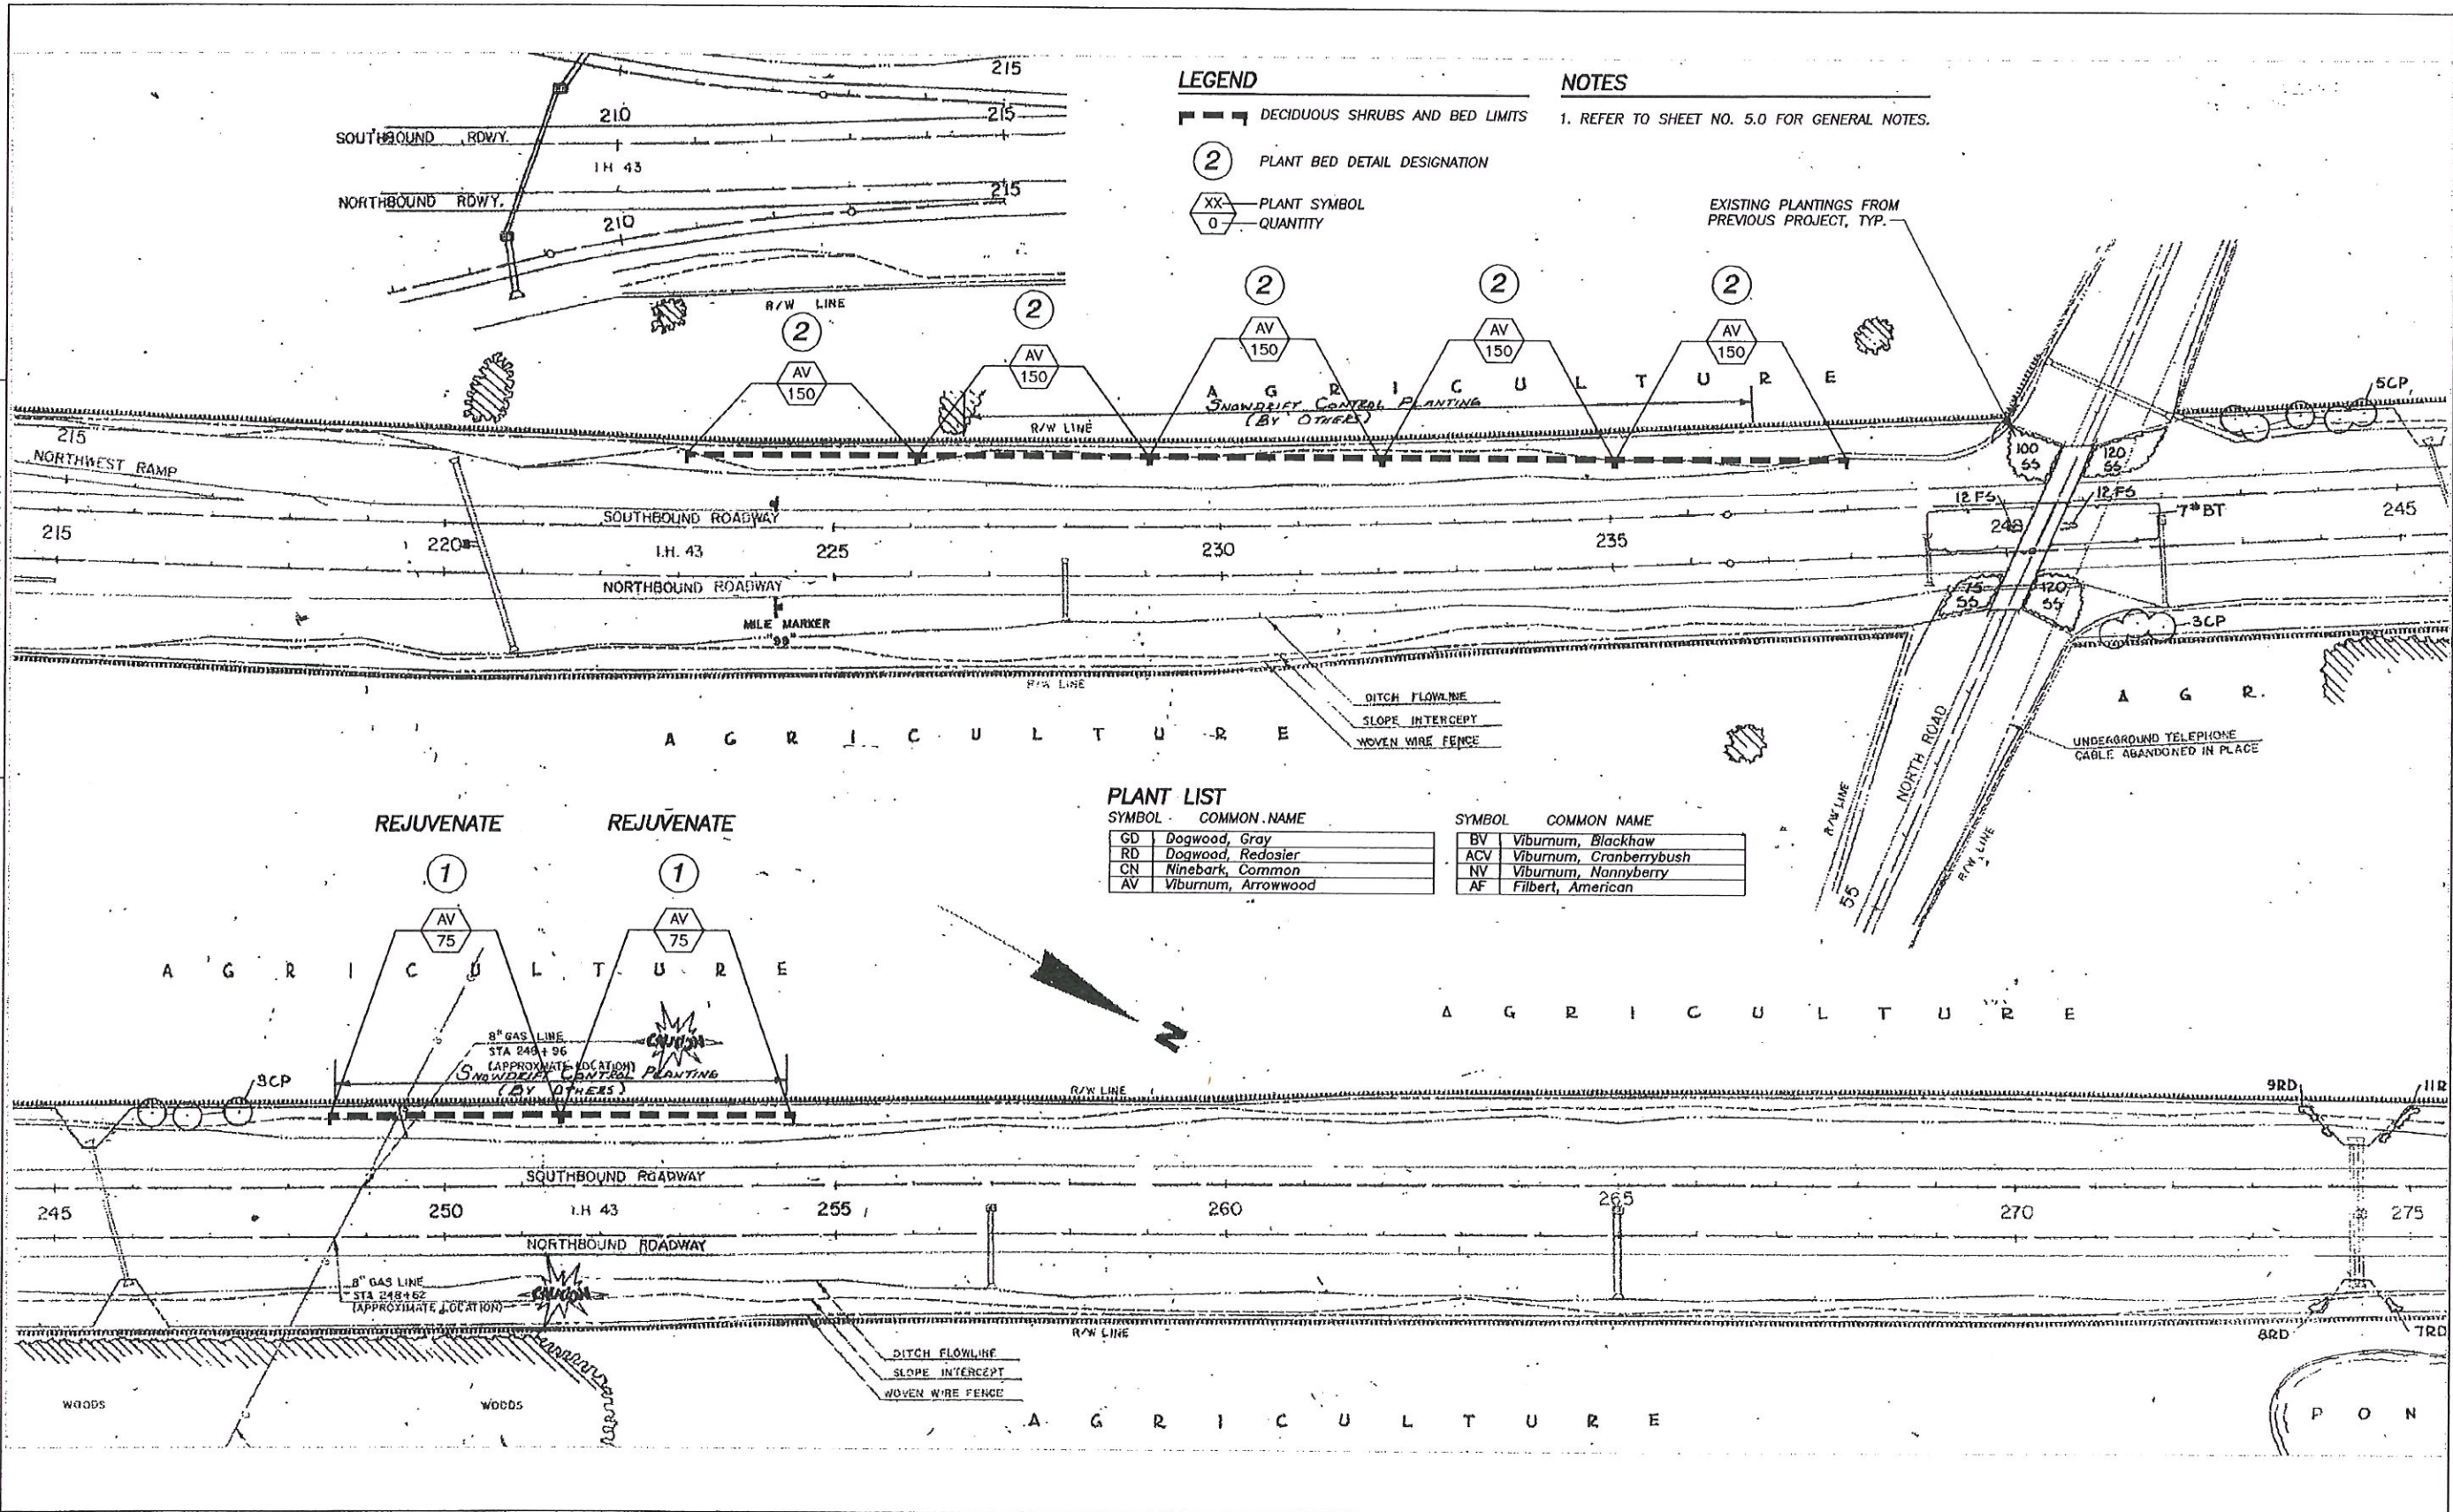

LEGEND

- DECIDUOUS SHRUBS AND BED LIMITS
- PLANT BED DETAIL DESIGNATION
- PLANT SYMBOL
- QUANTITY

NOTES

1. REFER TO SHEET NO. 5.0 FOR GENERAL NOTES.


PLANT LIST

SYMBOL	COMMON NAME	SYMBOL	COMMON NAME
GD	Dogwood, Gray	BV	Viburnum, Blackhaw
RD	Dogwood, Redosier	ACV	Viburnum, Cranberrybush
CN	Ninebark, Common	NV	Viburnum, Nannyberry
AV	Viburnum, Arrowwood	AF	Filbert, American

STATE PROJECT NUMBER: 1000-01-81	HWY: IH 43 - GREEN BAY	COUNTY: BROWN AND MANITOWOC	SCALE, FEET 0 100 200	SHEET NO: 5.9	E
FILE NAME: 5.9.DWG	PLOT DATE: 8/3/00	ORG DATE:	PLOT NAME:	ORIGINATOR:	PLOT SCALE:


SCHMELTZER DESIGN, INC. PROJECT NO. 00010

121314101617, 20, 22, 23, 24, 25, 26, 27, 28, 29, 30, 31, 32, 33, 34, 35, 36, 37, 38, 39, 40, 41, 42, 43, 44, 45, 46, 47, 48, 49, 50, 51, 52, 53, 54, 55, 56, 57, 58, 59, 60, 61, 62, 63

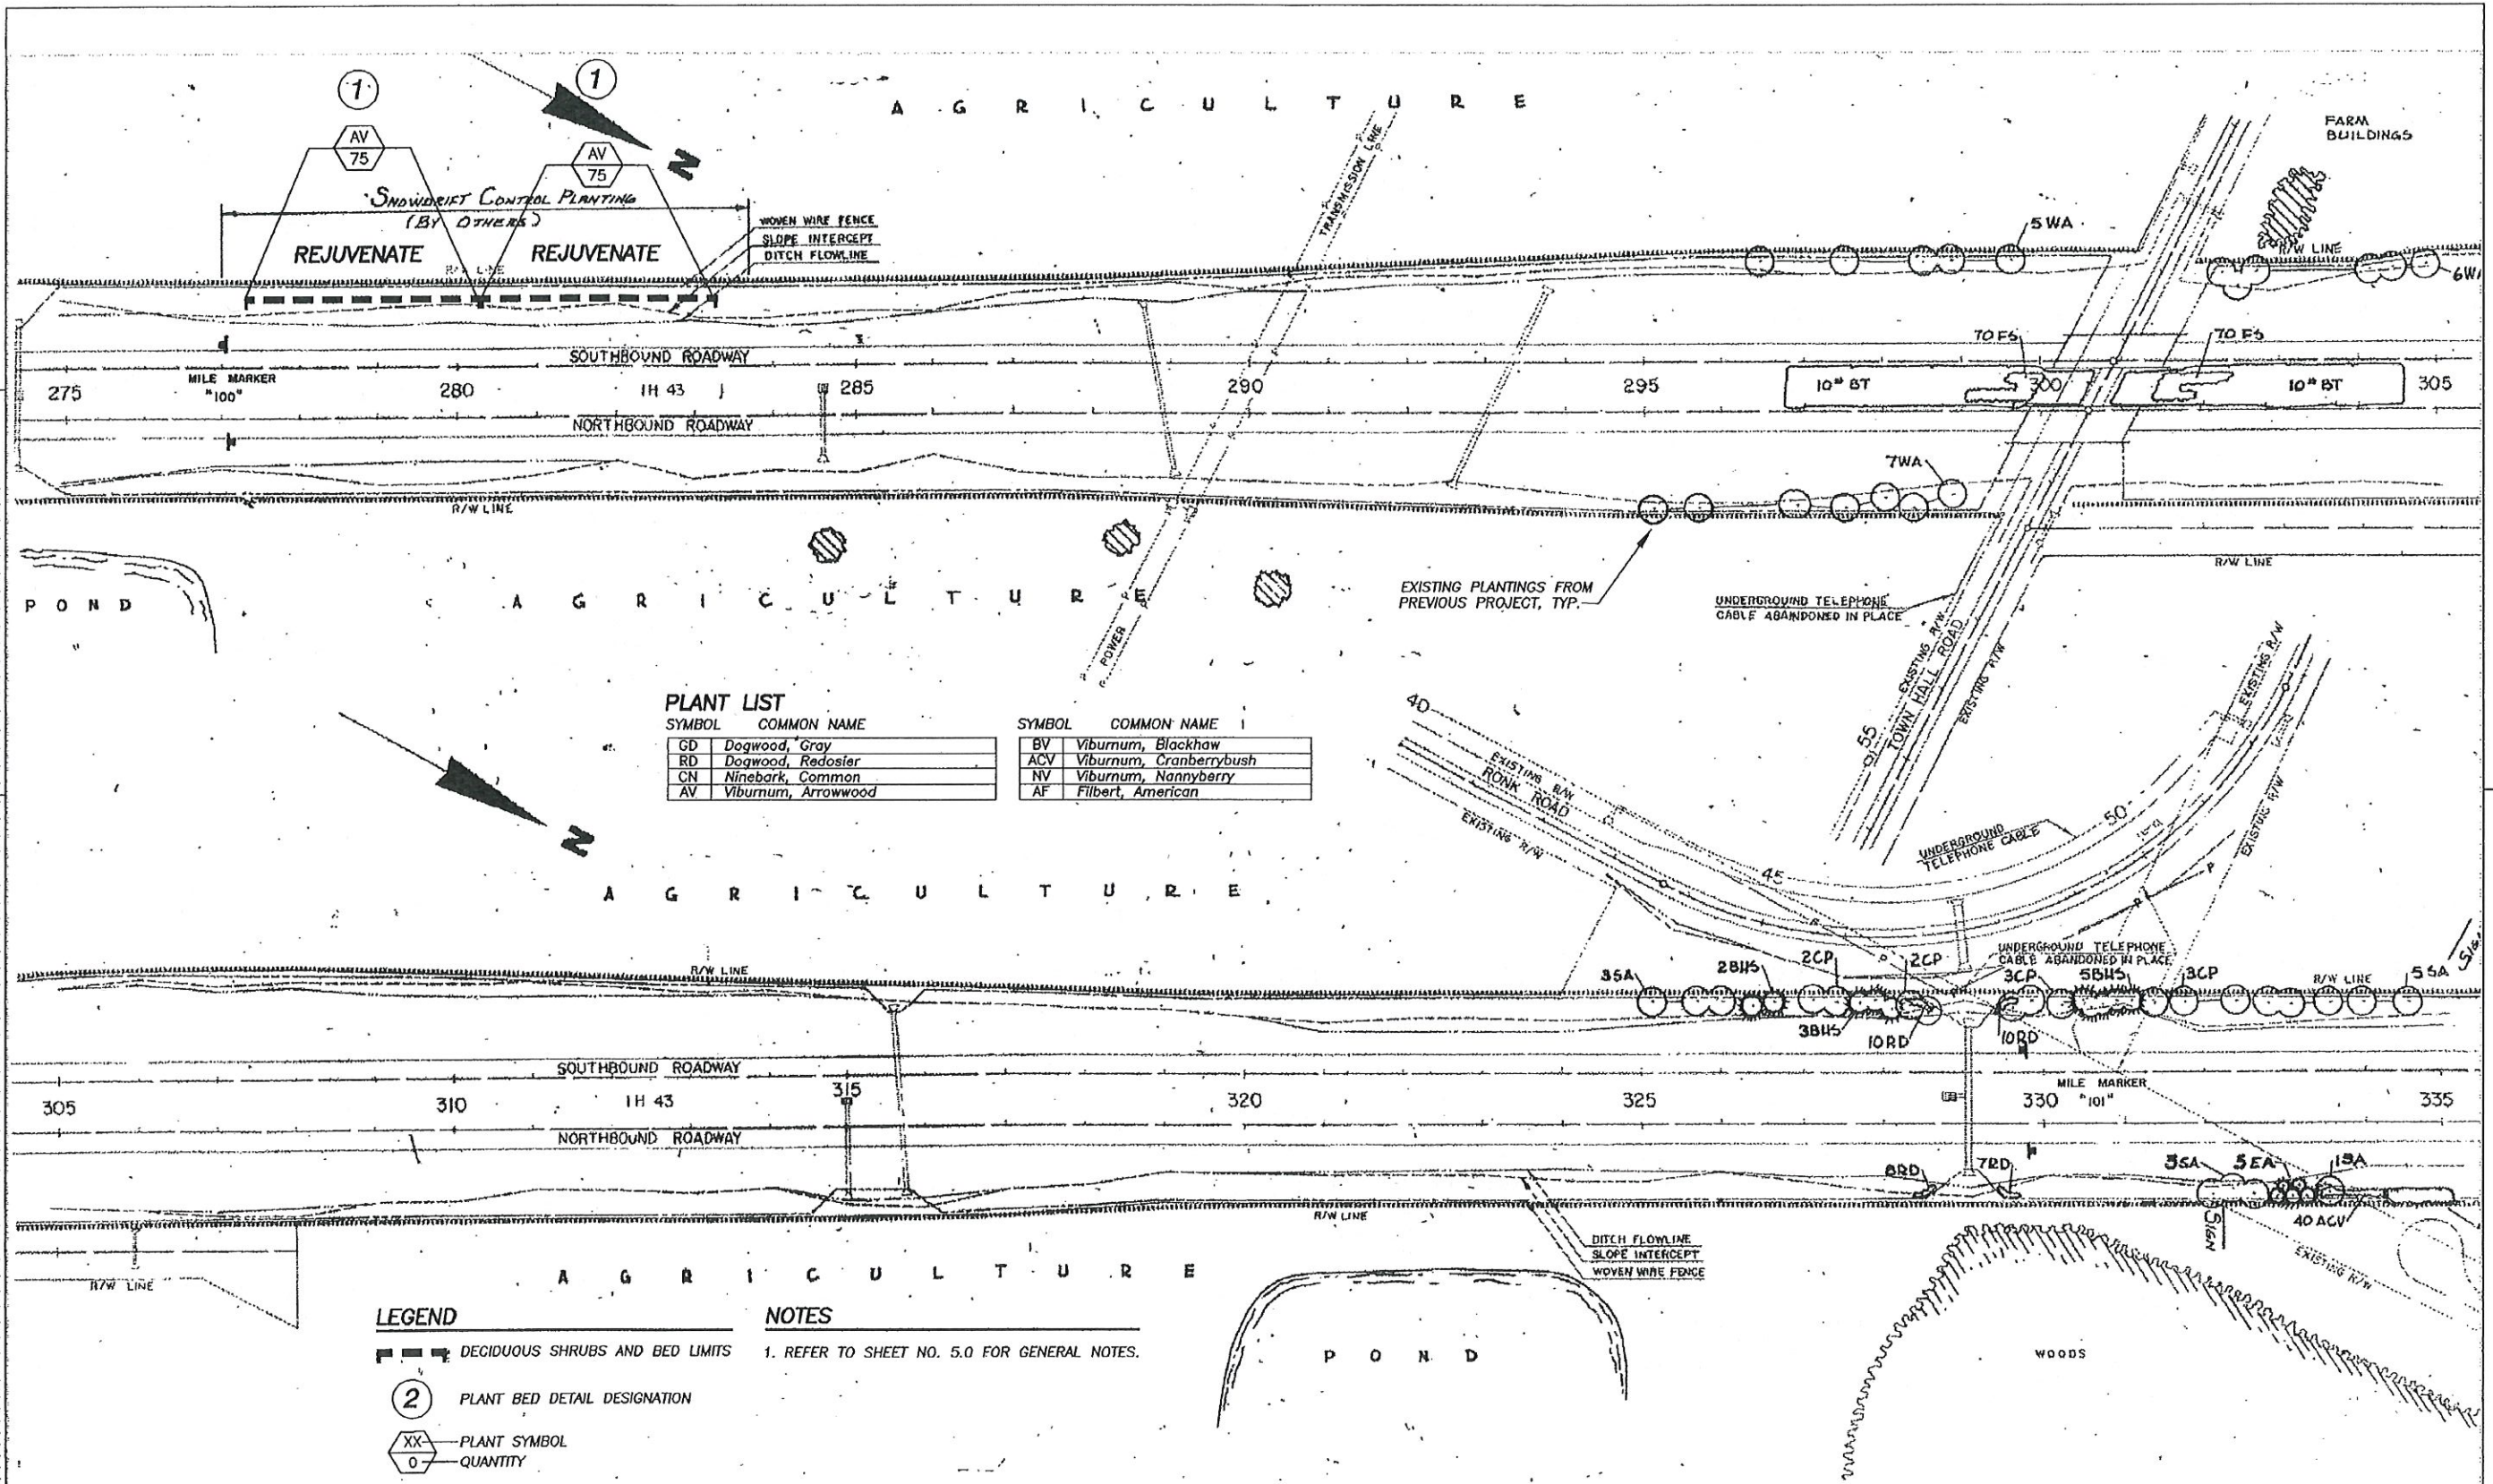

STATE PROJECT NUMBER: 1000-01-81	HWY: IH 43 - GREEN BAY	COUNTY: BROWN AND MANITOWOC	SCALE, FEET 0 100 200	SHEET NO: 5.10 E
FILE NAME: 5.10.DWG	PLOT DATE: 8/3/00	ORG DATE:	PLOT NAME:	ORIGINATOR: PLOT SCALE:
SCHMELTZER DESIGN, INC. PROJECT NO. 00010				

LETTERS ONLY 1,2,3,4,5,6,7,8,9,10,11,12,13,14,15,16,17,18,19,20,21,22,23,24,25,26,27,28,29,30,31,32,33,34,35,36,37,38,39,40,41,42,43,44,45,46,47,48,49,50,51,52,53,54,55,56,57,58,59,60,61,62,63

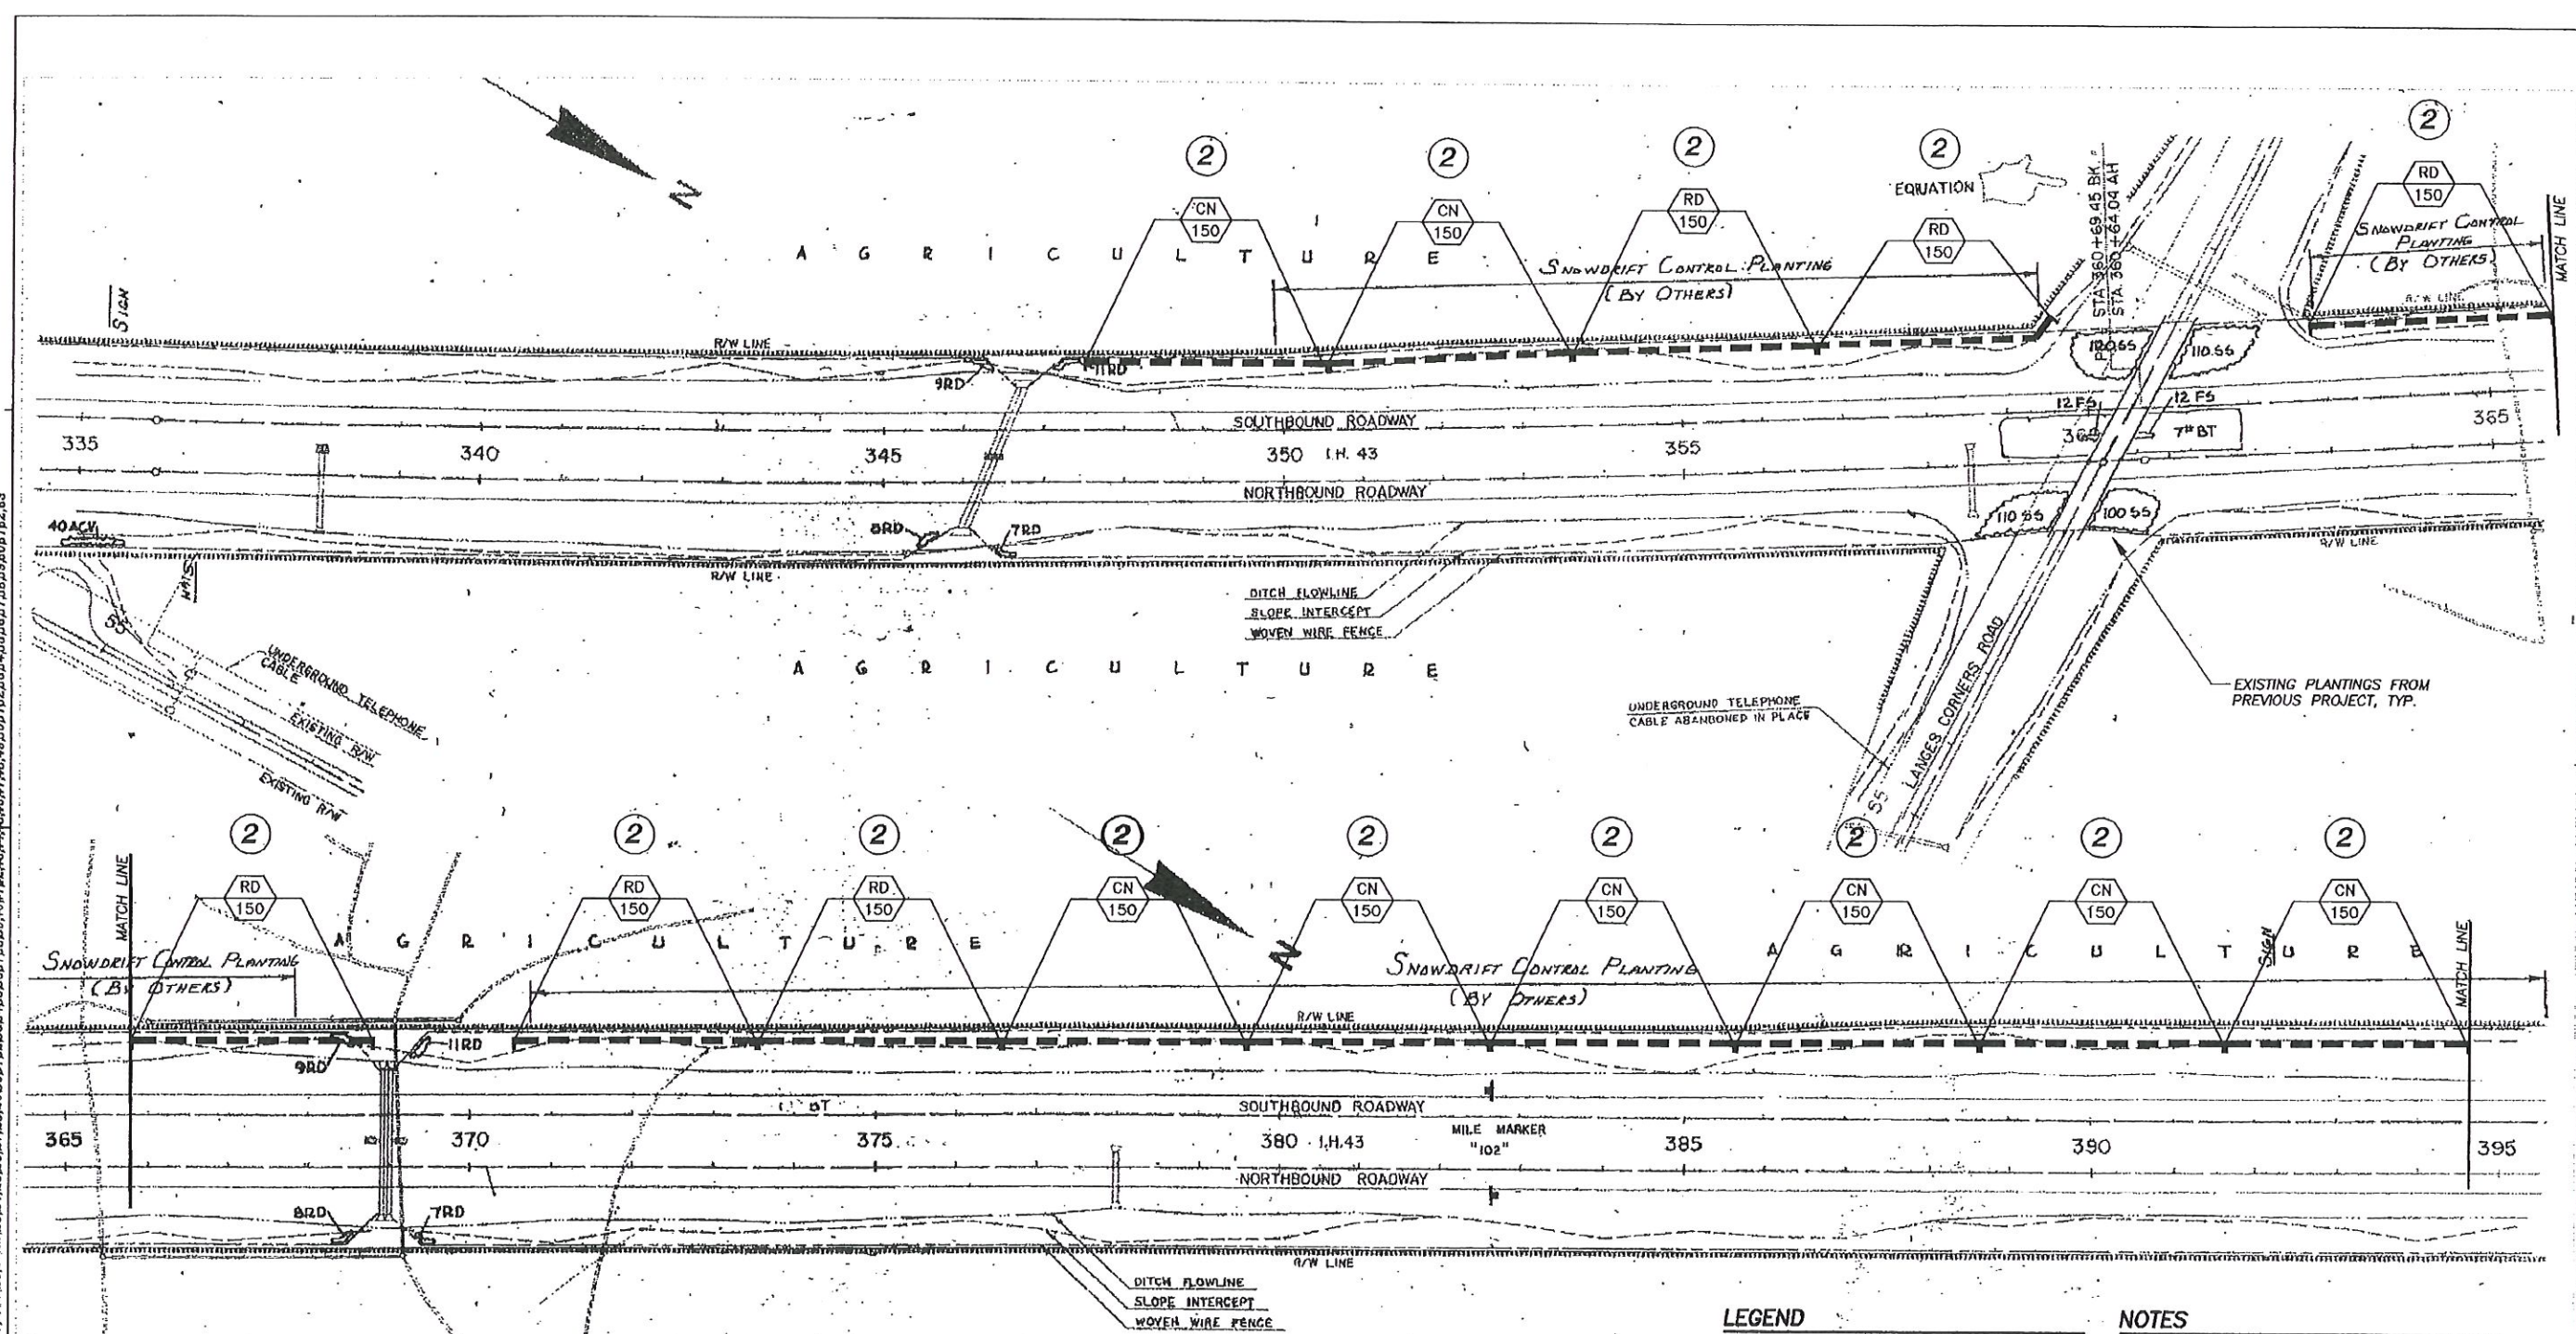

PLANT LIST

SYMBOL	COMMON NAME
GD	Dogwood, Gray
RD	Dogwood, Redosier
CN	Ninebark, Common
AV	Viburnum, Arrowwood

SYMBOL	COMMON NAME
BV	Viburnum, Blackhaw
ACV	Viburnum, Cranberrybush
NV	Viburnum, Nannyberry
AF	Filbert, American

LEGEND


- DECIDUOUS SHRUBS AND BED LIMITS
- 2 PLANT BED DETAIL DESIGNATION
- XX PLANT SYMBOL
- 0 QUANTITY

NOTES

- REFER TO SHEET NO. 5.0 FOR GENERAL NOTES.

STATE PROJECT NUMBER: 1000-01-81	HWY: IH 43 - GREEN BAY	COUNTY: BROWN AND MANITOWOC	SCALE, FEET 0 100 200	SHEET NO: 5.11	E
FILE NAME: 5.11.DWG	PLOT DATE: 8/3/00	ORG DATE:	PLOT NAME:	ORIGINATOR:	PLOT SCALE:
SCHMELTZER DESIGN, INC. PROJECT NO. 00010					

LEVELS 001#2,3,4,5,6,7,8,9,10,11,12,13,14,15,16,17,18,19,20,21,22,23,24,25,26,27,28,29,30,31,32,33,34,35,36,37,38,39,40,41,42,43,44,45,46,47,48,49,50,51,52,53,54,55,56,57,58,59,60,61,62,63

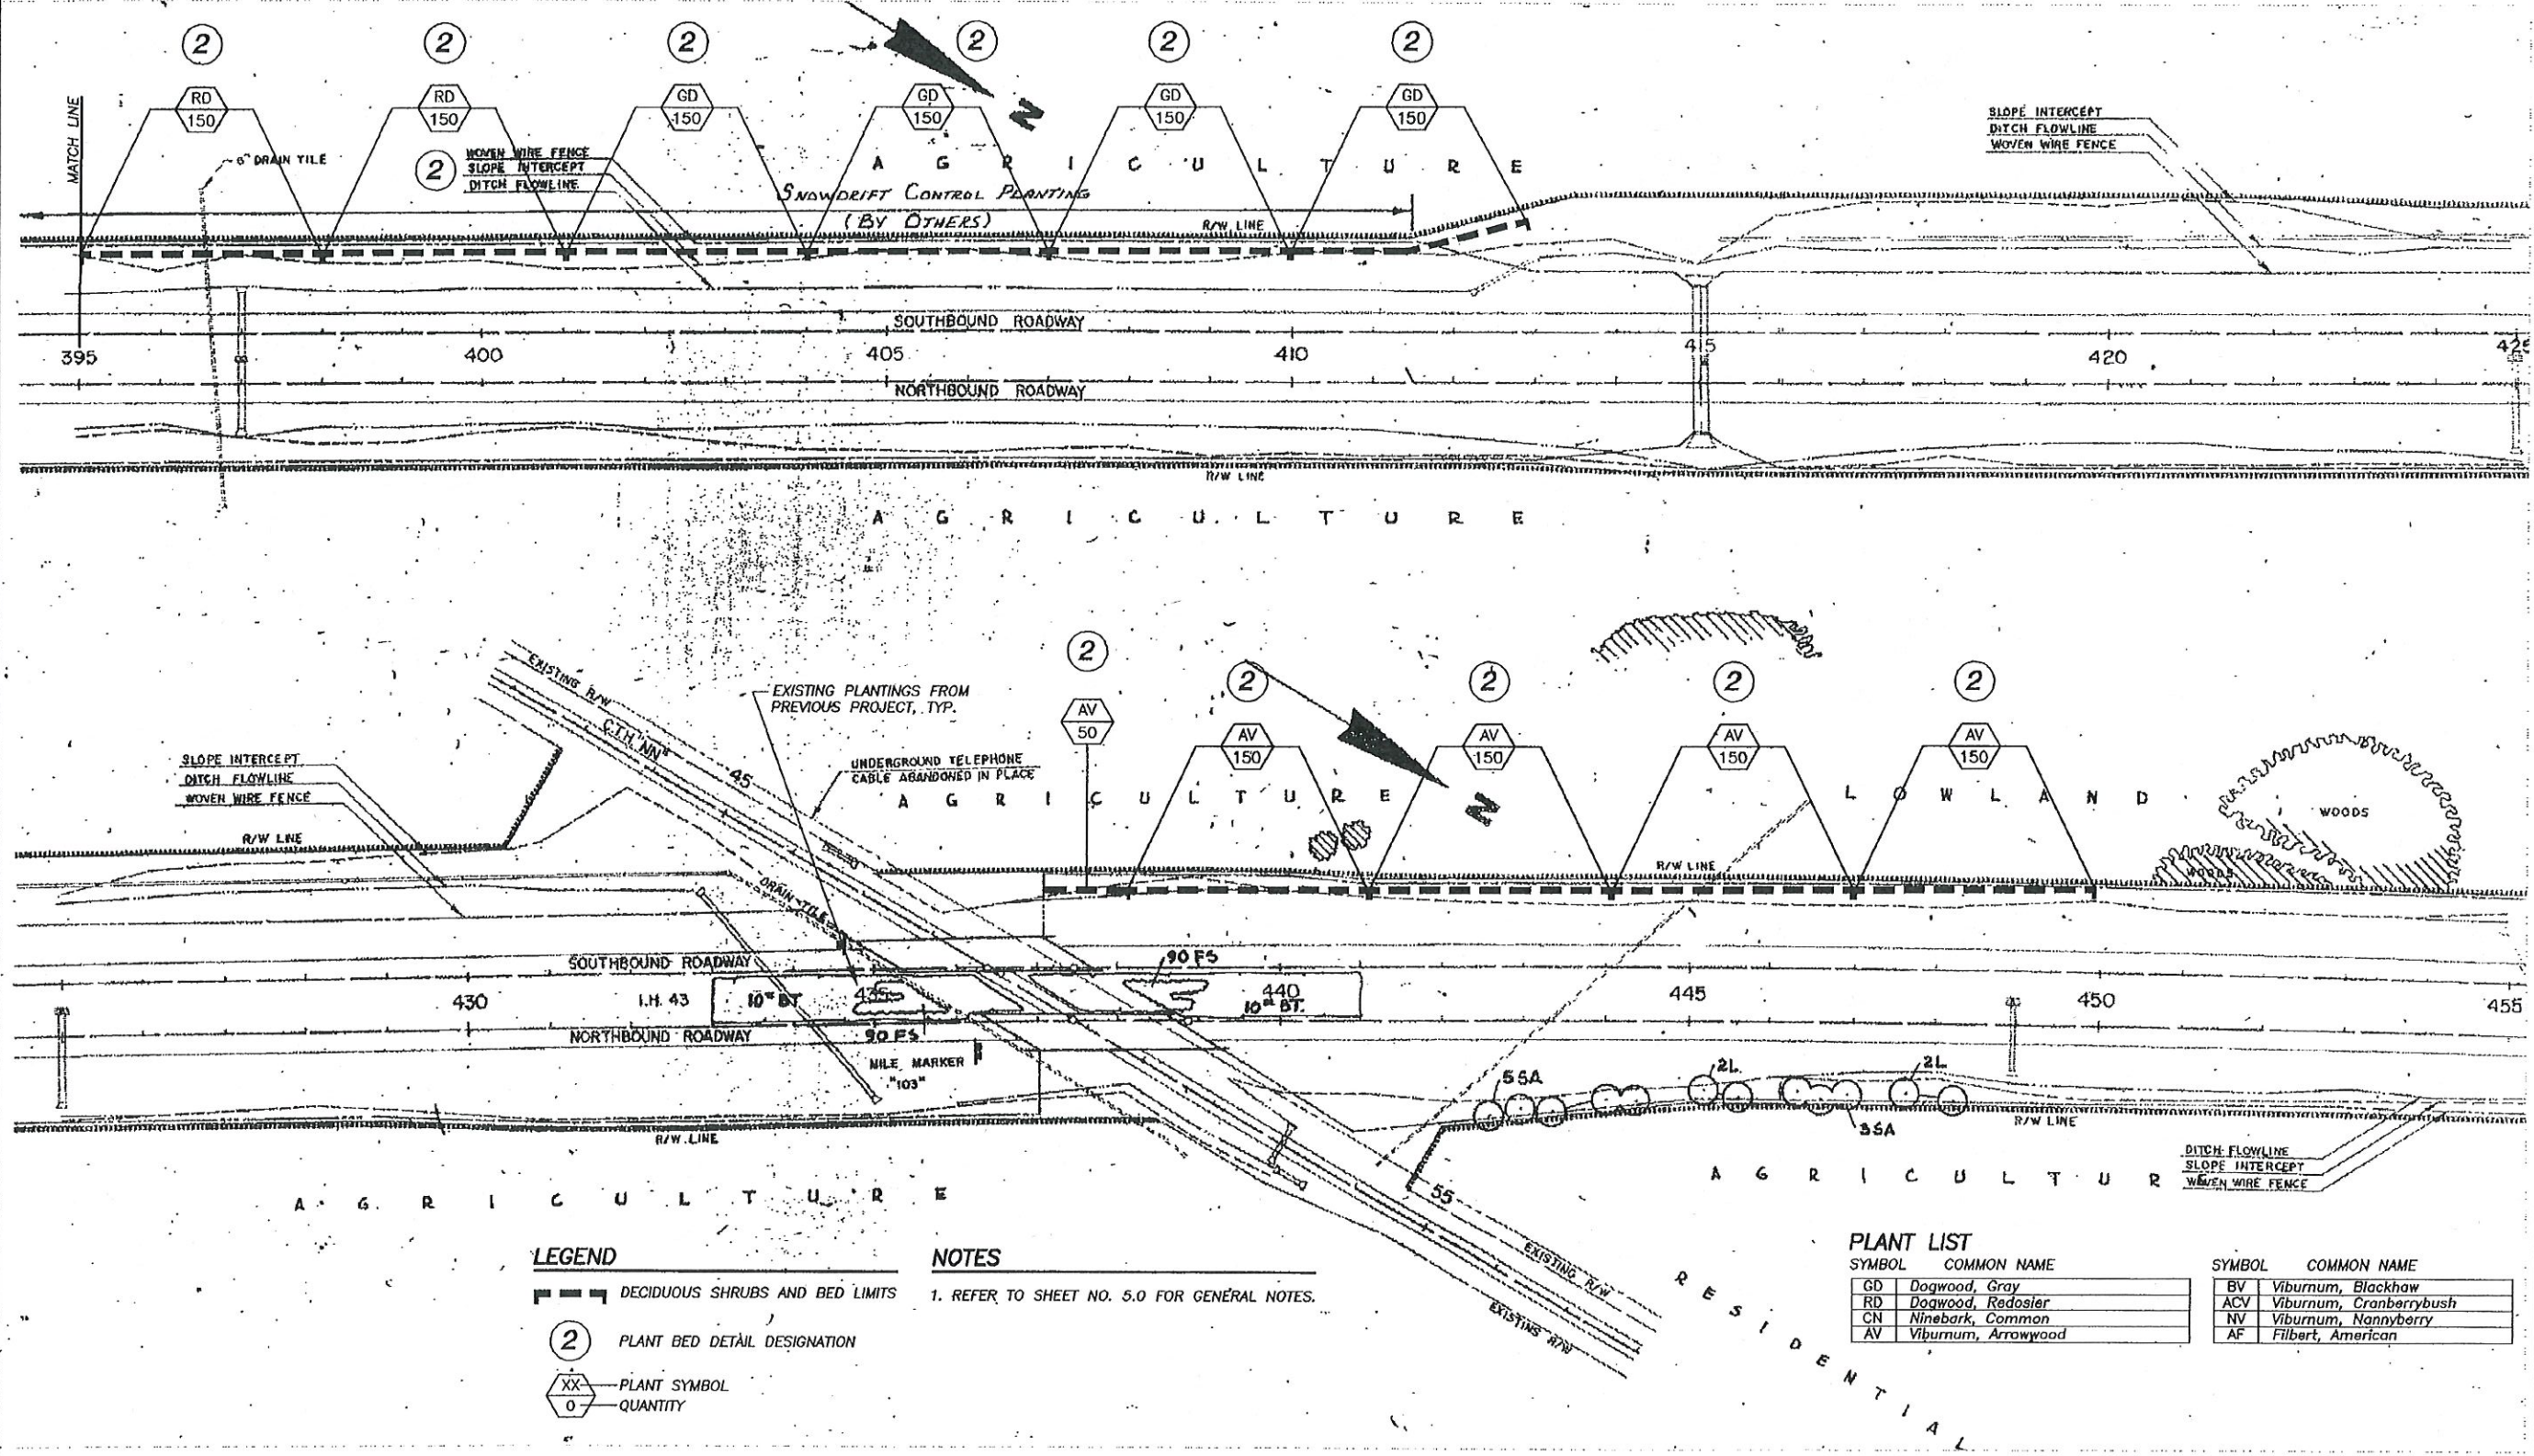

- LEGEND**
- DECIDUOUS SHRUBS AND BED LIMITS
 - 2 PLANT BED DETAIL DESIGNATION
 - XX PLANT SYMBOL
 - 0 QUANTITY


NOTES

1. REFER TO SHEET NO. 5.0 FOR GENERAL NOTES.

PLANT LIST

SYMBOL	COMMON NAME	SYMBOL	COMMON NAME
GD	Dogwood, Gray	BV	Viburnum, Blackhaw
RD	Dogwood, Redosier	ACV	Viburnum, Cranberrybush
CN	Ninebark, Common	NV	Viburnum, Nannyberry
AV	Viburnum, Arrowwood	AF	Filbert, American

STATE PROJECT NUMBER: 1000-01-81	HWY: IH 43 - GREEN BAY	COUNTY: BROWN AND MANITOWOC	SCALE, FEET 0 100 200	SHEET NO: 5.12 E
FILE NAME: 5.12.DWG	PLOT DATE: 8/3/00	ORG DATE:	PLOT NAME:	ORIGINATOR: PLOT SCALE:
SCHMELTZER DESIGN, INC. PROJECT NO. 00010				

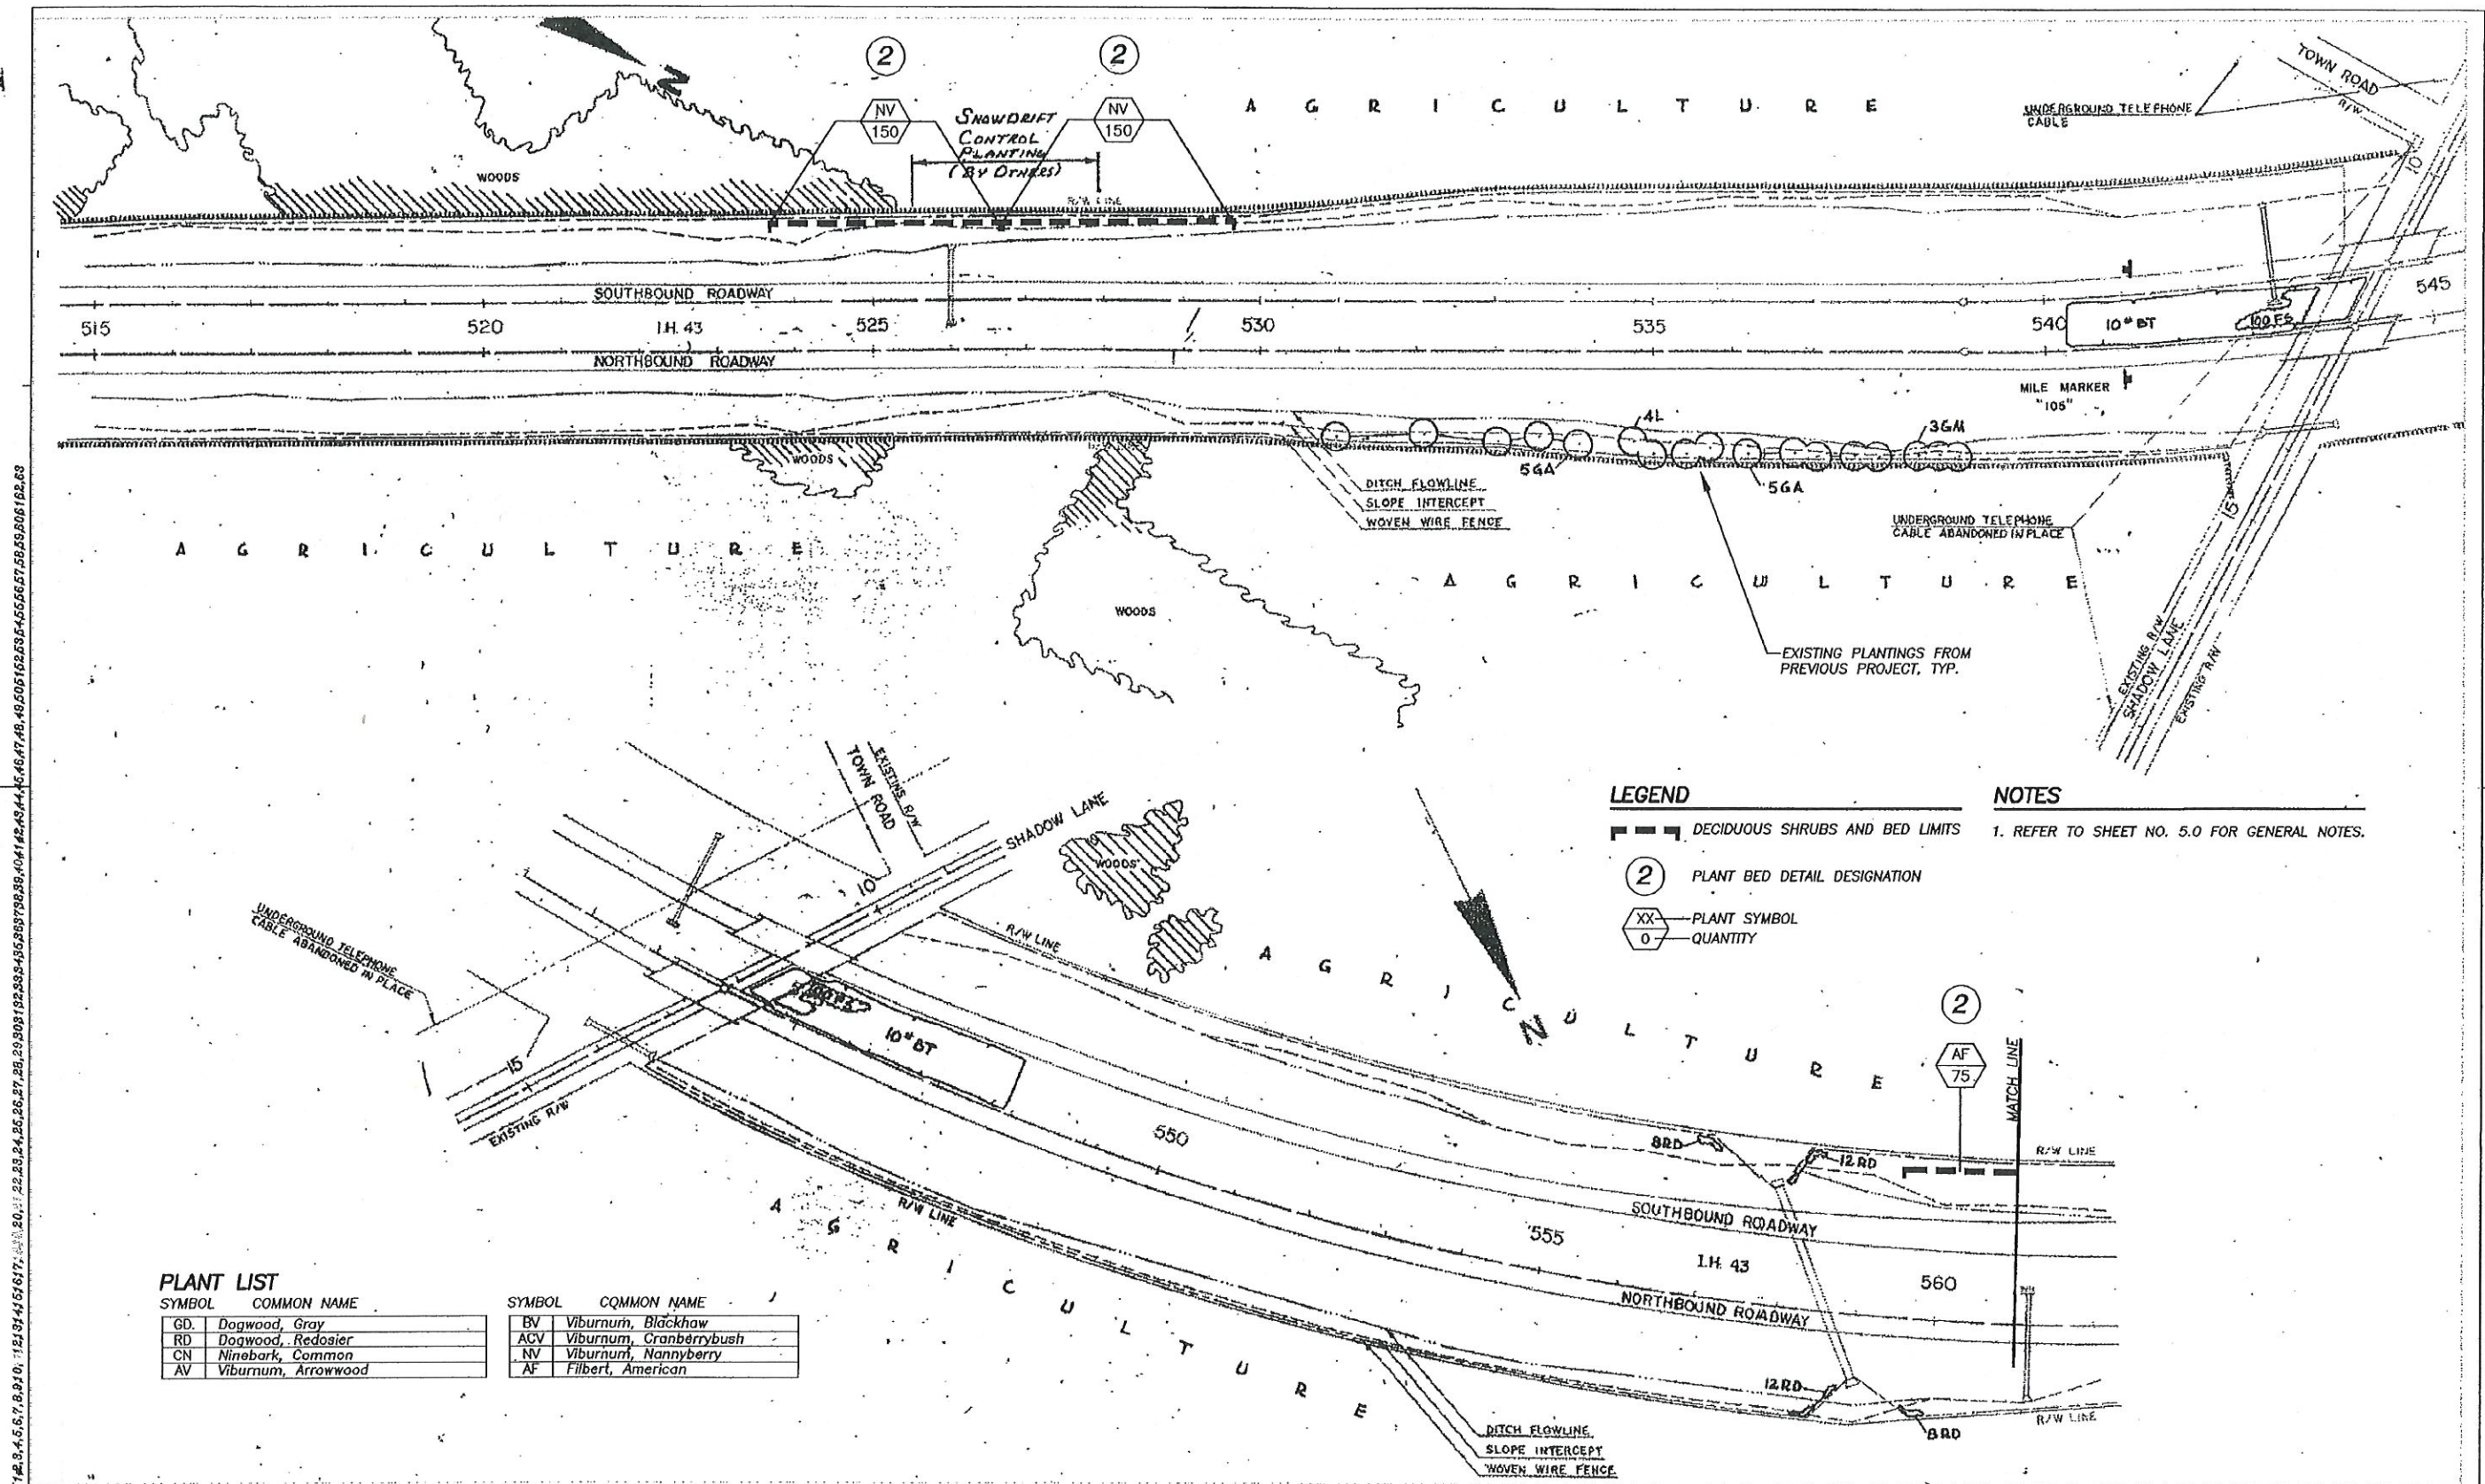

PLANT LIST

LEGEND

NOTES

STATE PROJECT NUMBER: 1000-01-81		HWY: IH 43 - GREEN BAY		COUNTY: BROWN AND MANITOWOC		SCALE, FEET 		SHEET NO: 5.14		E	
FILE NAME: 5.14.DWG		PLOT DATE: 8/3/00		ORG DATE:		PLOT NAME:		ORIGINATOR:		PLOT SCALE:	
SCHMELTZER DESIGN, INC. PROJECT NO. 00010											

