

COLEMAN ENGINEERING COMPANY

635 Circle Drive
IRON MOUNTAIN, MICHIGAN 49801
(906) 774-3440

JOB _____

SHEET NO. _____ OF _____

CALCULATED BY _____ DATE _____

CHECKED BY _____ DATE _____

SCALE _____

$\frac{5}{8}$ " Rebar w/CEC cap
set in NW Quadrant
of Dill Rd and US 41
using WisCoors


CP 900

North : 34 98 40.5 2
East : 71 82 86.8 6
Elev : 97 3. 00

A) 2.5' NW of B.O.C.

B) 40.7' West of $\odot$ US141

C) 18.5' N 72° E from stop sign

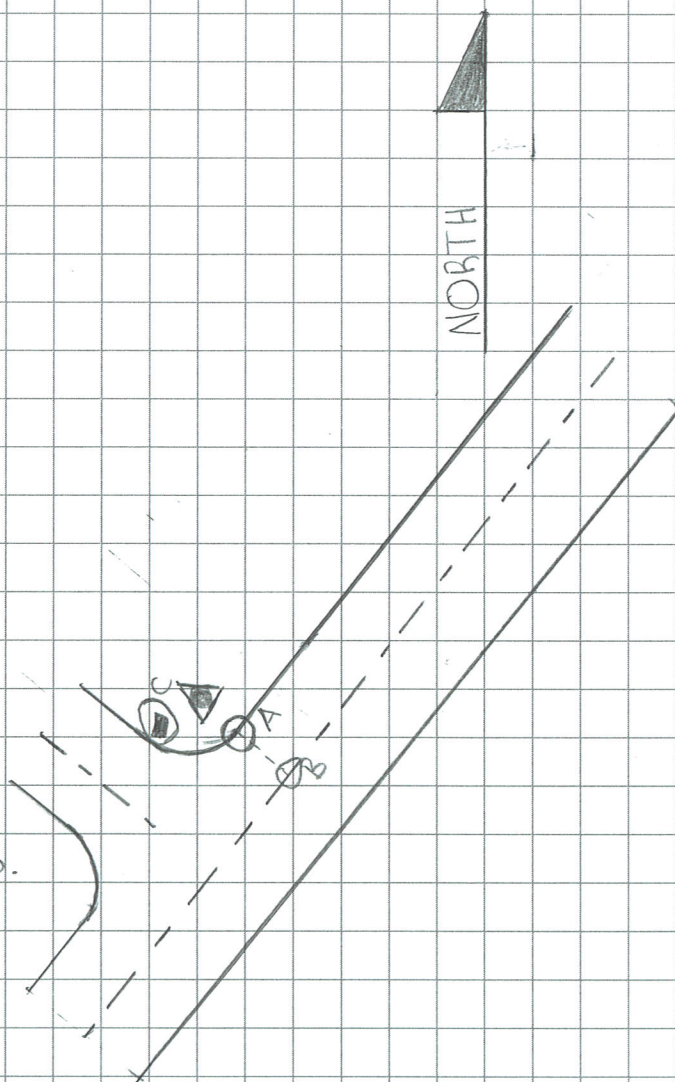

Coleman Engineering Co.
1491-21-00
17289

COLEMAN ENGINEERING COMPANY

635 Circle Drive
IRON MOUNTAIN, MICHIGAN 49801
(906) 774-3440

JOB _____

SHEET NO. _____ OF _____

CALCULATED BY _____ DATE _____

CHECKED BY _____ DATE _____

SCALE _____


$\frac{5}{8}$ " Rebar with CEC cap
set North side of
gravel driveway FN19126

CP 901

North : 34 84 32.57
East : 71 80 00.50
Elev : 974.10

A) 10' North of driveway FN19126

B) 32' East of $\angle$ Hwy 141

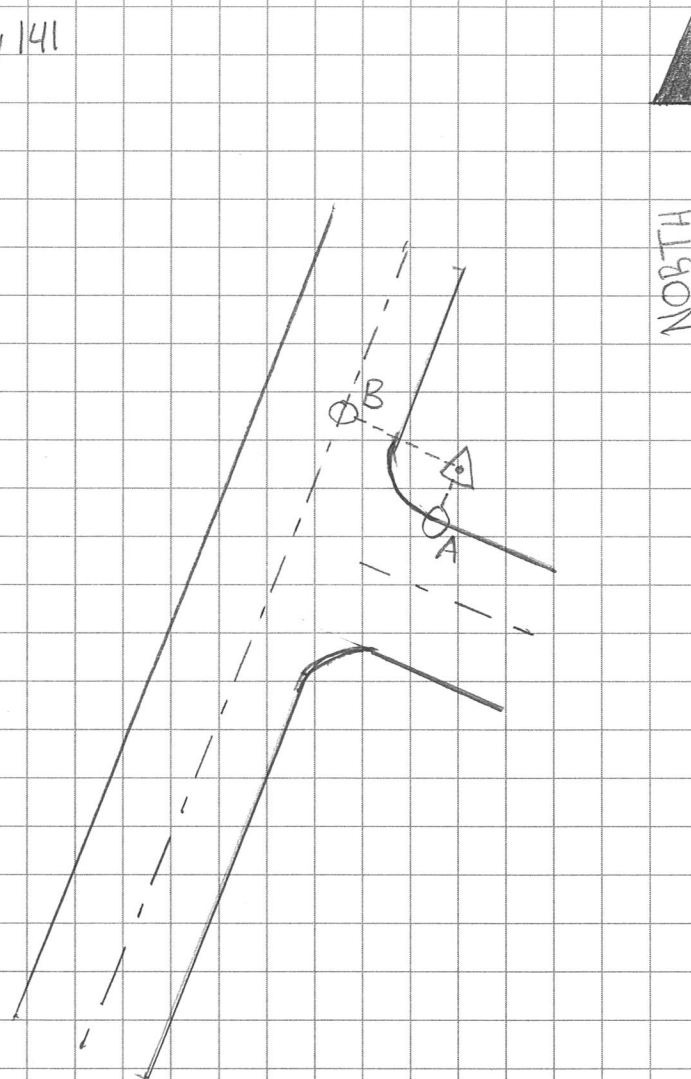

Coleman Engineering Co.
1491 - 21 - 00
17289