

4546-02-71

COUNTY:

BROWN COUNTY


FEBRUARY 2019

ORDER OF SHEETS

Section No.	1	Title
Section No.	2	Typical Sections and Details
Section No.	3	Estimate of Quantities
Section No.	3	Miscellaneous Quantities
Section No.	4	Right of Way Plat
Section No.	5	Plan and Profile
Section No.	6	Standard Detail Drawings
Section No.	7	Sign Plates
Section No.	8	Structure Plans
Section No.	9	Computer Earthwork Data
Section No.	9	Cross Sections

TOTAL SHEETS = 70








Sheets revised: 1, 3, 5, 9, 11, 38, 48

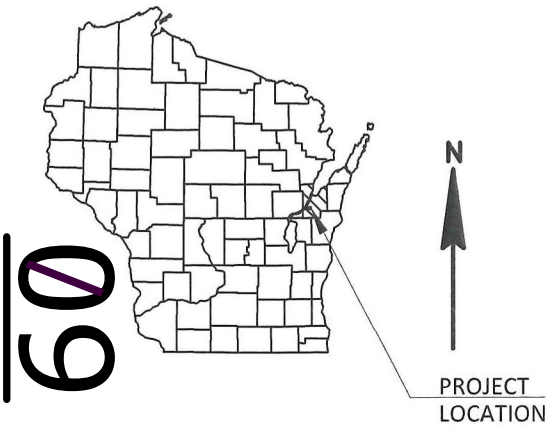

DESIGN DESIGNATION

A.A.D.T.	(2019)	=	2,300
A.A.D.T.	(2039)	=	3,300
D.H.V.		=	N/A
D.D.		=	60/40
T.		=	6.0%
DESIGN SPEED		=	50 MPH
ESALS		=	380,000

       CONVENTIONAL SYMBOLS

<u>PLAN</u>		<u>PROFILE</u>	
CORPORATE LIMITS		GRADE LINE	
PROPERTY LINE		ORIGINAL GROUND	
LOT LINE		MARSH OR ROCK PROFILE (To be noted as such)	
LIMITED HIGHWAY EASEMENT		SPECIAL DITCH	
EXISTING RIGHT OF WAY		GRADE ELEVATION	
PROPOSED OR NEW R/W LINE		CULVERT (Profile View)	
SLOPE INTERCEPT		<u>UTILITIES</u>	
REFERENCE LINE		ELECTRIC	
EXISTING CULVERT		FIBER OPTIC	
PROPOSED CULVERT (Box or Pipe)		GAS	
COMBUSTIBLE FLUIDS		SANITARY SEWER	
MARSH AREA		STORM SEWER	
WOODED OR SHRUB AREA		TELEPHONE	
		WATER	
		UTILITY PEDESTAL	
		POWER POLE	
		TELEPHONE POLE	

STATE OF WISCONSIN
DEPARTMENT OF TRANSPORTATION

PLAN OF PROPOSED IMPROVEMENT

T WRIGHTSTOWN, CTH D

PLUM CREEK BRIDGE

CTH D

BROWN COUNTY

STATE PROJECT NUMBER
4546-02-71



END PROJECT
~~STA 11+65.00~~
STA 12+12.00

STRUCTURE B-5-440

BEGIN PROJECT
STA 8+00.00
Y=490,824.068
X=58,720.016

HORIZONTAL POSITIONS SHOWN ON THIS PLAN ARE WISCONSIN COUNTY COORDINATES, BROWN COUNTY, NAD83 (2011), IN U.S. SURVEY FEET. VALUES ARE GRID COORDINATES, GRID BEARINGS, AND GRID DISTANCES. GRID DISTANCES MAY BE USED AS GROUND DISTANCES.

STATE PROJECT	FEDERAL PROJECT	
	PROJECT	CONTRACT
4546-02-71		

AS-BUILT PLAN


SUPERVISOR: Rob Wagner
PROJECT MANAGER: Kyle Trembl
PROJECT LEADER: Sam Bremer
CONTRACTOR: Radtke Contractors Inc.
CONSTRUCTION STARTED 07/22/19
SUBSTANTIALLY COMPLETE 10/25/19

ACCEPTED FOR BROWN COUNTY

DATE: 7/25/18 [Signature]
(Signature)

Senior Level Engineer
(Title of Official)

ORIGINAL PLANS PREPARED BY

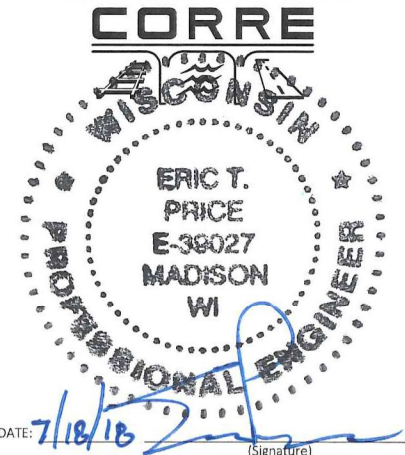

DATE: 7/18/18  (Signature)

STATE OF WISCONSIN
DEPARTMENT OF TRANSPORTATION

PREPARED BY	
Surveyor	CORRE, INC.
Designer	CORRE, INC.

Management Consultant SHORT ELLIOT HENDRICKSON, INC.

APPROVED FOR THE DEPARTMENT

DATE: 7/30/18 [Signature]

MANAGEMENT CONSULTANT SIGNATURE

FILE NAME : P:\WI - NE REGION\4546-02-00_CTH D_BROWN CO\500_CADD\501_C3D_2016\4546-02-00\SHEETSPLAN\010101-TI.DWG

PLOT DATE : 6/15/2018 4:52 PM

PLOT BY : BOBBY JONES

PLOT NAME :

GENERAL NOTES

ELEVATIONS SHOWN ON THE PLAN ARE REFERENCED TO NAVD88 (2012).

CURVE DATA IS BASED ON THE ARC DEFINITION.

BEARINGS SHOWN ON THE PLANS ARE GRID/GROUND/PROJECT BEARINGS TO THE NEAREST SECOND.

THE LOCATION OF EXISTING AND PROPOSED UTILITY INSTALLATIONS AS SHOWN ON THE PLANS IS APPROXIMATE. THERE MAY BE OTHER UTILITY INSTALLATIONS WITHIN THE PROJECT AREA THAT ARE NOT SHOWN.

NO TREES OR SHRUBS ARE TO BE REMOVED WITHOUT THE APPROVAL OF THE ENGINEER.

THE EXACT LOCATION OF THE EROSION CONTROL DEVICES SHALL BE DETERMINED IN THE FIELD.

SILT FENCE IS TO BE PLACED AS SHOWN ON THE PLANS OR AS DIRECTED BY THE ENGINEER, AND IN PLACE PRIOR TO BRIDGE REMOVAL.

DISTURBED AREAS WITHIN THE RIGHT-OF-WAY, EXCEPT THE AREAS WITHIN THE FINISHED SHOULDER POINTS, ARE TO BE 4-INCH TOPSOILED, FERTILIZED, AND SEEDED AND MULCHED. FINISHED SEEDED SURFACE SHALL BE 1-INCH BELOW THE TOP OF ADJACENT CONCRETE.

THE LOCATION OF ALL DRIVEWAYS WILL BE DETERMINED BY THE ENGINEER.


ALL PAVEMENT DIMENSIONS AND STATIONS ARE SHOWN TO THE EDGE OF PAVEMENT UNLESS NOTED OTHERWISE.

A VERTICAL SAWCUT SHALL BE MADE THROUGH EXISTING DRIVEWAYS AND PAVEMENTS AT REMOVAL LIMITS.

EXCAVATION BELOW SUBGRADE (EBS) IS NOT USED TO BALANCE YARDAGE AND IS NOT SHOWN ON THE CROSS SECTIONS BUT IS MEASURED AND PAID FOR AS COMMON OR ROCK EXCAVATION.

4.5-INCH HMA PAVEMENT SHALL BE CONSTRUCTED WITH A 2.25-INCH UPPER LAYER AND A 2.25-INCH LOWER LAYER.

CONTROL POINT TIES

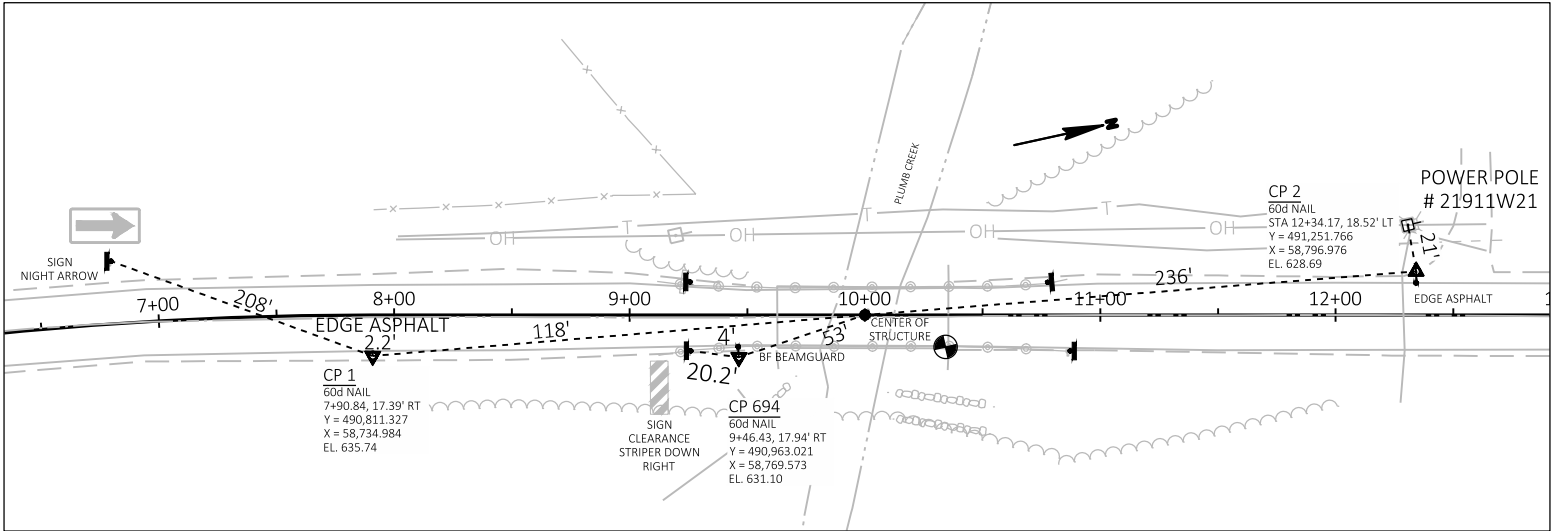

UTILITY CONTACTS

* ELECTRIC

WISCONSIN PUBLIC SERVICE CORP
RANDY STEIER
2850 S. ASHLAND AVENUE
PO BOX 19001
GREEN BAY, WI 54307-9001
PHONE: (920) 671-5167
EMAIL: RDSTEIER@WISCONSINPUBLICSERVICE.COM

* GAS

WISCONSIN PUBLIC SERVICE CORP
DAVE CZARNECKI
2850 S. ASHLAND AVENUE
PO BOX 19001
GREEN BAY, WI 54307-9001
PHONE: (920) 412-4746
EMAIL: DFCZARNECKI@WISCONSINPUBLICSERVICE.COM

* TELEPHONE

AT&T
JOE KASSAB
205 S. JEFFERSON STREET
GREEN BAY, WI 54301
PHONE: (920) 202-4002
EMAIL: JK572K@ATT.COM

GAGING STATION

US GEOLOGICAL SURVEY
PAUL RENEAU
8505 RESEARCH WAY
MIDDLETON, WI 53562
PHONE: (608) 821-3901
EMAIL: PCRENEAU@USGS.GOV

* DENOTES DIGGERS HOTLINE MEMBER



Dial 811 or (800)242-8511

www.DiggersHotline.com

CONSULTANT CONTACT

CORRE, INC.
6510 GRAND TETON PLAZA
SUITE 314
MADISON, WI 53719

ERIC PRICE, P.E.
(608)-828-6146
EPRICE@CORREINC.COM

DNR CONTACT

DEPARTMENT OF NATURAL RESOURCES
2984 SHAWANO AVENUE
GREEN BAY, WI 54313

JIM DOPERALSKI
(920) 662-5119
JAMES.DOPERALSKI@WISCONSIN.GOV

SPONSOR CONTACT

BROWN COUNTY HIGHWAY DEPT.
2198 GLENDALE AVENUE
GREEN BAY, WI 54303

WILL BERG
(920) 662-2171
BERG_WR@CO.BROWN.WI.US

RUNOFF COEFFICIENT TABLE

	HYDROLOGIC SOIL GROUP											
	A			B			C			D		
	SLOPE RANGE (PERCENT)			SLOPE RANGE (PERCENT)			SLOPE RANGE (PERCENT)			SLOPE RANGE (PERCENT)		
LAND USE:	0-2	2-6	6 & OVER	0-2	2-6	6 & OVER	0-2	2-6	6 & OVER	0-2	2-6	6 & OVER
ROW CROPS	.08	.16	.22	.12	.20	.27	.15	.24	.33	.19	.28	.38
	.22	.30	.38	.26	.34	.44	.30	.37	.50	.34	.41	.56
MEDIAN STRIP-TURF	.19	.20	.24	.19	.22	.26	.20	.23	.30	.20	.25	.30
	.24	.26	.30	.25	.28	.33	.26	.30	.37	.27	.32	.40
SIDE SLOPE-TURF			.25			.27			.28			.30
			.32			.34			.36			.38
PAVEMENT:												
ASPHALT	.70 - .95											
CONCRETE	.80 - .95											
BRICK	.70 - .80											
DRIVES, WALKS	.75 - .85											
ROOFS	.75 - .95											
GRAVEL ROADS, SHOULDERS	.40 - .60											

TOTAL PROJECT AREA = 1.77 ACRES
TOTAL AREA EXPECTED TO BE DISTURBED BY CONSTRUCTION ACTIVITIES = 1.25 ACRES


PROJECT NO: 4546-02-71

HWY: CTH D

COUNTY: BROWN

GENERAL NOTES

SHEET

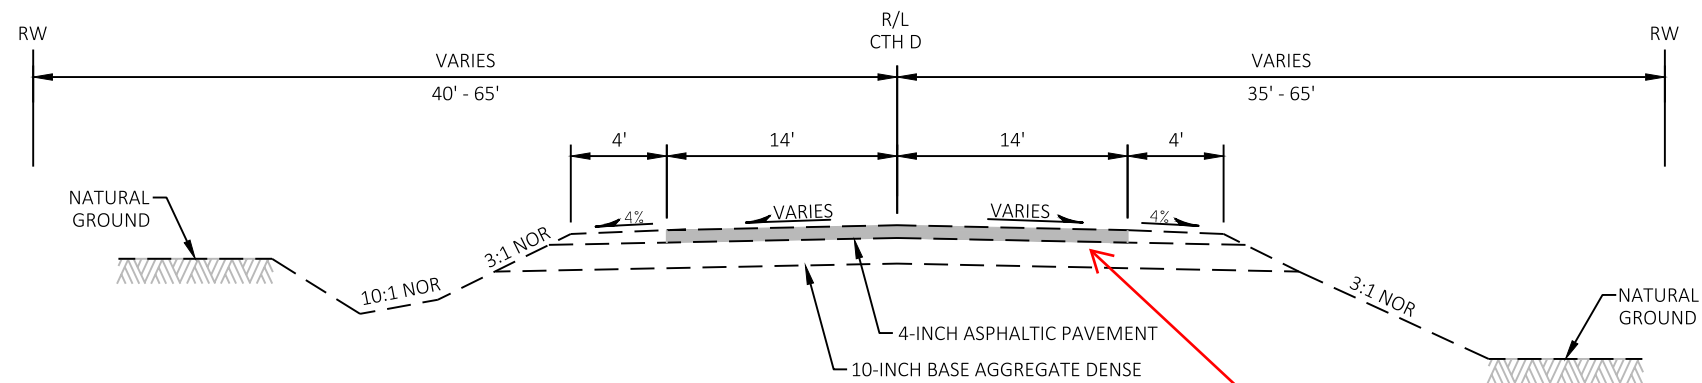


TYPICAL EXISTING SECTION - CTH D


STA 6+00 - STA 13+54

*12-INCH CONCRETE APPROACH SLAB AT 24' WIDE
UNDER EXISTING ASPHALT PAVEMENT.
STA 9+24.00 - STA 9+54.73
STA 10+45.27 - STA 10+77

*12-INCH CONCRETE
PAVEMENT APPROACH SLAB

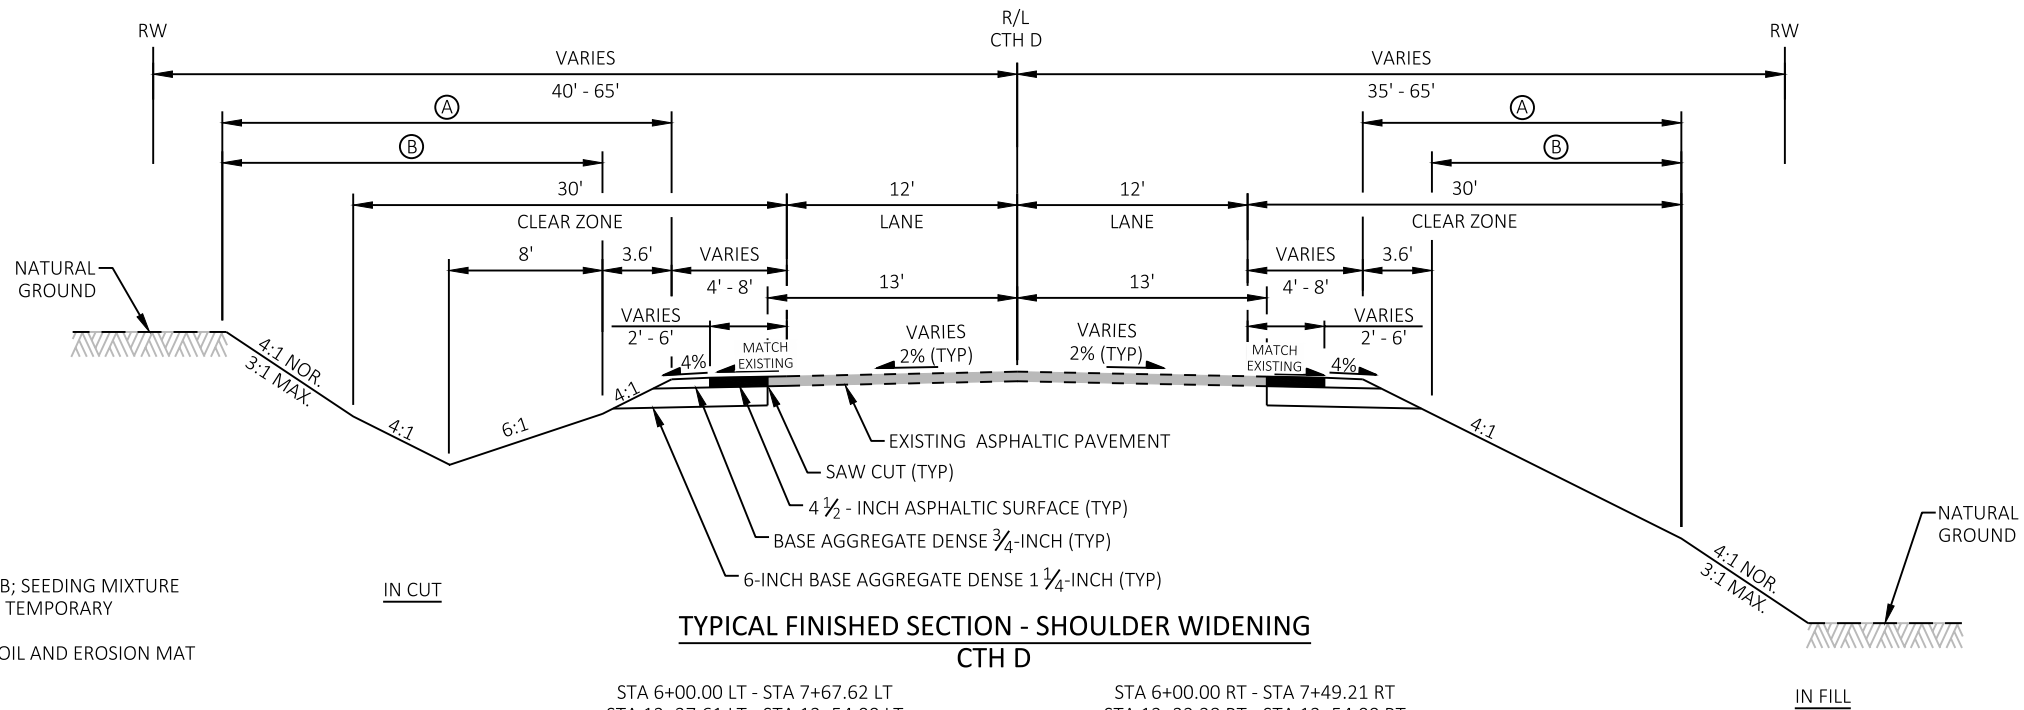


TYPICAL FINISHED SECTION - SHOULDER WIDENING
CTH D

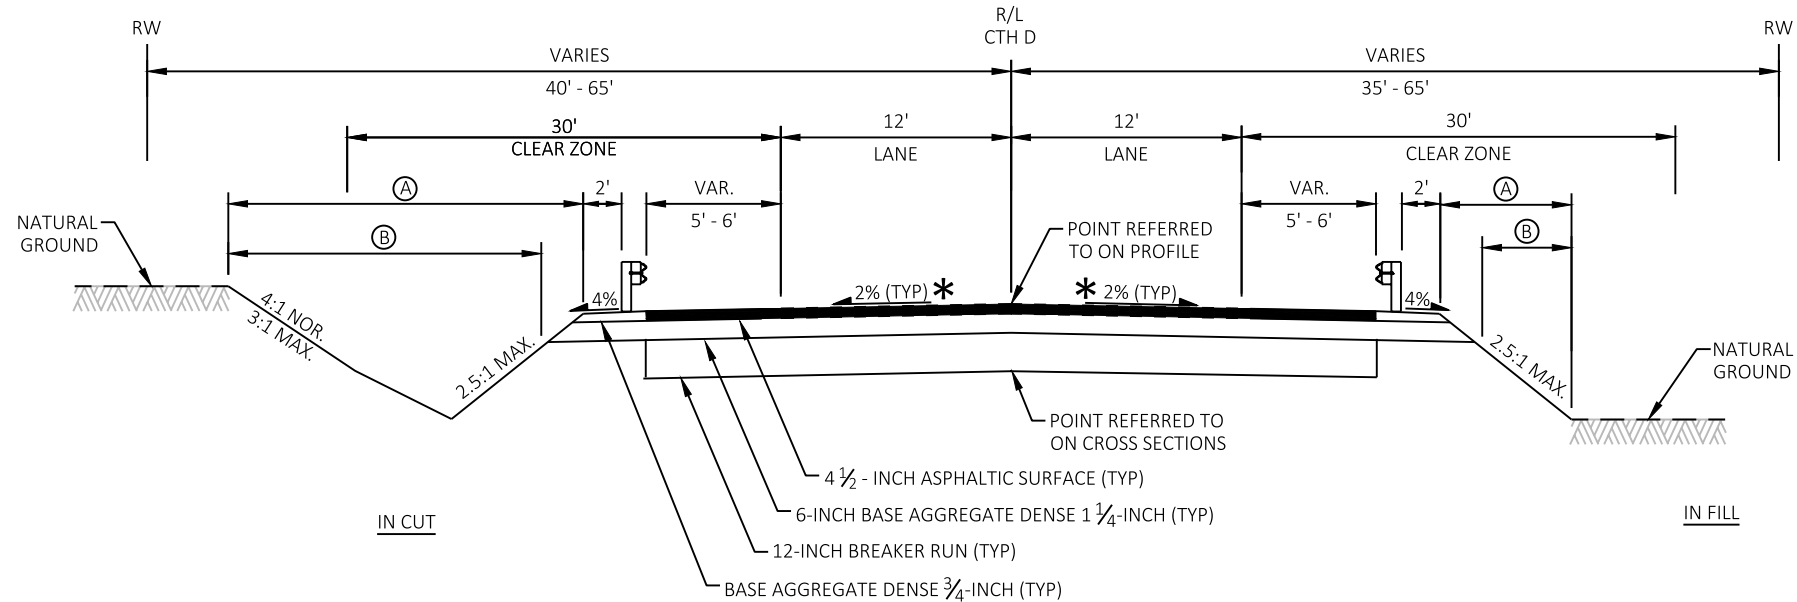

TYPICAL FINISHED SECTION
CTH D

STA 8+00.00 - STA 9+54.73
STA 10+45.27 - STA 11+65.00

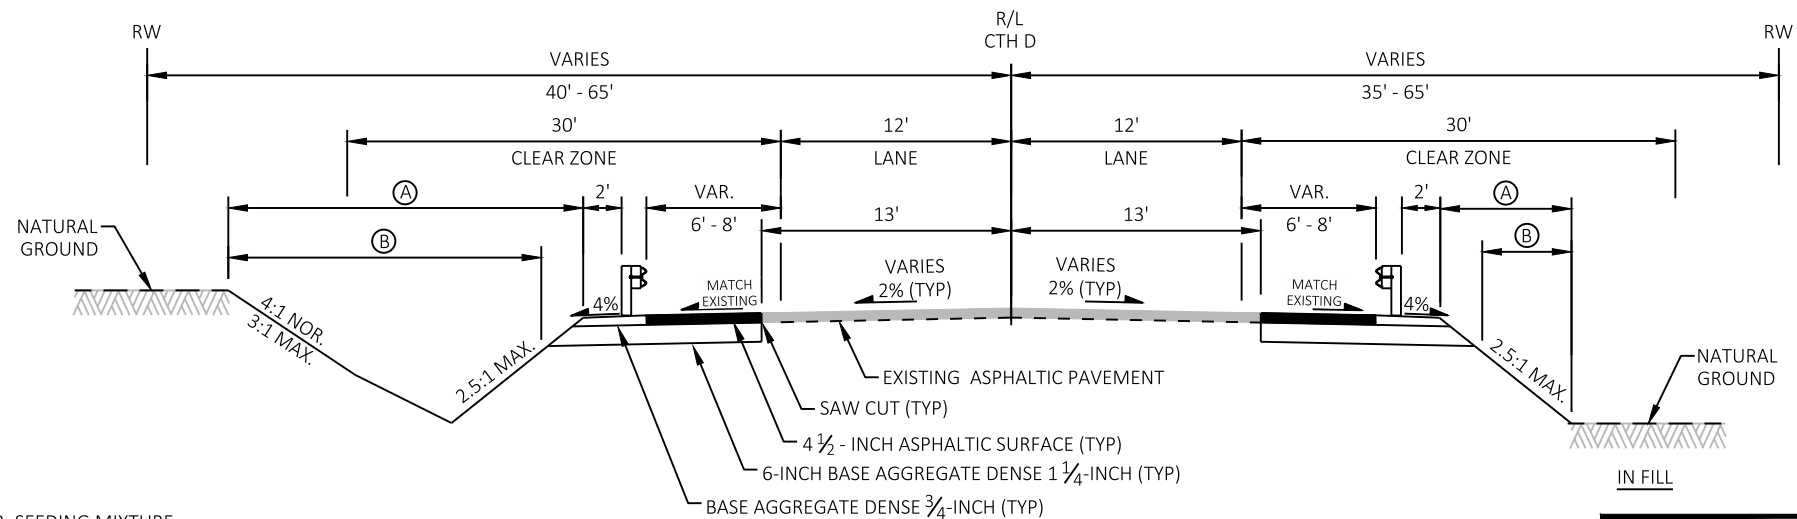

TYPICAL FINISHED SECTION - SHOULDER WIDENING
CTH D

STA 7+67.62 LT - STA 8+00.00 LT
STA 11+65.00 LT - STA 12+37.61 LT
STA 7+49.21 RT - STA 8+00.00 RT
STA 11+65.00 RT - STA 12+32.38 RT

LEGEND

- (A) FERTILIZER TYPE B; SEEDING MIXTURE NO. 20; SEEDING TEMPORARY
- (B) SALVAGED TOPSOIL AND EROSION MAT
- * UNLESS OTHERWISE SHOWN IN SUPER ELEVATION TABLE

SUPERELEVATION CURVE	STATION		LENGTH	LEFT		RIGHT	
	START	END		SHOULDER	LANE	LANE	SHOULDER
CURVE 1							
MATCH EXISTING	8+00			-4.00%	2.20%	-2.80%	-4.00%
REVERSE CROWN	8+35			-4.00%	2.00%	-2.00%	-4.00%
LEVEL CROWN	8+88			-4.00%	0.00%	-2.00%	-4.00%
RUNOUT	8+88	9+41	53.00'				
LEVEL CROWN	8+88			-4.00%	0.00%	-2.00%	-4.00%
BEGIN NORMAL CROWN	9+41			-4.00%	-2.00%	-2.00%	-4.00%

PROJECT NO: 4546-02-71

HWY: CTH D


COUNTY: BROWN

PLAN: TYPICAL SECTIONS

SHEET

4

E

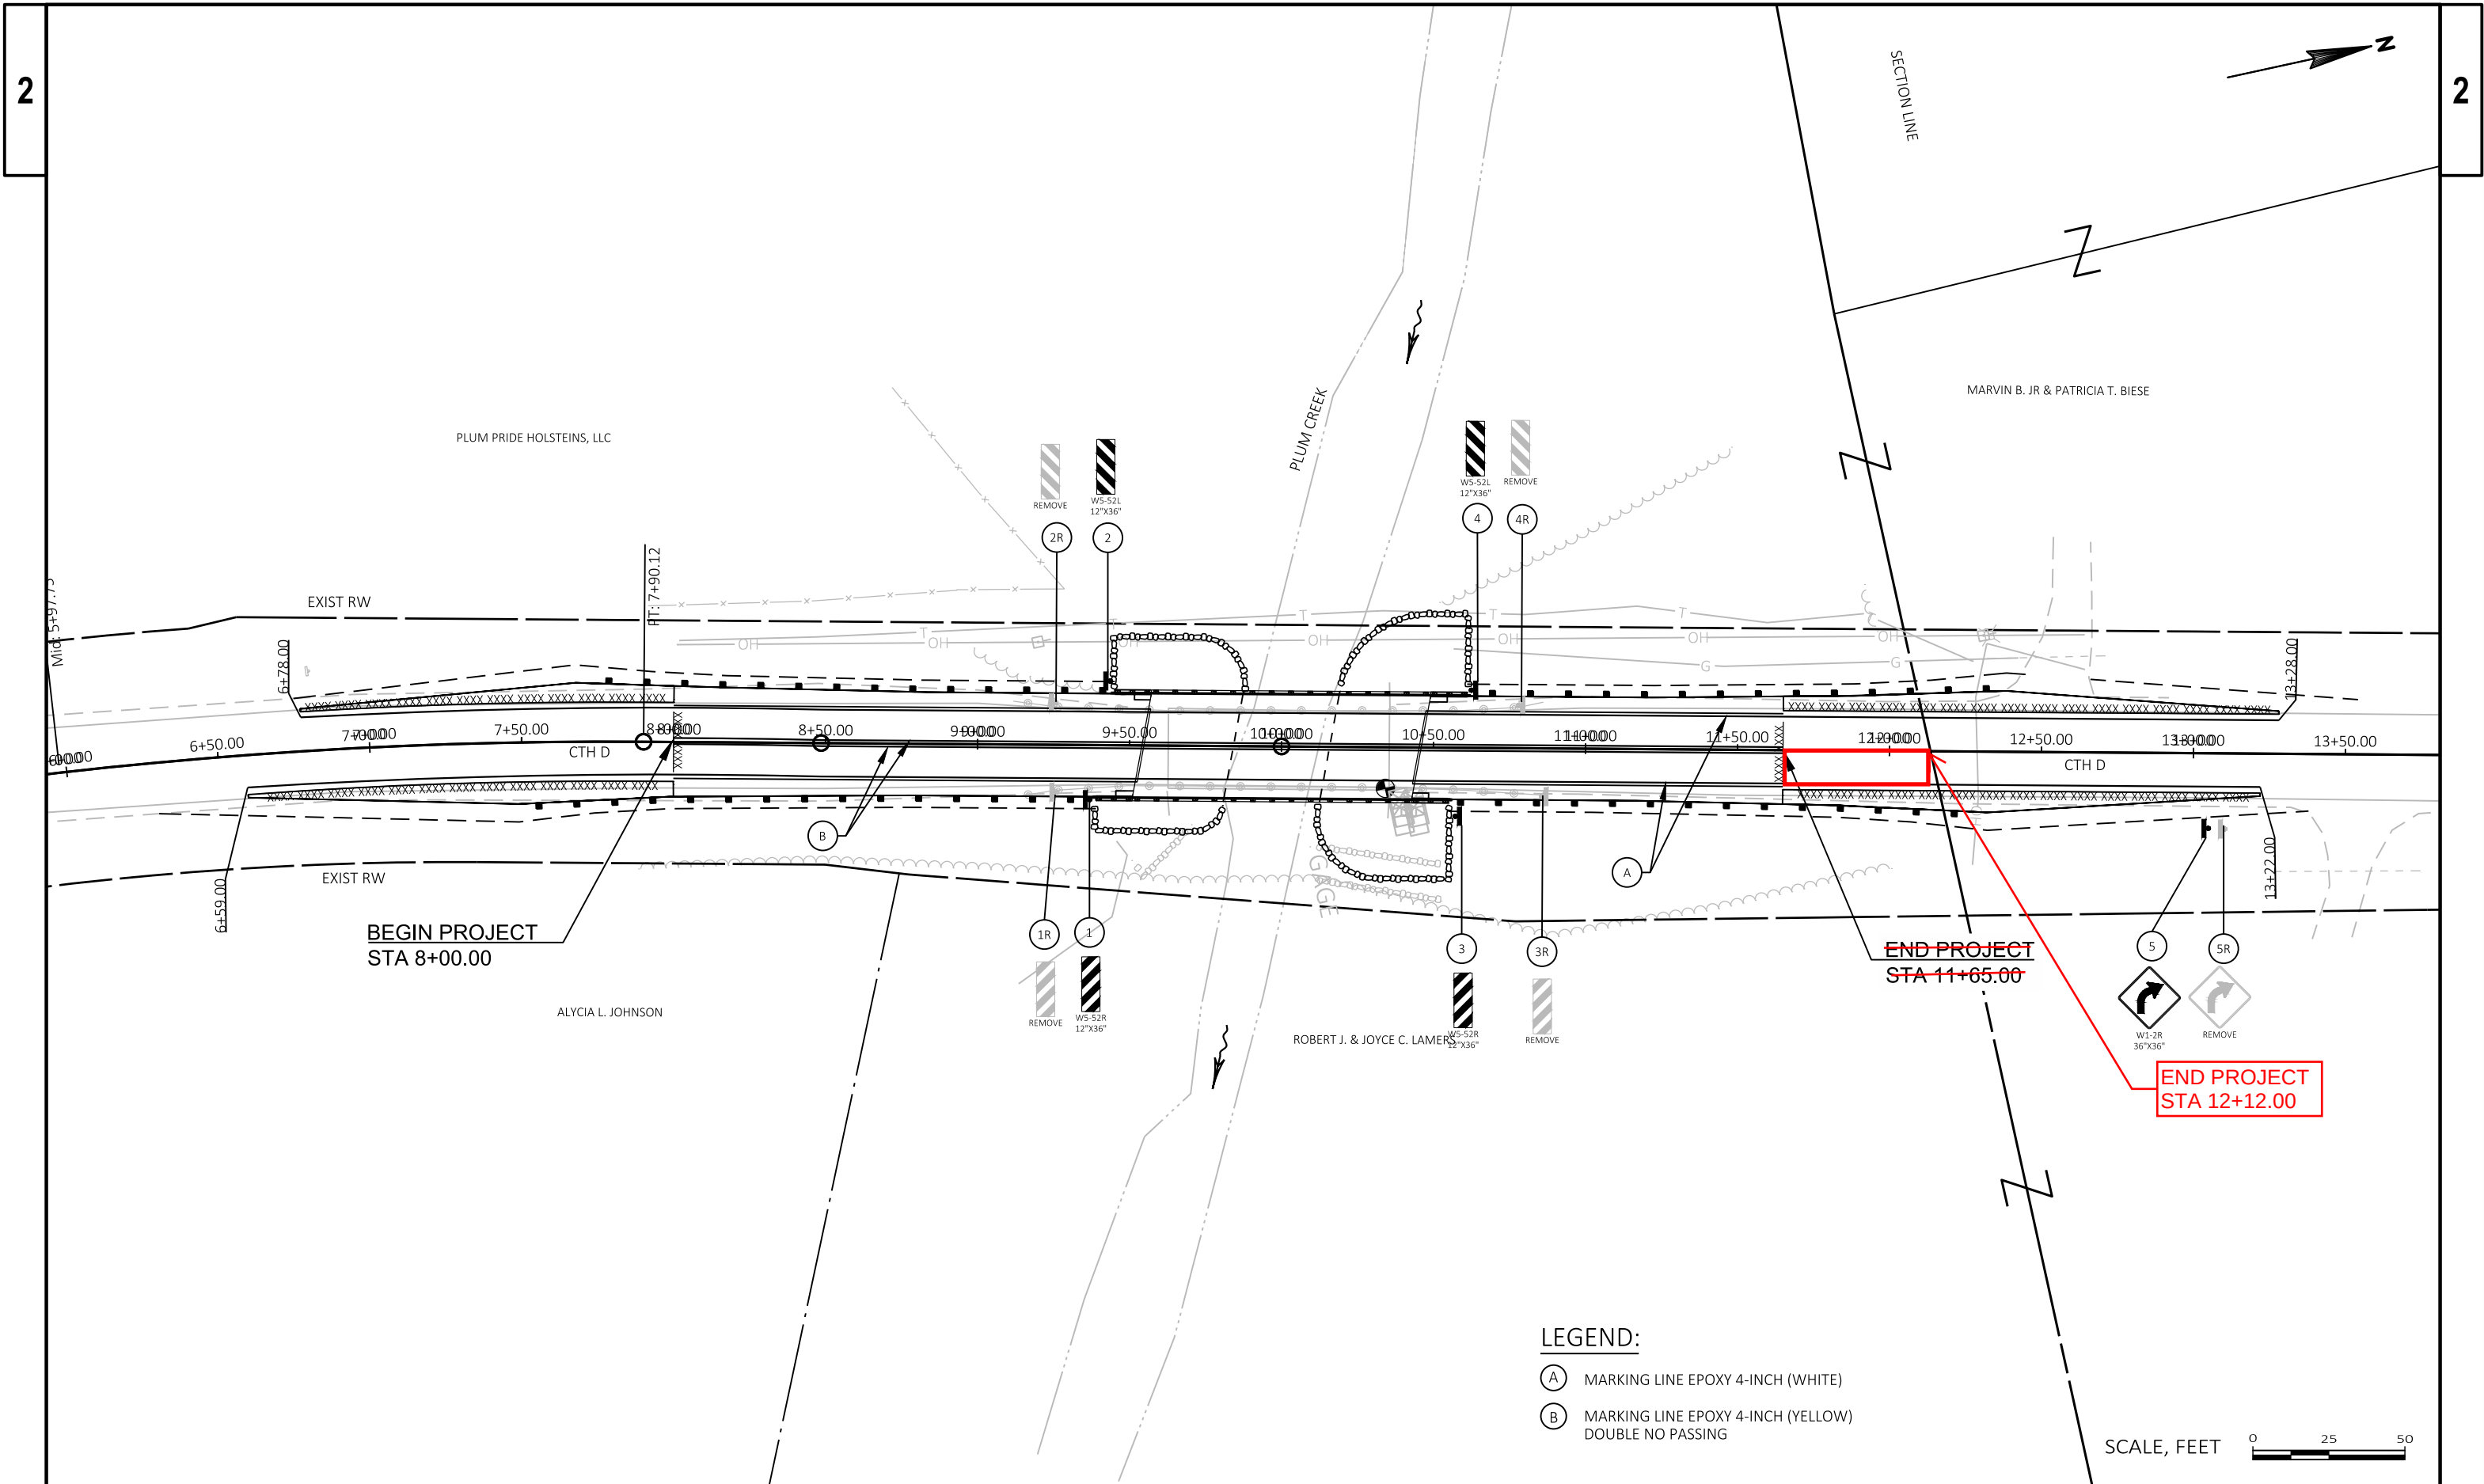

3

Division	From/To Station	Location	205.0100 Common Excavation (1)		Salvaged/Unusable Pavement Material (4)	Available Material (5)	Unexpanded Fill	Expanded Fill (6)	Mass Ordinate +/- (7)	Waste	208.0100 Borrow
			Cut (2)	EBS Excavation				Factor 1.30			
Division 1 CTH D	6+25 - 8+00	LT	21	0	0	21	565	735	-714		
	6+00 - 8+00	RT	18	0	0	18	515	669	-651		
	8+00 - 9+45	MAINLINE	242	0	50	192	216	281	-88		
	10+55 - 11+65	MAINLINE	201	0	38	163	149	194	-31		
	11+65 - 13+54	LT	19	0	0	19	110	143	-123		
	11+65 - 13+54	RT	35	0	0	35	151	197	-162		
Division 1 Subtotal			537	0	88	448	1,706	2,218	-1,770	0	1,770
Grand Total			537	0	88	448	1,706	2,218	-1,770	0	1,770
Total Common Exc			537								

Notes:
(1) Common Excavation is the sum of the Cut and EBS Excavation columns. Item number 205.0100
(2) Salvaged/Unsuable Pavement Material is included in Cut.
(4) Salvaged/Unusable Pavement Material
(5) Available Material = Cut - Salvaged/Unusuable Pavement Material
(6) Expanded Fill Factor = 1.3
(7) The Mass Ordinate + or - Qty calculated for the Division. Plus quantity indicates an excess of material within the Division. Minus indicates a shortage of material within the Division.

3

CLEARING AND GRUBBING ITEMS <table><tr><th>STATION</th><th>LOCATION</th><th>201.0105 CLEARING STA</th><th>201.0205 GRUBBING STA</th></tr><tr><td colspan="4">CATEGORY CODE 0010</td></tr><tr><td>6+00 - 12+00</td><td>CTH D</td><td>6</td><td>6</td></tr><tr><td colspan="2">TOTALS</td><td>6</td><td>6</td></tr></table>				STATION	LOCATION	201.0105 CLEARING STA	201.0205 GRUBBING STA	CATEGORY CODE 0010				6+00 - 12+00	CTH D	6	6	TOTALS		6	6	REMOVING GUARDRAIL <table><tr><th colspan="2">STATION - STATION</th><th>LOCATION</th><th>204.0165 REMOVING GUARDRAIL LF</th></tr><tr><td colspan="4">CATEGORY CODE 0010</td></tr><tr><td>9+09 - 9+60</td><td>9+60</td><td>LT</td><td>51</td></tr><tr><td>9+09 - 9+60</td><td>9+60</td><td>RT</td><td>51</td></tr><tr><td>10+35 - 10+86</td><td>10+86</td><td>LT</td><td>51</td></tr><tr><td>10+35 - 10+86</td><td>10+86</td><td>RT</td><td>51</td></tr><tr><td colspan="2">TOTAL</td><td colspan="2">204</td></tr></table>				STATION - STATION		LOCATION	204.0165 REMOVING GUARDRAIL LF	CATEGORY CODE 0010				9+09 - 9+60	9+60	LT	51	9+09 - 9+60	9+60	RT	51	10+35 - 10+86	10+86	LT	51	10+35 - 10+86	10+86	RT	51	TOTAL		204		FINISHING ROADWAY <table><tr><th colspan="2">213.0100 EACH</th></tr><tr><td colspan="2">CATEGORY CODE 0010</td></tr><tr><td>ID 4546-02-71</td><td>1</td></tr><tr><td>TOTAL</td><td>1</td></tr></table>				213.0100 EACH		CATEGORY CODE 0010		ID 4546-02-71	1	TOTAL	1																			
STATION	LOCATION	201.0105 CLEARING STA	201.0205 GRUBBING STA																																																																															
CATEGORY CODE 0010																																																																																		
6+00 - 12+00	CTH D	6	6																																																																															
TOTALS		6	6																																																																															
STATION - STATION		LOCATION	204.0165 REMOVING GUARDRAIL LF																																																																															
CATEGORY CODE 0010																																																																																		
9+09 - 9+60	9+60	LT	51																																																																															
9+09 - 9+60	9+60	RT	51																																																																															
10+35 - 10+86	10+86	LT	51																																																																															
10+35 - 10+86	10+86	RT	51																																																																															
TOTAL		204																																																																																
213.0100 EACH																																																																																		
CATEGORY CODE 0010																																																																																		
ID 4546-02-71	1																																																																																	
TOTAL	1																																																																																	
BASE AGGREGATE DENSE <table><tr><th>STATION - STATION</th><th>LOCATION</th><th>305.0110 BASE AGGREGATE DENSE 3/4-INCH TON</th><th>305.0120 BASE AGGREGATE DENSE 1 1/4-INCH TON</th><th>311.0110 BREAKER RUN TON</th></tr><tr><td colspan="5">CATEGORY CODE 0010</td></tr><tr><td>6+00 - 8+00</td><td>MAINLINE</td><td>33</td><td>96</td><td>--</td></tr><tr><td>8+00 - 9+54</td><td>MAINLINE</td><td>38</td><td>258</td><td>411</td></tr><tr><td>10+46 - 11+65</td><td>MAINLINE</td><td>30</td><td>200</td><td>317</td></tr><tr><td>11+65 - 13+54</td><td>MAINLINE</td><td>30</td><td>86</td><td>--</td></tr><tr><td colspan="2">TOTALS</td><td>98</td><td>544</td><td>728</td></tr></table>				STATION - STATION	LOCATION	305.0110 BASE AGGREGATE DENSE 3/4-INCH TON	305.0120 BASE AGGREGATE DENSE 1 1/4-INCH TON	311.0110 BREAKER RUN TON	CATEGORY CODE 0010					6+00 - 8+00	MAINLINE	33	96	--	8+00 - 9+54	MAINLINE	38	258	411	10+46 - 11+65	MAINLINE	30	200	317	11+65 - 13+54	MAINLINE	30	86	--	TOTALS		98	544	728	WATER <table><tr><th>LOCATION</th><th>624.0100 MGAL</th></tr><tr><td colspan="2">CATEGORY CODE 0010</td></tr><tr><td>BASE COMPACTION</td><td>7</td></tr><tr><td>DUST CONTROL</td><td>3</td></tr><tr><td>TOTAL</td><td>10</td></tr></table>		LOCATION	624.0100 MGAL	CATEGORY CODE 0010		BASE COMPACTION	7	DUST CONTROL	3	TOTAL	10	ASPHALTIC ITEMS <table><tr><th>STATION - STATION</th><th>LOCATION</th><th>455.0605 TACK COAT GAL</th><th>465.0105 ASPHALTIC SURFACE TON</th></tr><tr><td colspan="4">CATEGORY CODE 0010</td></tr><tr><td>6+59 - 8+00</td><td>MAINLINE</td><td>9</td><td>34</td></tr><tr><td>8+00 - 9+54</td><td>MAINLINE</td><td>34</td><td>121</td></tr><tr><td>10+46 - 11+65</td><td>MAINLINE</td><td>26</td><td>93</td></tr><tr><td>11+65 - 13+28</td><td>MAINLINE</td><td>12</td><td>43</td></tr><tr><td colspan="2">TOTALS</td><td>72</td><td>257</td></tr></table>				STATION - STATION	LOCATION	455.0605 TACK COAT GAL	465.0105 ASPHALTIC SURFACE TON	CATEGORY CODE 0010				6+59 - 8+00	MAINLINE	9	34	8+00 - 9+54	MAINLINE	34	121	10+46 - 11+65	MAINLINE	26	93	11+65 - 13+28	MAINLINE	12	43	TOTALS		72	257
STATION - STATION	LOCATION	305.0110 BASE AGGREGATE DENSE 3/4-INCH TON	305.0120 BASE AGGREGATE DENSE 1 1/4-INCH TON	311.0110 BREAKER RUN TON																																																																														
CATEGORY CODE 0010																																																																																		
6+00 - 8+00	MAINLINE	33	96	--																																																																														
8+00 - 9+54	MAINLINE	38	258	411																																																																														
10+46 - 11+65	MAINLINE	30	200	317																																																																														
11+65 - 13+54	MAINLINE	30	86	--																																																																														
TOTALS		98	544	728																																																																														
LOCATION	624.0100 MGAL																																																																																	
CATEGORY CODE 0010																																																																																		
BASE COMPACTION	7																																																																																	
DUST CONTROL	3																																																																																	
TOTAL	10																																																																																	
STATION - STATION	LOCATION	455.0605 TACK COAT GAL	465.0105 ASPHALTIC SURFACE TON																																																																															
CATEGORY CODE 0010																																																																																		
6+59 - 8+00	MAINLINE	9	34																																																																															
8+00 - 9+54	MAINLINE	34	121																																																																															
10+46 - 11+65	MAINLINE	26	93																																																																															
11+65 - 13+28	MAINLINE	12	43																																																																															
TOTALS		72	257																																																																															
PROJECT NO: 4546-02-71		HWY: CTH D		COUNTY: BROWN		MISCELLANEOUS QUANTITIES		SHEET NO: 6		E																																																																								

3

MGS GUARDRAIL ITEMS						
STATION - STATION		LOCATION	614.2300 MGS GUARDRAIL 3 LF	614.2500 THRIE BEAM TRANSITION LF	614.2610 TERMINAL EAT EACH	
CATEGORY CODE 0010						
7+49	-	8+02	RT	--	--	1
8+02	-	9+02	RT	100.0	--	--
9+02	-	9+39	RT	--	36.8	--
7+68	-	8+21	LT	--	--	1
8+21	-	9+08	LT	87.5	--	--
9+08	-	9+45	LT	--	36.8	--
10+55	-	10+92	RT	--	36.8	--
10+92	-	11+79	RT	87.5	--	--
11+79	-	12+32	RT	--	--	1
10+60	-	10+97	LT	--	36.8	--
10+97	-	11+85	LT	87.5	--	--
11+85	-	12+38	LT	--	--	1
TOTALS			362.5	147.2	4	

LANDSCAPING ITEMS

STATION - STATION			LOCATION	625.0500 SALVAGED TOPSOIL SY	627.0200 MULCHING SY	628.2008 EROSION MAT URBAN CLASS I TYPE B SY	629.0210 FERTILIZER TYPE B CWT	630.0120 SEEDING MIXTURE NO. 20 LB	630.0200 SEEDING TEMPORARY LB
CATEGORY CODE 0010									
6+00	-	9+54	LT	985	--	985	0.6	27	13
6+00	-	9+54	RT	849	--	849	0.5	23	11
10+46	-	13+54	LT	559	--	559	0.4	15	8
10+46	-	13+54	RT	532	--	532	0.3	14	7
UNDISTRIBUTED				290	140	150	0.2	8	4
TOTALS				3,215	140	3,075	1.8	79	43

3

REMOVING SIGN ITEMS

STATION		LOCATION	638.3000 REMOVING SMALL SIGN SUPPORTS EACH	638.2602 REMOVING SIGNS TYPE II EACH	SIGN MESSAGE
CATEGORY CODE 0010					
9+25		LT	1	1	BRIDGE HASH MARKS
9+25		RT	1	1	BRIDGE HASH MARKS
10+65		LT	1	1	BRIDGE HASH MARKS
10+65		RT	1	1	BRIDGE HASH MARKS
13+00		RT	1	1	CURVE
TOTALS			5	5	

EROSION CONTROL

STATION - STATION			LOCATION	628.1504 SILT FENCE LF	628.1520 MAINTENANCE LF	MOBILIZATIONS	
CATEGORY CODE 0010						628.1905 EROSION CONTROL EACH	628.1910 EMERGENCY EROSION CONTROL EACH
6+00	-	9+54	LT & RT	700	700	--	--
10+46	-	13+54	LT & RT	510	510	--	--
UNDISTRIBUTED				CTH D	--	2	2
TOTALS				1,210	1,210	2	2

FIELD OFFICE TYPE B

642.5001 EACH	
CATEGORY CODE 0010	
PROJECT	1
TOTAL	1

SIGNING ITEMS

STATION		LOCATION	SIGN NUMBER	SIGN CODE	SIZE	634.0612 POSTS WOOD 4X6-INCH X 12-FT EACH	634.0614 POSTS WOOD 4X6-INCH X 14-FT EACH	637.2230 SIGNS TYPE II REFLECTIVE F SF	SIGN MESSAGE
CATEGORY CODE 0010									
9+45		LT	2	W5-52L	12" X 36"	1	--	3.00	BRIDGE HASH MARKS
9+39		RT	1	W5-52R	12" X 36"	1	--	3.00	BRIDGE HASH MARKS
10+55		LT	4	W5-52L	12" X 36"	1	--	3.00	BRIDGE HASH MARKS
10+60		RT	3	W5-52R	12" X 36"	1	--	3.00	BRIDGE HASH MARKS
13+00		RT	5	W1-2R	36" X 36"	--	1	9.00	CURVE RIGHT
TOTALS						4	1	21.00	

3

TRAFFIC CONTROL ITEMS				
LOCATION	643.5000 TRAFFIC CONTROL EACH	643.0420 BARRICADES TYPE III DAYS	643.0705 WARNING LIGHTS TYPE A DAYS	643.0900 SIGNS DAYS
CATEGORY CODE 0010				
PROJECT	1	1,476	2,296	1,148
TOTALS	1	1,476	2,296	1,148

MARKING LINE EPOXY 4-INCH			
STATION - STATION	LOCATION	646.1020 LF	REMARKS
CATEGORY CODE 0010			
6+78 - 13+28	RT EDGELINE	650	WHITE
8+00 - 11+65	CENTERLINE	730	DOUBLE YELLOW
6+59 - 13+22	LT EDGELINE	663	WHITE
TOTAL		2,043	

3

SAWING PAVEMENT		
STATION	LOCATION	690.0150 ASPHALT LF
CATEGORY CODE 0010		
6+78 - 8+00	LT	122
6+59 - 8+00	RT	141
8+00	MAINLINE	26
11+65	MAINLINE	26
11+65 - 13+22	RT	157
11+65 - 13+28	LT	163
TOTAL		635

CONSTRUCTION STAKING ITEMS						
STATION - STATION	LOCATION	650.4500 SUBGRADE LF	650.5000 BASE LF	650.6500* STRUCTURE LAYOUT LS	650.9910 SUPPLEMENTAL CONTROL LS	650.9920 SLOPE STAKES LF
CATEGORY CODE 0010						
6+00 - 9+54	MAINLINE	--	--	--	--	354
8+00 - 9+54	MAINLINE	154	154	--	--	--
10+46 - 11+65	MAINLINE	119	119	--	--	--
10+46 - 13+54	MAINLINE	--	--	--	--	308
UNDISTRIBUTED		--	--	1	1	--
TOTALS		273	273	1	1	662

* PAID FOR UNDER CATEGORY 0020

CONVENTIONAL SYMBOLS

SECTION LINE
QUARTER LINE
SIXTEENTH LINE
NEW REFERENCE LINE
NEW R/W LINE
EXISTING R/W OR HE LINE
PROPERTY LINE
LOT, TIE & OTHER MINOR LINES
SLOPE INTERCEPT
CORPORATE LIMITS
UNDERGROUND FACILITY (COMMUNICATIONS, ELECTRIC, ETC.)
NEW R/W (FEE OR HE) (HATCHING VARIES BY OWNER)
TEMPORARY LIMITED EASEMENT AREA
EASEMENT AREA (PERMANENT LIMITED OR RESTRICTED DEVELOPMENT)
TRANSMISSION STRUCTURES
BUILDING
BRIDGE

SECTION CORNER SYMBOL
SECTION CORNER MONUMENT
GEODETIC SURVEY MONUMENT
SIXTEENTH CORNER MONUMENT
SIGN
ELECTRIC POLE
TELEPHONE POLE
PEDESTAL (LABEL TYPE) (TV, TEL, ELEC, ETC.)
ACCESS RESTRICTED BY ACQUISITION
NO ACCESS (BY STATUTORY AUTHORITY)
ACCESS RESTRICTED (BY PREVIOUS PROJECT OR CONTROL)
NO ACCESS (NEW HIGHWAY)
PARCEL NUMBER
UTILITY NUMBER
PARALLEL OFFSETS

R/W MONUMENT (TO BE SET)
NON-MONUMENTED R/W POINT
FOUND IRON PIN (1-INCH UNLESS NOTED)
OFF-PREMISE SIGN
COMPENSABLE
NON-COMPENSABLE

CONVENTIONAL ABBREVIATIONS

ACCESS RIGHTS	AR	POINT OF INTERSECTION	PI
ACRES	AC	PROPERTY LINE	PL
AHEAD	AH	RECORDED AS	{100'}
ALUMINUM	ALUM	REEL / IMAGE	R/I
AND OTHERS	ET AL	REFERENCE LINE	R/L
BACK	BK	REMAINING	REM
BLOCK	BLK	RESTRICTIVE DEVELOPMENT	RDE
CENTERLINE	C/L	EASEMENT	
CERTIFIED SURVEY MAP	CSM	RIGHT	RT
CONCRETE	CONC	RIGHT OF WAY	R/W
COUNTY	CO	SECTION	SEC
COUNTY TRUNK HIGHWAY	CTH	SEPTIC VENT	SEPV
DISTANCE	DIST	SQUARE FEET	SF
CORNER	COR	STATE TRUNK HIGHWAY	STH
DOCUMENT NUMBER	DOC	STATION	STA
EASEMENT	EASE	TELEPHONE PEDESTAL	TP
EXISTING	EX	TEMPORARY LIMITED EASEMENT	TLE
GAS VALVE	GV	EASEMENT	
GRID NORTH	GN	TRANSPORTATION PROJECT	TPP
HIGHWAY EASEMENT	HE	PLAT	
IDENTIFICATION	ID	UNITED STATES HIGHWAY	USH
LAND CONTRACT	LC	VOLUME	V
LEFT	LT		
MONUMENT	MON		
NATIONAL GEODETIC SURVEY	NGS		
NUMBER	NO		
OUTLOT	OL		
PAGE	P		
POINT OF TANGENCY	PT		
PERMANENT LIMITED EASEMENT	PLE		
POINT OF BEGINNING	POB		
POINT OF CURVATURE	PC		
POINT OF COMPOUND CURVE	PCC		

CURVE DATA

LONG CHORD	LCH
LONG CHORD BEARING	LCB
RADIUS	R
DEGREE OF CURVE	D
CENTRAL ANGLE	Δ/DELTA
LENGTH OF CURVE	L
TANGENT	T
DIRECTION AHEAD	DA
DIRECTION BACK	DB

NOTES:


POSITIONS SHOWN ON THIS PLAT ARE WISCONSIN COORDINATE REFERENCE SYSTEM COORDINATES (WISCRS), BROWN COUNTY, NAD 83 (2011) IN US SURVEY FEET. VALUES SHOWN ARE GRID COORDINATES, GRID BEARINGS, AND GRID DISTANCES. GRID DISTANCES MAY BE USED AS GROUND DISTANCES.

RIGHT OF WAY MONUMENTS ARE REBAR AND ARE PLACED PRIOR TO THE COMPLETION OF THE PROJECT.

RIGHT OF WAY BOUNDARIES ARE DEFINED WITH COURSES OF THE PERIMETER OF THE HIGHWAY LANDS REFERENCED TO THE U.S. PUBLIC LAND SURVEY OR OTHER SURVEYS OF PUBLIC RECORD.

CONVENTIONAL UTILITY SYMBOLS

WATER	—W—
GAS	—G—
TELEPHONE	—T—
OVERHEAD TRANSMISSION LINES	—OH—
ELECTRIC	—E—
CABLE TELEVISION	—TV—
FIBER OPTIC	—FO—
SANITARY SEWER	—SAN—
STORM SEWER	—SS—

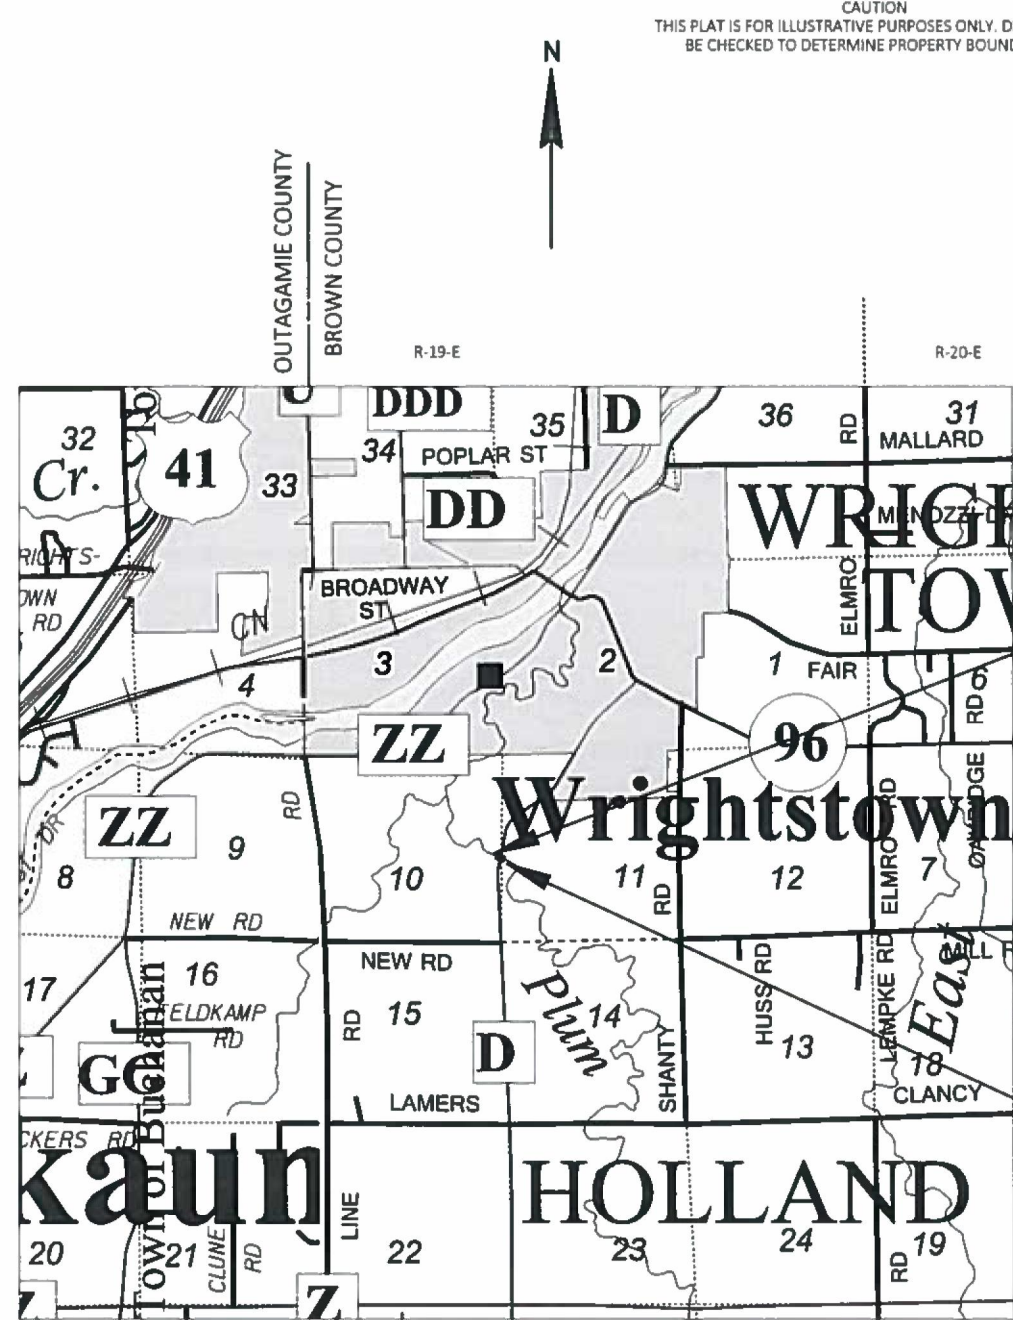

CAUTION
THIS PLAT IS FOR ILLUSTRATIVE PURPOSES ONLY. DEEDS MUST BE CHECKED TO DETERMINE PROPERTY BOUNDARIES.

R/W PROJECT NUMBER 4546-02-00	SHEET NUMBER 4.01	TOTAL SHEETS 2
PLAT OF RIGHT OF WAY REQUIRED FOR T WRIGHTSTOWN, CTH D PLUM CREEK BRIDGE		
CTH D BROWN COUNTY		
CONSTRUCTION PROJECT NUMBER: 4546-02-71		



END RELOCATION ORDER
STA 13+00.00
166.23' EAST AND 84.91' SOUTH
OF THE WEST QUARTER CORNER, SEC 11,
T-21-N, R-19-E

BEGIN RELOCATION ORDER
STA 6+00.00
24.15' EAST AND 600.16' SOUTH
OF THE WEST QUARTER CORNER, SEC 11,
T-21-N, R-19-E



1802 WARDEN STREET
EAU CLAIRE, WI 54703
(608)828-1011
www.correinc.com



I, BRYON J. MOTSZKO, REGISTERED LAND SURVEYOR, S-2846, HEREBY CERTIFY THAT I HAVE SURVEYED THE LAND DESCRIBED HEREON AND THAT THE MAP HEREON IS A CORRECT REPRESENTATION OF THAT SURVEY TO THE BEST OF MY KNOWLEDGE AND BELIEF.

DATE: 1/23/18 *Bryon J. Motzko*
(Signature)

BROWN COUNTY

APPROVED FOR COUNTY
DATE: 4/5/18 *Paul [Signature]*
(Signature)

The most current Right of Way information should be viewed in DOTView using the Real Estate Project ID. The Plat information contained in this AsBuilt Plan may not be the final records.

SCHEDULE OF LANDS & INTERESTS REQUIRED

OWNERS NAMES ARE SHOWN FOR REFERENCE ONLY AND ARE SUBJECT TO CHANGE PRIOR TO THE TRANSFER OF LAND INTERESTS TO THE COUNTY.

PARCEL NUMBER	OWNER	INTEREST REQUIRED	R/W ACRES REQUIRED		
			NEW (AC)	EXISTING (AC)	TOTAL (AC)
1	PLUM PRIDE HOLSTEINS, LLC	FEE	0.09	0.00	0.09
2	ALYCIA L. JOHNSON	FEE	0.12	0.00	0.12
3	MARVIN B. JR. AND PATRICIA T. BIESE	FEE	0.10	0.00	0.10
80	AT&T	RELEASE OF RIGHTS			

PT 200 - PT 100
L = 45.07'
LCH = 45.07'
CB = S06° 56' 07"W
R = 1185.149
Δ = 002° 10' 44"

PT 203 - PT 105
L = 131.15'
LCH = 131.08'
CB = S09° 14' 43"W
R = 1105.728
Δ = 006° 47' 46"

PT 101 - PT 102
L = 145.83'
LCH = 145.79'
CB = N10° 07' 39"E
R = 1660.524
Δ = 005° 01' 55"

PT 106 - PT 107
L = 134.42'
LCH = 134.37'
CB = N10° 07' 39"E
R = 1530.524
Δ = 005° 01' 55"

CONCRETE MONUMENT
WITH BRASS CAP
Y = 491227.037
X = 58663.227

END RELOCATION ORDER
STA 13+00.00
Y = 491311.944
X = 58829.456

TOWN

BEGIN RELOCATION ORDER

STA 6+00.00
Y = 490626.880
X = 58687.378

PLUM PRIDE HOLSTEINS, LLC

MARVIN B. JR.
AND
PATRICIA T. BIESE

0.08 AC. TOTAL
(0.01 AC. LOCATED WITHIN PLUM CREEK)

AT&T
(NO RECORDED EASEMENT)

WISCONSIN PUBLIC
SERVICE CORPORATION

WISCONSIN BELL, INC.
D/B/A/ SBC AMERITECH WISCONSIN
DOC# 2040688

ROBERT J.
AND
JOYCE C.
LAMERS

MAG NAIL
Y = 491244.394
X = 63840.767

NOTE:
EXISTING RIGHT OF WAY IS BASED ON
WISDOT RIGHT-OF-WAY PLAN 50381(1)
DATED 7/2/1958 AND SHOWN CSM'S.

COORDINATE POINT TABLE

POINT NO.	Y	X
100	490631.27	58644.32
101	490685.14	58628.80
102	490828.65	58654.43
103	490838.30	58656.59
104	490881.61	58691.93
105	490623.16	58723.90
106	490667.93	58757.65
107	490800.20	58781.28
108	490809.84	58783.44

COORDINATE POINT TABLE

POINT NO.	Y	X
109	490864.10	58769.99
110	491003.58	58719.29
111	491065.41	58717.79
112	491250.80	58759.37
113	491271.91	58779.48
200	490676.00	58649.76
201	490692.14	58649.43
203	490752.53	58744.96

COURSE TABLE

POINT	POINT	BEARING	DISTANCE
100	101	N16° 04' 10"W	56.07'
101	102	CURVE DATA	
102	103	N12° 38' 36"E	9.88'
103	104	N39° 12' 30"E	55.90'
104	201	S12° 38' 36"W	194.18'
201	200	S01° 10' 24"E	16.14'
200	100	CURVE DATA	
100	105	S84° 11' 03"E	80.00'
105	106	N37° 00' 37"E	56.06'
106	107	CURVE DATA	
107	108	N12° 38' 36"E	9.88'
108	109	N13° 55' 18"W	55.90'
109	203	S12° 38' 36"W	114.34'
203	105	CURVE DATA	
104	109	S77° 21' 24"E	80.00'
112	113	N43° 36' 26"E	29.15'
113	110	S12° 38' 36"W	275.00'
110	111	N01° 23' 34"W	61.85'
111	112	N12° 38' 36"E	190.00'

PI STA = 5+98.68
Y = 490625.804
X = 58675.541
DELTA = 13° 49' 00"
D = 3° 35' 28"
T = 193.32'
L = 384.75'
R = 1595.52'
PC STA = 4+05.37
Y = 490432.529
X = 58679.500
PT STA = 7+90.12
Y = 490814.431
X = 58717.854
BK = N01° 10' 24.0"W
AH = N12° 38' 36.0"E

REVISION DATE

DATE 1/23/18

SCALE, FEET

HWY: CTH D

STATE R/W PROJECT NUMBER: 4546-02-00


PLAT SHEET 4.02

GRID FACTOR N/A

COUNTY: BROWN


CONSTRUCTION PROJECT NUMBER: 4546-02-71

PS&E SHEET

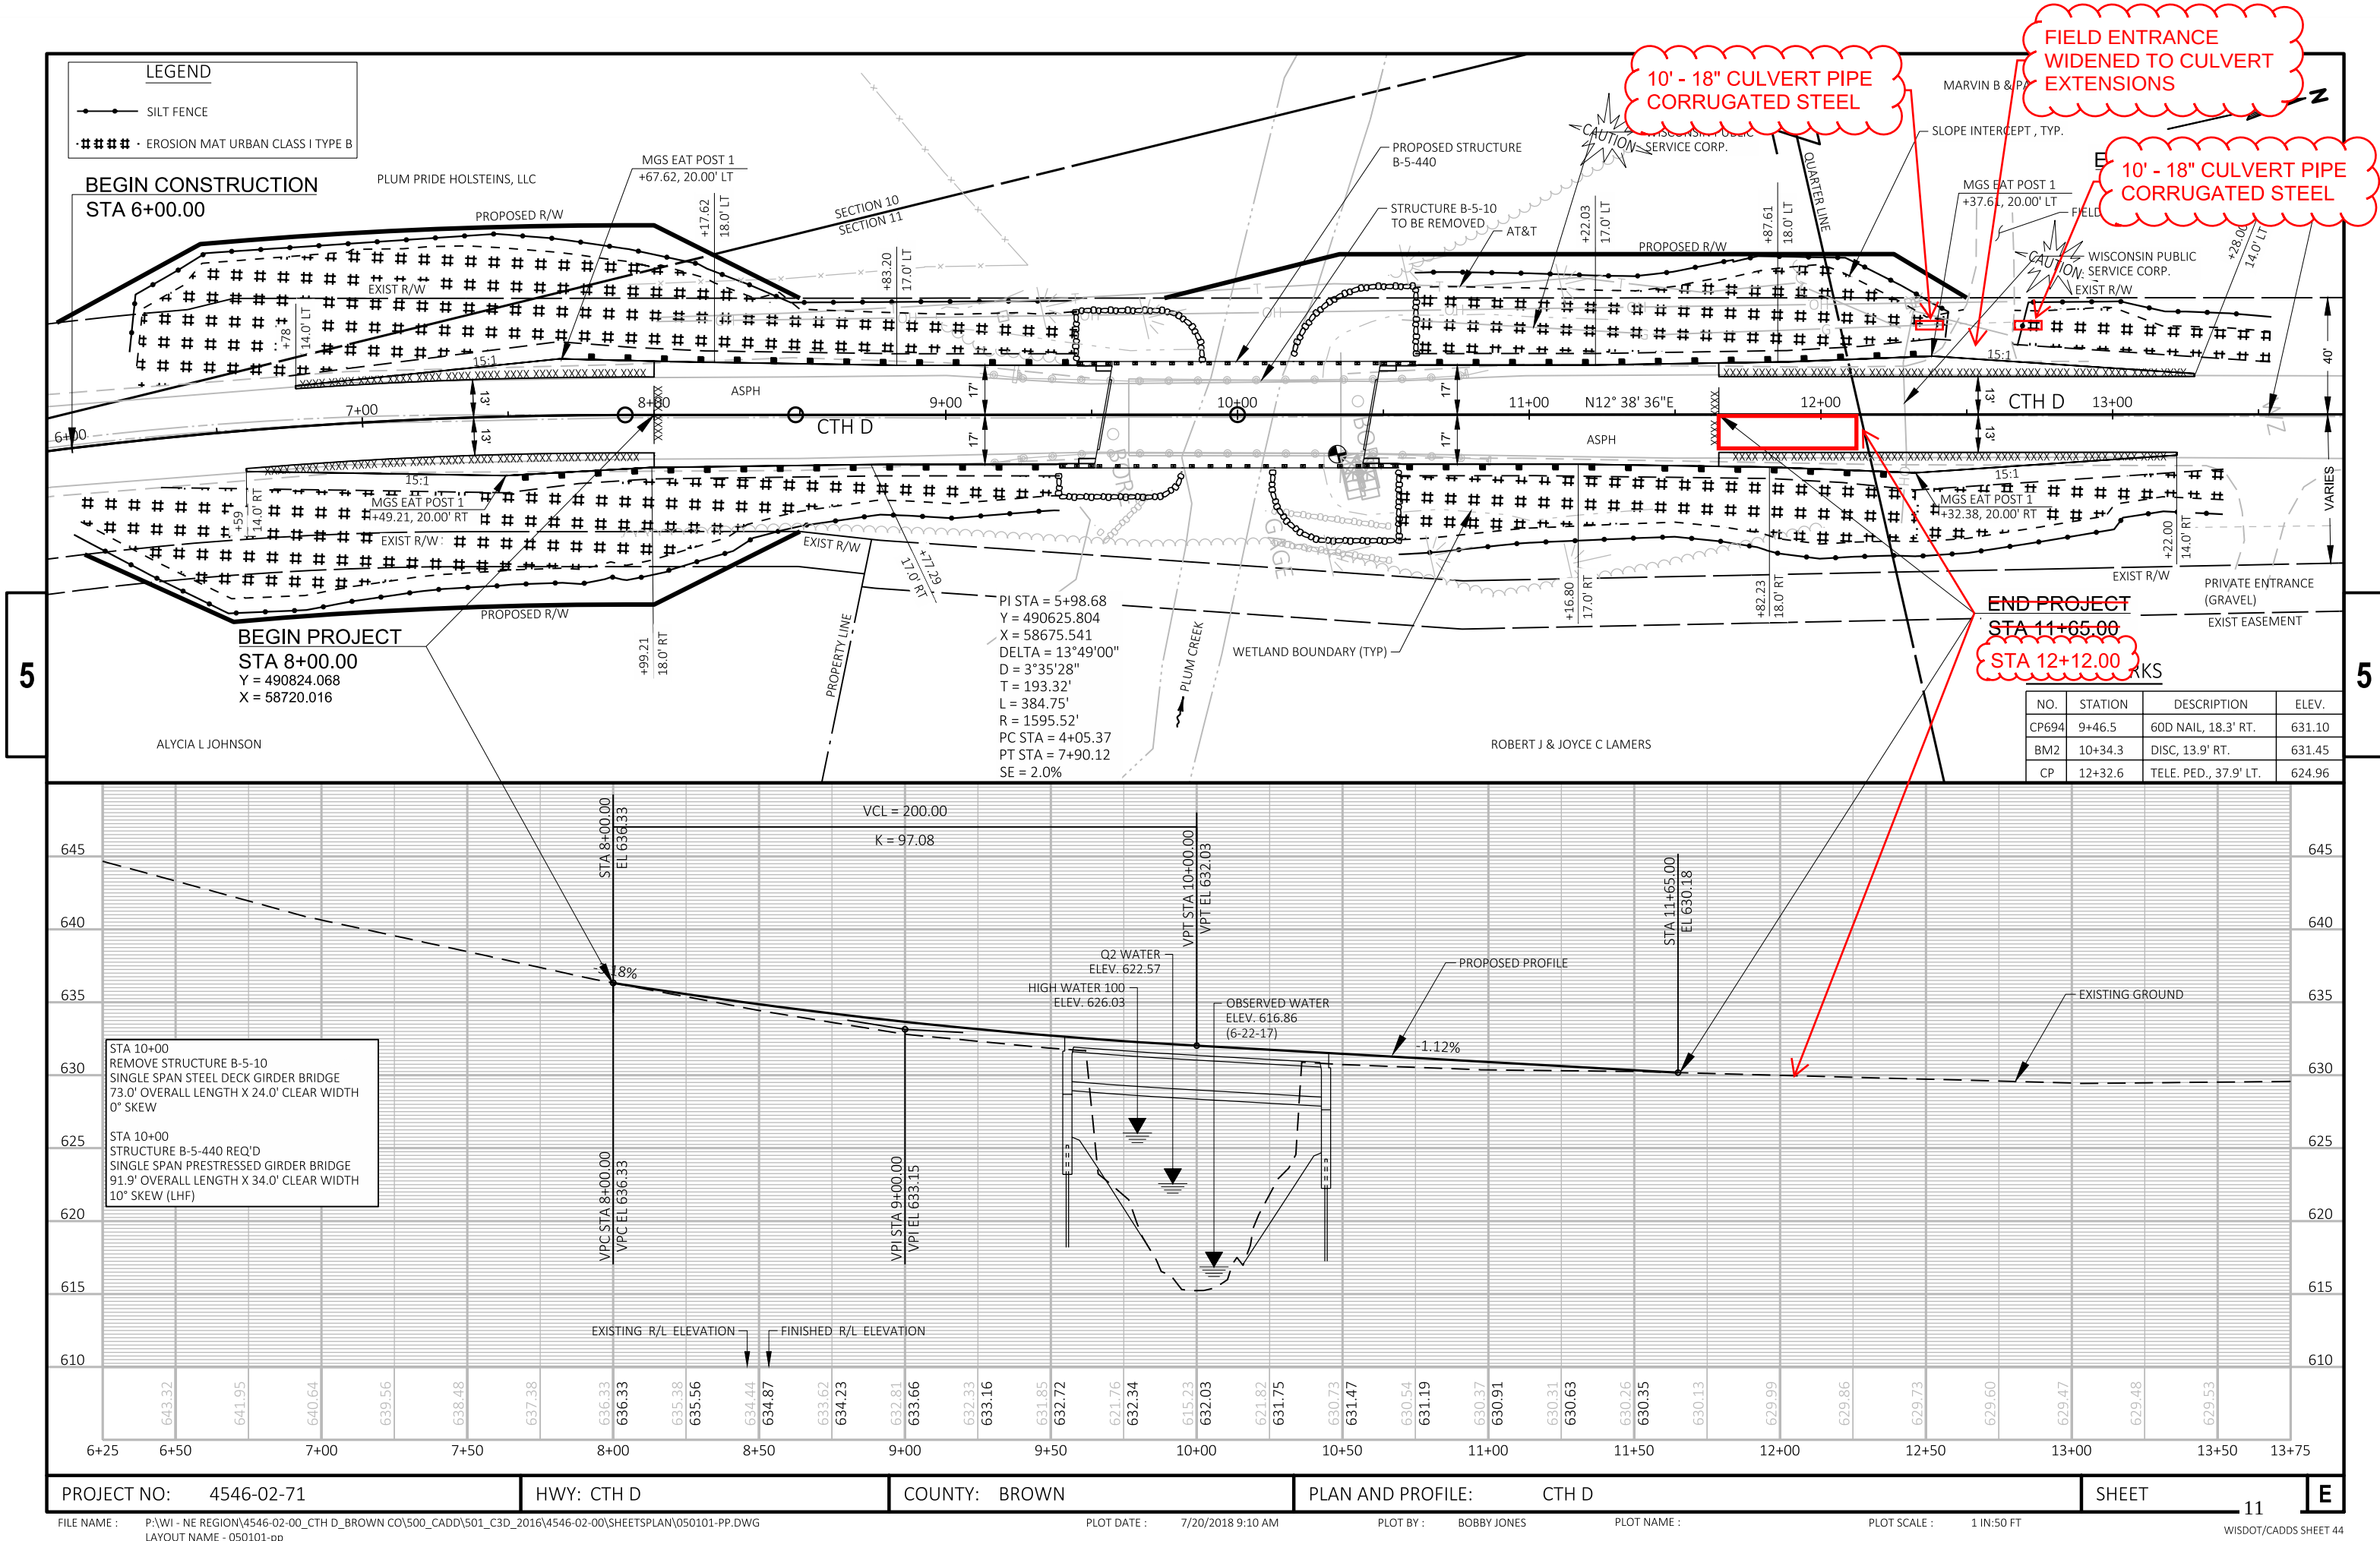

Standard Detail Drawing List


08E09-06	SILT FENCE
12A03-10	NAME PLATE (STRUCTURES)
14B42-06A	MIDWEST GUARDRAIL SYSTEM (MGS) GUARDRAIL
14B42-06B	MIDWEST GUARDRAIL SYSTEM (MGS) GUARDRAIL
14B42-06C	MIDWEST GUARDRAIL SYSTEM (MGS) GUARDRAIL
14B44-04A	MIDWEST GUARDRAIL SYSTEM ENERGY ABSORBING TERMINAL (MGS)
14B44-04B	MIDWEST GUARDRAIL SYSTEM ENERGY ABSORBING TERMINAL (MGS)
14B44-04C	MIDWEST GUARDRAIL SYSTEM ENERGY ABSORBING TERMINAL (MGS)
14B45-05A	MIDWEST GUARDRAIL SYSTEM THRIE BEAM TRANSITION (MGS)
14B45-05B	MIDWEST GUARDRAIL SYSTEM THRIE BEAM TRANSITION (MGS)
14B45-05C	MIDWEST GUARDRAIL SYSTEM THRIE BEAM TRANSITION (MGS)
14B45-05H	MIDWEST GUARDRAIL SYSTEM THRIE BEAM TRANSITION (MGS)
15C02-06A	BARRICADES AND SIGNS FOR MAINLINE CLOSURES
15C02-06B	BARRICADES AND SIGNS FOR MAINLINE CLOSURES
15C06-09	SIGNING & MARKING FOR TWO LANE BRIDGES
15C08-19A	LONGITUDINAL MARKING (MAINLINE)
15C11-07B	CHANNELIZING DEVICES DRUMS, CONES, BARRICADES AND VERTICAL PANELS
15D38-02A	TEMPORARY TRAFFIC CONTROL SIGN MOUNTING
15D38-02B	ATTACHMENT OF SIGNS TO POSTS

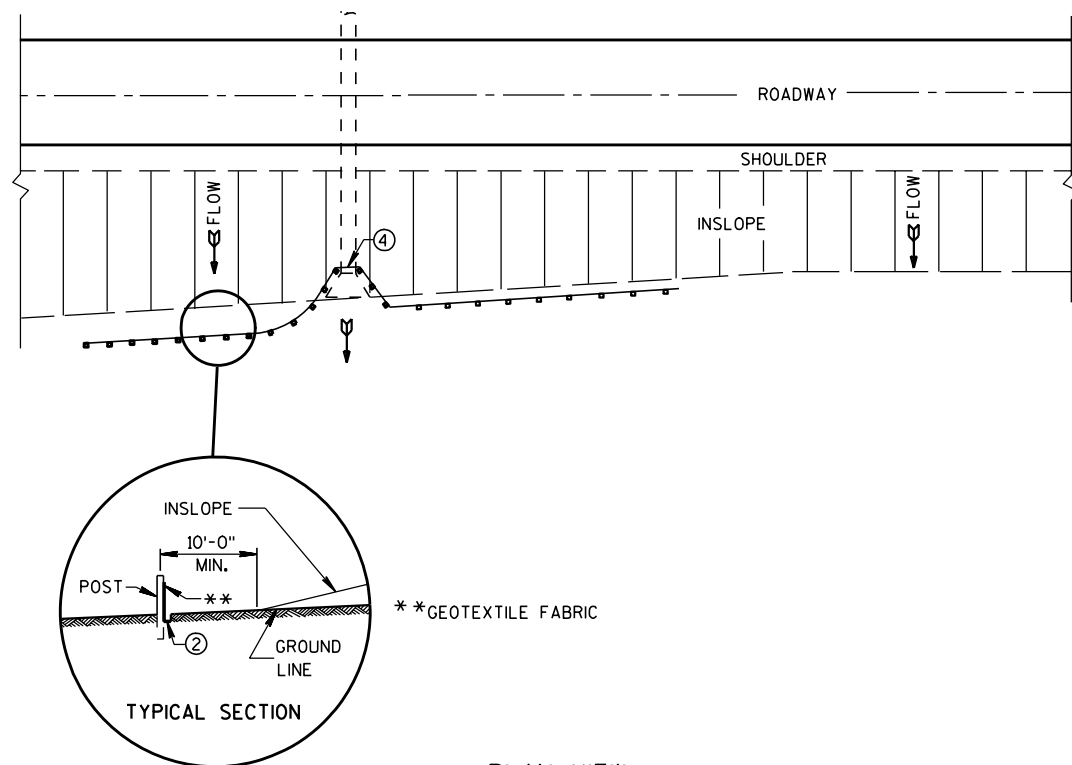


PLAN VIEW

TYPICAL APPLICATION OF SILT FENCE

NOTE: ADDITIONAL POST DEPTH OR TIE BACKS MAY BE REQUIRED IN UNSTABLE SOILS

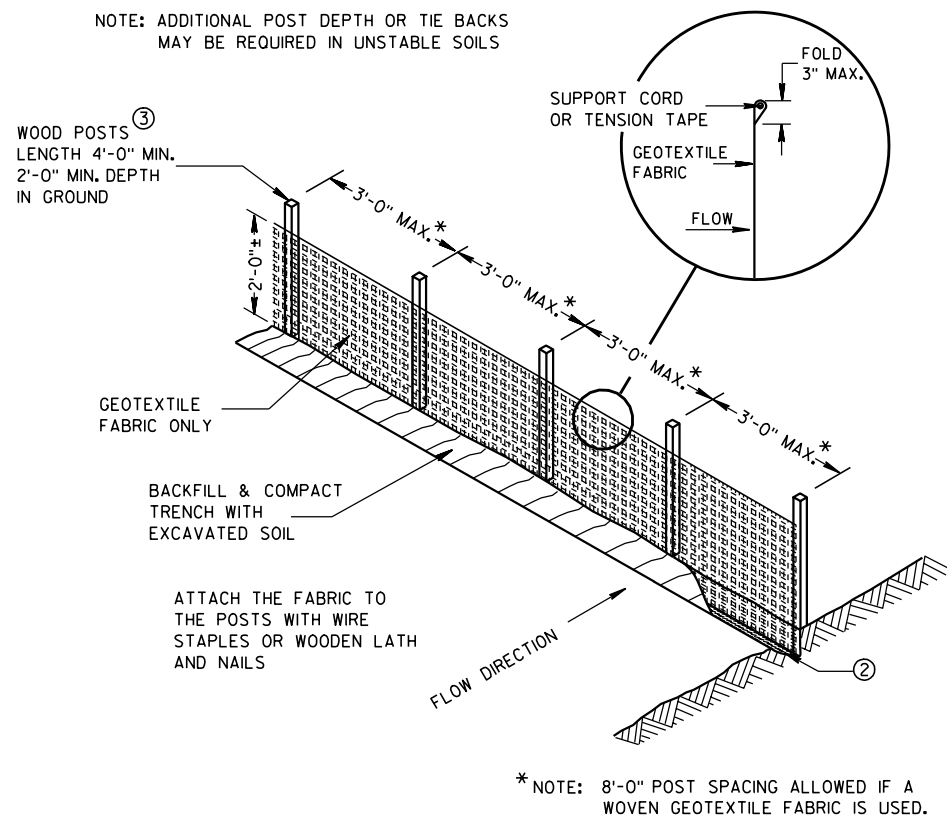


SILT FENCE

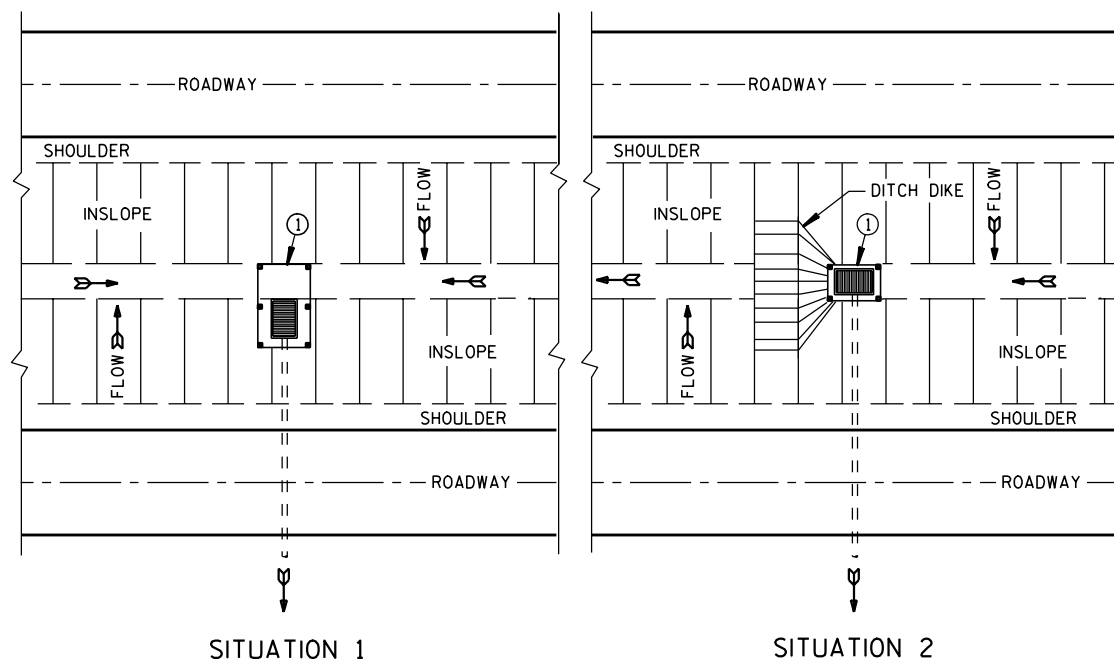

PLAN VIEW


SILT FENCE AT MEDIAN SURFACE DRAINS

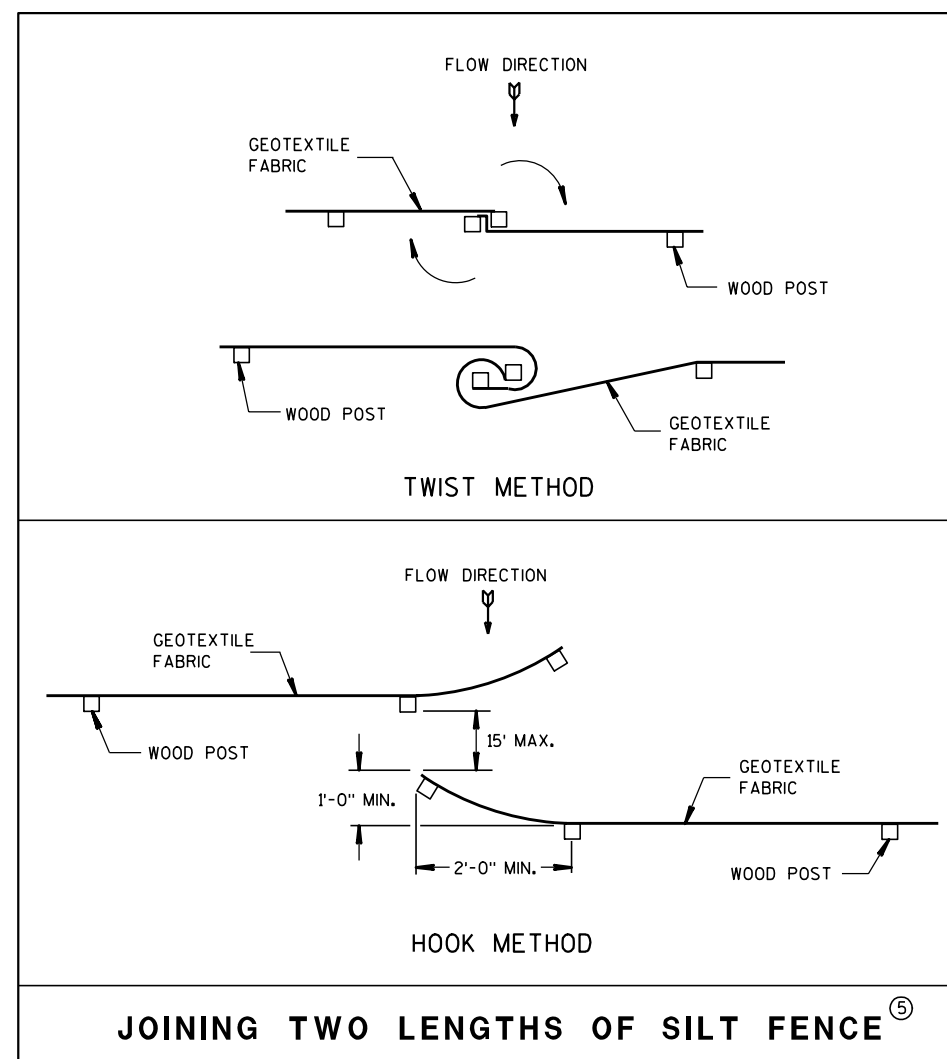


GENERAL NOTES

DETAILS OF CONSTRUCTION NOT SHOWN ON THIS DRAWING SHALL CONFORM TO THE PERTINENT REQUIREMENTS OF THE STANDARD SPECIFICATIONS AND APPLICABLE SPECIAL PROVISIONS.

- ① HORIZONTAL BRACE REQUIRED WITH 2" X 4" WOODEN FRAME OR EQUIVALENT AT TOP OF POSTS.
- ② FOR MANUAL INSTALLATIONS THE TRENCH SHALL BE A MINIMUM OF 4" WIDE & 6" DEEP TO BURY AND ANCHOR THE GEOTEXTILE FABRIC. FOLD MATERIAL TO FIT TRENCH AND BACKFILL & COMPACT TRENCH WITH EXCAVATED SOIL.
- ③ WOOD POSTS SHALL BE A MINIMUM SIZE OF 1 1/8" X 1 1/8" OF OAK OR HICKORY.
- ④ SILT FENCE TO EXTEND ACROSS THE TOP OF THE PIPE.
- ⑤ CONSTRUCT SILT FENCE FROM A CONTINUOUS ROLL IF POSSIBLE BY CUTTING LENGTHS TO AVOID JOINTS. IF A JOINT IS NECESSARY USE ONE OF THE FOLLOWING TWO METHODS; A) OVERLAP THE END POSTS AND TWIST, OR ROTATE, AT LEAST 180 DEGREES, B) HOOK THE END OF EACH SILT FENCE LENGTH.

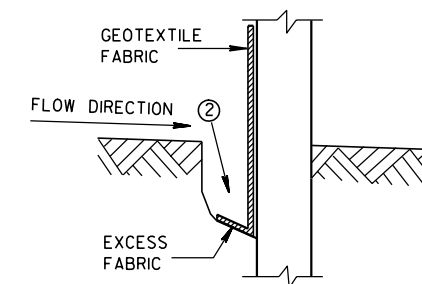

TRENCH DETAIL

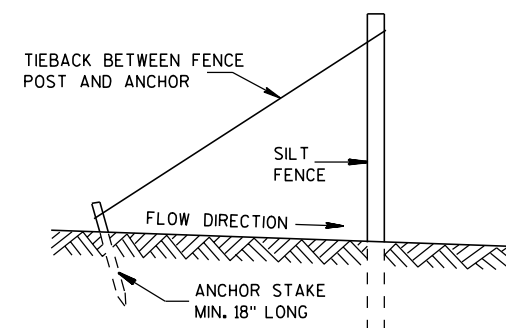SILT FENCE TIE BACK
(WHEN REQUIRED BY THE ENGINEER)

SILT FENCE

STATE OF WISCONSIN
DEPARTMENT OF TRANSPORTATION

APPROVED

4-29-05


DATE

/S/ Beth Conn


CHIEF ROADWAY DEVELOPER

ENGINEER

FHWA

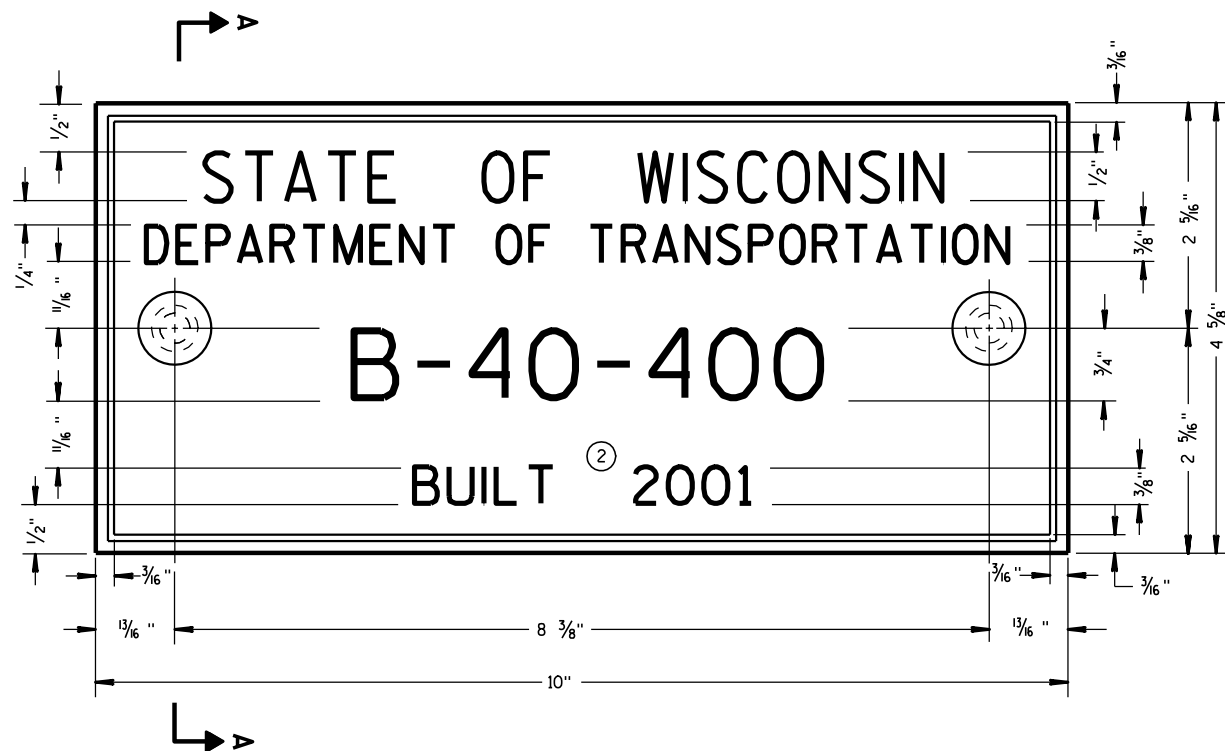

TYPICAL NAME PLATE
(BRIDGES, CULVERTS, AND RETAINING WALLS)

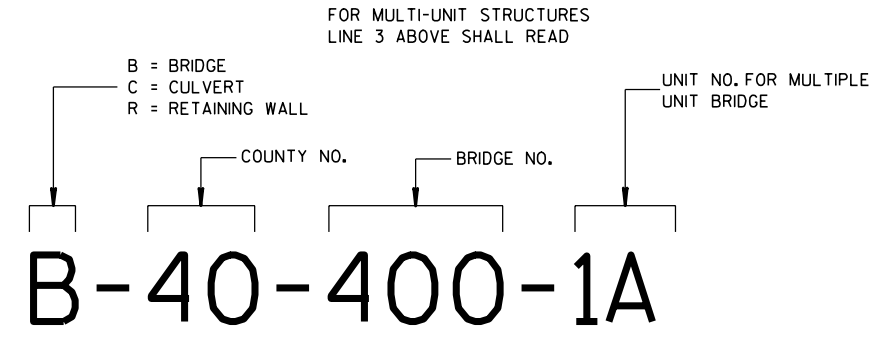


NUMBERING DESIGNATION
MULTI-UNIT STRUCTURES

GENERAL NOTES


NAME PLATES TO BE INSTALLED ON BRIDGES, CULVERTS, AND RETAINING WALLS SHALL CONFORM TO THE REQUIREMENTS OF SECTION 502.3.11 OF THE STANDARD SPECIFICATIONS.

THE BRIDGE NUMBER AND YEAR BUILT SHOWN ON THIS DRAWING ARE EXAMPLES ONLY. SEE CONSTRUCTION PLANS FOR INDIVIDUAL NUMBERING AND YEAR BUILT.


- 1 EPOXY RESIN SHALL BE FROM AN APPROVED MANUFACTURER AND USED IN ACCORDANCE WITH MANUFACTURER'S RECOMMENDATIONS.
- 2 REHABILITATION OF AN EXISTING STRUCTURE SHOULD USE THE DATE OF ORIGINAL STRUCTURE CONSTRUCTION.

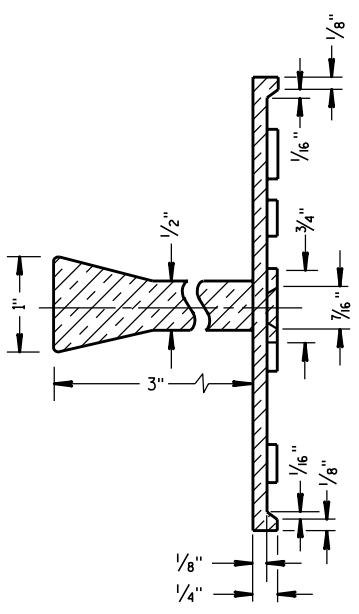

SECTION A-A

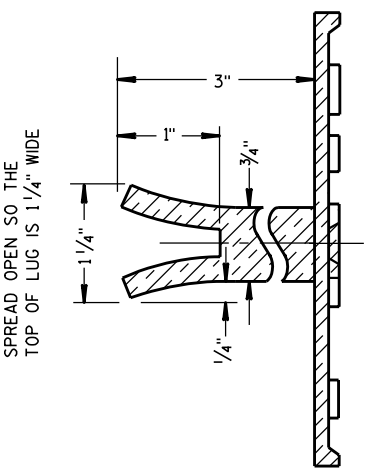









ALTERNATE LUG

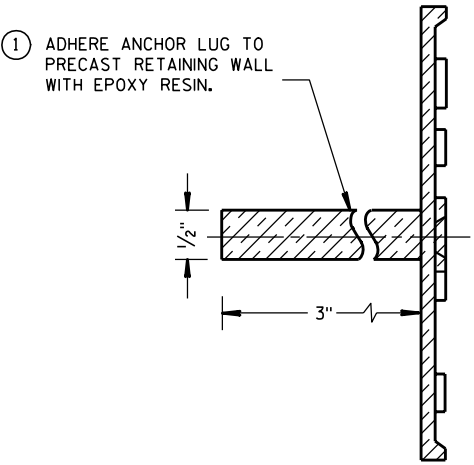


ALTERNATE LUG
(FOR ATTACHMENT TO PRECAST STRUCTURES)

NAME PLATE (STRUCTURES)		
STATE OF WISCONSIN DEPARTMENT OF TRANSPORTATION		
APPROVED DATE 3/26/10	CHIEF STRUCTURAL DEVELOPER 14 /S/ Scot Beck	JEER
FHWA		

- ① WOOD OR STEEL POSTS (w6X9 OR w6X8.5) MAY BE USED. DO NOT INTERMIX WOOD AND STEEL POSTS. INSTALL STEEL POSTS WITH HOLES ON APPROACHING TRAFFIC SIDE.
- ② USE WOOD OR APPROVED PLASTIC BLOCKOUTS. WOOD BLOCKOUTS MAY BE CONSTRUCTED OUT OF TWO OR MORE WOOD BLOCKOUTS. SEE ALTERNATE WOOD BLOCKOUT DETAIL. DIMENSIONS OF APPROVED PLASTIC BLOCKOUTS MAY VARY.
- ③ IF ROCK IS ENCOUNTERED DURING EXCAVATION, PROVIDE A HOLE 12 INCHES IN DIAMETER EXTENDING 20 INCHES DEEP INTO THE ROCK. PLACE APPROXIMATELY 2 1/2" INCHES OF GRANULAR MATERIAL IN THE BOTTOM OF THE HOLE. CUT THE POSTS TO LENGTH AND INSTALL. BACKFILL WITH EXCAVATED MATERIAL AND COMPACT. BACKFILL IS TO BE FREE OF LARGE ROCKS.
- ④ WHEN THE DISTANCE FROM BACK OF POST TO SHOULDER HINGE POINT IS LESS THAN 2 FEET INSTALL LONGER POST AT HALF POST SPACING (K).
- ⑤ FOR NEW MGS INSTALLATION TOP OF W-BEAM RAIL TOLERANCE IS $\pm 1"$. FOR EXISTING MGS INSTALLATION TOP OF W-BEAM IS BETWEEN $27 \frac{3}{4}"$ TO $32"$.
- ⑥ WHEN USING STEEL POST AND WOOD BLOCKOUTS INSTALL FOUR 16D GALVANIZED NAILS. INSTALL NAILS AT THE BACK CORNERS OF THE BLOCK AND BEND THE NAILS OVER THE FLANGE OF THE STEEL POST.
- ⑦ TOTAL POST LENGTH FOR TYPE K IS 7' - 0".
TOTAL POST LENGTH FOR OTHER MGS TYPES IS 6' - 0".

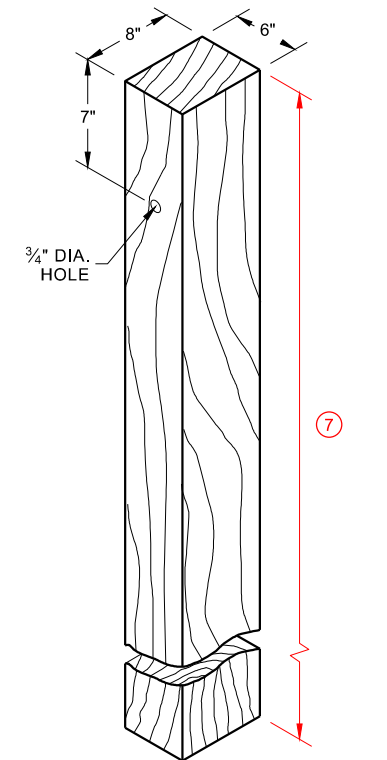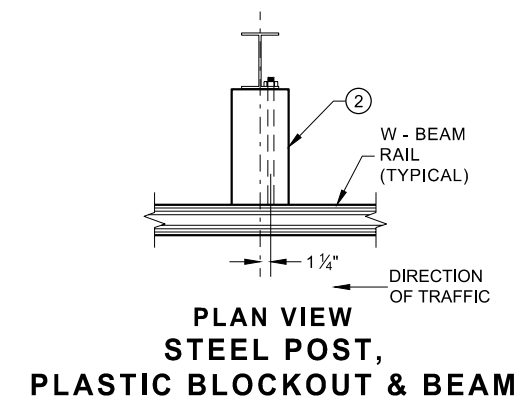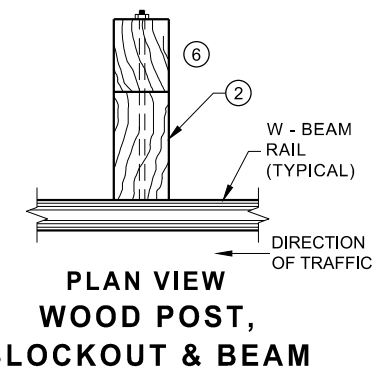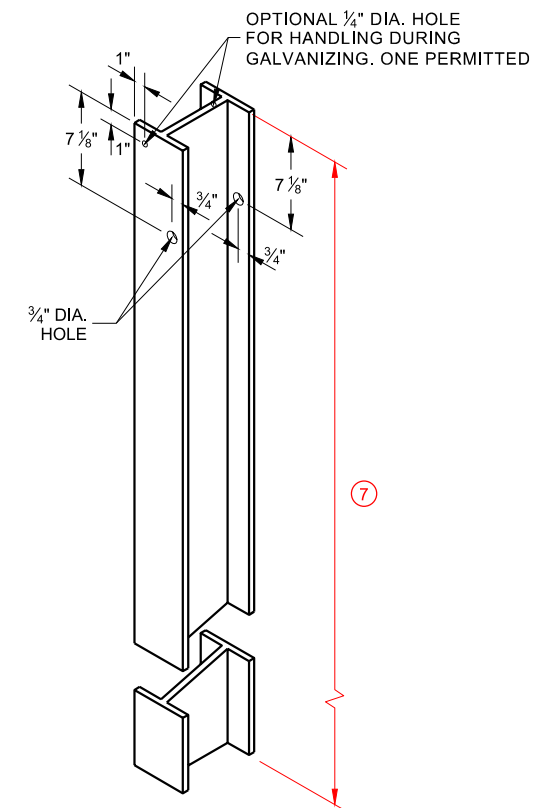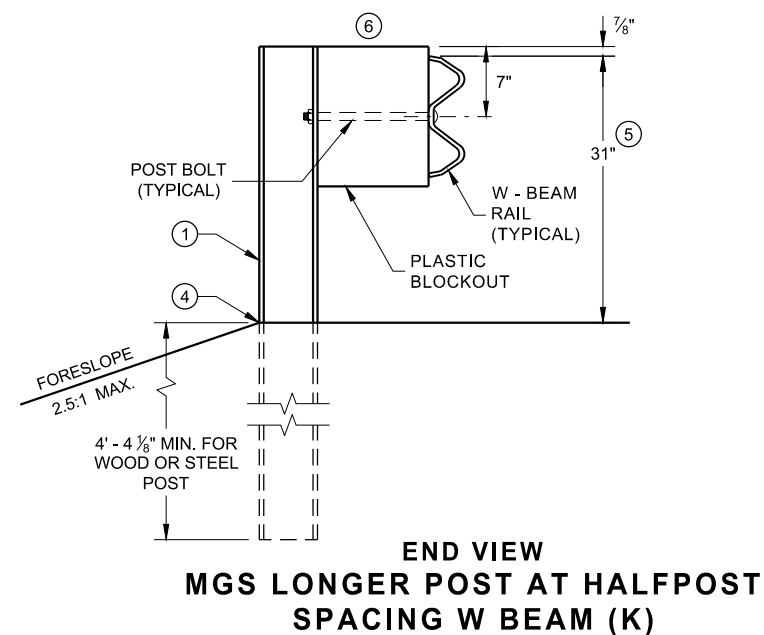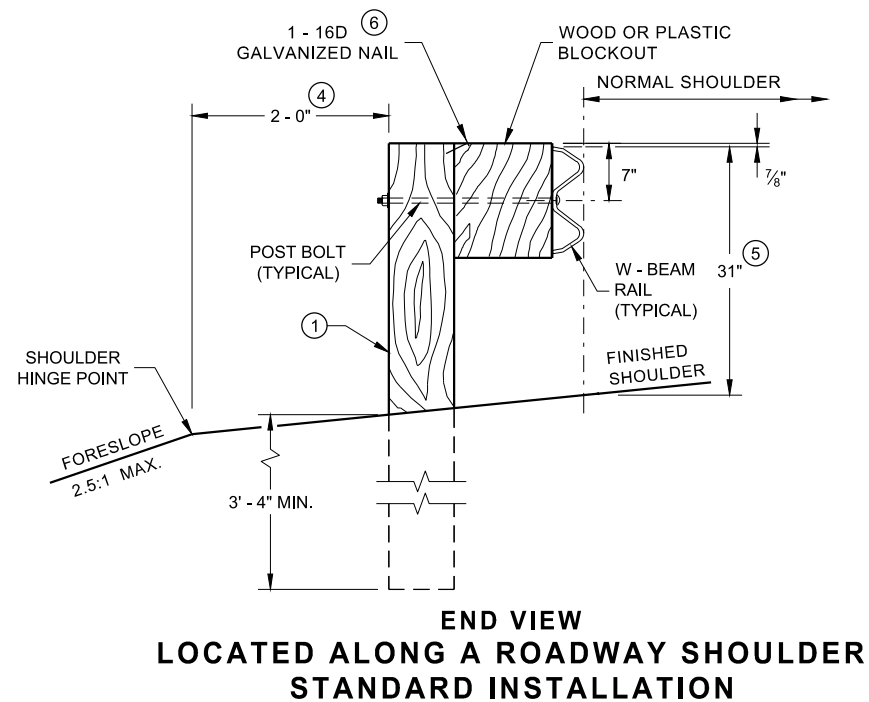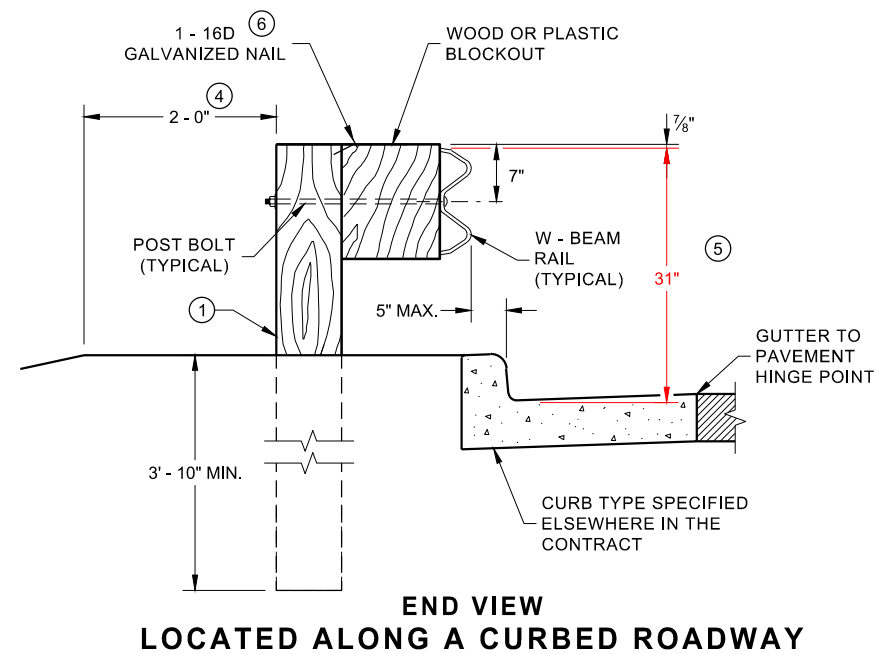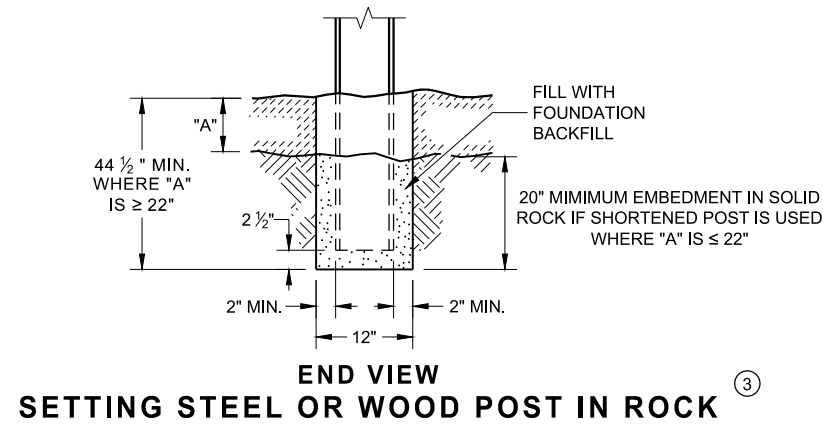


WOOD POST (6" X 8") NOMINAL ⁽¹⁾

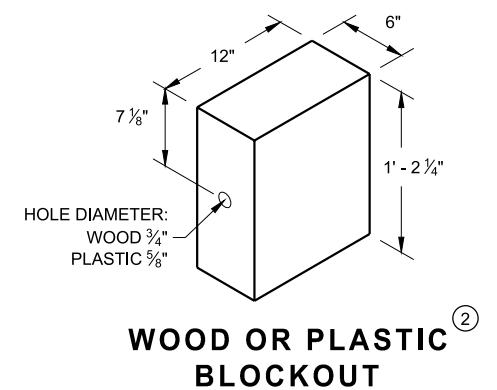


**WOOD OR PLASTIC
BLOCKOUT**

MIDWEST GUARDRAIL SYSTEM (MGS) GUARDRAIL


STATE OF WISCONSIN
DEPARTMENT OF TRANSPORTATION 15

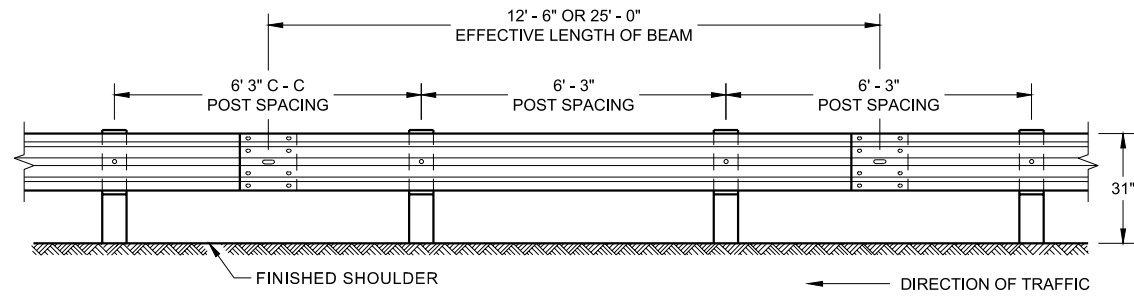


**FRONT VIEW
POST SPACING STANDARD INSTALLATION**

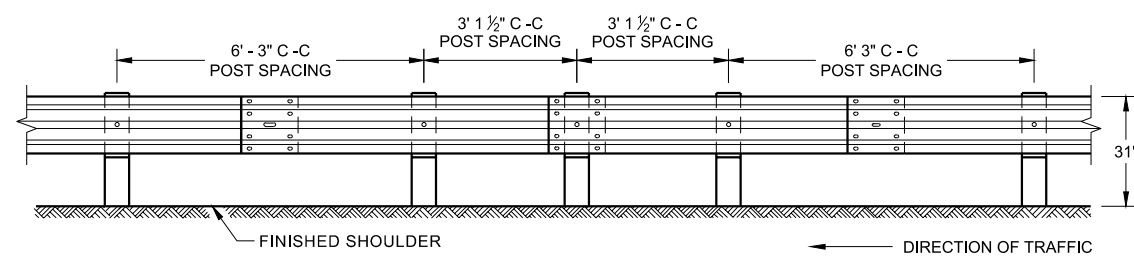


**FRONT VIEW
HALF POST SPACING (HS) AND
HALF POST SPACING WITH LONGER POSTS (K)**

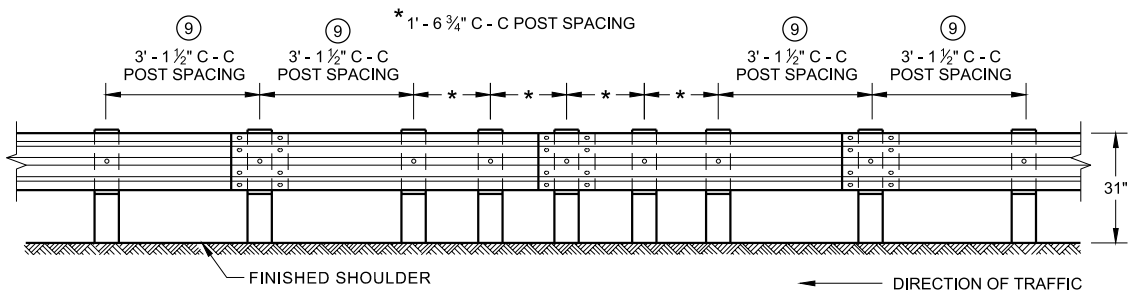


**FRONT VIEW
QUARTER POST SPACING (QS)**

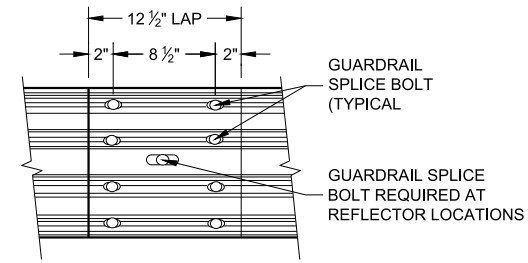


**FRONT VIEW
MID-SPAN BEAM SPLICE**

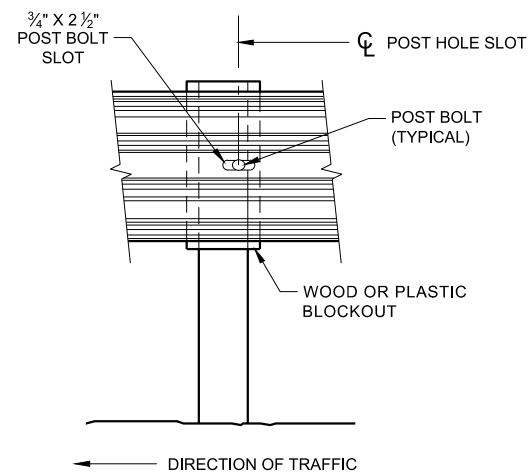

FRONT VIEW AT STEEL POST

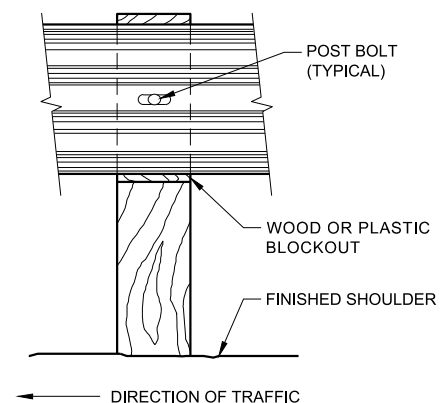


FRONT VIEW AT WOOD POST

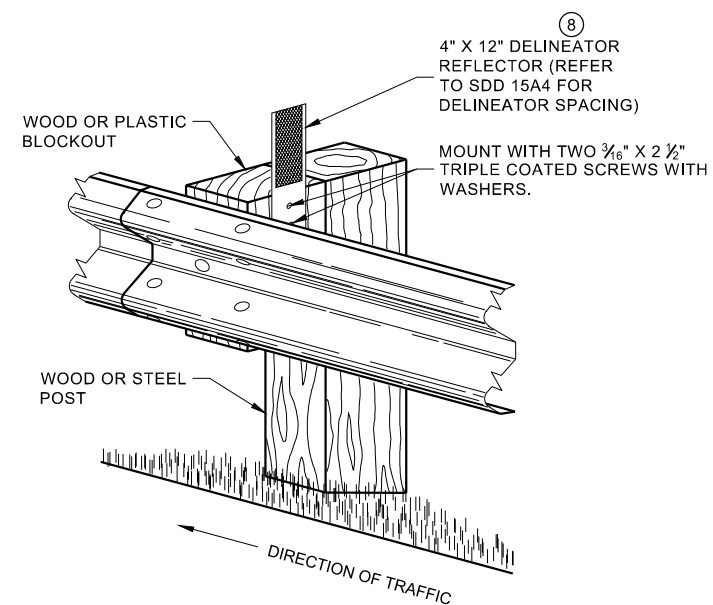

**ONE SIDED REFLECTOR DETAIL
AND TYPICAL INSTALLATION**

GENERAL NOTES


- ⑧ DO NOT INSTALL REFLECTORS ON THE FIRST 50 FEET OF THE APPROACH END OF THE ENERGY ABSORBING TERMINAL. RAIL SPLICE LOCATIONS ARE THE ONLY ACCEPTABLE LOCATIONS FOR REFLECTORS.
 - ⑨ 25 FEET OF HALF POST SPACING IS REQUIRED ON APPROACH AND DEPARTURE ENDS OF QUARTER POST SPACING.
- POST BOLTS ARE A 3/8" DIAMETER ASTM A307 GUARDRAIL BOLT. A POST BOLT REQUIRES 3/4" DIAMETER A563A DOUBLE RECESSED (DR) HEAVY HEX NUT AND 3/4" DIAMETER F844 FLAT WASHER. POST BOLTS MAY BE LONGER IF MULTIPLE BLOCKOUTS ARE BEING USED.
- GUARD RAIL SPLICE BOLTS ARE A 3/8" DIAMETER ASTM A307 GUARDRAIL HEAD BOLT. A GUARDRAIL SPLICE BOLT REQUIRES 3/4" DIAMETER A563A DOUBLE RECESSED (DR) HEAVY HEX NUT.

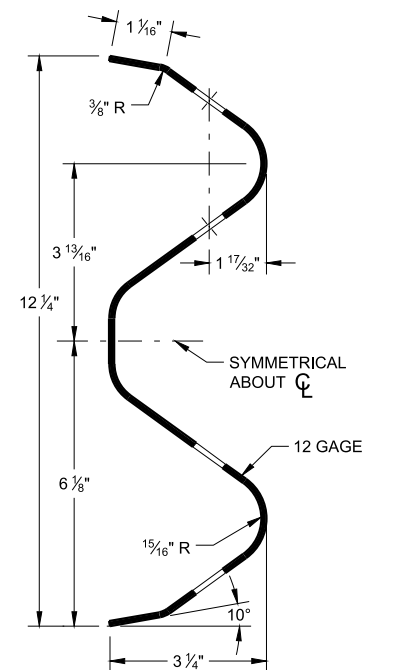

SECTION THRU W-BEAM RAIL

**MIDWEST GUARDRAIL SYSTEM
(MGS) GUARDRAIL**


STATE OF WISCONSIN
DEPARTMENT OF TRANSPORTATION

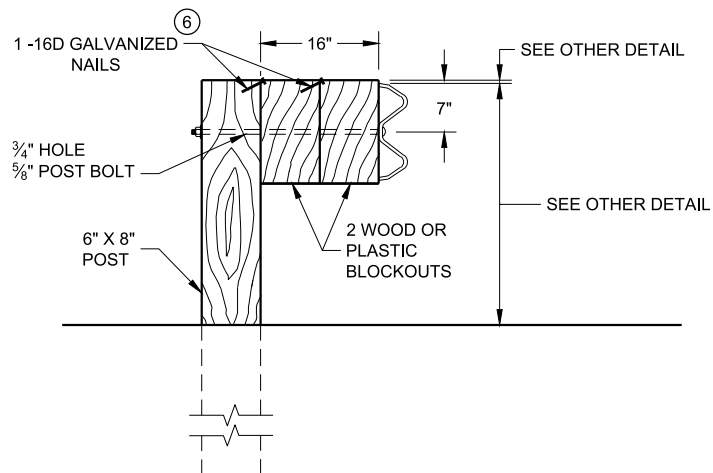

DETAIL FOR 16" BLOCKOUT DEPTH


IT IS ACCEPTABLE TO USE BLOCKOUTS UP TO 16" DEEP TO INCREASE THE POST OFFSET TO AVOID UNDERGROUND OBSTACLES. THERE IS NO LIMIT TO THE NUMBER OF POSTS THAT CAN HAVE ADDITIONAL BLOCKOUTS UP TO 16" DEEP.

- NOTE:
1. ALL FILLETS SHALL HAVE A MINIMUM RADIUS OF $\frac{3}{16}$ ".
 2. IF THE BOLT EXTENDS MORE THAN $\frac{1}{4}$ " FROM THE NUT THE BOLT SHOULD BE TRIMMED BACK.

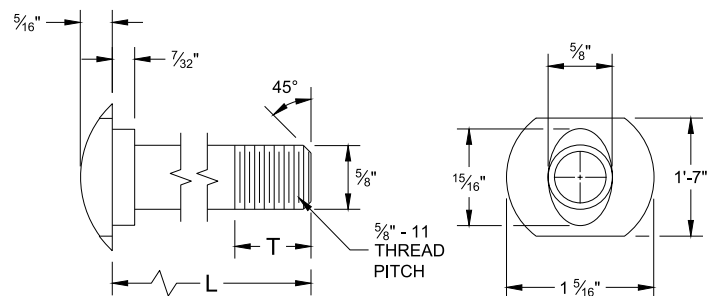


POST BOLT TABLE


L	T (MIN.)
1 1/4"	1 1/8"
2"	1 3/4"
10"	4"
14"	4 1/16"
18"	4"
21"	4 1/16"
25"	4"

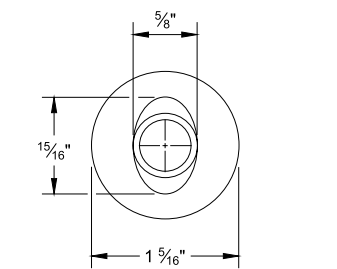


ALTERNATE BOLT HEAD

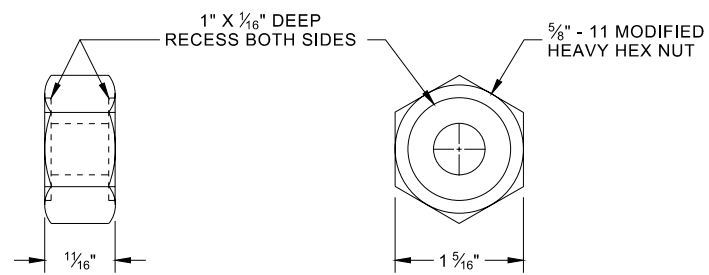


POST BOLT, SPLICE BOLT AND RECESS NUT

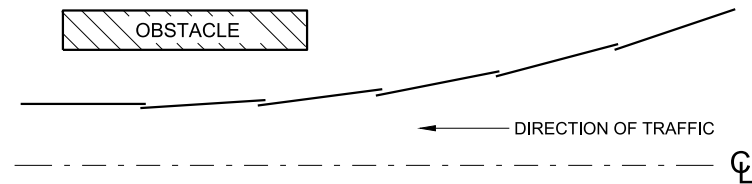

PLAN VIEW BEAM LAPPING DETAIL

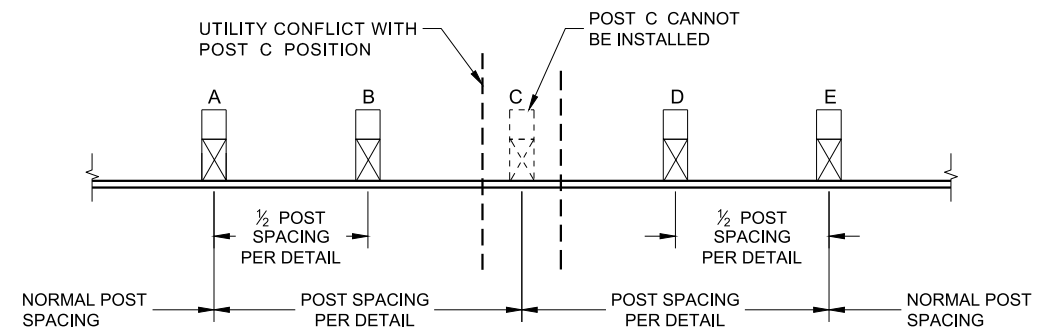

POST DRIVING FOR CONTINUOUS UNDERGROUND OBSTRUCTION

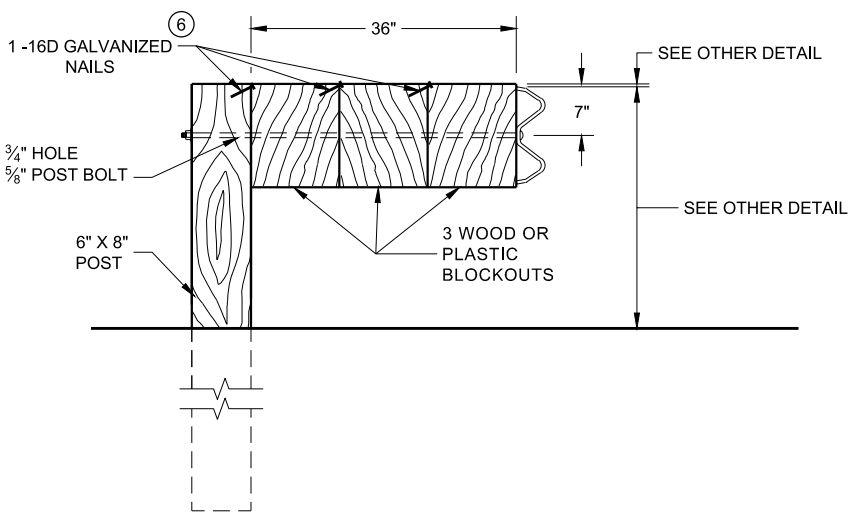


DETAIL FOR 36" BLOCKOUT DEPTH


NOTES: UNDER SPECIAL CIRCUMSTANCES, SUCH AS AVOIDING OBSTACLES THAT ARE NOT RELOCATED, IT IS ACCEPTABLE TO INSTALL ADDITIONAL BLOCKOUTS TO OBTAIN UP TO 36" DEPTH FOR ONE OR TWO POSTS IN A SECTION OF GUARDRAIL.

DO NOT USE 16" OR 36" BLOCKOUTS IF IT CAUSES THE POST TO BE DRIVEN BEYOND SHOULDER HINGE POINT OR CAUSES A FIXED OBJECT TO BE WITHIN THE DEFLECTION DISTANCE OF THE BARRIER.

- 6 WHEN USING STEEL POST AD WOOD BLOCKOUTS, INSTALL FOUR 16D GALVANIZED NAILS. INSTALL NAILS AT THE BACK CORNERS OF THE BLOCK AND BEND THE NAILS OVER THE FLANGE OF THE STEEL POST.

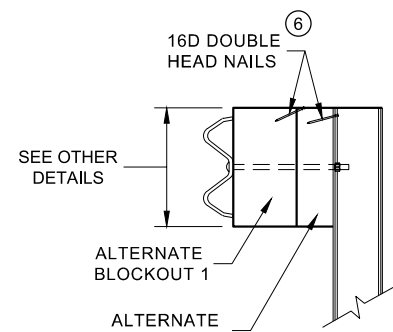

SIDE VIEW

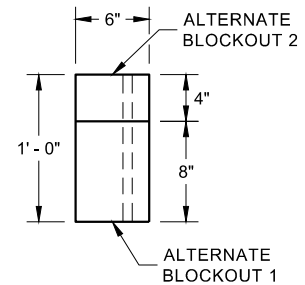

PLAN VIEW

ALTERNATE WOOD BLOCKOUT DETAIL

MIDWEST GUARDRAIL SYSTEM (MGS) GUARDRAIL


STATE OF WISCONSIN DEPARTMENT OF TRANSPORTATION

- (A) THE SLOPE IN THE AREA BOUNDED BY THE GRADELINE, THE HINGE POINT LINE (HPL) AND THE CLEAR ZONE LIMITS (CZL) SHALL BE 4:1 OR FLATTER.
- (B) AFTER FINAL ASSEMBLY, RECHECK CABLE TO BE SURE IT IS TAUT AND HAS NOT RELAXED
- (C) DIFFERENT MANUFACTURERS REQUIRE DIFFERENT PERFORATED W - BEAM RAIL END PANELS. SEE MANUFACTURER'S INFORMATION.
- (D) ATTACH ALUMINUM SHEET TO E.A.T. HEAD USING 4 STAINLESS STEEL SELF - TAPPING SCREWS. ONE SCREW PER CORNER.
- (E) HARDWARE MAY VARY BETWEEN MANUFACTURER. SEE MANUFACTURER'S DRAWING FOR INFORMATION.

DIMENSIONS MAY VARY, MANUFACTURER'S INFORMATION.


THE CENTER OF THE UPPER 3 1/2" DIAMETER HOLE ON POST NUMBER 3 THROUGH POST 9 IS TO BE FLUSH WITH THE GROUND LINE UP TO A MAXIMUM OF 2" ABOVE GROUND LINE. WOOD BLOCKS ON POSTS NUMBERED 3 THROUGH 9 MAY BE ADJUSTED UP TO 3" ABOVE THE TOP OF POST.

STATE OF WISCONSIN
DEPARTMENT OF TRANSPORTATION 18

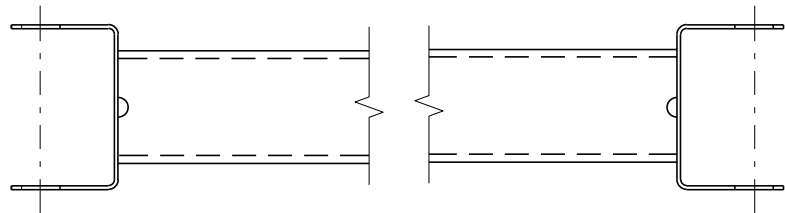


GENERIC GROUND STRUT⁹ E


BILL OF MATERIALS	
PART NO.	DESCRIPTION MATERIALS PROVIDED BY MGS EAT MANUFACTURER. SEE MANUFACTURER'S DETAILS FOR MORE INFORMATION.
①	UPPER POST NO. 1 6" X 6" TUBE
②	LOWER POST NO. 1
③	WOOD CRT
④	WOOD BLOCKOUT
⑤	PIPE SLEEVE
⑥	BEARING PLATE
⑦	BCT CABLE ASSEMBLY
⑧	ANCHOR CABLE BOX
⑨	GROUND STRUT
⑩	PERFORATED W-BEAM RAIL END PANEL, 12'-6" LONG.
⑪	STANDARD W-BEAM RAIL. MULTIPLE SECTIONS REQUIRED. SECTIONS VARY IN LENGTH.
⑫	IMPACT HEAD
⑬	EAT MARKER POST - YELLOW (SEE APPROVED PRODUCTS LIST)
⑭	SOIL PLATE
⑮	UPPER POST NO. 2
⑯	LOWER POST NO. 2

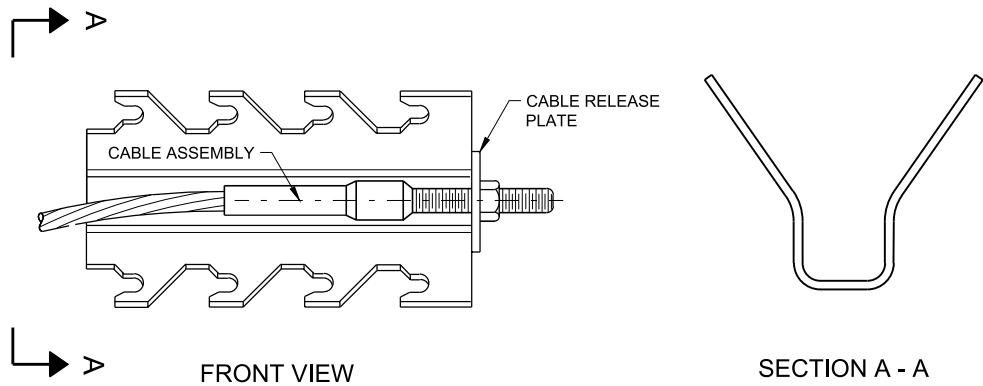


GENERIC ANCHOR CABLE BOX⁹ E

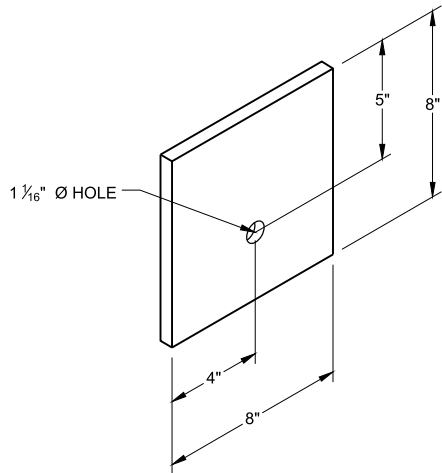


BEARING PLATE⁶ E

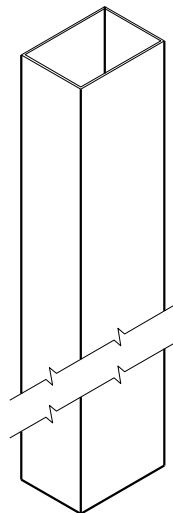


UPPER POST NO. 1 ⁽¹⁾ (E)

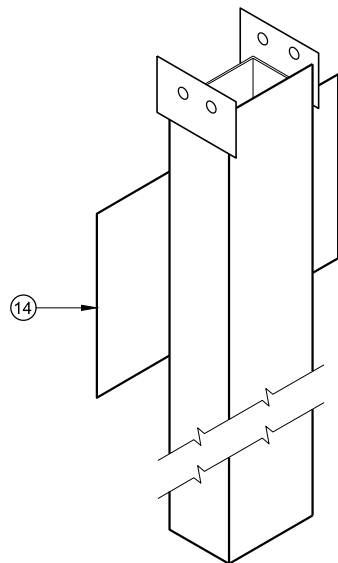


LOWER POST NO. 1 ⁽²⁾ (E)

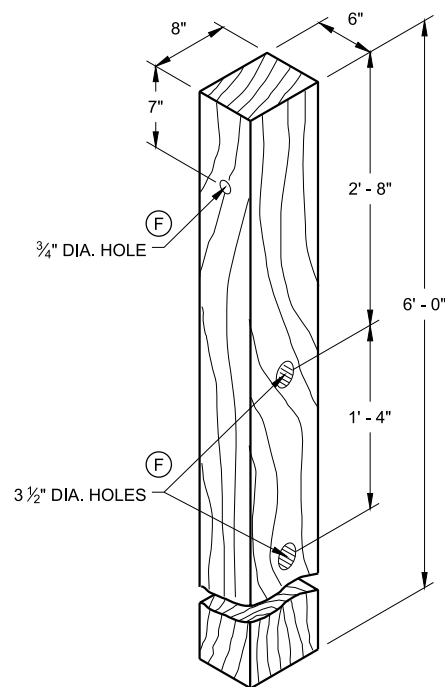


WOOD CRT POST ⁽³⁾ (E)
POSTS NUMBER 3-9

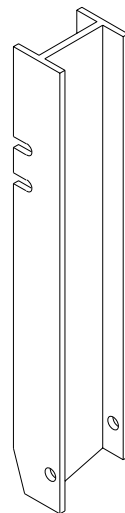


UPPER POST NO. 2 ⁽¹⁵⁾ (E)

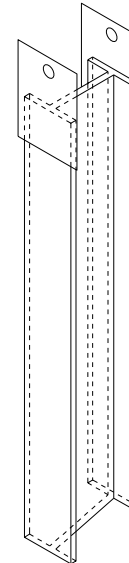


LOWER POST NO. 2 ⁽¹⁶⁾ (E)

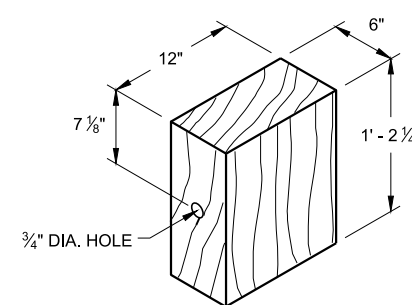


WOOD BLOCKOUT ⁽⁴⁾
REQ'D. AT ALL POSTS EXCEPT POST NO'S 1 & 2

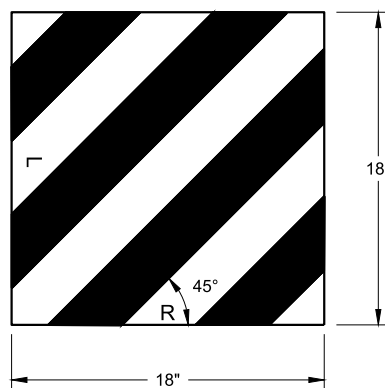


REFLECTIVE SHEETING DETAIL ^(E)

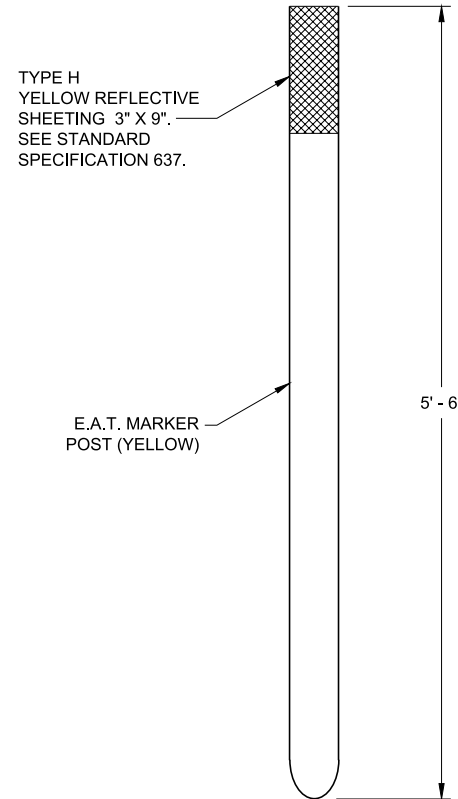

E.A.T. MARKER POST ⁽¹³⁾

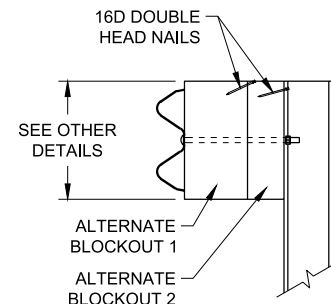

SIDE VIEW

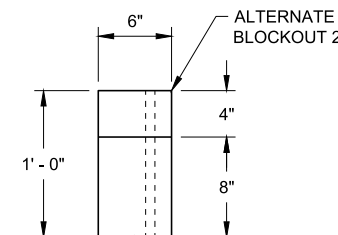


TOP VIEW

ALTERNATE WOOD
BLOCKOUT DETAIL


**MIDWEST GUARDRAIL SYSTEM
ENERGY ABSORBING TERMINAL
(MGS)**

STATE OF WISCONSIN
DEPARTMENT OF TRANSPORTATION

APPROVED
7/2018 DATE /S/ Rodney Taylor
ROADWAY STANDARDS DEVELOPMENT UNIT SUPERVISOR
FHWA

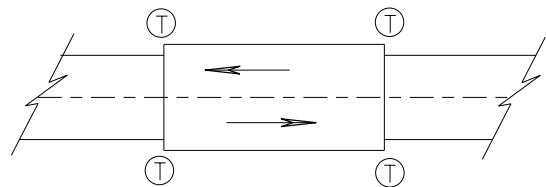

TWO WAY TRAFFIC

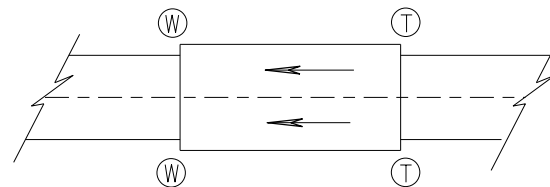

ONE WAY TRAFFIC

(T) THRIE BEAM CONNECTION

(W) W-BEAM CONNECTION WHEN REQUIRED

TYPICAL LOCATIONS OF THRIE BEAM AND W-BEAM CONNECTIONS TO BRIDGE

GENERAL NOTES

IF ROCK IS ENCOUNTERED, REMOVE ROCK TO FULL DEPTH OF POST PLUS 2 1/2", AND 12" DIAMETER AROUND POST. SEE 14B42 FOR MORE DETAILS.

TRANSITION USES STEEL POSTS ONLY.


SEE STANDARD DETAIL DRAWING 14 B 42 FOR MORE INFORMATION.

POST 2 THROUGH 17 USES STEEL POST ONLY


① BRIDGE RAILING TYPE "W" DOES NOT REQUIRE A TERMINAL CONNECTOR.

② OPTIONAL CURB AND GUTTER OR DRAINAGE FEATURE SEE PLAN FOR INFORMATION.

⑬ STEEL OR WOOD POST IS ACCEPTABLE AT POST 1. SEE SDD14B42

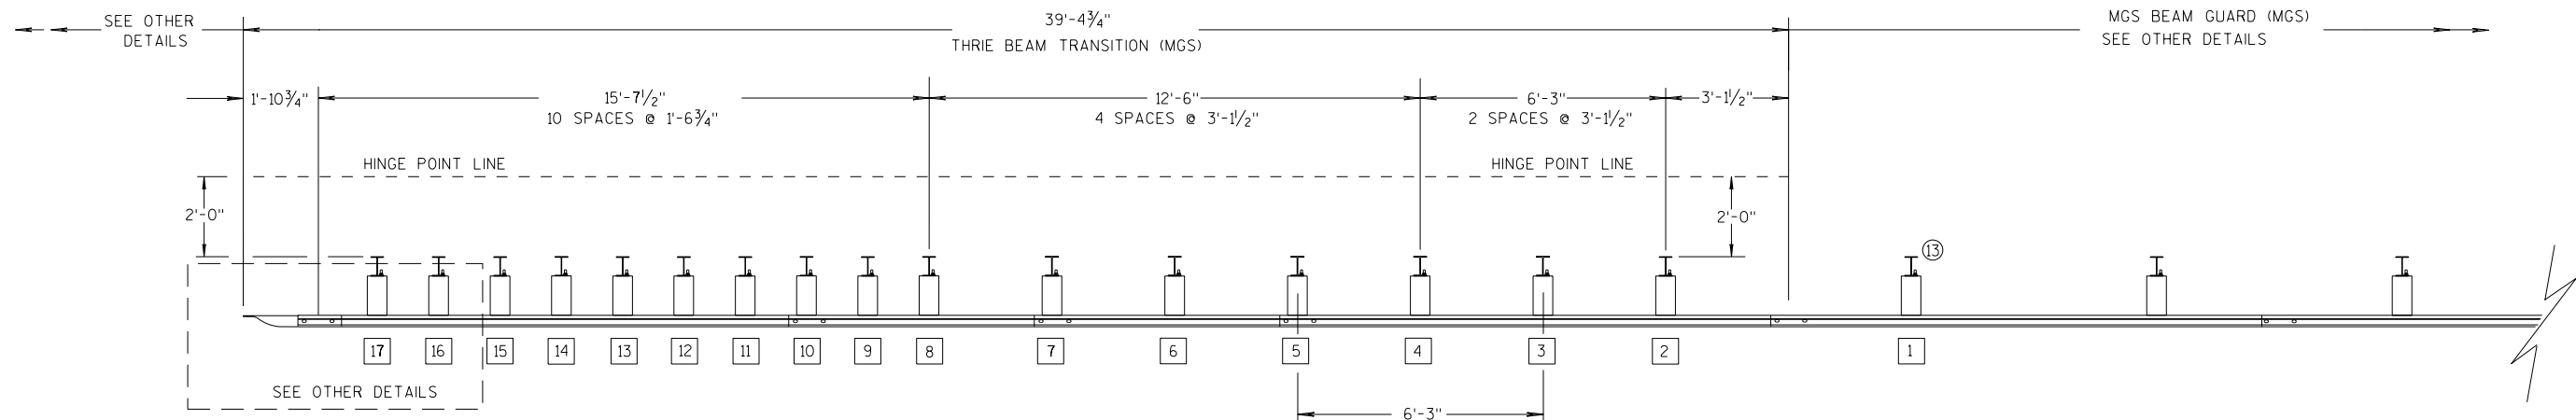

PLAN VIEW

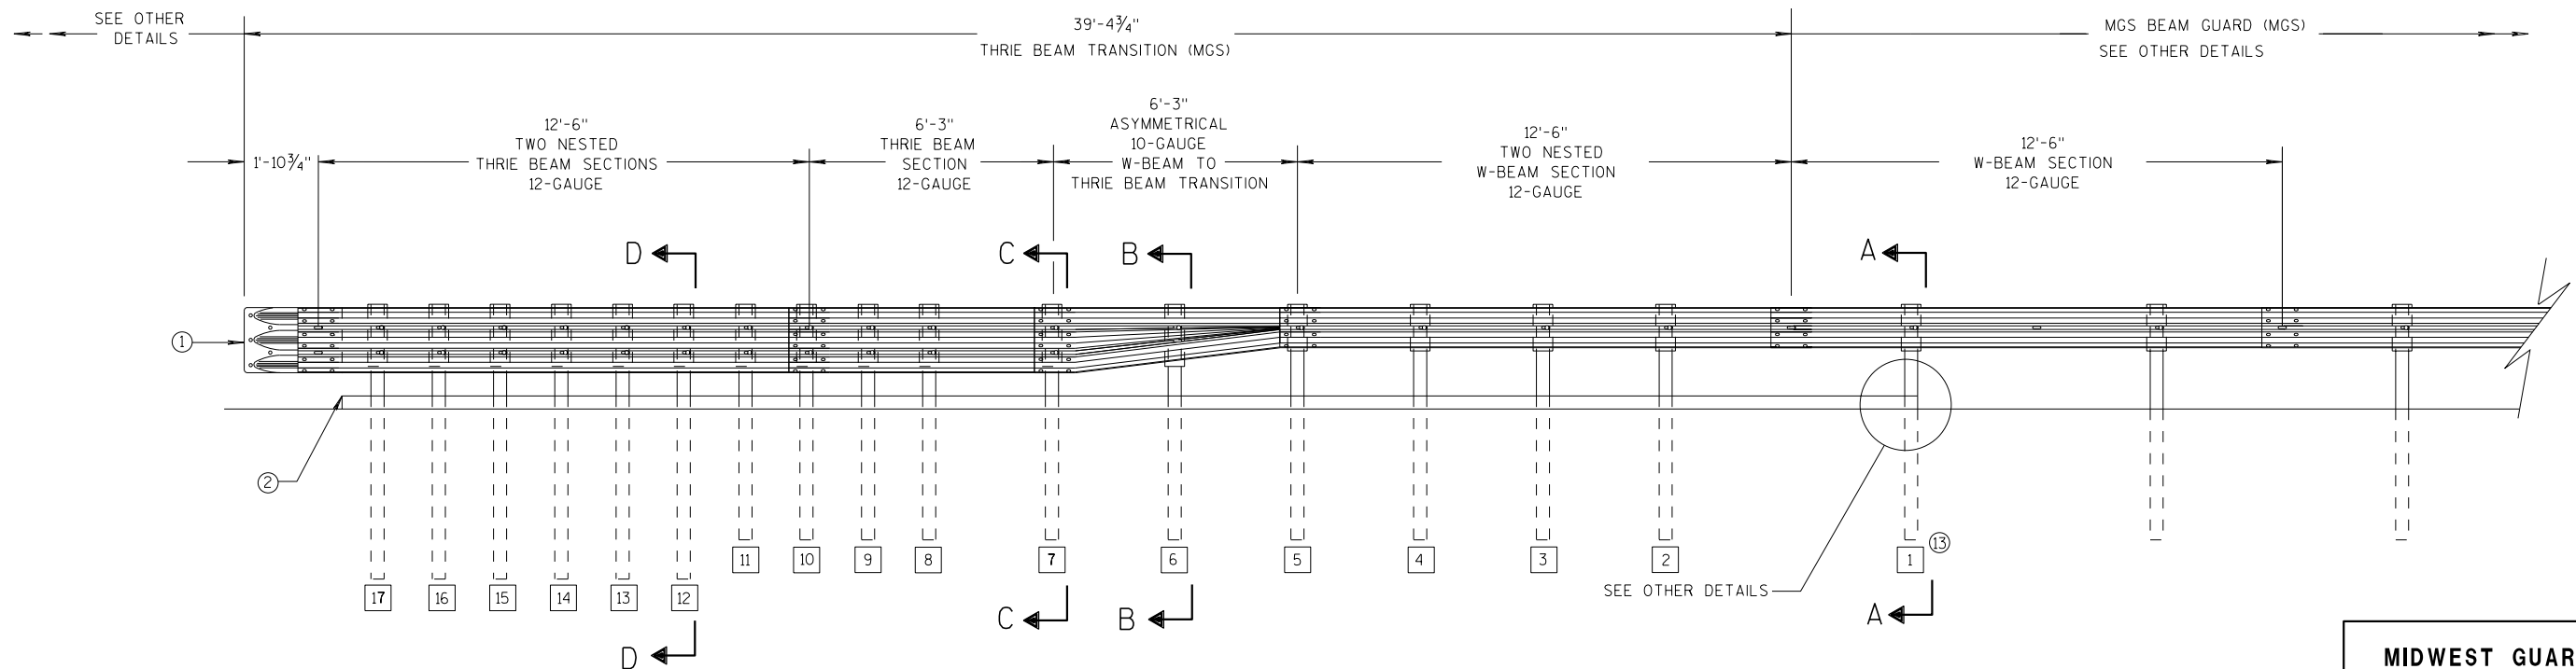

ELEVATION VIEW


MIDWEST GUARDRAIL SYSTEM THRIE BEAM TRANSITION

MIDWEST GUARDRAIL SYSTEM
THRIE BEAM TRANSITION (MGS)


STATE OF WISCONSIN
DEPARTMENT OF TRANSPORTATION

GENERAL NOTES


- 2 OPTIONAL CURB AND GUTTER OR DRAINAGE FEATURE SEE PLAN FOR INFORMATION.
- 3 WHEN USING STEEL POSTS AND WOOD BLOCKOUTS INSTALL FOUR 10D GALVANIZED NAILS. INSTALL NAILS AT THE BACK CORNERS OF THE BLOCK AND BEND THE NAILS OVER THE FLANGE OF THE STEEL POST.
- 4 TOLERANCE FOR TOP OF W-BEAM RAIL IS ± 1".
- 13 STEEL OR WOOD POST IS ACCEPTABLE AT POST 1. SEE SDD 14B42

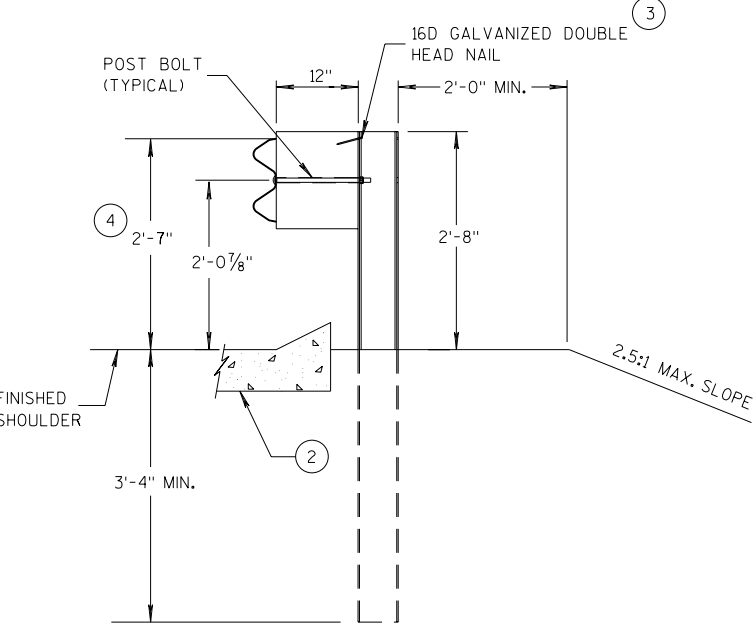


SECTION A-A
POSTS 1-5

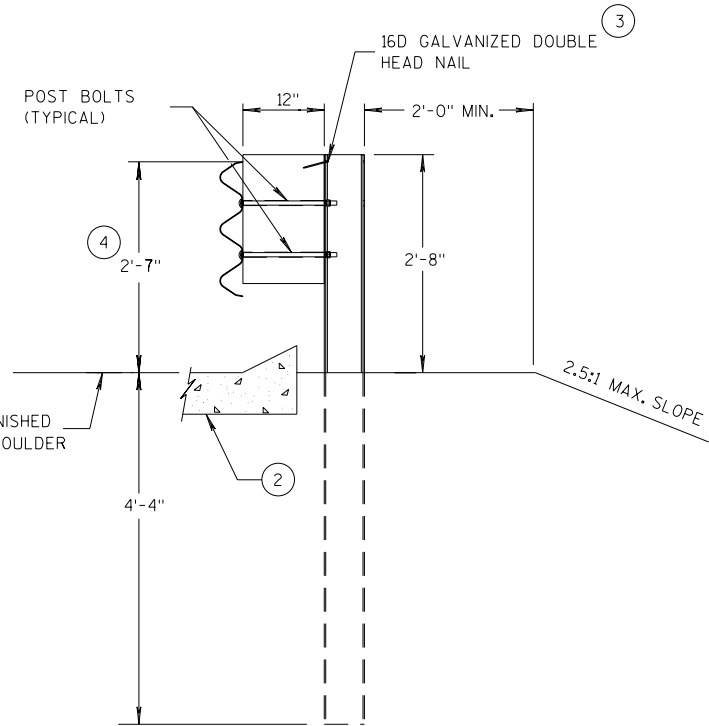

SECTION D-D
POSTS 12-17

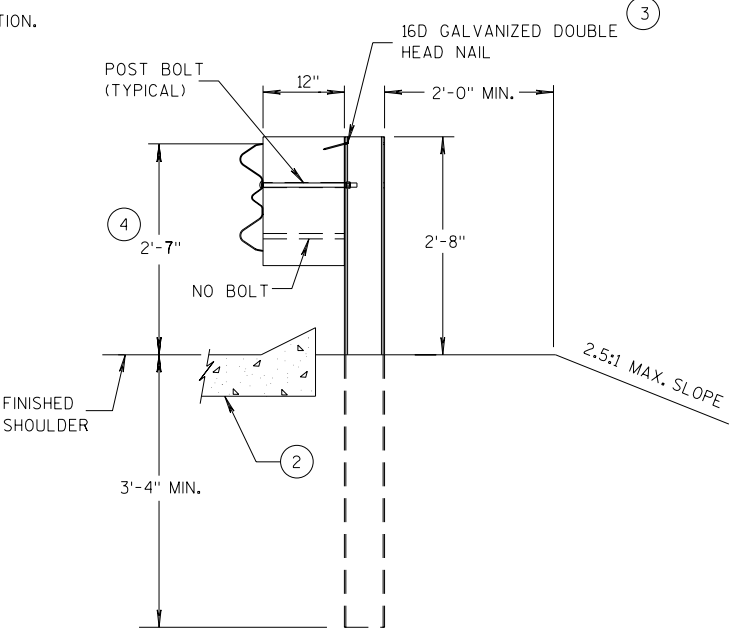

SECTION B-B
POST 6

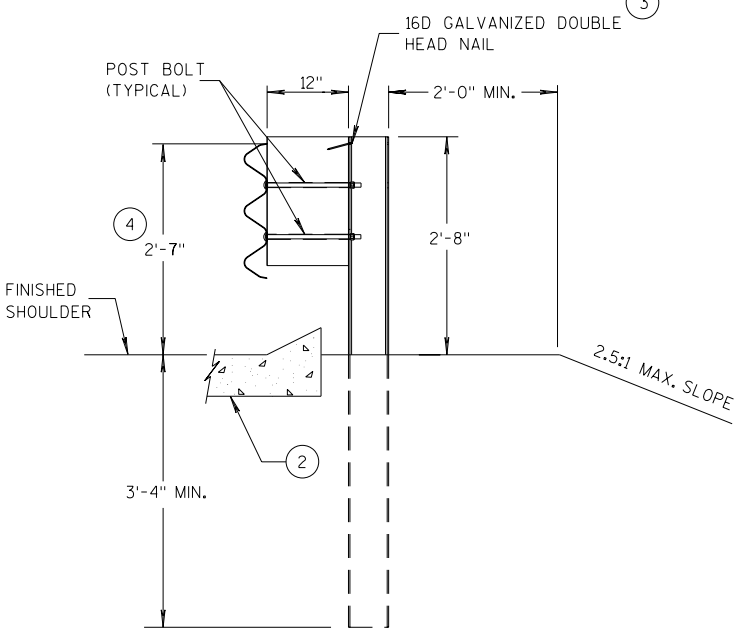

SECTION C-C
POSTS 7-11



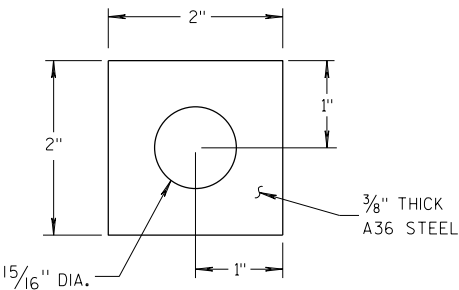



PLATE WASHER DETAIL

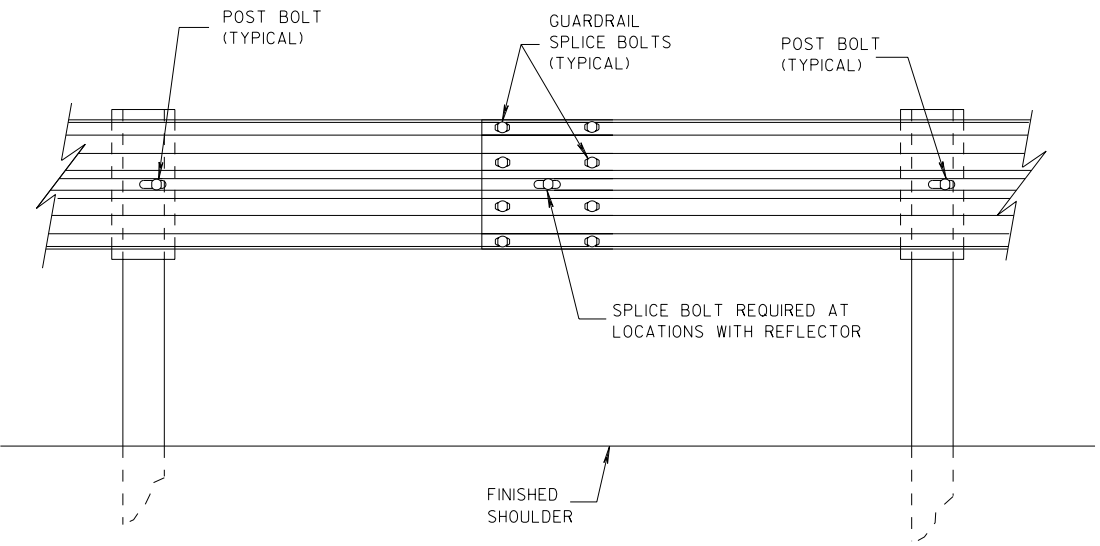

SPlice DETAIL

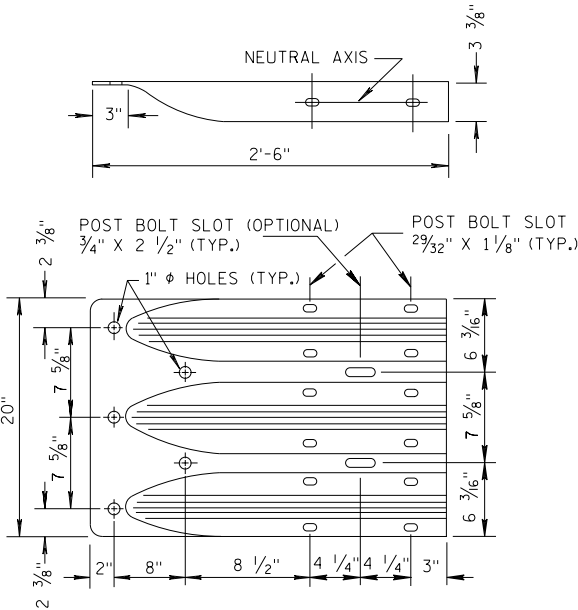


THRIE BEAM
TERMINAL CONNECTOR

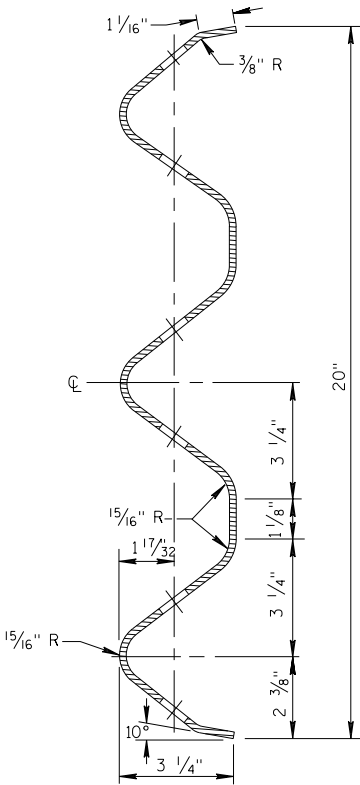


SECTION THRU THRIE
BEAM RAIL ELEMENT

MIDWEST GUARDRAIL SYSTEM
THRIE BEAM TRANSITION (MGS)


STATE OF WISCONSIN
DEPARTMENT OF TRANSPORTATION

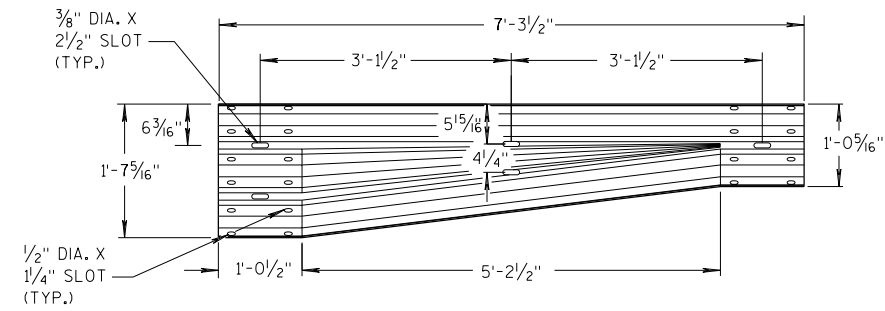


W-BEAM TO THRIE BEAM TRANSITION SECTION

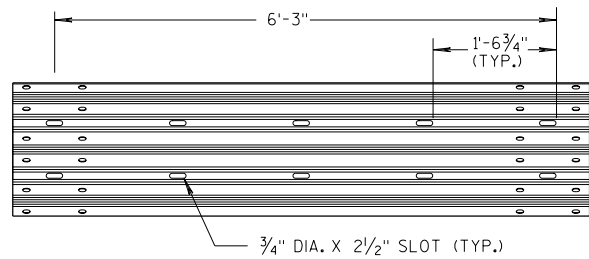


6'-3" THRIE BEAM SECTION

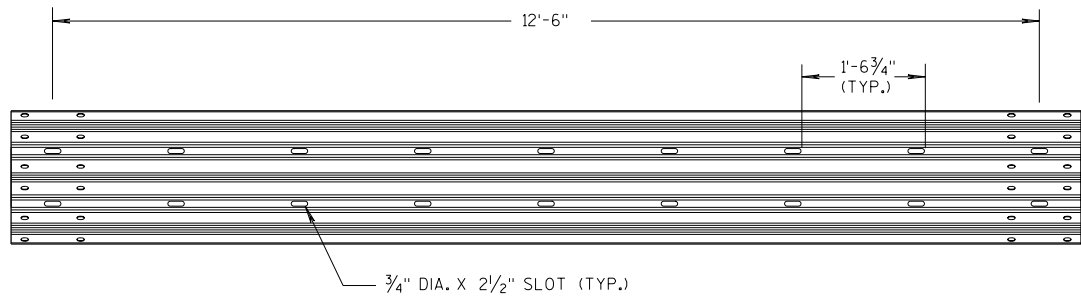

12'-6" THRIE BEAM SECTION

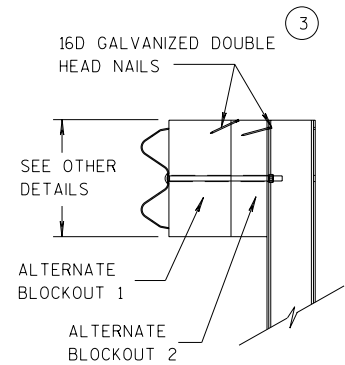


SIDE VIEW

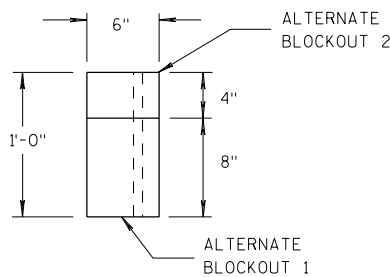

TOP VIEW


ALTERNATE WOOD BLOCKOUT DETAIL

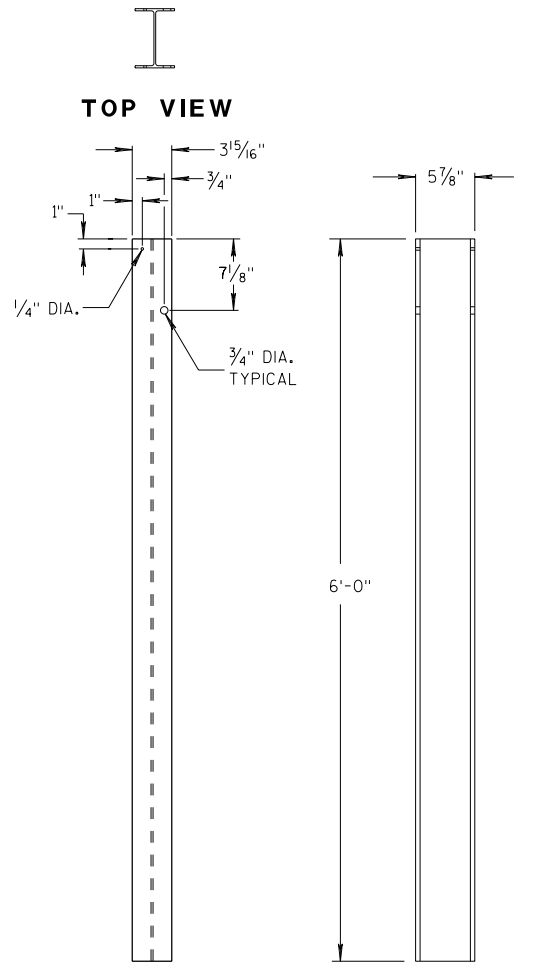


FRONT VIEW

SIDE VIEW

STEEL POSTS 1-5

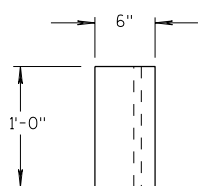


TOP VIEW

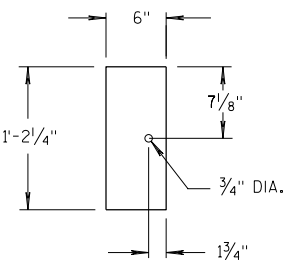

FRONT VIEW


BLOCKOUT POSTS 1-5

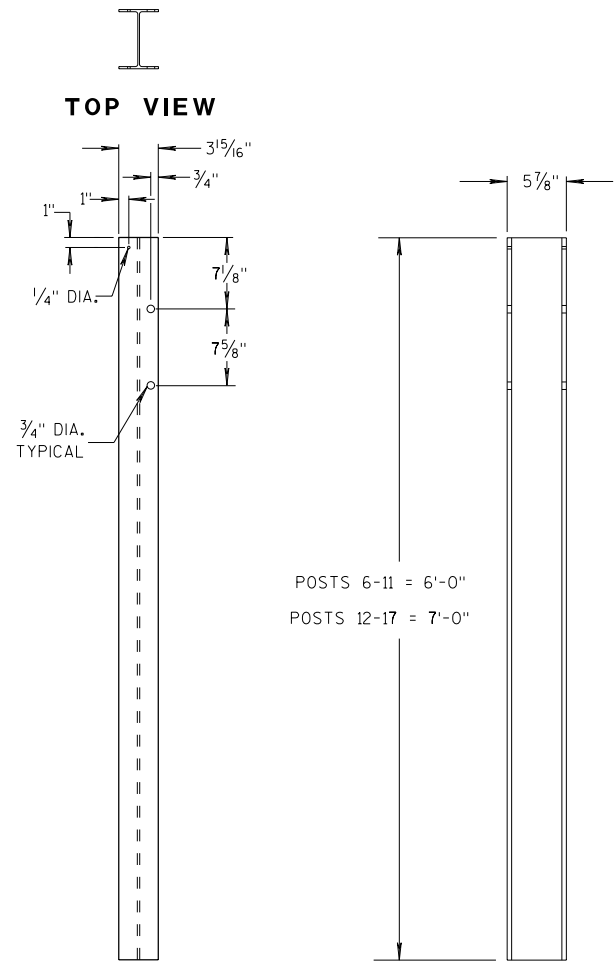


FRONT VIEW

SIDE VIEW

STEEL POSTS 6-17

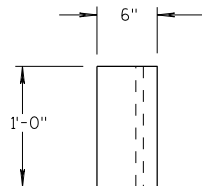

TOP VIEW

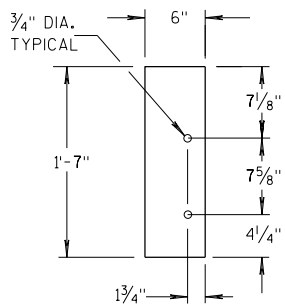

FRONT VIEW

BLOCKOUT POSTS 6-17

GENERAL NOTES

STEEL POSTS ARE W6X9 OR W6X8.5.

BOLT HOLES FOR POST ARE ON FRONT AND OF SIDE OF POST.

③ WHEN USING STEEL POSTS AND WOOD BLOCKOUTS INSTALL FOUR 16D GALVANIZED NAILS. INSTALL NAILS AT THE BACK CORNERS OF THE BLOCK AND BEND THE NAILS OVER THE FLANGE OF THE STEEL POST.

⑤ WOOD BLOCKS MAY BE CONSTRUCTED OUT OF 2 WOOD BLOCKS. SEE ALTERNATE WOOD BLOCK DETAIL.


⑬ STEEL OR WOOD POST IS ACCEPTABLE AT POST 1. SEE SDD 14B42.

MIDWEST GUARDRAIL SYSTEM
THRIE BEAM TRANSITION (MGS)


STATE OF WISCONSIN
DEPARTMENT OF TRANSPORTATION

GENERAL NOTES


④ TOLERANCE FOR TOP OF W-BEAM RAIL IS $\pm 1"$.

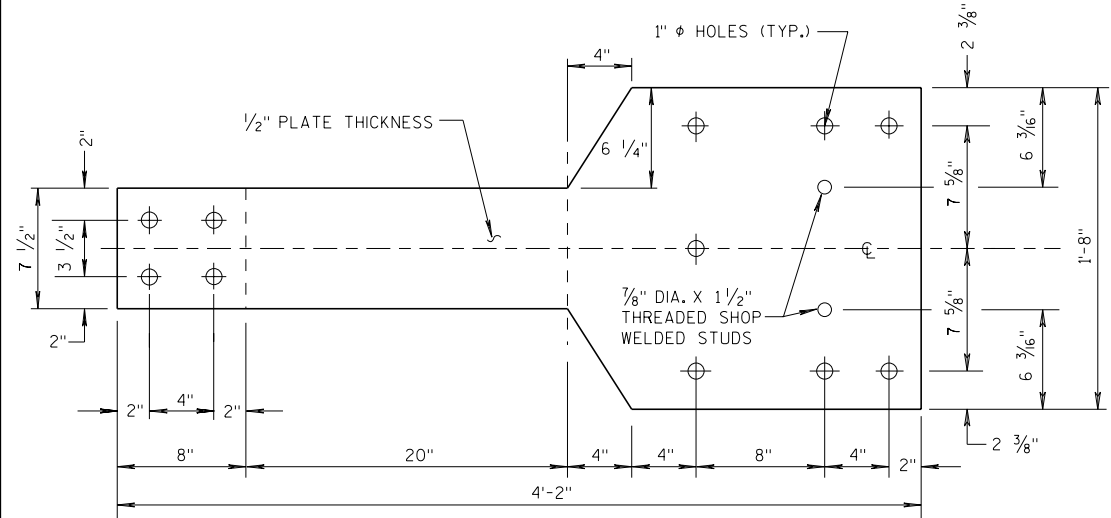

FRONT VIEW

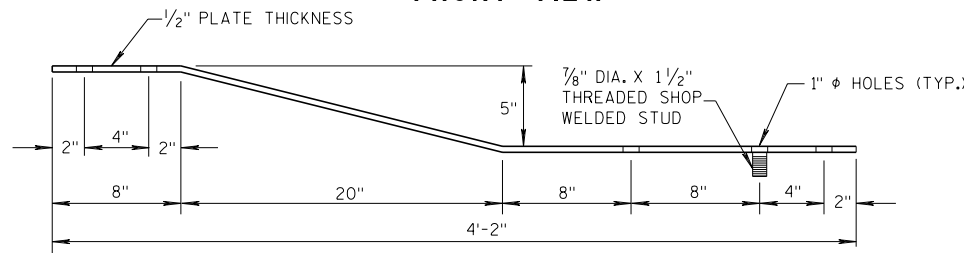


PLAN VIEW
BACK-UP PLATE DETAIL, TYPE "M"

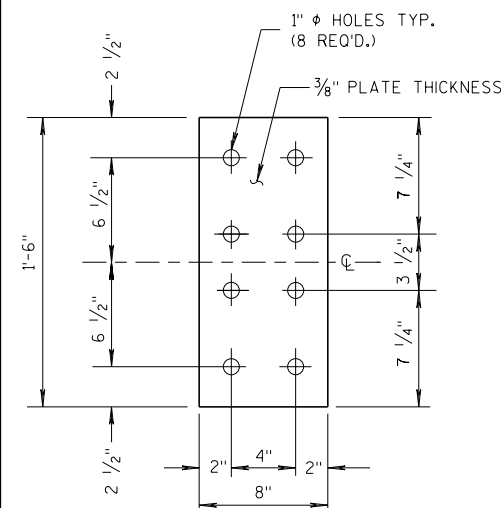


FRONT VIEW

ANCHOR
PLATE DETAIL,
TYPE "M"

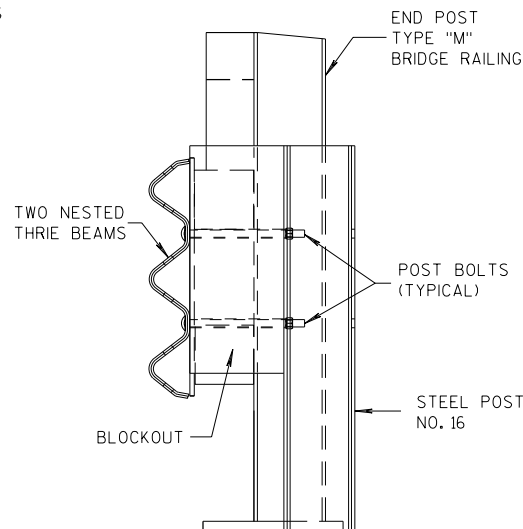


SECTION M-M

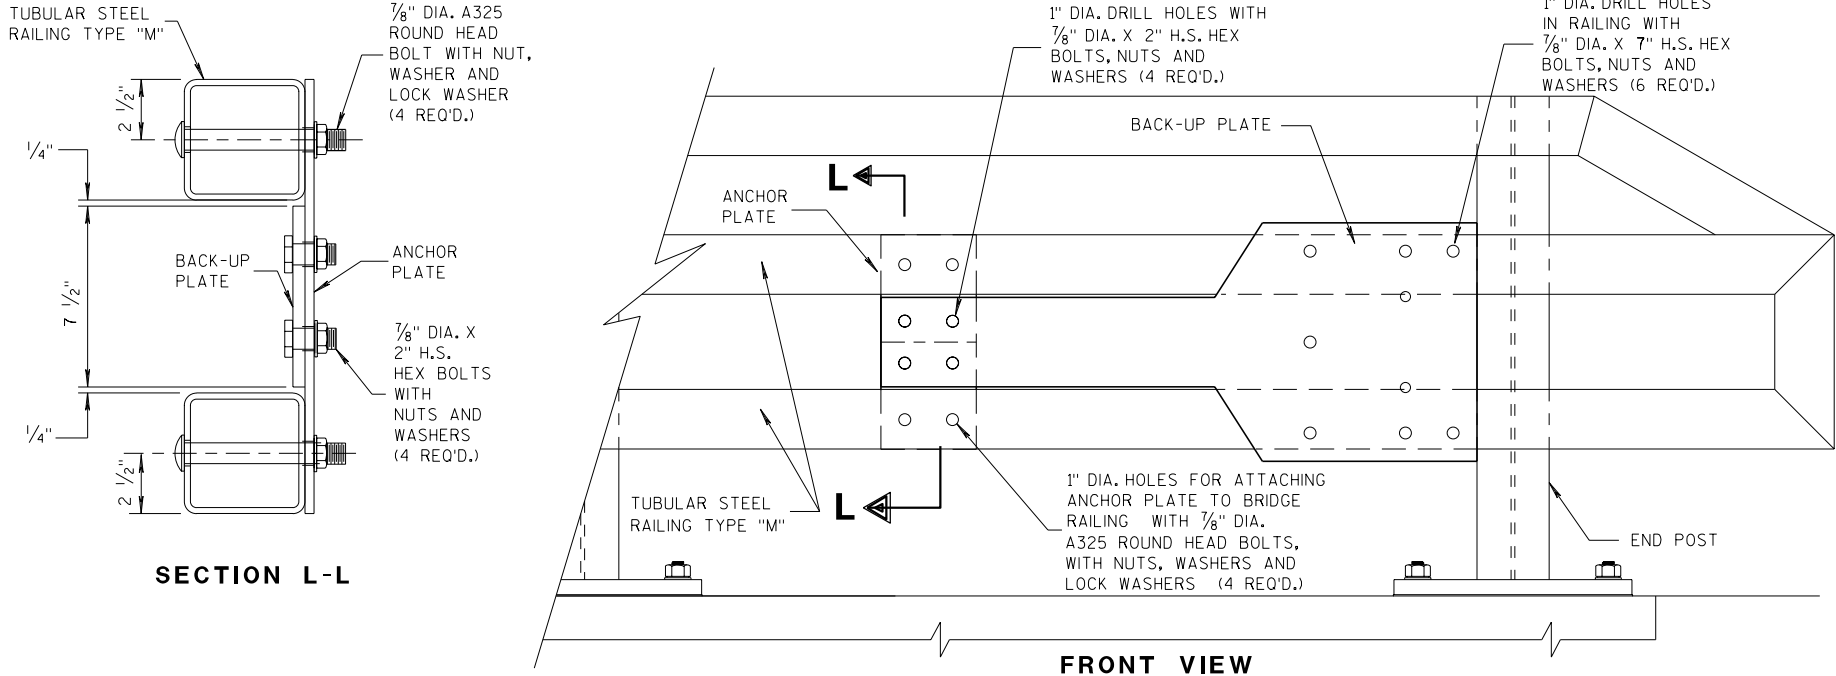

SECTION L-L


FRONT VIEW

ANCHOR AND BACK-UP PLATE MOUNTING TO BRIDGE RAILING, TYPE "M"

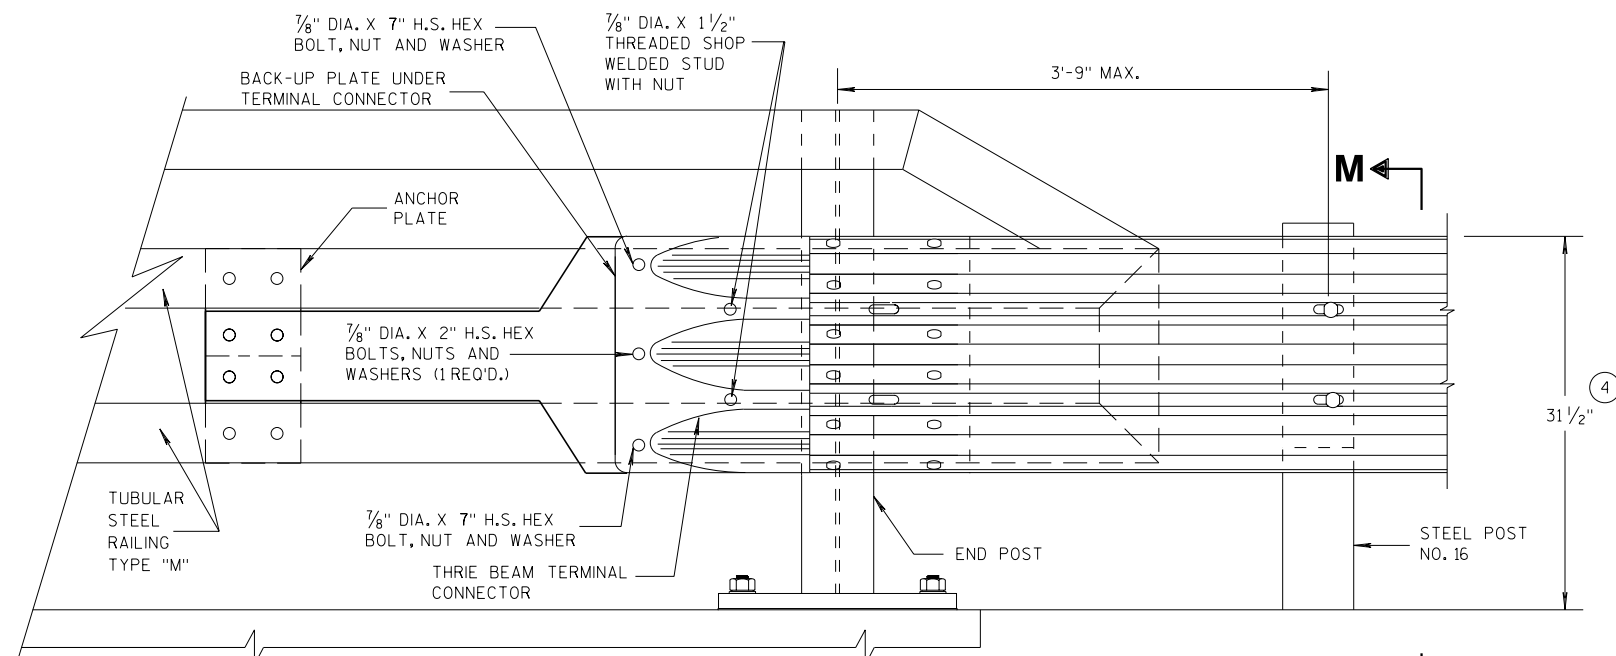

FRONT VIEW

M

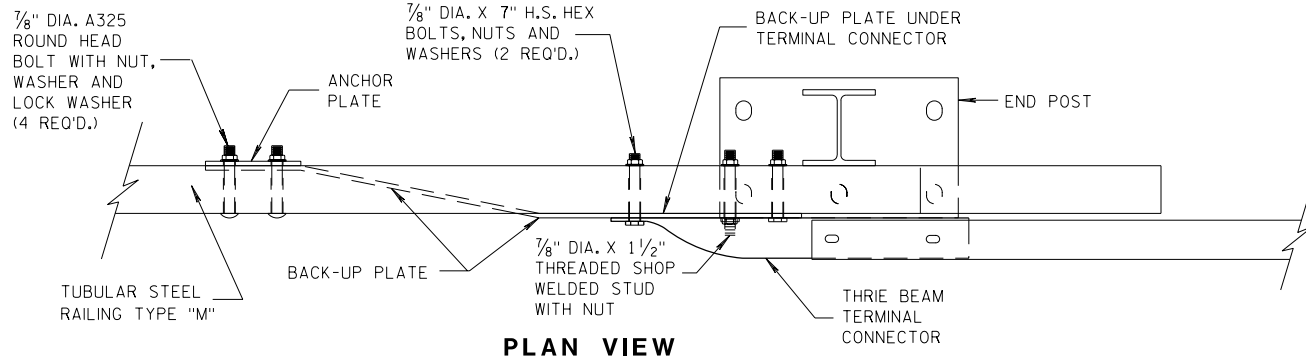


PLAN VIEW

THREE BEAM CONNECTION TO TUBULAR RAILING, TYPE "M"

MIDWEST GUARDRAIL SYSTEM
THREE BEAM TRANSITION (MGS)

STATE OF WISCONSIN
DEPARTMENT OF TRANSPORTATION

APPROVED
07/2018 /S/ Rodney Taylor
DATE ROADWAY STANDARDS UNIT SUPERVISOR
FHWA

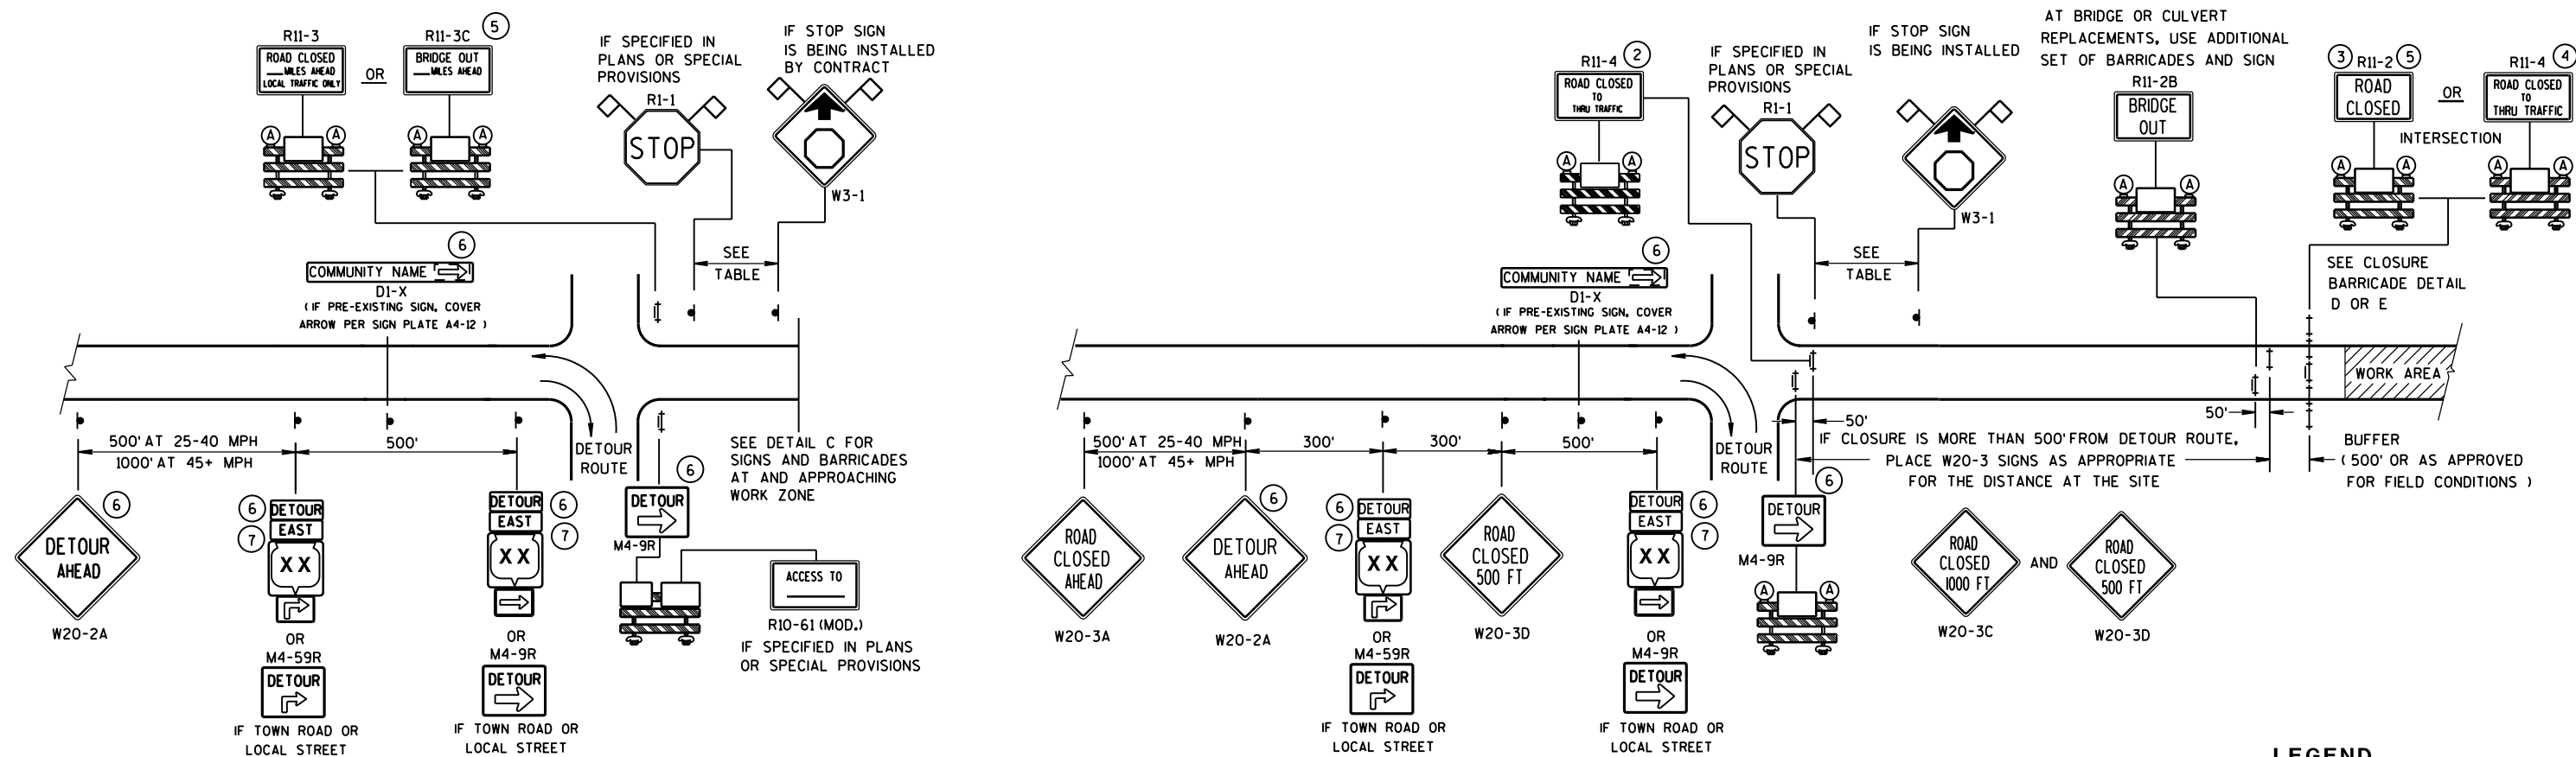


DETAIL A

MAINLINE CLOSURE WITH POSTED DETOUR

WORK ZONE GREATER THAN 1/2 MILE FROM DETOUR ROUTE (1000 FEET IF URBAN)



WORK ZONE LESS THAN 1/2 MILE FROM DETOUR ROUTE (1000 FEET IF URBAN)

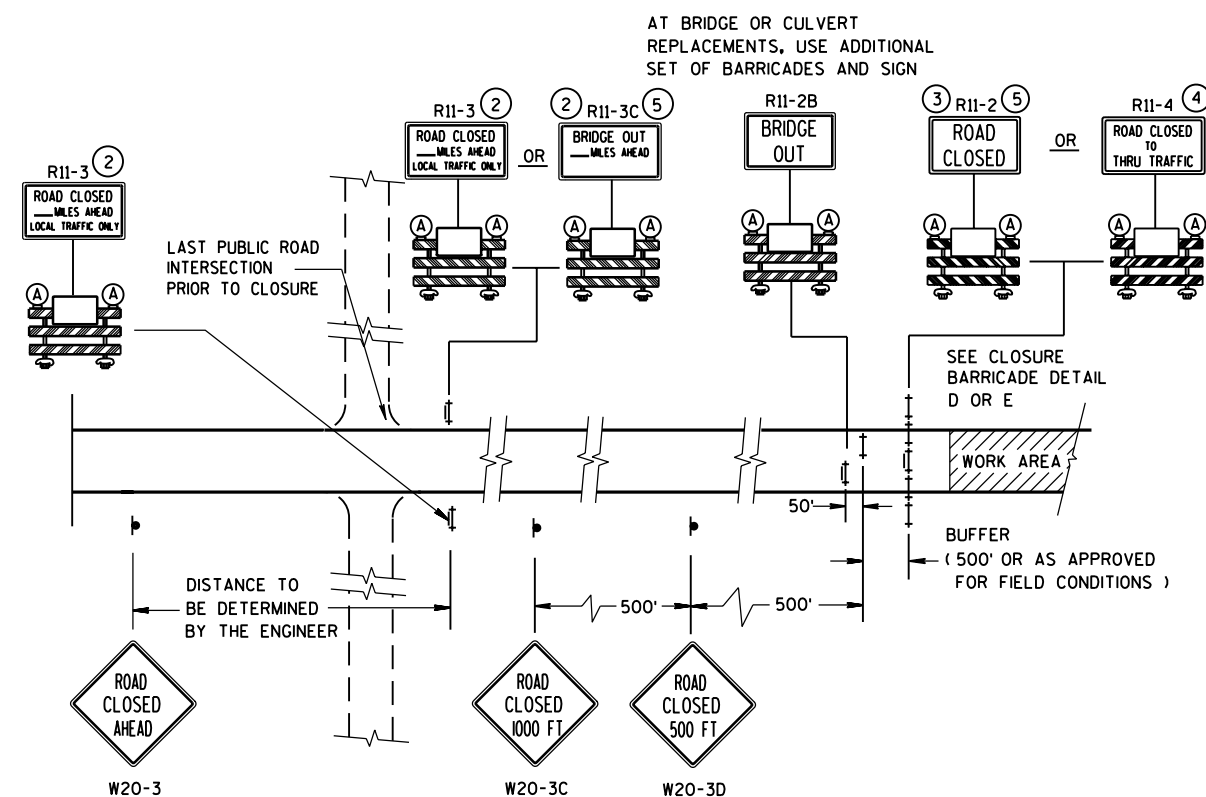

DETAIL C
MAINLINE CLOSURE, NO POSTED DETOUR

SPEED LIMIT (MPH)	"STOP AHEAD" ADVANCE WARNING DISTANCE (F T)
25	200
30	200
35	350
40	350
45	500
50	550
55	750


- # LEGEND
- | | |
|---|---------------------------------------|
|  | SIGN ON PERMANENT SUPPORT |
|  | TYPE III BARRICADE |
|  | TYPE III BARRICADE WITH ATTACHED SIGN |
|  | TYPE "A" WARNING LIGHT (FLASHING) |
|  | WORK AREA |
|  | M4-8
M3-X |
|  | M1-4 |
|  | COUNTY
XX |
|  | XX |
|  | M05-1 |
|  | M06-1 |
|  | FLAGS, 16" X 16" MIN., (ORANGE) |

SEE SDD 15C2-SHEET "b"
FOR GENERAL NOTES
AND FOOTNOTES ① THROUGH ⑦


BARRICADES AND SIGNS FOR MAINLINE CLOSURES

STATE OF WISCONSIN
DEPARTMENT OF TRANSPORTATION

Sept. 2015 /S/ Peter Amakobe Atepe
DATE STATEWIDE WORK ZO 25 F
FHWA SAFETY ENGINEER

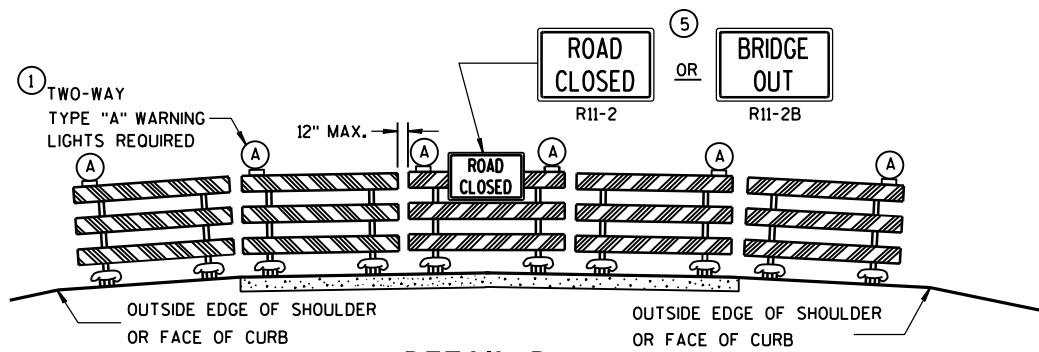

DETAIL D
ROAD CLOSURE BARRICADE DETAIL
APPROACH VIEW

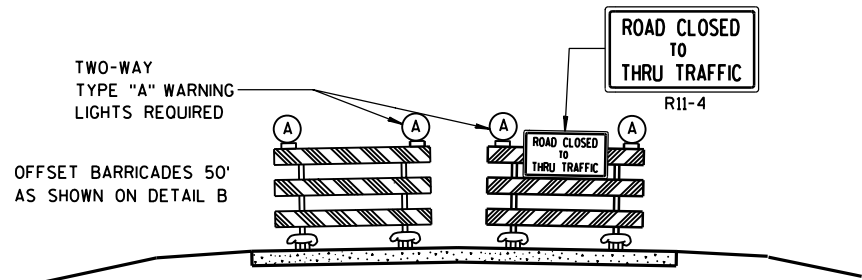

DETAIL E
LANE CLOSURE BARRICADE DETAIL
APPROACH VIEW

SEE SDD 15C2-SHEET "a" FOR LEGEND

GENERAL NOTES

THE EXACT NUMBER, LOCATION, AND SPACING OF ALL SIGNS AND BARRICADES SHALL BE ADJUSTED TO FIT FIELD CONDITIONS AS APPROVED BY THE ENGINEER.

ANY SIGNS TEMPORARY OR EXISTING, WHICH CONFLICT WITH TRAFFIC CONTROL "IN USE" SHALL BE REMOVED OR COVERED AS NEEDED AND AS APPROVED BY THE ENGINEER.

THE SPACING BETWEEN TRAFFIC CONTROL SIGNS SHOULD BE ADJUSTED TO NOT CONFLICT WITH AND SHOULD PROVIDE A DESIRABLE MINIMUM OF 200 FEET CLEARANCE TO EXISTING SIGNS THAT WILL REMAIN IN PLACE.

BARRICADES THAT MUST BE MOVED FOR A WORK OPERATION SHALL BE IMMEDIATELY RE-ESTABLISHED UPON COMPLETION OF THE OPERATION OR, FOR CONTINUING OPERATIONS, AT THE END OF EACH WORKING DAY.

SIGNS THAT WILL BE IN PLACE LESS THAN 7 CONTINUOUS DAYS AND NIGHTS MAY BE MOUNTED ON PORTABLE SUPPORTS.

ALL TYPE III BARRICADES SHALL HAVE RAILS REFLECTORIZED ON BOTH FACES. STRIPES SHALL BE PROPERLY SLOPED DOWN TOWARD THE TRAFFIC SIDE OR AS SHOWN IN THE ROAD CLOSURE BARRICADE DETAIL D FOR FULL ROAD CLOSURES.

TYPE "A" LOW-INTENSITY FLASHING WARNING LIGHTS SHALL BE VISIBLE ON BOTH SIDES OF THE BARRICADE.

THE R11-2, R11-3, M4-9, R11-4 AND R10-61 SIGNS PLACED ON BARRICADES SHALL COVER NO MORE THAN THE TOP RAIL. THE SIGNS SHALL NOT COVER ANY PORTION OF THE MIDDLE OR BOTTOM RAILS.

"WO AND "MO" SIGNS ARE THE SAME AS "W" AND "M" SIGNS EXCEPT THE BACKGROUND IS ORANGE.

ALL SIGNS SHALL BE 48" X 48" UNLESS OTHERWISE NOTED BELOW:


- R11-2 SHALL BE 48" X 30".
- R11-3, R11-4 AND R10-61 SHALL BE 60" X 30".
- M4-9 SHALL BE 30" X 24".
- M3-X SHALL BE 24" X 12". (36" X 18" IF NEEDED TO MATCH EXISTING SIGNS.)
- M4-8 SHALL BE 24" X 12". (30" X 15" IF NEEDED TO MATCH EXISTING SIGNS.)
- M1-4, M1-5A, AND M1-6 SHALL BE 24" X 24". (36" X 36" IF NEEDED TO MATCH EXISTING SIGNS.)
- M05-1 AND M06-1 SHALL BE 21" X 21". (30" X 30" IF NEEDED TO MATCH EXISTING SIGNS.)
- D1-X SHALL BE AS SHOWN ON SPECIFIC PROJECT SIGNING DETAIL SHEETS.
- R1-1 SHALL BE 36" X 36".

- 1 TWO WARNING LIGHTS SHALL BE PROVIDED ON THE CENTER BARRICADE AND A MINIMUM OF ONE WARNING LIGHT SHALL BE PROVIDED ON EACH OF THE OTHER BARRICADES WITHIN THE ROADWAY LIMITS. SPACING OF THE WARNING LIGHTS SHALL BE UNIFORM TO THE EDGE OF ROADWAY AS SHOWN (APPROX. 8-FOOT LIGHT SPACING).
- 2 THESE SIGNS AND BARRICADES ARE NOT REQUIRED IF ROAD CLOSURE BEGINS AT INTERSECTION.
- 3 FOR ROAD CLOSURE WITHOUT LOCAL ACCESS TO PROJECT, SEE ROAD CLOSURE BARRICADE DETAIL D.
- 4 FOR ROAD CLOSURE WITH LOCAL ACCESS TO PROJECT, SEE LANE CLOSURE BARRICADE DETAIL E.
- 5 FOR BRIDGE OR CULVERT REPLACEMENTS, SUBSTITUTE "BRIDGE OUT" INSTEAD OF "ROAD CLOSED" ON R11-2 AND R11-3 SIGNS.
- 6 INSTALL DETOUR AND COMMUNITY GUIDE SIGNS AND ARROWS ONLY IF SPECIFIED IN THE CONTRACT. IF THERE ARE EXISTING ROUTE MARKER ASSEMBLIES THAT WILL REMAIN IN PLACE, ADJUST THE LOCATION OF THE DETOUR ROUTE SIGNS TO CORRESPOND WITH THE EXISTING ASSEMBLIES. MODIFY EXISTING SIGNS WHERE POSSIBLE. SEE SPECIFIC PROJECT DETOUR SIGNING DETAIL SHEETS. IF DETOUR SIGNS ARE BEING INSTALLED BY OTHERS, PLACE THE CONTRACTED TRAFFIC CONTROL SIGNS TO ALLOW FOR PLACEMENT OF ALL WARNING, DETOUR AND GUIDE SIGNS AS SHOWN.
- 7 "EAST" CARDINAL DIRECTION MARKERS AND RIGHT TURN ARROWS ARE SHOWN. USE OTHER CARDINAL DIRECTIONS AND ARROWS AS APPROPRIATE.

BARRICADES AND SIGNS
FOR
MAINLINE CLOSURES

STATE OF WISCONSIN
DEPARTMENT OF TRANSPORTATION


Sept. 2015 /S/ Peter Amokobe Atepe
DATE STATEWORK 2026 FIC
FHWA SAFETY ENGR

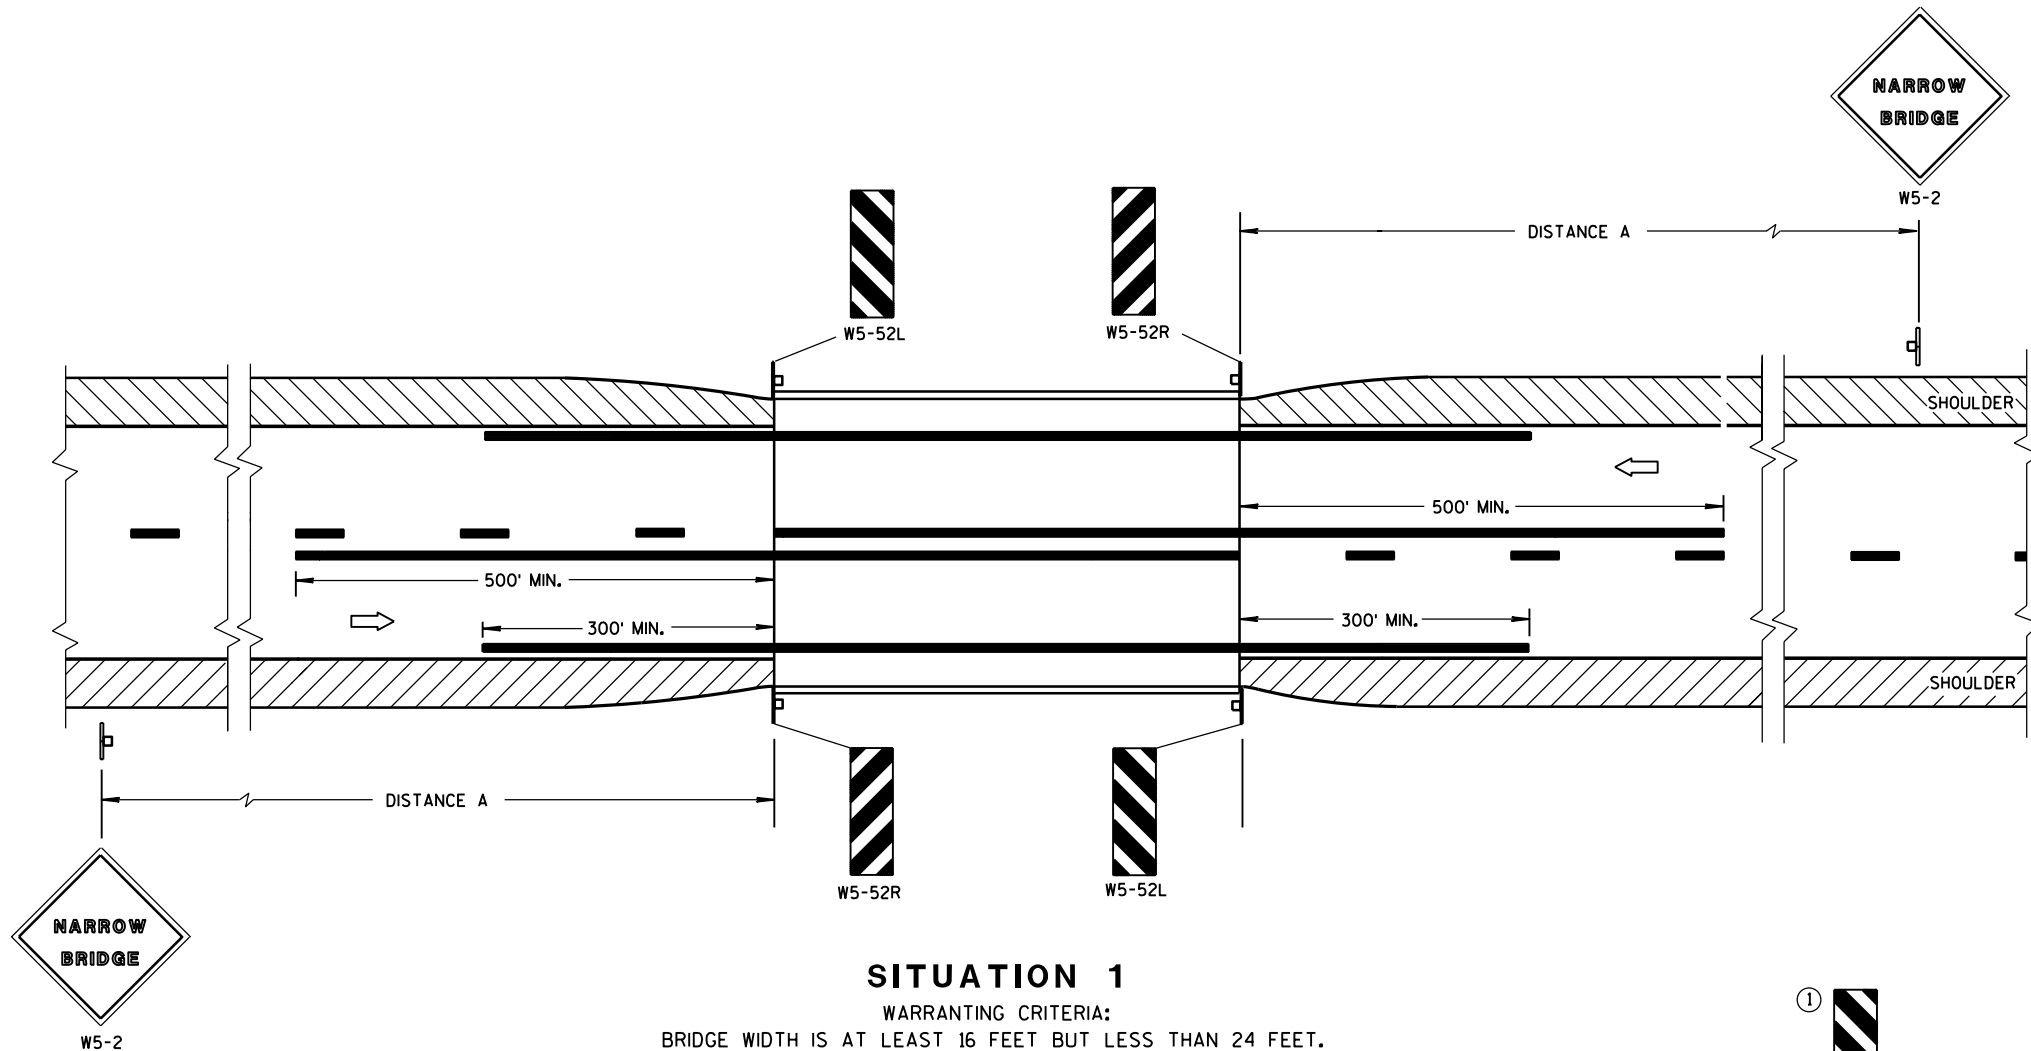

SITUATION 1
WARRANTING CRITERIA:
BRIDGE WIDTH IS AT LEAST 16 FEET BUT LESS THAN 24 FEET.

DISTANCE TABLE

POSTED OR 85th PERCENTILE SPEED	DISTANCE "A "
25	150'
30	200'
35	250'
40	300'
45	400'
50	550'
55	750'

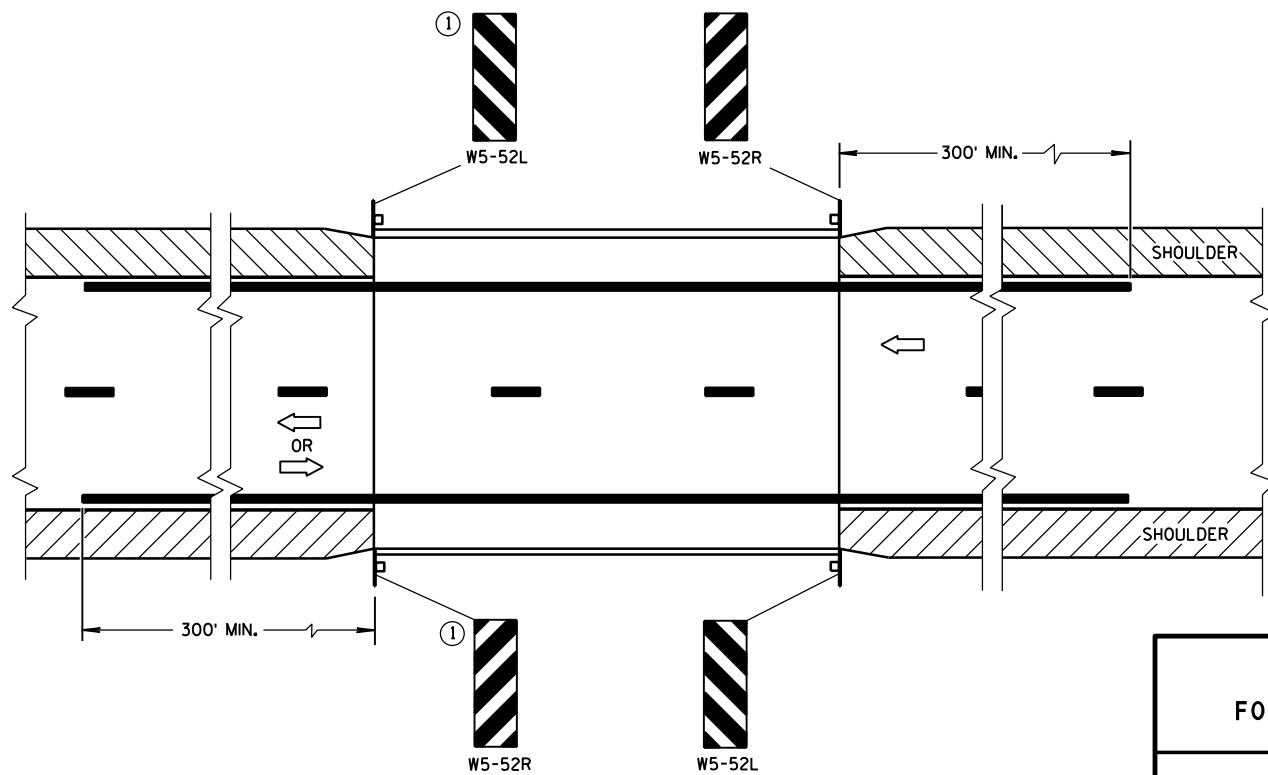

SITUATION 2
WARRANTING CRITERIA:
1. BRIDGE WIDTH IS AT LEAST 24 FEET AND
2. BRIDGE SHOULDER WIDTH IS LESS THAN 6 FEET.

GENERAL NOTES

DETAILS OF TRAFFIC CONTROL DEVICES AND INSTALLATION NOT SHOWN ON THIS DRAWING SHALL CONFORM TO THE PERTINENT REQUIREMENTS OF THE STANDARD SPECIFICATIONS, THE SPECIAL PROVISIONS, AND THE MANUAL ON UNIFORM TRAFFIC CONTROL DEVICES.

LOCATE W5-52 SIGN POST(S) BEHIND GUARDRAIL WHEN PRESENT.

PLACE THE EDGE OF THE W5-52 SIGN IN LINE WITH FACE OF CURB OR PARAPET.


① OMIT ON ONE-WAY TRAVELLED WAYS.

➡ DIRECTION OF TRAFFIC


**SIGNING & MARKING
FOR TWO LANE BRIDGES**

STATE OF WISCONSIN
DEPARTMENT OF TRANSPORTATION

APPROVED
June 2017 /S/ Matthew R. Rauch
DATE STATE SIGNING AND MAR 27 JEER
FHWA

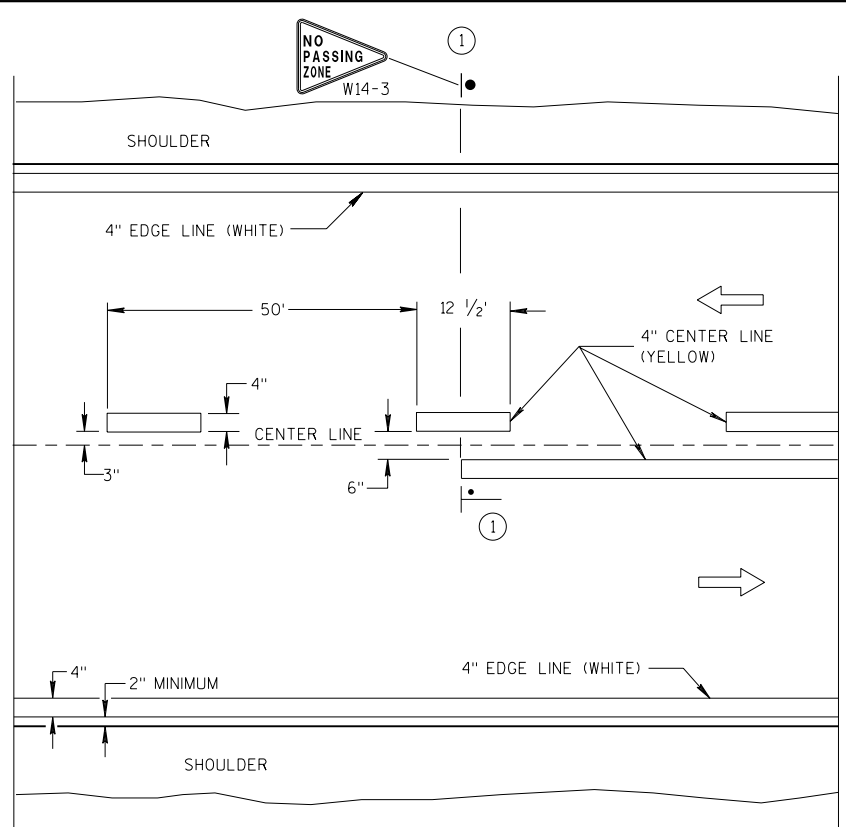


TWO WAY TRAFFIC

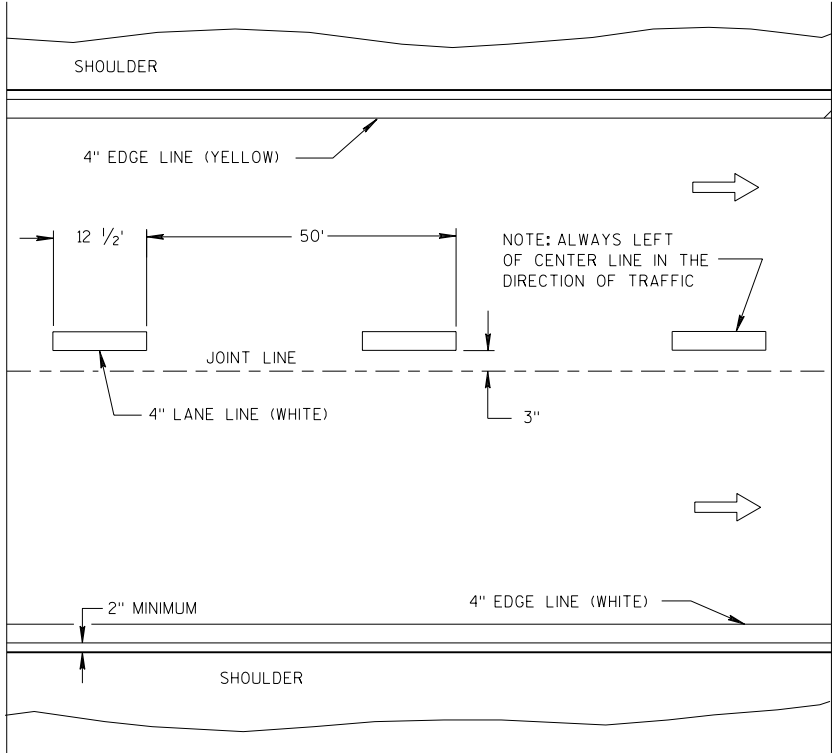


ONE WAY TRAFFIC

PERMANENT PAVEMENT MARKING

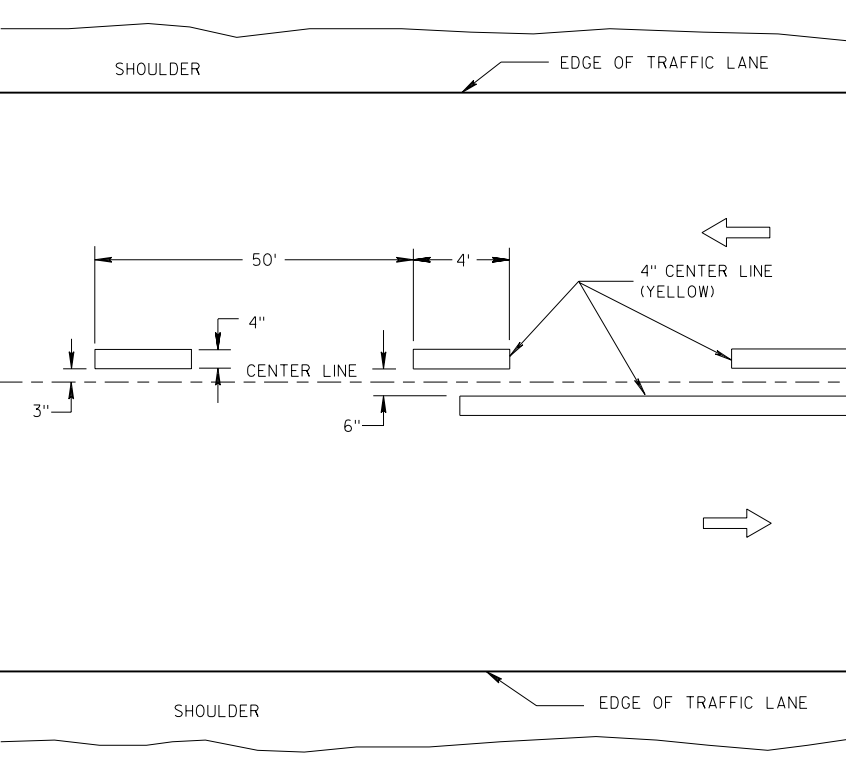

TWO WAY TRAFFIC

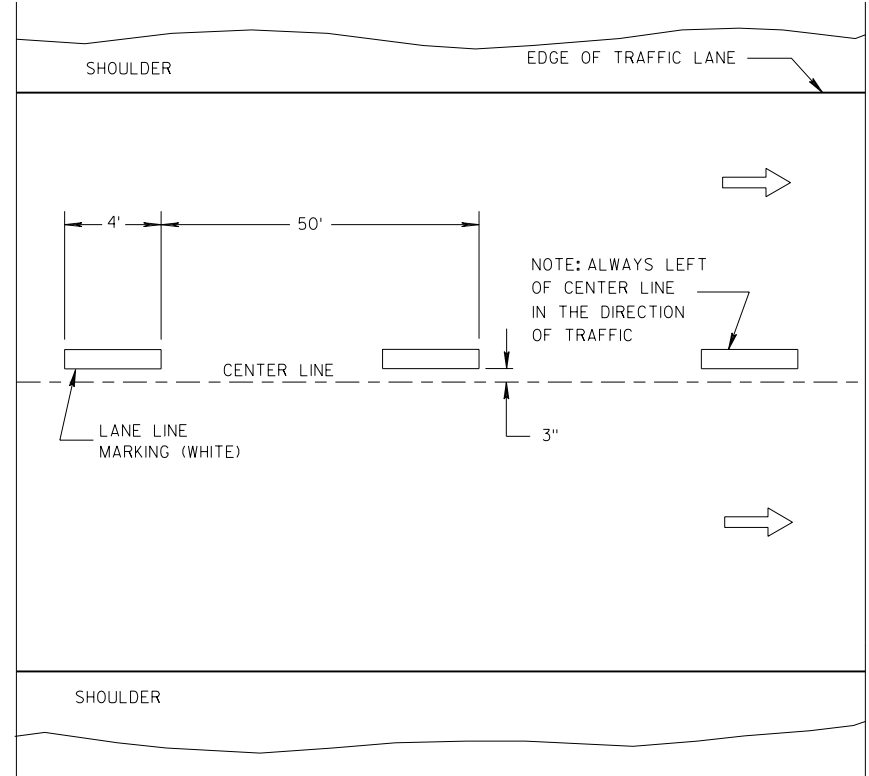

ONE WAY TRAFFIC

TEMPORARY PAVEMENT MARKING

GENERAL NOTES

DETAILS OF CONSTRUCTION NOT SHOWN ON THIS DRAWING SHALL CONFORM TO STANDARD SPECIFICATIONS AND SPECIAL PROVISIONS.

① LOCATE THE NO PASSING ZONE W14-3 SIGN WITHIN 50 FEET OF THE "T" MARKING.


NOTE

ARROW SYMBOL (➡) SHOWS DIRECTION OF TRAVEL


LEGEND

- "T" MARKING
- POST MOUNTED SIGN

LONGITUDINAL MARKING (MAINLINE)			
STATE OF WISCONSIN DEPARTMENT OF TRANSPORTATION			
APPROVED			
7/2018	/S/ Matthew R. Rauch		
DATE	STATE SIGNING AND MAR 28		
FHWA	INEER		

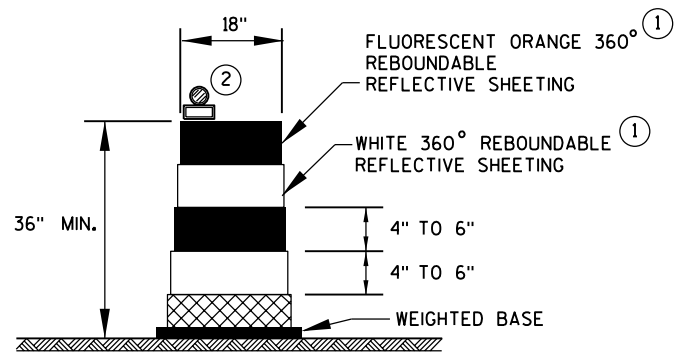

DRUM

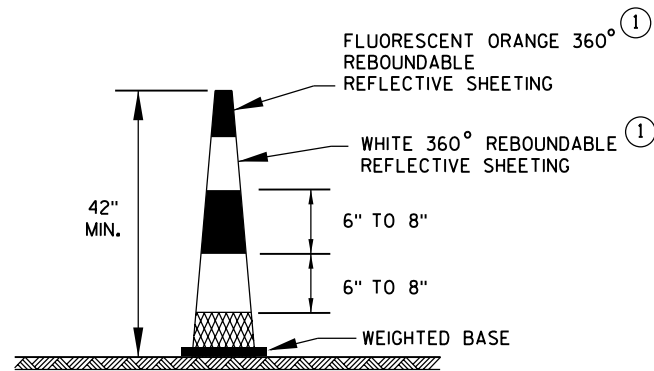


42" CONE

DO NOT USE IN TAPERS
1/2 SPACING OF DRUMS


GENERAL NOTES

- ① REFLECTIVE SHEETING SHALL FOLLOW THE REQUIREMENTS IN THE APPROVED PRODUCTS LISTING FOR SIGN SHEETING.
- ② LOCATION OF WARNING LIGHTS WHEN SHOWN ON THE PLAN.

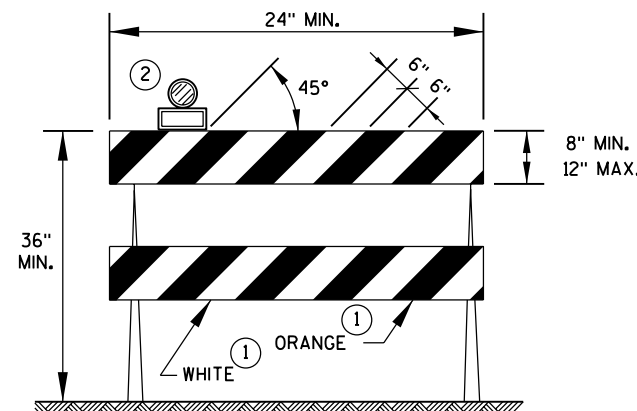


TYPE 2 BARRICADE

FOR RAILS LESS THAN 36" LONG, 4" WIDE STRIPES MAY BE USED.
ALL STRIPES SHALL SLOPE DOWNWARD TO THE TRAFFIC SIDE FOR CHANNELIZATION.

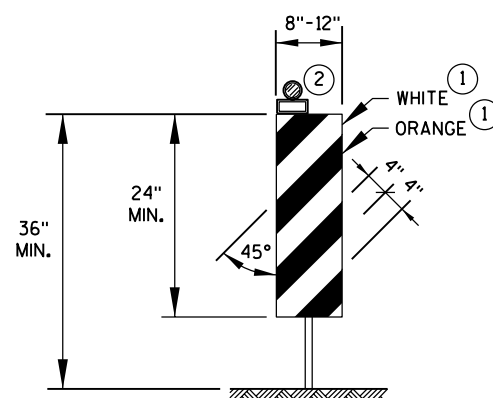

VERTICAL PANEL

THE STRIPES SHALL SLOPE DOWNWARD TO THE TRAFFIC SIDE FOR CHANNELIZATION.

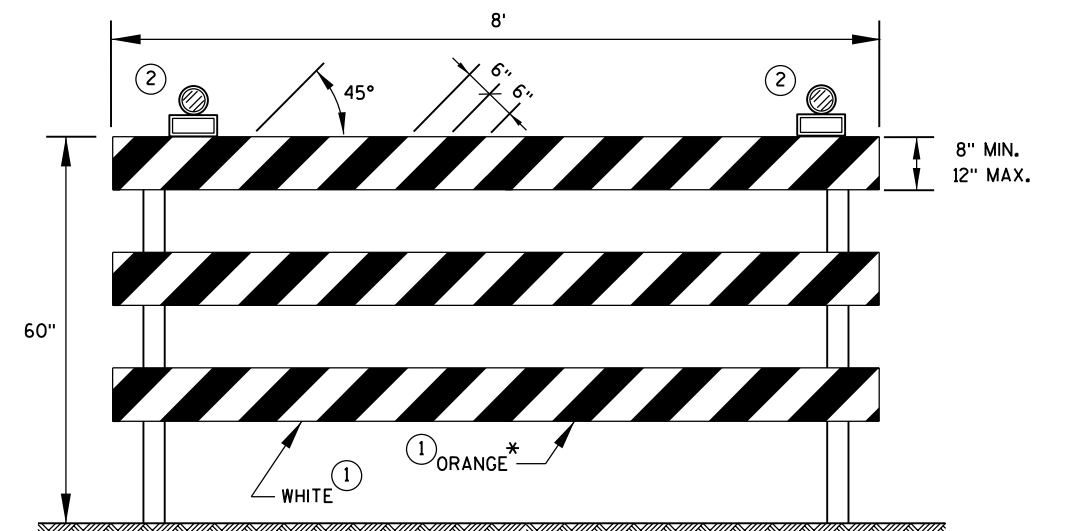

TYPE 3 BARRICADE

IF SIGN MOUNTED, DO NOT COVER MORE THAN 50% OF THE TOP TWO RAILS OR 33% OF THE TOTAL AREA OF THE THREE RAILS.

* IF USED FOR A PERMANENT APPLICATION, USE RED SHEETING.

CHANNELIZING DEVICES
DRUMS, CONES, BARRICADES
AND VERTICAL PANELS

STATE OF WISCONSIN
DEPARTMENT OF TRANSPORTATION



APPROVED
June 2017 /S/ Andrew Heidtke
DATE WORK ZONE ENG 29
FHWA



TUBULAR STEEL POSTS

AREA OF SIGN INSTALLATION (SQ. FT.)	NUMBER OF REQUIRED TUBULAR STEEL POSTS
9 OR LESS	1
GREATER THAN 9 LESS THAN OR EQUAL TO 18	2
GREATER THAN 18 LESS THAN OR EQUAL TO 27	3

SIGNS LARGER THAN 27 SQ.FT. SHALL NOT BE MOUNTED ON TUBULAR STEEL POSTS.

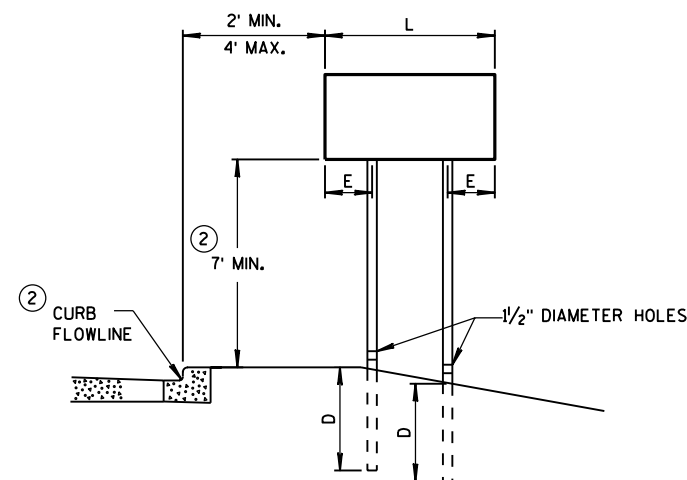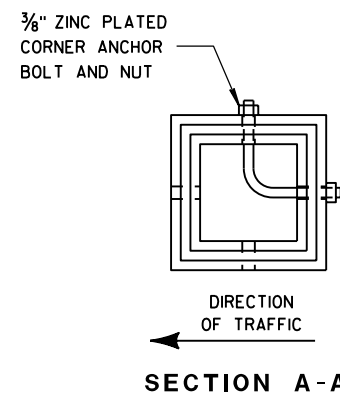


URBAN AREA


POST MOUNTING DETAIL FOR TEMPORARY TRAFFIC CONTROL FIXED MESSAGE SIGNS

WOOD POST
EMBEDMENT DEPTH


AREA OF SIGN INSTALLATION (SQ. FT.)	D (MIN)
20 OR LESS	4'
GREATER THAN 20	5'

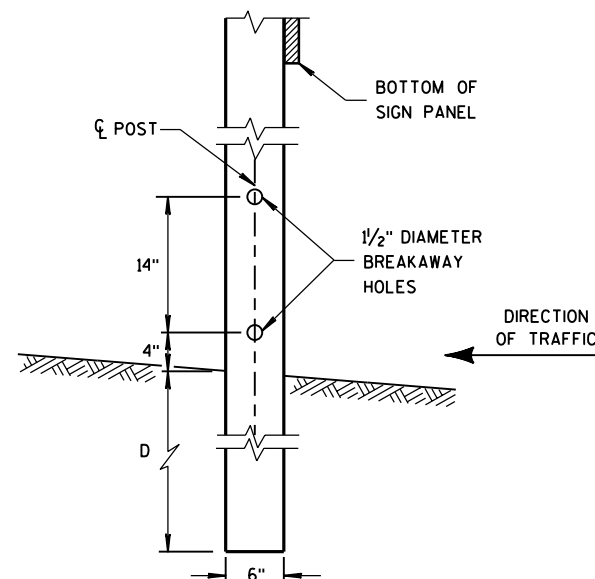

4" x 6" WOOD POST MODIFICATION

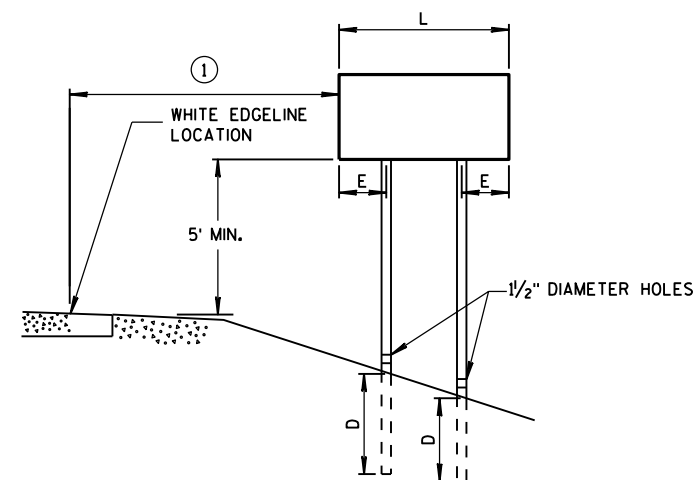

RURAL AREA

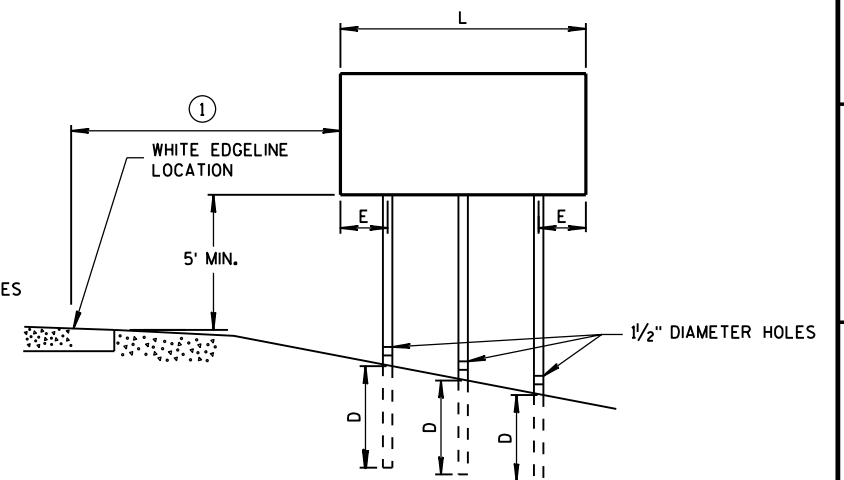

GENERAL NOTES

- ① 6 FEET FROM THE EDGE OF PAVEMENT (EDGE LINE LOCATION) UNLESS OTHERWISE DIRECTED BY THE PROJECT ENGINEER. LATERAL OFFSET SHOULD BE ADJUSTED TO AVOID THE DITCH FLOWLINE.
- ② THE EXISTENCE OF CURB AND GUTTER DOES NOT IN ITSELF MANDATE THE VERTICAL CLEARANCE ILLUSTRATED. THAT HEIGHT IS TYPICALLY MEASURED WHERE THERE IS SIDEWALK ADJACENT TO THE ROADWAY OR PARKING IS PERMITTED. IN THE ABSENCE OF SIDEWALK, VERTICAL CLEARANCE IS MEASURED FROM THE TOP OF THE CURB. IF NO SIDEWALK AND NO PARKING, VERTICAL CLEARANCE MAY BE REDUCED TO 5 FOOT MINIMUM. OFFSET OF SIGNS IS MEASURED FROM THE CURB FLOWLINE.
- ③ FOR SIGNS REQUIRING 4 POSTS, SPACE INTERMEDIATE POSTS EVENLY.


4" X 6" WOOD POST

POST SPACING REQUIREMENTS		NUMBER OF WOOD POSTS REQUIRED
L	E	
48" OR LESS AND LESS THAN 20 SQ. FT.	-	1
LESS THAN 60"	12"	2
60" TO 120"	L/5	2
GREATER THAN 120" LESS THAN 168"	12"	3
168" AND GREATER	12"	4

SEE NOTE (3)

TEMPORARY TRAFFIC CONTROL SIGN MOUNTING

STATE OF WISCONSIN
DEPARTMENT OF TRANSPORTATION 30

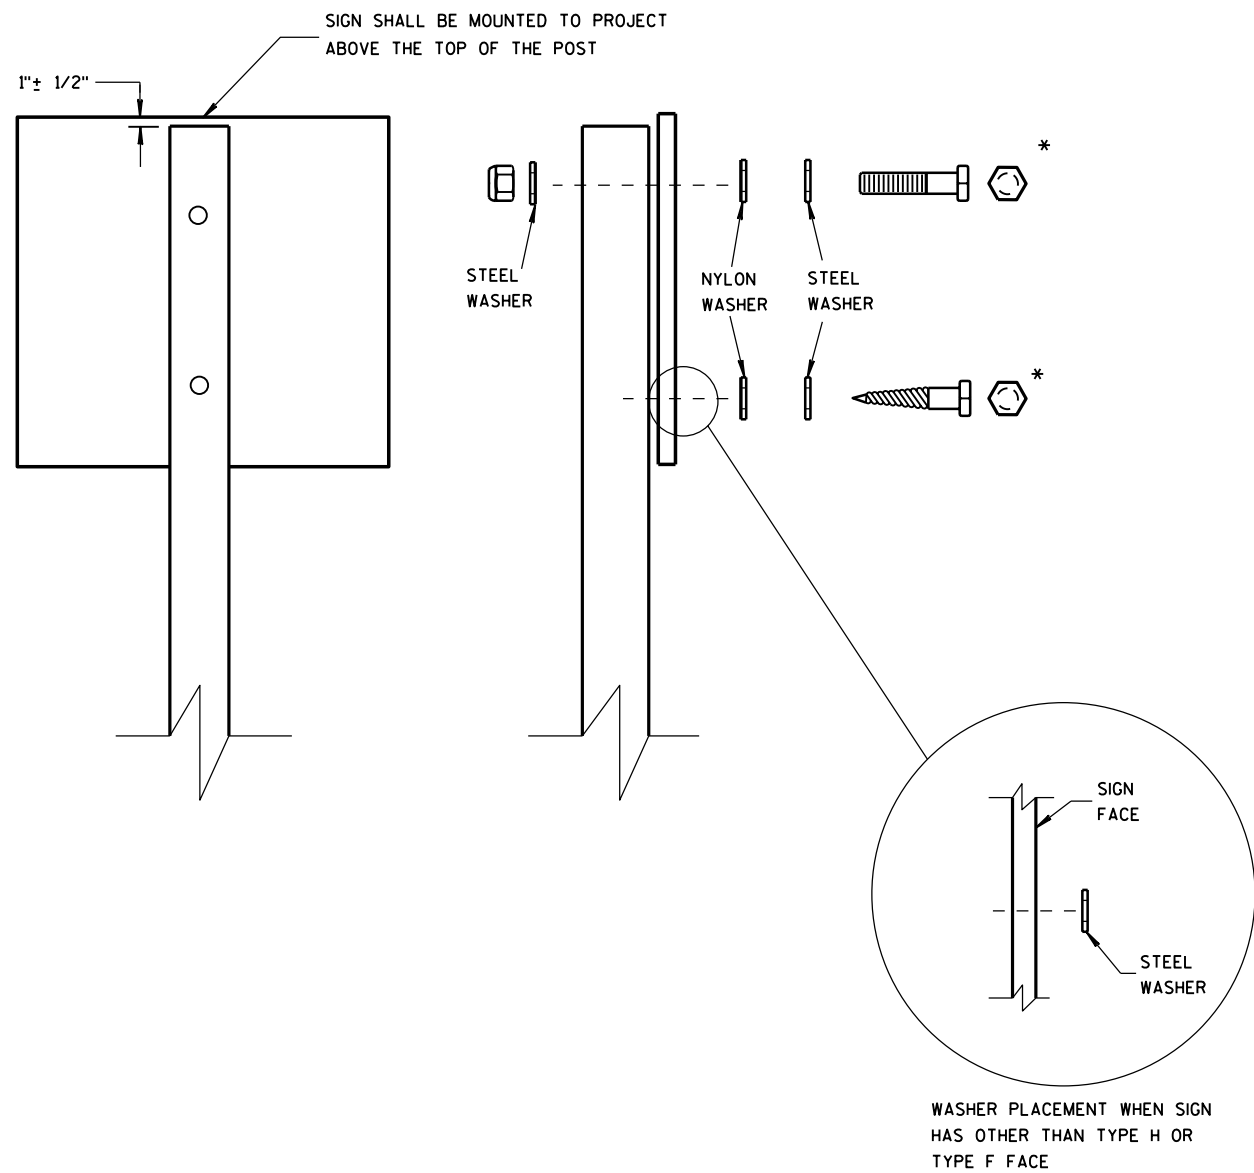

NUTS, BOLTS AND LAGS USED FOR MOUNTING SIGNS SHALL HAVE HEXAGONAL HEADS AND SHALL BE EITHER:

- A. HOT DIP GALVANIZED IN ACCORDANCE WITH ASTM DESIGNATION: A 153, CLASS D, OR SC 3
- B. ELECTRO-GALVANIZED IN ACCORDANCE WITH ASTM DESIGNATION: B 633, TYPE III, SC 3

THREADS ON BOLTS AND NUTS SHALL BE MANUFACTURED WITH SUFFICIENT ALLOWANCE FOR THE CADMIUM PLATE OR GALVANIZED COATING TO PERMIT THE NUTS TO RUN FREELY ON THE BOLTS.

- WOOD POSTS (4" x 4" or 4" x 6")
- LAG SCREWS - 3/8" x 3"
 - MACHINE BOLTS - 5/16" x 6-1/2" OR 7" LENGTH W/ NUTS



- SQUARE STEEL POSTS (2" x 2")
- MACHINE BOLTS - 3/8" x 3-1/4" LENGTH W/ NUTS
 - RIVETS - 9/32" (6605-9-6) BULB-TITE, TRI-FOLD, ALUMINUM BODY/MANDREL O.D. FLANGE .720-.765 INCH, GRIP RANGE .042-.375 INCH

- WASHERS (ALL POSTS) -
- 1-1/4" O.D. x 3/8" I.D. x 1/16" STEEL
 - 1-1/4" O.D. x 3/8" I.D. x .080 NYLON FOR ALL TYPE H SIGNS

* TWO DIFFERENT FASTENING SYSTEMS ARE SHOWN FOR ILLUSTRATION PURPOSES. ON ANY INDIVIDUAL SIGN, EITHER ONE OR THE OTHER SYSTEM SHALL BE USED. ACTUAL NUMBER OF FASTENERS PER SIGN VARIES WITH THE SIGN AREA. FOR A SINGLE POST INSTALLATION, ALL SIGNS GREATER THAN 9 SQ. FT. REQUIRE THE USE OF 3 FASTENERS.


ATTACHMENT OF SIGNS TO POSTS	
STATE OF WISCONSIN DEPARTMENT OF TRANSPORTATION	
APPROVED June 2017 DATE	/S/ Andrew Heidtke WORK ZONE ENC 31
FHWA	

URBAN AREA

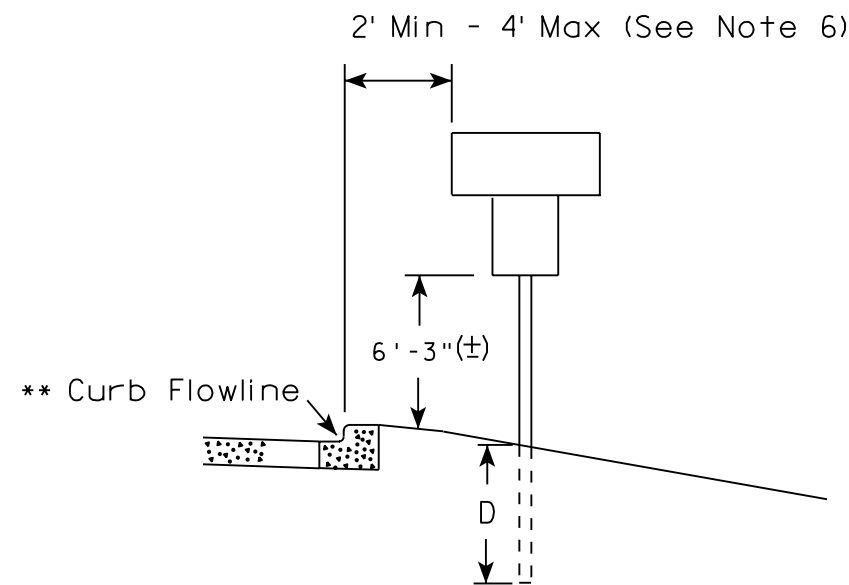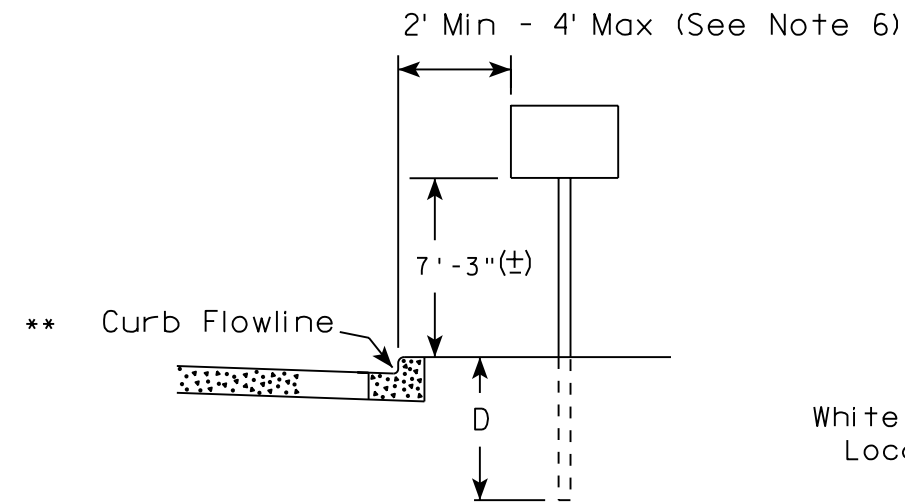


White Edgeline
Location

RURAL AREA (See Note 2)

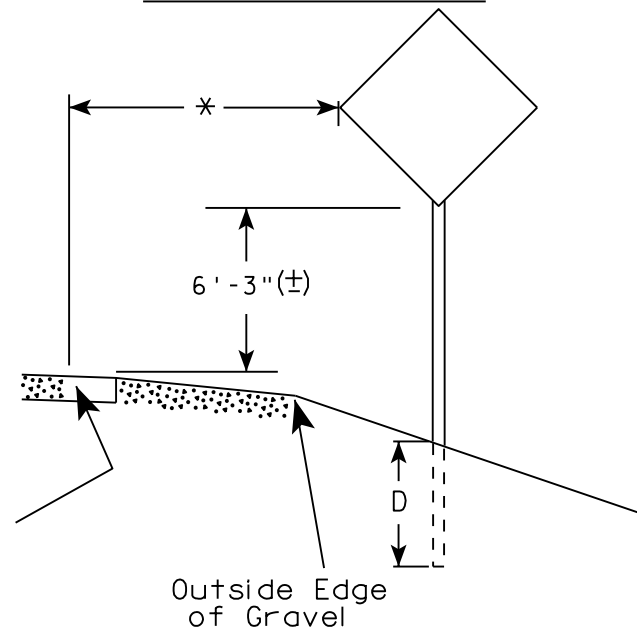

White Edgeline
Location

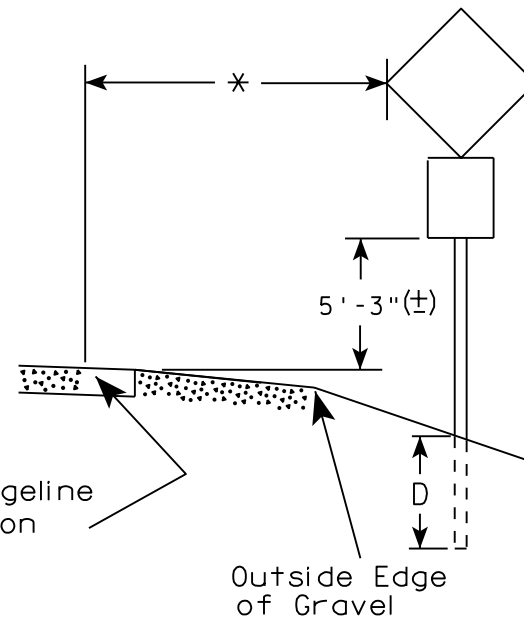

Outside Edge
of Gravel

POST EMBEDMENT DEPTH

Area of Sign Installation (Sq. Ft.)	D (Min)
20 or Less	4'
Greater than 20	5'

GENERAL NOTES

1. Signs wider than 4 feet or 20 sq.ft or larger, shall be mounted on multiple posts. Refer to plate A4-4.
2. If signs are mounted on barrier wall, see A4-10 sign plate.
3. For expressways and freeways, mounting height is 7'- 3" (±) or 6'-3" (±) depending upon existence of a sub-sign.
4. J-Assemblies are considered to be one sign for mounting height.
5. Minimum mounting height for signs mounted on traffic signal poles is 5'- 3" (±).
6. Offset distance shall be consistent with existing signs or consistent throughout length of project.
7. The (±) tolerance for mounting height is 3 inches.
8. Folding signs shall be mounted at a height of 5'-3" (±) or as directed by the Engineer.
9. The Double Arrow sign (W12-1) shall be mounted at a height of 2'-3" (±). The Chevron sign (W1-8), Roundabout Chevron panel (R6-4B), Enhanced Reference Markers, Clearance Markers (W5-52), Mile Markers (D10 series), In Road Object Markers (W5-54) & End of Road Markers (W5-56) shall be mounted at a height of 4'-3" (±).

✱✱ The existence of curb and gutter does not in itself mandate the vertical clearance illustrated. That height is typically measured where there is sidewalk adjacent to the roadway or parking is permitted. In the absence of sidewalk vertical clearance is measured from the top of the curb. Offset of signs is measured from the flow line.

* 6 feet from edge of a paved shoulder or 12 feet from the edge of pavement (edge line location) or 2 feet from outside edge of gravel, whichever is greater unless directed by project engineer.

TYPICAL INSTALLATION
OF PERMANENT TYPE II
SIGNS ON SINGLE POSTS

WISCONSIN DEPT OF TRANSPORTATION

APPROVED *Matthew R. Rauch*
for State Traffic Engineer

DATE 8/21/17 PLATE NO. A4-3.21


PROJECT NO:

HWY:

COUNTY:

SHEET NO: 32

E

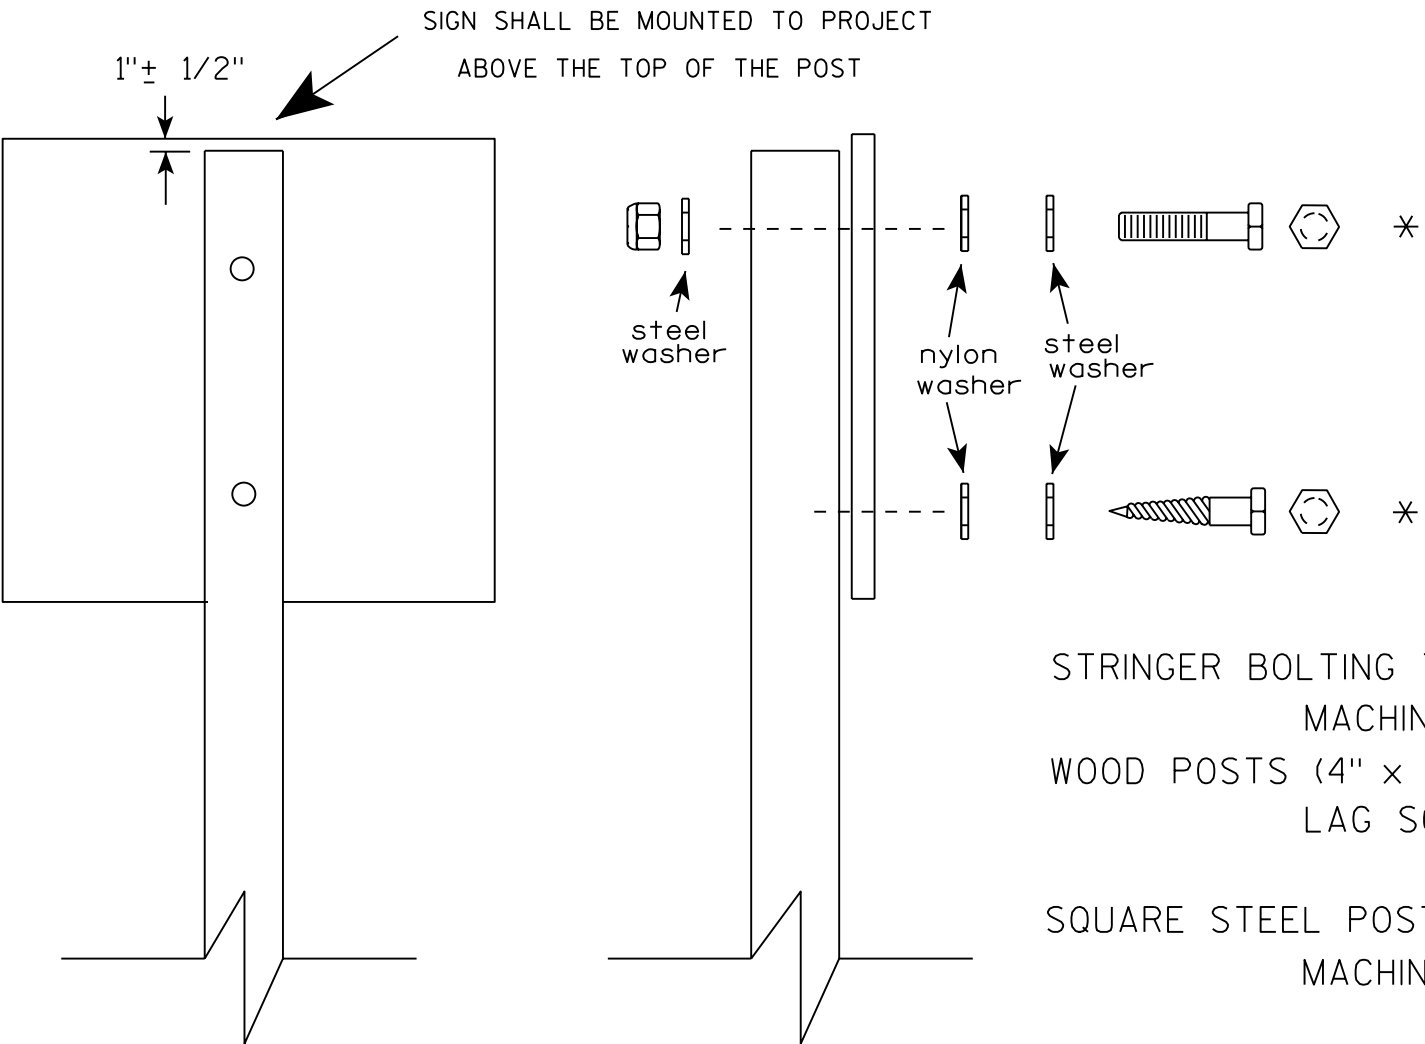

Nuts, bolts and lags used for mounting signs shall have hexagonal heads and shall be either :

- a. Hot dip galvanized in accordance with ASTM Designation: A 153, Class D, or SC 3
- b. Electro-galvanized in accordance with ASTM Designation : B 633, TYPE III, SC 3.


Threads on bolts and nuts shall be manufactured with sufficient allowance for the cadmium plate or galvanized coating to permit the nuts to run freely on the bolts.

- STRINGER BOLTING TO ALUMINUM SIGNS (SEE SIGN PLATE A4-18)
- MACHINE BOLTS - 5/16" X 1-3/4" Length w/ lock nuts
- WOOD POSTS (4" x 4" or 4" x 6")
- LAG SCREWS - 3/8" X 3" (NO STRINGERS ON BACK OF SIGN)
 - 3/8" X 4" (STRINGERS ON BACK OF SIGN)
- SQUARE STEEL POSTS (2" x 2")
- MACHINE BOLTS - 3/8" X 3-1/4" Length w/ nuts (NO STRINGER ON BACK OF SIGN)
 - 3/8" X 5" Length w/ nuts (STRINGERS ON BACK OF SIGN)
- RIVETS - 9/32" (6605-9-6) BULB-TITE, TRI-FOLD, ALUMINUM BODY/MANDREL
- O.D. FLANGE .720-.765 INCH, GRIP RANGE .042-.375 INCH
- WASHERS (ALL POSTS) -
- 1-1/4" O.D. X 3/8" I.D. X 1/16" STEEL
 - 1-1/4" O.D. X 3/8" I.D. X .080 NYLON

* Two different fastening systems are shown for illustration purposes. On any individual sign, either one or the other system shall be used. Actual number of fasteners per sign varies with the sign area, but normally there are two. For a single post installation, all signs greater than 9 sq. ft. require the use of 3 fasteners.

ATTACHMENT OF SIGNS TO POSTS	
WISCONSIN DEPT OF TRANSPORTATION	
APPROVED	<i>Matthew R. Rauch</i> For State Traffic Engineer
DATE 8/11/16	PLATE NO. A4-8.8 33

7

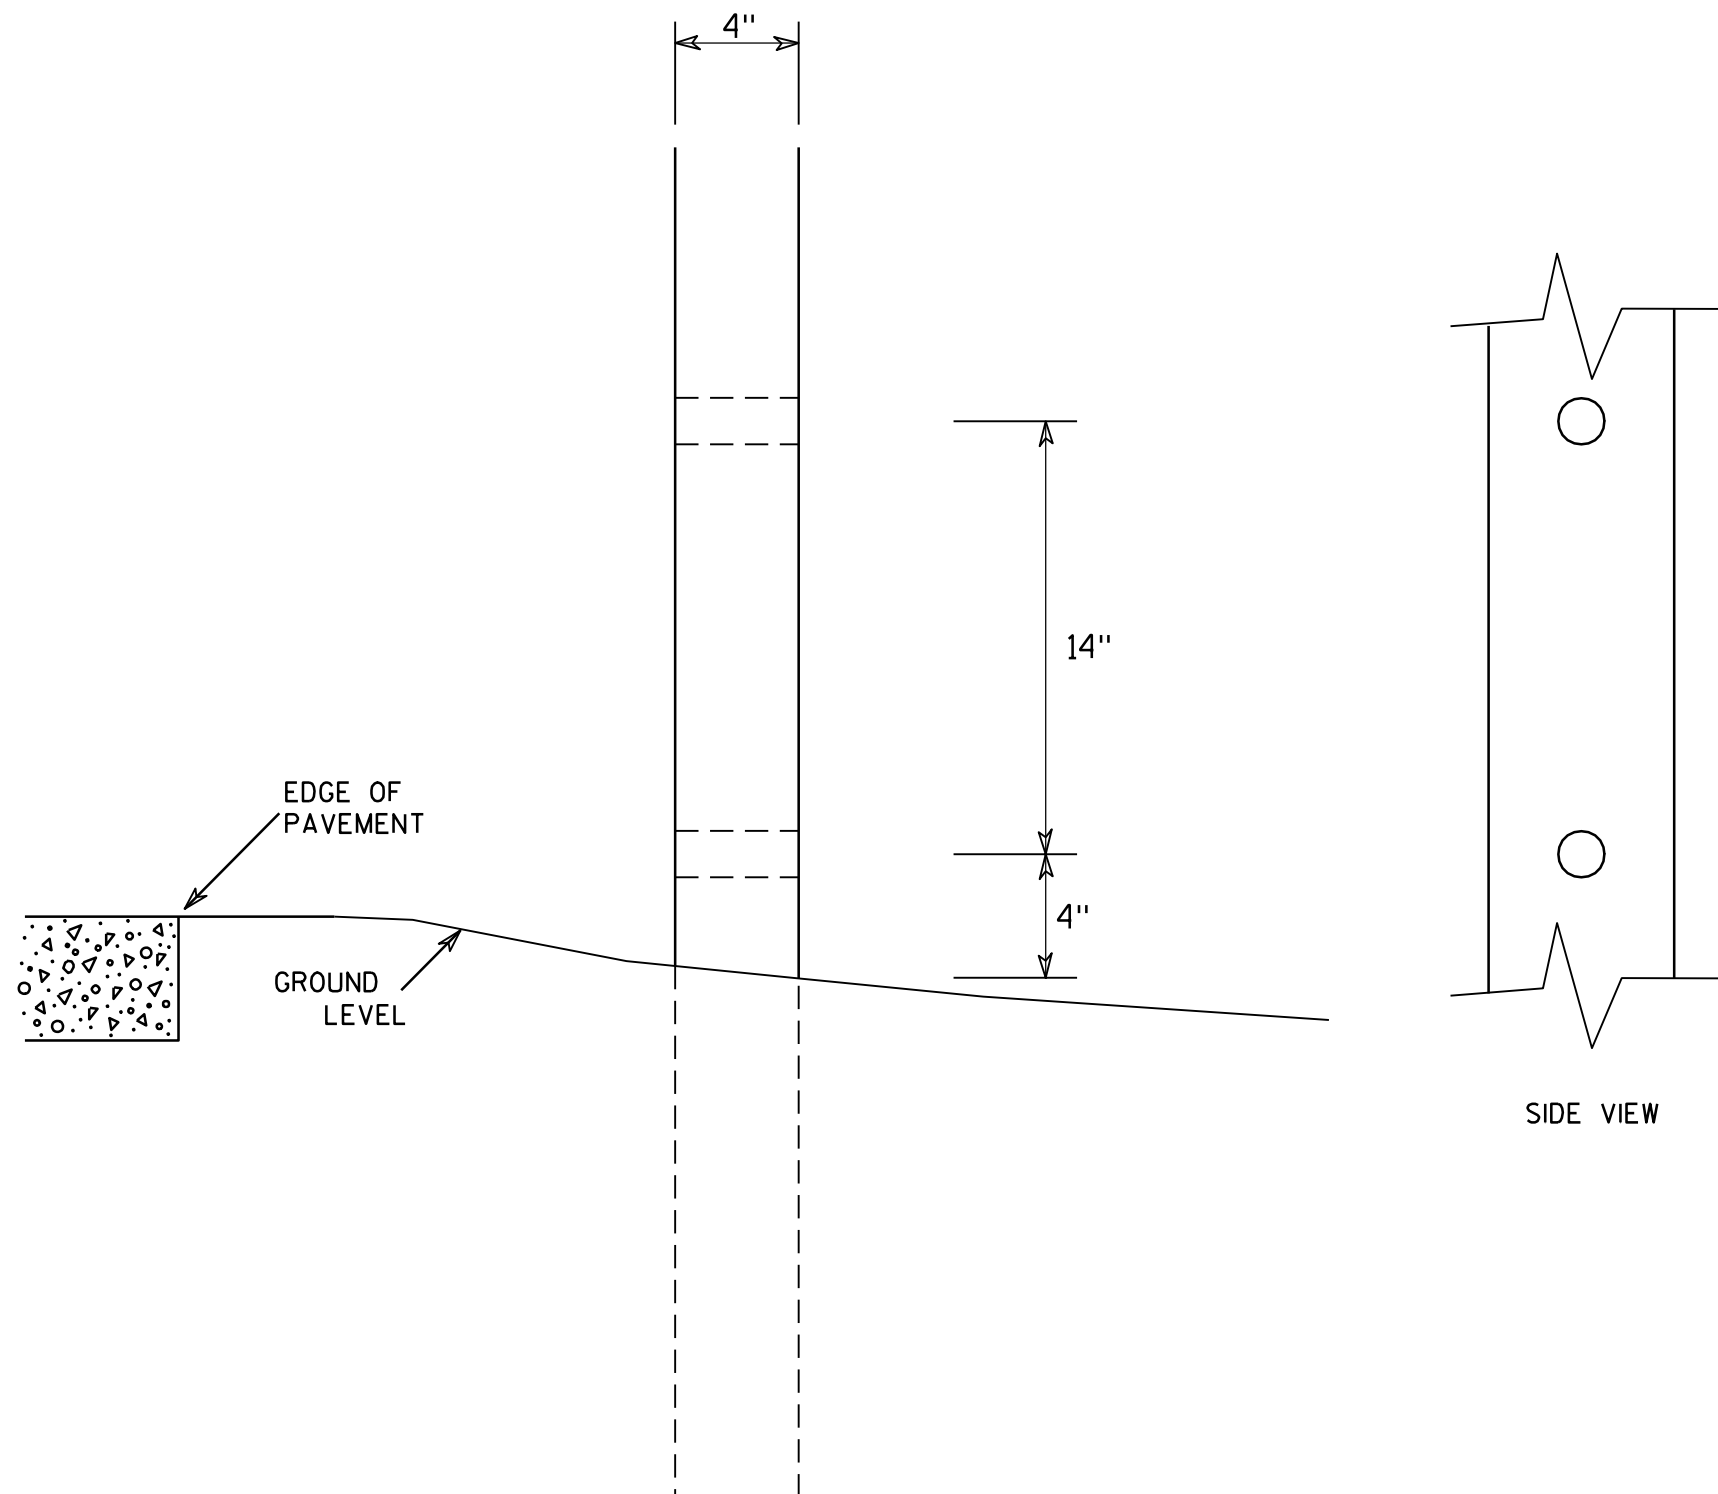

GENERAL NOTES

1. All 4 x 6 Wood Posts shall be modified by having two 1½" diameter holes drilled perpendicular to the roadway centerline.

7

4 X 6 WOOD POST MODIFICATIONS

WISCONSIN DEPT OF TRANSPORTATION

APPROVED

Chester J. Spang
for State Traffic Engineer

DATE 3/27/97

PLATE NO. A4-11.2

PROJECT NO:

HWY:


COUNTY:

SHEET NO: 34


E

NOTES

- Sign is Type II - Type F Reflective - reference WIS DOT Standard Specification for HIGHWAY and STRUCTURE CONSTRUCTION latest edition.
- Color:
Background - Yellow
Message - Black
- Corners may be square or rounded when base material is plywood but borders shall be rounded as shown. When base material is metal, the corners and borders shall be rounded.
- W1-2L is the same as W1-2R except the arrow is reversed along the vertical centerline.

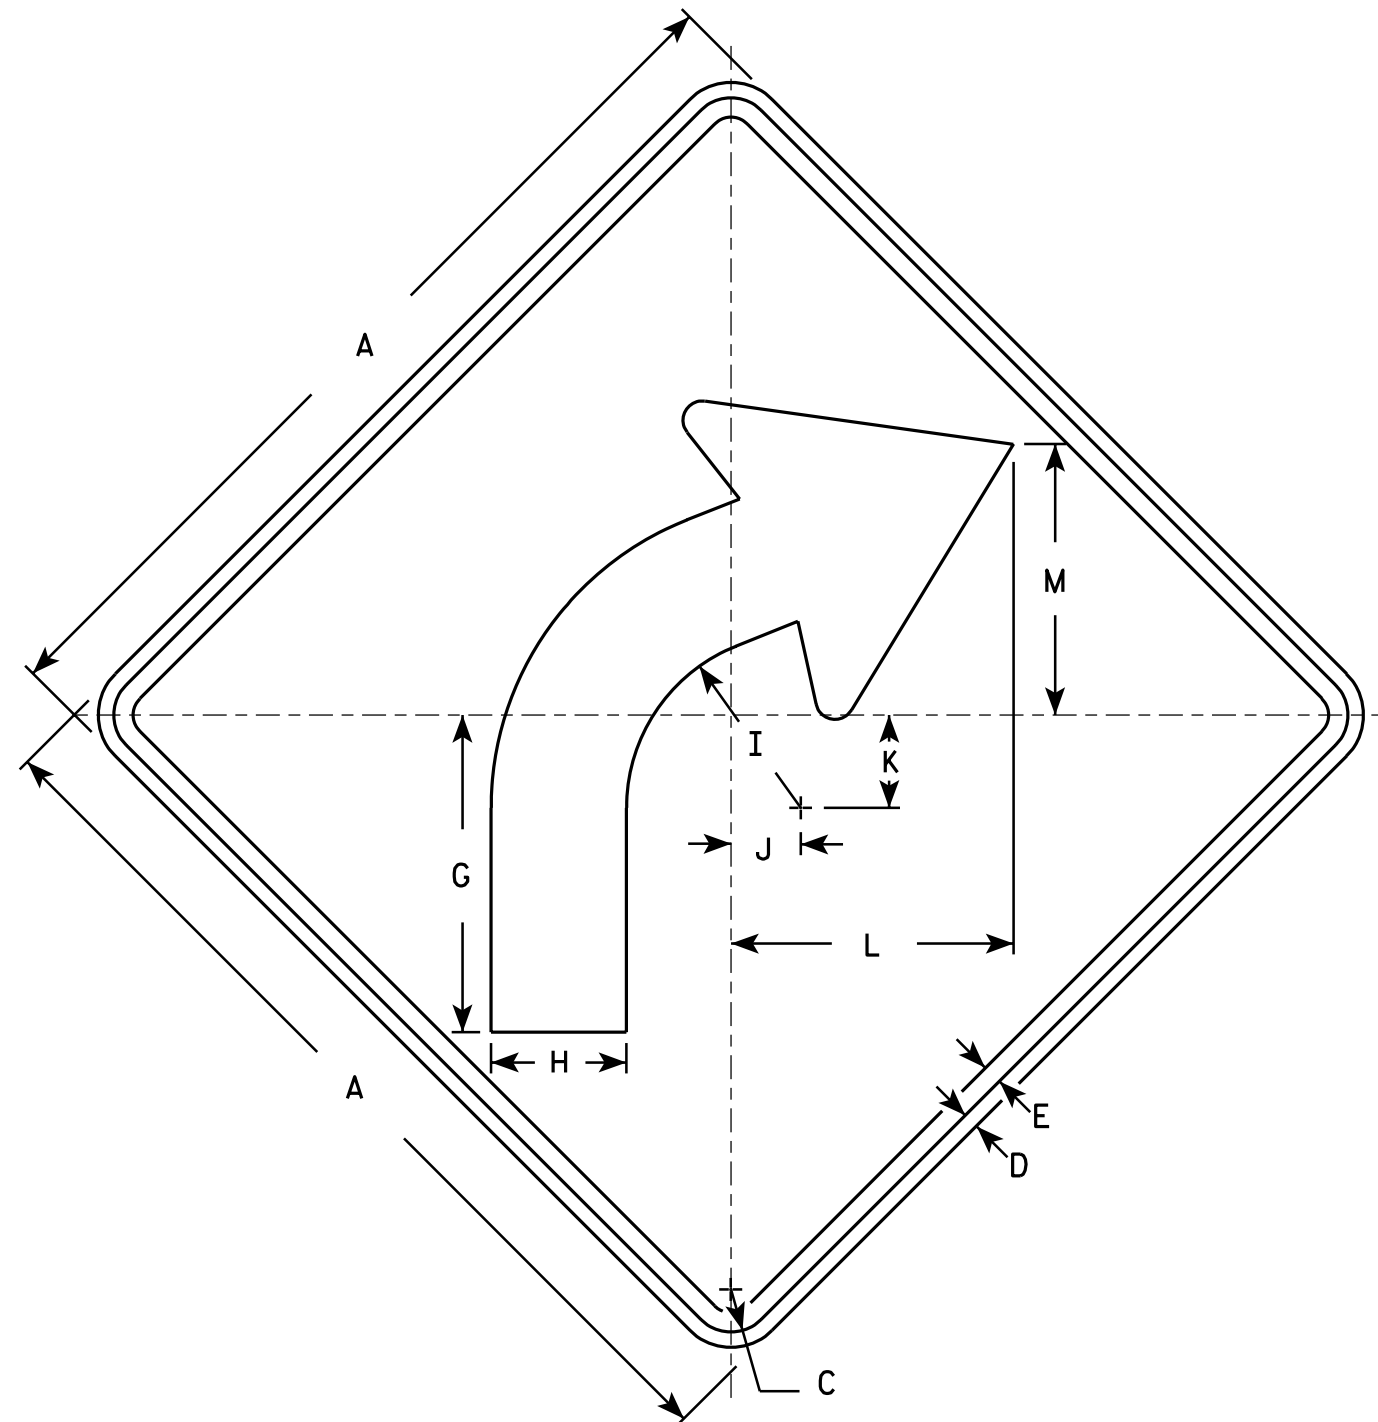

W1-2R

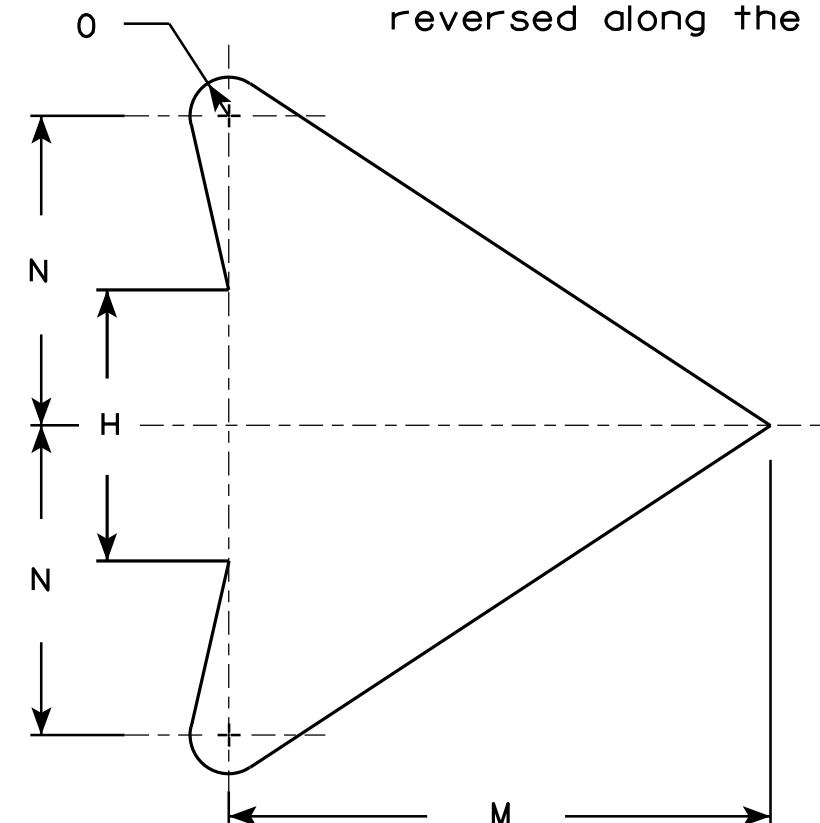

ARROW DETAIL

SIZE	A	B	C	D	E	F	G	H	I	J	K	L	M	N	O	P	Q	R	S	T	U	V	W	X	Y	Z	Area sq. ft.
1	24		1 1/8	3/8	1/2		8 1/4	3 1/2	4 1/2	1 3/4	2 3/8	7 1/4	7	4	1/2												4.0
2S	30		1 3/8	1/2	5/8		10 1/4	4 3/8	5 5/8	2 1/4	3	9 1/8	8 3/4	5	5/8												6.25
2M	36		1 5/8	5/8	3/4		12 3/8	5 1/4	6 3/4	2 5/8	3 1/2	10 7/8	10 1/2	6	3/4												9.0
3	36		1 5/8	5/8	3/4		12 3/8	5 1/4	6 3/4	2 5/8	3 1/2	10 7/8	10 1/2	6	3/4												9.0
4	36		1 5/8	5/8	3/4		12 3/8	5 1/4	6 3/4	2 5/8	3 1/2	10 7/8	10 1/2	6	3/4												9.0
5	48		2 1/4	3/4	1		16 1/2	7	9	3 1/2	4 5/8	14 1/2	14	8	1												16.0

STANDARD SIGN

W1-2

WISCONSIN DEPT OF TRANSPORTATION

APPROVED *Matthew R. Rauch*
for State Traffic Engineer

DATE 5/15/12 PLATE NO. W1-2.10


PROJECT NO:

HWY:

COUNTY:

SHEET NO: 35

E

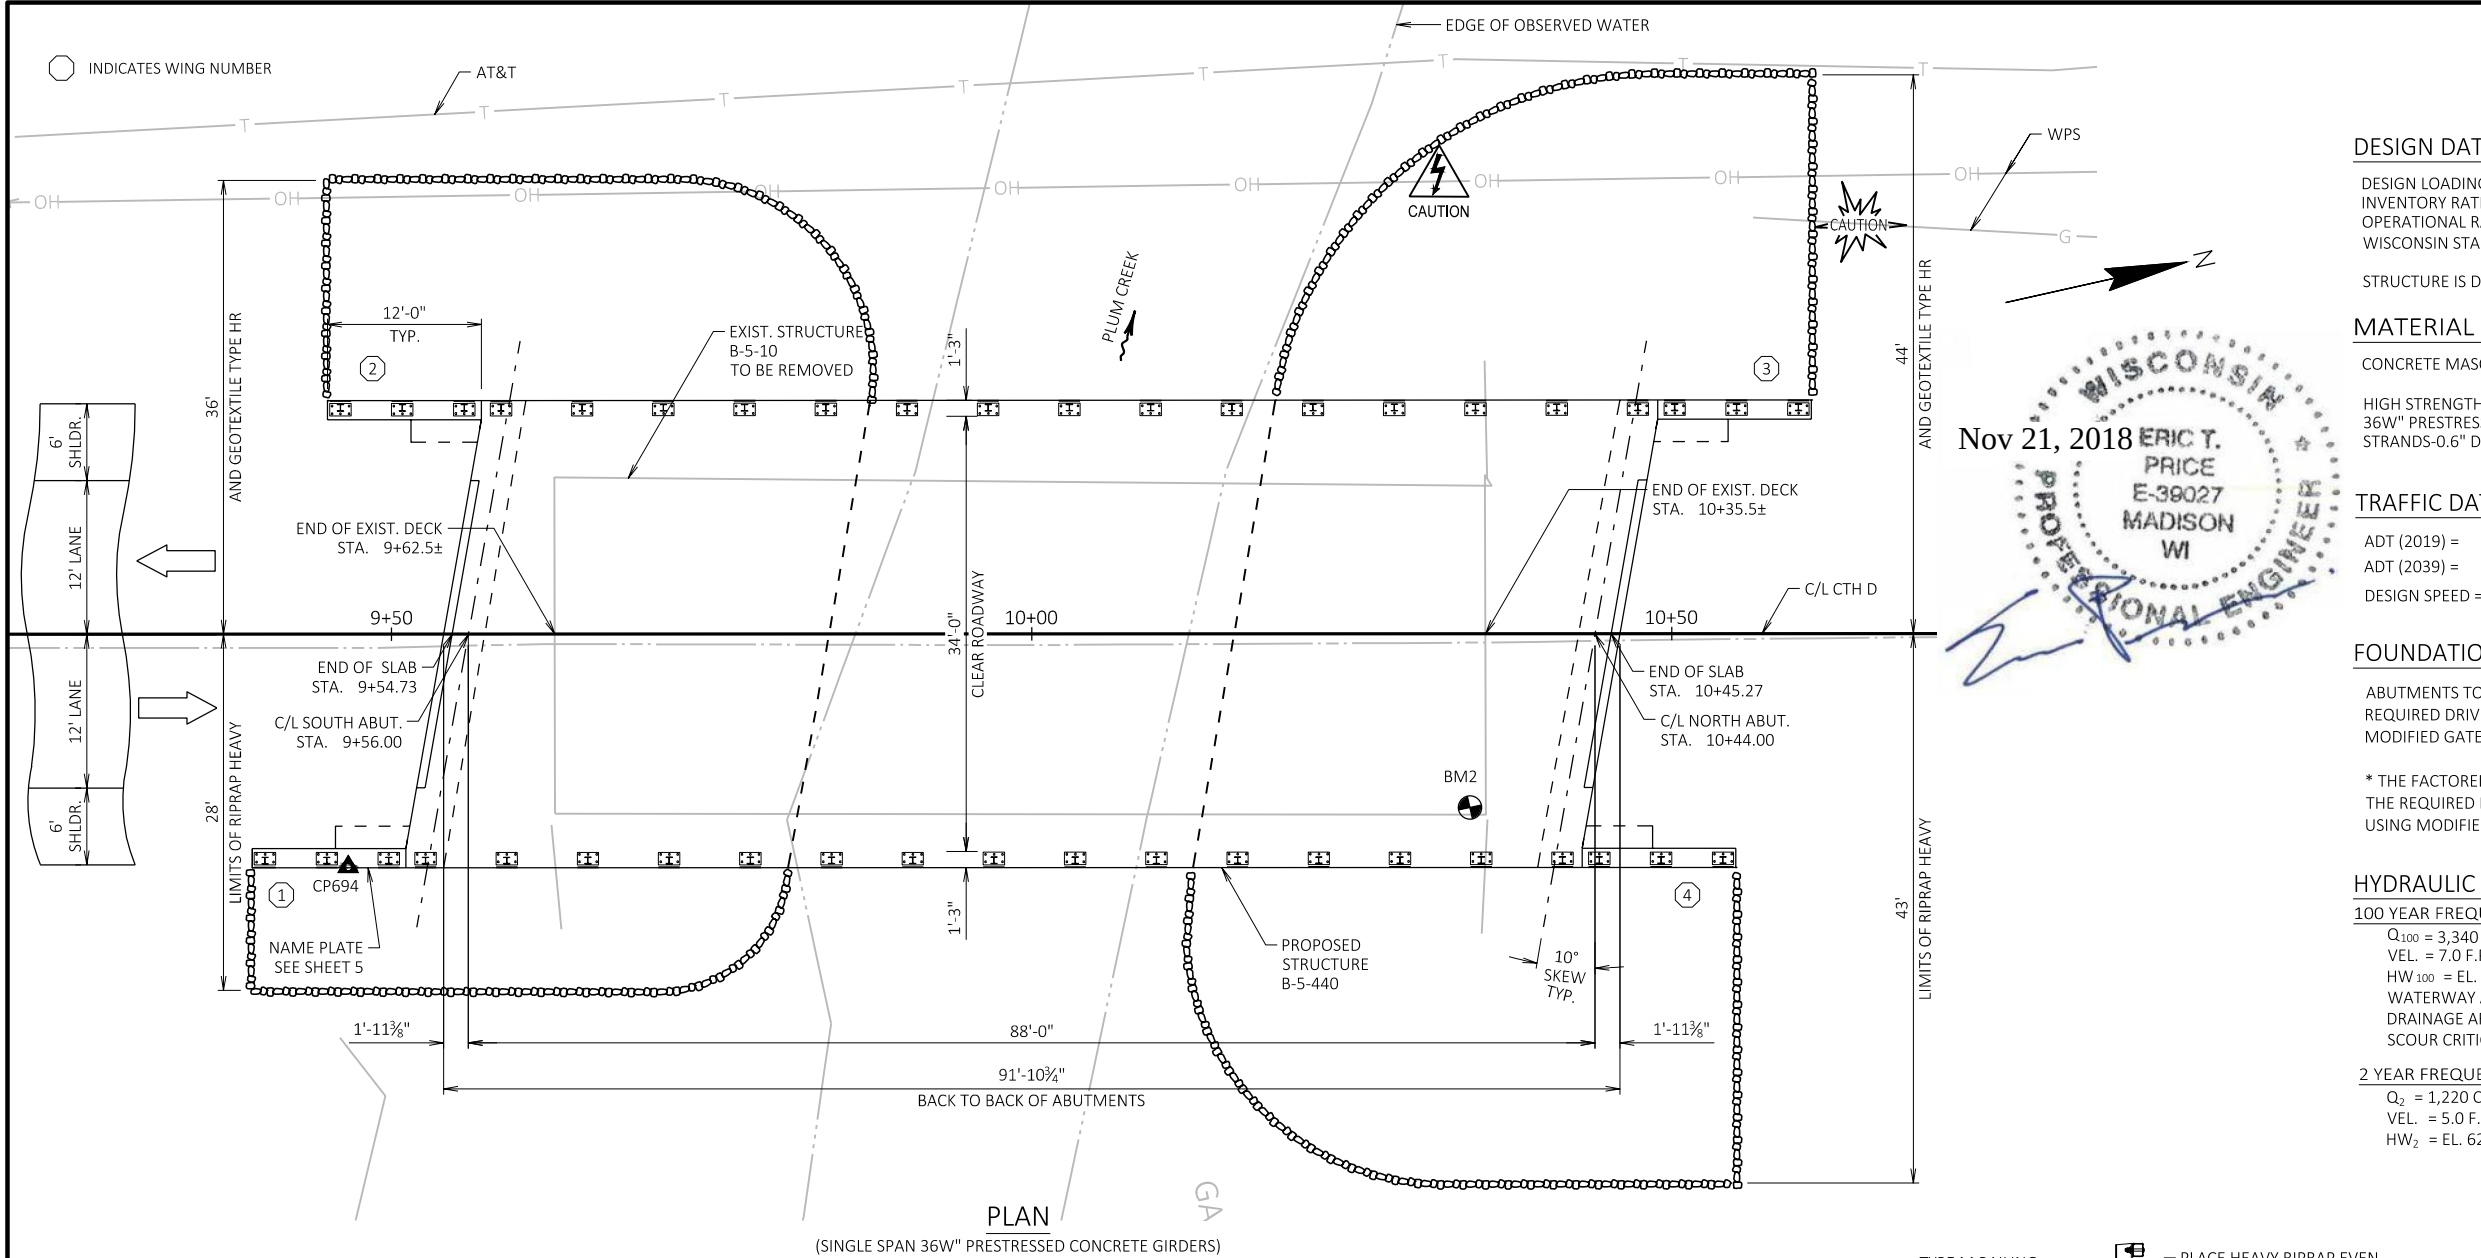

STATE PROJECT NUMBER
4546-02-71

DESIGN DATA
DESIGN LOADING _____ HL-93
INVENTORY RATING FACTOR _____ 1.17
OPERATIONAL RATING FACTOR _____ 1.86
WISCONSIN STANDARD PERMIT VEHICLE (WIS-SPV) _____ 240 KIPS

STRUCTURE IS DESIGNED FOR A FUTURE WEARING SURFACE OF 20 PSF.

MATERIAL PROPERTIES
CONCRETE MASONRY, SLAB _____ f'c = 4,000 PSI
ALL OTHER _____ f'c = 3,500 PSI
HIGH STRENGTH BAR STEEL REINFORCEMENT _____ fy = 60,000 PSI
36W" PRESTRESSED GIRDERS, CONCRETE MASONRY _____ f'c = 6,000 PSI
STRANDS-0.6" DIA ULTIMATE TENSILE STRENGTH _____ fu = 270,000 PSI

TRAFFIC DATA
ADT (2019) = 2,300
ADT (2039) = 3,300
DESIGN SPEED = 50 MPH




FOUNDATION DATA
ABUTMENTS TO BE SUPPORTED ON HP 10-INCH X 42 LB STEEL PILING DRIVEN TO A REQUIRED DRIVING RESISTANCE OF 165* TONS PER PILE AS DETERMINED BY THE MODIFIED GATES DYNAMIC FORMULA. ESTIMATED 90' LONG AT BOTH ABUTMENTS.

* THE FACTORED AXIAL RESISTANCE OF PILES IN COMPRESSION USED FOR DESIGN IS THE REQUIRED DRIVING RESISTANCE MULTIPLIED BY A RESISTANCE FACTOR OF 0.5 USING MODIFIED GATES TO DETERMINE DRIVEN PILE CAPACITY.

HYDRAULIC DATA
100 YEAR FREQUENCY
Q₁₀₀ = 3,340 C.F.S.
VEL. = 7.0 F.P.S.
HW₁₀₀ = EL. 626.03
WATERWAY AREA = 475 SQ. FT.
DRAINAGE AREA = 21.2 SQ. MI.
SCOUR CRITICAL CODE = 5

2 YEAR FREQUENCY
Q₂ = 1,220 C.F.S.
VEL. = 5.0 F.P.S.
HW₂ = EL. 622.57

- LIST OF DRAWINGS**
1. GENERAL PLAN
 2. CROSS SECTION & QUANTITIES
 3. SUBSURFACE EXPLORATION
 4. SOUTH ABUTMENT
 5. SOUTH ABUTMENT DETAILS
 6. NORTH ABUTMENT
 7. NORTH ABUTMENT DETAILS
 8. 36W-INCH PRESTRESSED GIRDER DETAILS 1
 9. 36W-INCH PRESTRESSED GIRDER DETAILS 2
 10. STEEL DIAPHRAGM
 11. SUPERSTRUCTURE
 12. SUPERSTRUCTURE DETAILS
 13. RAILING TUBULAR TYPE M

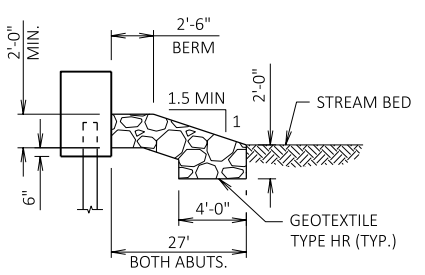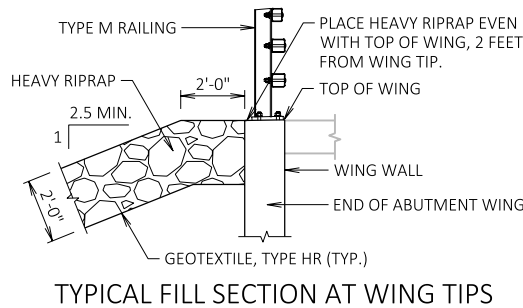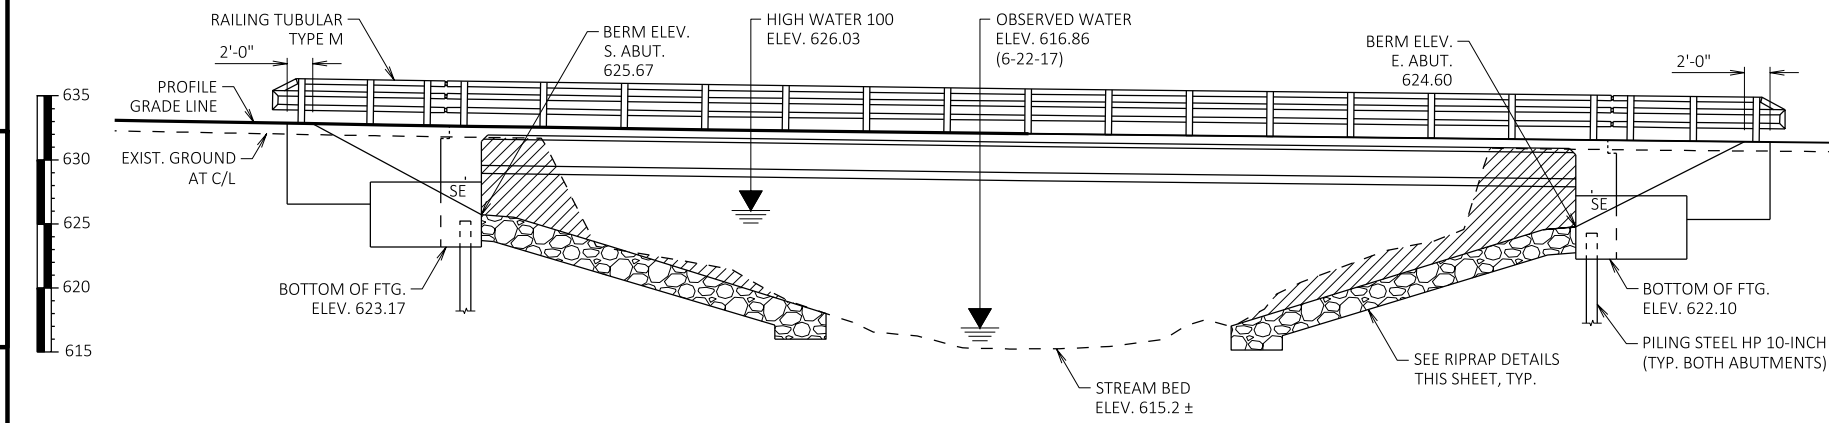

BENCH MARKS

NO.	STATION	DESCRIPTION	ELEV.
CP694	9+46.5	60D NAIL, 18.3' RT.	631.10
BM2	10+34.3	DISC, 13.9' RT.	631.45
CP	12+32.6	TELE. PED., 37.9' LT.	624.96

BRIDGE OFFICE CONTACT
BILL DREHER, P.E.
TELEPHONE: (608) 266-8489

CONSULTANT CONTACT
ERIC PRICE, P.E.
TELEPHONE: (608) 826-6146

CORRE

STATE OF WISCONSIN
DEPARTMENT OF TRANSPORTATION

ACCEPTED *William C. Dreher* SDR 11/23/18
CHIEF STRUCTURES DESIGN ENGINEER DATE

STRUCTURE B-5-440

CTH D OVER PLUM CREEK


COUNTY BROWN TOWN/CITY/VILLAGE WRIGHTSTOWN

DESIGN SPEC. AASHTO LRFD BRIDGE DESIGN SPECIFICATIONS

DESIGNED BY ERA DESIGN CK'D. ETP DRAWN BY PKF PLANS CK'D. ETP

GENERAL PLAN



SHEET 1 OF 13
37

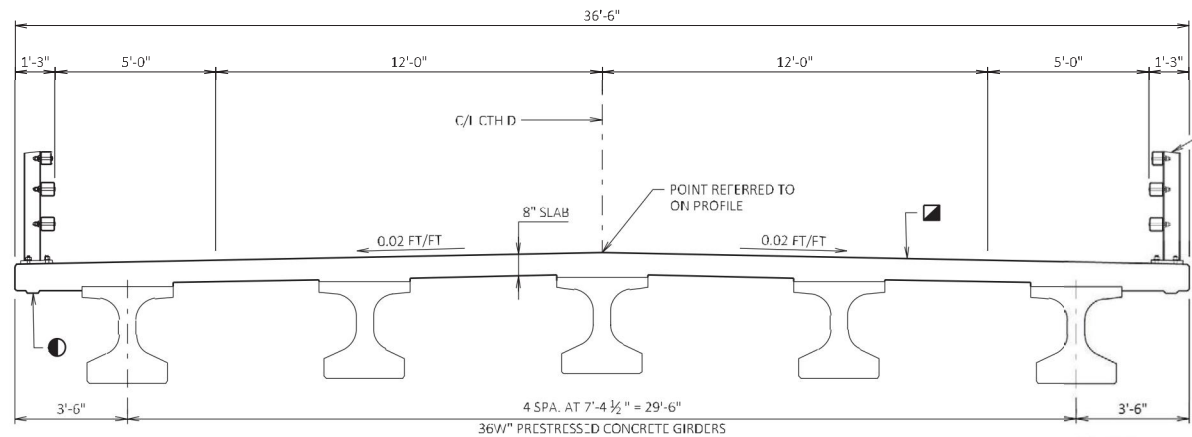


CROSS SECTION THRU BRIDGE
(LOOKING NORTH)

LEGEND

- SPECIAL DRIP EDGE REQ'D. EXTEND 6" FROM F.F. OF ABUTMENT BODY.
- COAT WITH "PROTECTIVE SURFACE TREATMENT" AS PER THE STANDARD SPECIFICATIONS.

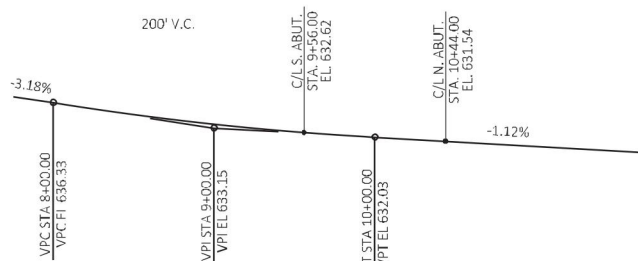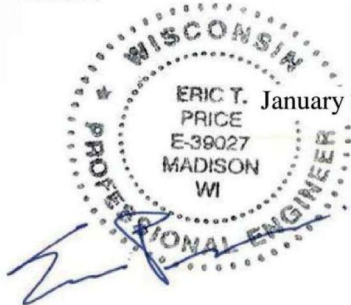


PROFILE GRADE LINE
(CT-4 D)

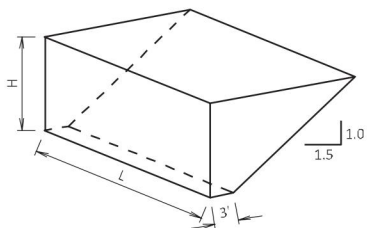

ABUTMENT BACKFILL QUANTITY DIAGRAM

L = OUT TO OUT OF ABUTMENT, INCLUDING WINGS (FT)
H = AVERAGE ABUTMENT FILL HEIGHT (FT)
EF = EXPANSION FACTOR (1.20 FOR CY BID ITEMS AND 1.00 FOR TON BID ITEMS)
 $V_{cr} = (L)(3.0')(H) + (L)(0.5)(1.5H)(H)$
 $V_{cy} = V_{cr}(EF)/27$
 $V_{ton} = V_{cy}(2.0)$


William C. Decker SDR
01/24/19

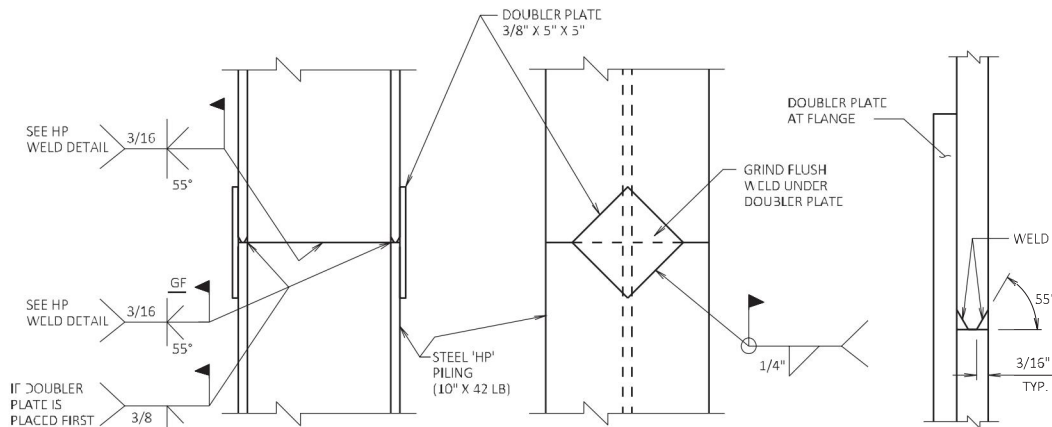

STEEL 'HP' PILING

STEEL 'HP' PILE MATERIAL SHALL BE A.S.T.M. DESIGNATION A36.

PILE SPLICE DETAILS

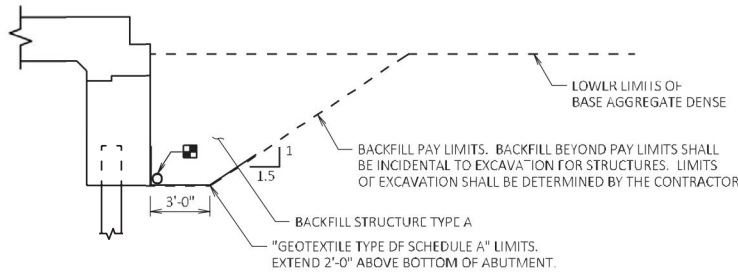

STRUCTURE BACKFILL LIMITS

- PIPE UNDERDRAIN WRAPPED (6-INCH). SLOPE 0.5% MIN. TO SUITABLE DRAINAGE. ATTACH RODENT SHIELD AT ENDS OF PIPE UNDERDRAIN.



1/23/19 QUANTITY REVISION			ETP
NO.	DATE	REVISION	BY
STATE OF WISCONSIN DEPARTMENT OF TRANSPORTATION			
STRUCTURE B-5-440			
DRAWN BY		PKF	PLANS CTD
CROSS SECTION & QUANTITIES		SHEET 2 OF 13	
		38	

TOTAL ESTIMATED QUANTITIES

BID NUMBER	BID ITEM	UNIT	SOUTH ABUT.	NORTH ABUT.	SUPER	TOTALS
203.0600 S	REMOVING OLD STRUCTURE OVER WATERWAY WITH MINIMAL DEBRIS STA. 10+00	LS	----	----	----	1
206.1000	EXCAVATION FOR STRUCTURES BRIDGES B-5-440	LS	----	----	----	1
210.1500	BACKFILL STRUCTURE TYPE A	TON	170	170	----	340
502.0100	CONCRETE MASONRY BRIDGES	CY	36	36	127	340
502.3200	PROTECTIVE SURFACE TREATMENT	SY	12	12	373	397
503.0137	PRESTRESSED GIRDER TYPE I 36W-INCH	LF	----	----	445	445
505.0400	BAR STEEL REINFORCEMENT HS STRUCTURES	LB	2,440	2,440	----	4,880
505.0600	BAR STEEL REINFORCEMENT HS COATED STRUCTURES	LB	1,430	1,420	21,950	24,800
506.2605	BEARING PADS ELASTOMERIC NON-LAMINATED	EACH	5	5	----	10
506.4000	STEEL DIAPHRAGMS B-5-440	EACH	----	----	8	8
513.4061	RAILING TUBULAR TYPE M	LF	26	26	184	236
516.0500	RUBBERIZED MEMBRANE WATERPROOFING	SY	9	9	----	18
550.0500	PILE POINTS	EACH	9	9	----	18
550.1100	PILING STEEL HP 10-INCH X 42 LB	LF	810	810	----	1,620
606.0300	RIPRAP HEAVY	CY	190	265	----	455
612.0406	PIPE UNDERDRAIN WRAPPED 6-INCH	LF	90	90	----	180
645.0111	GEOTEXTILE TYPE DF SCHEDULE A	SY	36	36	----	72
645.0120	GEOTEXTILE TYPE HR	SY	260	360	----	620
NON-BID ITEMS						
	FILLER	SIZE	----	----	----	1/2" & 3/4"

BILL OF BARS - SOUTH ABUTMENT

DIMENSIONS IN BENDING DETAILS ARE OUT-TO-OUT OF BAR.

BAR MARK	NO. REQ'D	LENGTH	BENT	BAR SERIES	LOCATION
NON-COATED BARS					TOTAL WEIGHT = 2,440 LBS
A401	9	28'-0"	X		BODY - AT PILES - 1 PER PILE VERT.
A402	18	2'-3"			BODY - AT PILES - 2 PER PILE VERT.
A503	45	15'-2"	X		BODY - STIRRUPS VERT.
A604	22	19'-10"			BODY - B.F. & F.F. & TOP & BTM HORIZ.
A805	14	20'-4"	X		BODY - B.F. HORIZ.
A406	8	4'-7"			BODY - ENDS VERT.
A407	8	6'-0"			BODY - BTWN BEAM SEATS HORIZ.
A408	16	4'-11"	X		BODY - BTWN BEAM SEATS VERT.
COATED BARS					TOTAL WEIGHT = 1,430 LBS
A510	12	15'-4"	X		WINGS 1 & 2 - STIRRUPS VERT.
A511	6	8'-1"			WING 1 - F.F. HORIZ.
A612	9	8'-1"			WING 1 - TOP & B.F. HORIZ.
A613	9	7'-6"			WING 2 - TOP & B.F. HORIZ.
A514	6	8'-6"			WING 2 - F.F. HORIZ.
A415	16	7'-9"			WINGS 1 & 2 - OVERHANG HORIZ.
A416	18	11'-8"			WINGS 1 & 2 HORIZ.
A517	22	12'-11"	X		WINGS 1 & 2 VERT.
A518	26	11'-11"	X		WINGS 1 & 2 - OVERHANG VERT.
A619	4	11'-8"			WINGS 1 & 2 - TOP HORIZ.

THE FIRST DIGIT OR FIRST TWO DIGITS OF THE BAR MARK SIGNIFIES THE BAR SIZE.

LEGEND

- A03

OPTIONAL KEYED CONST. JOINT FORMED BY BEVELED 2" x 6" (18" RUBBERIZED MEMBRANE WATERPROOFING AT B.F. & ¾" "V" GROOVE AT F.F. IF JOINT IS USED).
- A09

SUPPORT ABUTMENT ON PILING STEEL HP 10-INCH x 42 LB, ESTIMATED 90 FEET LONG, DRIVEN TO A REQUIRED DRIVING RESISTANCE OF 165 TONS PER PILE. SEE ADDITIONAL FOUNDATION DATA ON SHEET 1 AND PILE SPLICE DETAILS ON SHEET 2.
- A15


PIPE UNDERDRAIN WRAPPED 6-INCH. SLOPE 0.5% MIN. TO SUITABLE DRAINAGE. ATTACH RODENT SCREEN AT ENDS OF PIPE UNDERDRAIN. RODENT SHIELD TO BE INCLUDED IN BID PRICE OF "PIPE UNDERDRAIN WRAPPED 6-INCH".
- A17

½" FILLER (INCLUDED IN WING LENGTH): SEAL ALL EXPOSED HORIZONTAL AND VERTICAL SURFACES OF ½" FILLER WITH NON-STAINING GRAY NON-BITUMINOUS JOINT SEALER. (1" DEEP AND HOLD 1/8" BELOW SURFACE OF CONCRETE.)
- A19


18" RUBBERIZED MEMBRANE WATERPROOFING. SEAL ALL HORIZONTAL AND VERTICAL JOINTS ON BACKFACE.

B.F. DENOTES BACK FACE
F.F. DENOTES FRONT FACE


STD. 180° HOOK

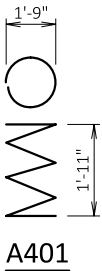


A401

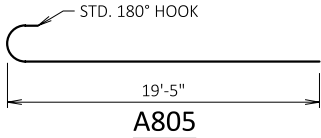


A805

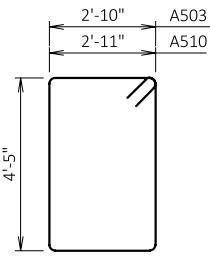

A503, A510

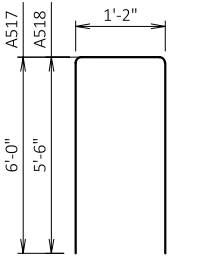


A517, A518

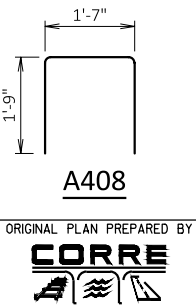


A408




NO.	DATE	REVISION	BY
STATE OF WISCONSIN DEPARTMENT OF TRANSPORTATION			
STRUCTURE B-5-440			
DRAWN BY PKF		PLANS CK'D. ETP	
SOUTH ABUTMENT DETAILS			SHEET 5 OF 13
			41

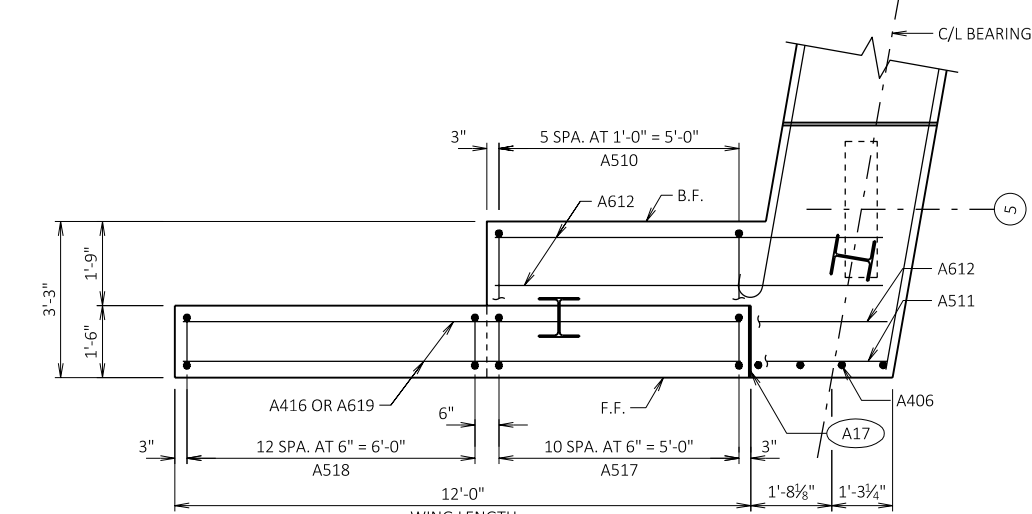


PLAN WING 1

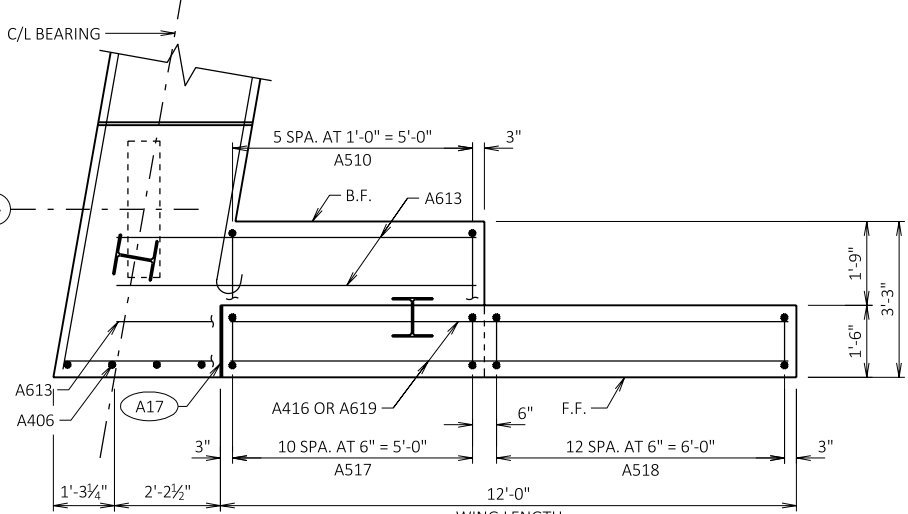


PLAN WING 2

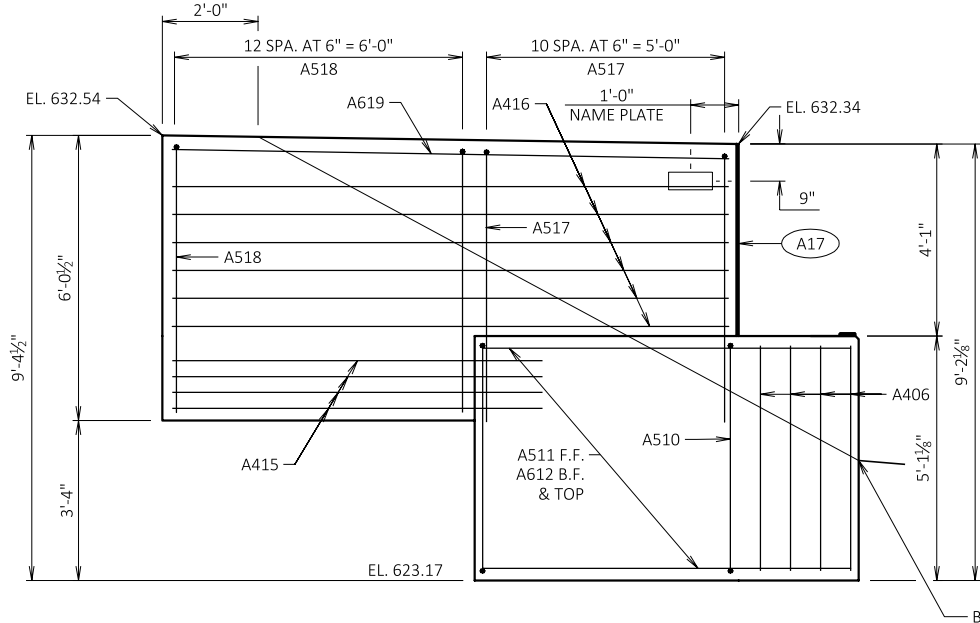


ELEVATION WING 1

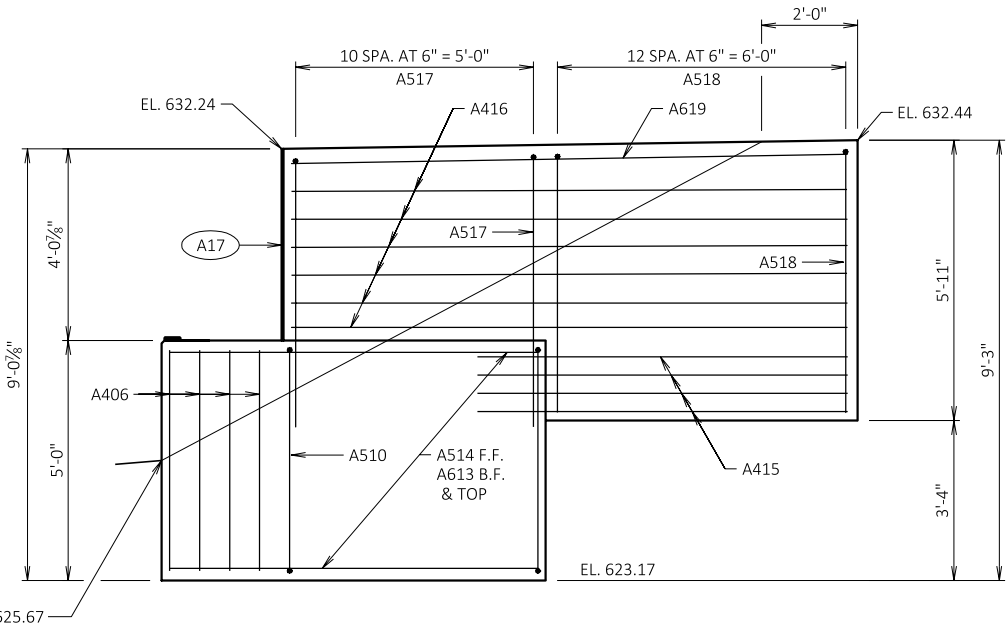


ELEVATION WING 2

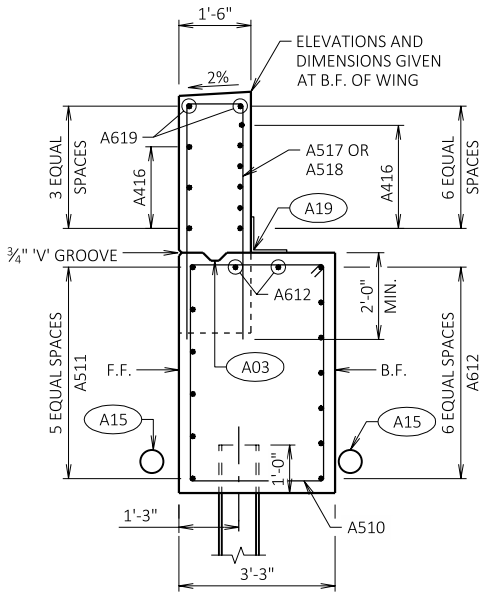


SECTION THRU WING 1

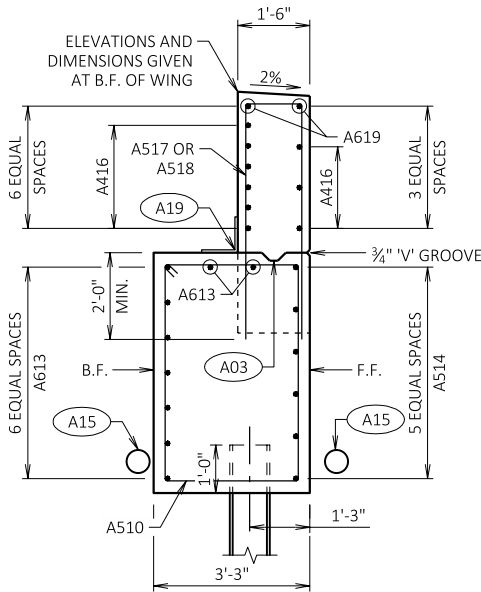

SECTION THRU WING 2

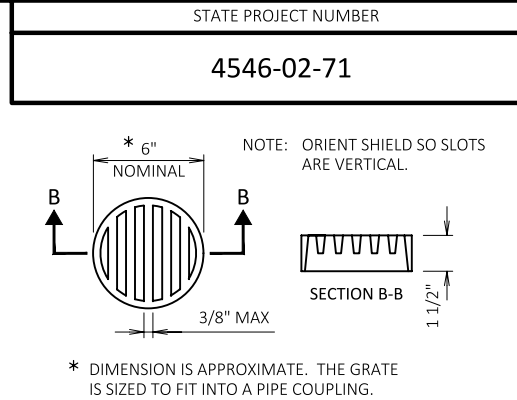

THE RODENT SHIELD SHALL BE A PVC GRATE SIMILAR TO THIS DETAIL. THE GRATE IS COMMERCIALY AVAILABLE AS A FLOOR STRAINER. A PIPE COUPLING IS REQUIRED FOR THE ATTACHMENT OF THIS SHIELD TO THE OUTFALL PIPE. THE SHIELD SHALL BE FASTENED TO THE PIPE COUPLING WITH TWO OR MORE NO. 10 X 1-INCH STAINLESS STEEL SHEET METAL SCREWS.

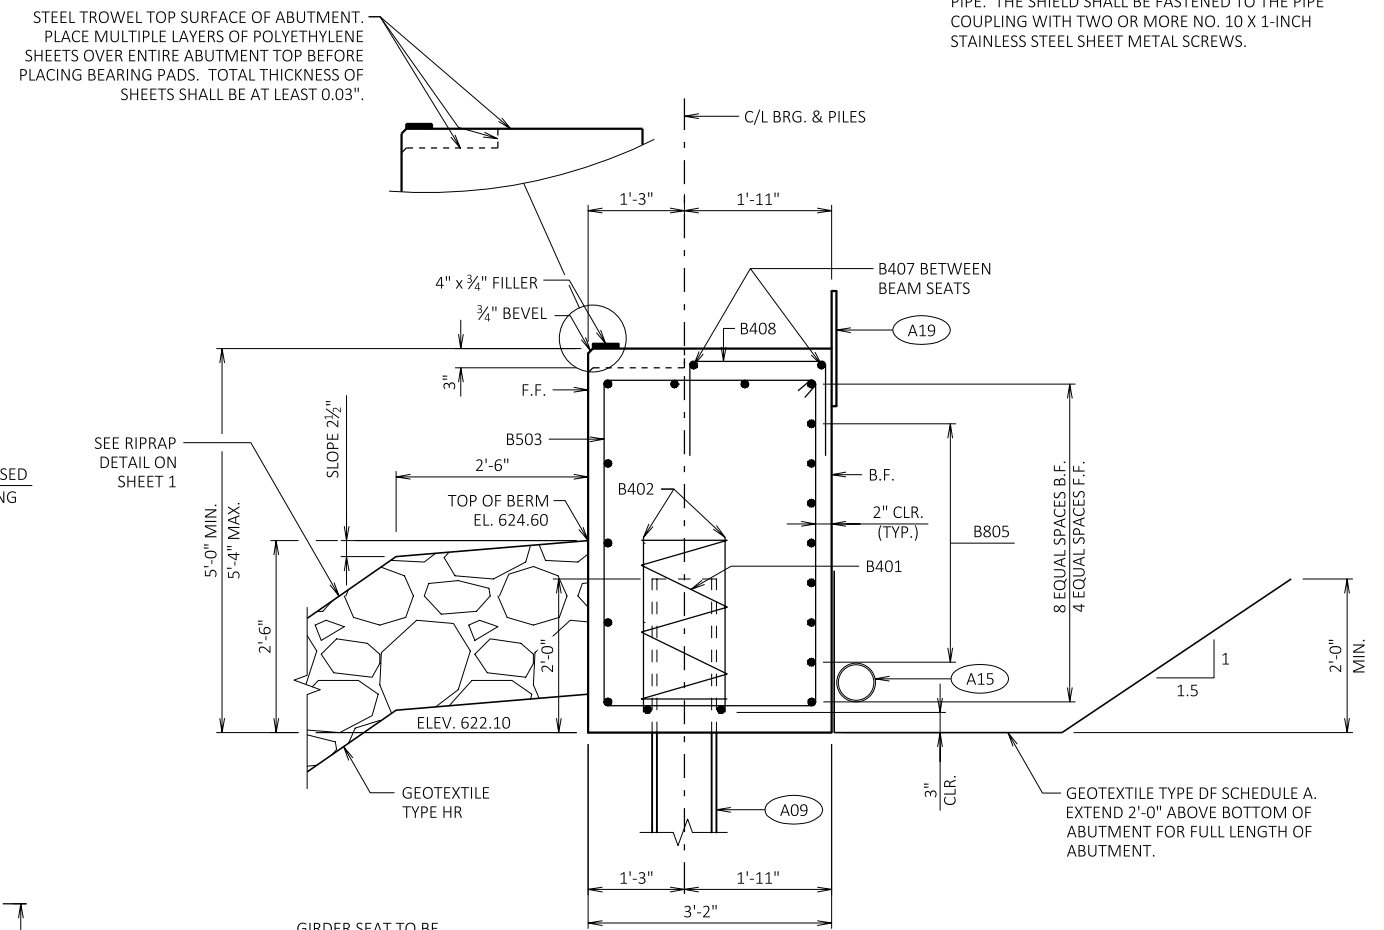

The diagram illustrates the 'GIRDER SEAT DETAIL' for a bridge structure. It shows a cross-section of a girder resting on a bearing pad. Key features and labels include:

- C/L OF GIRDER**: Centerline of the girder.
- BEARING PAD**: The surface the girder sits on.
- B.F. OF ABUT.**: Back face of the abutment.
- C/L OF BRG.**: Centerline of the bridge.
- F.F. OF ABUT.**: Front face of the abutment.
- BEAM SEAT ELEVATION**: The elevation of the beam seat.
- GIRDER SEAT TO BE BUILT PARALLEL TO THE SLOPE OF THE GIRDERS IN THIS DIRECTION.**: A note indicating the orientation of the girder seat.
- 0.03'**: A vertical dimension indicating the offset from the horizontal line.
- +0.02'**: A horizontal dimension indicating the offset from the vertical line.
- GIRDER SEAT TO BE BUILT LEVEL IN THIS DIRECTION.**: A note indicating the orientation of the girder seat.



NO.	DATE	REVISION	BY
STATE OF WISCONSIN DEPARTMENT OF TRANSPORTATION			
STRUCTURE B-5-440			
		DRAWN BY	PKF
		PLANS CK'D.	ETP
NORTH ABUTMENT		SHEET 6 OF 13	
		42	

BILL OF BARS - NORTH ABUTMENT

DIMENSIONS IN BENDING DETAILS ARE OUT-TO-OUT OF BAR.

BAR MARK	NO. REQ'D	LENGTH	BENT	BAR SERIES	LOCATION
NON-COATED BARS					TOTAL WEIGHT = 2,440 LBS
B401	9	28'-0"	X		BODY - AT PILES - 1 PER PILE VERT.
B402	18	2'-3"			BODY - AT PILES - 2 PER PILE VERT.
B503	45	15'-2"	X		BODY - STIRRUPS VERT.
B604	22	19'-10"			BODY - B.F. & F.F. & TOP & BTM HORIZ.
B805	14	20'-4"	X		BODY - B.F. HORIZ.
B406	8	4'-7"			BODY - ENDS VERT.
B407	8	6'-0"			BODY - BTWN BEAM SEATS HORIZ.
B408	16	4'-11"	X		BODY - BTWN BEAM SEATS VERT.
COATED BARS					TOTAL WEIGHT = 1,420 LBS
B510	12	15'-4"	X		WINGS 3 & 4 - STIRRUPS VERT.
B511	6	8'-1"			WING 3 - F.F. HORIZ.
B612	9	8'-1"			WING 3 - TOP & B.F. HORIZ.
B613	9	7'-6"			WING 4 - TOP & B.F. HORIZ.
B514	6	8'-6"			WING 4 - F.F. HORIZ.
B415	16	7'-9"			WINGS 3 & 4 - OVERHANG HORIZ.
B416	18	11'-8"			WINGS 3 & 4 HORIZ.
B517	22	12'-7"	X		WINGS 3 & 4 VERT.
B518	26	11'-11"	X		WINGS 3 & 4 - OVERHANG VERT.
B619	4	11'-8"			WINGS 3 & 4 - TOP HORIZ.

THE FIRST DIGIT OR FIRST TWO DIGITS OF THE BAR MARK SIGNIFIES THE BAR SIZE.

LEGEND

- A03

OPTIONAL KEYED CONST. JOINT FORMED BY BEVELED 2" x 6" (18" RUBBERIZED MEMBRANE WATERPROOFING AT B.F. & ¾" "V" GROOVE AT F.F. IF JOINT IS USED).
- A09


SUPPORT ABUTMENT ON PILING STEEL HP 10-INCH x 42 LB, ESTIMATED 90 FEET LONG, DRIVEN TO A REQUIRED DRIVING RESISTANCE OF 165 TONS PER PILE. SEE ADDITIONAL FOUNDATION DATA ON SHEET 1 AND PILE SPLICE DETAILS ON SHEET 2.
- A15

PIPE UNDERDRAIN WRAPPED 6-INCH. SLOPE 0.5% MIN. TO SUITABLE DRAINAGE. ATTACH RODENT SCREEN AT ENDS OF PIPE UNDERDRAIN. RODENT SHIELD TO BE INCLUDED IN BID PRICE OF "PIPE UNDERDRAIN WRAPPED 6-INCH".
- A17


½" FILLER (INCLUDED IN WING LENGTH): SEAL ALL EXPOSED HORIZONTAL AND VERTICAL SURFACES OF ½" FILLER WITH NON-STAINING GRAY NON-BITUMINOUS JOINT SEALER. (1" DEEP AND HOLD 1/8" BELOW SURFACE OF CONCRETE.)
- A19

18" RUBBERIZED MEMBRANE WATERPROOFING. SEAL ALL HORIZONTAL AND VERTICAL JOINTS ON BACKFACE.


B.F. DENOTES BACK FACE
F.F. DENOTES FRONT FACE

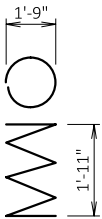


B401

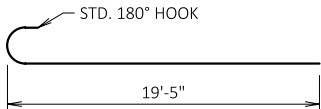


B805

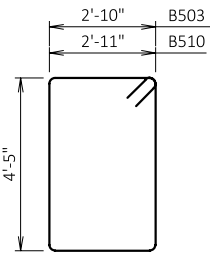

B503, B510

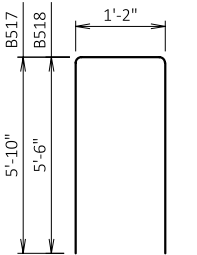


B517, B518

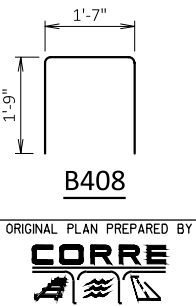


B408


NO.	DATE	REVISION	BY
STATE OF WISCONSIN DEPARTMENT OF TRANSPORTATION			
STRUCTURE B-5-440			
DRAWN BY PKF		PLANS CK'D. ETP	
NORTH ABUTMENT DETAILS			SHEET 7 OF 13
			43

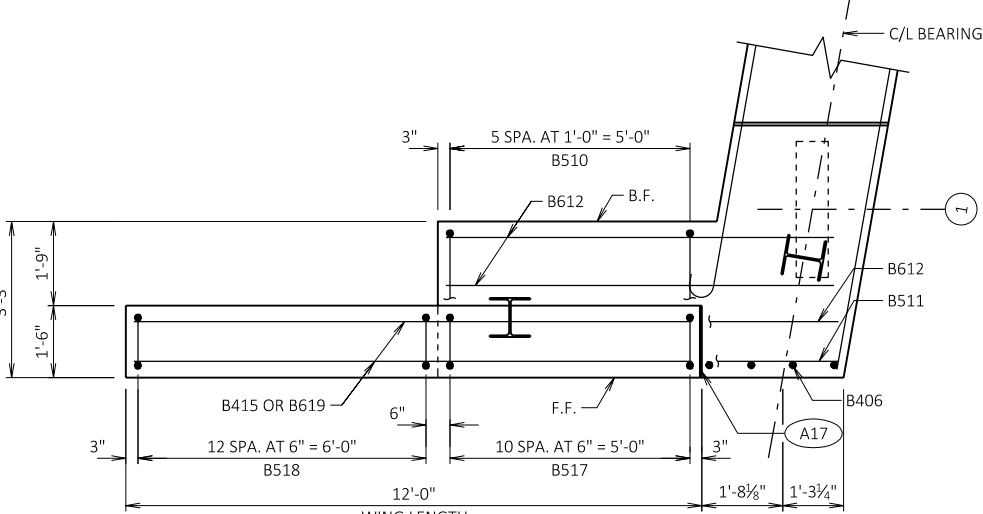


PLAN WING 3

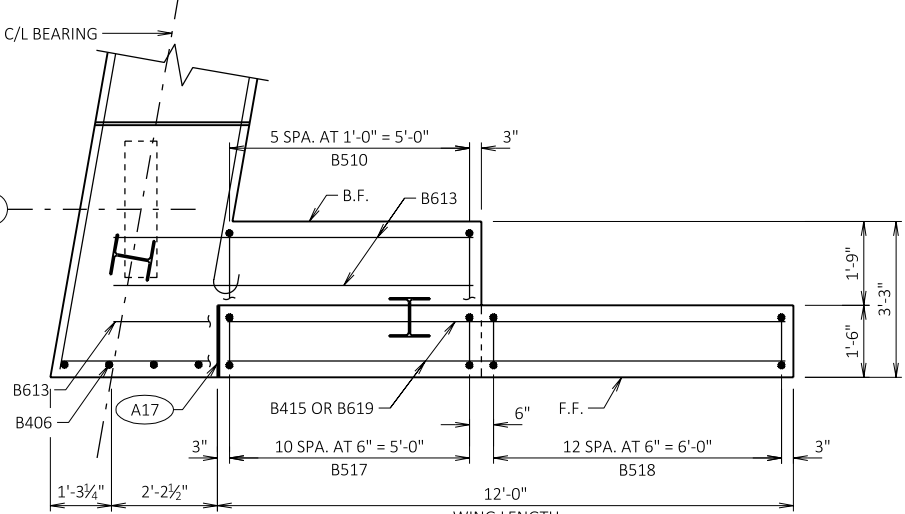


PLAN WING 4

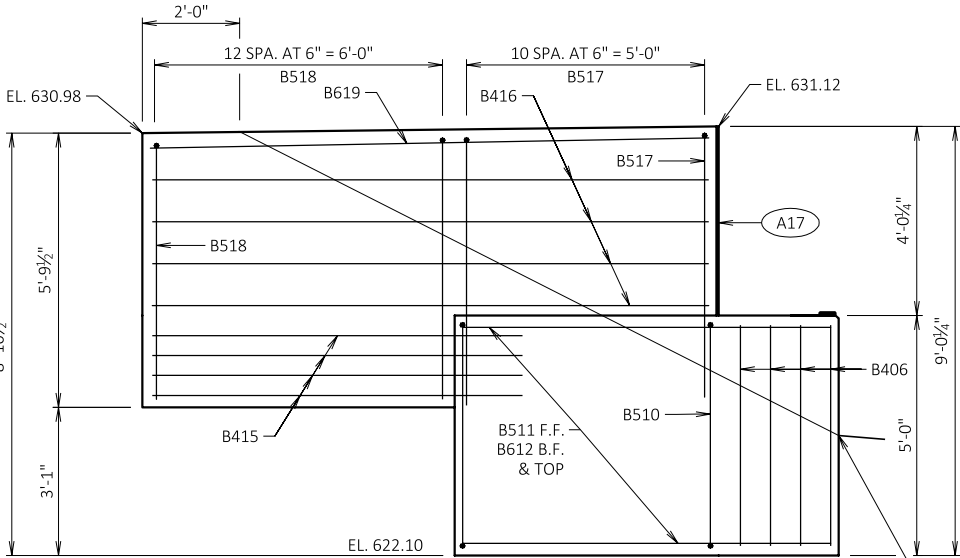


ELEVATION WING 3

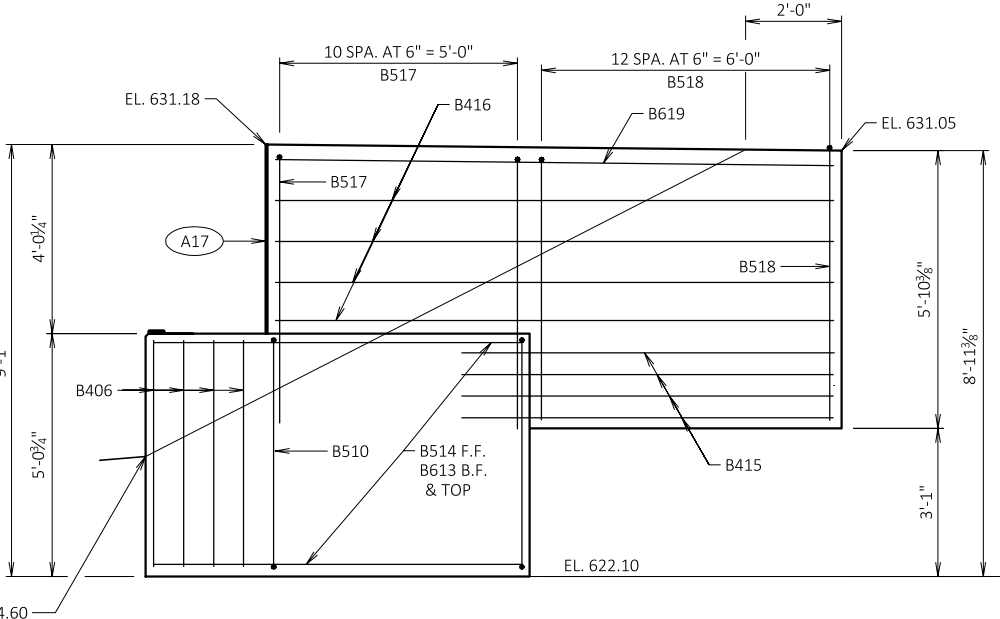

ELEVATION WING 4

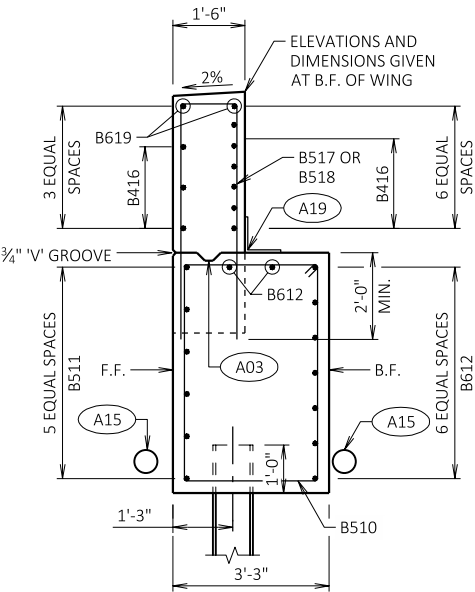

SECTION THRU WING 3

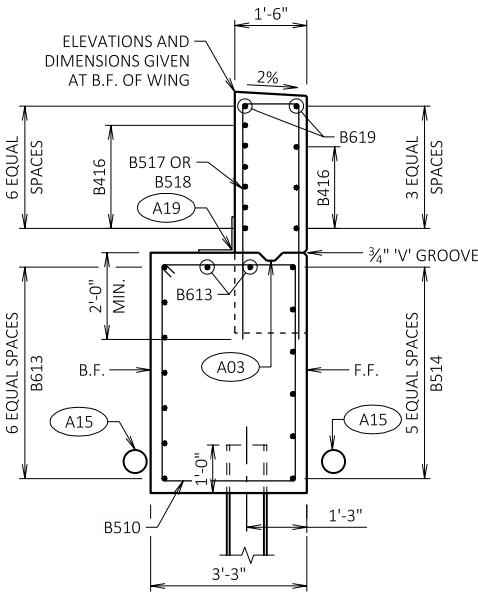

SECTION THRU WING 4

NOTES

TOP OF GIRDER TO BE ROUGH FLOATED AND BROOMED TRANSVERSELY, EXCEPT THE THE OUTSIDE 8" OF GIRDER, WHICH SHALL RECEIVE A SMOOTH FINISH. AN APPROVED CONCRETE SEALER SHALL BE APPLIED TO ALL SMOOTH SURFACES INCLUDING THE OUTSIDE 8" OF THE TOP FLANGE.

DO NOT APPLY CONCRETE SEALER OR EPOXY TO SURFACES RECEIVING APPLICATION OF CONCRETE STAINING.

THE GIRDERS SHALL BE PROVIDED WITH A SUITABLE LIFTING DEVICE FOR HANDLING AND ERECTING THE GIRDERS. SEE SECT. 503.3.3 OF STANDARD SPECIFICATIONS FOR GUIDANCE.

STRANDS SHALL BE FLUSH WITH END OF GIRDER, FOR GIRDER ENDS EMBEDDED COMPLETELY IN CONCRETE, END OF STRANDS SHALL BE COATED WITH NON-BITUMINOUS JOINT SEALER. FOR GIRDER ENDS THAT ARE FINALLY EXPOSED, COAT THE GIRDER ENDS, EXPOSED STRAND ENDS AND ALL NON-BONDING SURFACES WITHIN 2 FEET OF THE GIRDER ENDS WITH A NON-PIGMENTED EPOXY CONFORMING TO AASHTO M-235 TYPE III, GRADE 2, CLASS B OR C. THE EPOXY SHALL BE APPLIED AT LEAST 3 DAYS AFTER MOIST CURING HAS CEASED AND PRIOR TO THE APPLICATION OF THE SEALER.


ALL GIRDERS SHALL BE CAST FULL LENGTH AS SHOWN.

SPACING SHOWN FOR #4 STIRRUPS IS FOR GRADE 60 REINFORCEMENT.

AN ALTERNATE EQUIVALENT OF WELDED WIRE FABRIC (WWF) ASTM A1064 MAY BE SUBSTITUTED FOR THE STIRRUP REINFORCEMENT SHOWN, UPON APPROVAL OF THE STRUCTURES DEVELOPMENT SECTION.

PRESTRESSING STRANDS SHALL BE (0.6" DIA.)-7 WIRE LOW-RELAXATION STRANDS WITH AN ULTIMATE STRENGTH OF 270,000 PSI.


FOR DIAPHRAGM INSERT & CONNECTION DETAILS SEE "STEEL DIAPHRAGM" SHEET.

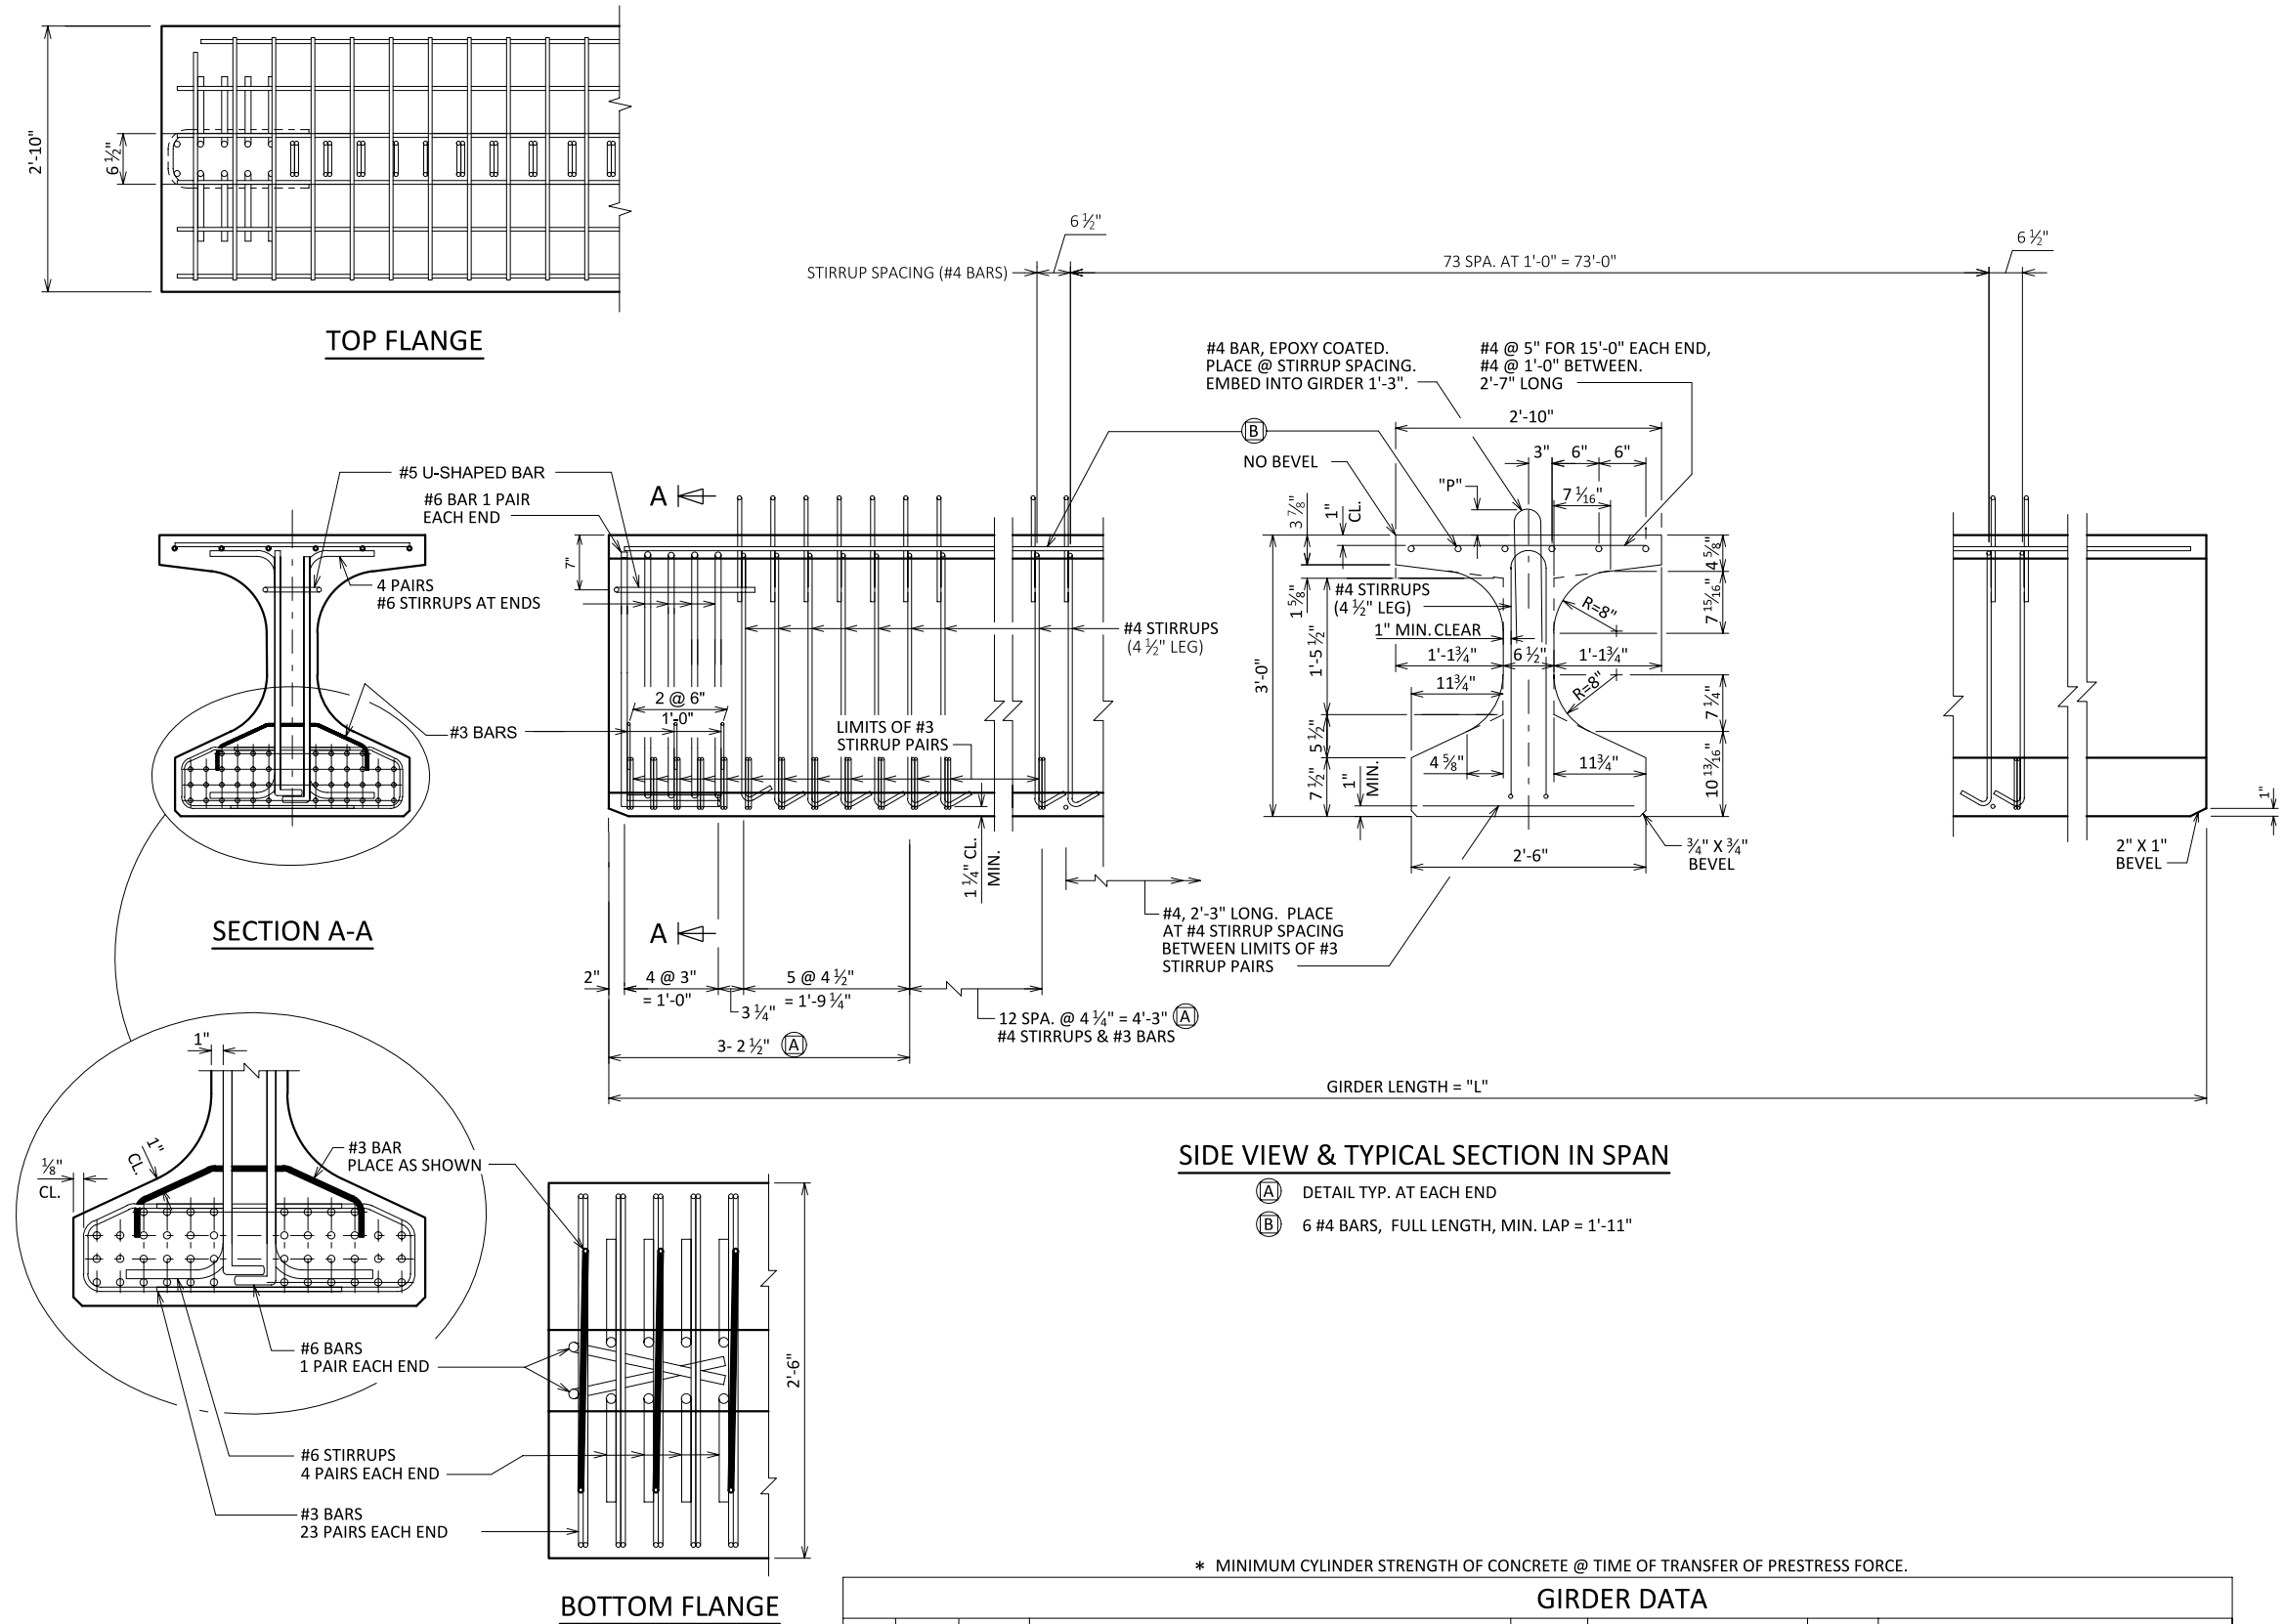

* MINIMUM CYLINDER STRENGTH OF CONCRETE @ TIME OF TRANSFER OF PRESTRESS FORCE.


GIRDER DATA																							
SPAN	GIRDER	GIRDER LENGTH "L" (FEET)	DEAD LOAD DEFL. (IN.)									CONC. STRGTH. f'c (P.S.I.)	"P" (IN.)			DIA. OF STRAND (IN.)	DRAPED PATTERN						
			1/10	2/10	3/10	4/10	5/10	6/10	7/10	8/10	9/10		1st 1/3 OF GIRDER	MID 1/3 OF GIRDER	END 1/3 OF GIRDER		TOTAL NO. OF STRANDS	f'ci (P.S.I.) *	(IN.)				
																			"A"	"B" MIN.	"B" MAX.	"C"	
1	1-5	89.00	0.6	1.1	1.6	1.8	1.9	1.8	1.6	1.1	0.6	8,000	7.75	6.25	7.75	0.6	36	6,800	31	11.5	14.5	5	

NO.	DATE	REVISION	BY
STATE OF WISCONSIN DEPARTMENT OF TRANSPORTATION			
STRUCTURE B-5-440			
DRAWN BY		PKF	PLANS CK'D. ETP
36W" PRESTRESSED GIRDER DETAILS 1			SHEET 8 OF 13
			44

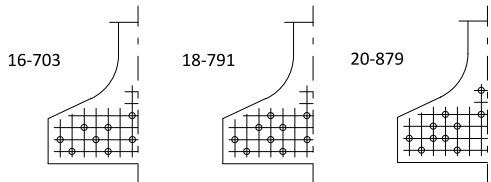


STANDARD ARRANGEMENTS TO RAISE CENTER OF GRAVITY
TO AVOID DRAPING OF STRANDS


0.6"Ø STRANDS

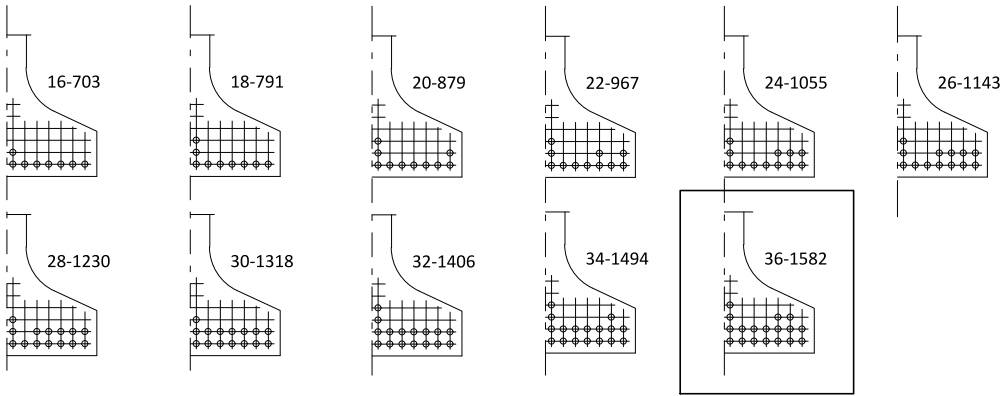

SPAN 1

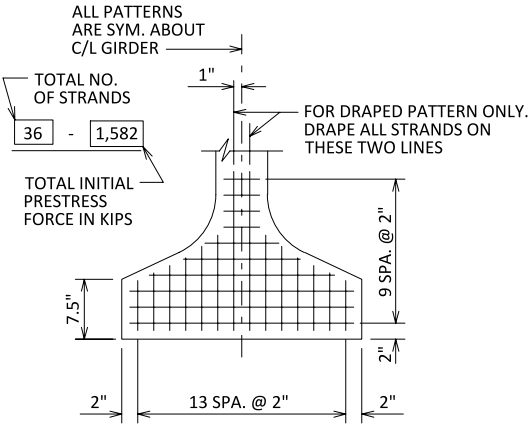

TYP. STRAND PATTERN

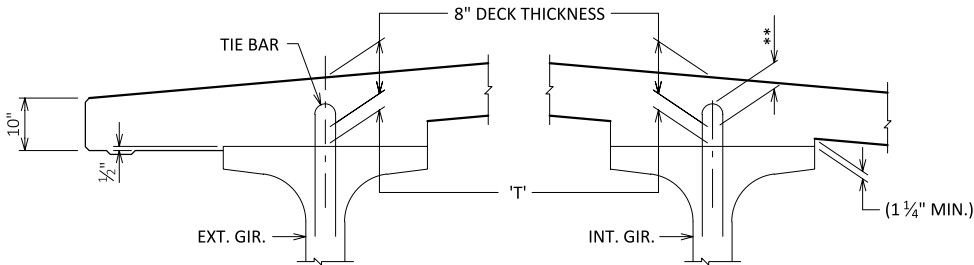


DECK HAUNCH DETAIL

IF 1 1/4" MINIMUM HAUNCH HEIGHT AT EDGE OF GIRDER CANNOT BE MAINTAINED, THE GRADE LINE MAY BE REVISED BY THE ENGINEER AT THE OPTION OF THE CONTRACTOR, THE PLAN DECK THICKNESS SHALL BE HELD. NOTIFY THE STRUCTURES SECTION IF THE GRADE LINE IS RAISED FROM THE PLAN PROFILE BY MORE THAN " OR, ** IF 3" MINIMUM DECK EMBEDMENT OF TIE BAR CANNOT BE OBTAINED.

TO DETERMINE 'T', ELEV. OF TOP OF GIR'S. AT C/L OF SUBSTRUCTURE UNITS & AT 1/10 POINTS OF EACH SPAN SHALL BE TAKEN. THEN FOLLOW THIS PROCESS:

TOP OF DECK ELEV. AT FINAL GRADE
- TOP OF GIRDER ELEVATION
+ DEAD LOAD DEFLECTION
- DECK THICKNESS
= HAUNCH HEIGHT 'T'


NOTE: AN AVERAGE HAUNCH ('T') OF 3 5/8" WAS USED IN THE QUANTITY "CONCRETE MASONRY BRIDGES".

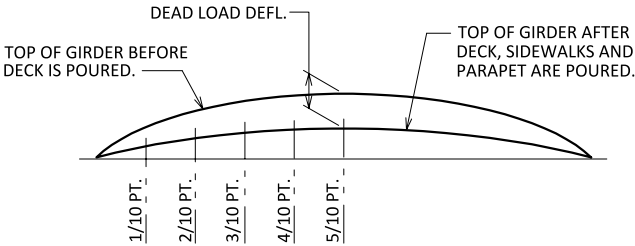

DEAD LOAD DEFLECTION DIAGRAM

ARRANGEMENT AT C/L SPAN - FOR GIRDERS WITH DRAPED STRANDS

0.6"Ø STRANDS

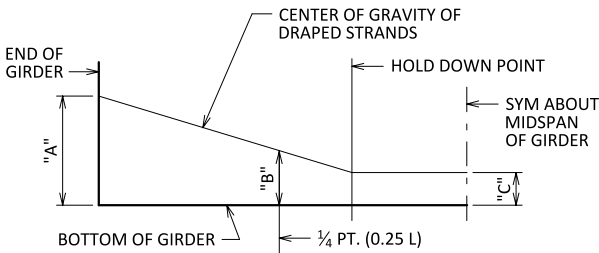

DRAPED STRAND PROFILE

* THE THEORETICAL INITIAL CAMBER VALUE AT THE TIME OF STRAND RELEASE AT MIDSPAN MULTIPLIED BY A FACTOR OF 1.4 TO ACCOUNT FOR CAMBER GROWTH FROM THE TIME OF STRAND RELEASE TO JOBSITE PLACEMENT.

SPAN	CAMBER (IN.) *
1	4 1/8"

THESE VALUES ARE NOT TO BE USED IN DETERMINING 'T', USE ACTUAL GIRDER SHOTS.
THESE VALUES ARE FOR INFORMATIONAL PURPOSES ONLY.

NO.	DATE	REVISION	BY
STATE OF WISCONSIN DEPARTMENT OF TRANSPORTATION			
STRUCTURE B-5-440			
		DRAWN BY PKF	PLANS CK'D. ETP
36W" PRESTRESSED GIRDER DETAILS 2		SHEET 9 OF 13	
		45	

NOTES


ALL DIAPHRAGM MATERIAL NOT EMBEDDED IN THE CONCRETE GIRDER SHALL BE PAID FOR AT THE UNIT PRICE BID FOR "STEEL DIAPHRAGMS B-5-440", EACH.

EACH DIAPHRAGM BETWEEN GIRDERS SHALL CONSTITUTE ONE UNIT.



ALL DIAPHRAGM STRUCTURAL STEEL SHALL BE ASTM A709 GRADE 36.

ALL DIAPHRAGM MATERIAL INCLUDING BOLTS, NUTS AND WASHERS SHALL BE GALVANIZED AFTER FABRICATION.


STEEL DIAPHRAGM TO CONCRETE WEB CONNECTION SHALL BE SNUG-TIGHT PLUS , TURN, UNLESS NOTED OTHERWISE. HIGH STRENGTH BOLTS FOR WEB CONNECTION SHALL MEET THE REQUIREMENTS FOR ASTM A325 OR ASTM A449.

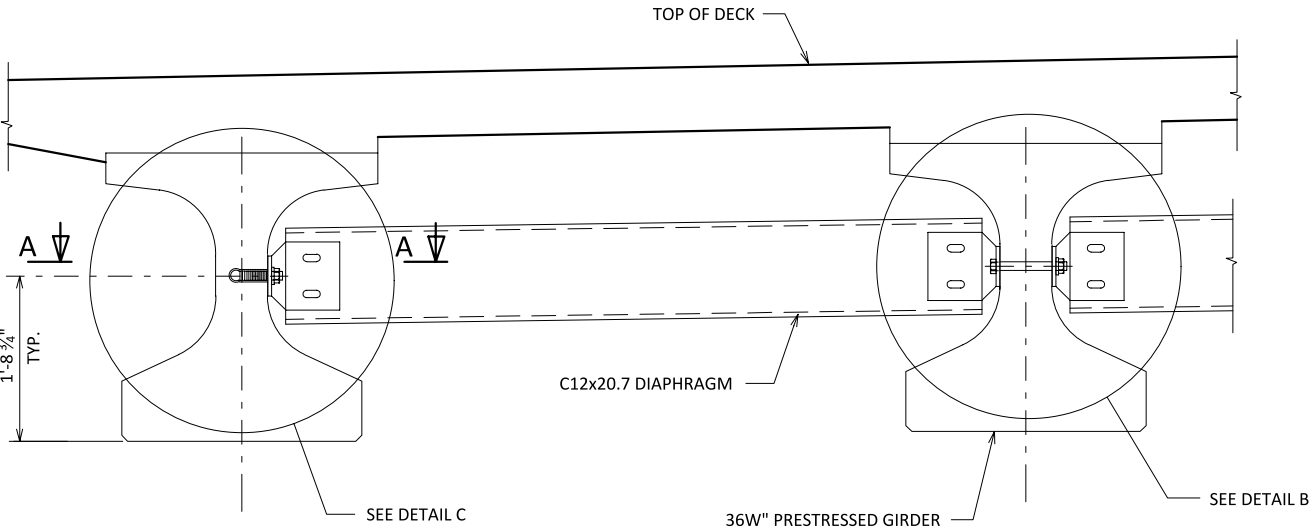



PART TRANSVERSE SECTION AT DIAPHRAGM

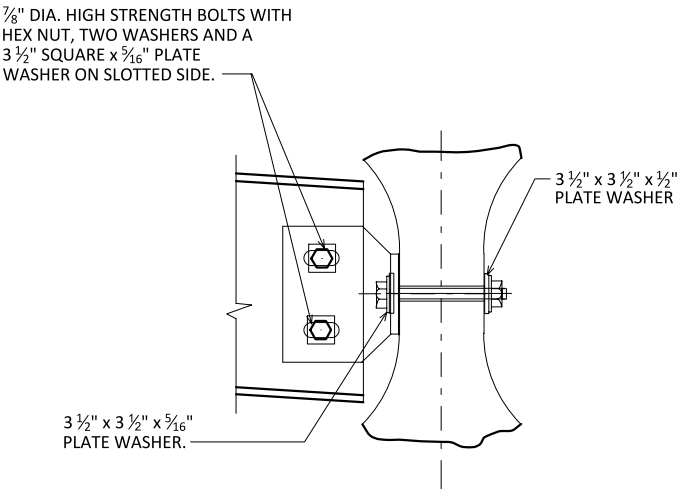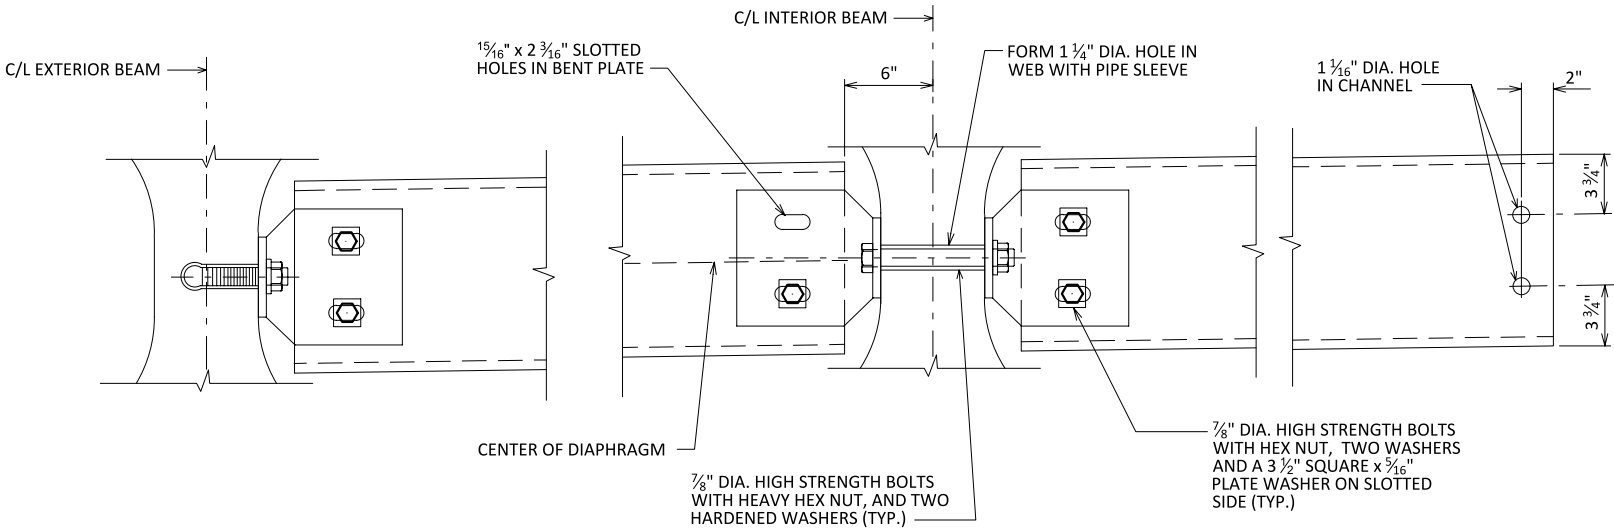


SECTION AT INTERIOR GIRDERS THRU DIAPHRAGM FOR SKEW ANGLES > 10°

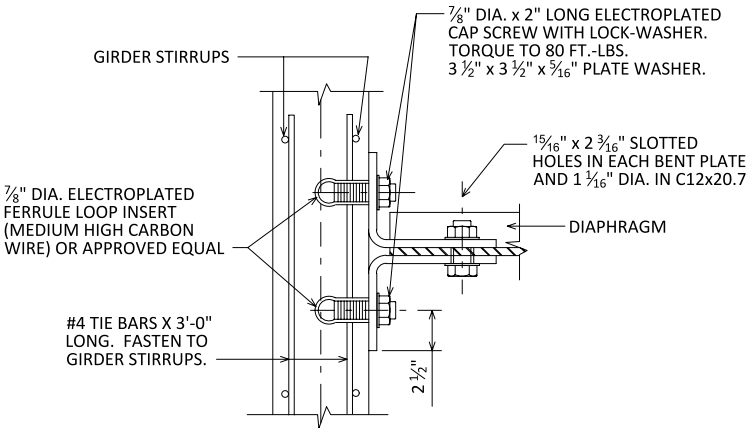

SECTION A-A
(FOR EXTERIOR ATTACHMENT)

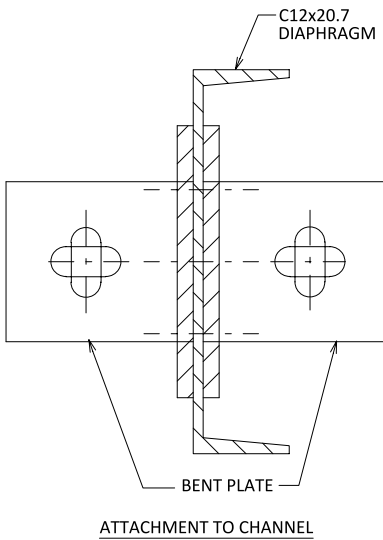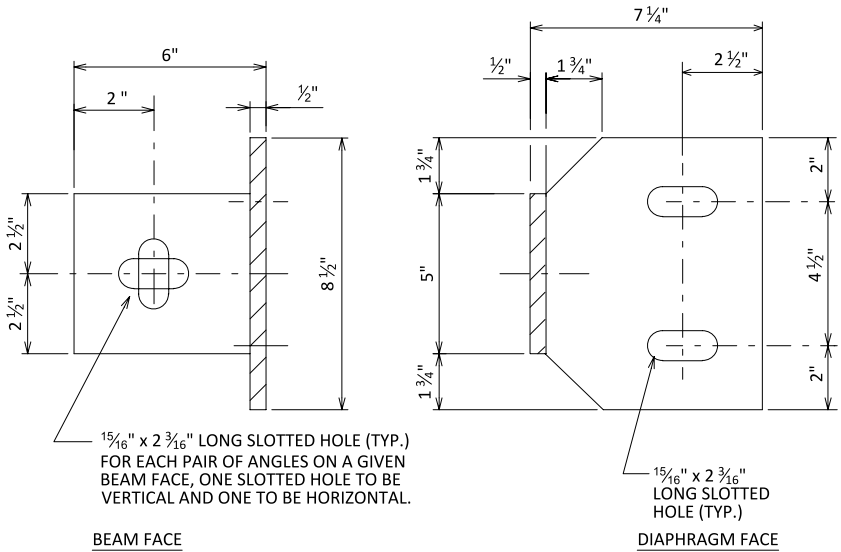

NO.	DATE	REVISION	BY
STATE OF WISCONSIN DEPARTMENT OF TRANSPORTATION			
STRUCTURE B-5-440			
DRAWN BY PKF		PLANS CK'D. ETP	
STEEL DIAPHRAGM		SHEET 10 OF 13	
		46	

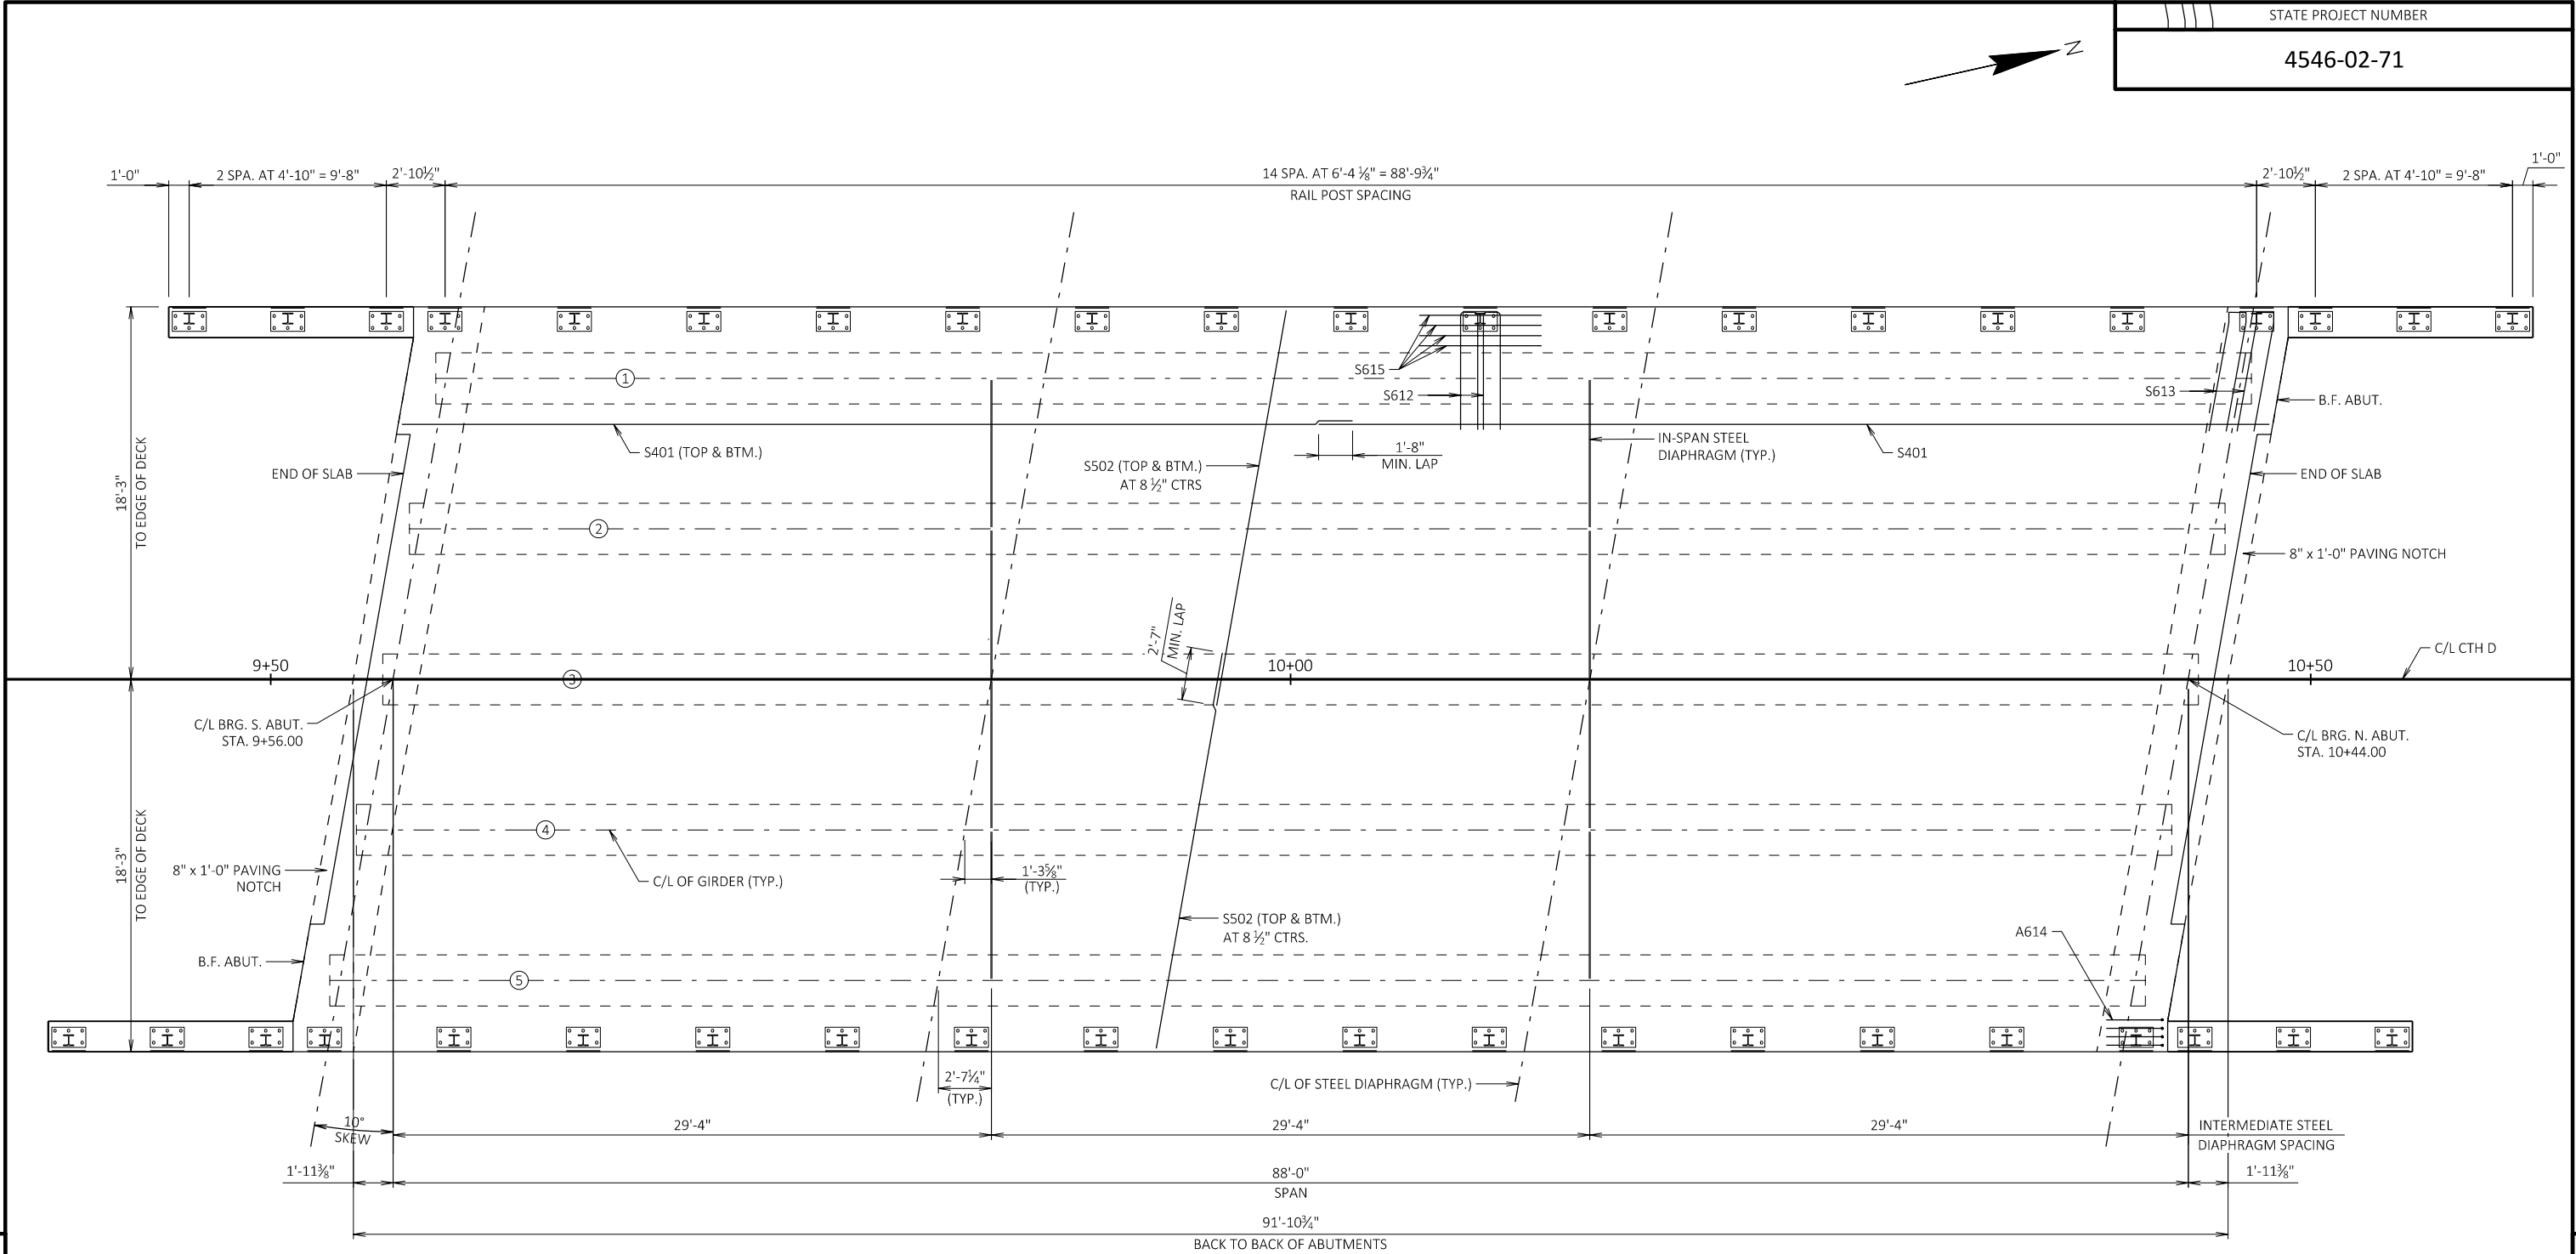

PLAN

TOP OF DECK ELEVATIONS

	C/L BRG. S. ABUT.	1/10	2/10	3/10	4/10	5/10	6/10	7/10	8/10	9/10	C/L BRG. N. ABUT.
GIRDER 1	632.29	632.15	632.03	631.91	631.81	631.71	631.61	631.51	631.41	631.31	631.21
GIRDER 2	632.45	632.32	632.20	632.08	631.97	631.87	631.77	631.67	631.57	631.47	631.38
GIRDER 3	632.62	632.49	632.36	632.24	632.13	632.03	631.93	631.83	631.73	631.64	631.54
GIRDER 4	632.50	632.36	632.23	632.11	632.00	631.90	631.80	631.70	631.60	631.50	631.40
GIRDER 5	632.37	632.23	632.10	631.98	631.87	631.76	631.67	631.57	631.47	631.37	631.27

NOTES

1. THE TOP LONGITUDINAL BAR STEEL REINFORCEMENT SHALL BE SUPPORTED BY CONTINUOUS BAR CHAIRS IN TRANSVERSE DIRECTION ON 4'-0" CENTERS.
2. THE BOTTOM TRANSVERSE BAR STEEL REINFORCEMENT SHALL BE CONTINUOUS BAR CHAIRS WITH A CENTER TO CENTER SPACING NOT TO EXCEED 4'-0". ONE LINE OF CONTINUOUS BAR CHAIRS SHALL BE PLACED NEAR EACH EDGE OF SLAB TO SUPPORT THE ENDS OF THE BOTTOM TRANSVERSE BAR STEEL.
3. ALL TRANSVERSE BAR STEEL REINFORCEMENT SHALL BE PLACED PARALLEL TO SUBSTRUCTURE UNITS.

NO.

DATE

REVISION

BY

STATE OF WISCONSIN
DEPARTMENT OF TRANSPORTATION

STRUCTURE B-5-440

DRAWN BY

PKF

PLANS CK'D.



ETP

SUPERSTRUCTURE

SHEET 11 OF 13

47



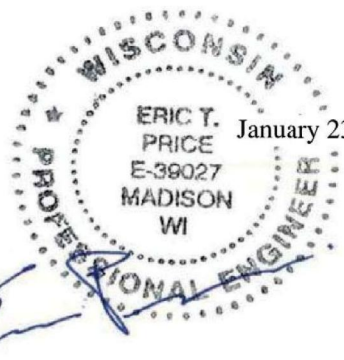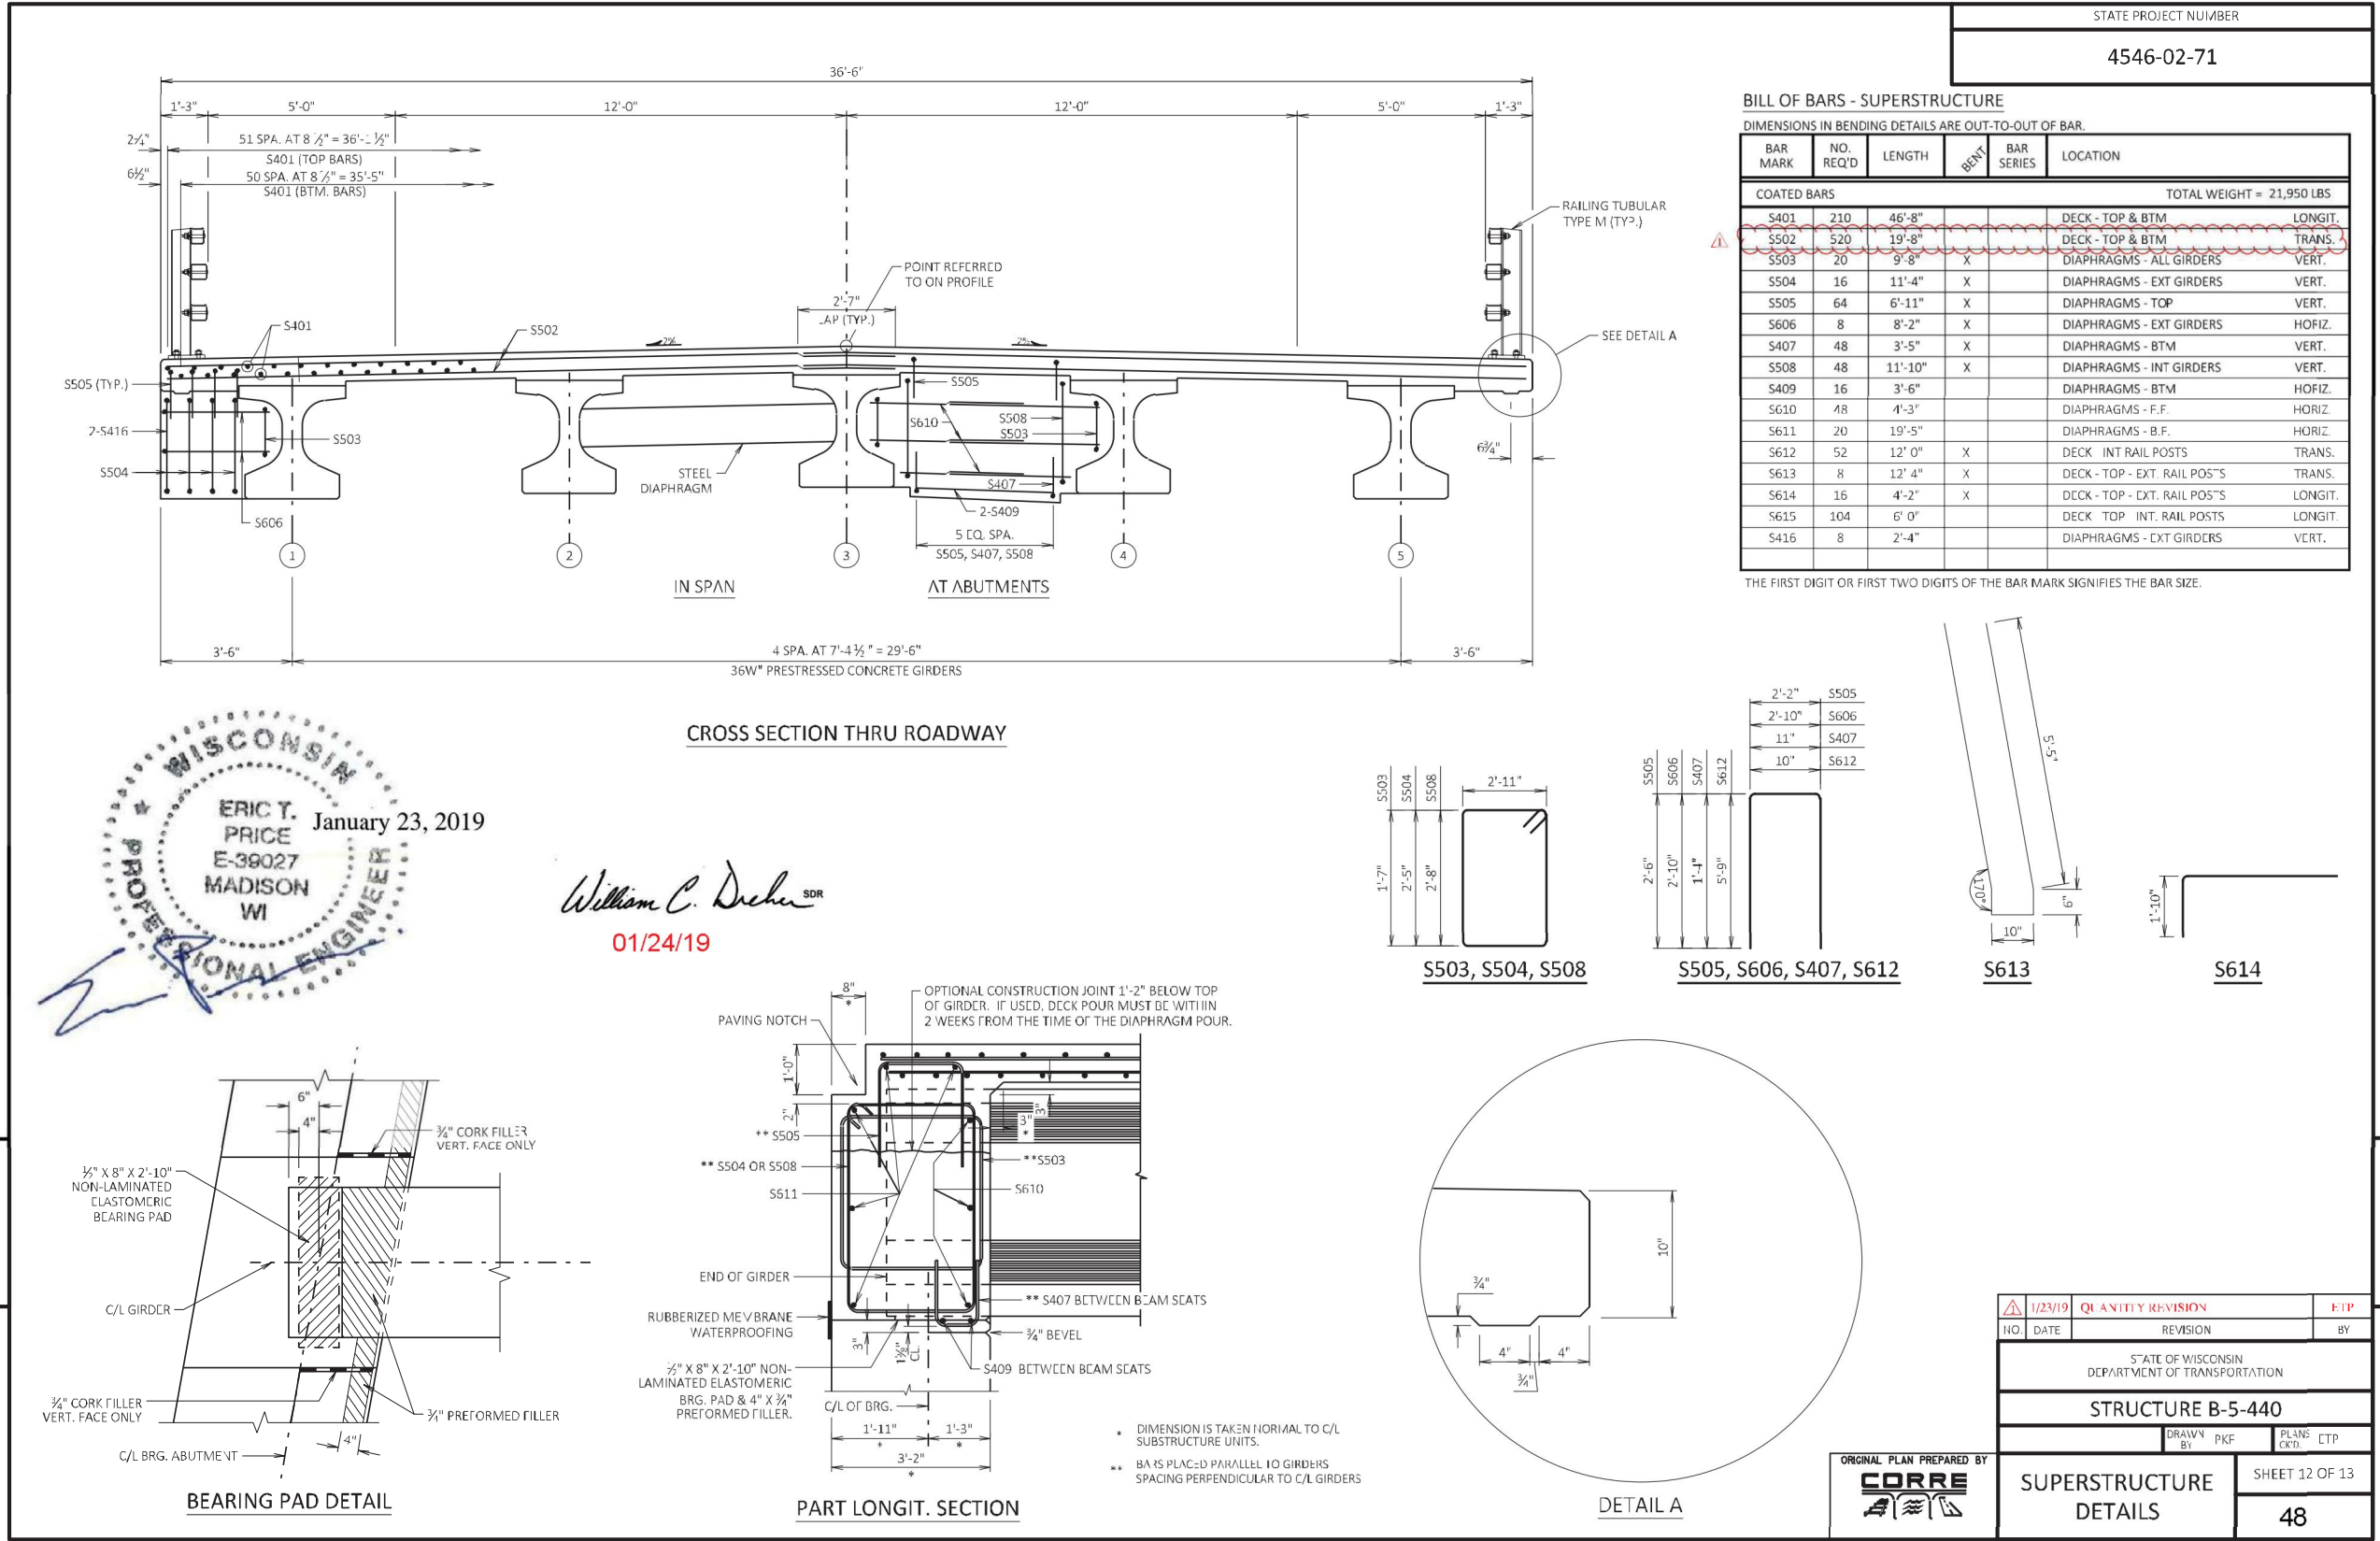

January 23, 2019

William C. Dreher SDR


01/24/19

8


8

 1/23/19		QUANTITY REVISION		FTP			
NO.	DATE	REVISION			BY		
STATE OF WISCONSIN DEPARTMENT OF TRANSPORTATION							
STRUCTURE B-5-440							
		DRAWN BY		PKF	PLANS CTD		
SUPERSTRUCTURE DETAILS		SHEET 12 OF 13					
		48					




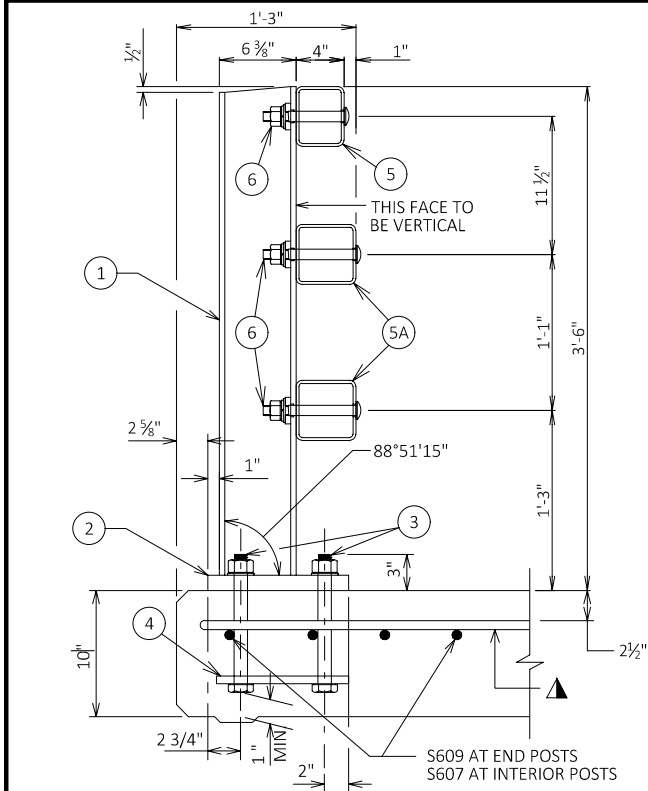


SECTION THRU RAILING ON DECK

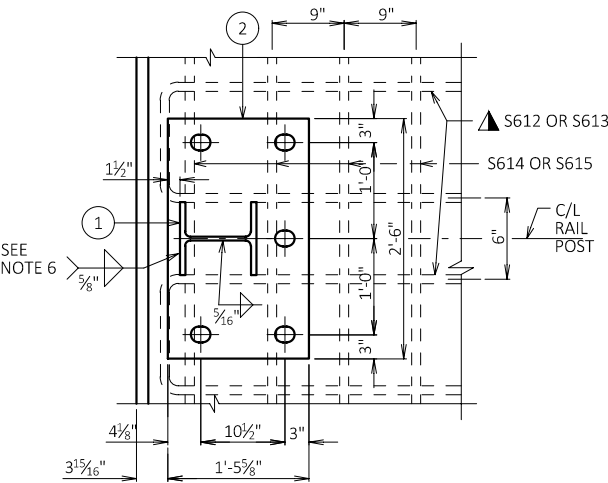


SECTION A-A

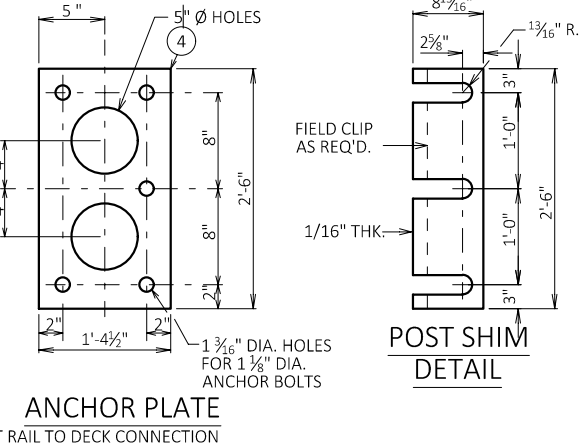


POST SHIM DETAIL

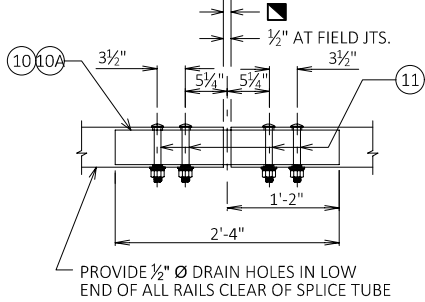


FIELD ERECTION JOINT DETAIL

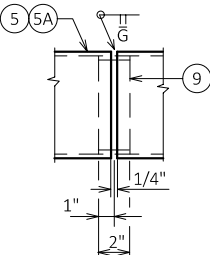


SHOP RAIL SPLICE DETAIL
LOCATION MUST BE SHOWN ON SHOP DRAWINGS

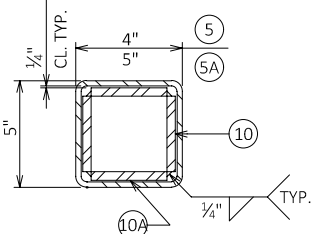


SECTION B-B

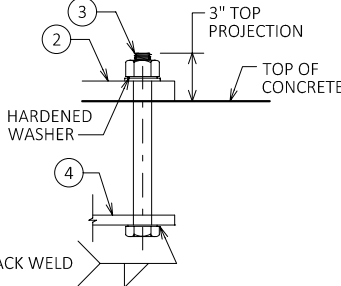

ANCHOR BOLTS

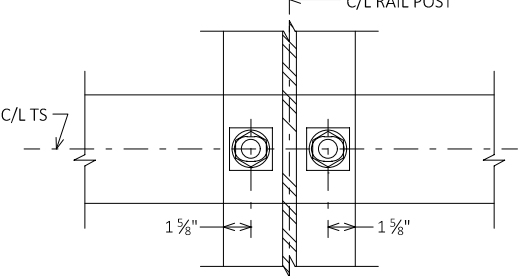


SECTION THRU POST WEB

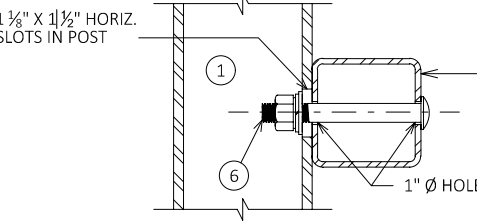


SECTION THRU RAIL


TYPICAL RAIL TO POST CONNECTIONS
NOTE: CONNECTIONS AT LOWER RAILS SHOWN. CONNECTIONS AT TOP RAIL SIMILAR.

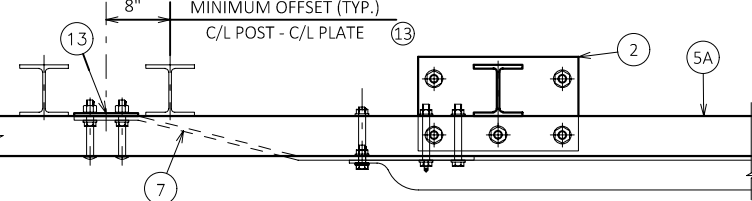


TOP VIEW AT END POST
THRIE BEAM RAIL ATTACHMENT

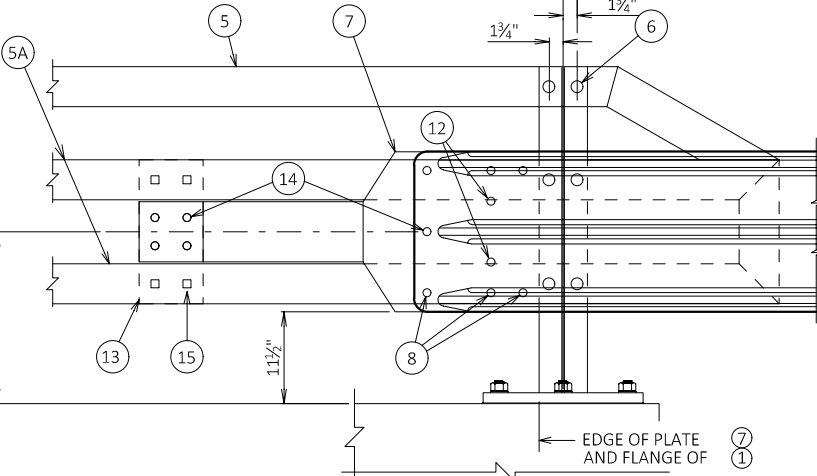


DETAIL AT END POST
THRIE BEAM RAIL ATTACHMENT

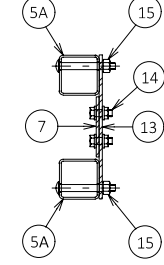


SECTION C-C

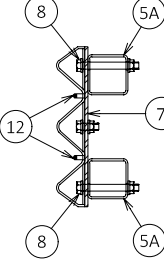


SECTION D-D

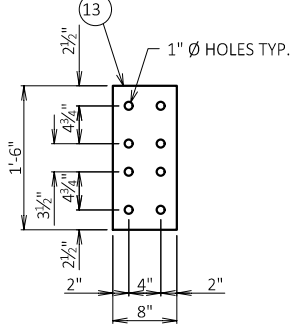

ANCHOR PLATE
AT BEAM GUARD ATTACHMENT

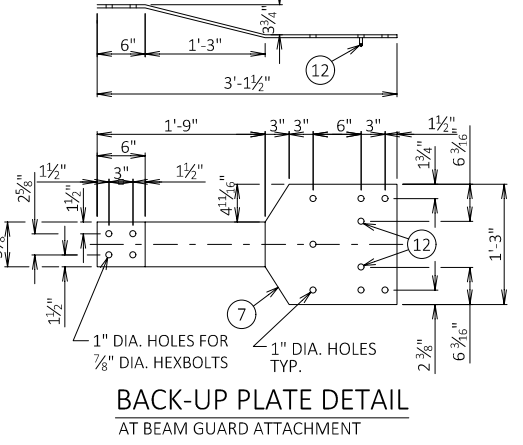

BACK-UP PLATE DETAIL
AT BEAM GUARD ATTACHMENT

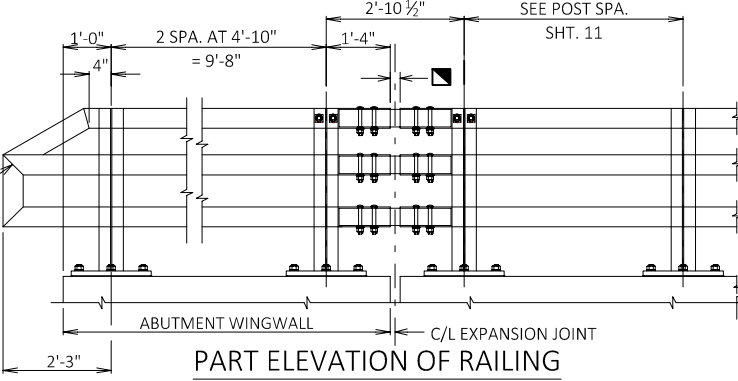

PART ELEVATION OF RAILING

LEGEND

- 1 W6 X 25 WITH 1 1/8" X 1 1/2" HORIZ. SLOTS ON EACH SIDE OF POST FOR BOLT NO. 6. CUT BOTTOM OF POST TO MATCH CROSS SLOPE OF ROADWAY. PLACE POST VERTICAL. PLACE POSTS NORMAL TO GRADE LINE.
- 2 PLATE 1 1/4" X 11 3/4" X 1'-8" WITH 1 5/16" X 1 5/8" SLOTTED HOLES FOR ANCHOR BOLTS NO. 3. WELD TO NO. 1 AS SHOWN. SLOTS PARALLEL TO SHORT SIDE OF
- 3 PLATE. ASTM A449 - 1 1/2" DIA. ANCHOR BOLTS WITH NUT AND HARDENED WASHER (ALL GALVANIZED). 5 REQ'D. PER POST. THREAD 3" AND PLACE NORMAL TO PLATE NO. 2. CHAMFER TOP OF BOLTS BEFORE THREADING. USE 1'-9" LONG IN ABUTMENT WINGS. AT POSTS ON CONCRETE SLAB SUPERSTRUCTURES WHERE THE SLAB THICKNESS IS > 16" USE 1'-3" LONG. USE 10 3/4" LONG AT ALL OTHER LOCATIONS. (AN EQUIVALENT THREADED ROD WITH NUTS AND HARDENED WASHERS MAY BE SUBSTITUTED FOR ANCHOR BOLTS IN WINGS IF REQ'D. FOR CONSTRUCTIBILITY.)
- 4 5/8" X 11" X 1'-8" ANCHOR PLATE (GALVANIZED) WITH 1 3/16" DIA. HOLES FOR ANCHOR BOLTS NO. 3
- 5 TS 5 X 4 X 0.25 STRUCTURAL TUBING. ATTACH TO NO. 1 WITH NO. 6.
- 5A TS 5 X 5 X 0.25 STRUCTURAL TUBING. ATTACH TO NO. 1 WITH NO. 6.
- 6 7/8" DIA. A325 SLOTTED ROUND HEAD BOLT WITH NUT, 3/16" X 1 5/8" X 1 5/8" WASHER, AND LOCK WASHER (2 REQ'D. AT EACH RAIL TO POST LOCATION.)
- 7 1/2" THK. BACK-UP PLATE WITH 2 - 7/8" X 1 1/2" THREADED SHOP WELDED STUDS (NO. 12). BOLT TO RAIL AS SHOWN IN DETAIL. REQUIRED AT THRIE BEAM GUARD RAIL ATTACHMENTS ONLY. PLACE SYMMETRICALLY ABOUT TUBES NO. 5A.
- 8 1" DIA. HOLES IN PLATE NO. 7 & TUBES NO. 5A FOR 7/8" DIA. A325 BOLTS WITH HEX NUTS AND WASHERS. 6 HOLES IN TUBES AND PLATE NO. 7.
- 9 SPLICE SLEEVE FABRICATED FROM 1/4" PLATE. PROVIDE "SLIDING FIT".
- 10 3/8" X 3 5/8" X 2'-4" PLATE. 2 PER RAIL. USED IN NO. 5 & 5A.
- 10A 3/8" X 2 5/8" X 2'-4" PLATE USED IN NO. 5, 3/8" X 3 5/8" X 2'-4" PLATE USED IN NO. 5A. 2 PER RAIL.
- 11 7/8" DIA. A325 ROUND HEAD BOLT WITH NUT, WASHER, AND LOCK WASHER. USE 1 5/16" X 1 1/4" LONGIT. SLOTTED HOLES AT FIELD JOINTS AND 1 9/16" X 2 1/2" MIN. LONGIT. SLOTTED HOLES AT EXP. JOINTS IN PLATE NO. 10A.
- 12 7/8" DIA. X 1 1/2" LONG THREADED SHOP WELDED STUDS (2 REQ'D.).
- 13 3/8" X 8" X 1'-6" PLATE. BOLT TO RAIL AS SHOWN IN DETAIL. REQ'D. AT THRIE BEAM GUARD RAIL ATTACHMENTS ONLY. PLACE SYM. ABOUT TUBES NO. 5A.
- 14 7/8" DIA. X 2" LONG A325 HEX BOLT WITH NUT AND WASHER (5 REQ'D.).
- 15 1" DIA. HOLES IN TUBES NO. 5A FOR 1" DIA. A325 ROUND HEAD BOLT WITH NUT, WASHER, AND LOCK WASHER (4 REQ'D.). 4 HOLES IN TUBES.


GENERAL NOTES


1. BID ITEM SHALL BE "RAILING TUBULAR TYPE M" WHICH INCLUDES ALL ITEMS SHOWN.
2. RAIL POST AND BASE PLATES SHALL CONFORM TO THE REQUIREMENTS OF ASTM A709 GRADE 50. HOLLOW RAILING STRUCTURAL TUBING SHALL CONFORM TO THE REQUIREMENTS OF ASTM A500 GRADE B OR C WITH A CERTIFIED FY = 50 KSI. ANCHOR PLATES, AND SPLICE TUBE PLATES SHALL CONFORM TO THE REQUIREMENTS OF ASTM A709 GRADE 36.
3. THE NUT SECURING THE POST BASE PLATE TO THE CONCRETE SHALL BE TIGHTENED TO A SNUG FIT AND GIVEN AN ADDITIONAL 1/2 TURN.
4. RAILS SHALL BE CONTINUOUS OVER A MINIMUM OF THREE (3) POSTS WITHOUT SPLICES WHERE POSSIBLE. RAILS SHALL BE SPLICED IN A PANEL OVER EXPANSION JOINTS.
5. ENDS OF TUBE SECTIONS SHALL BE SAWED. GRIND SMOOTH EXPOSED EDGES. ALL CUT ENDS SHALL BE TRUE AND SMOOTH.
6. WELD IS THE SAME ON BOTH FLANGES. FLANGE WELD DOES NOT REQUIRE MAGNETIC PARTICLE TESTING.
7. FILL BOLT SLOT OPENINGS IN POST SHIMS AND PLATE NO. 2 AND CAULK AROUND PERIMETER OF PLATE NO. 2 WITH NON-STAINING GRAY NON-BITUMINOUS JOINT SEALER. STEEL POST SHIMS MAY BE USED UNDER POSTS WHERE REQ'D. FOR ALIGNMENT.
8. POST BASE PLATES SHALL BE FLAT WITH ALL SURFACES SMOOTH AND FREE FROM WARP AND ALL EDGES SMOOTH, STRAIGHT AND VERTICAL. ALL PLATE CUTS SHALL BE MACHINE OR MACHINE FLAME CUT.
9. ALL MATERIAL SHALL BE GALVANIZED AFTER FABRICATION. PRIOR TO GALVANIZING, ALL STEEL RAILING POSTS & STEEL TUBING SHALL BE GIVEN A NO. 6 BLAST CLEANING BY SSPC SPECIFICATIONS.


- ▲ TIE TO TOP MAT OF STEEL.
- * FOR ANCHOR BOLTS IN WINGS, TACK WELD MAY BE USED IN FIELD AFTER ANCHOR PLATE IS IN POSITION IF REQ'D. FOR CONSTRUCTIBILITY.
- RDWY. OPENING OR 2" MIN. FOR STRIP SEAL EXP. JOINT & " OPENING FOR A1 ABUTMENT.


STATE PROJECT NUMBER			
4546-02-71			
NO.	DATE	REVISION	BY
STATE OF WISCONSIN DEPARTMENT OF TRANSPORTATION			
STRUCTURE B-5-440			
DRAWN BY		PKF	PLANS CK'D. ETP
RAILING TUBULAR TYPE M			SHEET 13 OF 13
			49

STATION	Distance	AREA (SF)			Incremental Vol (CY) (Unadjusted)			Cumulative Vol (CY)		Mass Ordinate
		Cut	Salvaged/Unusable Pavement Material	Fill	Cut	Salvaged/Unusable Pavement Material	Fill	Cut 1.00	Expanded Fill 1.30	
6+25 LT	0.00	0.00	0.00	0.00	0	0	0	0	0	0
6+50 LT	25.00	4.27	0.00	95.34	2	0	44	2	57	-55
6+76 LT	26.00	2.72	0.00	83.29	3	0	86	5	169	-164
7+00 LT	24.00	2.92	0.00	106.50	3	0	84	8	279	-271
7+50 LT	50.00	3.57	0.00	104.73	6	0	196	14	533	-519
7+68 LT	18.00	3.73	0.00	90.98	2	0	65	16	618	-602
7+92 LT	24.00	3.76	0.00	67.38	3	0	70	20	709	-690
8+00 LT	8.00	3.70	0.00	66.21	1	0	20	21	735	-714
SUBTOTAL =					21	0	565			
6+00 RT	0.00	0.00	0.00	0.00	0	0	0	0	0	0
6+29 RT	29.00	2.32	0.00	33.86	1	0	18	1	24	-22
6+50 RT	21.00	2.15	0.00	106.04	2	0	54	3	94	-91
7+00 RT	50.00	2.55	0.00	89.12	4	0	181	7	329	-322
7+49 RT	49.00	2.98	0.00	72.62	5	0	147	12	520	-508
7+50 RT	1.00	2.98	0.00	71.57	0	0	3	12	524	-511
7+74 RT	24.00	3.11	0.00	65.98	3	0	61	15	603	-588
7+99 RT	25.00	3.02	0.00	40.32	3	0	49	18	667	-649
8+00 RT	1.00	3.00	0.00	38.87	0	0	1	18	669	-651
SUBTOTAL =					18	0	515			
8+00	0.00	65.78	9.33	105.08	0	0	0	0	0	0
8+18	18.00	59.34	9.33	53.35	42	6	53	42	69	-33
8+50	32.00	47.80	9.33	20.50	63	11	44	105	126	-38
9+00	50.00	37.01	9.33	32.37	79	17	49	184	189	-40
9+39	39.00	34.14	9.33	49.52	51	13	59	235	266	-79
9+45	6.00	32.23	9.33	52.87	7	2	11	242	281	-88
SUBTOTAL =					242	50	216			
STRUCTURE B-5-440										
10+55	0.00	37.88	9.33	39.74	0	0	0	0	0	0
10+61	6.00	39.07	9.33	20.50	9	2	7	9	9	-2
11+00	39.00	45.51	9.33	32.37	61	13	38	70	58	-4
11+50	50.00	59.62	9.33	49.52	97	17	76	167	157	-23
11+65	15.00	62.86	9.33	52.87	34	5	28	201	194	-31
SUBTOTAL =					201	38	149			
11+65 LT	0.00	2.00	0.00	29.63	0	0	0	0	0	0
11+88 LT	23.00	1.97	0.00	30.55	2	0	26	2	33	-32
12+00 LT	12.00	1.76	0.00	42.92	1	0	16	3	55	-52
12+13 LT	13.00	3.84	0.00	22.96	1	0	16	4	75	-71
12+38 LT	25.00	4.26	0.00	0.82	4	0	11	8	89	-82
12+50 LT	12.00	3.88	0.00	5.62	2	0	1	9	91	-82
13+00 LT	50.00	1.61	0.00	18.85	5	0	23	15	121	-106
13+38 LT	38.00	3.80	0.00	3.71	4	0	16	18	141	-123
13+54 LT	16.00	0.00	0.00	0.00	1	0	1	19	143	-123
SUBTOTAL =					19	0	110			
11+65 RT	0.00	1.30	0.00	20.55	0	0	0	0	0	0
11+82 RT	20.00	1.31	0.00	24.91	1	0	17	1	22	-21
12+00 RT	15.00	1.30	0.00	40.36	1	0	18	2	45	-44
12+07 RT	7.00	1.32	0.00	40.42	0	0	10	2	59	-57
12+32 RT	25.00	1.31	0.00	38.89	1	0	37	3	107	-104
12+50 RT	18.00	1.30	0.00	31.93	1	0	24	4	137	-133
13+00 RT	50.00	1.39	0.00	9.72	2	0	39	7	188	-181
13+38 RT	38.00	27.17	0.00	0.00	20	0	7	27	197	-170
13+54 RT	16.00	0.00	0.00	0.00	8	0	0	35	197	-162
SUBTOTAL =					35	0	151			
TOTAL =					537	88	1,706			

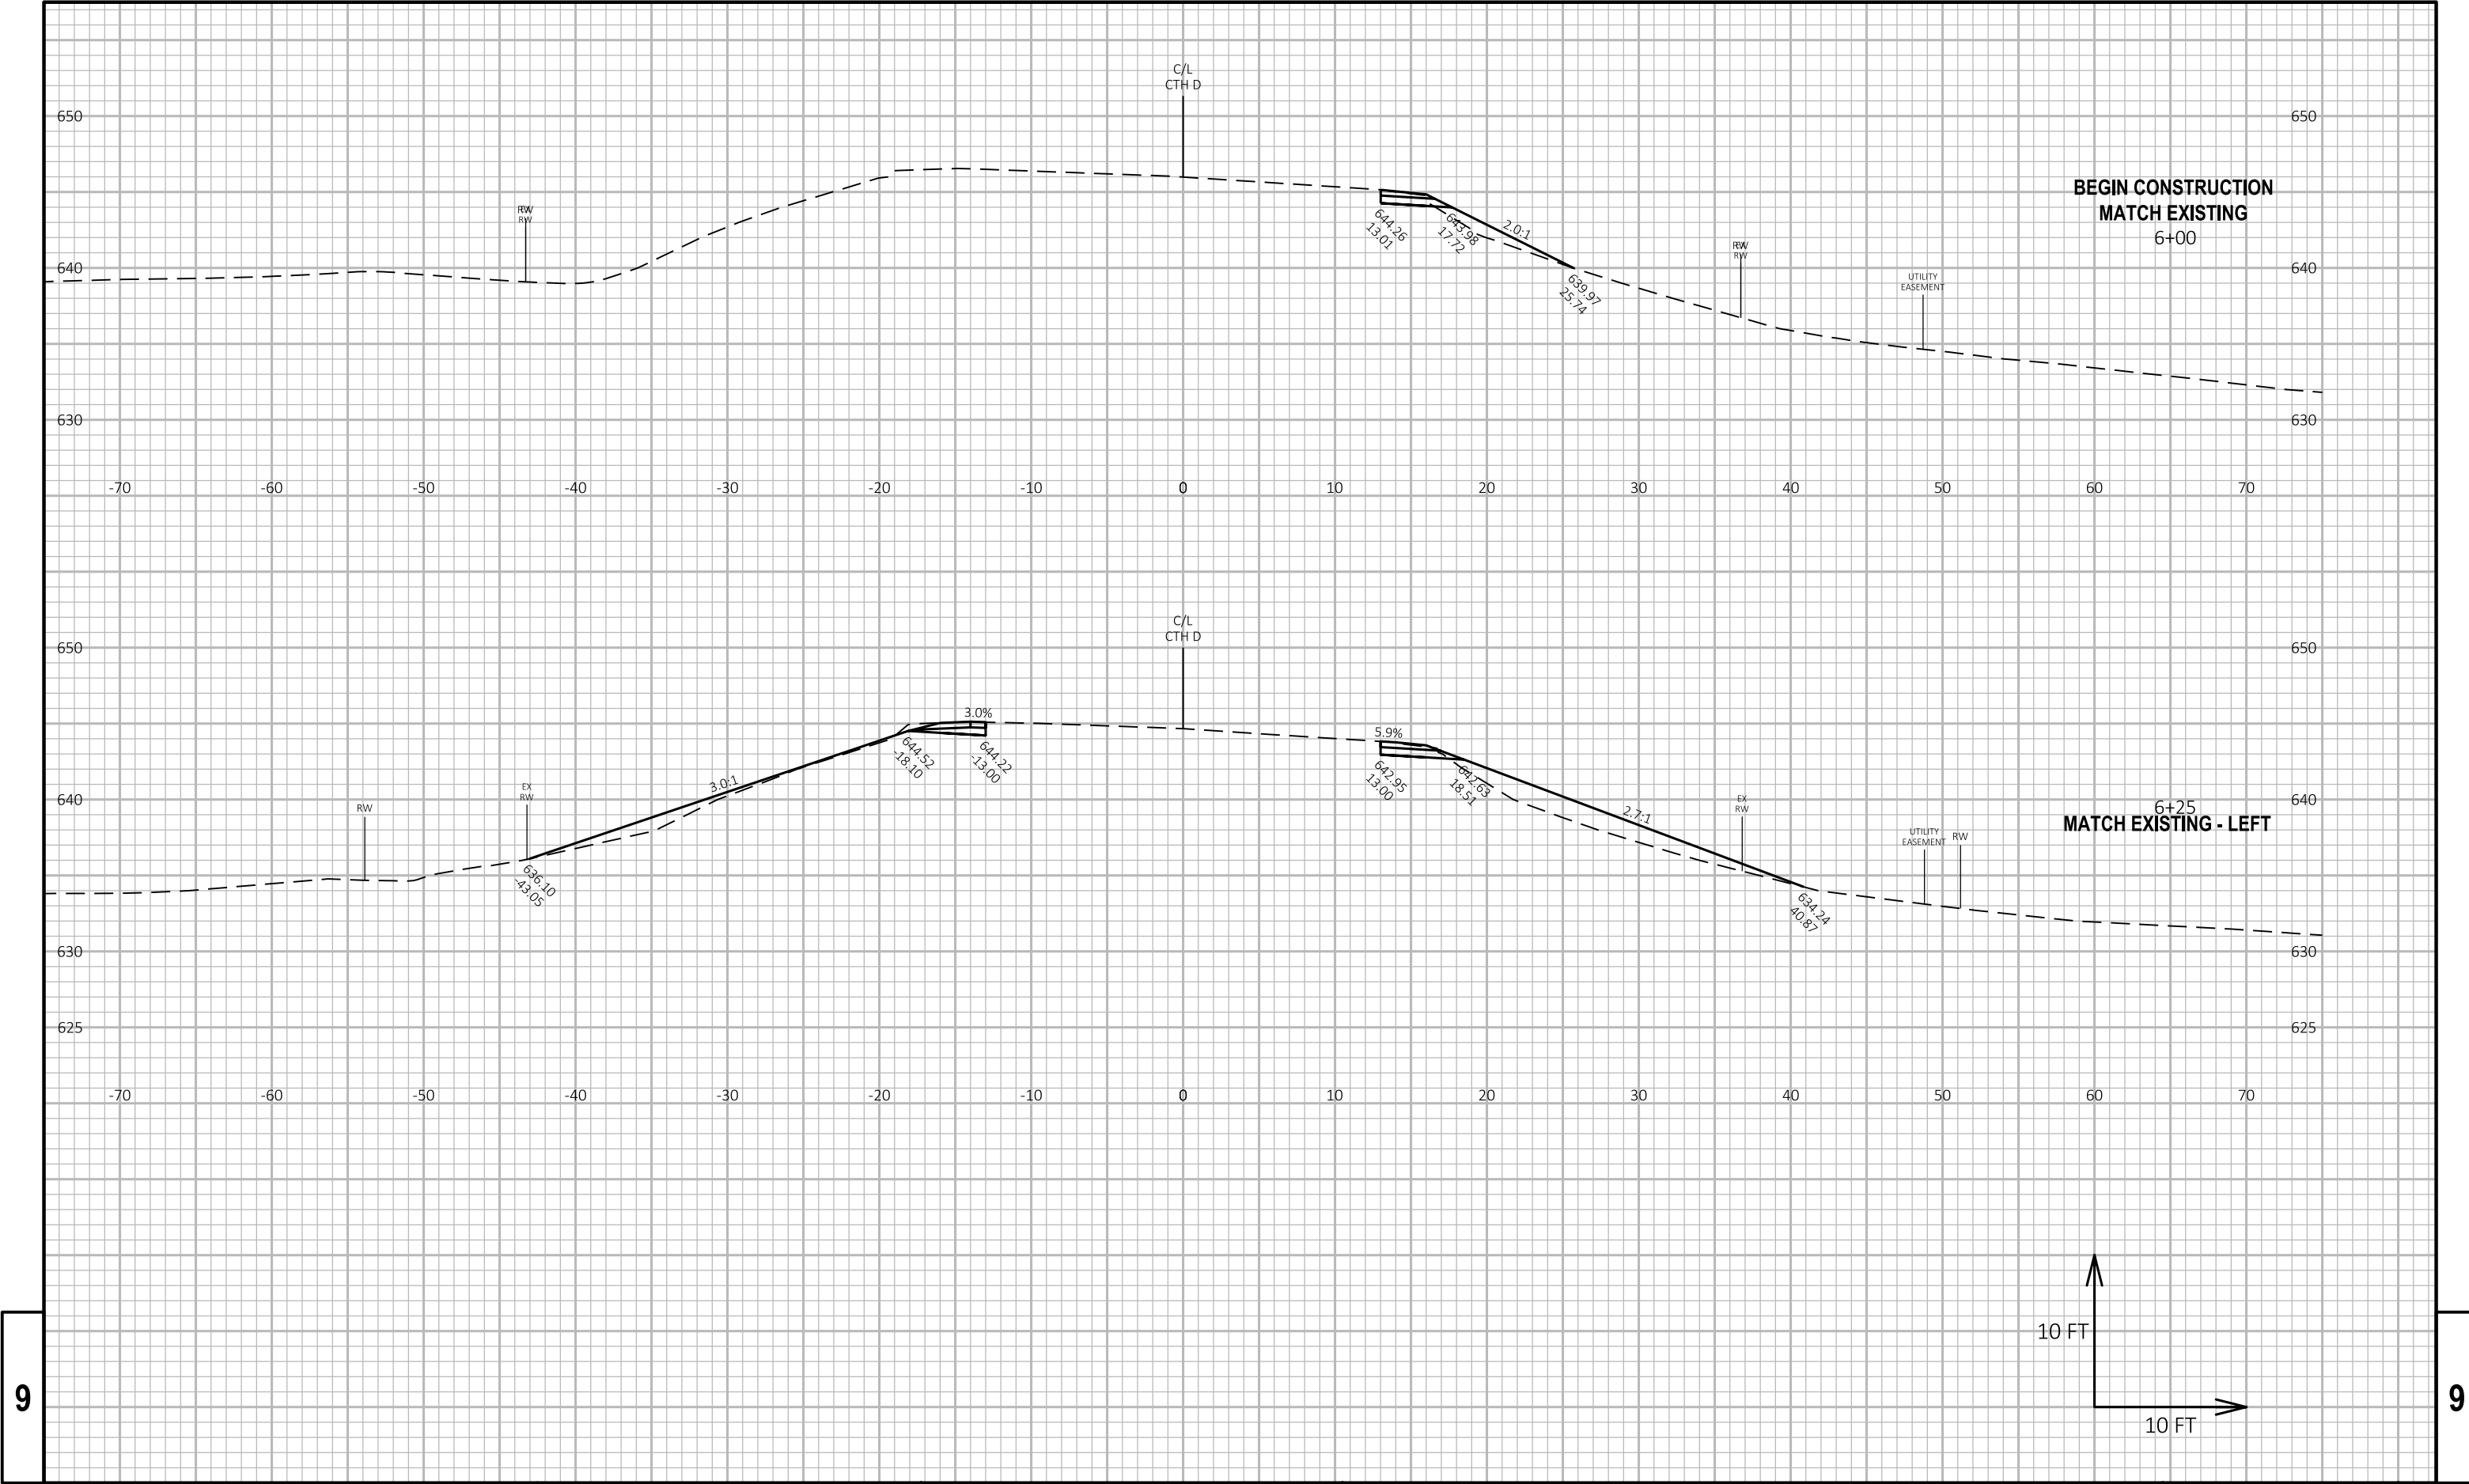

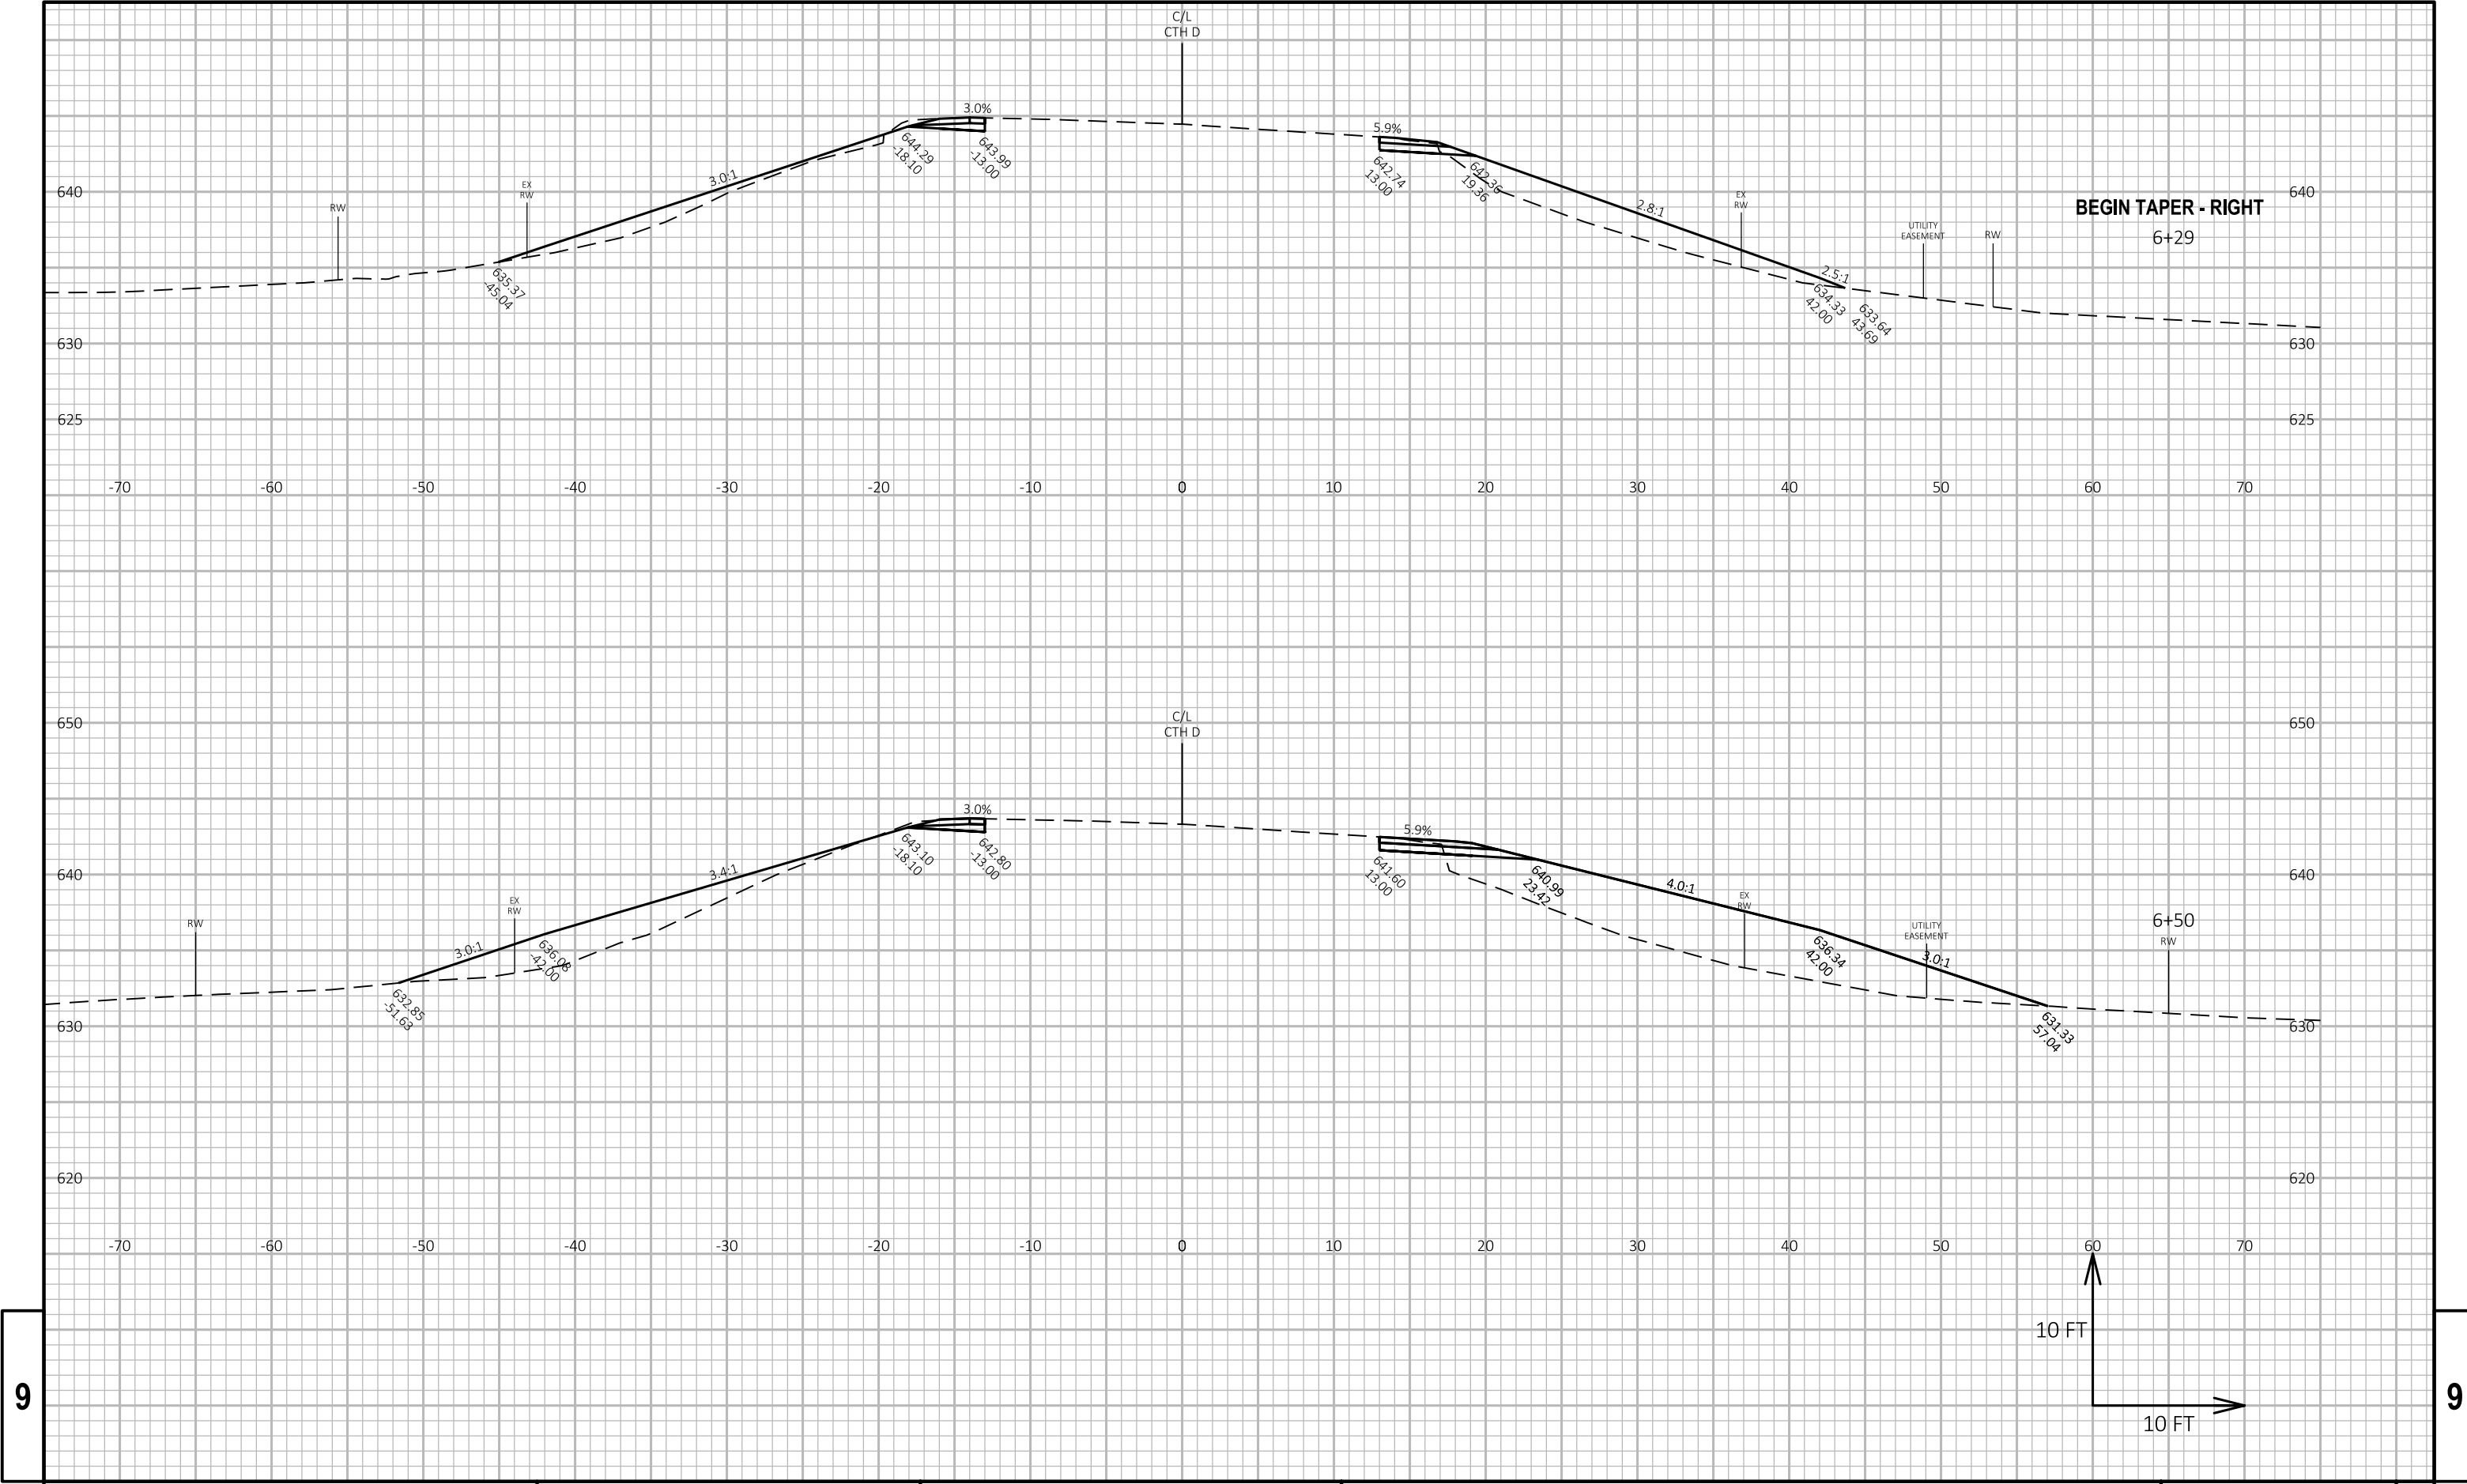

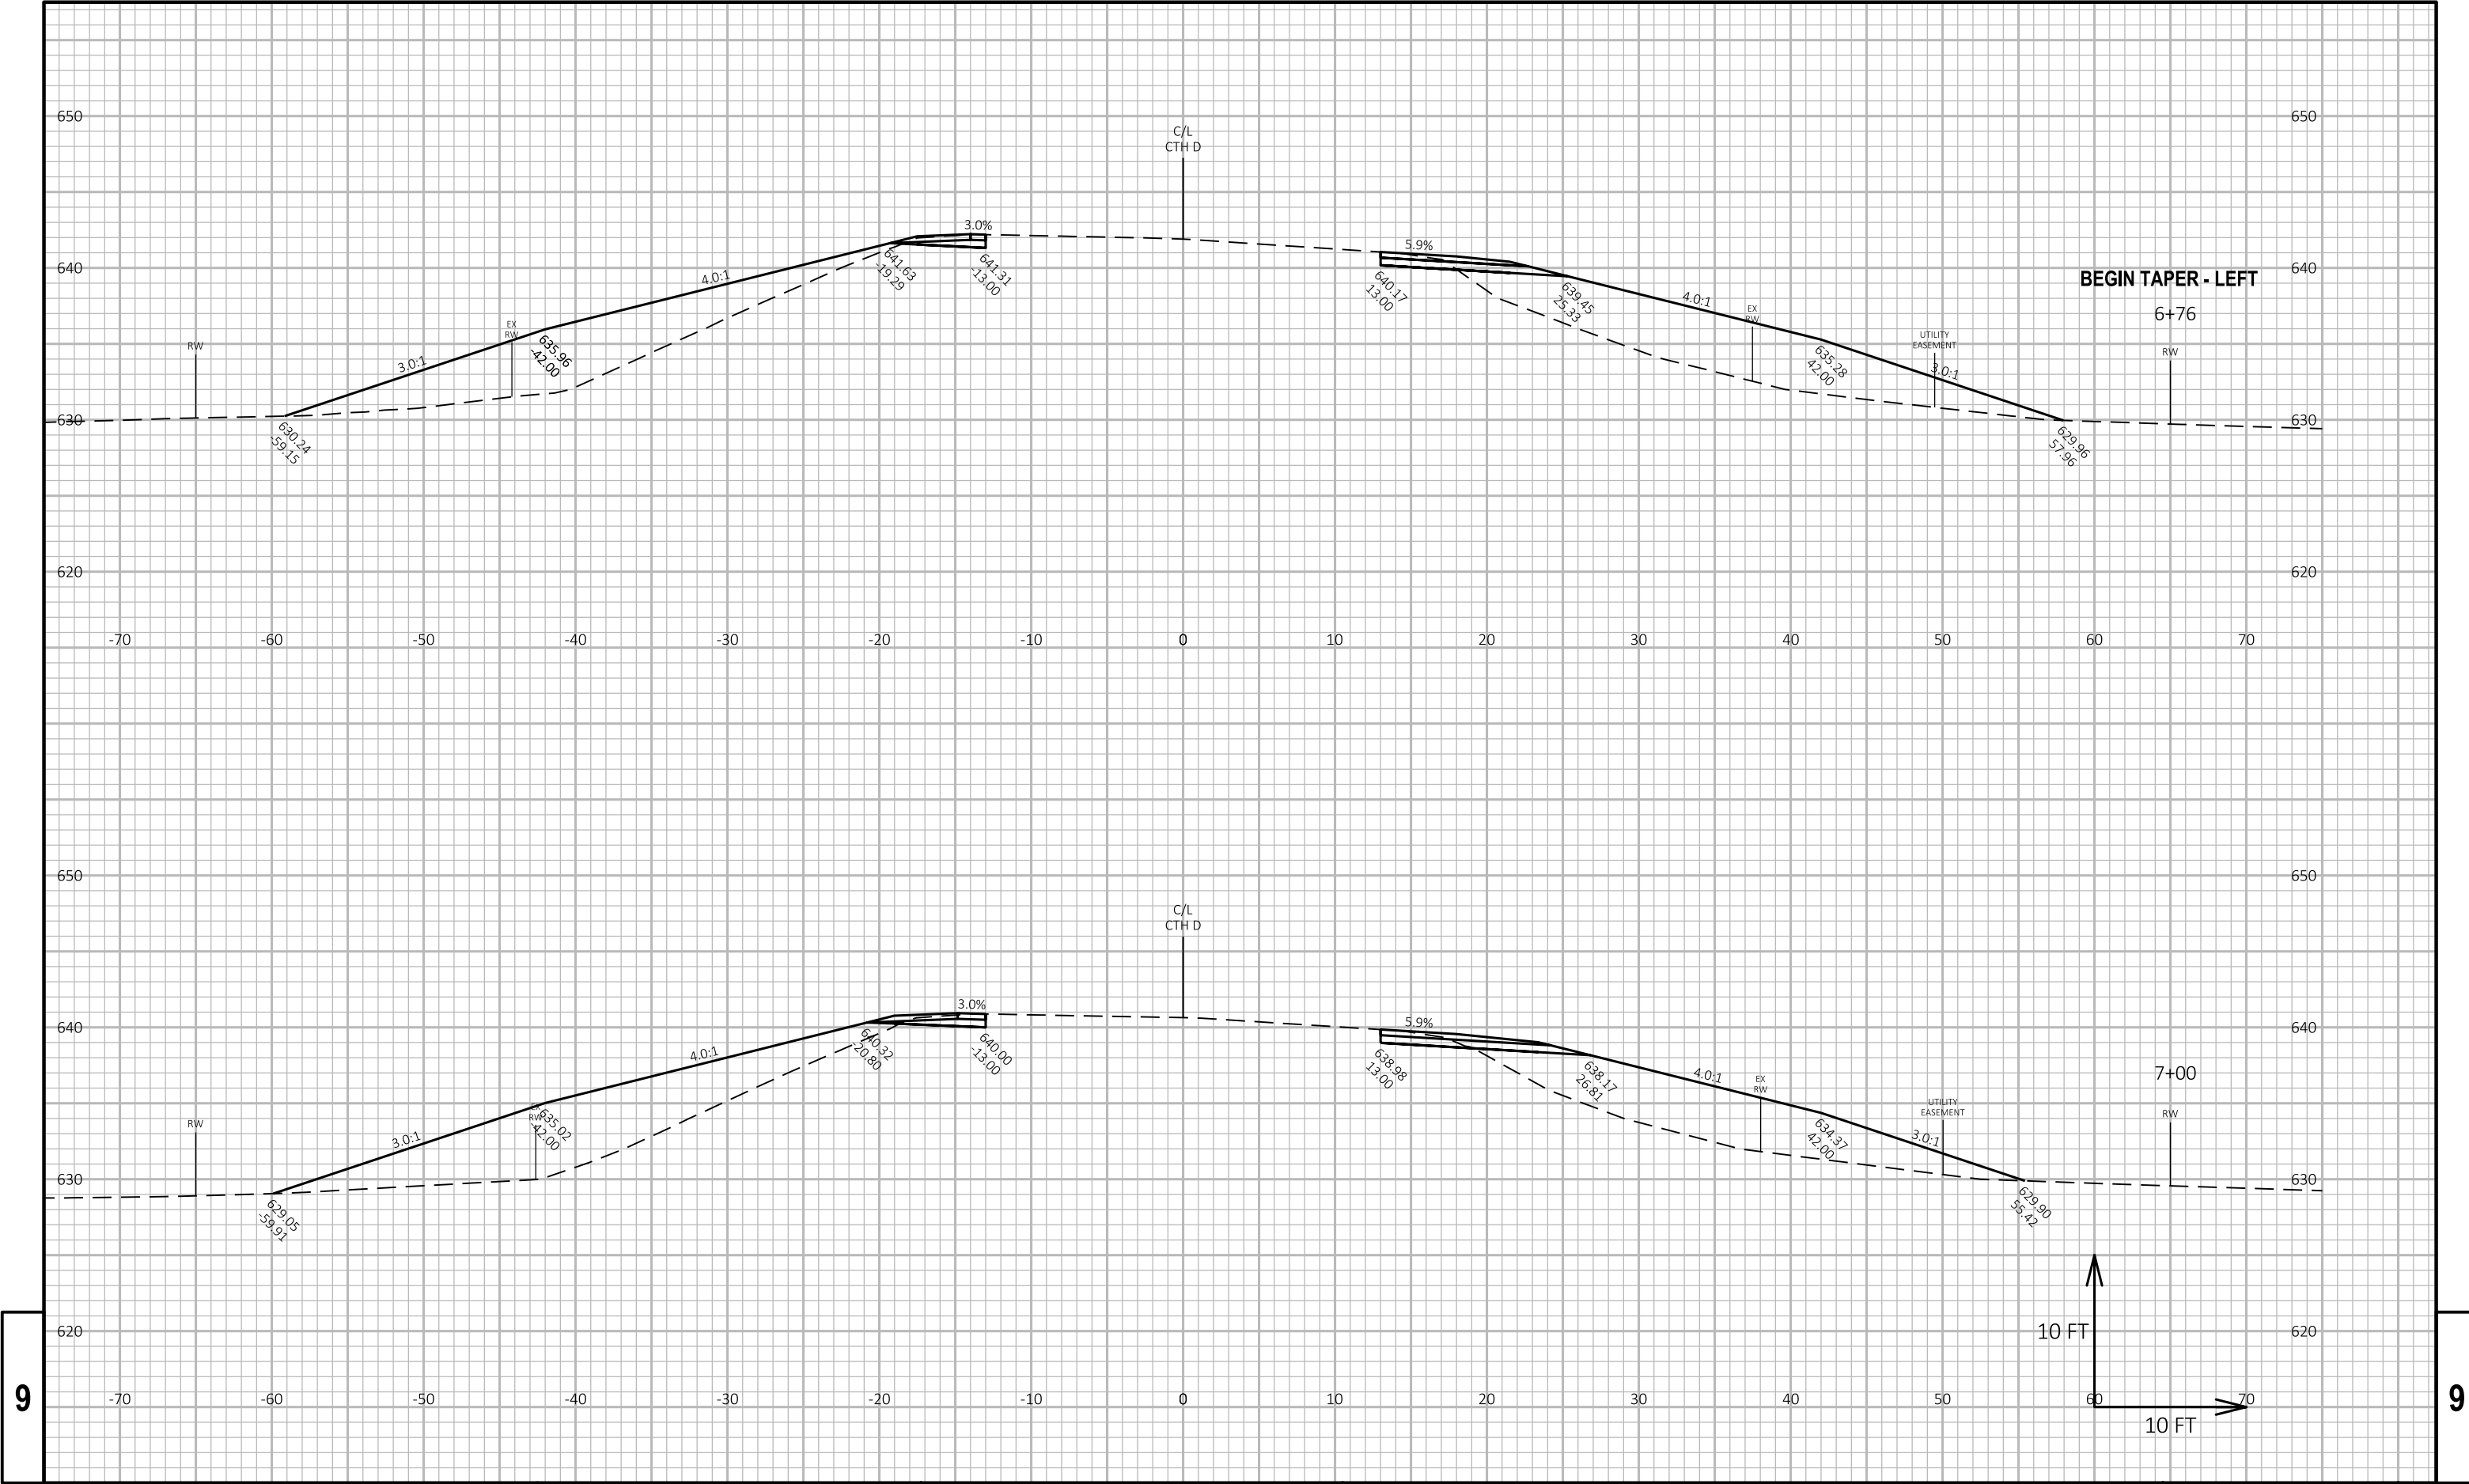

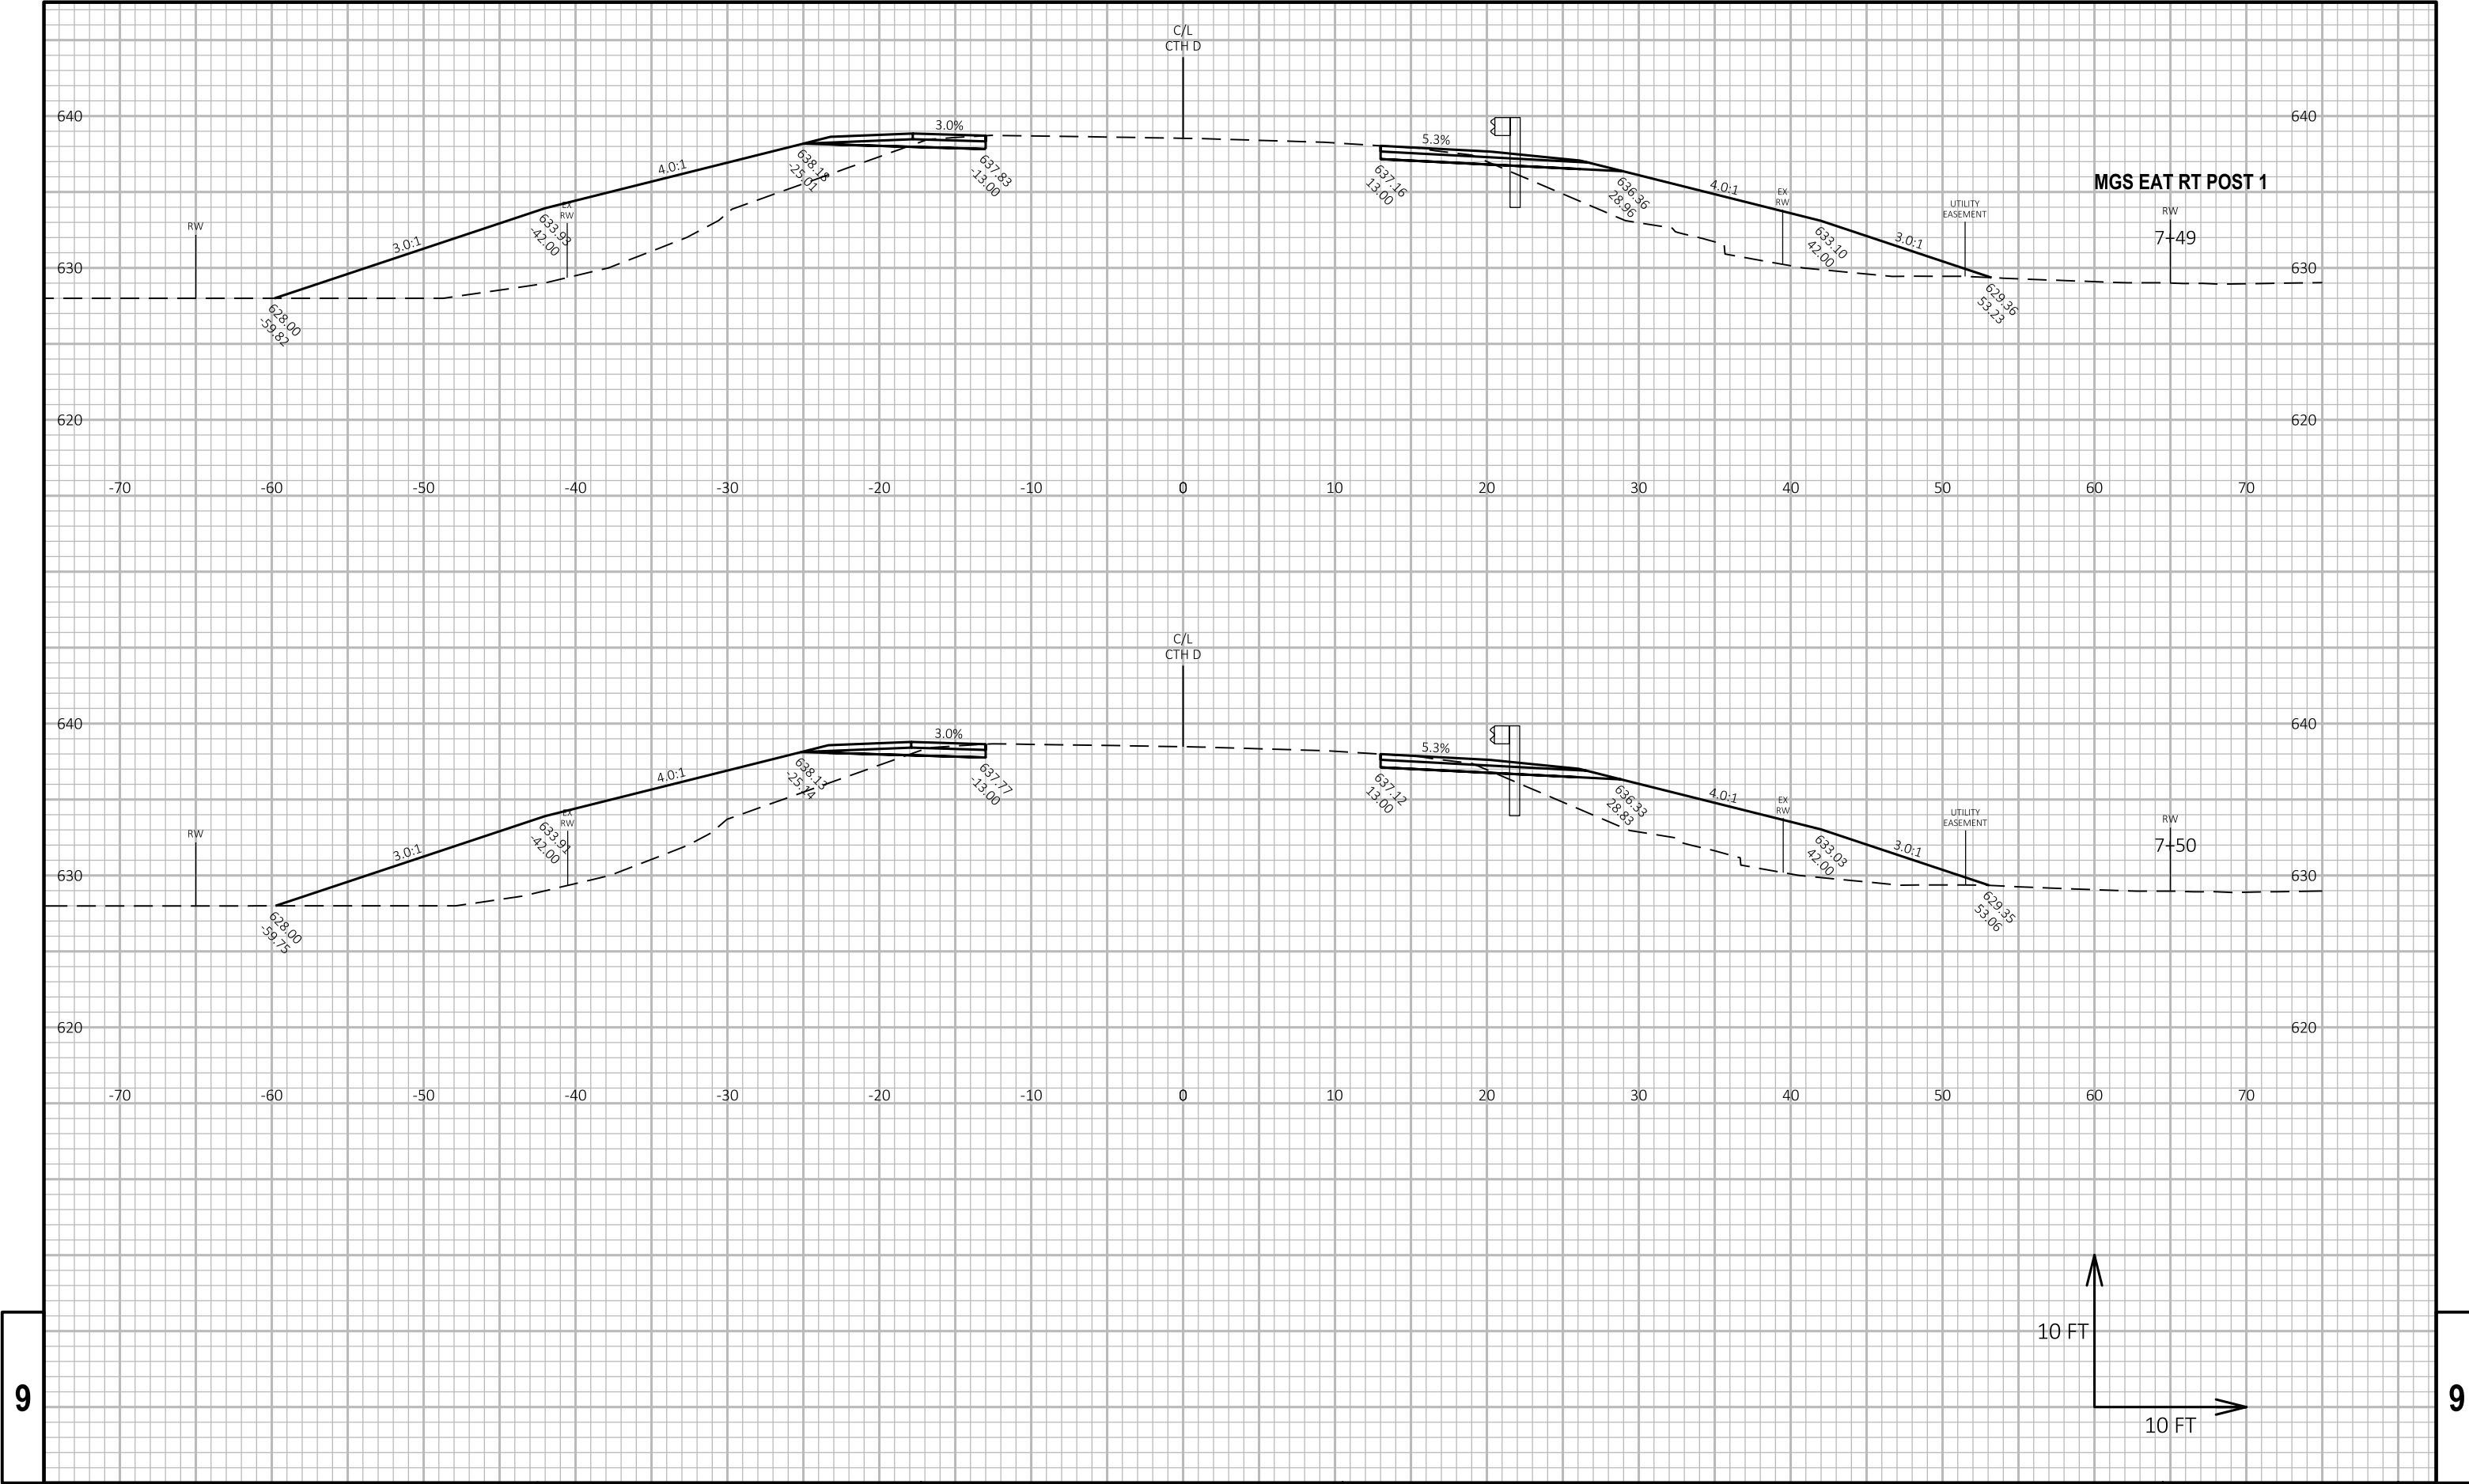

PROJECT NO: 4546-02-71

HWY: CTH D

COUNTY: BROWN

CROSS SECTIONS: CTH D

SHEET

54

E

FILE NAME : G:\WI - NE REGION\4546-02-00_CTH D_BROWN CO\500_CADD\501_C3D_2016\4546-02-00\SHEETS\PLAN\090101-XS.DWG
LAYOUT NAME - xs - (4)


PLOT DATE : 7/22/2018 8:45 AM


PLOT BY : CHARLENE AND BOBBY


PLOT NAME :

PLOT SCALE : 1 IN:10 FT HORZ. / 1 IN:10 FT VERT.

WISDOT/CADD SHEET 49

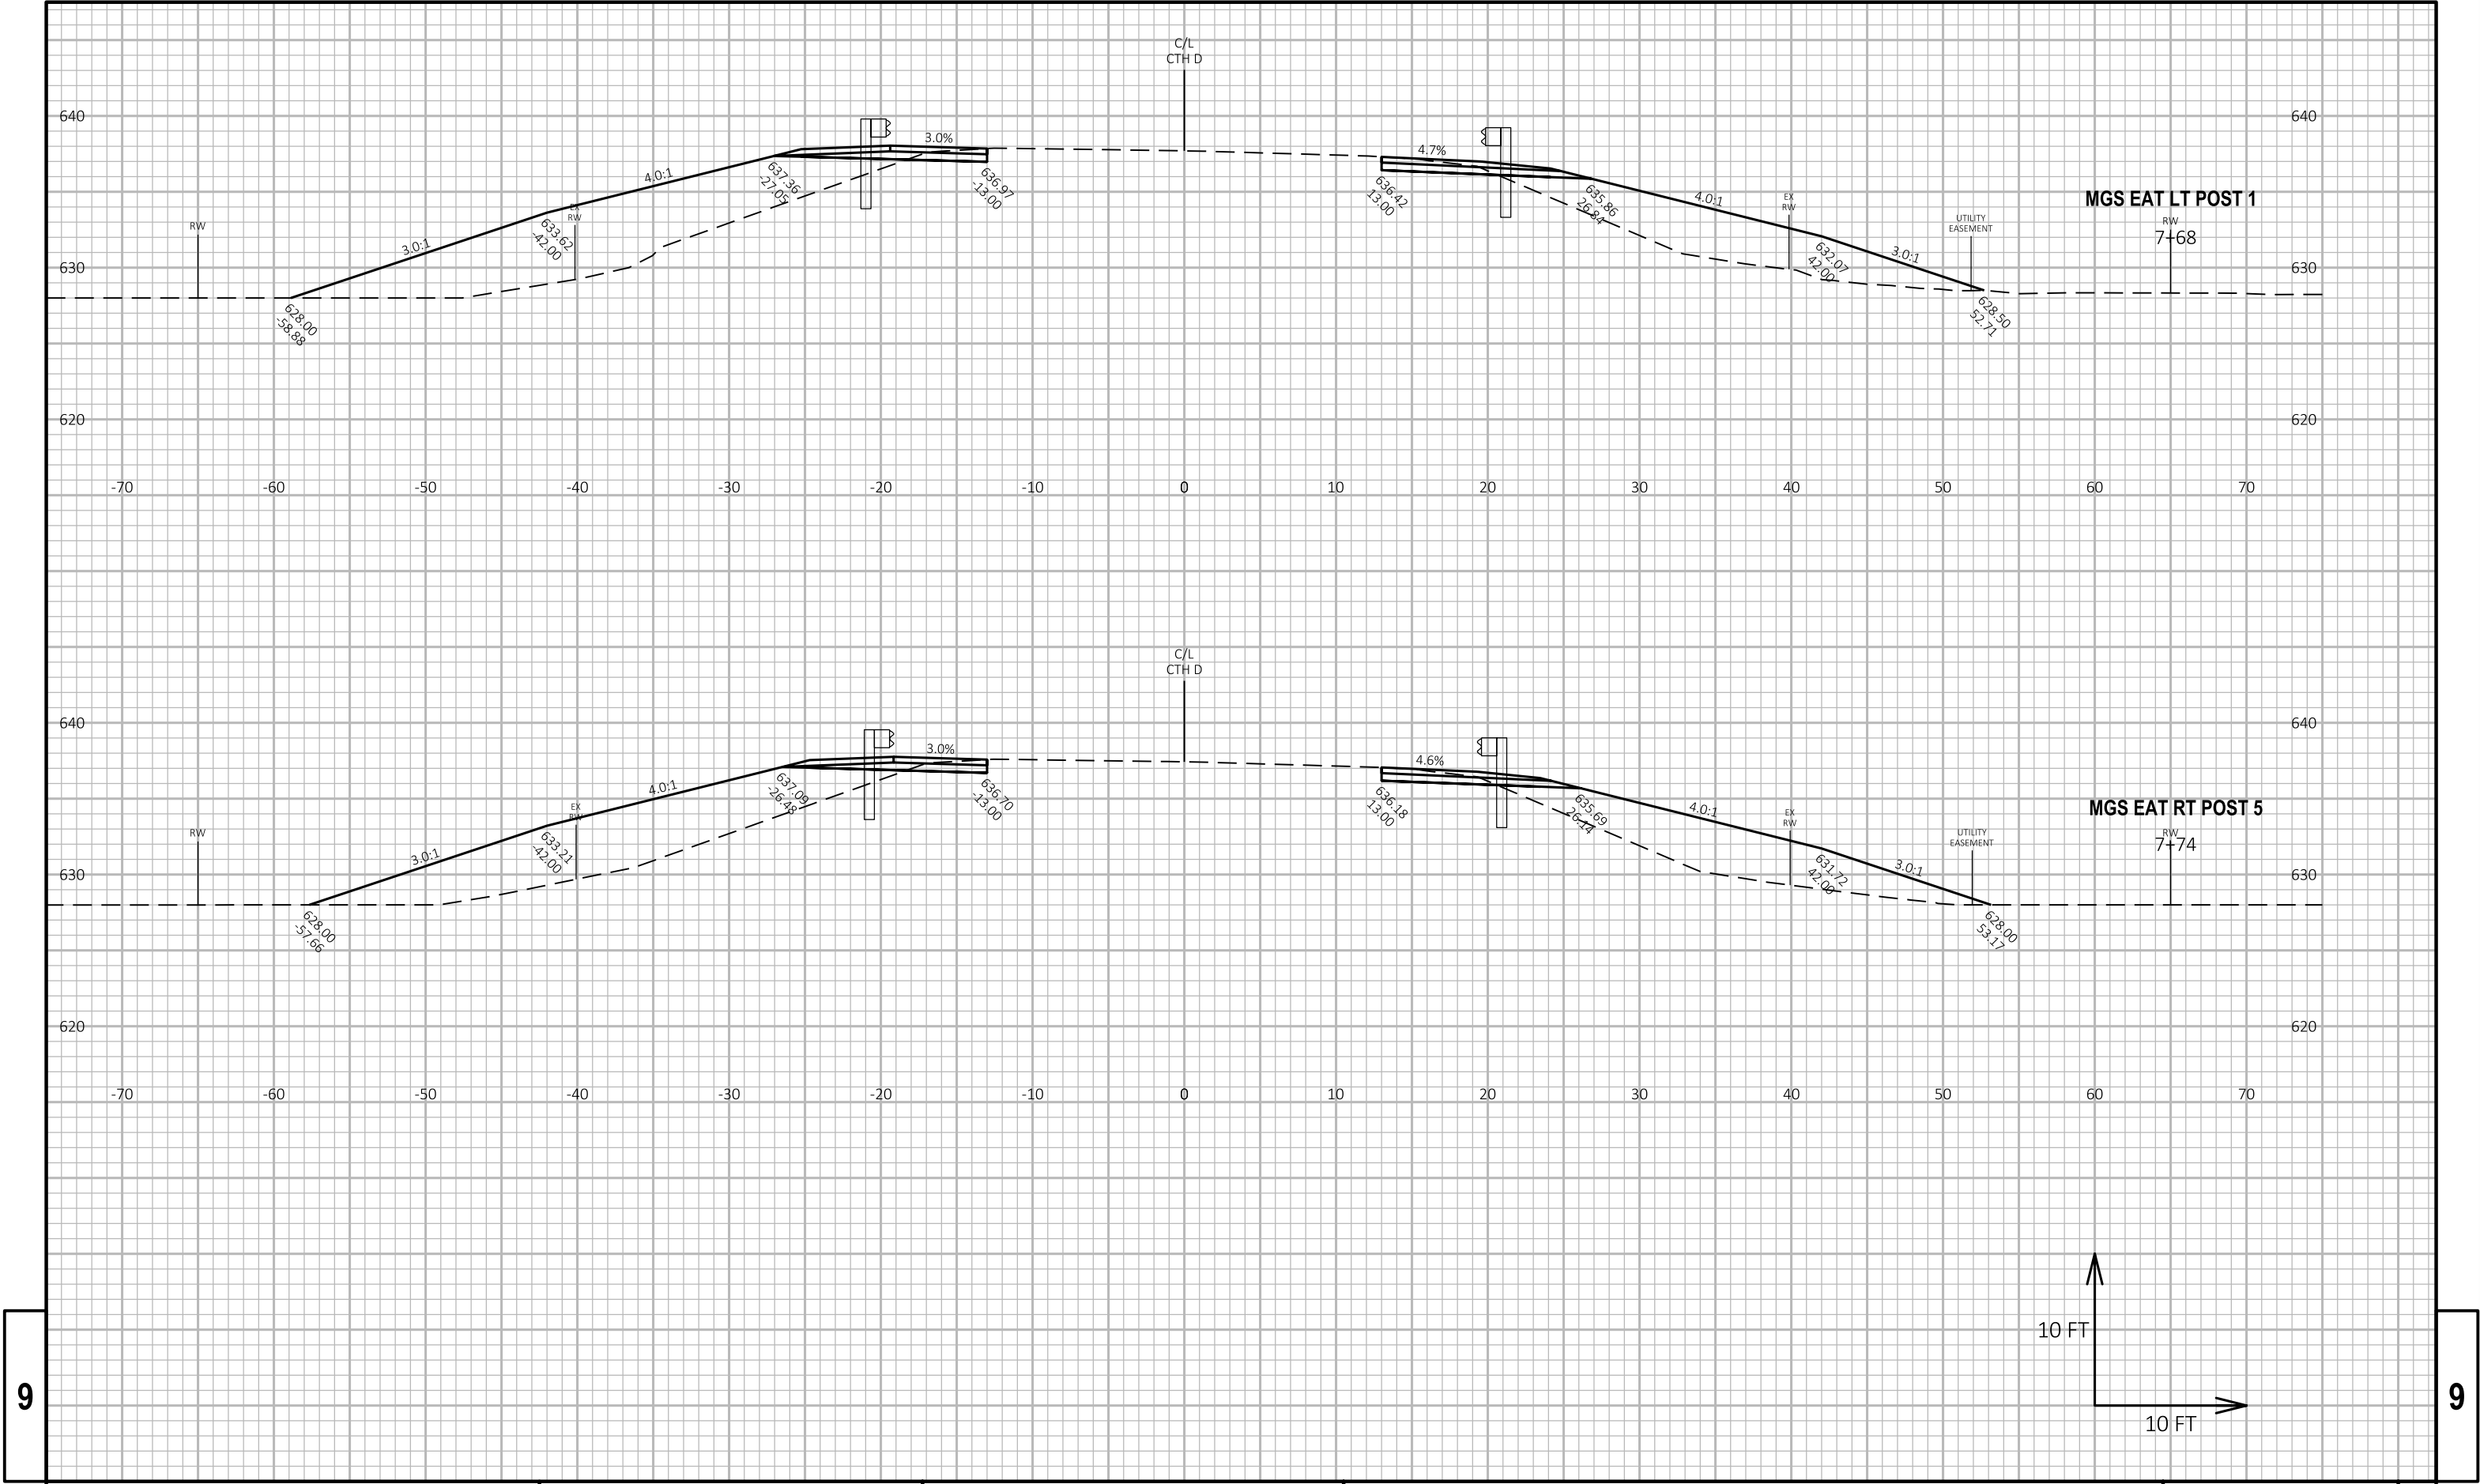


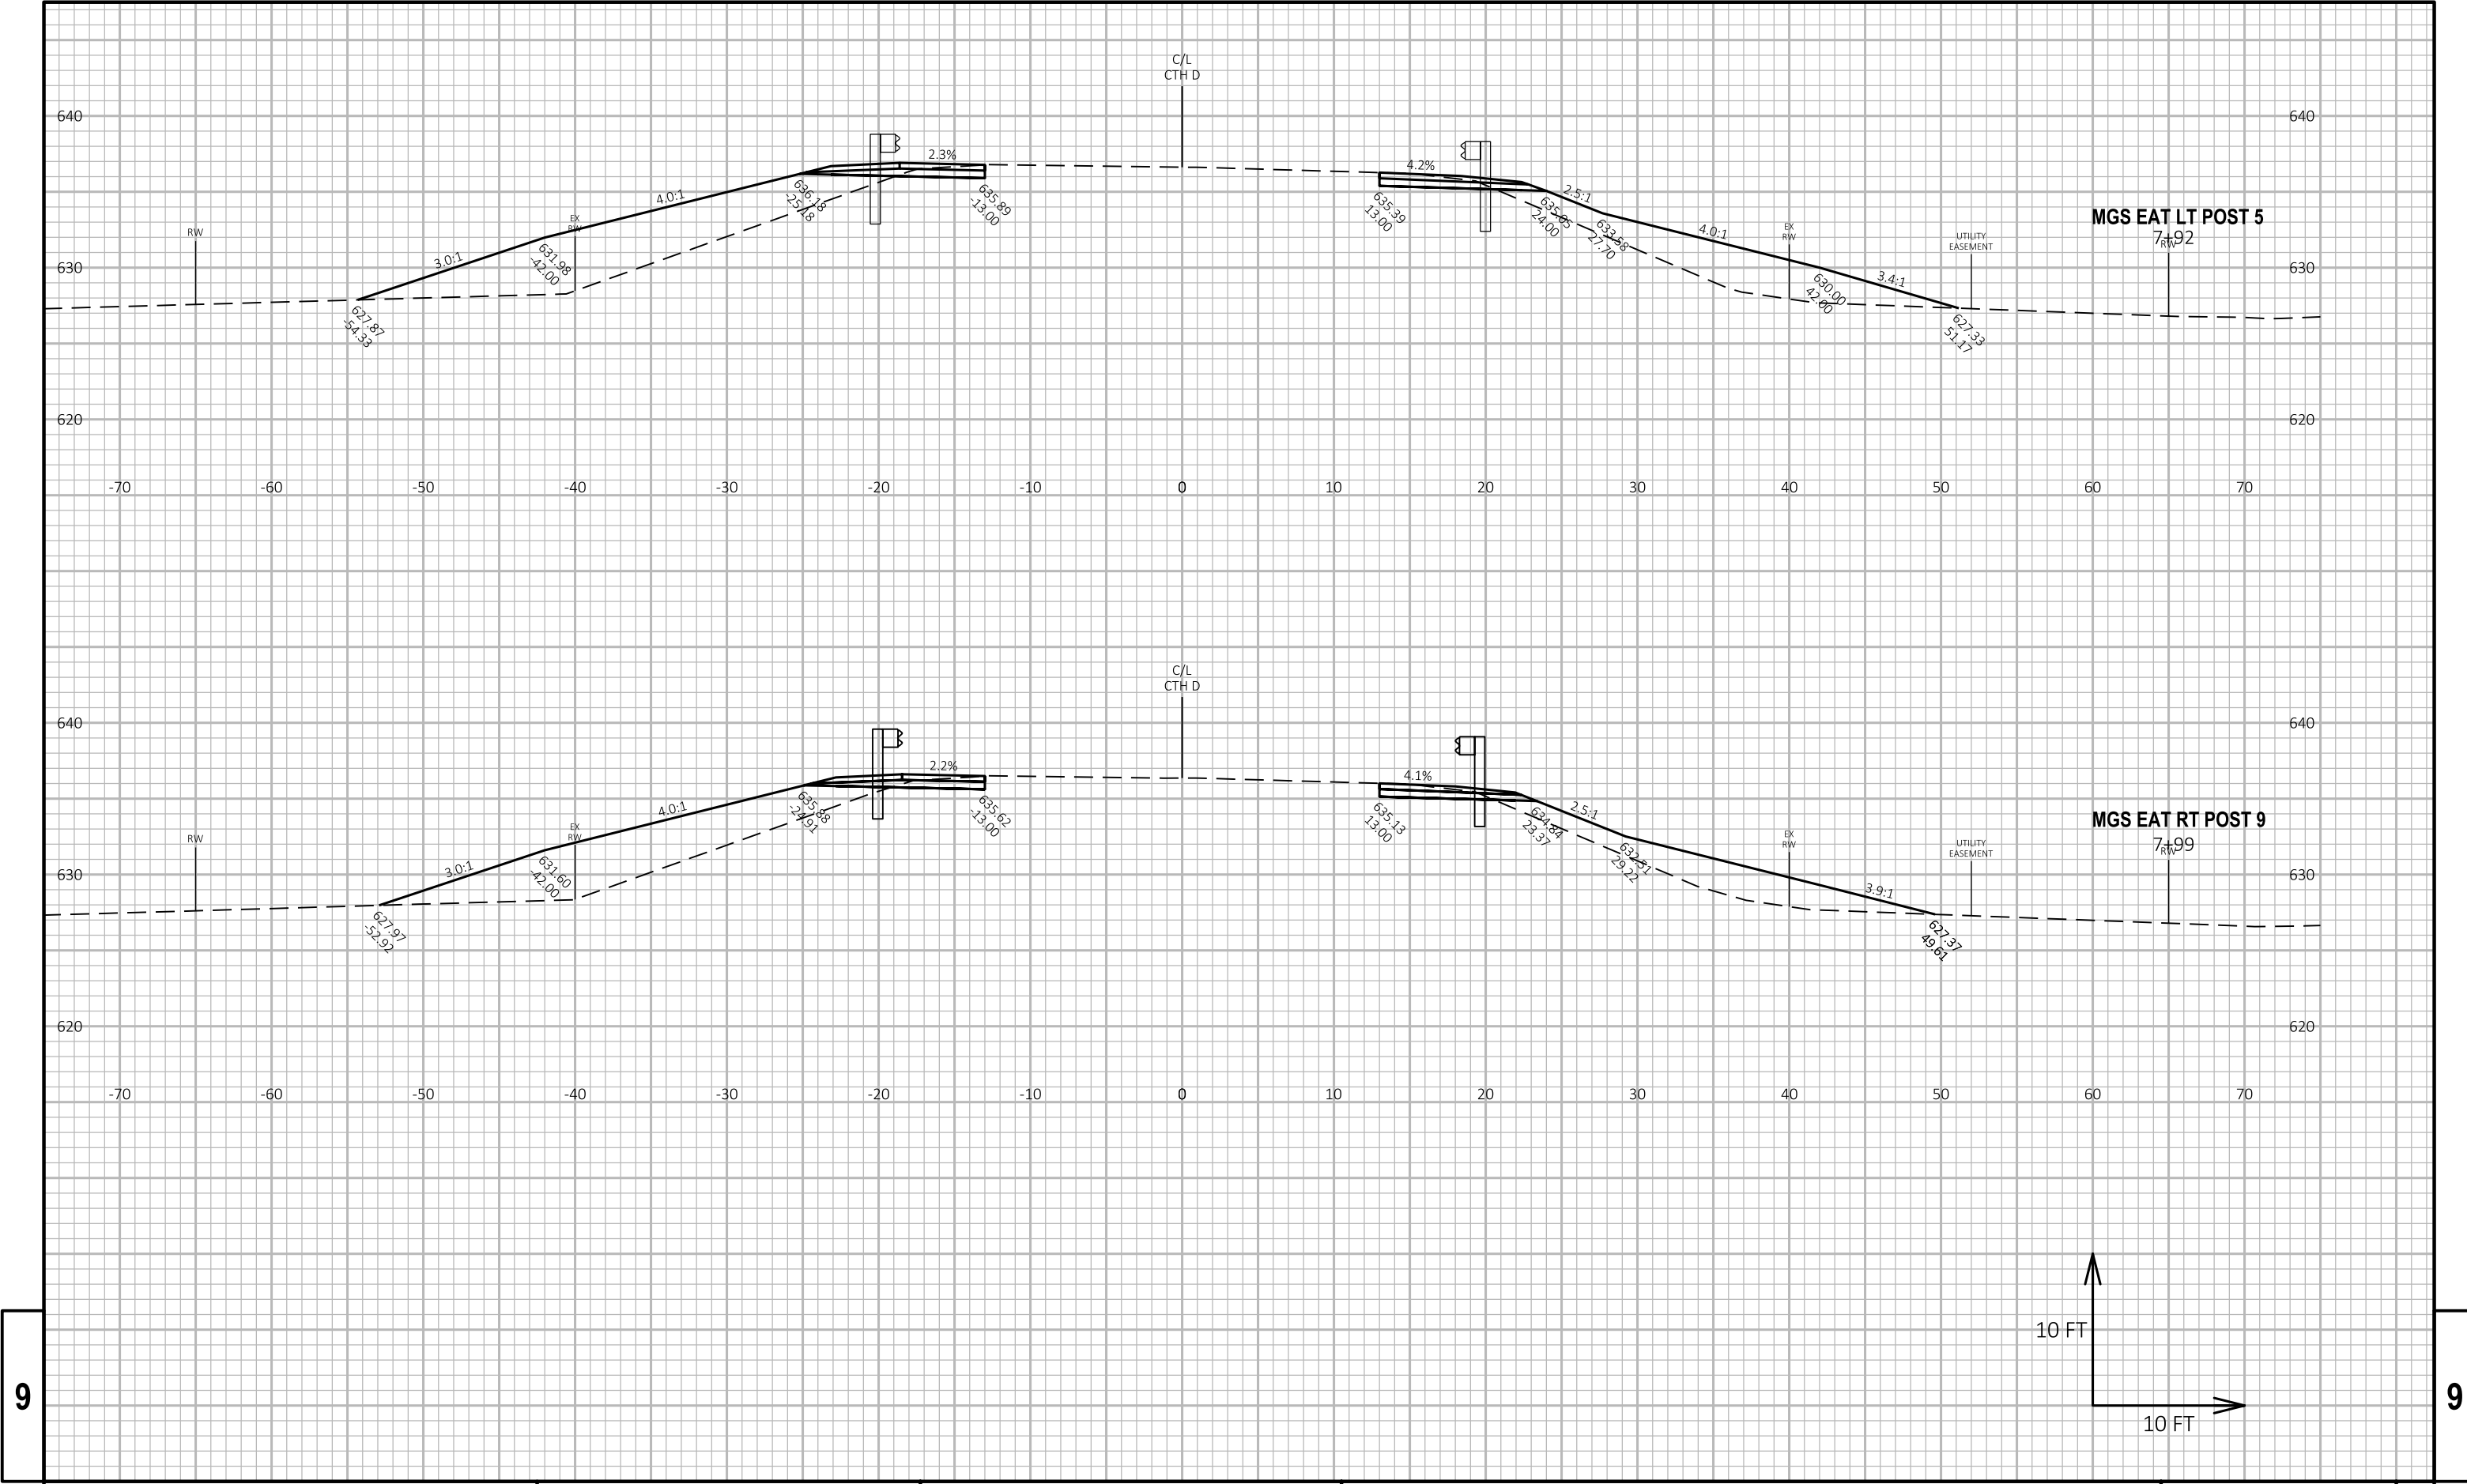


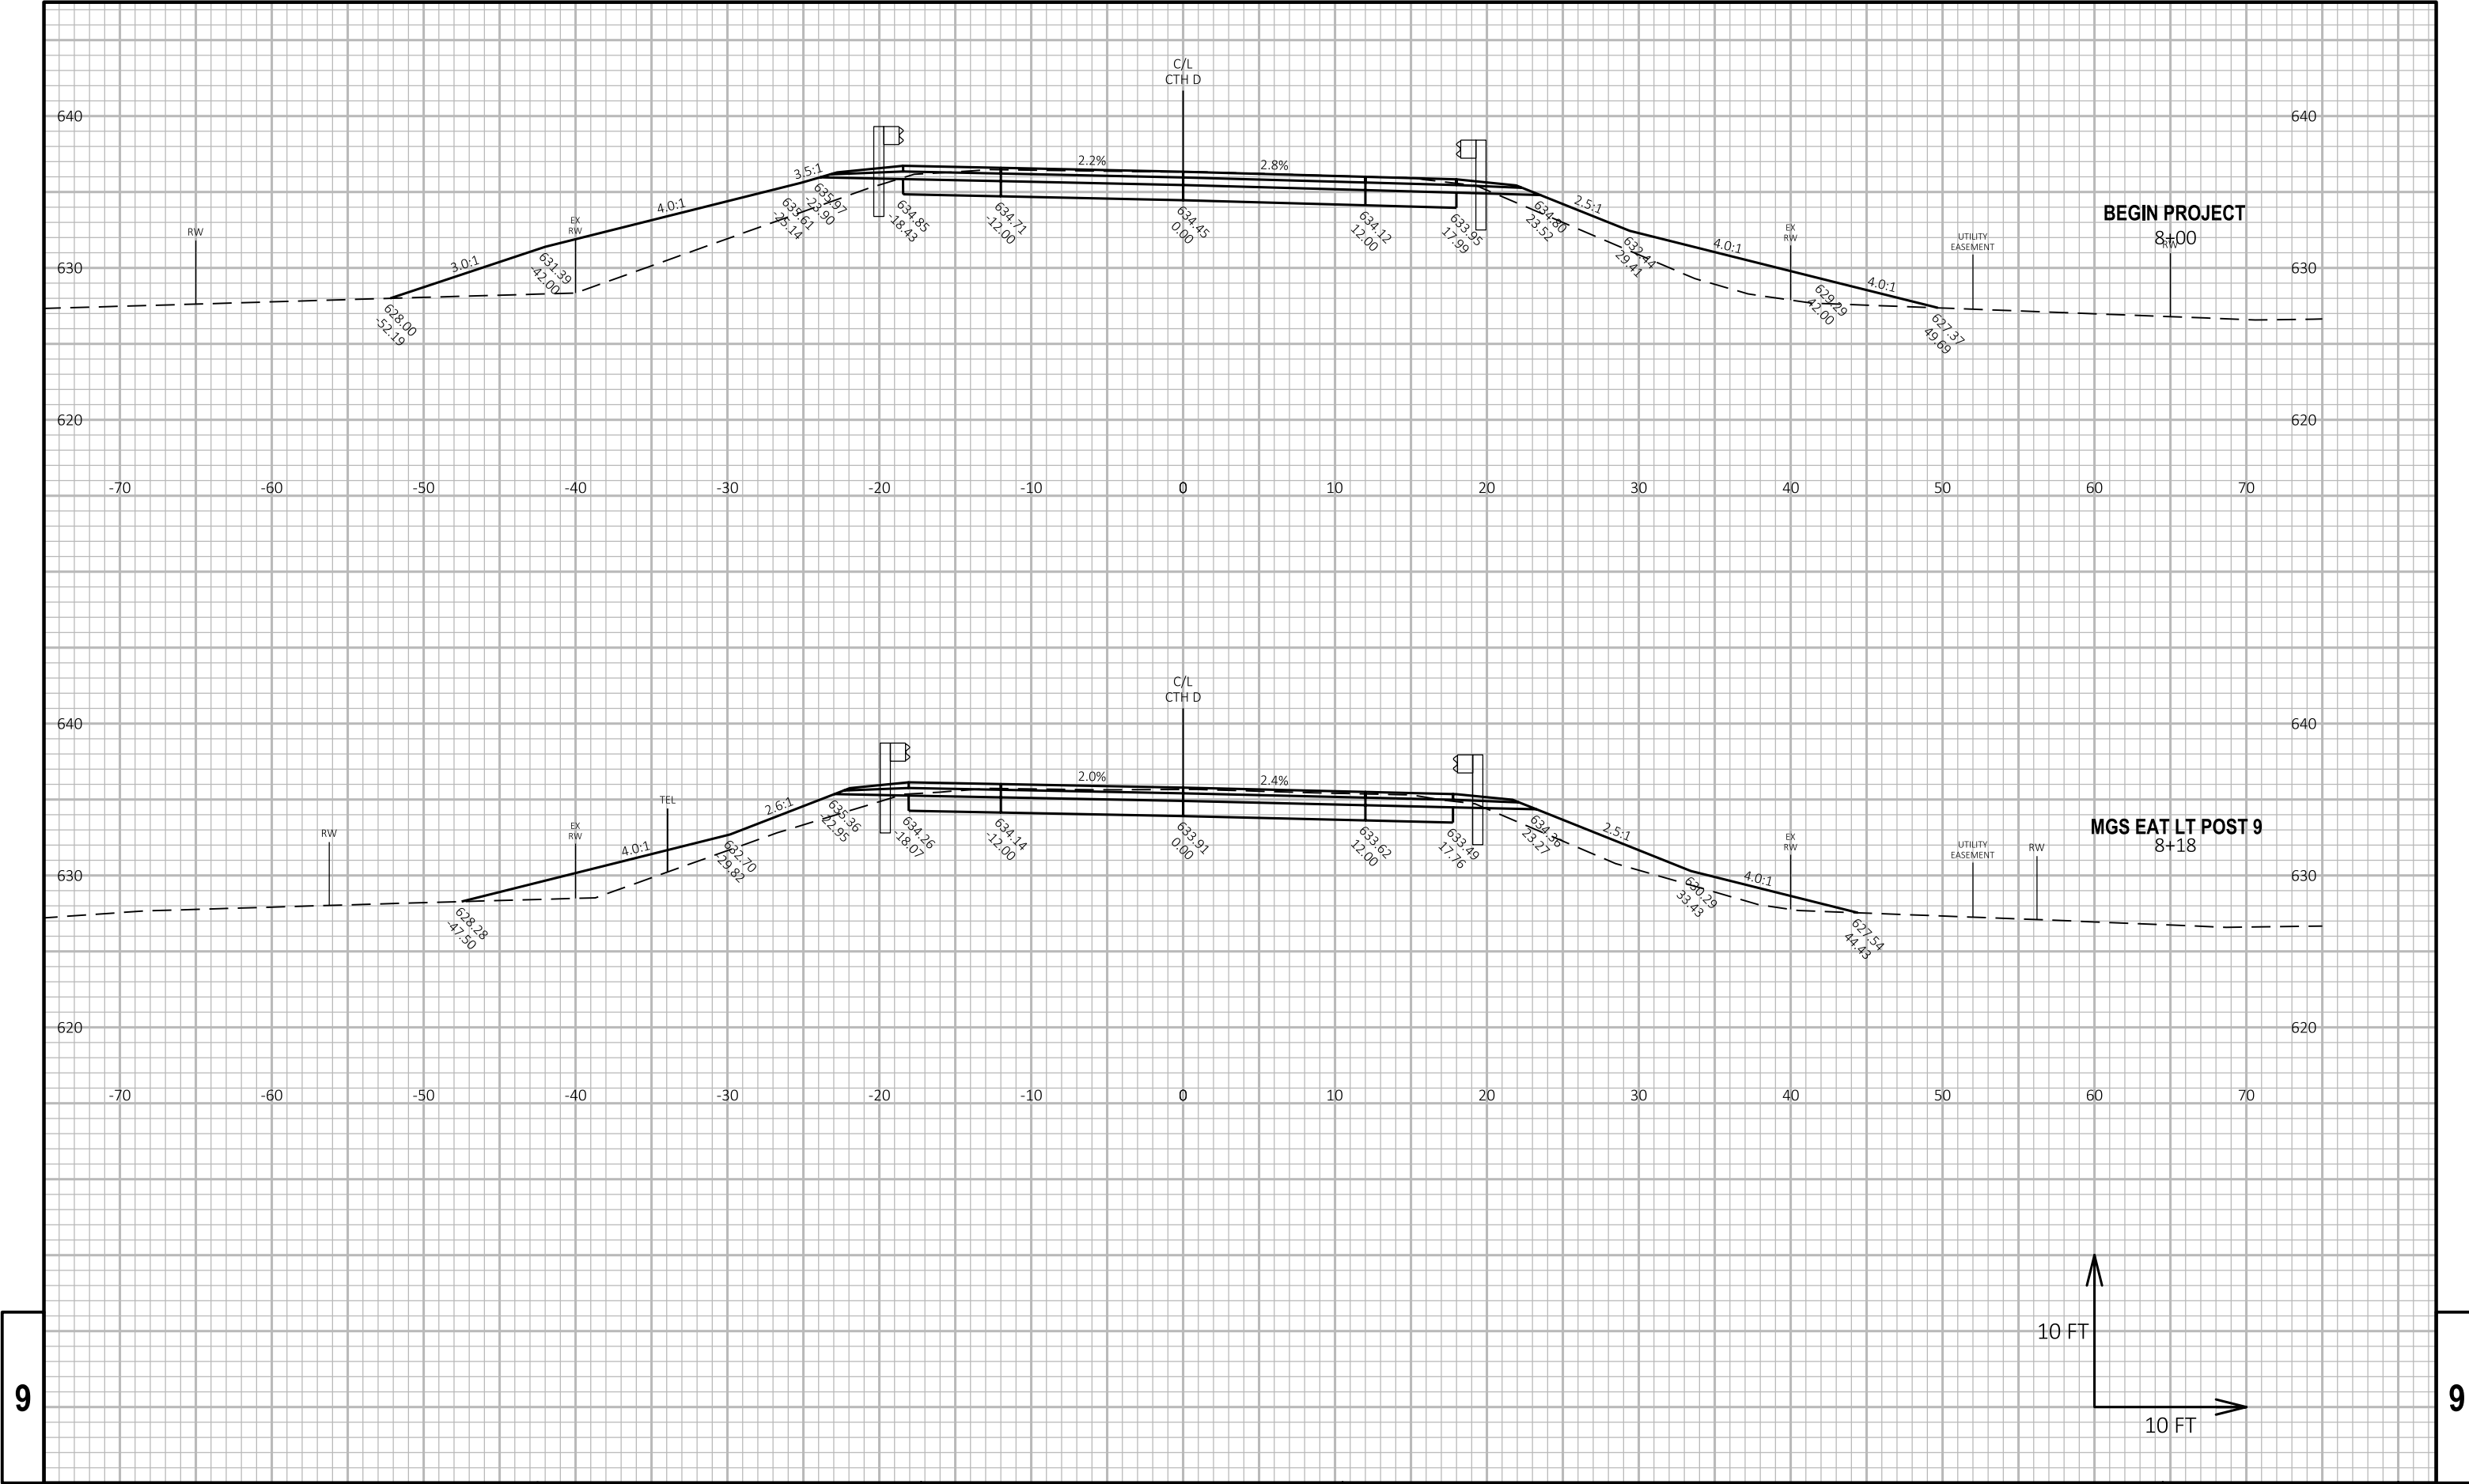



9

9

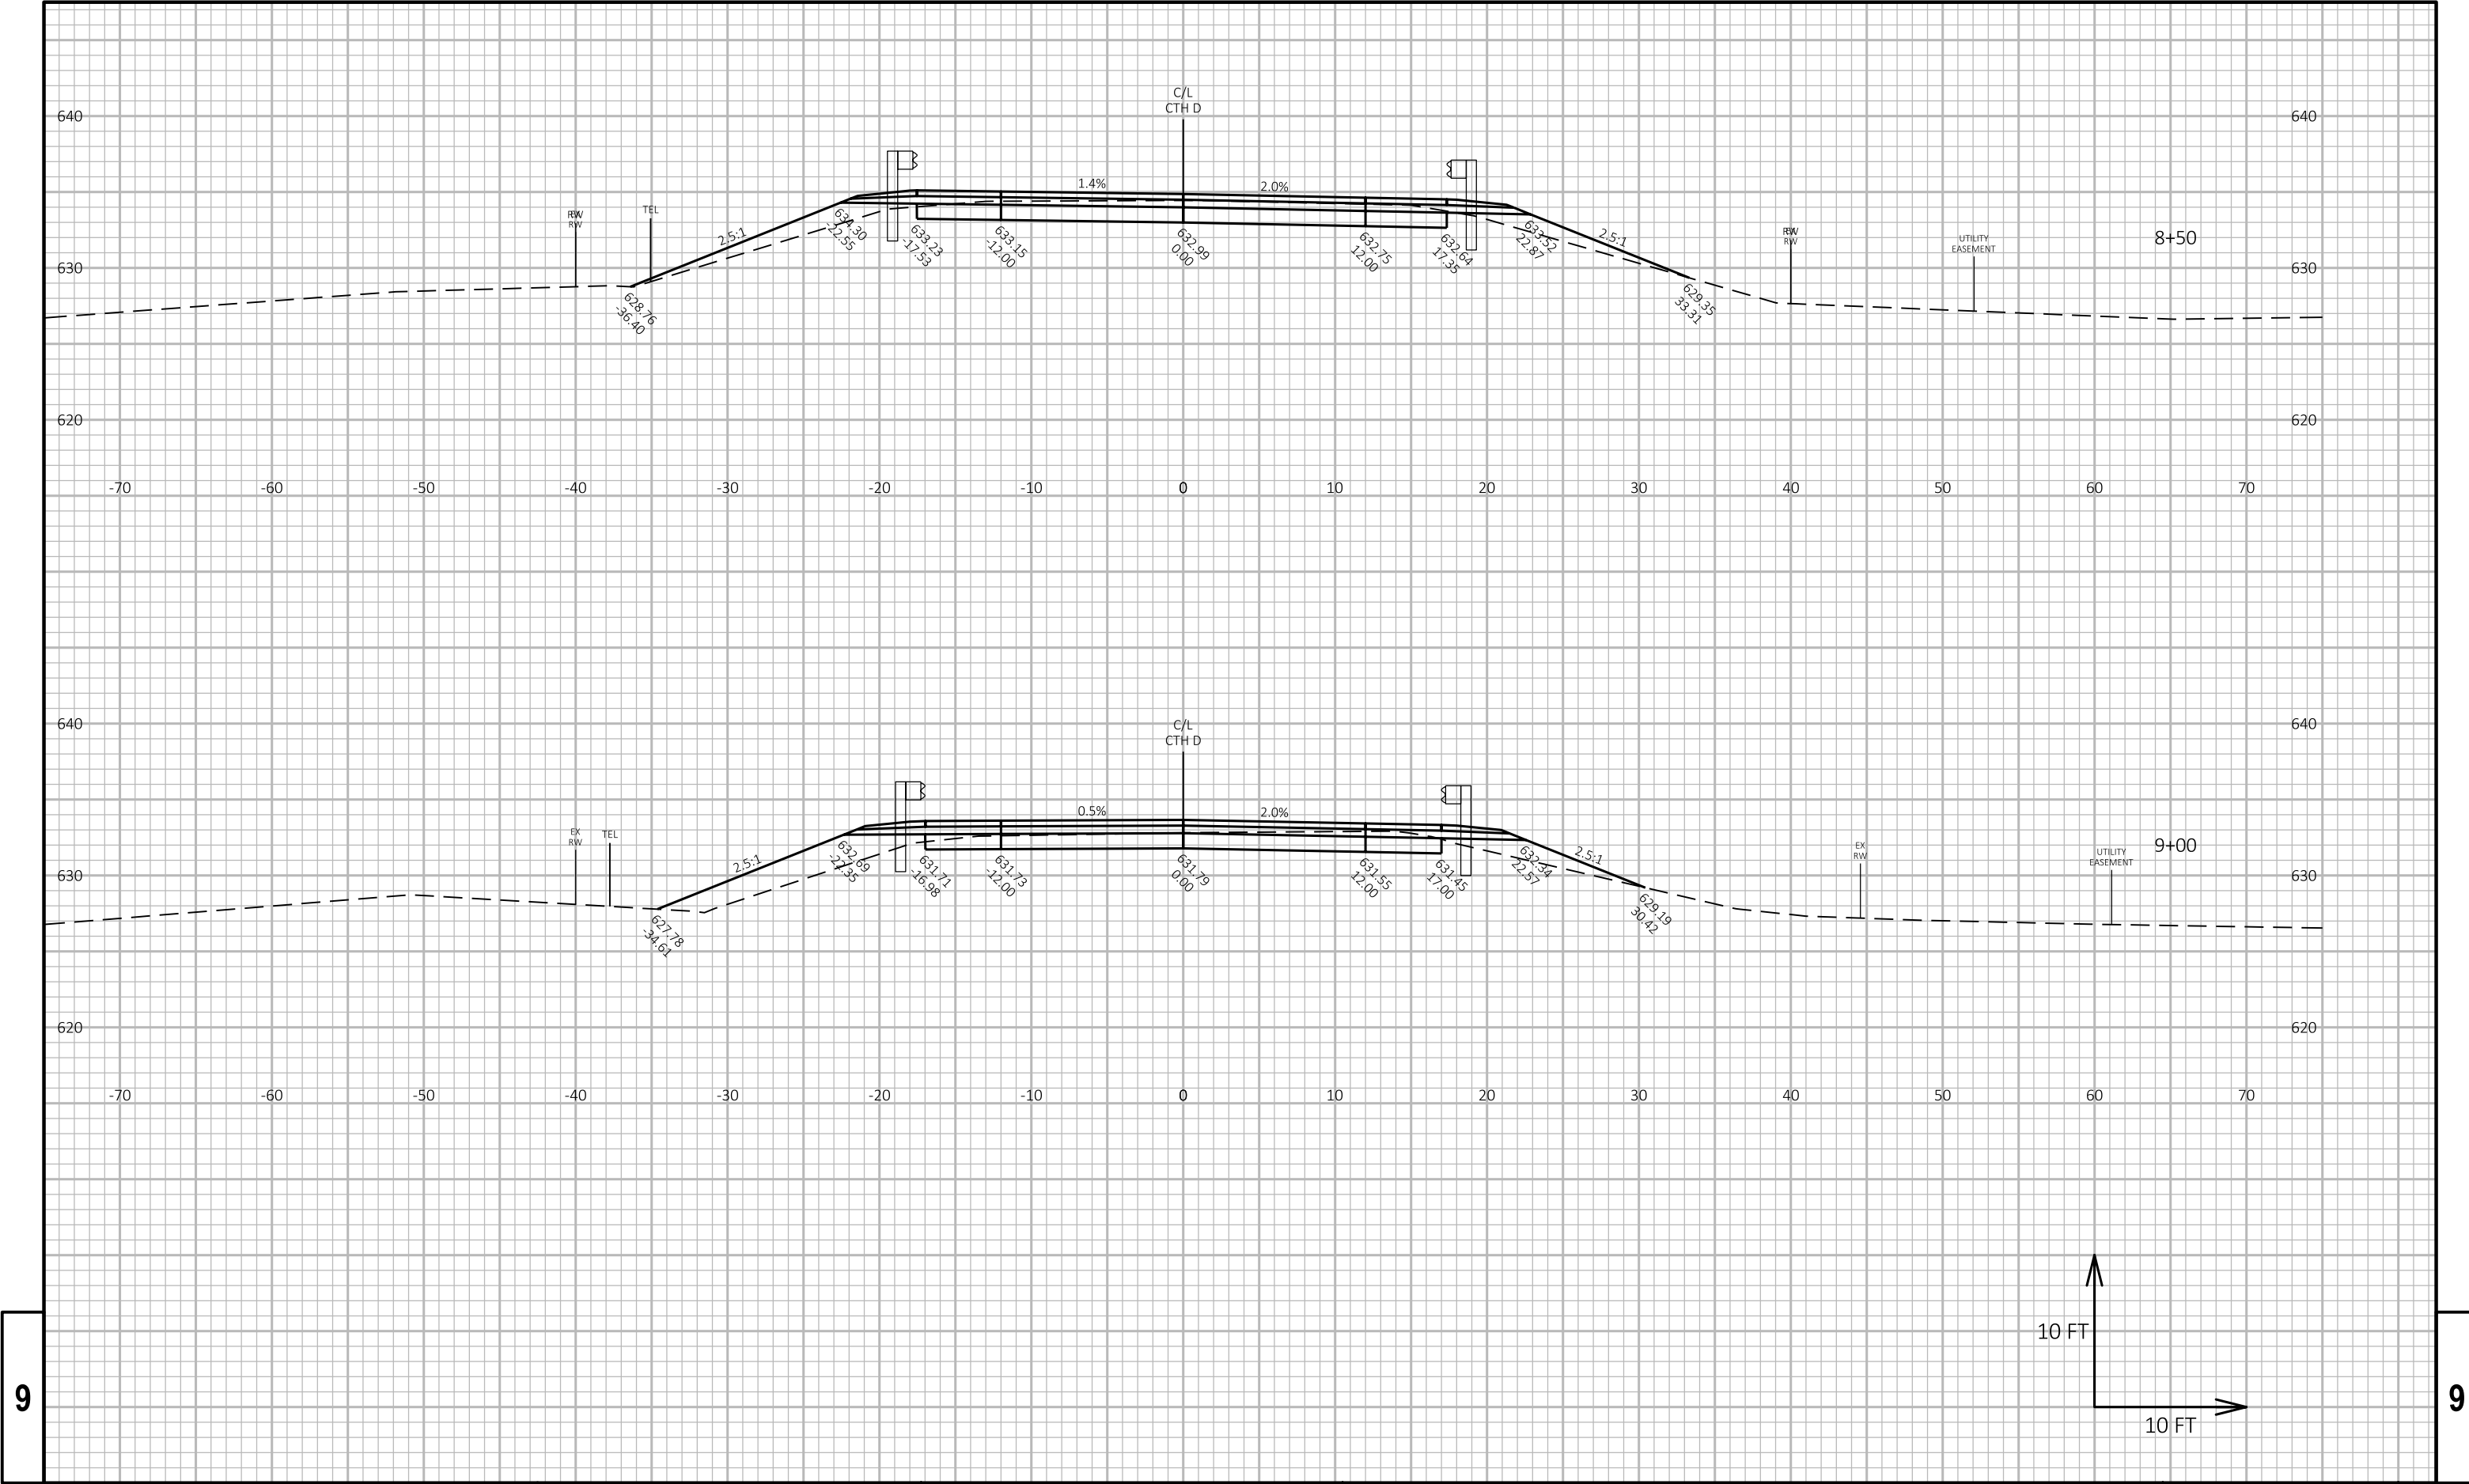

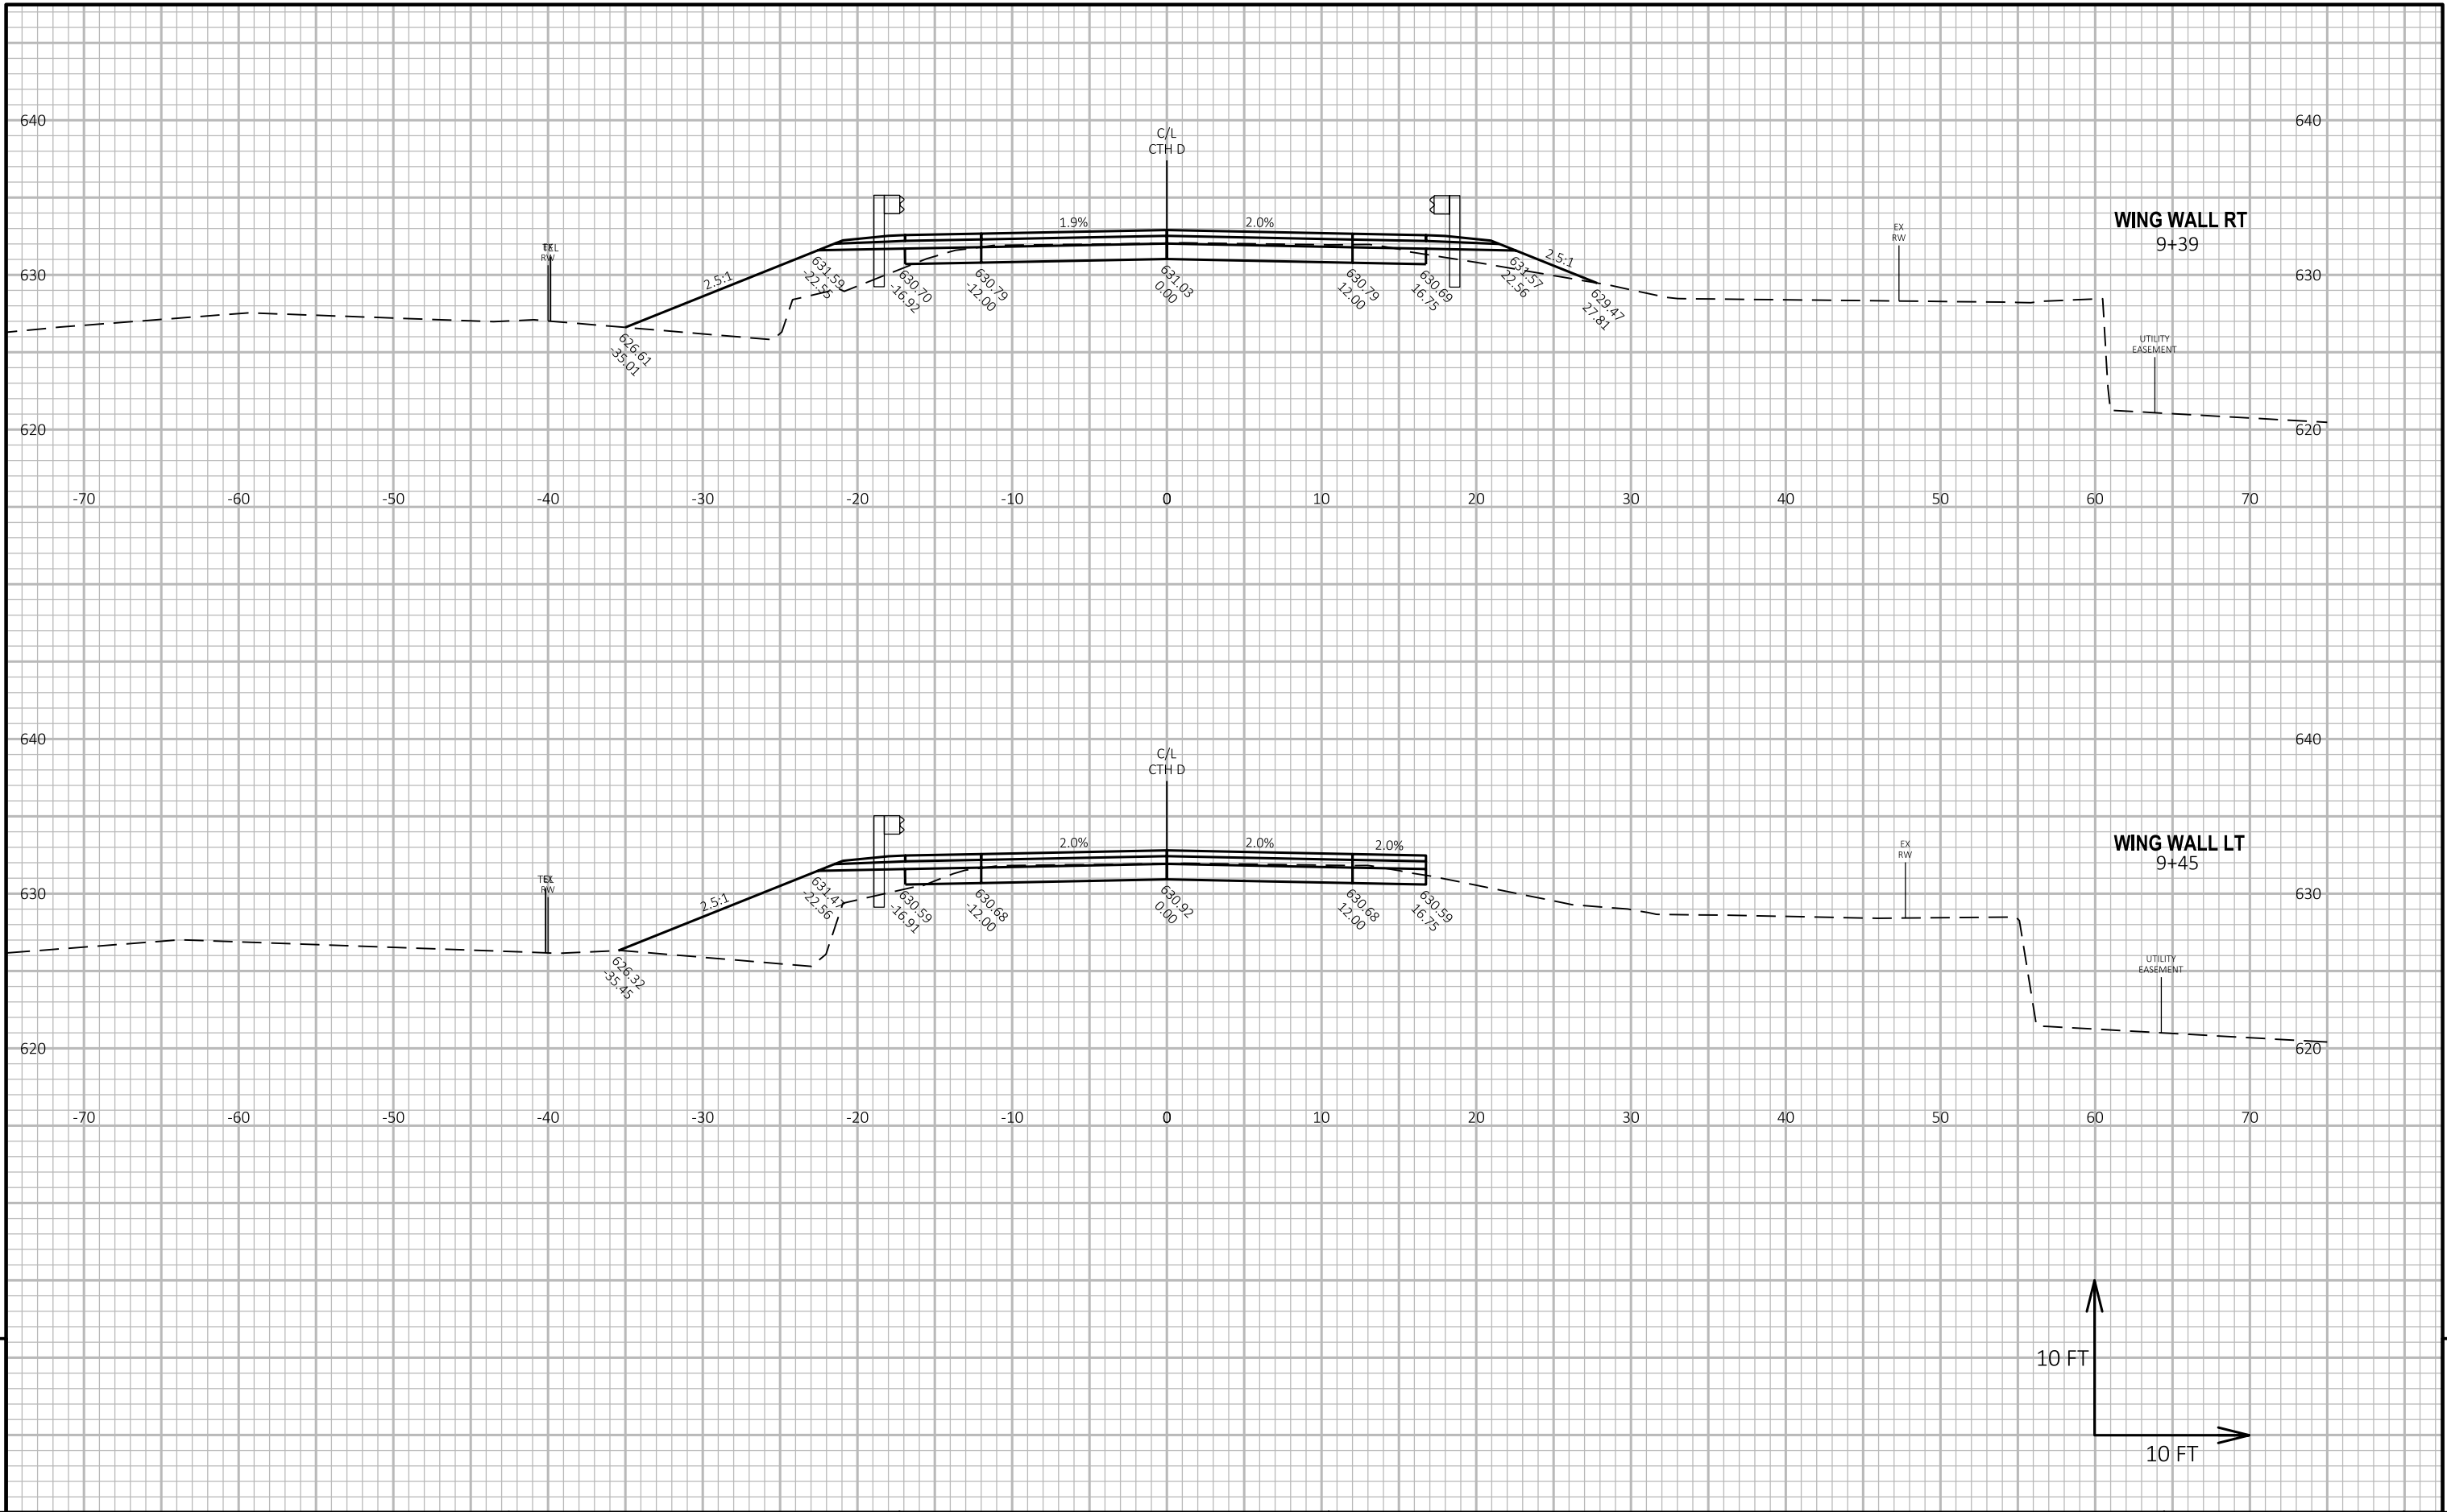


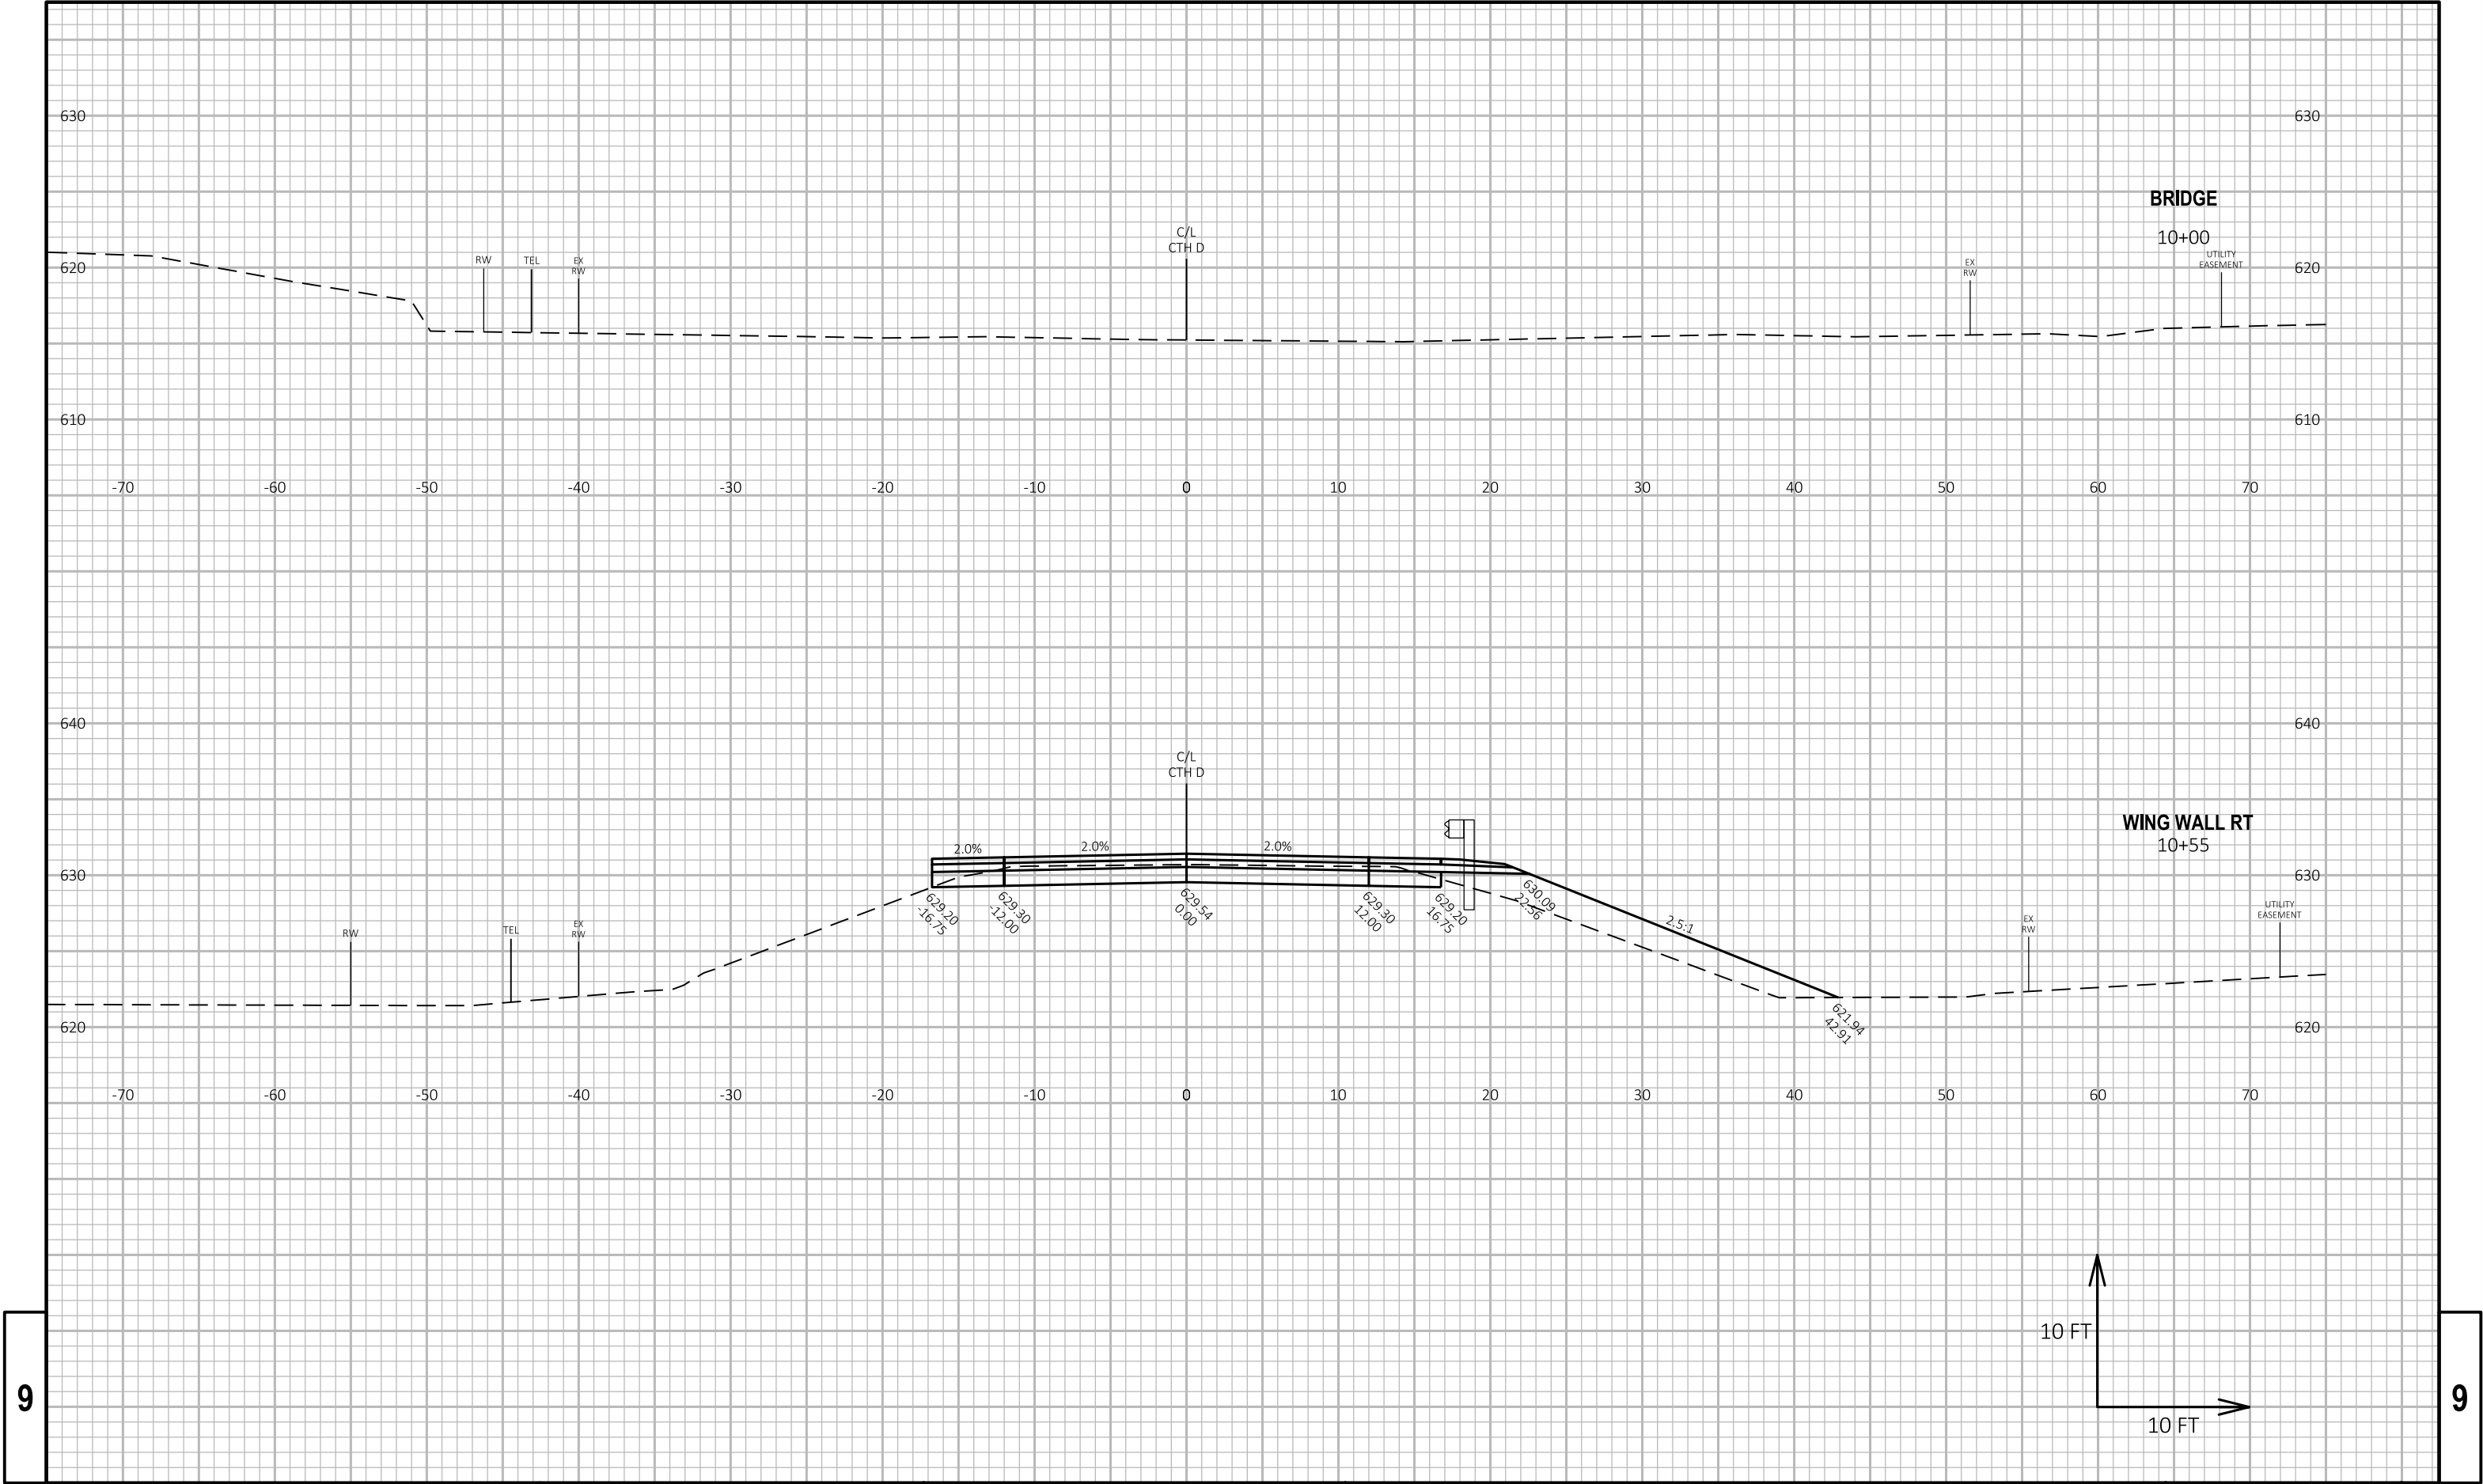

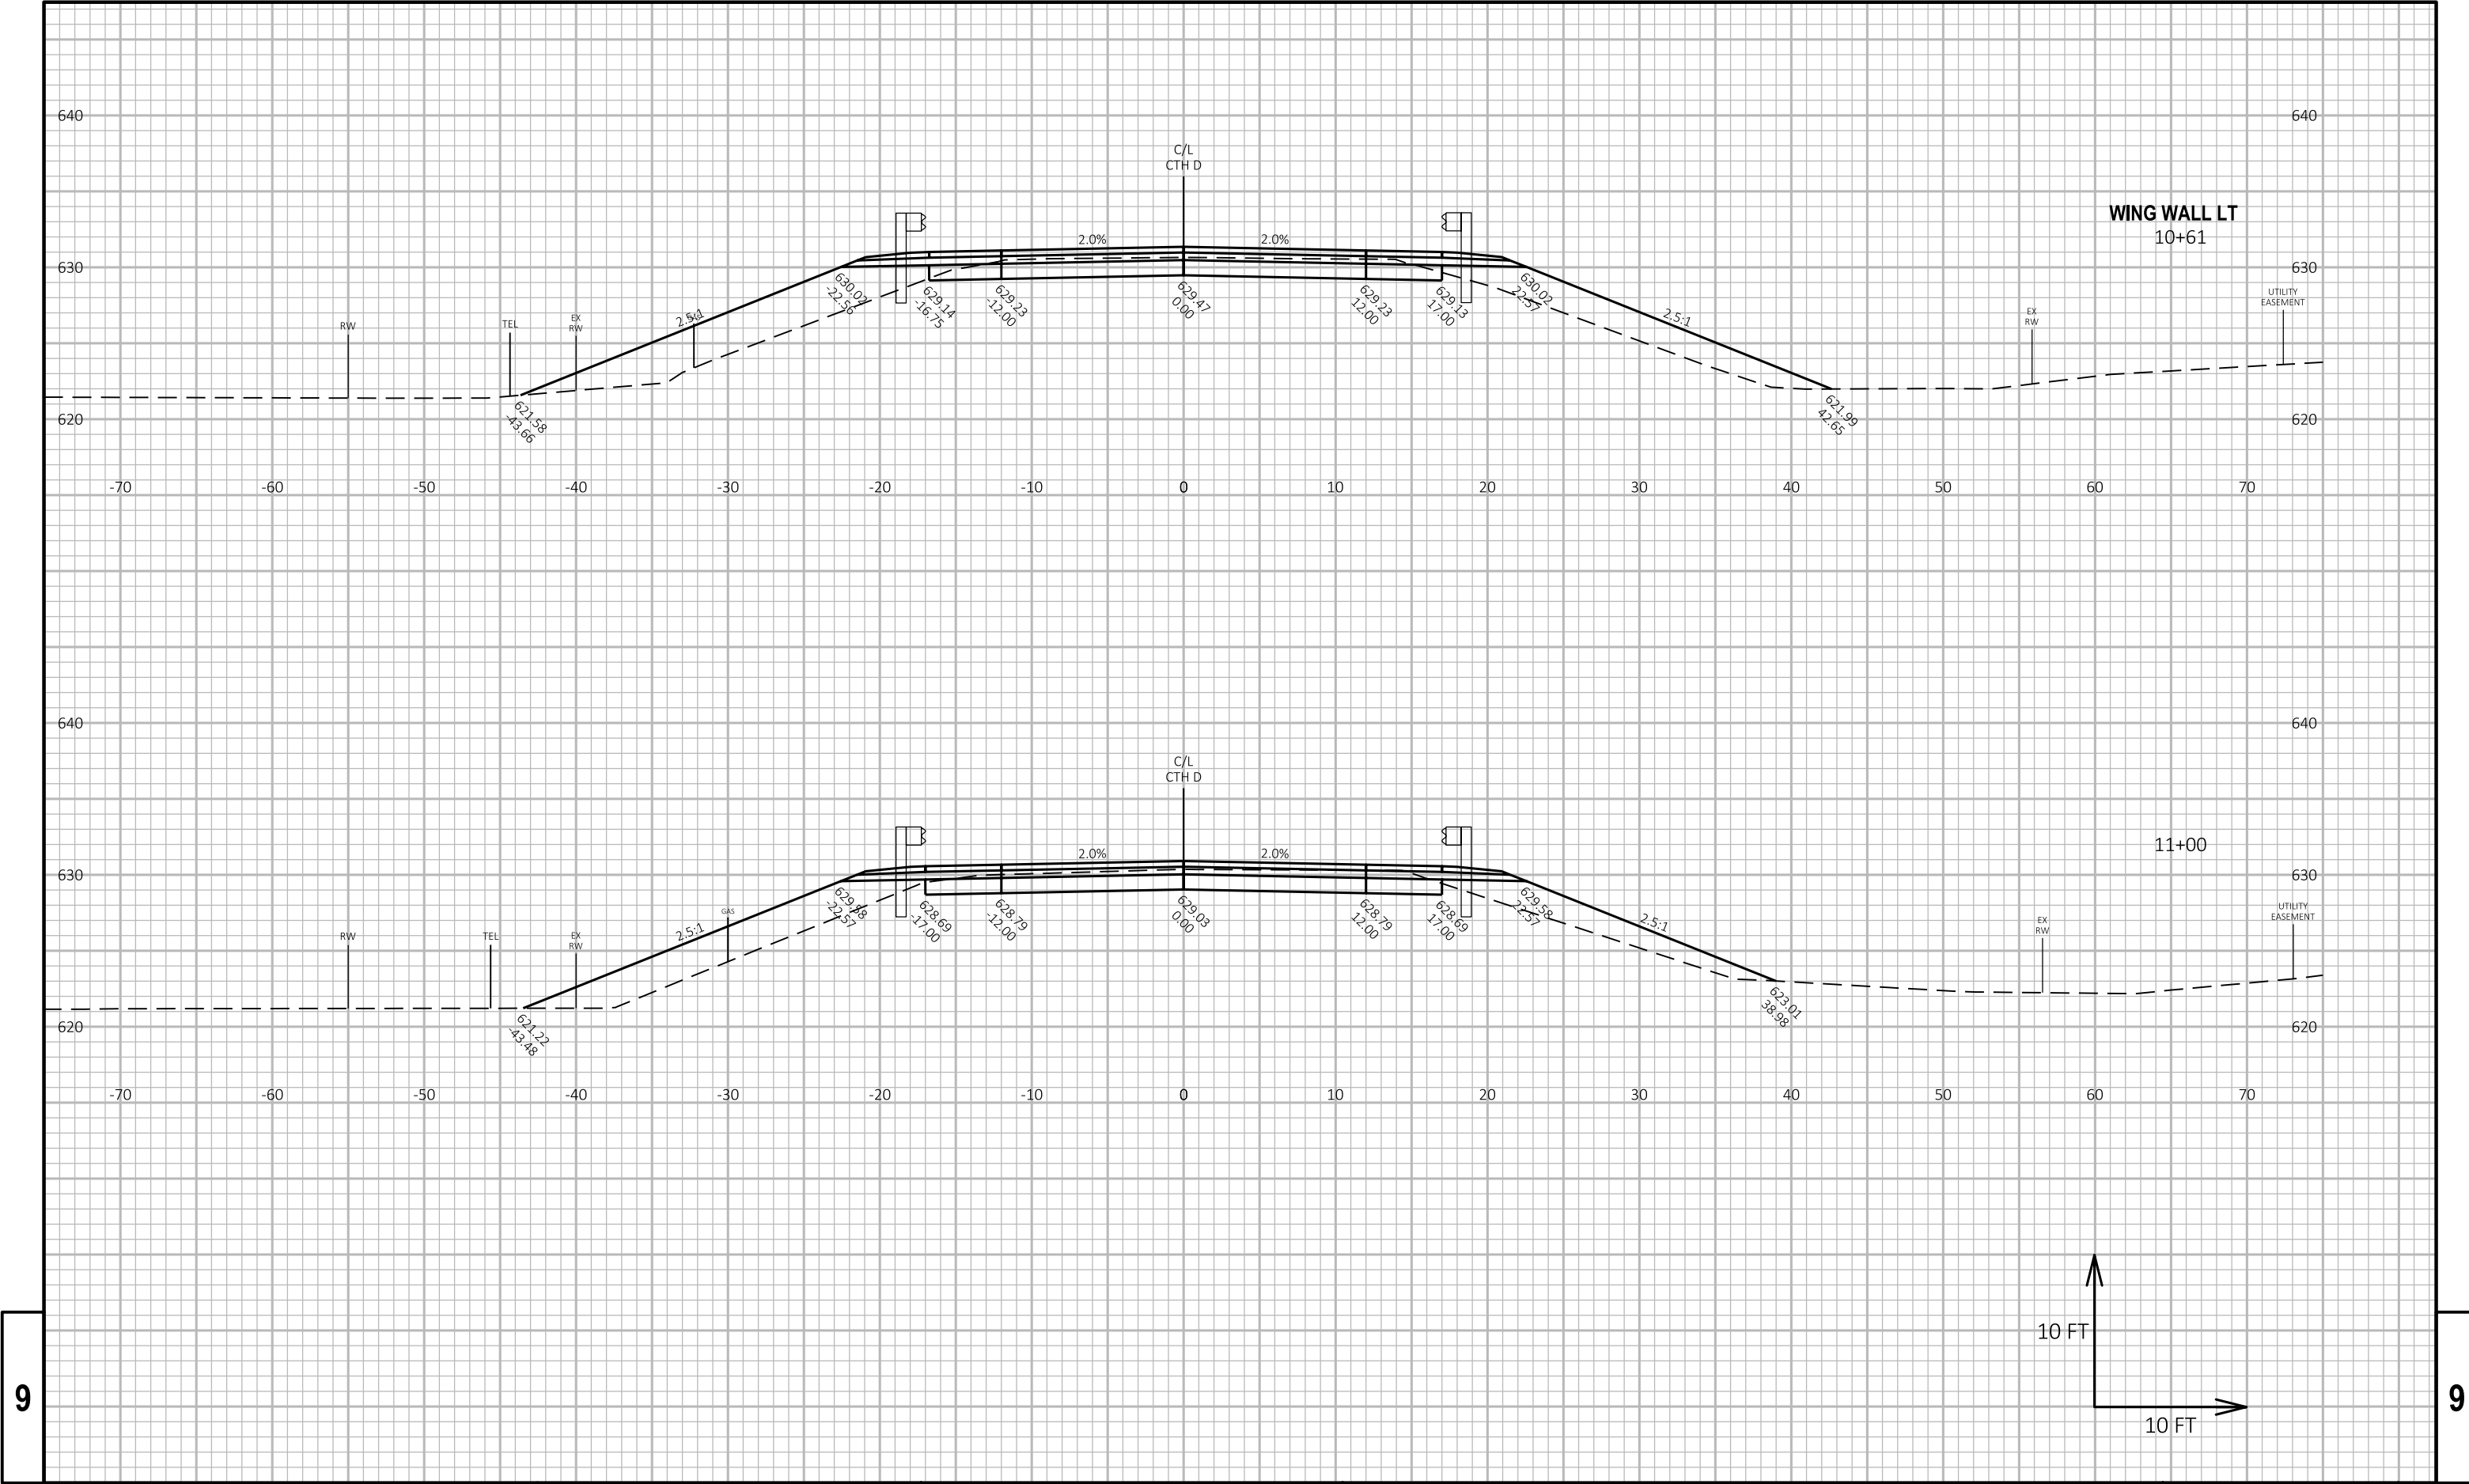


9


9

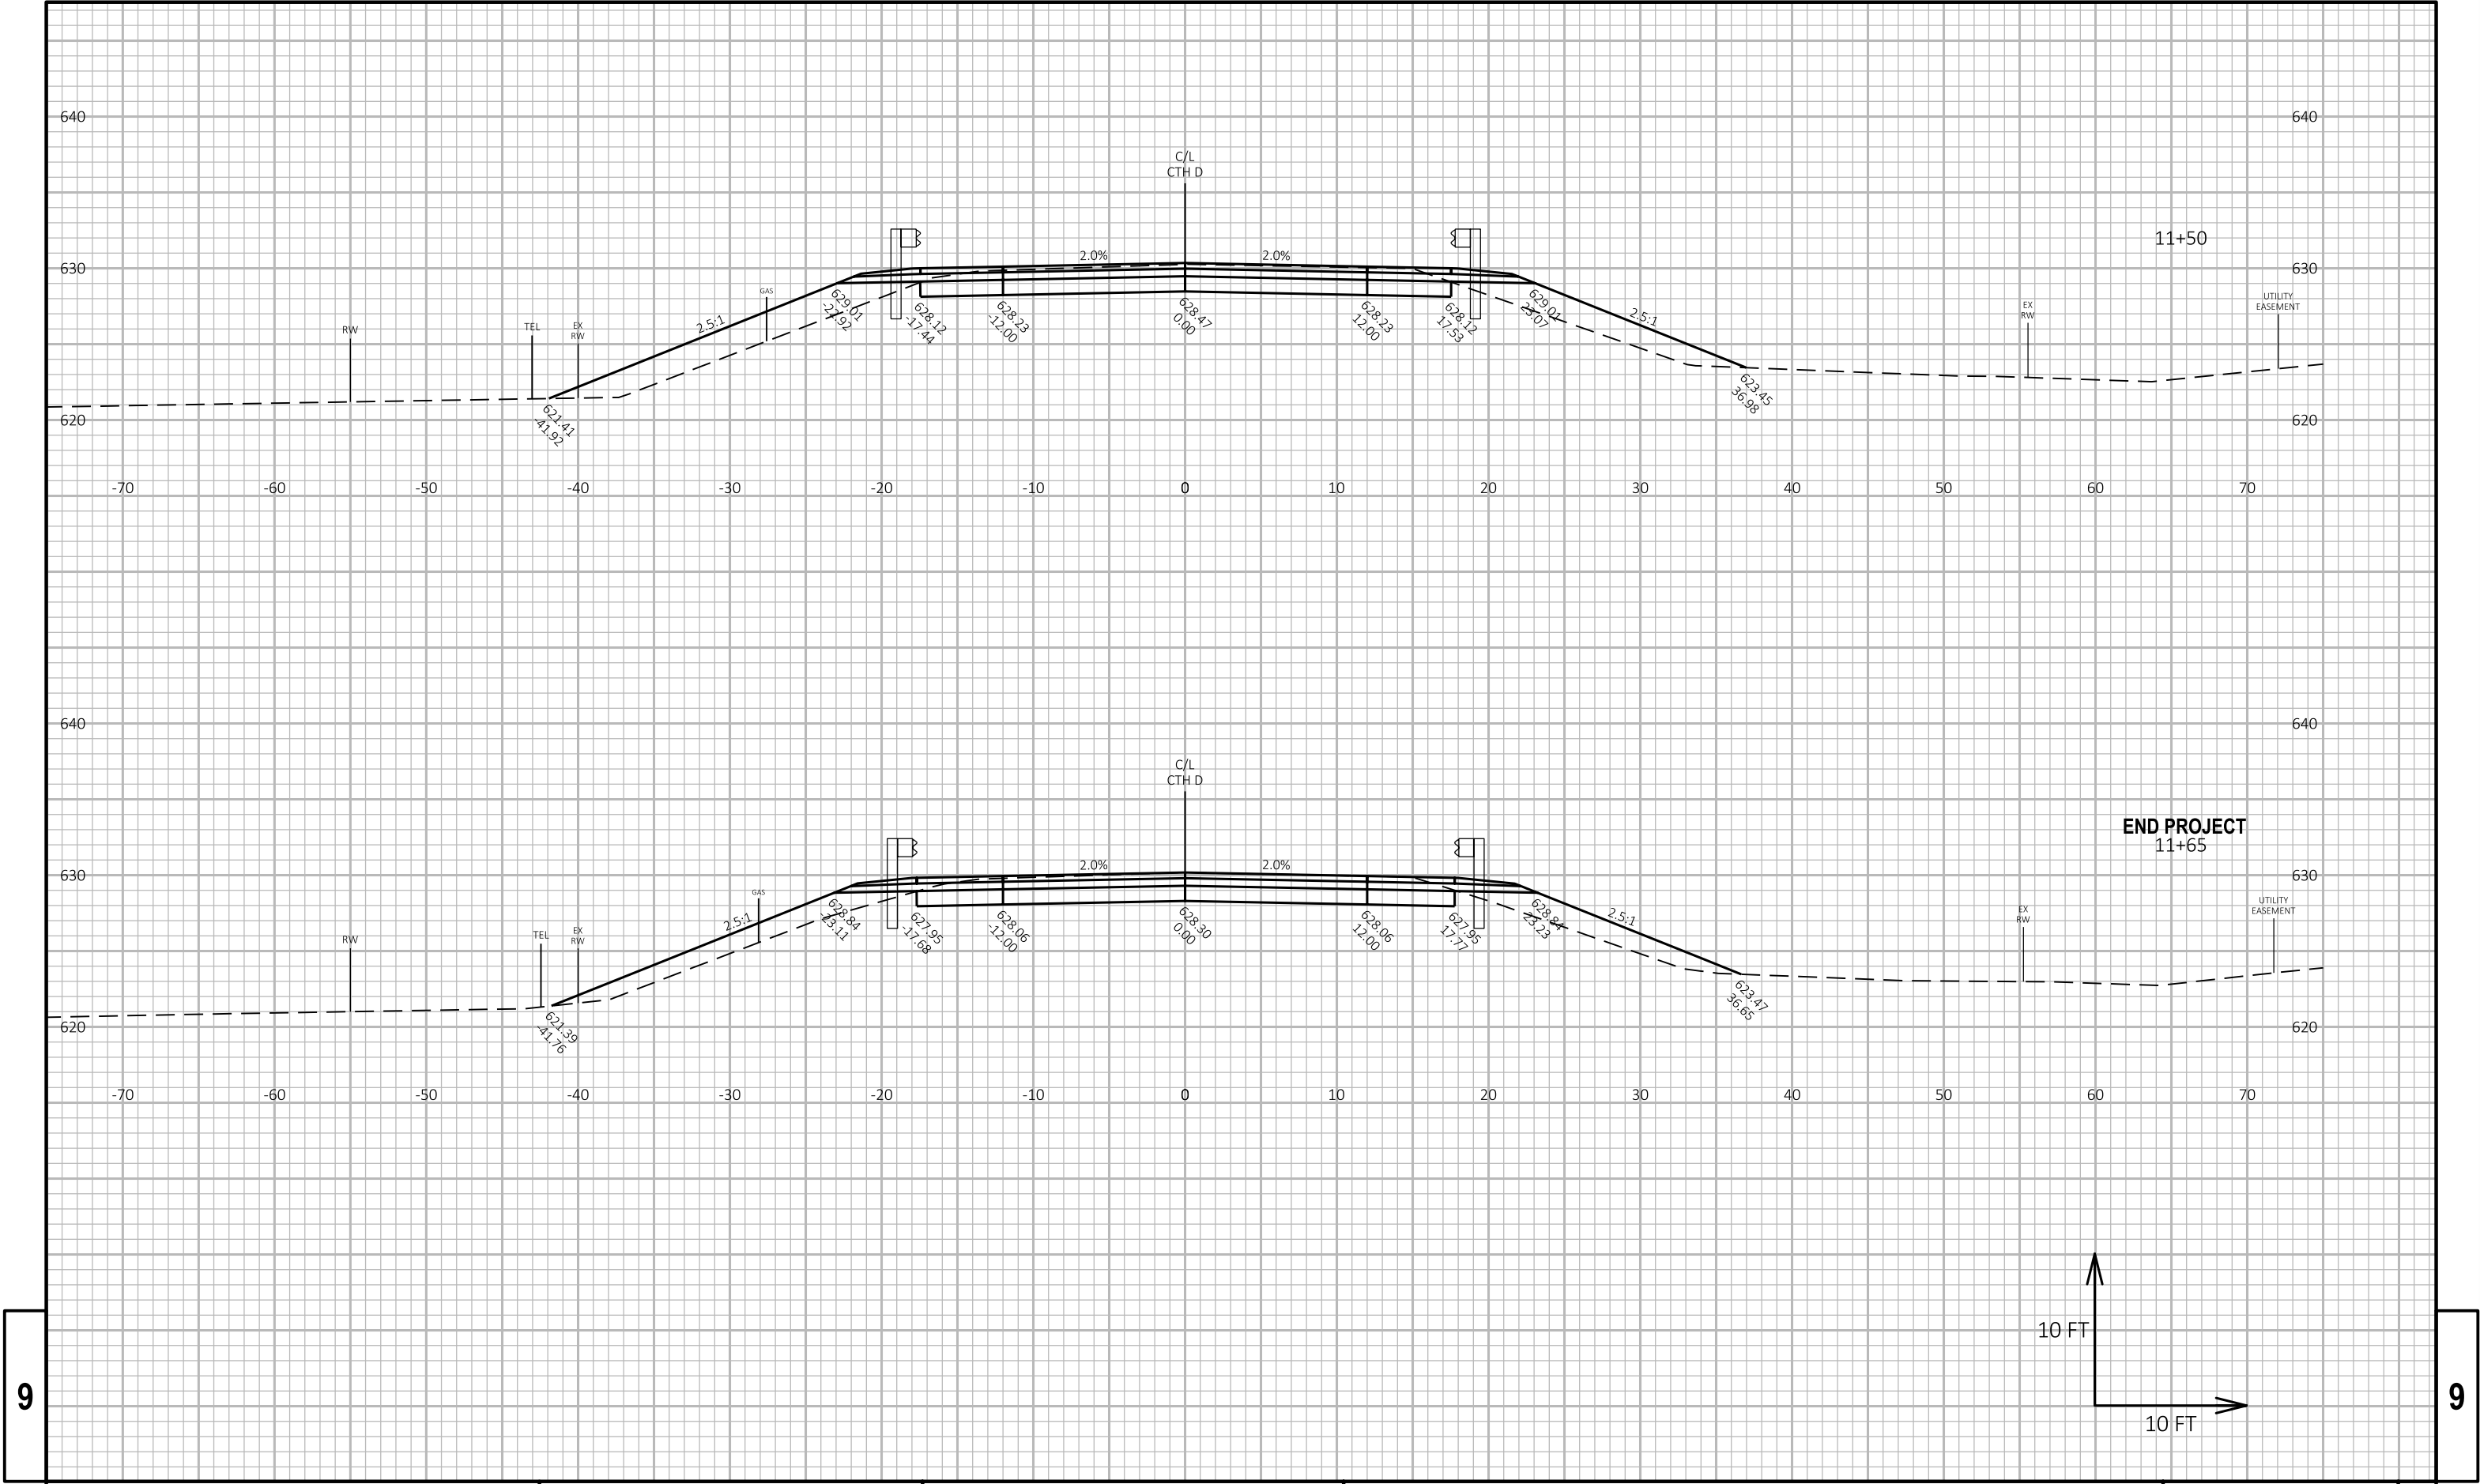

9


9

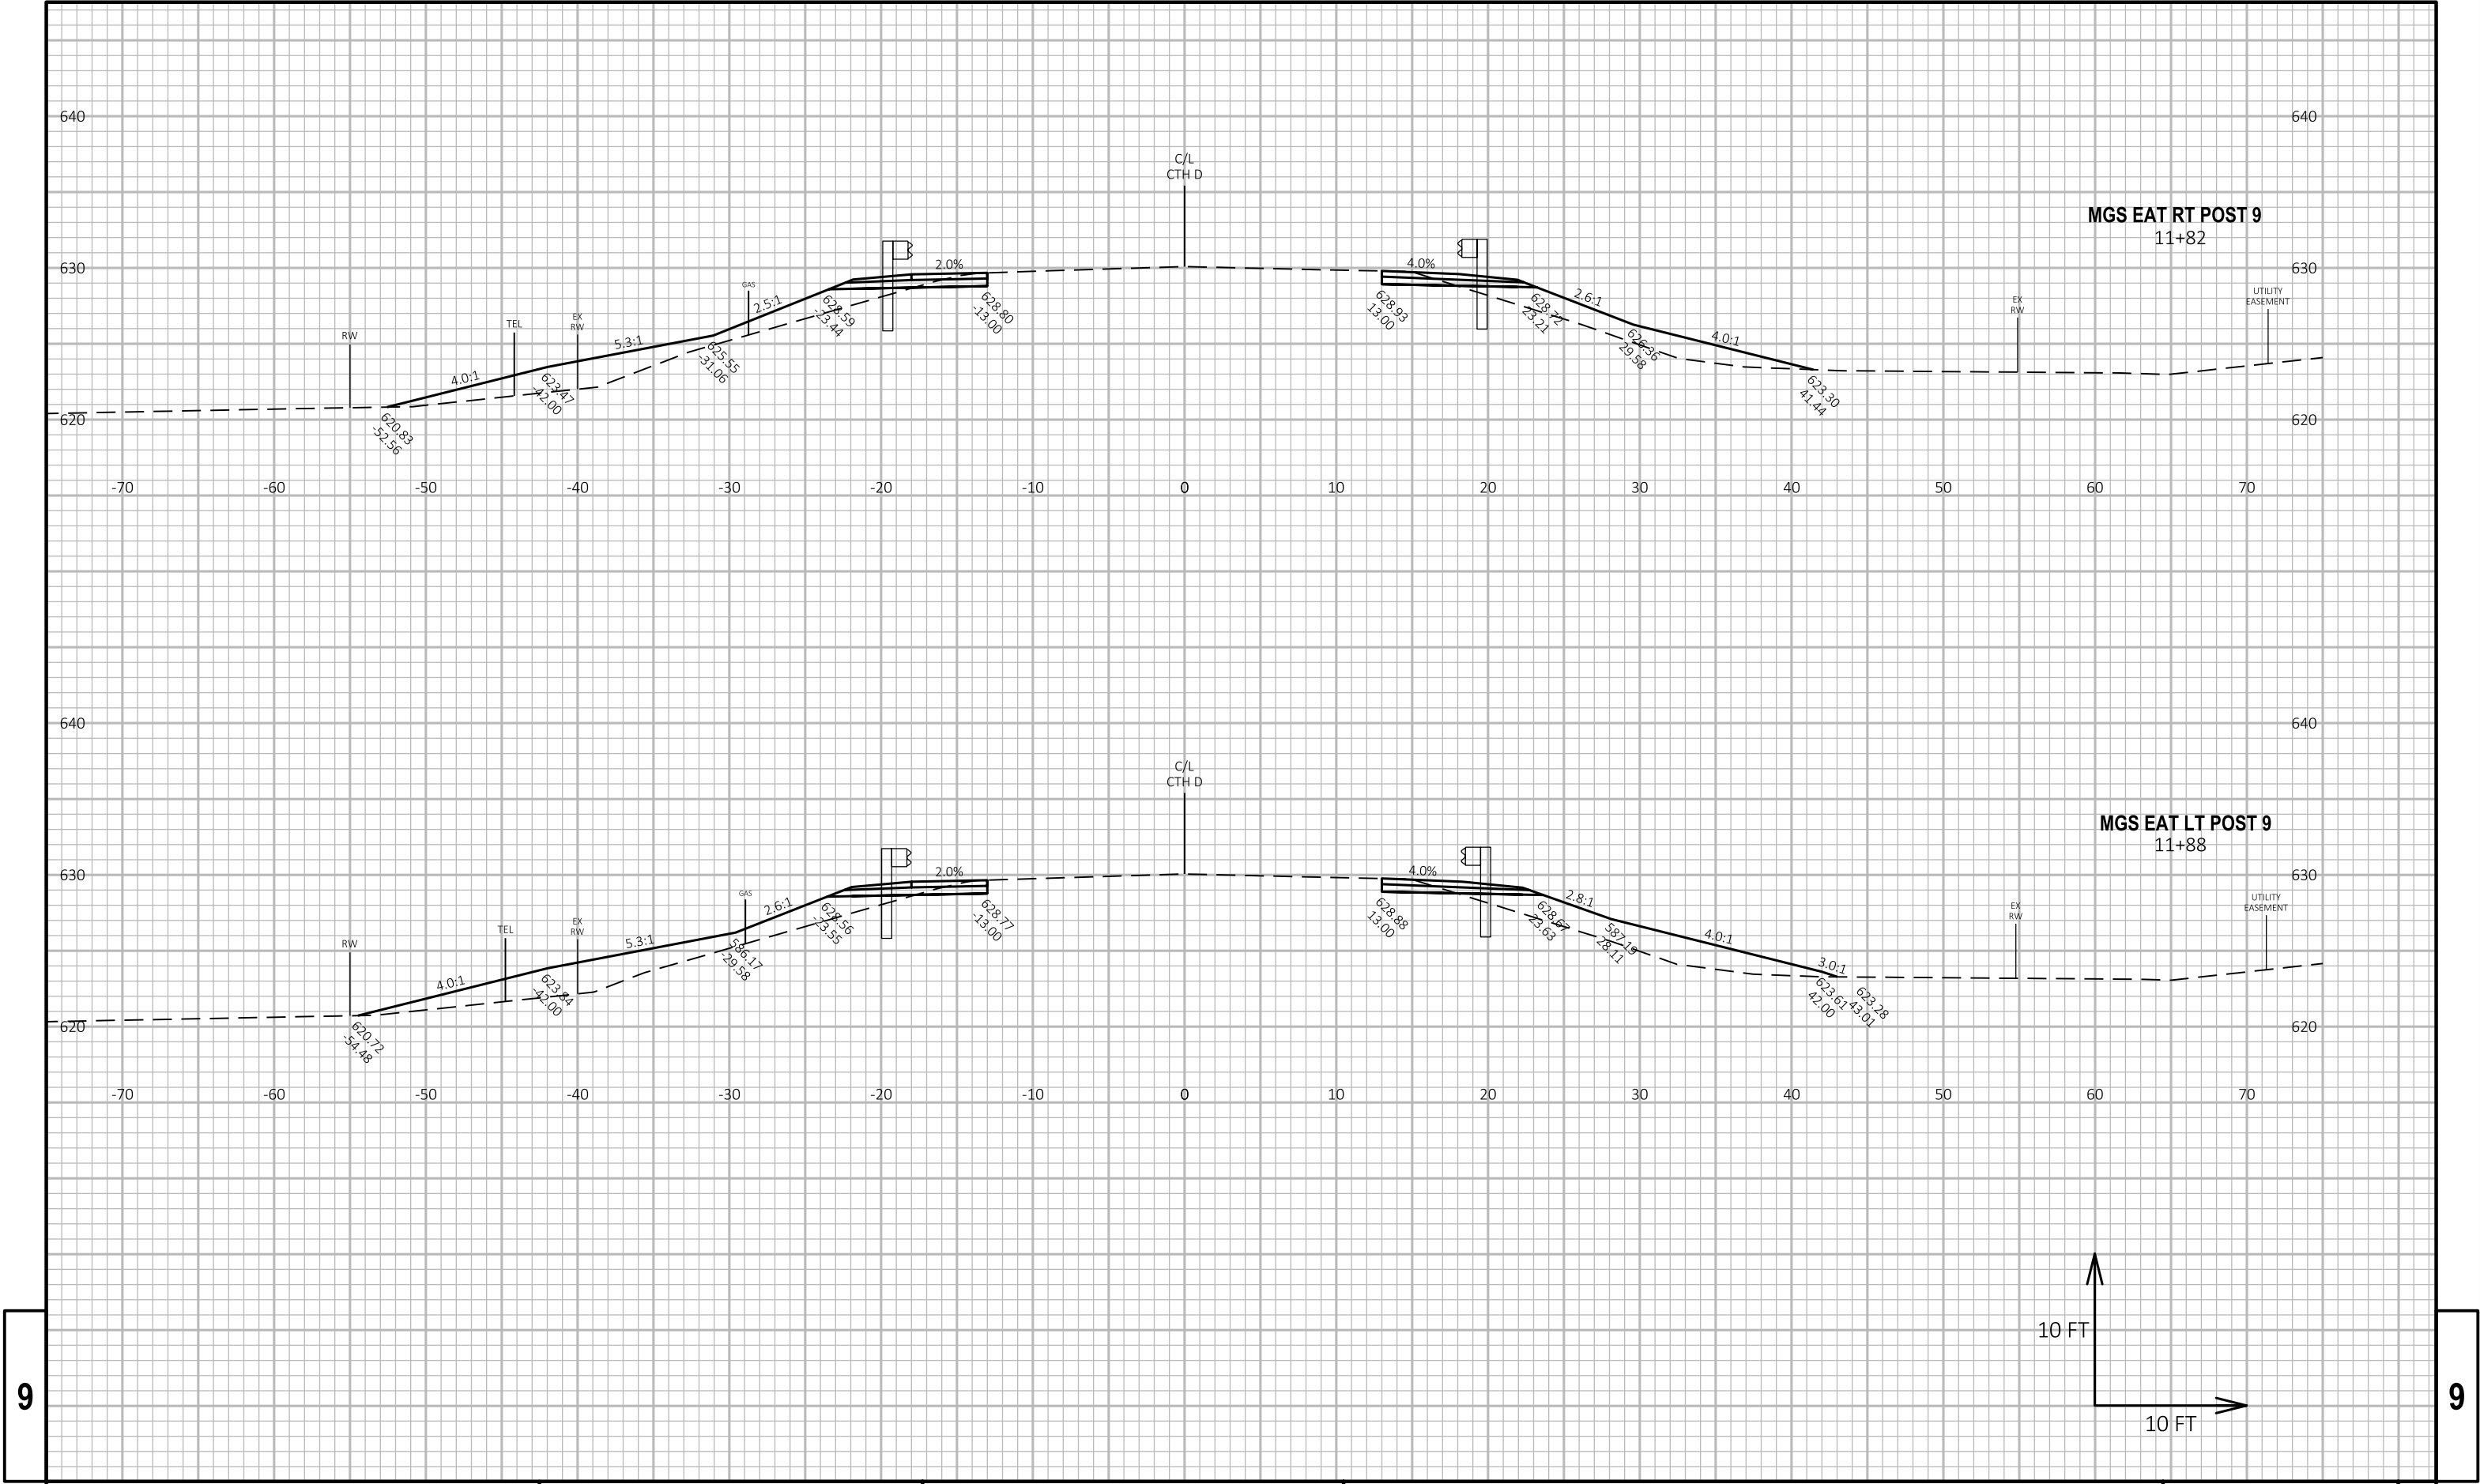

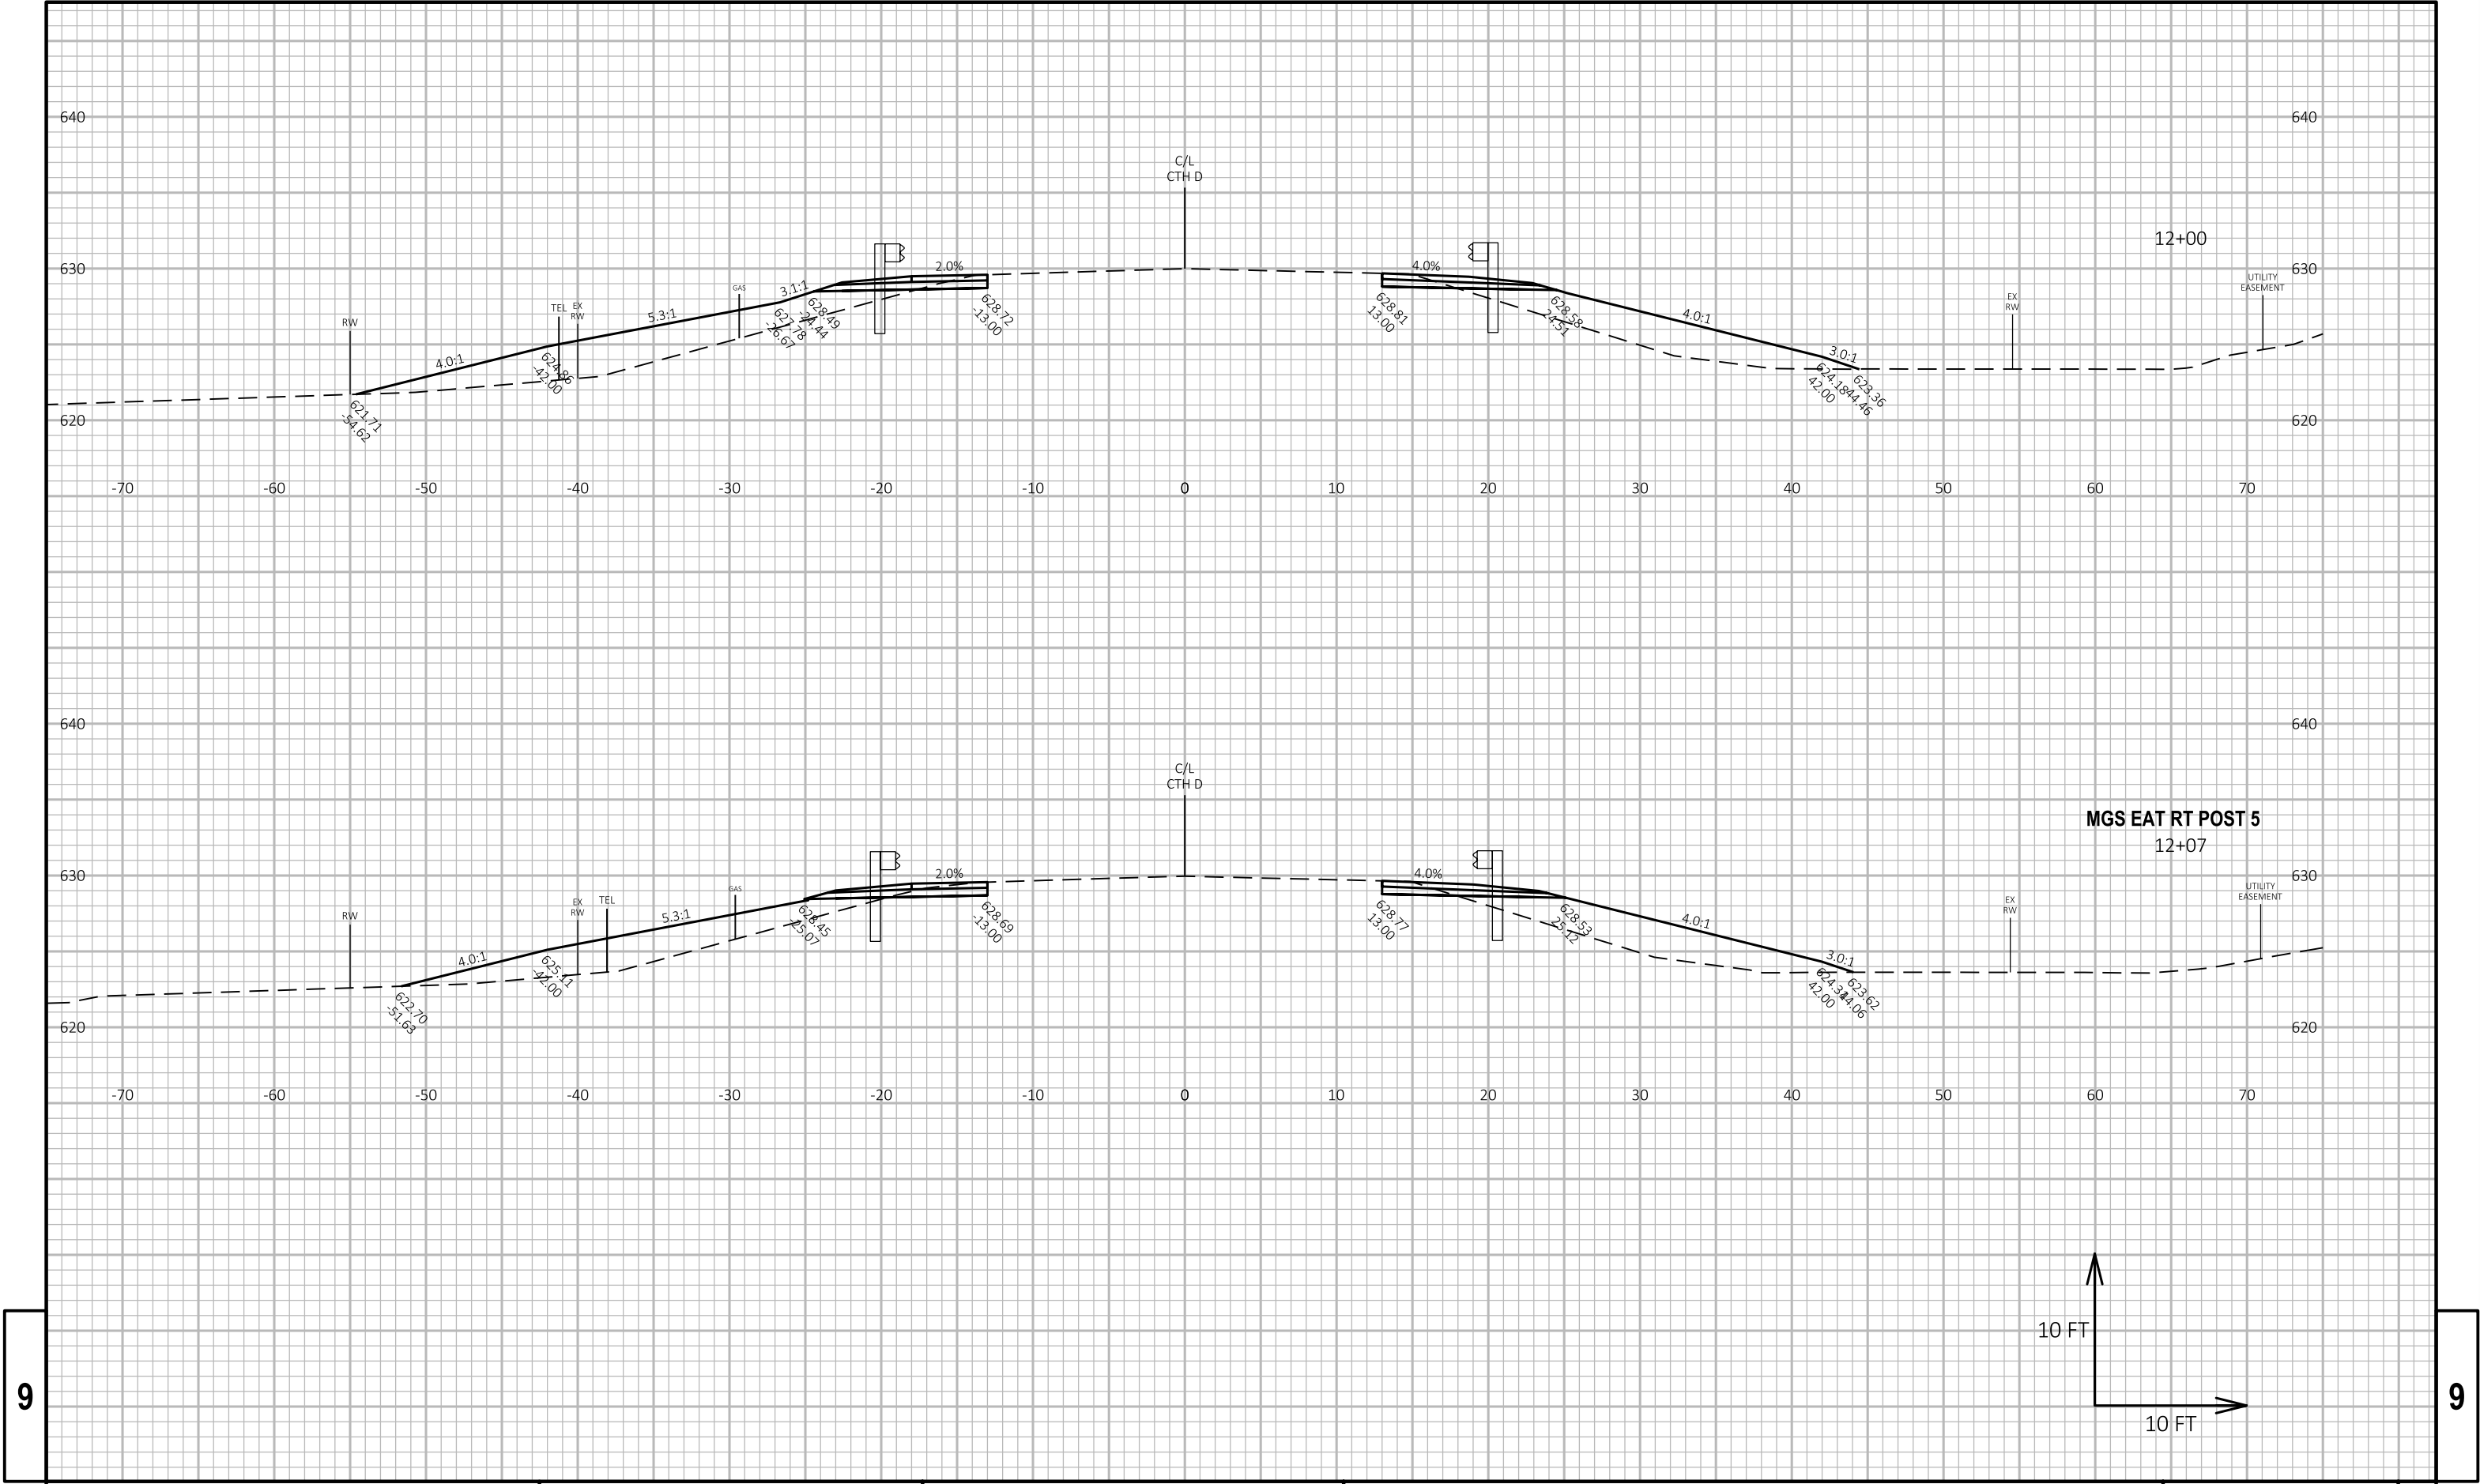


9


9

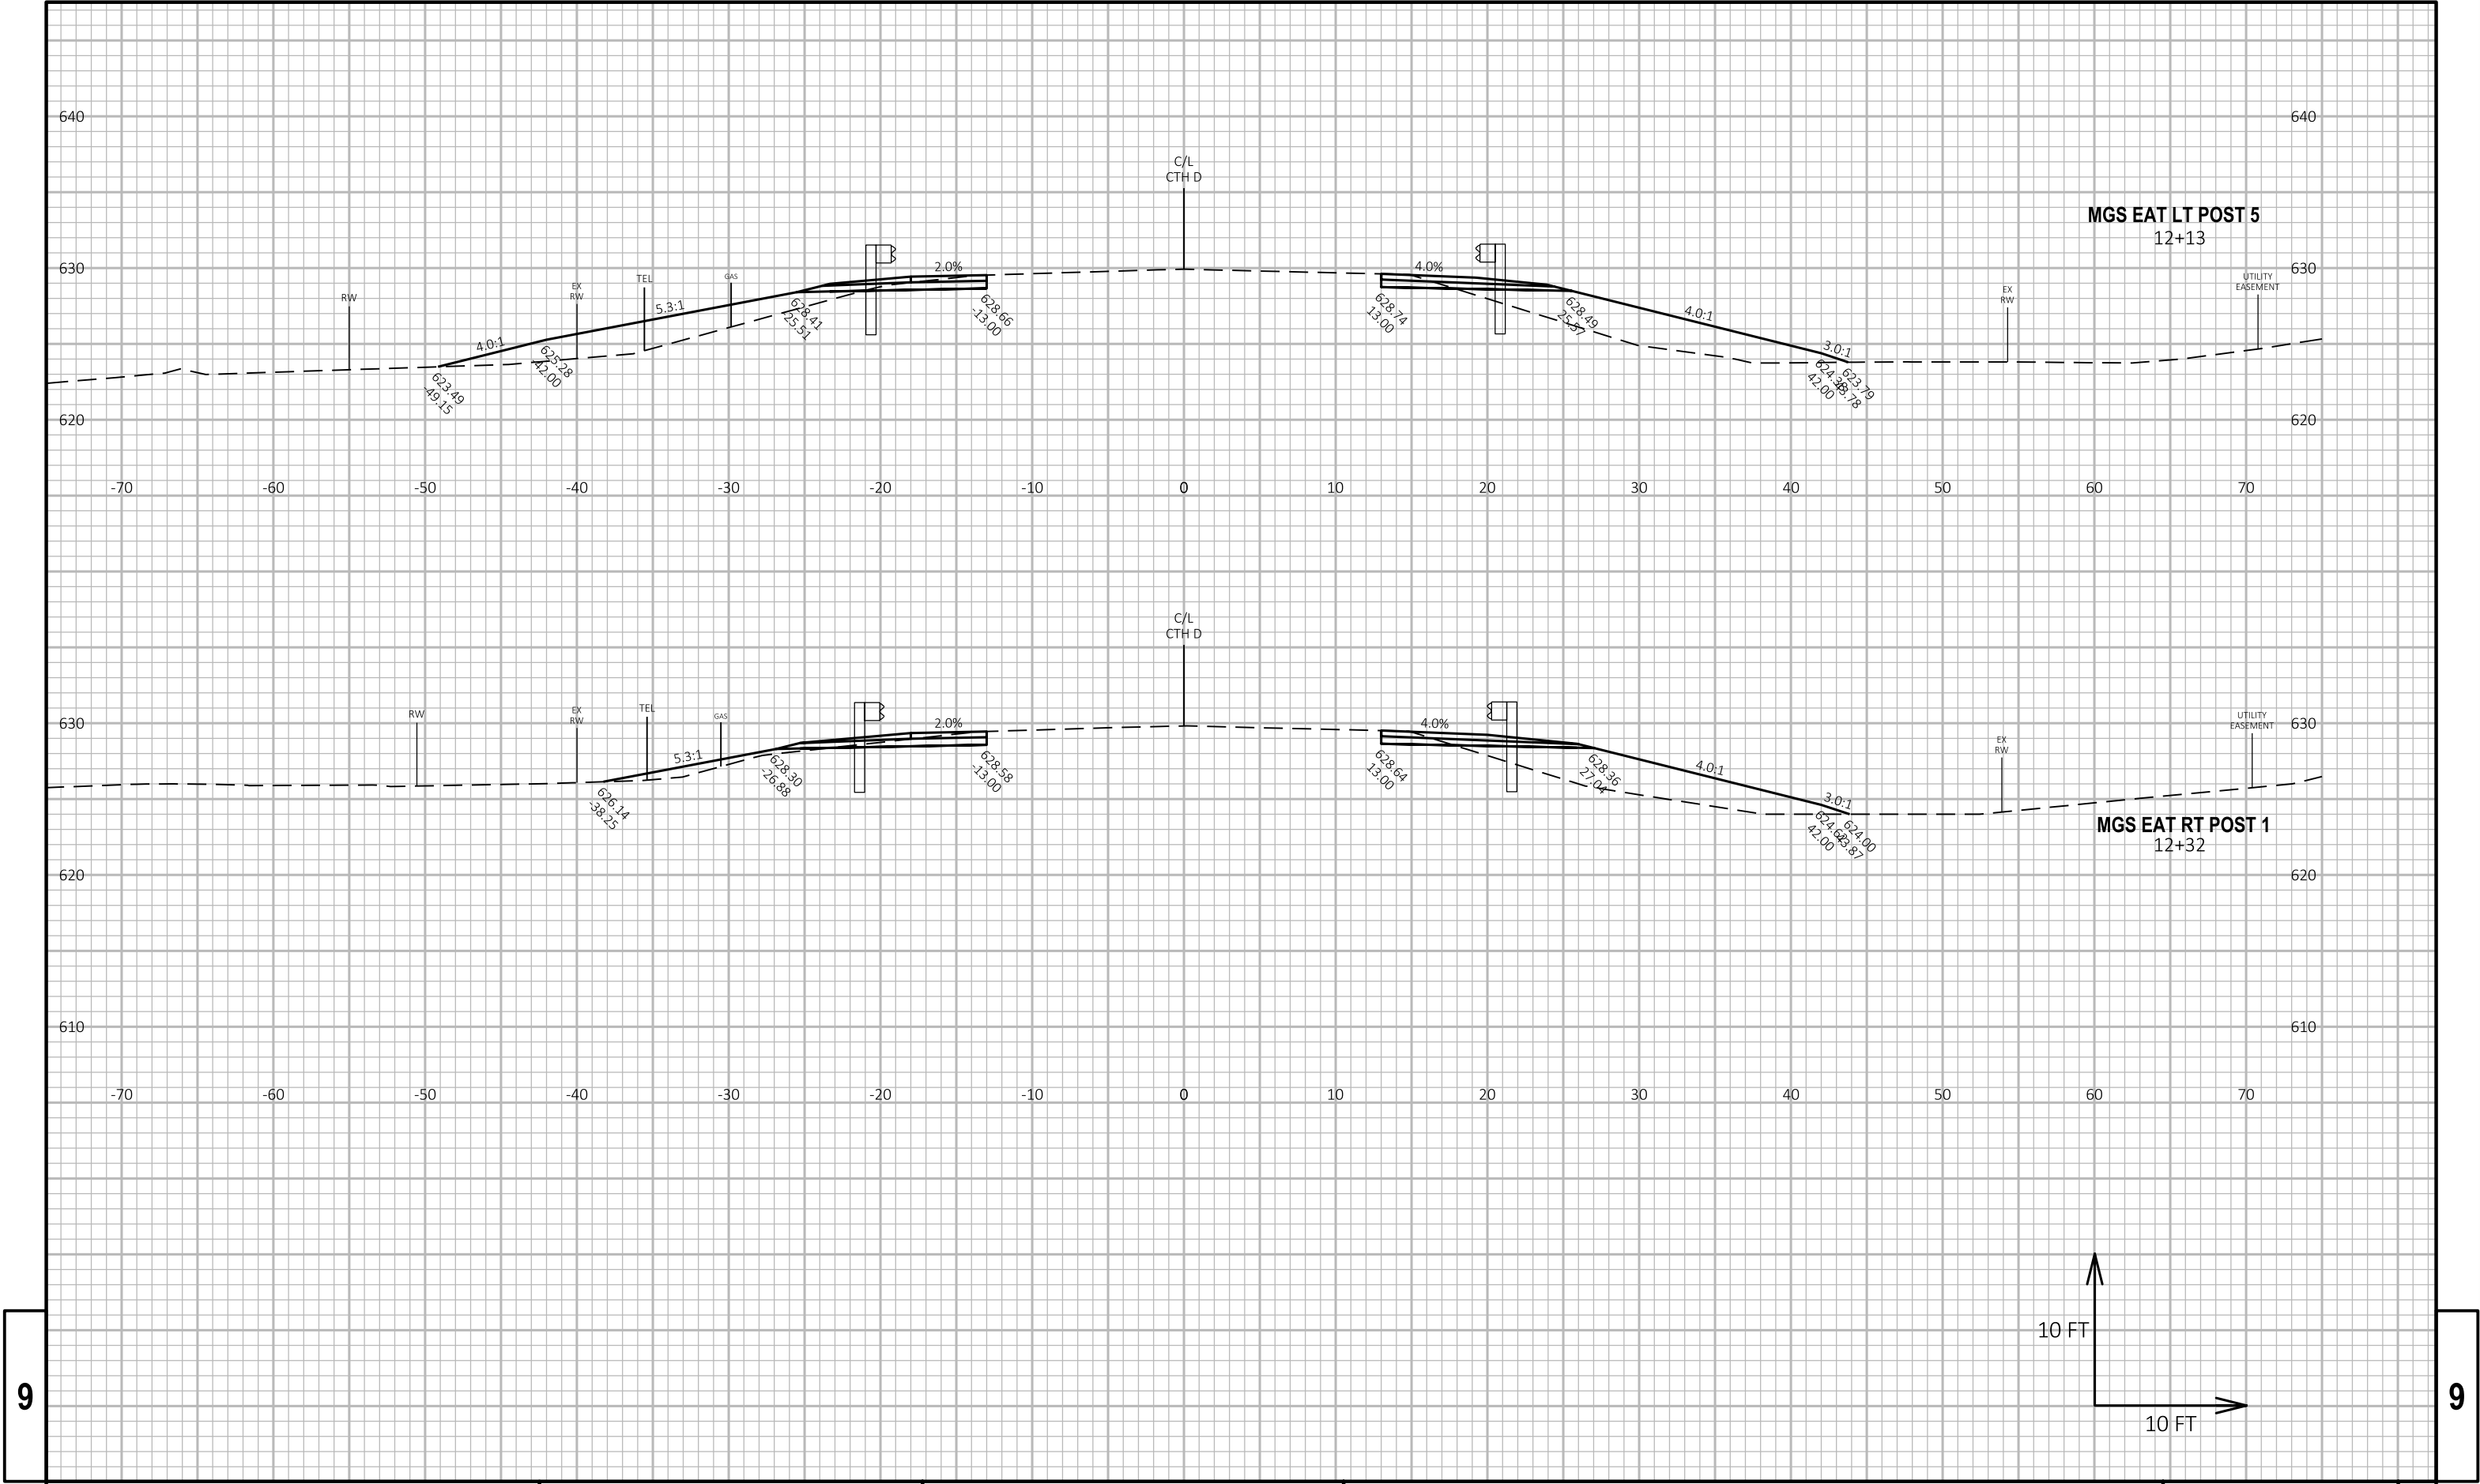

9


9

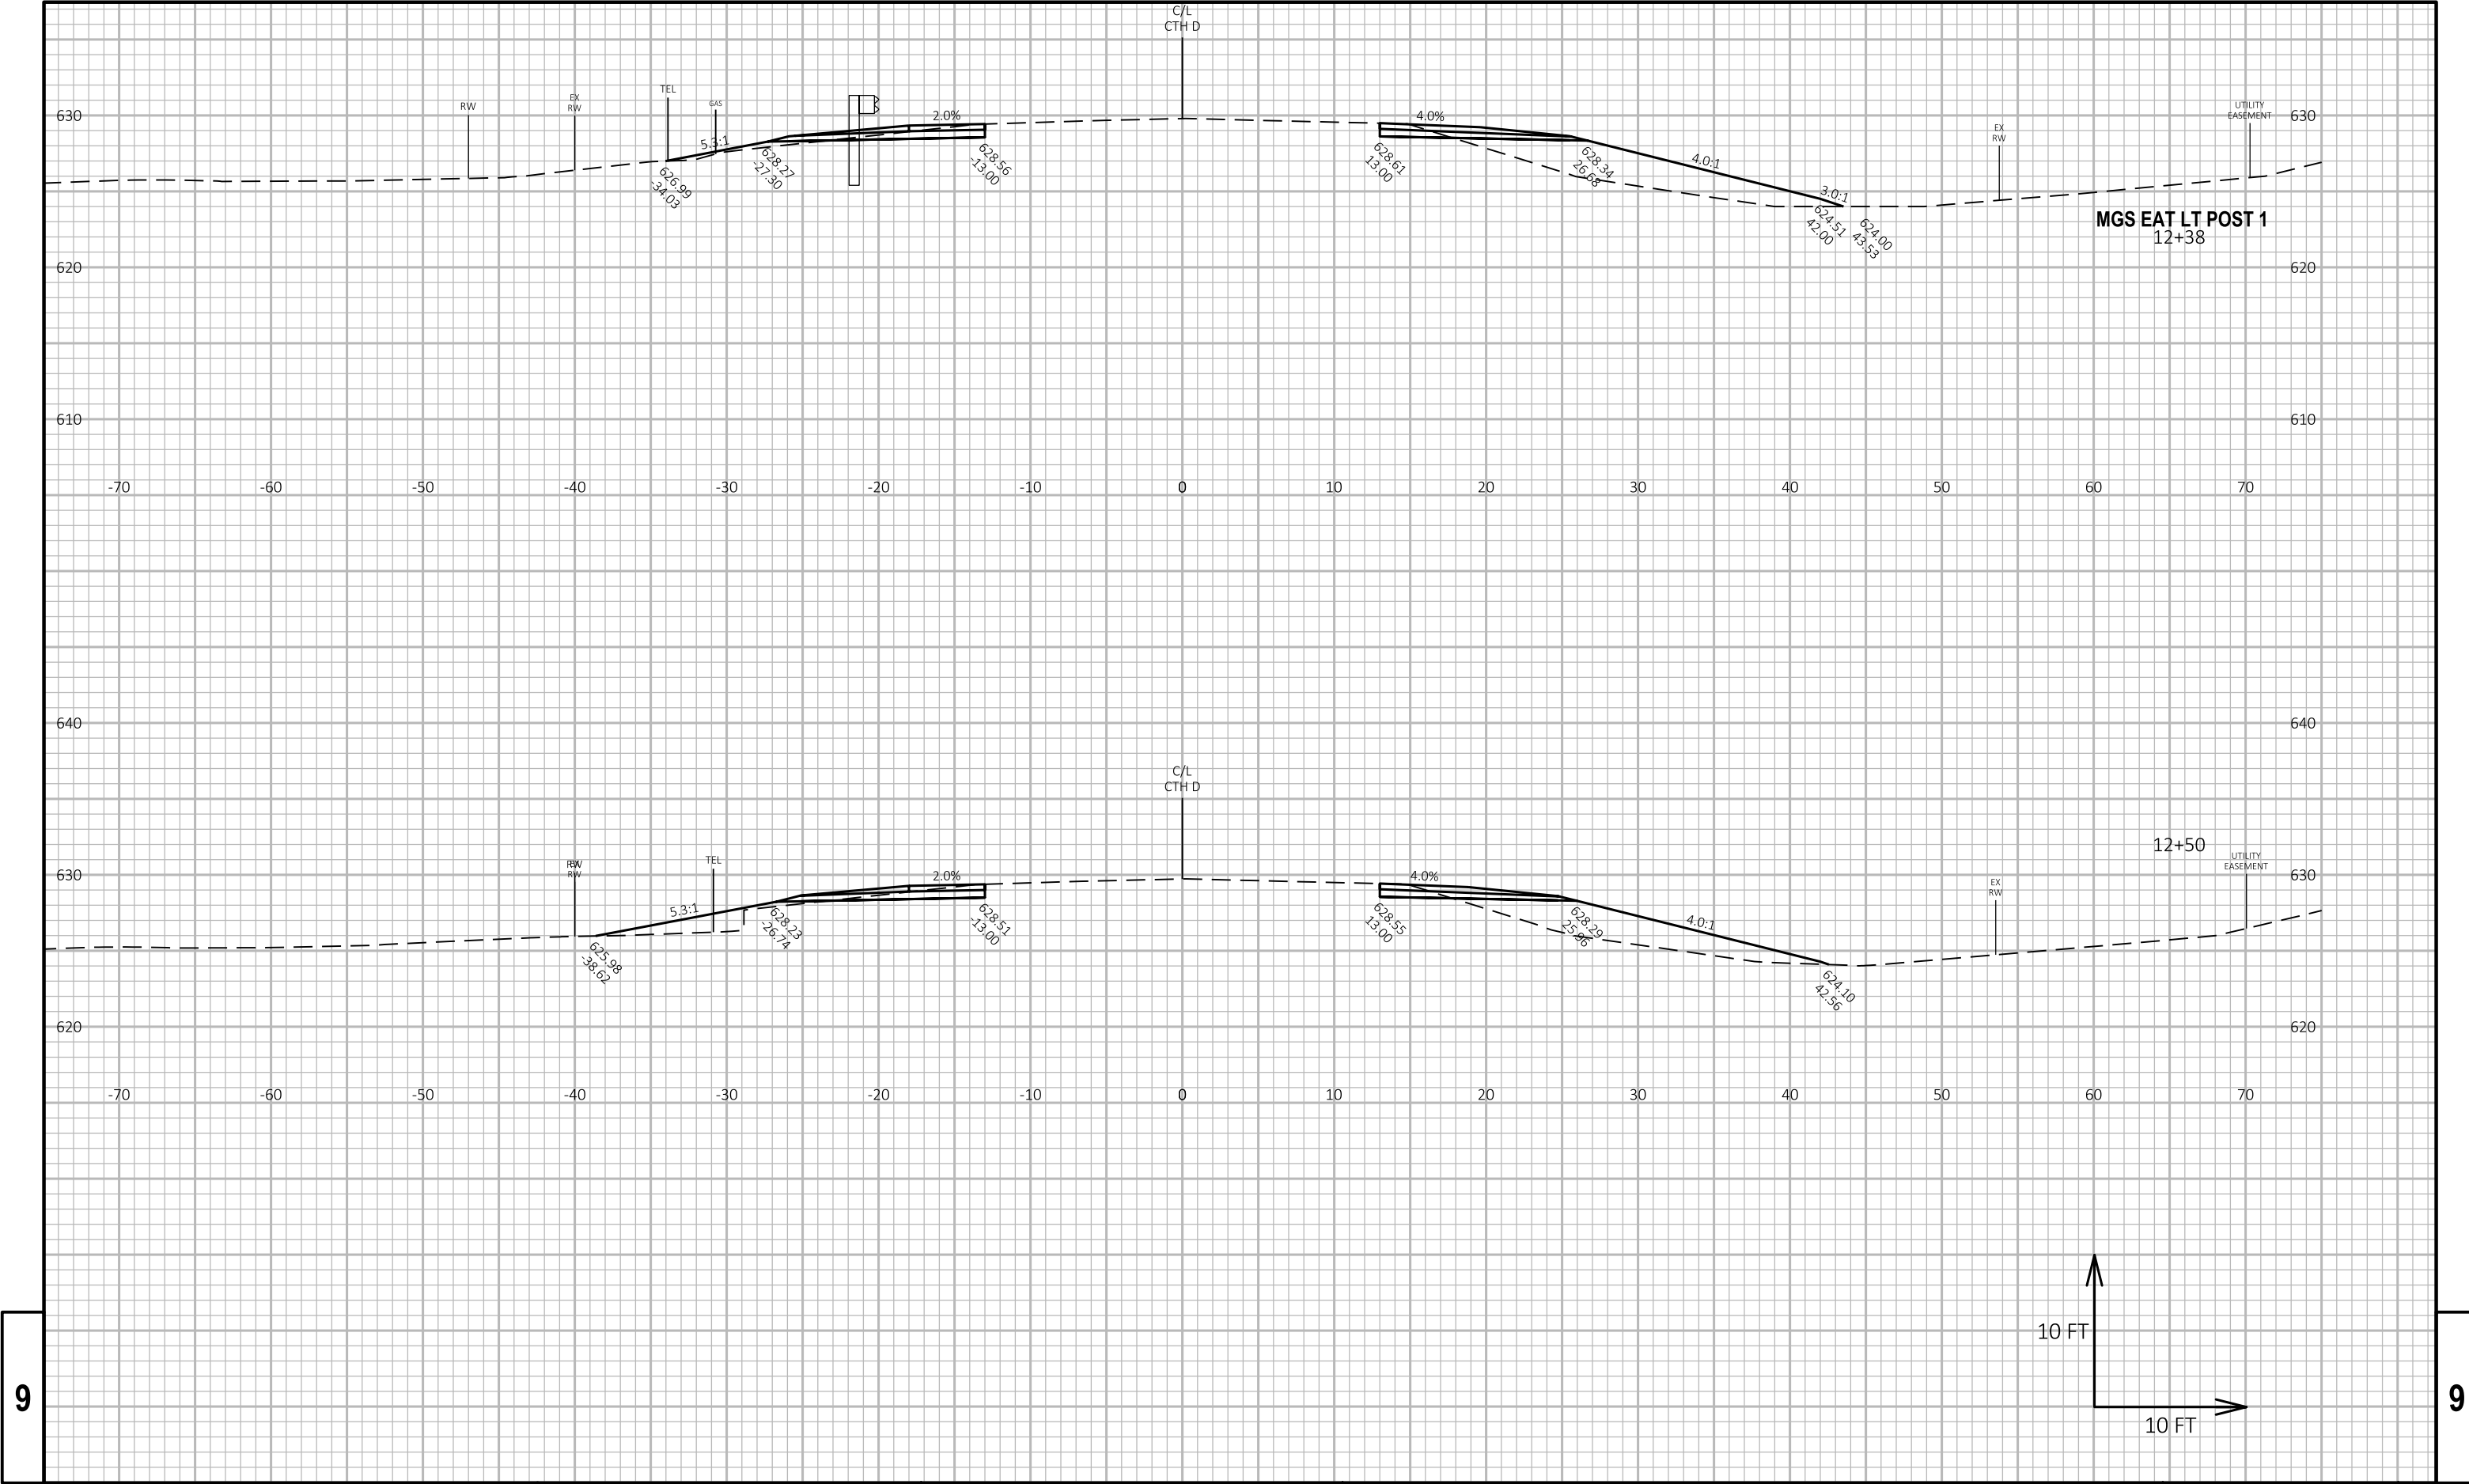

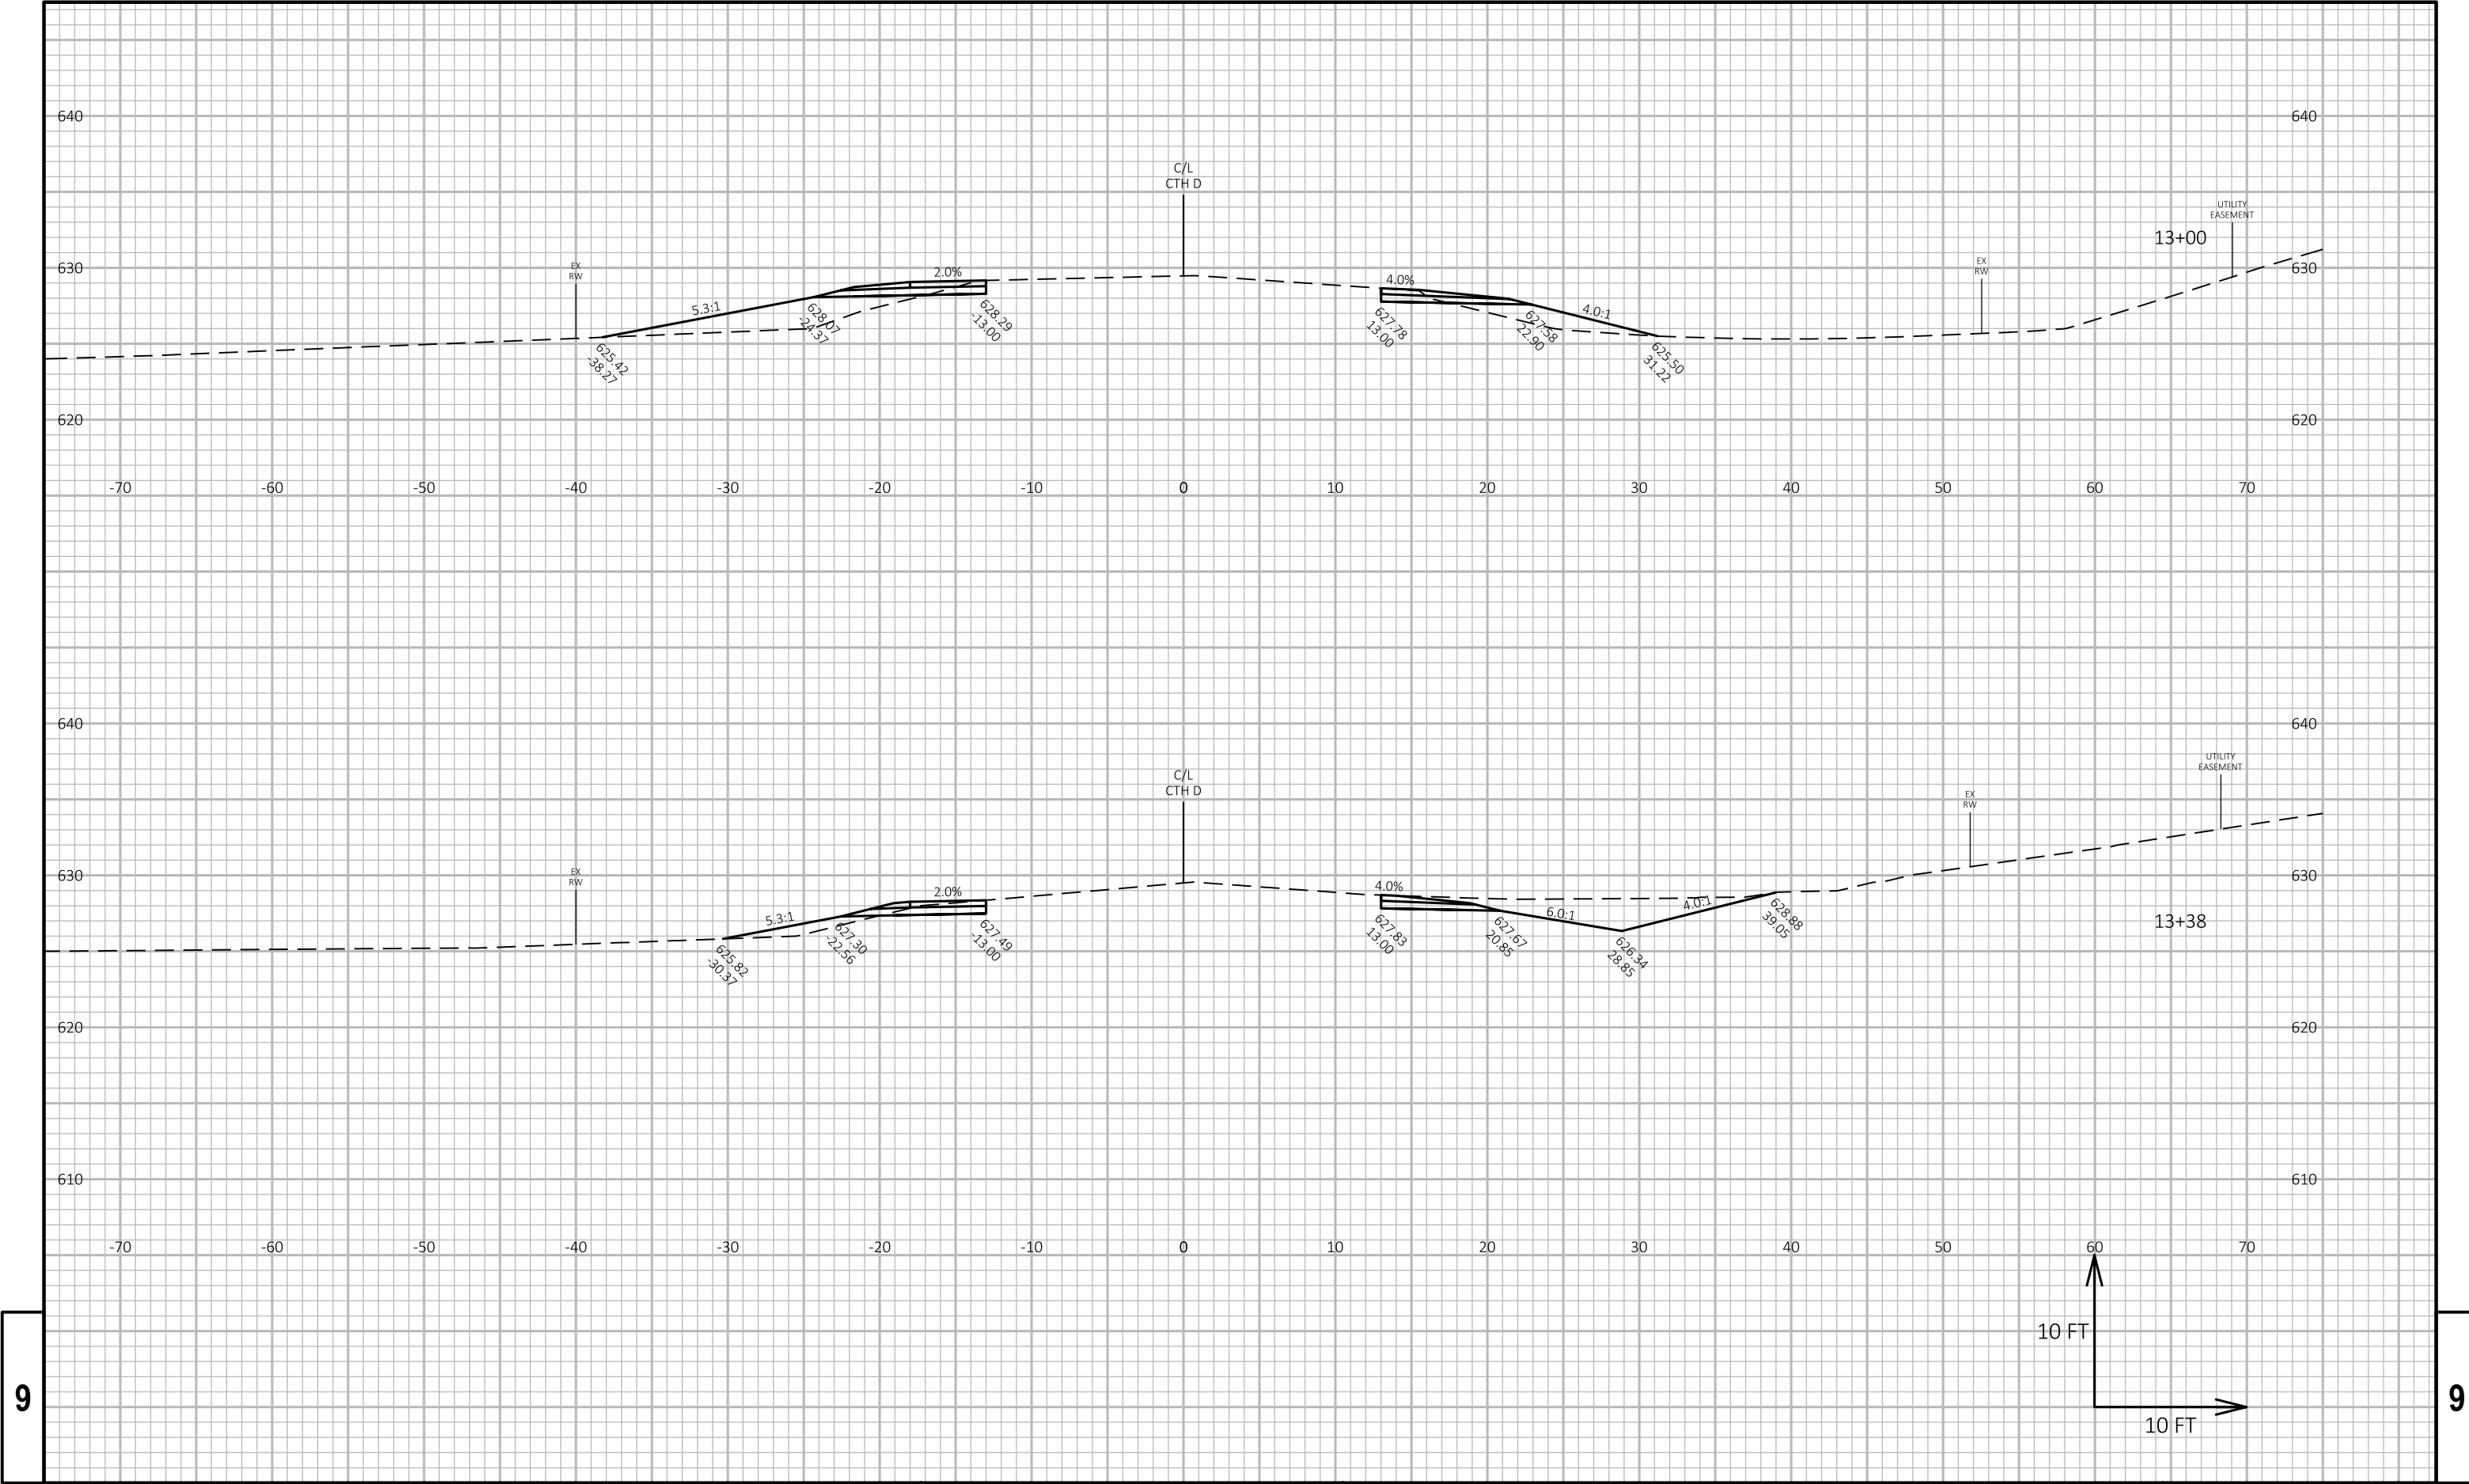

9

9

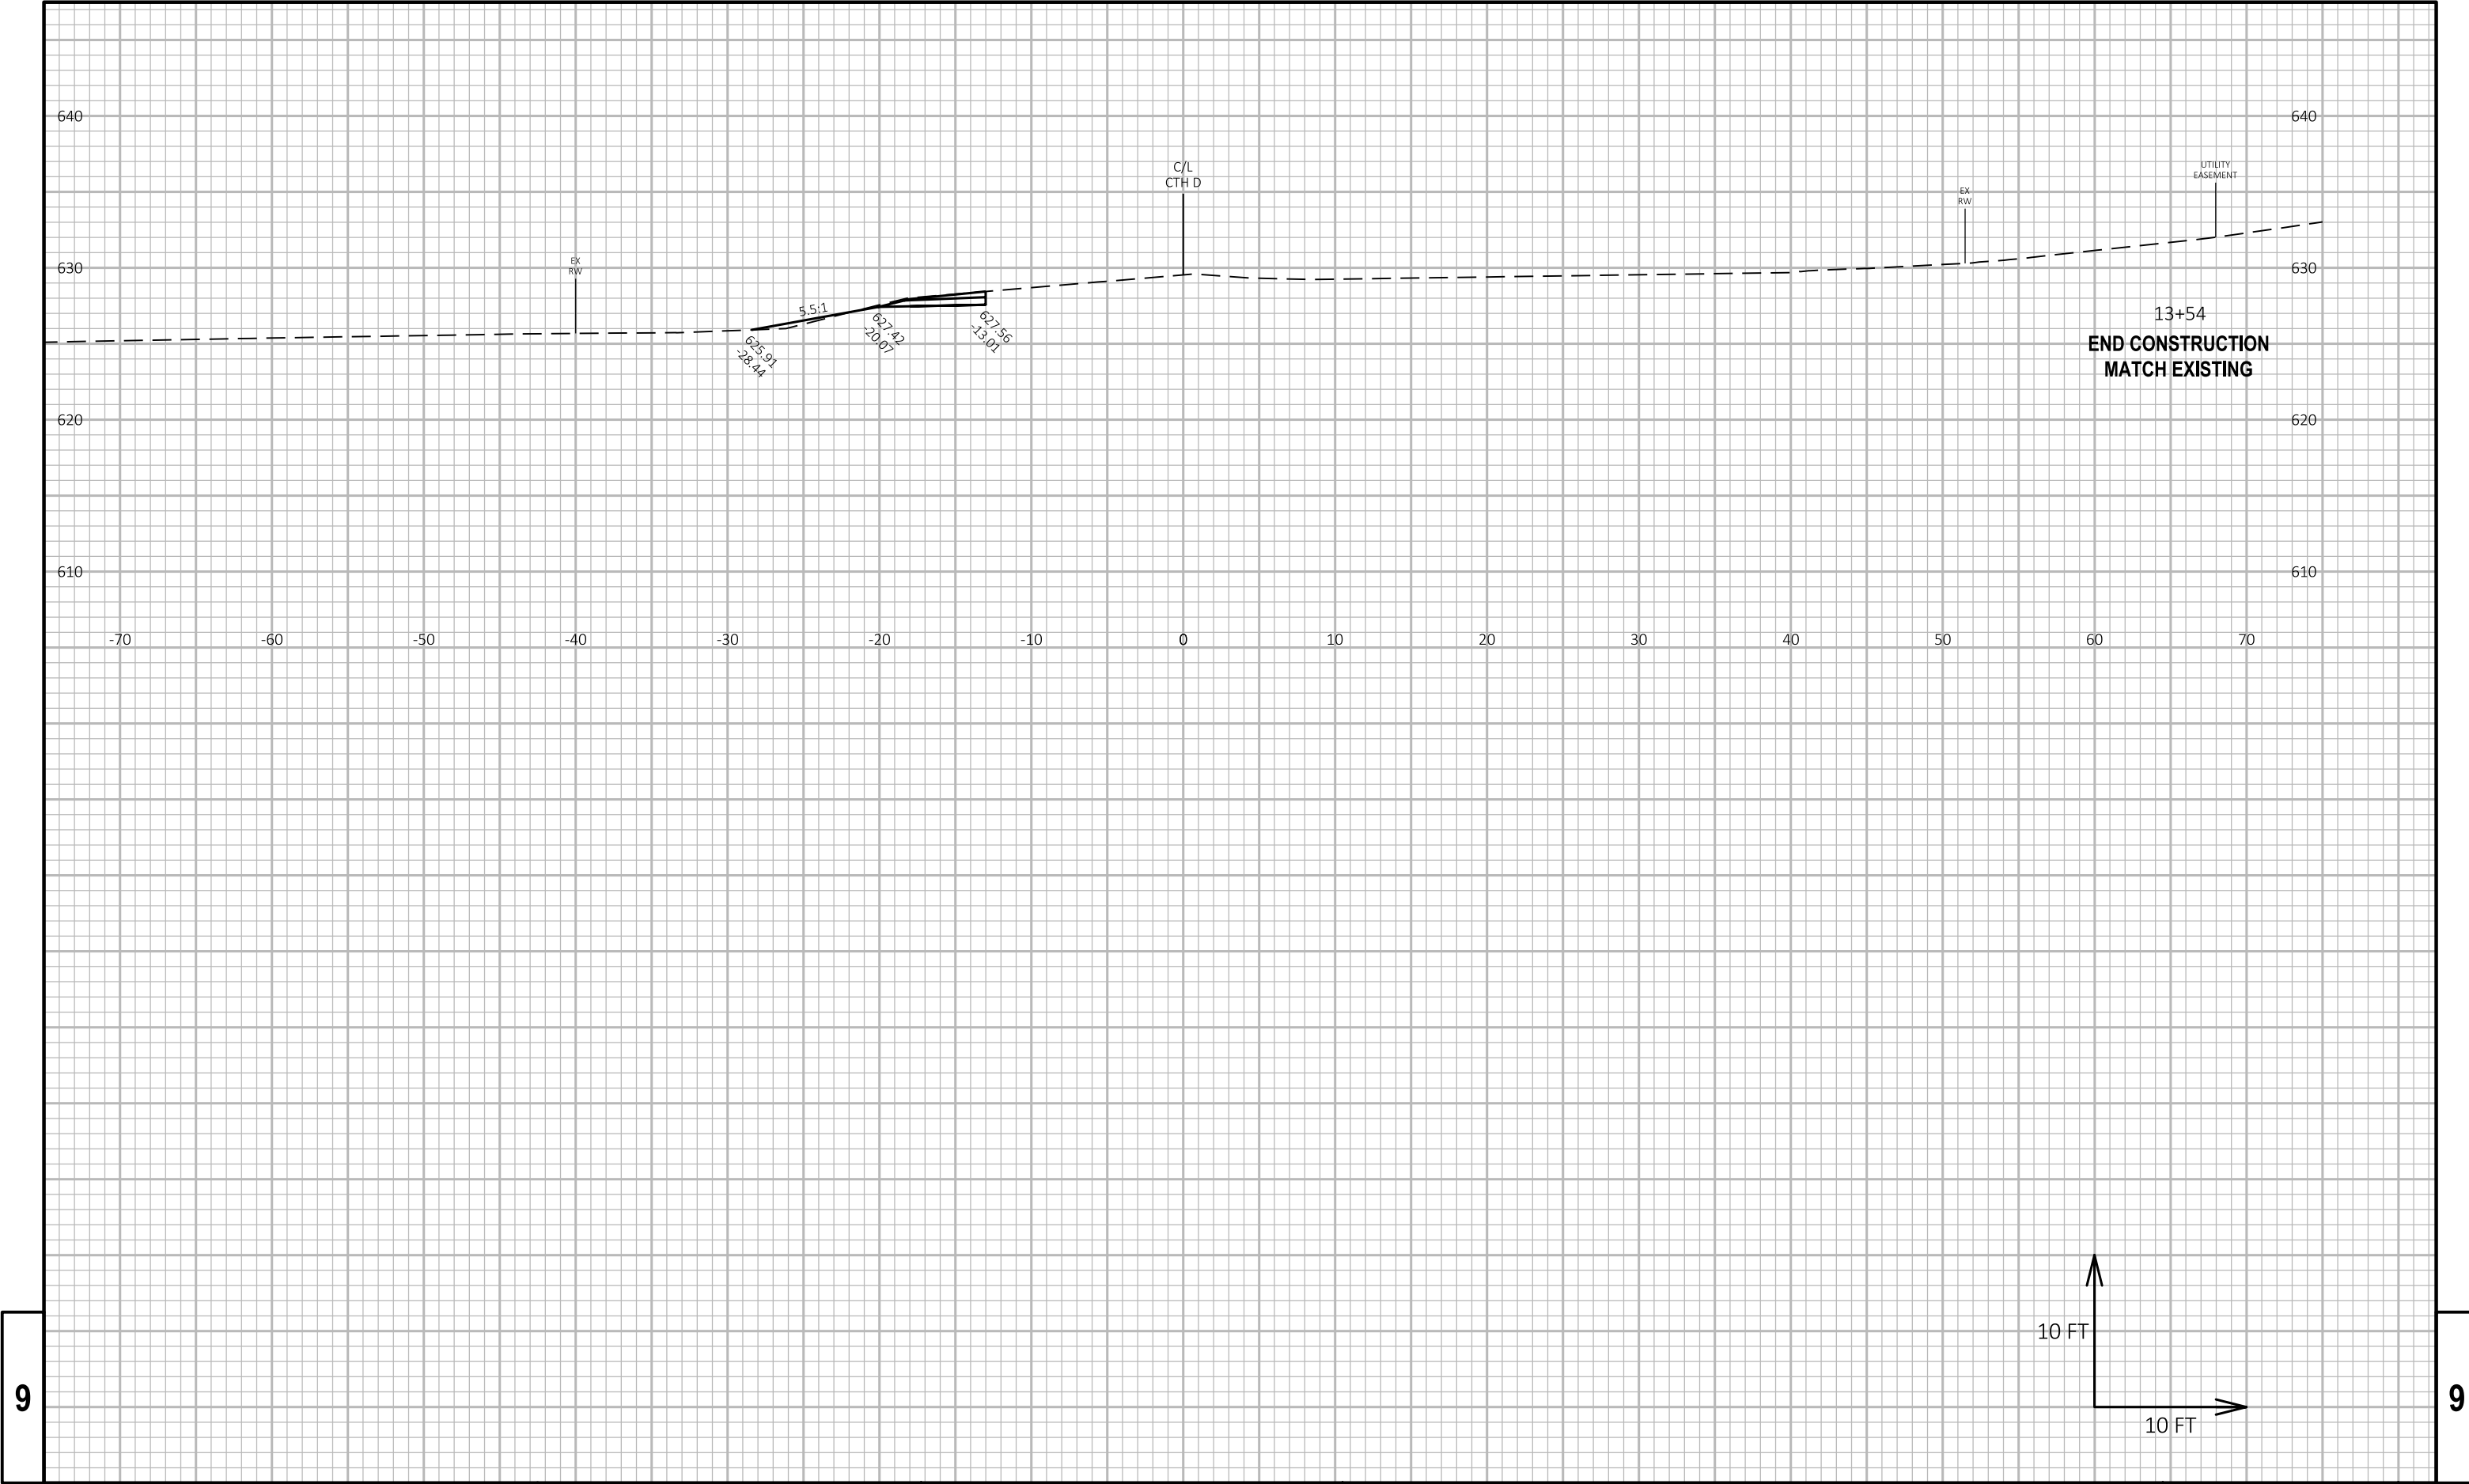


9

9

PROJECT NO: 4546-02-71	HWY: CTH D	COUNTY: BROWN	CROSS SECTIONS: CTH D	SHEET 68	E
------------------------	------------	---------------	-----------------------	----------	---

Notes

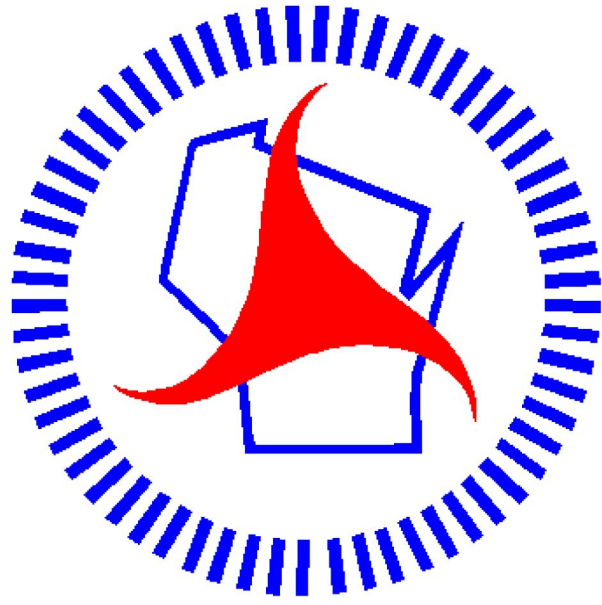

Wisconsin Department of Transportation

Dedicated people creating transportation solutions through innovation and exceptional service.

<http://www.dot.wisconsin.gov>