

#### DESIGN DATA

DESIGN LOADING \_\_\_\_\_ HL-93  
INVENTORY RATING FACTOR \_\_\_\_\_ 1.17  
OPERATIONAL RATING FACTOR \_\_\_\_\_ 1.86  
WISCONSIN STANDARD PERMIT VEHICLE (WIS-SPV) \_\_\_\_\_ 240 KIPS

STRUCTURE IS DESIGNED FOR A FUTURE WEARING SURFACE OF 20 PSF.

#### MATERIAL PROPERTIES

CONCRETE MASONRY, SLAB \_\_\_\_\_ f'c = 4,000 PSI  
ALL OTHER \_\_\_\_\_ f'c = 3,500 PSI  
HIGH STRENGTH BAR STEEL REINFORCEMENT \_\_\_\_\_ fy = 60,000 PSI  
36W" PRESTRESSED GIRDERS, CONCRETE MASONRY \_\_\_\_\_ f'c = 6,000 PSI  
STRANDS-0.6" DIA ULTIMATE TENSILE STRENGTH \_\_\_\_\_ fu = 270,000 PSI

#### TRAFFIC DATA

ADT (2019) = 2,300  
ADT (2039) = 3,300  
DESIGN SPEED = 50 MPH

#### FOUNDATION DATA

ABUTMENTS TO BE SUPPORTED ON HP 10-INCH X 42 LB STEEL PILING DRIVEN TO A REQUIRED DRIVING RESISTANCE OF 165\* TONS PER PILE AS DETERMINED BY THE MODIFIED GATES DYNAMIC FORMULA. ESTIMATED 90' LONG AT BOTH ABUTMENTS.

\* THE FACTORED AXIAL RESISTANCE OF PILES IN COMPRESSION USED FOR DESIGN IS THE REQUIRED DRIVING RESISTANCE MULTIPLIED BY A RESISTANCE FACTOR OF 0.5 USING MODIFIED GATES TO DETERMINE DRIVEN PILE CAPACITY.

#### HYDRAULIC DATA

##### 100 YEAR FREQUENCY


Q<sub>100</sub> = 3,340 C.F.S.  
VEL. = 7.0 F.P.S.  
HW<sub>100</sub> = EL. 626.03  
WATERWAY AREA = 475 SQ. FT.  
DRAINAGE AREA = 21.2 SQ. MI.  
SCOUR CRITICAL CODE = 5

##### 2 YEAR FREQUENCY

Q<sub>2</sub> = 1,220 C.F.S.  
VEL. = 5.0 F.P.S.  
HW<sub>2</sub> = EL. 622.57

STATE PROJECT NUMBER


4546-02-71

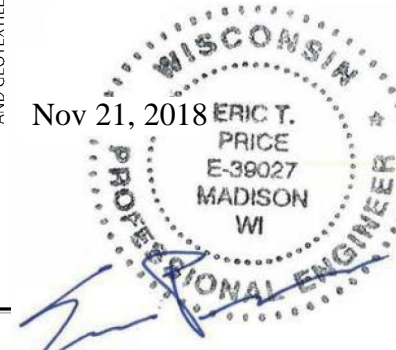

AVERAGE PILE LENGTH  
WAS ROUGHLY 72 FEET


#### LIST OF DRAWINGS

1. GENERAL PLAN
2. CROSS SECTION & QUANTITIES
3. SUBSURFACE EXPLORATION
4. SOUTH ABUTMENT
5. SOUTH ABUTMENT DETAILS
6. NORTH ABUTMENT
7. NORTH ABUTMENT DETAILS
8. 36W-INCH PRESTRESSED GIRDER DETAILS 1
9. 36W-INCH PRESTRESSED GIRDER DETAILS 2
10. STEEL DIAPHRAGM
11. SUPERSTRUCTURE
12. SUPERSTRUCTURE DETAILS
13. RAILING TUBULAR TYPE M

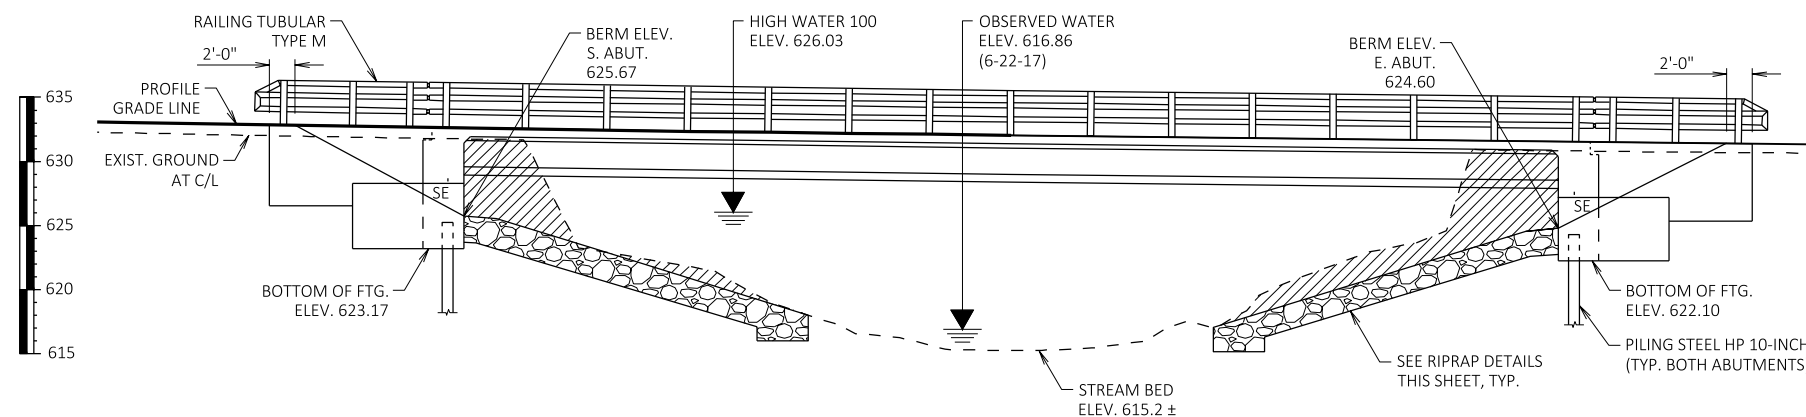


#### BENCH MARKS

NO.	STATION	DESCRIPTION	ELEV.
CP694	9+46.5	60D NAIL, 18.3' RT.	631.10
BM2	10+34.3	DISC, 13.9' RT.	631.45
CP	12+32.6	TELE. PED., 37.9' LT.	624.96

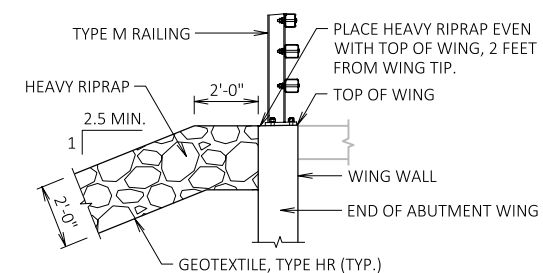

#### TYPICAL FILL SECTION AT WING TIPS

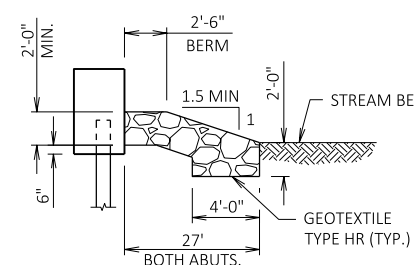


#### RIPRAP DETAIL

BRIDGE OFFICE CONTACT  
BILL DREHER, P.E.  
TELEPHONE: (608) 266-8489

CONSULTANT CONTACT  
ERIC PRICE, P.E.  
TELEPHONE: (608) 826-6146



NO.	DATE	REVISION	BY
<b>CORRE</b>			
STATE OF WISCONSIN DEPARTMENT OF TRANSPORTATION			
ACCEPTED	William C. Dreher	11/23/18	DATE
STRUCTURE B-5-440			
CTH D OVER PLUM CREEK			
COUNTY	BROWN	TOWN/CITY/VILLAGE	WRIGHTSTOWN
DESIGN SPEC.	AASHTO LRFD BRIDGE DESIGN SPECIFICATIONS		
DESIGNED BY	ERA	DESIGN CK'D.	ETP
DRAWN BY	PKF	PLANS CK'D.	ETP
GENERAL PLAN			SHEET 1 OF 13
			37



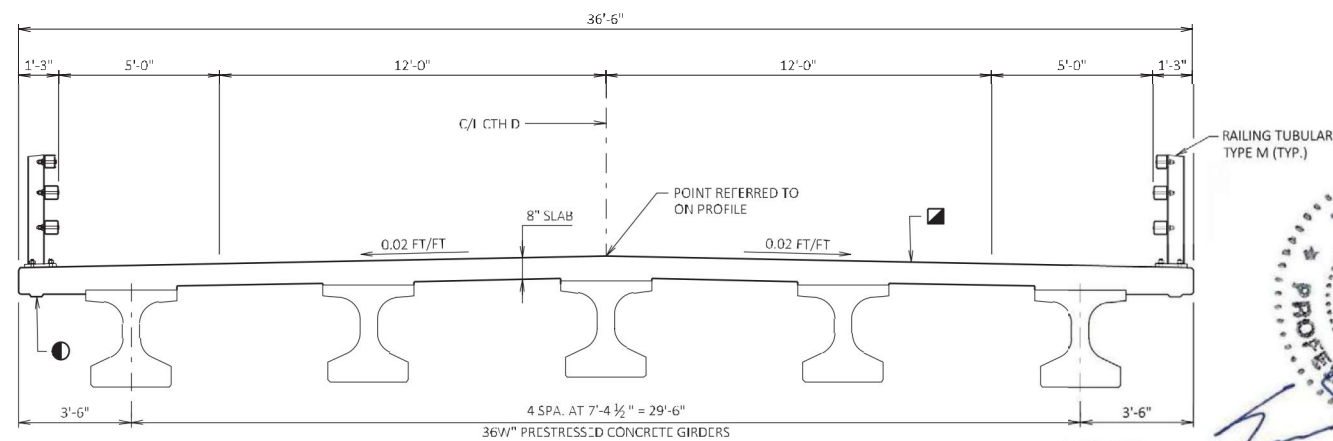

CROSS SECTION THRU BRIDGE  
(LOOKING NORTH)


- LEGEND**
- SPECIAL DRIP EDGE REQ'D. EXTEND 6" FROM F.F. OF ABUTMENT BODY.
  - COAT WITH "PROTECTIVE SURFACE TREATMENT" AS PER THE STANDARD SPECIFICATIONS.

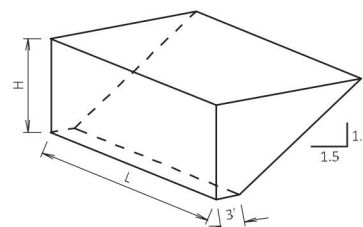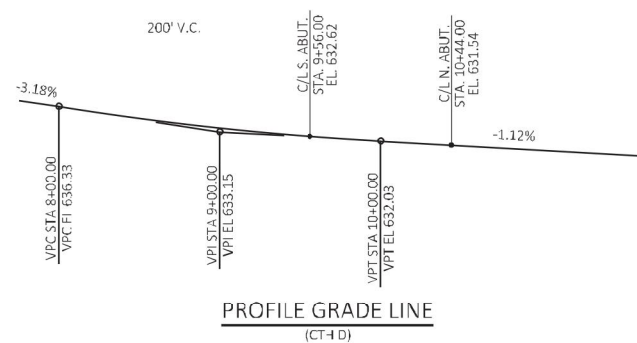


ABUTMENT BACKFILL QUANTITY DIAGRAM

L = OUT TO OUT OF ABUTMENT, INCLUDING WINGS (FT)  
H = AVERAGE ABUTMENT FILL HEIGHT (FT)  
EF = EXPANSION FACTOR 1.20 FOR CY BID ITEMS AND 1.00 FOR TON BID ITEMS)  
 $V_{Cr} = (L)(3.0')(H) + (L)(0.5)(1.5H)(H)$   
 $V_{CY} = V_{Cr}(EF)/27$   
 $V_{TON} = V_{CY}(2.0)$

William C. Dreher SD

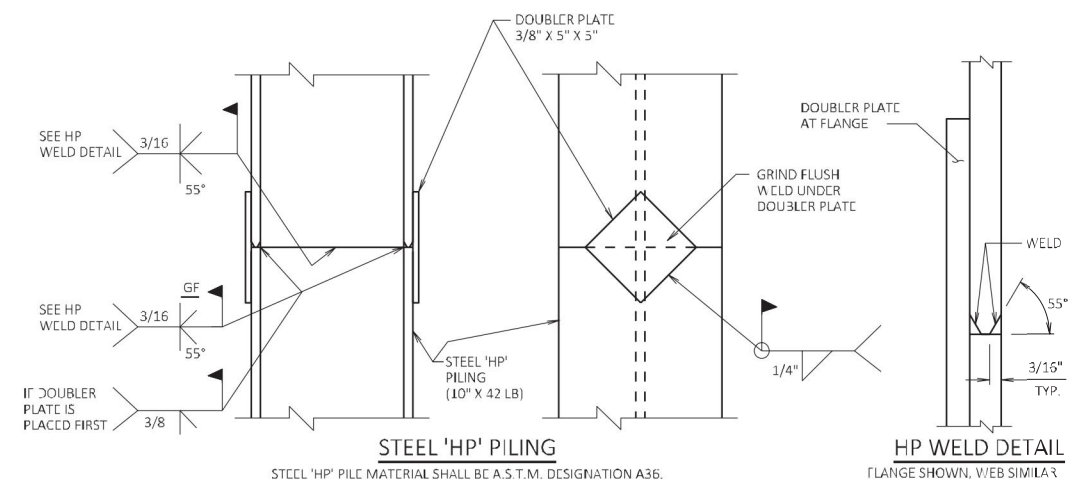

## PILE SPLICE DETAILS

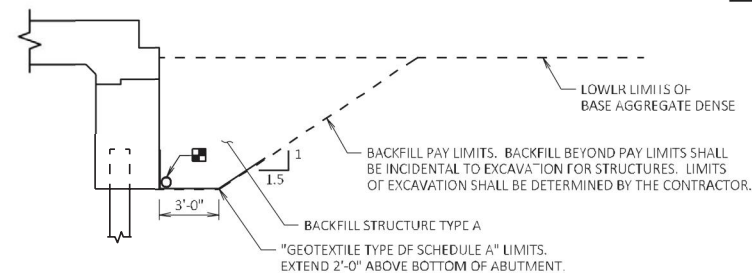

## STRUCTURE BACKFILL LIMITS

- PIPE UNDERDRAIN WRAPPED (6-INCH). SLOPE 0.5% MIN. TO SUITABLE DRAINAGE. ATTACH RODENT SHIELD AT ENDS OF PIPE UNDERDRAIN.

TOTAL ESTIMATED QUANTITIES

BID NUMBER	BID ITEM	UNIT	SOUTH ABUT.	NORTH ABUT.	SUPER	TOTALS
203.0600.S	REMOVING OLD STRUCTURE OVER WATERWAY WITH MINIMAL DEBRIS STA. 10+00	LS	----	----	----	1
206.1000	EXCAVATION FOR STRUCTURES BRIDGES B-5-440	LS	----	----	----	1
210.1500	BACKFILL STRUCTURE TYPE A	TON	170	170	----	340
502.0100	CONCRETE MASONRY BRIDGES	CY	36	36	127	340
502.3200	PROTECTIVE SURFACE TREATMENT	SY	12	12	373	397
503.0137	PRESTRESSED GIRDER TYPE I 36W-INCH	LF	----	----	445	445
505.0400	BAR STEEL REINFORCEMENT HS STRUCTURES	LB	2,440	2,440	----	4,880
505.0600	BAR STEEL REINFORCEMENT HS COATED STRUCTURES	LB	1,430	1,420	21,950	24,800
506.2605	BEARING PADS ELASTOMERIC NON-LAMINATED	EACH	5	5	----	10
506.4000	STEEL DIAPHRAGMS B-5-440	EACH	----	----	8	8
513.4061	RAILING TUBULAR TYPE M	LF	26	26	184	236
516.0500	RUBBERIZED MEMBRANE WATERPROOFING	SY	9	9	----	18
550.0500	PILE POINTS	EACH	9	9	----	18
550.1100	PIILING STEEL HP 10-INCH X 42 LB	LF	810	810	----	1,620
606.0300	R PRAP HEAVY	CY	190	265	----	455
612.0406	PIPE UNDERDRAIN WRAPPED 6-INCH	LF	90	90	----	180
645.0111	GEOTEXTILE TYPE DF SCHEDULE A	SY	36	36	----	72
645.0120	GEOTEXTILE TYPE HR	SY	260	360	----	620
	NON-BID ITEMS					
	FILLER	SIZE	----	----	----	½" & ¾"

STATE PROJECT NUMBER
4546-02-71

## GENERAL NOTES

DRAWINGS SHALL NOT BE SCALED.

BAR STEEL REINFORCEMENT SHALL BE EMBEDDED 2" CLEAR UNLESS SHOWN OR NOTED OTHERWISE.

THE FIRST DIGIT OF A THREE DIGIT BAR NO. AND THE FIRST TWO DIGITS OF A FOUR DIGIT BAR NO. SIGNIFIES THE BAR SIZE.

JOINT FILLER SHALL CONFORM TO THE REQUIREMENTS OF AASHTO DESIGNATION M153 TYPE I, II OR III OR AASHTO DESIGNATION M213.

THE SLOPE OF THE FILL IN FRONT OF THE ABUTMENTS SHALL BE COVERED WITH RIPRAP HEAVY AND GEOTEXTILE TYPE HR TO THE EXTENT SHOWN ON THE GENERAL PLAN SHEET AND IN THE ABUTMENT DETAILS, OR AS DIRECTED BY THE ENGINEER.

THE UPPER LIMITS OF "EXCAVATION FOR STRUCTURES BRIDGES B-5-44C" SHALL BE THE EXISTING GROUNDLINE.

EXCAVATION BELOW THE ABUTMENT AND ABUTMENT BEDDING MATERIALS REQUIRES ENGINEER APPROVAL. GEOTEXTILE SHALL BE SET AT THE BOTTOM OF EXCAVATION AND EXTEND 2'-0" ABOVE BOTTOM OF ABUTMENT.

THE HAUNCH CONCRETE QUANTITY IS BASED ON THE AVERAGE HAUNCH SHOWN ON THE PRESTRESSED GIRDER DETAILS SHEET.

PROTECTIVE SURFACE TREATMENT IS TO BE APPLIED TO THE TOP OF DECK AND WINGS, EXTERIOR EXPOSED FACE OF WINGS, AND THE END 1'-0" OF THE ABUTMENT FRONT FACES.



THE EXISTING STRUCTURE 8-5-10, TO BE REMOVED, IS A SINGLE SPAN STEEL DECK GIRDER BRIDGE, 73.0 FT. LONG WITH A 24.0 FT. CLEAR ROADWAY WIDTH.

THE ELASTOMERIC BEARING PADS NON-LAMINATED NEED NOT BE INDIVIDUALLY MOLDED PROVIDED THE CUT EDGES ARE SMOOTH AND TRUE.

AT THE BACKFACE OF ABUTMENT ALL VOLUME WHICH CANNOT BE PLACED BEFORE ABUTMENT CONSTRUCTION AND IS NOT OCCUPIED BY THE NEW STRUCTURE SHALL BE BACKFILLED WITH BACKFILL STRUCTURE.

THE BACKFILL QUANTITIES ARE BASED ON THE PAY LIMITS SHOWN ON THE PLANS AND MAY NOT REFLECT ACTUAL PLACE QUANTITIES. "BACKFILL STRUCTURE TYPE A" REQUIRED DIRECTLY BEHIND ABUTMENTS AND ABUTMENT WINGS FOR 3 FEET. BACKFILL PLACED BEYOND PAY LIMITS OR EXCEEDING PLAN QUANTITIES SHALL BE INCIDENTAL TO EXCAVATION FOR STRUCTURES.

BORING #	DATE COMPLETED	NORTHING (Y)	EASTING (X)
1	JULY 11, 2017	490976.2	58760.96
2	JULY 10, 2017	491060.5	58768.35
BORINGS COMPLETED BY: RIVER VALLEY TESTING CORP.			
REPORT COMPLETED BY: RIVER VALLEY TESTING CORP.			
ALL COORDINATES REFERENCED TO WCCS NAD 83(91) BROWN COUNTY			

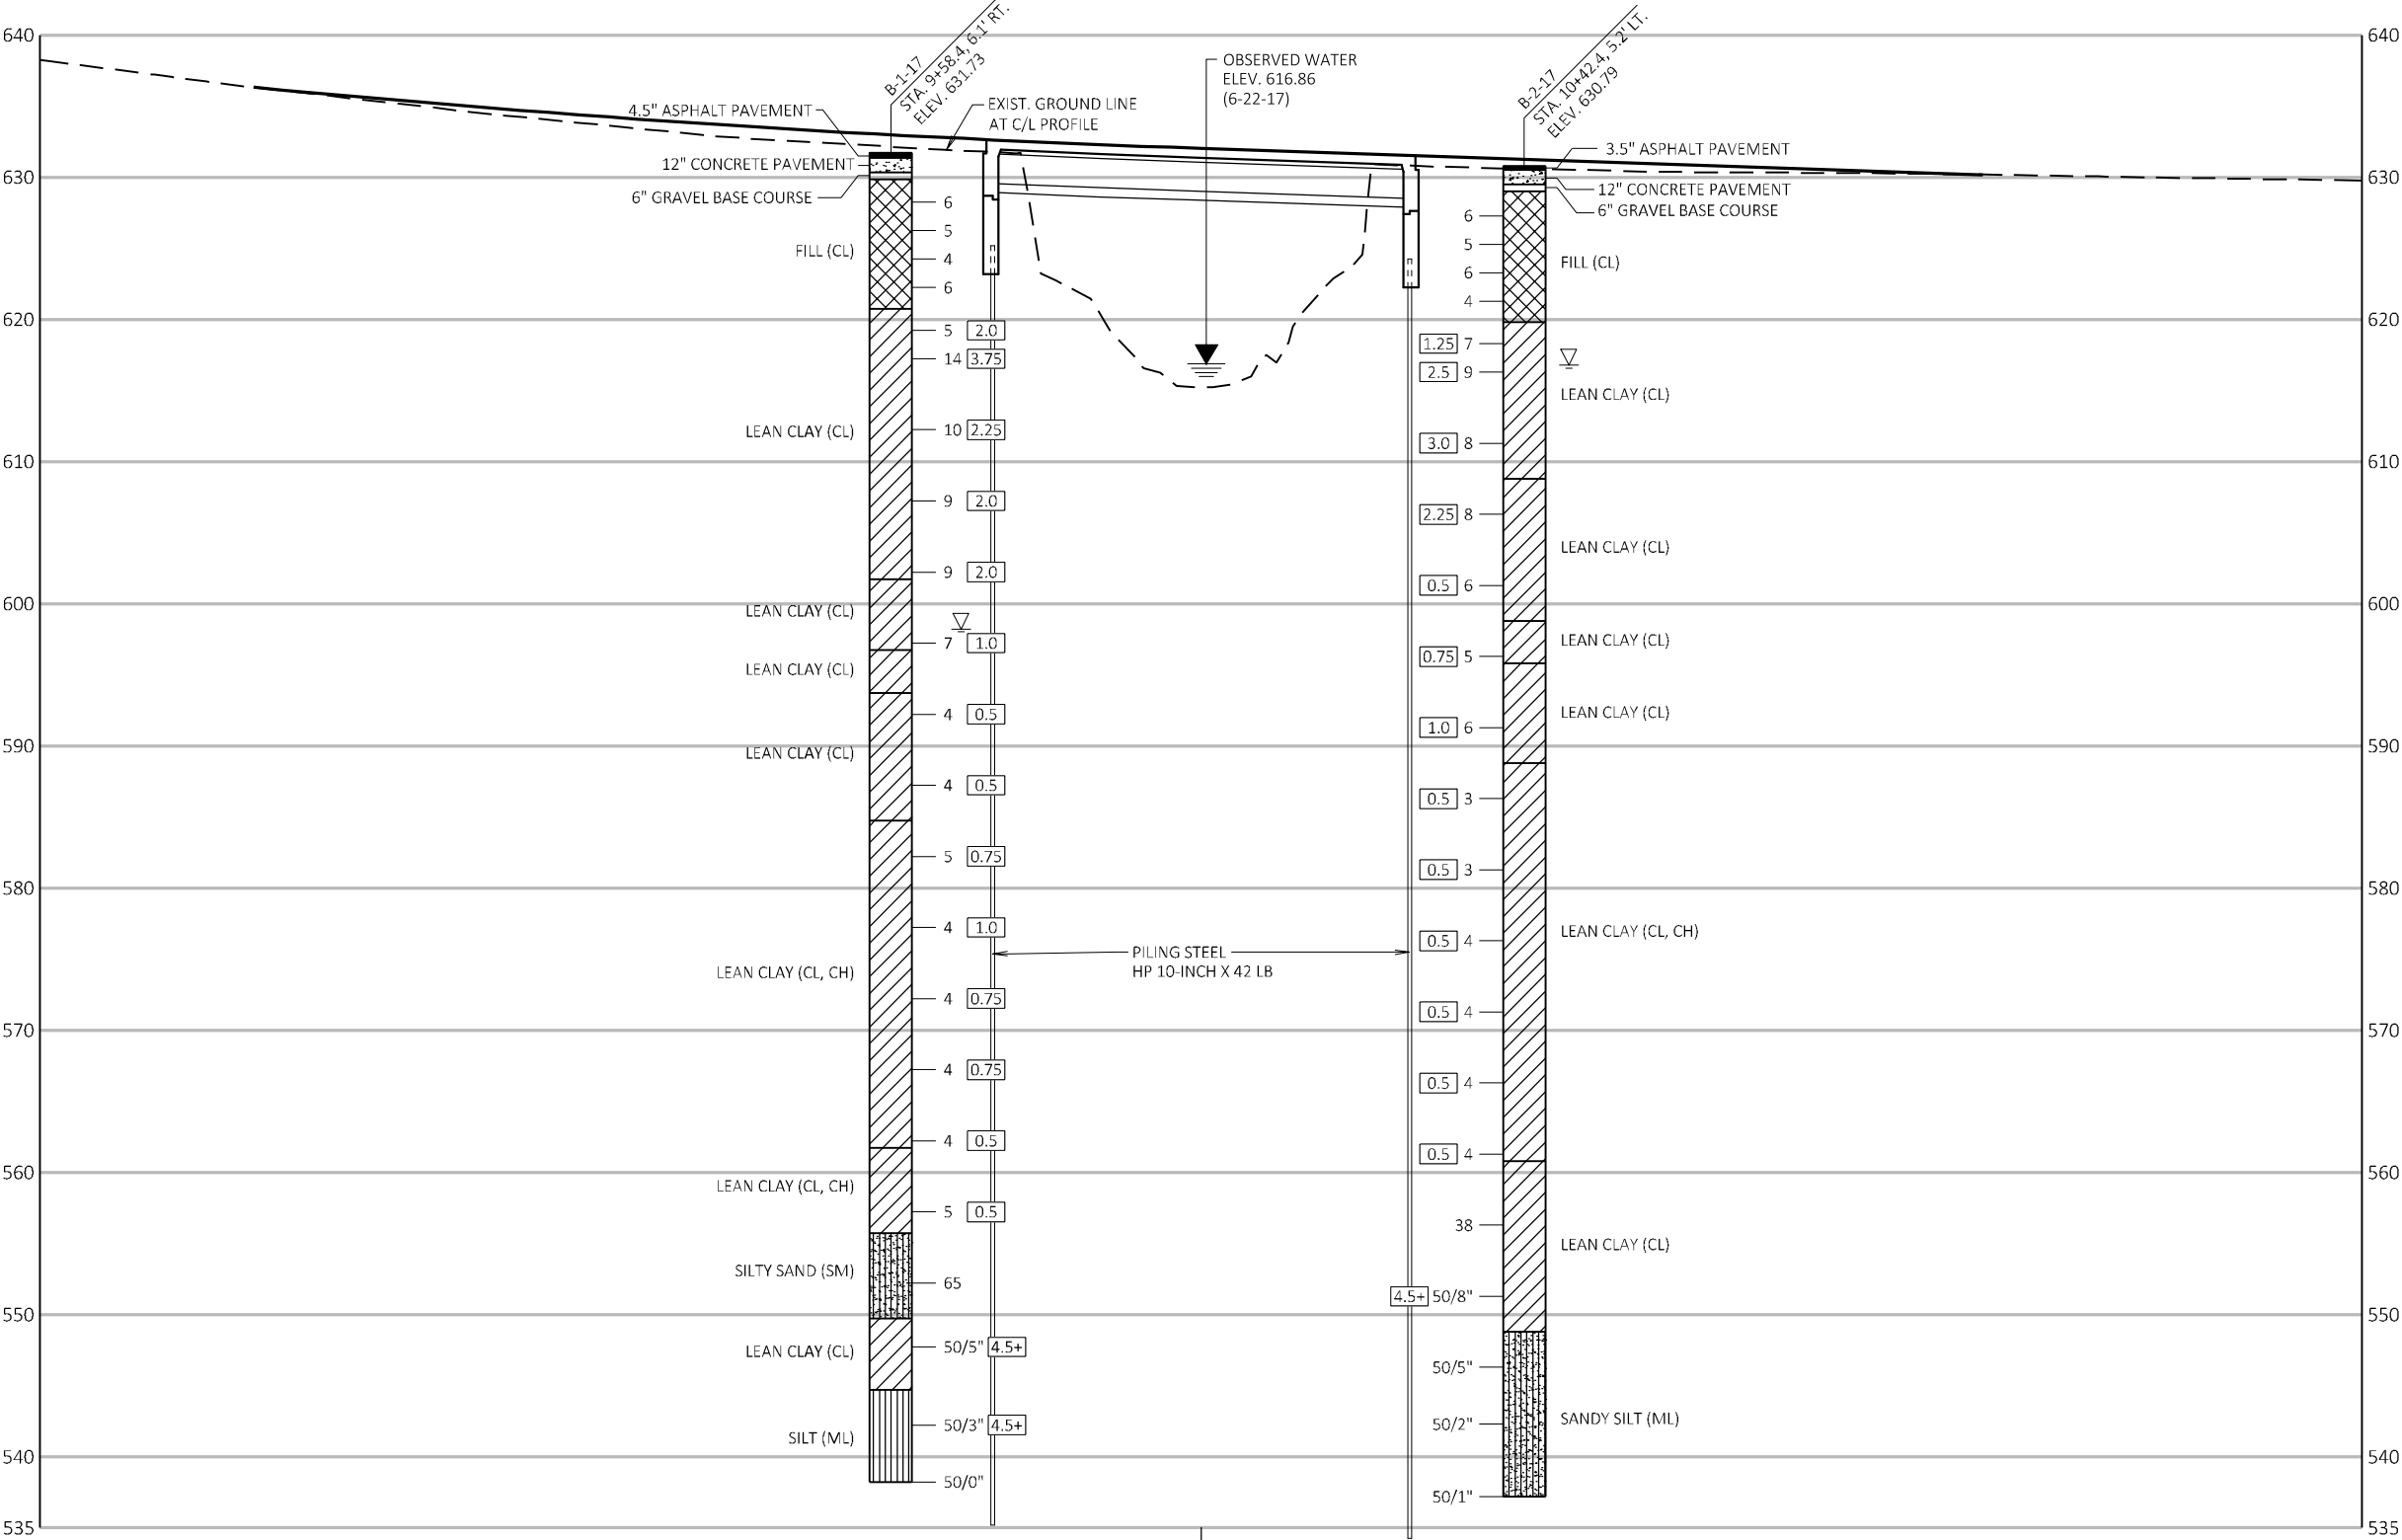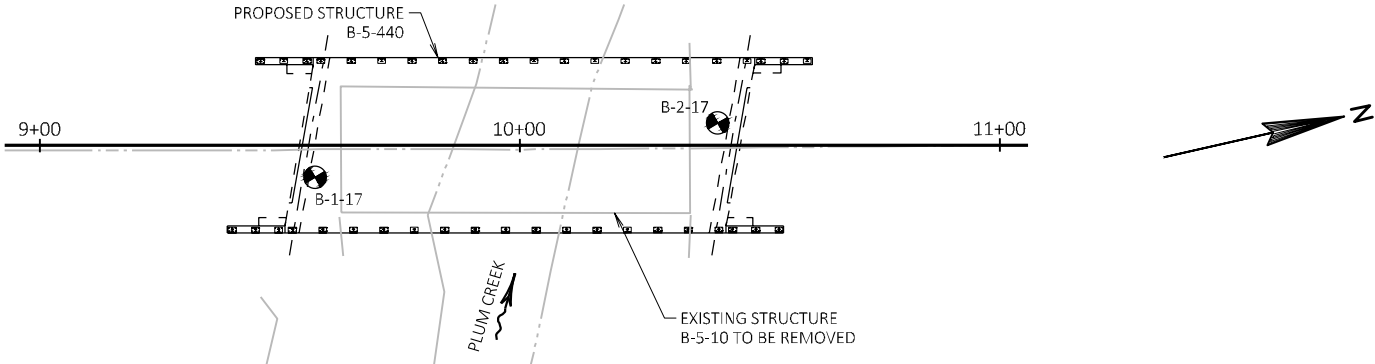

STATE PROJECT NUMBER

4546-02-71

MATERIAL SYMBOLS

ASPHALT

CONCRETE

SAND

BOULDERS OR COBBLES

SHALE

TOPSOIL

FILL

CLAY

LIMESTONE

SANDSTONE

PEAT

GRAVEL

SILT

BEDROCK (UNKNOWN)

IGNEOUS/META

LEGEND OF BORING

BORING #/ELEV. STA./OFFSET

ST

(1) 0.25

(2) 17

F-C

COBBLE OR BOULDER

WEATHERED LIMESTONE

CORE RUN #1 - 24'-29'

REC=80%, RQD=72%

(1) UNCONFINED STRENGTH, AS DETERMINED BY A POCKET PENETROMETER (TSF)

(2) UNLESS OTHERWISE, SPECIFIED THE SPT 'N' VALUE IS BASED ON AASHTO T-206, STANDARD PENETRATION TEST. THE SPT 'N' VALUE PRESENTED HAS NOT BEEN CORRECTED FOR OVERBURDEN PRESSURE OR HAMMER EFFICIENCY.

GROUND WATER ELEVATION

▽

 AT TIME OF DRILLING

▼

 END OF DRILLING

▽

 AFTER DRILLING

ABBREVIATIONS

F-FINE M-MEDIUM C-COARSE ST-SHELBY TUBE

SUBSURFACE EXPLORATION FOR FOUNDATION DESIGN AND BIDDERS INFORMATION

BORINGS WERE COMPLETED AT POINTS APPROXIMATELY AS INDICATED ON THIS DRAWING TO OBTAIN INFORMATION CONCERNING THE CHARACTER OF SUBSURFACE MATERIALS FOUND AT THE SITE. BECAUSE THE INVESTIGATED DEPTHS ARE LIMITED AND THE AREA OF THE BORINGS IS VERY SMALL IN RELATION TO THE ENTIRE SITE, THE WISCONSIN DEPARTMENT OF TRANSPORTATION DOES NOT WARRANT SIMILAR SUBSURFACE CONDITIONS BELOW, BETWEEN, OR BEYOND THESE BORINGS. VARIATIONS IN SOIL CONDITIONS SHOULD BE EXPECTED AND FLUCTUATIONS IN GROUNDWATER LEVELS MAY OCCUR.

NO.	DATE	REVISION	BY
STATE OF WISCONSIN DEPARTMENT OF TRANSPORTATION			
STRUCTURE B-5-440			
DRAWN BY		PKF	PLANS CK'D. ETP
SUBSURFACE EXPLORATION		SHEET 3 OF 13	
		39	





BILL OF BARS - SOUTH ABUTMENT

DIMENSIONS IN BENDING DETAILS ARE OUT-TO-OUT OF BAR.


BAR MARK	NO. REQ'D	LENGTH	BENT	BAR SERIES	LOCATION
NON-COATED BARS					TOTAL WEIGHT = 2,440 LBS
A401	9	28'-0"	X		BODY - AT PILES - 1 PER PILE VERT.
A402	18	2'-3"			BODY - AT PILES - 2 PER PILE VERT.
A503	45	15'-2"	X		BODY - STIRRUPS VERT.
A604	22	19'-10"			BODY - B.F. & F.F. & TOP & BTM HORIZ.
A805	14	20'-4"	X		BODY - B.F. HORIZ.
A406	8	4'-7"			BODY - ENDS VERT.
A407	8	6'-0"			BODY - BTWN BEAM SEATS HORIZ.
A408	16	4'-11"	X		BODY - BTWN BEAM SEATS VERT.
COATED BARS					TOTAL WEIGHT = 1,430 LBS
A510	12	15'-4"	X		WINGS 1 & 2 - STIRRUPS VERT.
A511	6	8'-1"			WING 1 - F.F. HORIZ.
A612	9	8'-1"			WING 1 - TOP & B.F. HORIZ.
A613	9	7'-6"			WING 2 - TOP & B.F. HORIZ.
A514	6	8'-6"			WING 2 - F.F. HORIZ.
A415	16	7'-9"			WINGS 1 & 2 - OVERHANG HORIZ.
A416	18	11'-8"			WINGS 1 & 2 HORIZ.
A517	22	12'-11"	X		WINGS 1 & 2 VERT.
A518	26	11'-11"	X		WINGS 1 & 2 - OVERHANG VERT.
A619	4	11'-8"			WINGS 1 & 2 - TOP HORIZ.

THE FIRST DIGIT OR FIRST TWO DIGITS OF THE BAR MARK SIGNIFIES THE BAR SIZE.


LEGEND

- A03 OPTIONAL KEYED CONST. JOINT FORMED BY BEVELED 2" x 6" (18" RUBBERIZED MEMBRANE WATERPROOFING AT B.F. & ¾" "V" GROOVE AT F.F. IF JOINT IS USED).
- A09 SUPPORT ABUTMENT ON PILING STEEL HP 10-INCH x 42 LB, ESTIMATED 90 FEET LONG, DRIVEN TO A REQUIRED DRIVING RESISTANCE OF 165 TONS PER PILE. SEE ADDITIONAL FOUNDATION DATA ON SHEET 1 AND PILE SPLICE DETAILS ON SHEET 2.
- A15 PIPE UNDERDRAIN WRAPPED 6-INCH. SLOPE 0.5% MIN. TO SUITABLE DRAINAGE. ATTACH RODENT SCREEN AT ENDS OF PIPE UNDERDRAIN. RODENT SHIELD TO BE INCLUDED IN BID PRICE OF "PIPE UNDERDRAIN WRAPPED 6-INCH".
- A17 ½" FILLER (INCLUDED IN WING LENGTH): SEAL ALL EXPOSED HORIZONTAL AND VERTICAL SURFACES OF ½" FILLER WITH NON-STAINING GRAY NON-BITUMINOUS JOINT SEALER. (1" DEEP AND HOLD 1/8" BELOW SURFACE OF CONCRETE.)
- A19 18" RUBBERIZED MEMBRANE WATERPROOFING. SEAL ALL HORIZONTAL AND VERTICAL JOINTS ON BACKFACE.


B.F. DENOTES BACK FACE  
F.F. DENOTES FRONT FACE

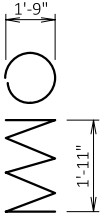


A401

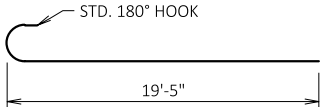


A805

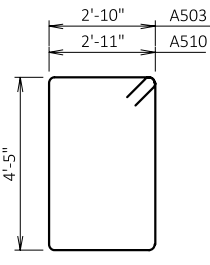

A503, A510

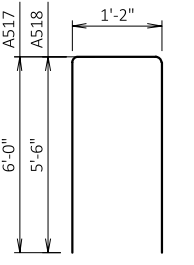


A517, A518

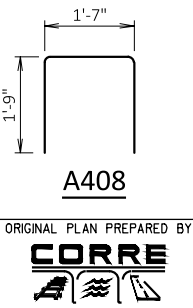


A408


NO.	DATE	REVISION	BY
STATE OF WISCONSIN DEPARTMENT OF TRANSPORTATION			
STRUCTURE B-5-440			
DRAWN BY PKF		PLANS CK'D. ETP	
SOUTH ABUTMENT DETAILS			SHEET 5 OF 13
			41

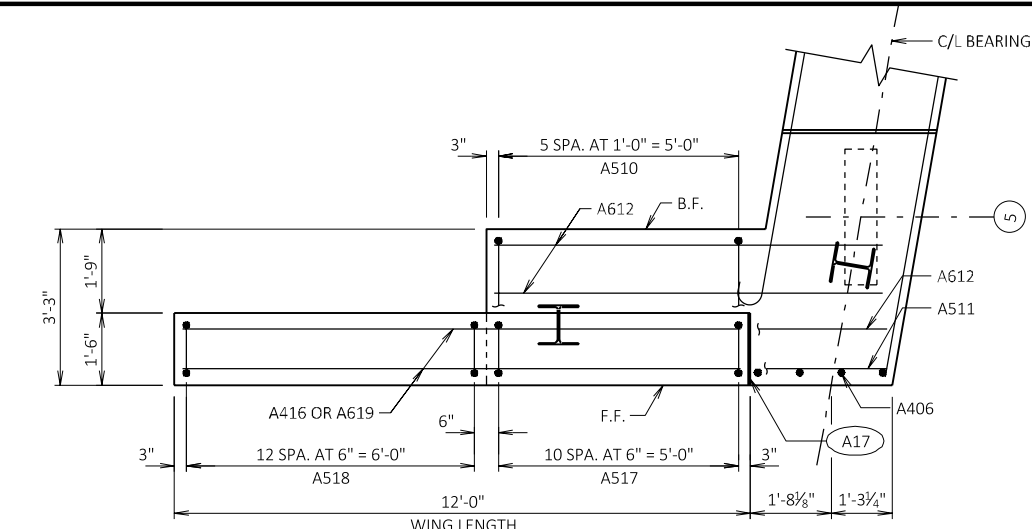


PLAN WING 1

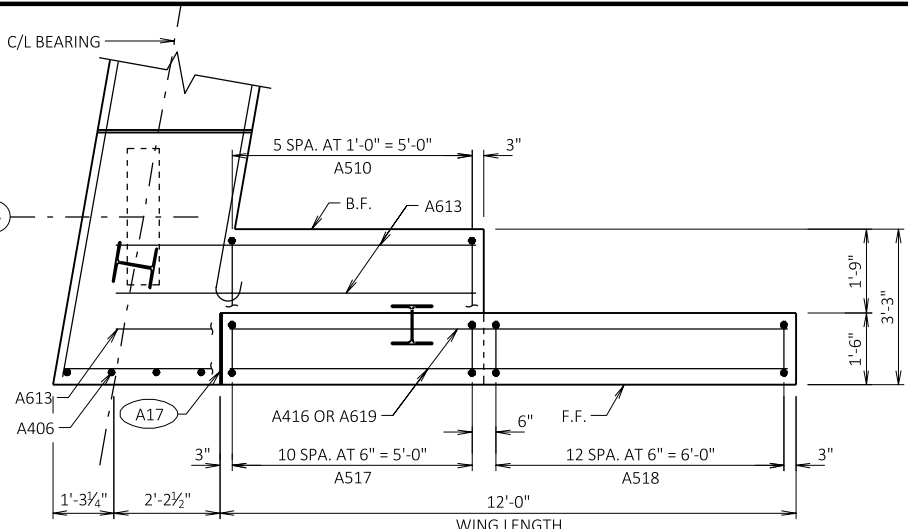


PLAN WING 2

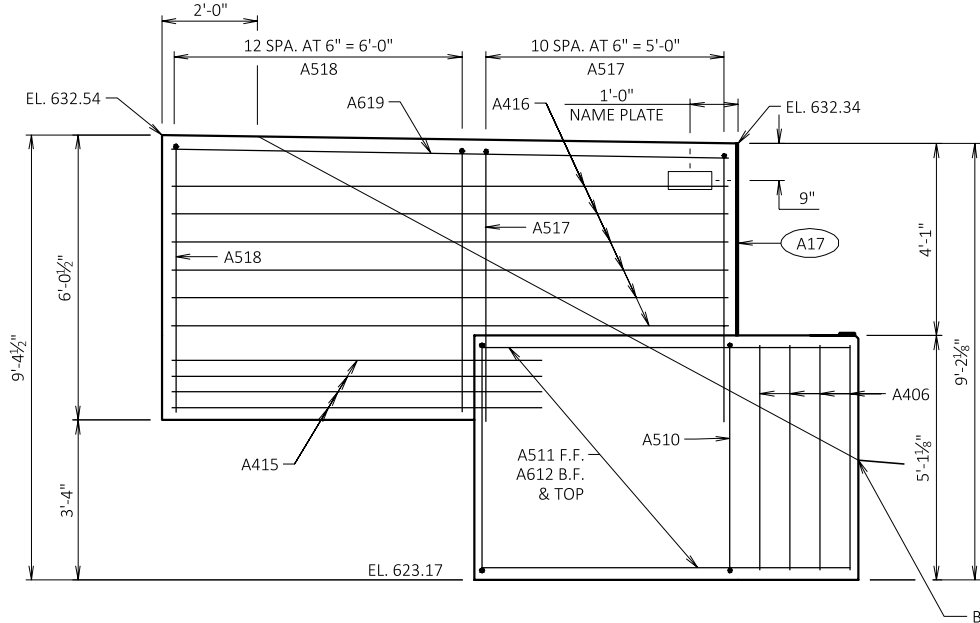


ELEVATION WING 1

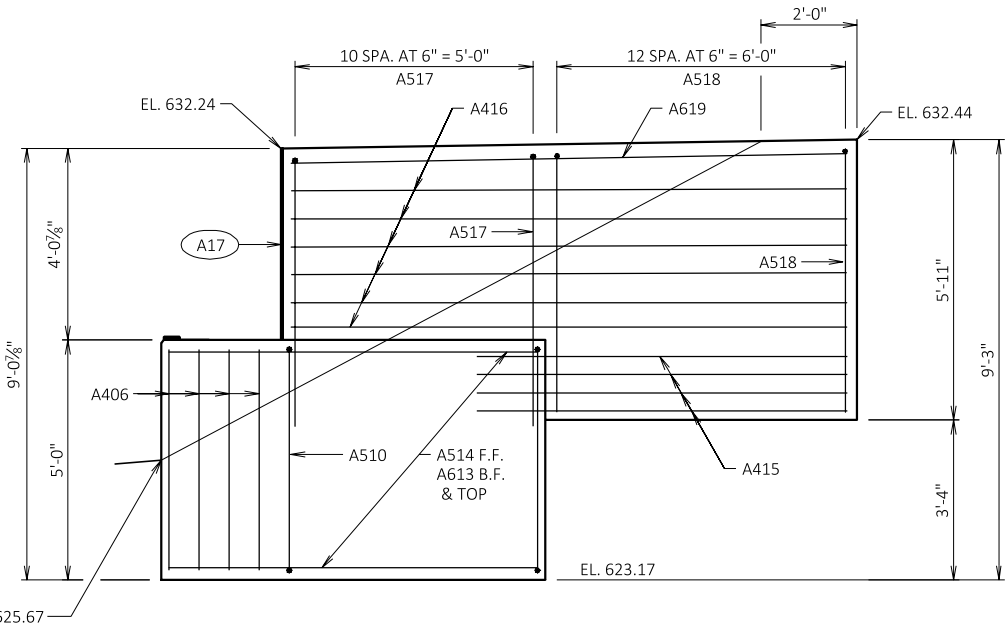


ELEVATION WING 2

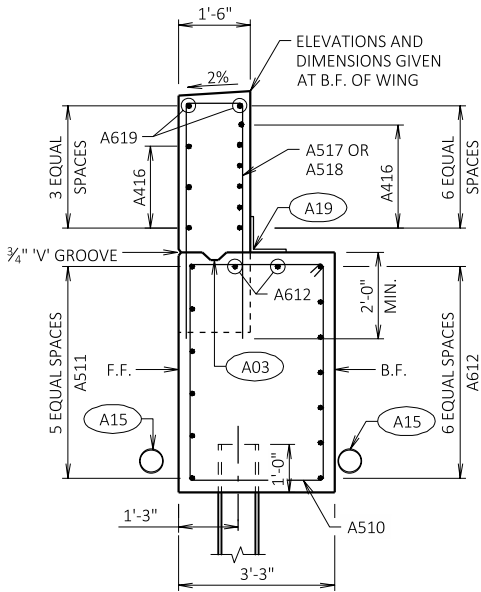


SECTION THRU WING 1

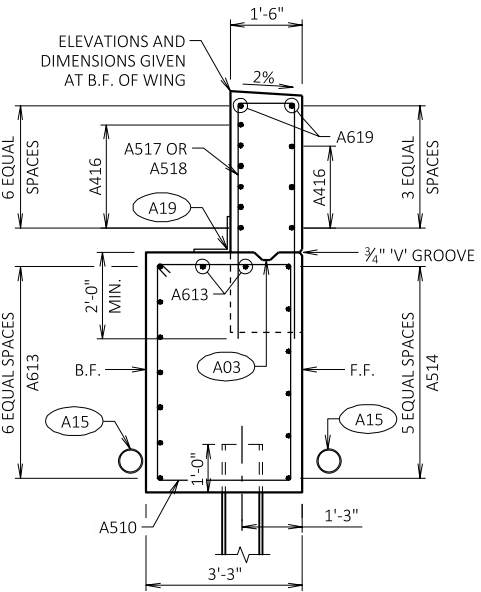


SECTION THRU WING 2

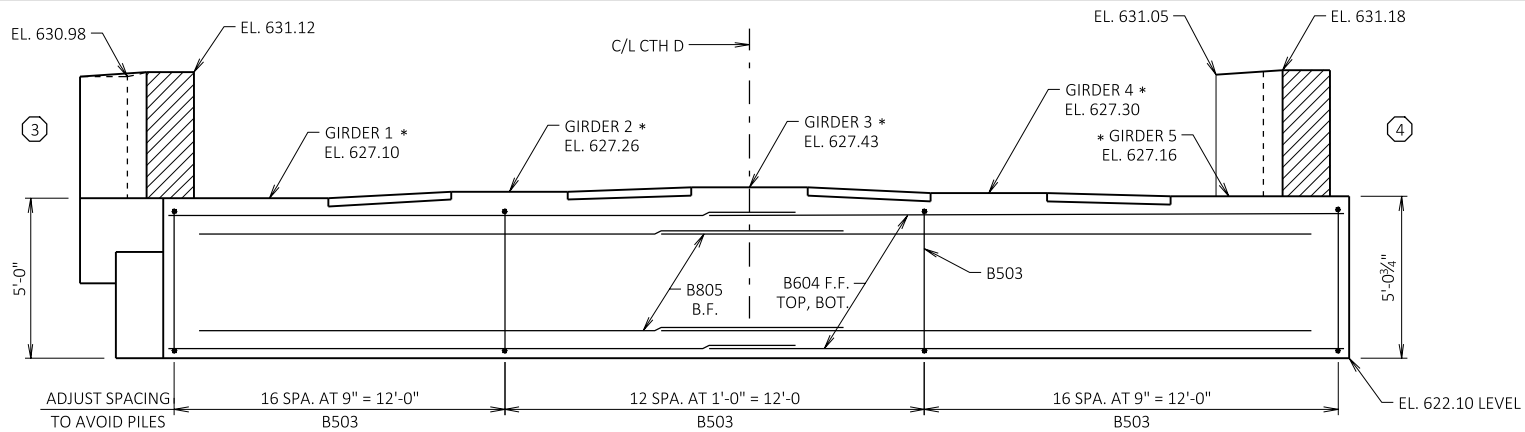

ELEVATION  
(LOOKING NORTH)

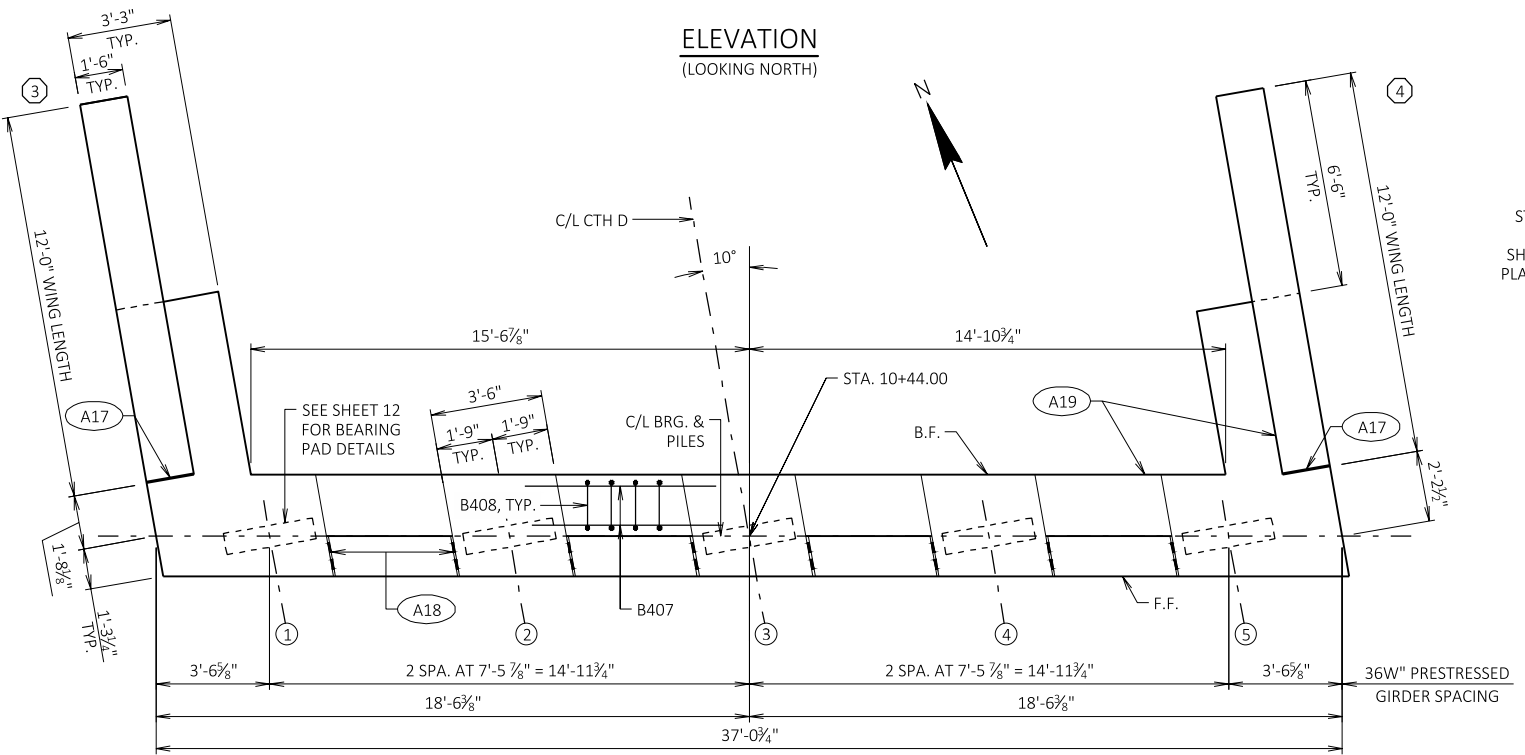

PLAN

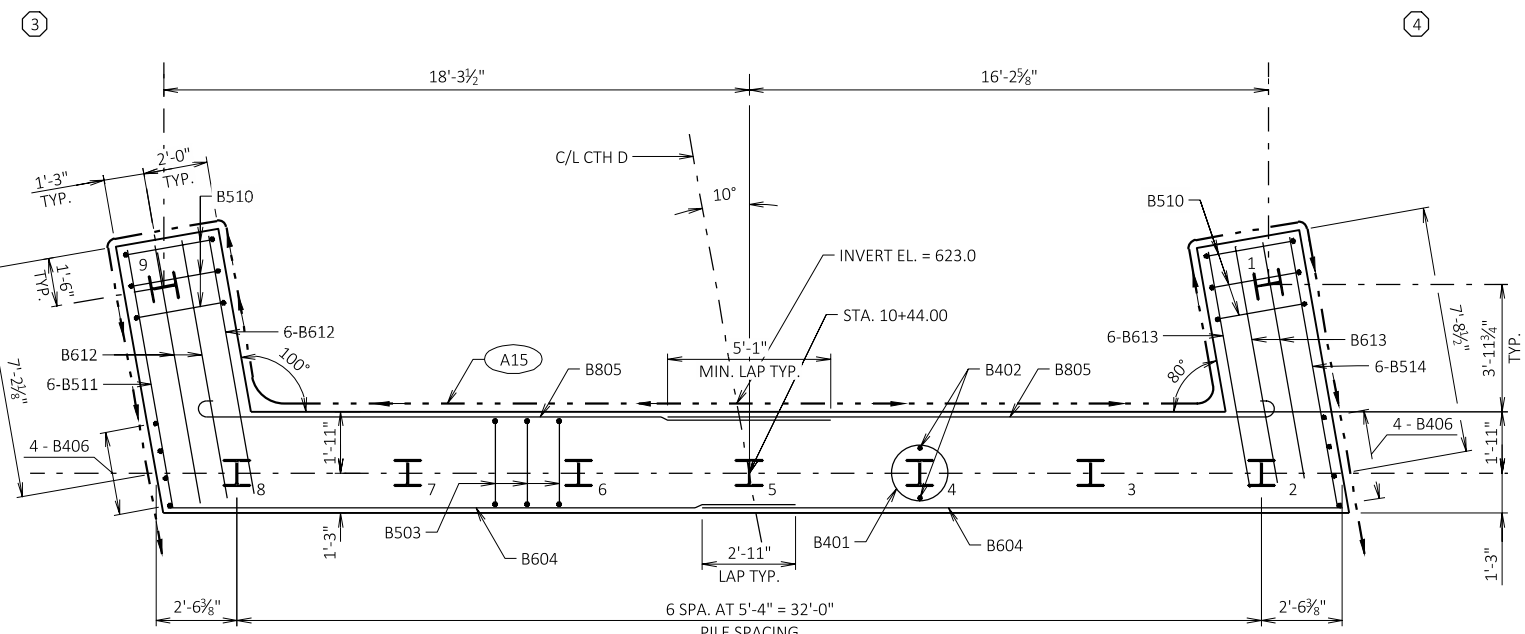


PILE PLAN

LEGEND

- INDICATES GIRDER NUMBER
- INDICATES WING NUMBER
- \* ELEVATION SHOWN AT THE TOP OF CONCRETE AT THE C/L OF BEARING.
- A09 SUPPORT ABUTMENT ON PILING STEEL HP 10-INCH x 42 LB, ESTIMATED 90 FEET LONG, DRIVEN TO A REQUIRED DRIVING RESISTANCE OF 165 TONS PER PILE. SEE ADDITIONAL FOUNDATION DATA ON SHEET 1 AND PILE SPICE DETAILS ON SHEET 2.
- A15 PIPE UNDERDRAIN WRAPPED 6-INCH. SLOPE 0.5% MIN. TO SUITABLE DRAINAGE. ATTACH RODENT SCREEN AT ENDS OF PIPE UNDERDRAIN. RODENT SHIELD TO BE INCLUDED IN BID PRICE OF "PIPE UNDERDRAIN WRAPPED 6-INCH".
- A17 1/2" FILLER (INCLUDED IN WING LENGTH): SEAL ALL EXPOSED HORIZONTAL AND VERTICAL SURFACES OF 1/2" FILLER WITH NON-STAINING GRAY NON-BITUMINOUS JOINT SEALER. (1" DEEP AND HOLD 1/8" BELOW SURFACE OF CONCRETE.)
- A18 3/4" CORK FILLER UP VERT. BEAM SEAT FACES THAT RUN PARALLEL WITH GIRDER.
- A19 18" RUBBERIZED MEMBRANE WATERPROOFING. SEAL ALL HORIZONTAL AND VERTICAL JOINTS ON BACKFACE.


B.F. DENOTES BACK FACE  
F.F. DENOTES FRONT FACE

STEEL TROWEL TOP SURFACE OF ABUTMENT.  
PLACE MULTIPLE LAYERS OF POLYETHYLENE  
SHEETS OVER ENTIRE ABUTMENT TOP BEFORE  
PLACING BEARING PADS. TOTAL THICKNESS OF  
SHEETS SHALL BE AT LEAST 0.03".

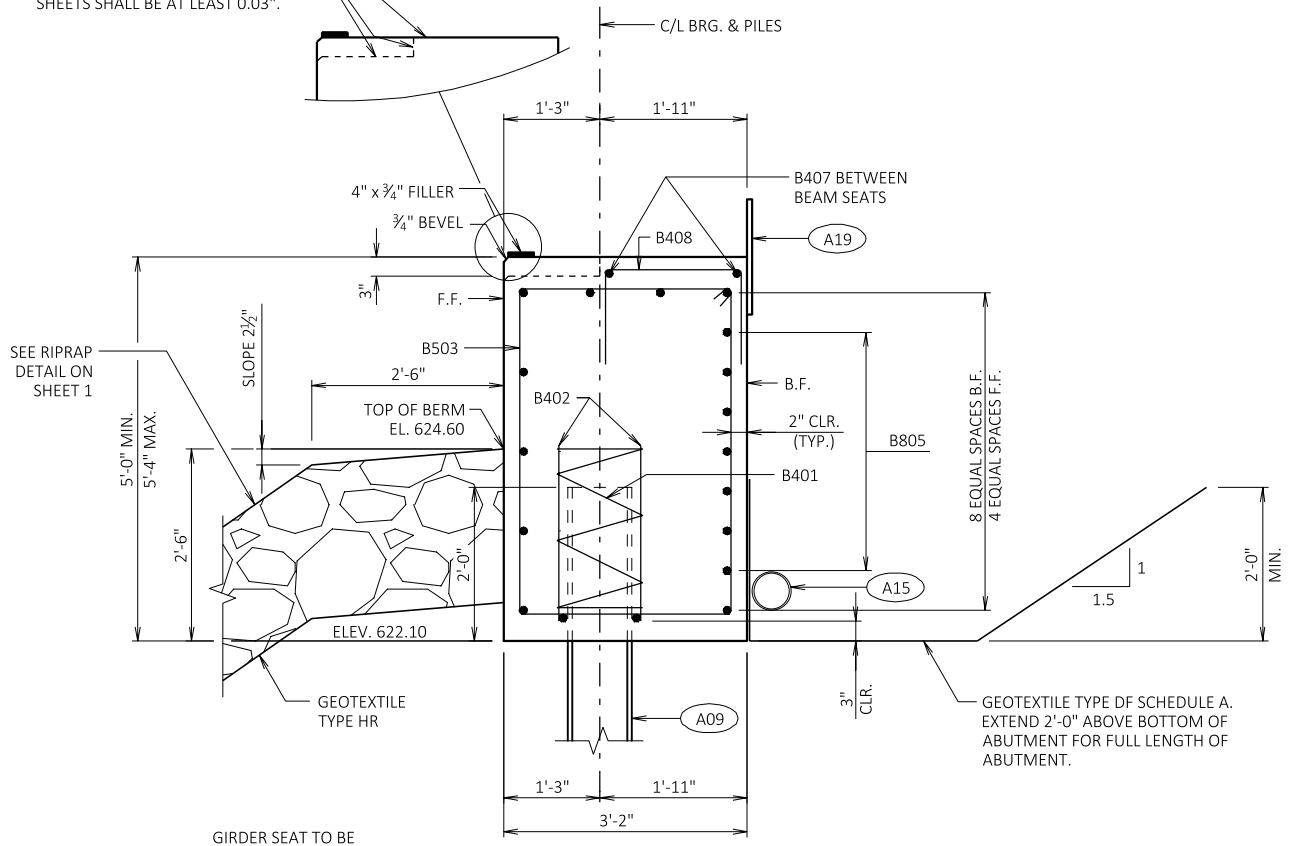

SECTION THRU BODY


HORIZONTAL BARS NOT OTHERWISE IDENTIFIED  
ARE B604 BARS

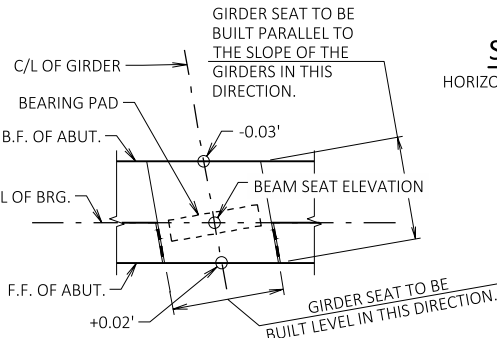

GIRDER SEAT DETAIL

STATE PROJECT NUMBER

4546-02-71

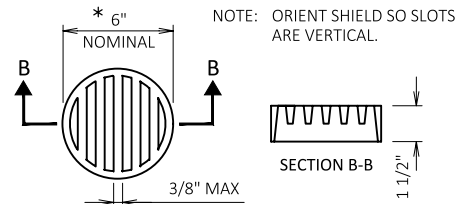

\* DIMENSION IS APPROXIMATE. THE GRATE  
IS SIZED TO FIT INTO A PIPE COUPLING.

RODENT SHIELD DETAIL

THE RODENT SHIELD, PIPE COUPLING AND SCREWS SHALL BE  
CONSIDERED INCIDENTAL TO THE BID ITEM "PIPE UNDERDRAIN  
WRAPPED 6-INCH".

THE RODENT SHIELD SHALL BE A PVC GRATE SIMILAR  
TO THIS DETAIL. THE GRATE IS COMMERCIALY AVAILABLE  
AS A FLOOR STRAINER. A PIPE COUPLING IS REQUIRED  
FOR THE ATTACHMENT OF THIS SHIELD TO THE OUTFALL  
PIPE. THE SHIELD SHALL BE FASTENED TO THE PIPE  
COUPLING WITH TWO OR MORE NO. 10 X 1-INCH  
STAINLESS STEEL SHEET METAL SCREWS.

NO.	DATE	REVISION	BY
STATE OF WISCONSIN DEPARTMENT OF TRANSPORTATION			
STRUCTURE B-5-440			
DRAWN BY		PKF	PLANS CK'D. ETP
NORTH ABUTMENT		SHEET 6 OF 13	
		42	



BILL OF BARS - NORTH ABUTMENT

DIMENSIONS IN BENDING DETAILS ARE OUT-TO-OUT OF BAR.

BAR MARK	NO. REQ'D	LENGTH	BENT	BAR SERIES	LOCATION
NON-COATED BARS					TOTAL WEIGHT = 2,440 LBS
B401	9	28'-0"	X		BODY - AT PILES - 1 PER PILE VERT.
B402	18	2'-3"			BODY - AT PILES - 2 PER PILE VERT.
B503	45	15'-2"	X		BODY - STIRRUPS VERT.
B604	22	19'-10"			BODY - B.F. & F.F. & TOP & BTM HORIZ.
B805	14	20'-4"	X		BODY - B.F. HORIZ.
B406	8	4'-7"			BODY - ENDS VERT.
B407	8	6'-0"			BODY - BTWN BEAM SEATS HORIZ.
B408	16	4'-11"	X		BODY - BTWN BEAM SEATS VERT.
COATED BARS					TOTAL WEIGHT = 1,420 LBS
B510	12	15'-4"	X		WINGS 3 & 4 - STIRRUPS VERT.
B511	6	8'-1"			WING 3 - F.F. HORIZ.
B612	9	8'-1"			WING 3 - TOP & B.F. HORIZ.
B613	9	7'-6"			WING 4 - TOP & B.F. HORIZ.
B514	6	8'-6"			WING 4 - F.F. HORIZ.
B415	16	7'-9"			WINGS 3 & 4 - OVERHANG HORIZ.
B416	18	11'-8"			WINGS 3 & 4 HORIZ.
B517	22	12'-7"	X		WINGS 3 & 4 VERT.
B518	26	11'-11"	X		WINGS 3 & 4 - OVERHANG VERT.
B619	4	11'-8"			WINGS 3 & 4 - TOP HORIZ.

THE FIRST DIGIT OR FIRST TWO DIGITS OF THE BAR MARK SIGNIFIES THE BAR SIZE.

LEGEND

- A03

OPTIONAL KEYED CONST. JOINT FORMED BY BEVELED 2" x 6" (18" RUBBERIZED MEMBRANE WATERPROOFING AT B.F. & ¾" "V" GROOVE AT F.F. IF JOINT IS USED).
- A09


SUPPORT ABUTMENT ON PILING STEEL HP 10-INCH x 42 LB, ESTIMATED 90 FEET LONG, DRIVEN TO A REQUIRED DRIVING RESISTANCE OF 165 TONS PER PILE. SEE ADDITIONAL FOUNDATION DATA ON SHEET 1 AND PILE SPLICE DETAILS ON SHEET 2.
- A15

PIPE UNDERDRAIN WRAPPED 6-INCH. SLOPE 0.5% MIN. TO SUITABLE DRAINAGE. ATTACH RODENT SCREEN AT ENDS OF PIPE UNDERDRAIN. RODENT SHIELD TO BE INCLUDED IN BID PRICE OF "PIPE UNDERDRAIN WRAPPED 6-INCH".
- A17


½" FILLER (INCLUDED IN WING LENGTH): SEAL ALL EXPOSED HORIZONTAL AND VERTICAL SURFACES OF ½" FILLER WITH NON-STAINING GRAY NON-BITUMINOUS JOINT SEALER. (1" DEEP AND HOLD 1/8" BELOW SURFACE OF CONCRETE.)
- A19

18" RUBBERIZED MEMBRANE WATERPROOFING. SEAL ALL HORIZONTAL AND VERTICAL JOINTS ON BACKFACE.


B.F. DENOTES BACK FACE  
F.F. DENOTES FRONT FACE

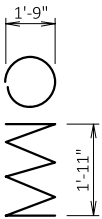


B401

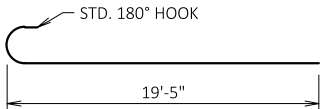


B805

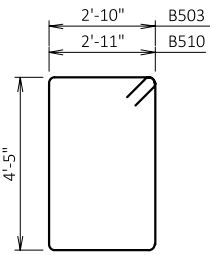

B503, B510

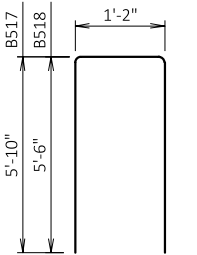


B517, B518

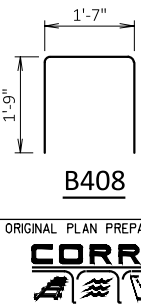


B408




NO.	DATE	REVISION	BY
STATE OF WISCONSIN DEPARTMENT OF TRANSPORTATION			
STRUCTURE B-5-440			
DRAWN BY PKF		PLANS CK'D. ETP	
NORTH ABUTMENT DETAILS			SHEET 7 OF 13
			43

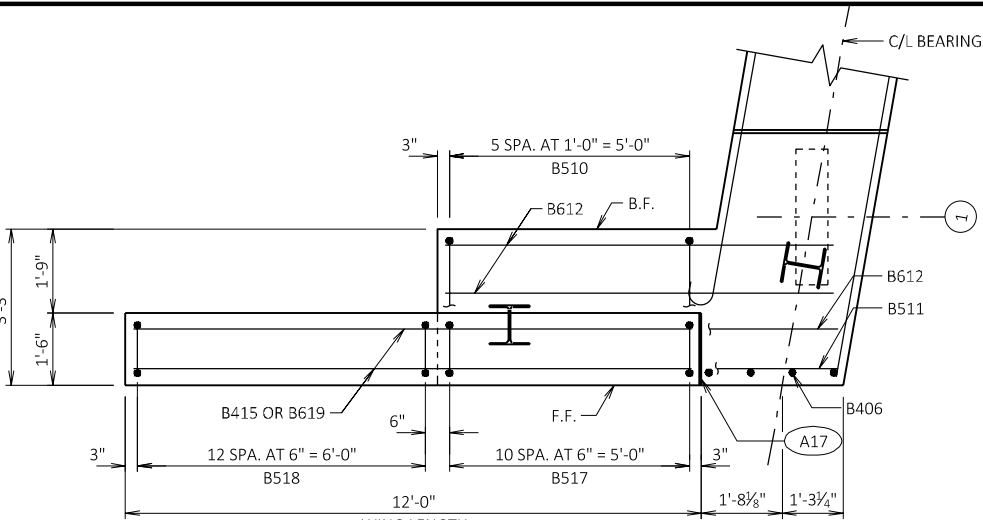


PLAN WING 3

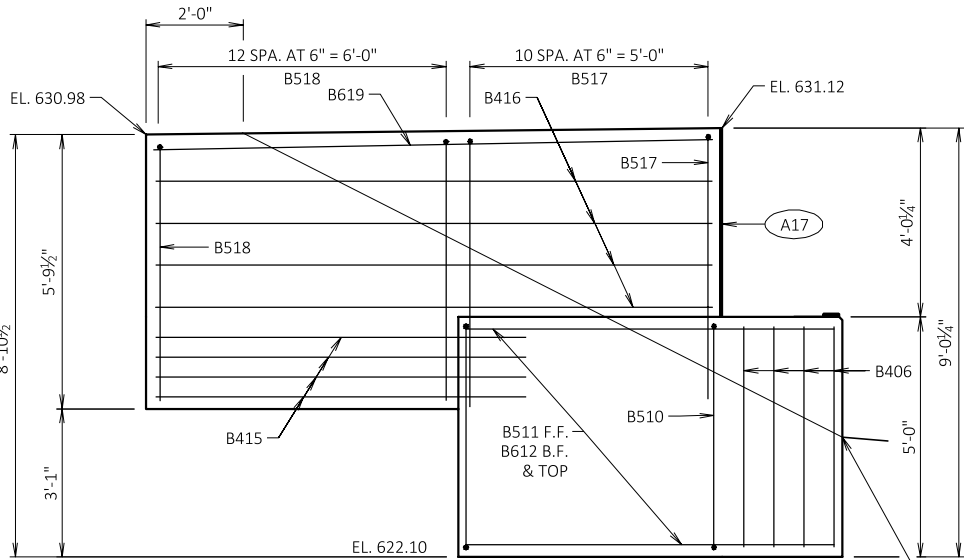


ELEVATION WING 3

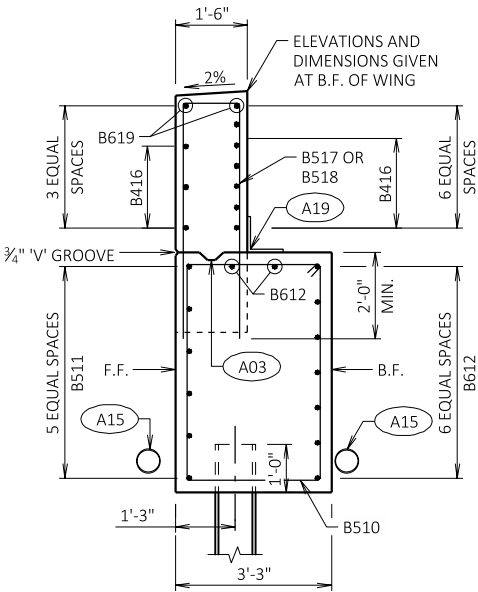


SECTION THRU WING 3

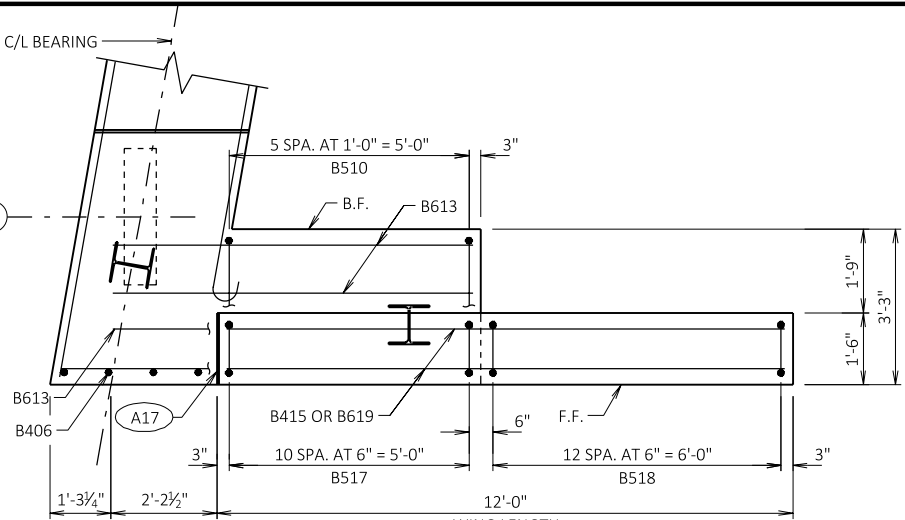

PLAN WING 4

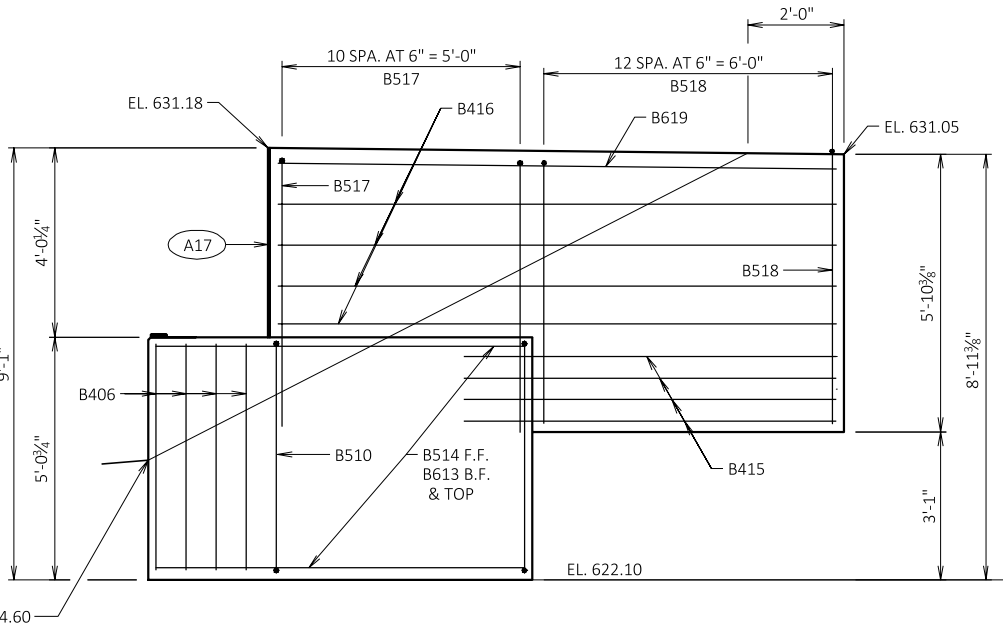

ELEVATION WING 4

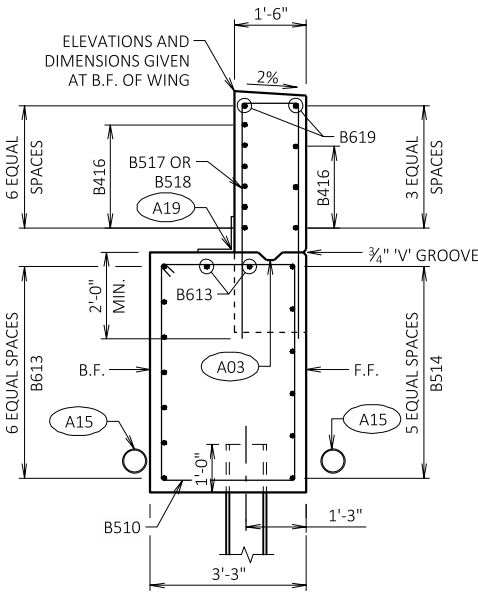


SECTION THRU WING 4


TOP OF GIRDER TO BE ROUGH FLOATED AND BROOMED TRANSVERSELY, EXCEPT THE THE OUTSIDE 8" OF GIRDER, WHICH SHALL RECEIVE A SMOOTH FINISH. AN APPROVED CONCRETE SEALER SHALL BE APPLIED TO ALL SMOOTH SURFACES INCLUDING THE OUTSIDE 8" OF THE TOP FLANGE.

THE GIRDERS SHALL BE PROVIDED WITH A SUITABLE LIFTING  
DEVICE FOR HANDLING AND ERECTING THE GIRDERS. SEE  
SECT. 503.3.3 OF STANDARD SPECIFICATIONS FOR GUIDANCE.

FOR DIAPHRAGM INSERT & CONNECTION DETAILS SEE  
"STEEL DIAPHRAGM" SHEET.

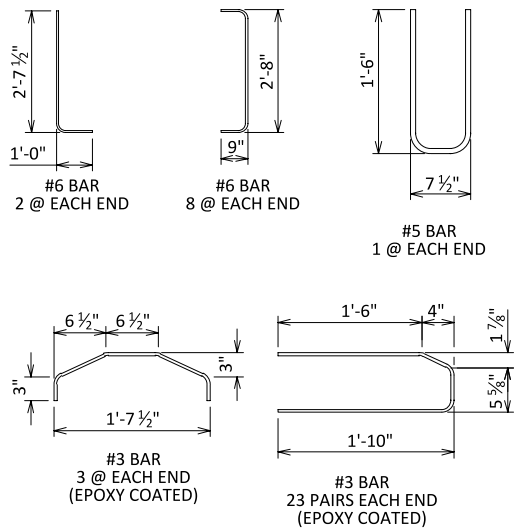
[illegible]

NO.	DATE	REVISION	BY
STATE OF WISCONSIN DEPARTMENT OF TRANSPORTATION			
STRUCTURE B-5-440			
DRAWN BY		PKF	PLANS C'D. ETP
36W" PRESTRESSED GIRDER DETAILS 1		SHEET 8 OF 13	
		44	

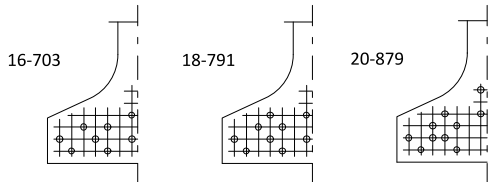


STANDARD ARRANGEMENTS TO RAISE CENTER OF GRAVITY  
TO AVOID DRAPING OF STRANDS


0.6"Ø STRANDS

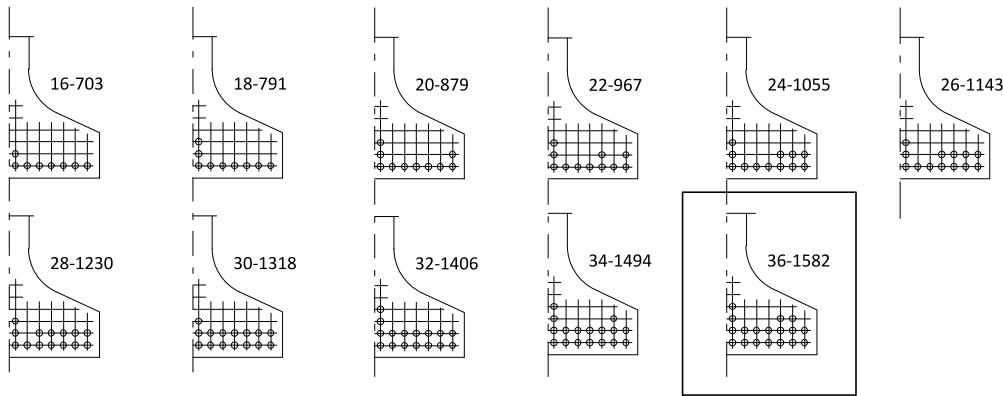

SPAN 1

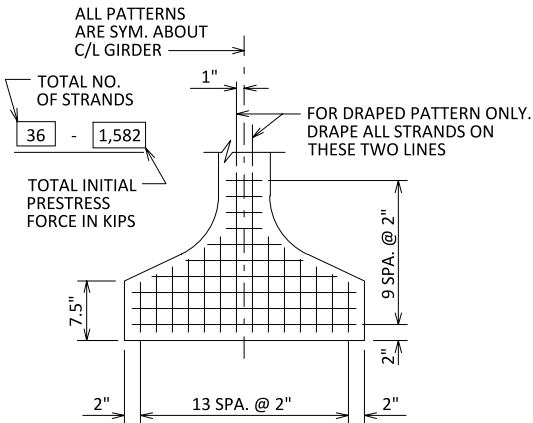

TYP. STRAND PATTERN

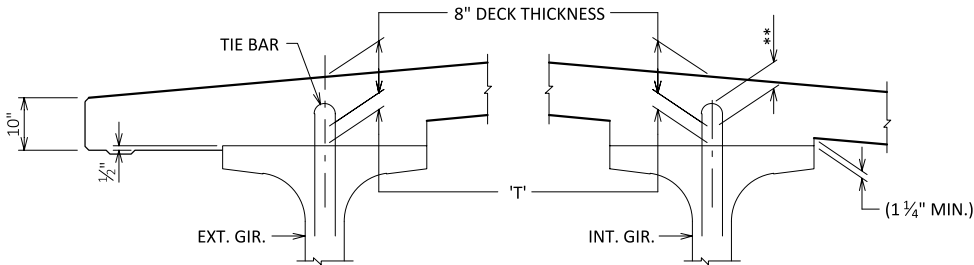

DECK HAUNCH DETAIL

IF 1 1/4" MINIMUM HAUNCH HEIGHT AT EDGE OF GIRDER CANNOT BE MAINTAINED, THE GRADE LINE MAY BE REVISED BY THE ENGINEER AT THE OPTION OF THE CONTRACTOR, THE PLAN DECK THICKNESS SHALL BE HELD. NOTIFY THE STRUCTURES SECTION IF THE GRADE LINE IS RAISED FROM THE PLAN PROFILE BY MORE THAN " OR, \*\* IF 3" MINIMUM DECK EMBEDMENT OF TIE BAR CANNOT BE OBTAINED.


TO DETERMINE 'T', ELEV. OF TOP OF GIR'S. AT C/L OF SUBSTRUCTURE UNITS & AT 1/10 POINTS OF EACH SPAN SHALL BE TAKEN. THEN FOLLOW THIS PROCESS:

TOP OF DECK ELEV. AT FINAL GRADE  
- TOP OF GIRDER ELEVATION  
+ DEAD LOAD DEFLECTION  
- DECK THICKNESS  
= HAUNCH HEIGHT 'T'

NOTE: AN AVERAGE HAUNCH ('T') OF 3 5/8" WAS USED IN THE QUANTITY "CONCRETE MASONRY BRIDGES".

ARRANGEMENT AT C/L SPAN - FOR GIRDERS WITH DRAPED STRANDS

0.6"Ø STRANDS

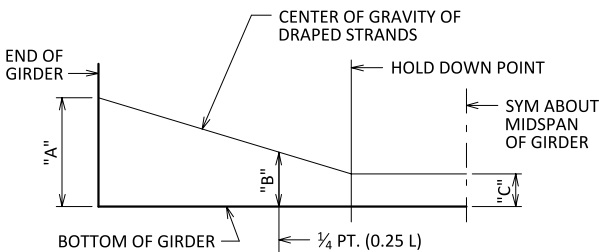


DRAPED STRAND PROFILE

\* THE THEORETICAL INITIAL CAMBER VALUE AT THE TIME OF STRAND RELEASE AT MIDSPAN MULTIPLIED BY A FACTOR OF 1.4 TO ACCOUNT FOR CAMBER GROWTH FROM THE TIME OF STRAND RELEASE TO JOBSITE PLACEMENT.

SPAN	CAMBER (IN.) *
1	4 1/8"

THESE VALUES ARE NOT TO BE USED IN DETERMINING 'T', USE ACTUAL GIRDER SHOTS.  
THESE VALUES ARE FOR INFORMATIONAL PURPOSES ONLY.

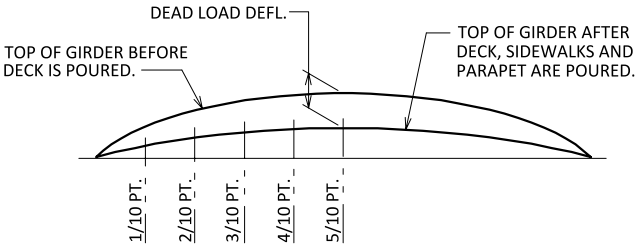

DEAD LOAD DEFLECTION DIAGRAM

NO.	DATE	REVISION	BY
STATE OF WISCONSIN DEPARTMENT OF TRANSPORTATION			
STRUCTURE B-5-440			
	DRAWN BY	PKF	PLANS CK'D. ETP
36W" PRESTRESSED GIRDER DETAILS 2			SHEET 9 OF 13
			45



NOTES


ALL DIAPHRAGM MATERIAL NOT EMBEDDED IN THE CONCRETE GIRDER SHALL BE PAID FOR AT THE UNIT PRICE BID FOR "STEEL DIAPHRAGMS B-5-440", EACH.

EACH DIAPHRAGM BETWEEN GIRDERS SHALL CONSTITUTE ONE UNIT.


ALL DIAPHRAGM STRUCTURAL STEEL SHALL BE ASTM A709 GRADE 36.

ALL DIAPHRAGM MATERIAL INCLUDING BOLTS, NUTS AND WASHERS SHALL BE GALVANIZED AFTER FABRICATION.

STEEL DIAPHRAGM TO CONCRETE WEB CONNECTION SHALL BE SNUG-TIGHT PLUS , TURN, UNLESS NOTED OTHERWISE. HIGH STRENGTH BOLTS FOR WEB CONNECTION SHALL MEET THE REQUIREMENTS FOR ASTM A325 OR ASTM A449.

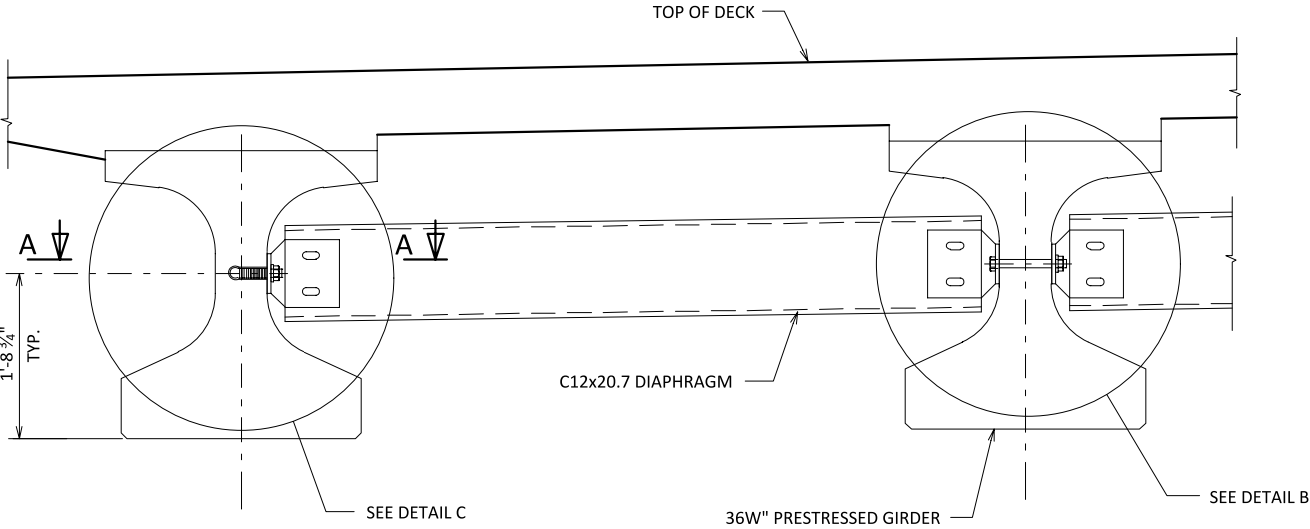


PART TRANSVERSE SECTION AT DIAPHRAGM

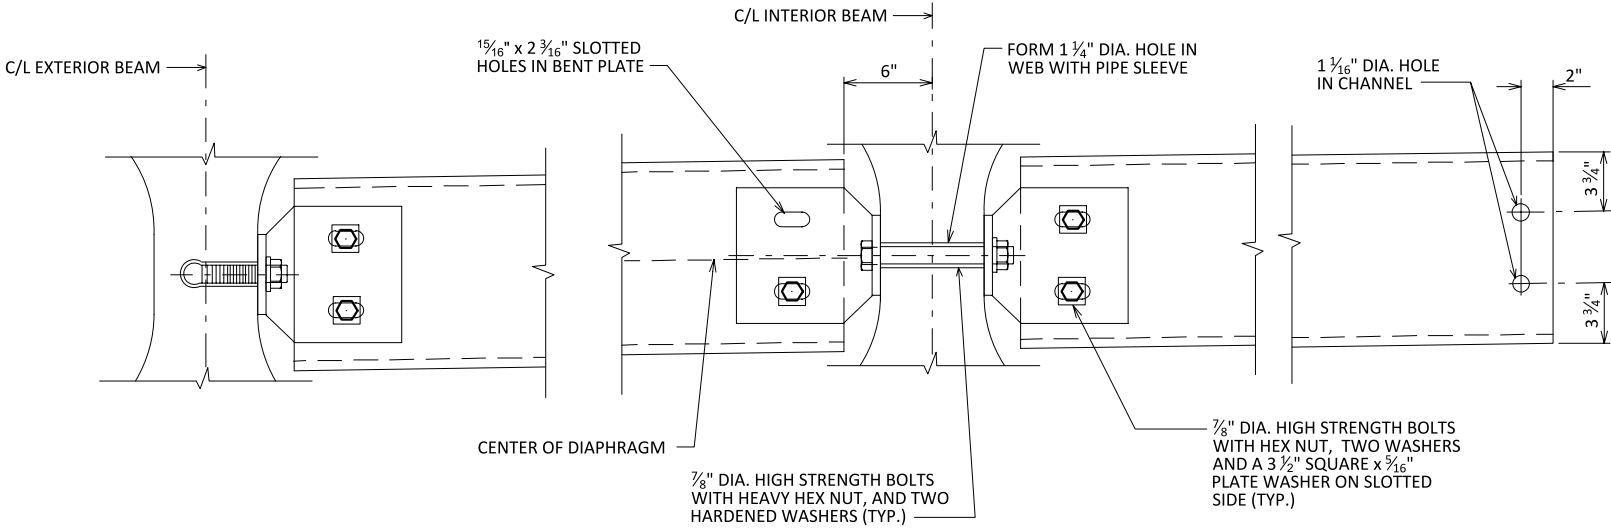


DETAIL C



DETAIL B

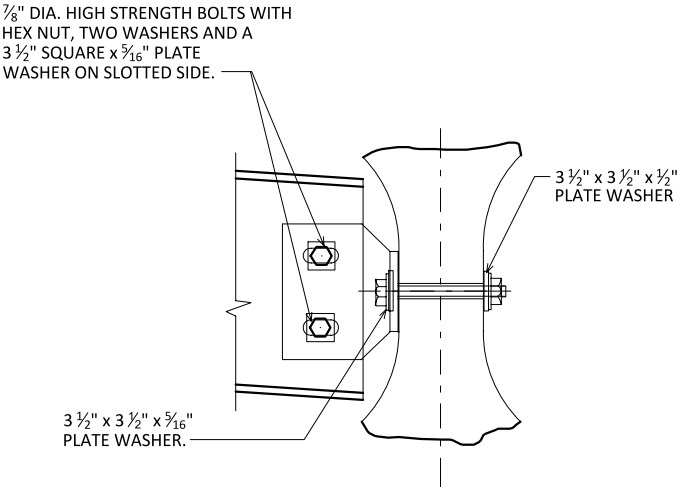


SECTION AT INTERIOR GIRDERS THRU DIAPHRAGM FOR SKEW ANGLES > 10°

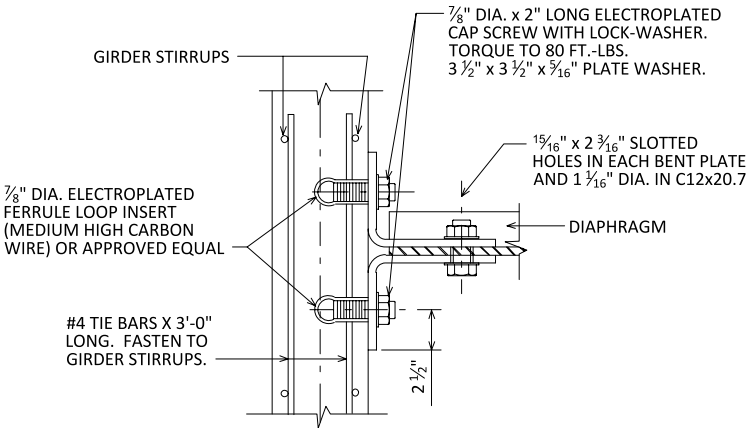

SECTION A-A  
(FOR EXTERIOR ATTACHMENT)

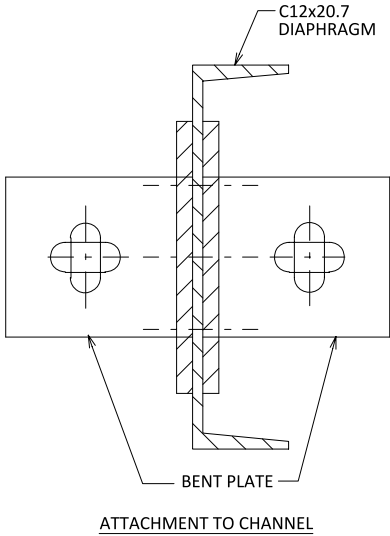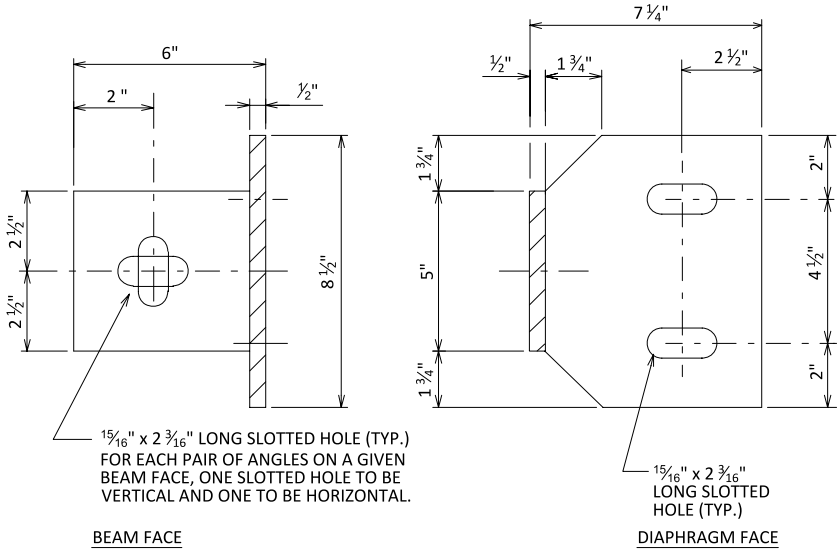

NO.	DATE	REVISION	BY
STATE OF WISCONSIN DEPARTMENT OF TRANSPORTATION			
STRUCTURE B-5-440			
DRAWN BY PKF		PLANS CK'D. ETP	
STEEL DIAPHRAGM		SHEET 10 OF 13	
		46	

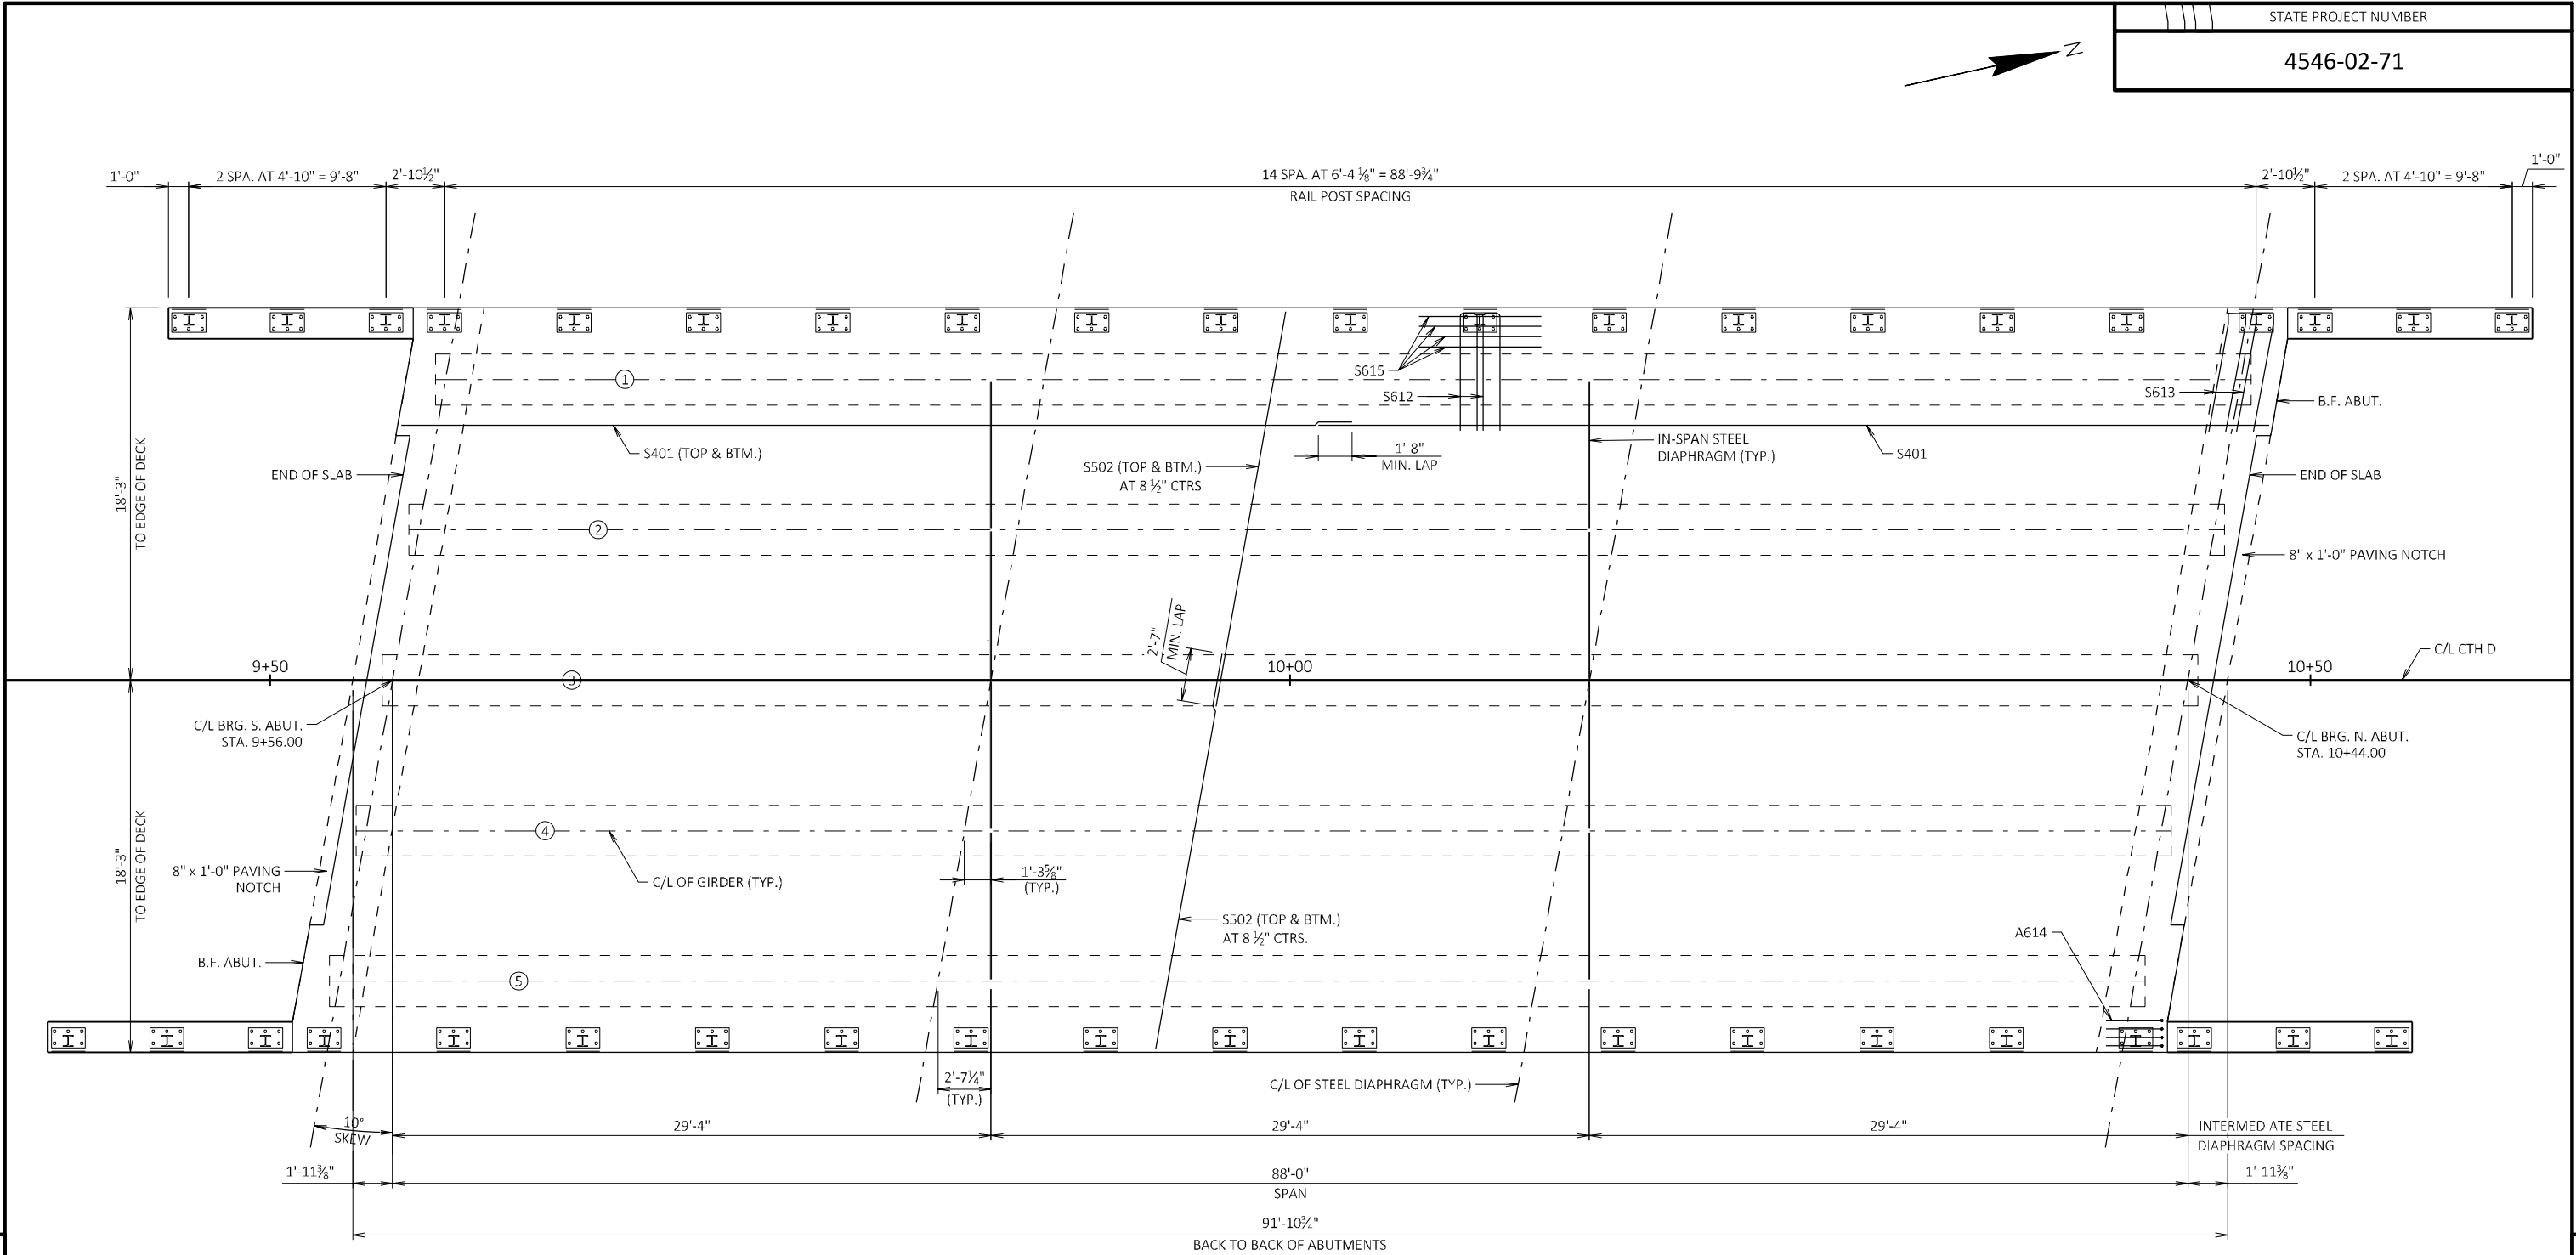

PLAN

TOP OF DECK ELEVATIONS

	C/L BRG. S. ABUT.	1/10	2/10	3/10	4/10	5/10	6/10	7/10	8/10	9/10	C/L BRG. N. ABUT.
GIRDER 1	632.29	632.15	632.03	631.91	631.81	631.71	631.61	631.51	631.41	631.31	631.21
GIRDER 2	632.45	632.32	632.20	632.08	631.97	631.87	631.77	631.67	631.57	631.47	631.38
GIRDER 3	632.62	632.49	632.36	632.24	632.13	632.03	631.93	631.83	631.73	631.64	631.54
GIRDER 4	632.50	632.36	632.23	632.11	632.00	631.90	631.80	631.70	631.60	631.50	631.40
GIRDER 5	632.37	632.23	632.10	631.98	631.87	631.76	631.67	631.57	631.47	631.37	631.27

NOTES

1. THE TOP LONGITUDINAL BAR STEEL REINFORCEMENT SHALL BE SUPPORTED BY CONTINUOUS BAR CHAIRS IN TRANSVERSE DIRECTION ON 4'-0" CENTERS.
2. THE BOTTOM TRANSVERSE BAR STEEL REINFORCEMENT SHALL BE CONTINUOUS BAR CHAIRS WITH A CENTER TO CENTER SPACING NOT TO EXCEED 4'-0". ONE LINE OF CONTINUOUS BAR CHAIRS SHALL BE PLACED NEAR EACH EDGE OF SLAB TO SUPPORT THE ENDS OF THE BOTTOM TRANSVERSE BAR STEEL.
3. ALL TRANSVERSE BAR STEEL REINFORCEMENT SHALL BE PLACED PARALLEL TO SUBSTRUCTURE UNITS.

NO.

DATE

REVISION

BY

STATE OF WISCONSIN  
DEPARTMENT OF TRANSPORTATION

STRUCTURE B-5-440

DRAWN BY

PKF

PLANS CK'D.

ETP


SUPERSTRUCTURE

SHEET 11 OF 13

47

ORIGINAL PLAN PREPARED BY



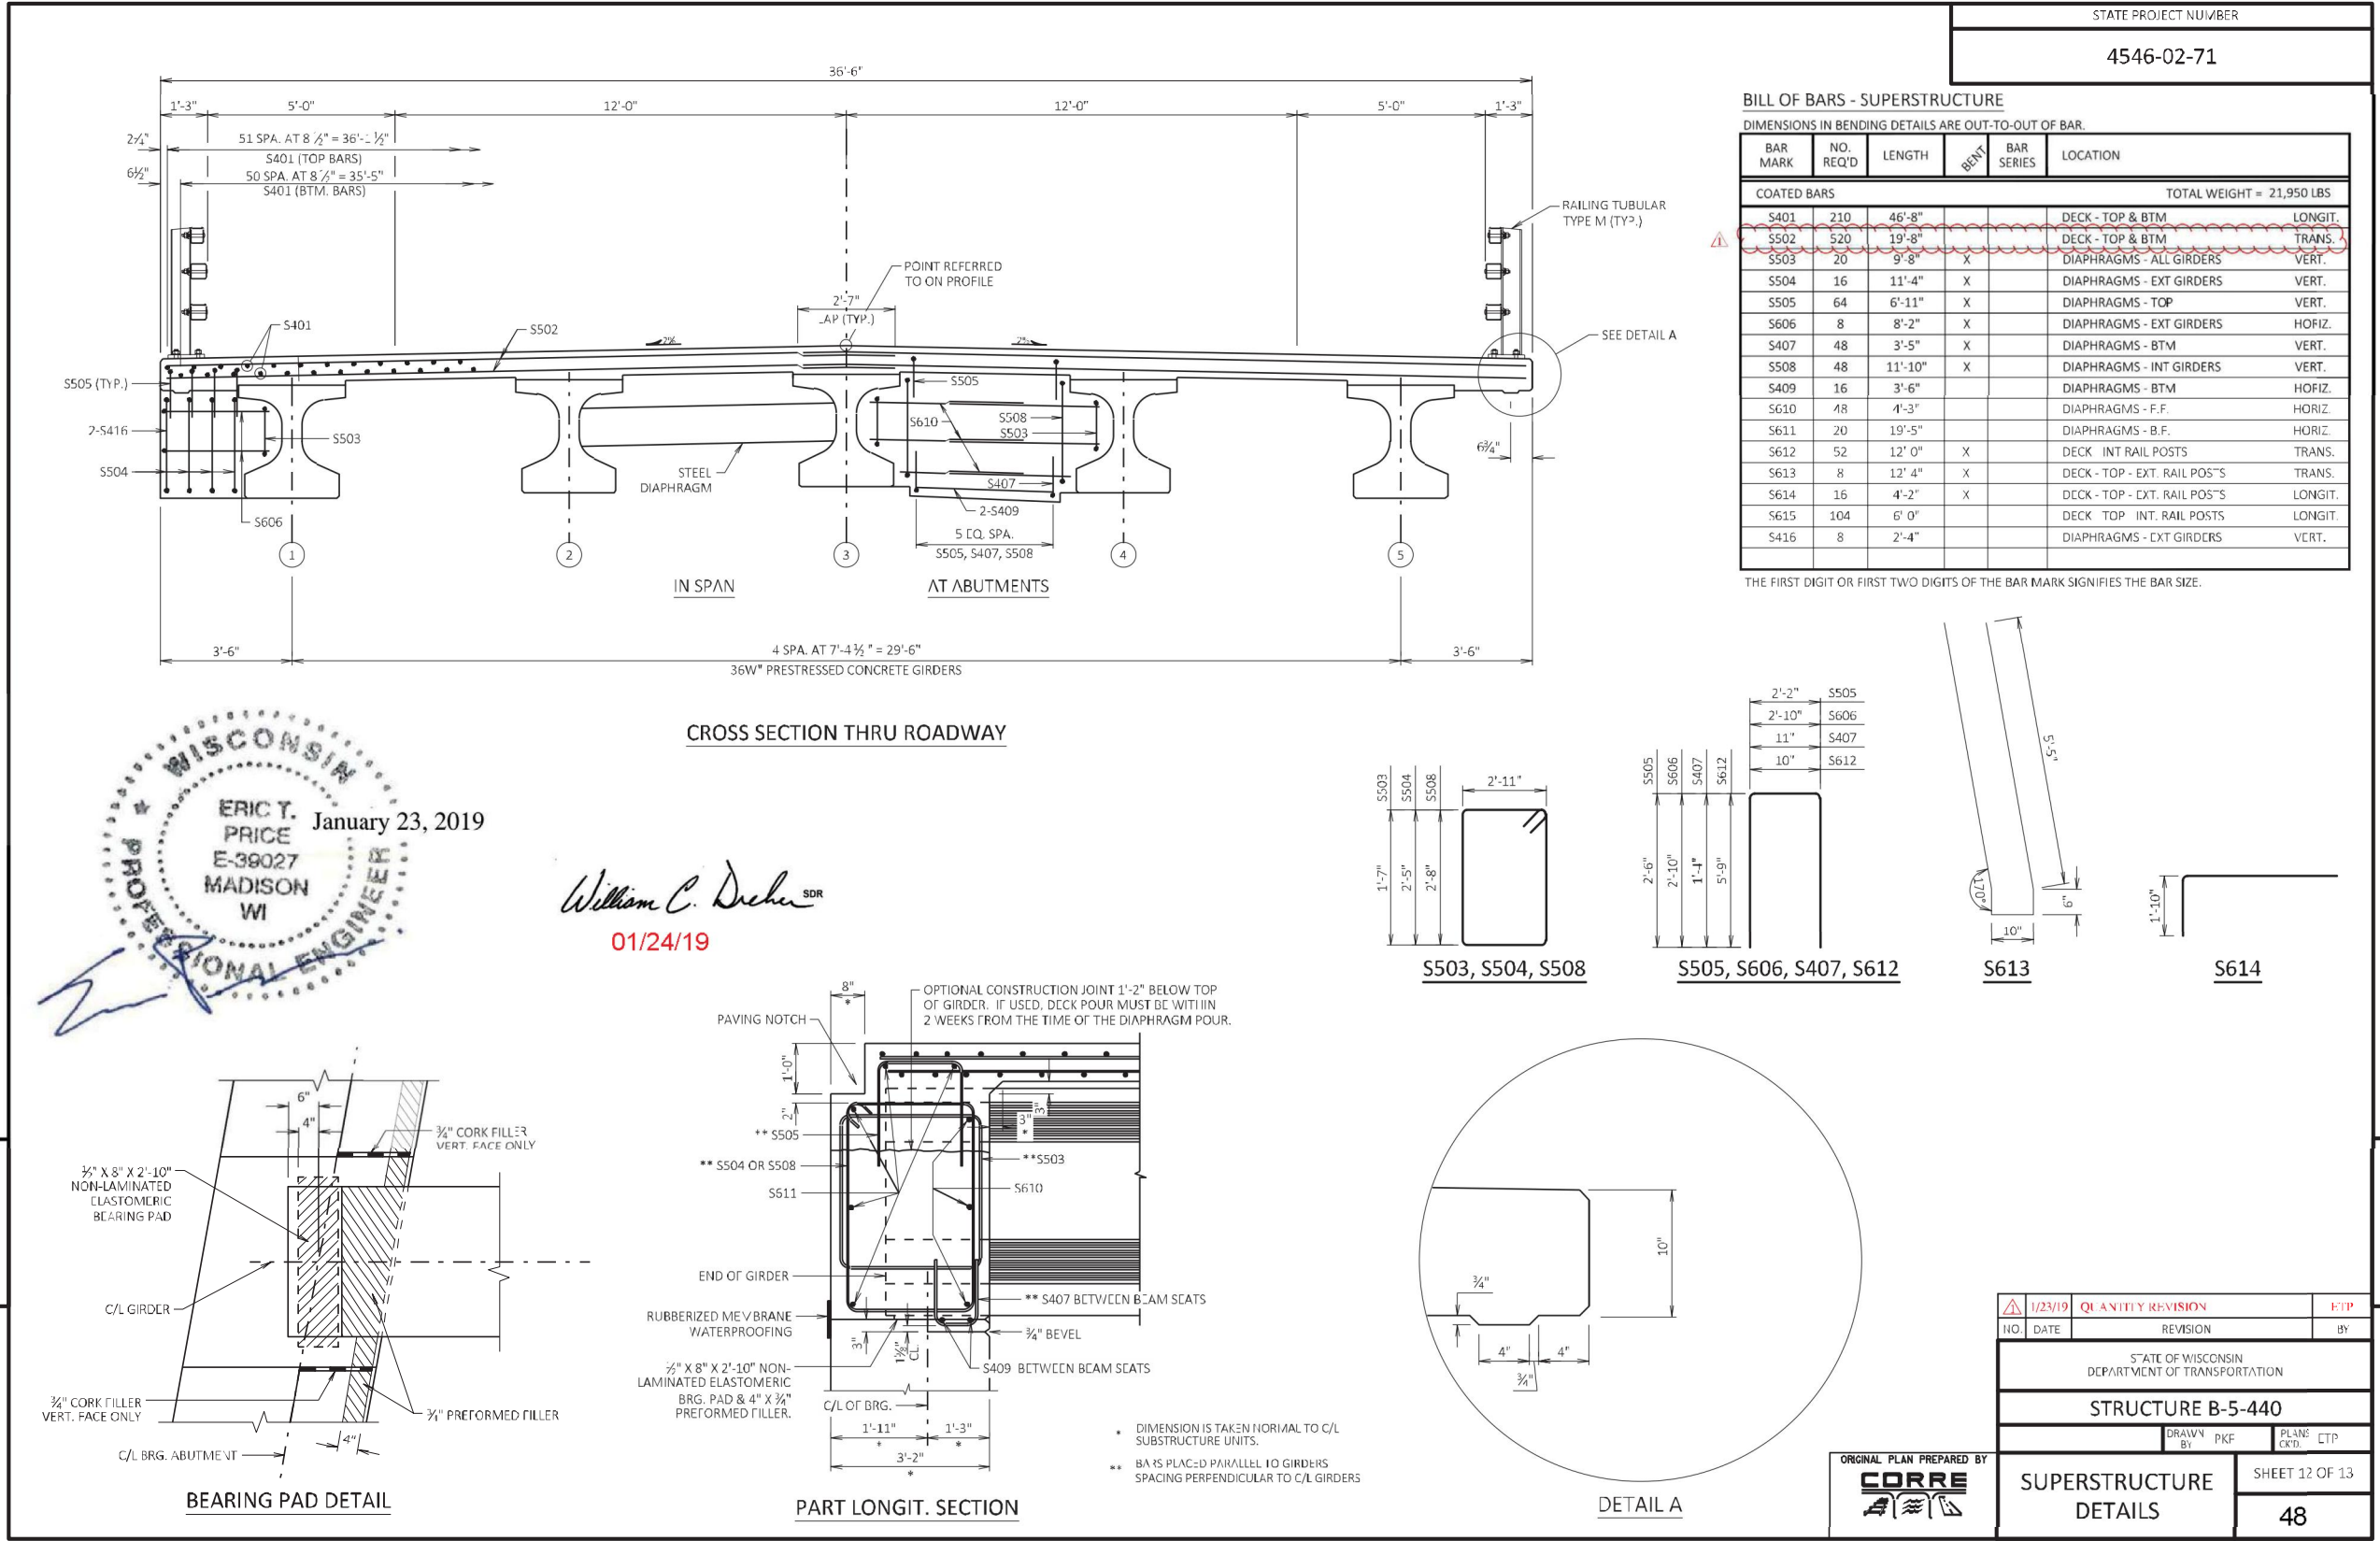

WISCONSIN  
ERIC T. PRICE  
January 23, 2019  
E-39027  
MADISON  
WI  
PROFESSIONAL ENGINEER

William C. Decker SDR  
01/24/19

1/23/19		QUANTITY REVISION	HTP
NO.	DATE	REVISION	BY
STATE OF WISCONSIN DEPARTMENT OF TRANSPORTATION			
STRUCTURE B-5-440			
DRAWN BY		PKF	PLANE CTD
SUPERSTRUCTURE DETAILS		SHEET 12 OF 13	
		48	




- ① W6 X25 WITH 1 5/8" X 1 1/2" HORIZ. SLOTS ON EACH SIDE OF POST FOR BOLT NO. 6. CUT BOTTOM OF POST TO MATCH CROSS SLOPE OF ROADWAY. PLACE POST VERTICAL. PLACE POSTS NORMAL TO GRADE LINE.
- ② PLATE 1 1/4" X 11 3/4" X 1'-8" WITH 1 5/16" X 1 5/8" SLOTTED HOLES FOR ANCHOR BOLTS NO. 3. WELD TO NO. 1 AS SHOWN. SLOTS PARALLEL TO SHORT SIDE OF
- ③ PLATE. ASTM A449 - 1 5/8" DIA. ANCHOR BOLTS WITH NUT AND HARDENED WASHER (ALL GALVANIZED). 5 REQ'D. PER POST. THREAD 3" AND PLACE NORMAL TO PLATE NO. 2. CHAMFER TOP OF BOLTS BEFORE THREADING. USE 1'-9" LONG IN ABUTMENT WINGS. AT POSTS ON CONCRETE SLAB SUPERSTRUCTURES WHERE THE SLAB THICKNESS IS > 16" USE 1'-3" LONG. USE 10 3/4" LONG AT ALL OTHER LOCATIONS. (AN EQUIVALENT THREADED ROD WITH NUTS AND HARDENED WASHERS MAY BE SUBSTITUTED FOR ANCHOR BOLTS IN WINGS IF REQ'D. FOR CONSTRUCTIBILITY.)
- ④ 5/8" X 11" X 1'-8" ANCHOR PLATE (GALVANIZED) WITH 1 5/16" DIA. HOLES FOR ANCHOR BOLTS NO. 3
- ⑤ TS 5 X 4 X 0.25 STRUCTURAL TUBING. ATTACH TO NO. 1 WITH NO. 6.
- ⑤A TS 5 X 5 X 0.25 STRUCTURAL TUBING. ATTACH TO NO. 1 WITH NO. 6.
- ⑥ 7/8" DIA. A325 SLOTTED ROUND HEAD BOLT WITH NUT, 3/16" X 1 5/8" X 1 5/8" WASHER, AND LOCK WASHER (2 REQ'D. AT EACH RAIL TO POST LOCATION.)
- ⑦ 1/2" THK. BACK-UP PLATE WITH 2 - 7/8" X 1 1/2" THREADED SHOP WELDED STUDS (NO. 12). BOLT TO RAIL AS SHOWN IN DETAIL. REQUIRED AT THRIE BEAM GUARD RAIL ATTACHMENTS ONLY. PLACE SYMMETRICALLY ABOUT TUBES NO. 5A.
- ⑧ 1" DIA. HOLES IN PLATE NO. 7 & TUBES NO. 5A FOR 7/8" DIA. A325 BOLTS WITH HEX NUTS AND WASHERS. 6 HOLES IN TUBES AND PLATE NO. 7.
- ⑨ SPLICE SLEEVE FABRICATED FROM 1/4" PLATE. PROVIDE "SLIDING FIT".
- ⑩ 3/8" X 3 3/8" X 2'-4" PLATE. 2 PER RAIL. USED IN NO. 5 & 5A.
- ⑩A 3/8" X 2 5/8" X 2'-4" PLATE USED IN NO. 5, 3/8" X 3 3/8" X 2'-4" PLATE USED IN NO. 5A. 2 PER RAIL.
- ⑪ 7/8" DIA. A325 ROUND HEAD BOLT WITH NUT, WASHER, AND LOCK WASHER. USE 1 5/16" X 1 1/2" LONGIT. SLOTTED HOLES AT FIELD JOINTS AND 1 5/8" X 2 1/4" MIN. LONGIT. SLOTTED HOLES AT EXP. JOINTS IN PLATE NO. 10A.
- ⑫ 7/8" DIA. X 1 1/2" LONG THREADED SHOP WELDED STUDS (2 REQ'D).
- ⑬ 3/8" X 8" X 1'-6" PLATE. BOLT TO RAIL AS SHOWN IN DETAIL. REQ'D. AT THRIE BEAM GUARD RAIL ATTACHMENTS ONLY. PLACE SYM. ABOUT TUBES NO. 5A.
- ⑭ 7/8" DIA. X 2" LONG A325 HEX BOLT WITH NUT AND WASHER (5 REQ'D.).
- ⑮ 1" DIA. HOLES IN TUBES NO. 5A FOR 1" DIA. A325 ROUND HEAD BOLT WITH NUT, WASHER, AND LOCK WASHER (4 REQ'D.). 4 HOLES IN TUBES.


1. BID ITEM SHALL BE "RAILING TUBULAR TYPE M" WHICH INCLUDES ALL ITEMS SHOWN.
2. RAIL POST AND BASE PLATES SHALL CONFORM TO THE REQUIREMENTS OF ASTM A709 GRADE 50. HOLLOW RAILING STRUCTURAL TUBING SHALL CONFORM TO THE REQUIREMENTS OF ASTM A500 GRADE B OR C WITH A CERTIFIED FY = 50 KSI. ANCHOR PLATES, AND SPLICE TUBE PLATES SHALL CONFORM TO THE REQUIREMENTS OF ASTM A709 GRADE 36.
3. THE NUT SECURING THE POST BASE PLATE TO THE CONCRETE SHALL BE TIGHTENED TO A SNUG FIT AND GIVEN AN ADDITIONAL „ TURN.
4. RAILS SHALL BE CONTINUOUS OVER A MINIMUM OF THREE (3) POSTS WITHOUT SPLICES WHERE POSSIBLE. RAILS SHALL BE SPLICED IN A PANEL OVER EXPANSION JOINTS.
5. ENDS OF TUBE SECTIONS SHALL BE SAWED. GRIND SMOOTH EXPOSED EDGES. ALL CUT ENDS SHALL BE TRUE AND SMOOTH.
6. WELD IS THE SAME ON BOTH FLANGES. FLANGE WELD DOES NOT REQUIRE MAGNETIC PARTICLE TESTING.
7. FILL BOLT SLOT OPENINGS IN POST SHIMS AND PLATE NO. 2 AND CAULK AROUND PERIMETER OF PLATE NO. 2 WITH NON-STAINING GRAY NON-BITUMINOUS JOINT SEALER. STEEL POST SHIMS MAY BE USED UNDER POSTS WHERE REQ'D. FOR ALIGNMENT.
8. POST BASE PLATES SHALL BE FLAT WITH ALL SURFACES SMOOTH AND FREE FROM WARP AND ALL EDGES SMOOTH, STRAIGHT AND VERTICAL. ALL PLATE CUTS SHALL BE MACHINE OR MACHINE FLAME CUT.
9. ALL MATERIAL SHALL BE GALVANIZED AFTER FABRICATION. PRIOR TO GALVANIZING, ALL STEEL RAILING POSTS & STEEL TUBING SHALL BE GIVEN A NO. 6 BLAST CLEANING BY SSPC SPECIFICATIONS.

RDWY. OPENING OR 2" MIN. FOR STRIP SEAL  
EXP. JOINT & " OPENING FOR A1 ABUTMENT.

NO.	DATE	REVISION	BY
STATE OF WISCONSIN DEPARTMENT OF TRANSPORTATION			
STRUCTURE B-5-440			
		DRAWN BY	PKF
		PLANS CK'D.	ETP
RAILING TUBULAR TYPE M		SHEET 13 OF 13	
		49	

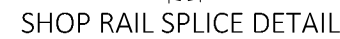

LOCATION MUST BE  
SHOWN ON SHOP DRAWINGS

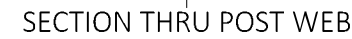


NOTE: CONNECTIONS AT LOWER RAILS SHOWN.  
CONNECTIONS AT TOP RAIL SIMILAR.

## TYPICAL RAIL TO POST CONNECTIONS



THREE BEAM RAIL ATTACHMENT

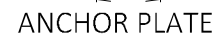

AT BEAM GUARD ATTACHMENT



### AT BEAM GUARD ATTACHMENT



THREE BEAM RAIL ATTACHMENT

