

As Built

GRE JUN 09

PROJECT ID: 1120-09-73
WITH: N/A

COUNTY: WINNEBAGO

ORDER OF SHEETS

Section No.	1	Title
Section No.	2	Typical Sections and Details
Section No.	3	Estimate of Quantities
Section No.	3	Miscellaneous Quantities
Section No.	4	Right-of-Way Plat
Section No.	5	Plan and Profile
Section No.	6	Standard Detail Drawings
Section No.	7	Sign Plates
Section No.	8	Structure Plans
Section No.	9	Computer Earthwork Data
Section No.	9	Cross Sections

TOTAL SHEETS = 130



DESIGN DESIGNATION

		STH 114
A.D.T.	2005	= N/A
A.D.T.	2035	= N/A
D.H.V.		= N/A
D.D.		= N/A
T.		= N/A
DESIGN SPEED		= 35 MPH
ESALS		= N/A

CONVENTIONAL SYMBOLS


PLAN	
CORPORATE LIMITS	////
PROPERTY LINE	---
LOT LINE	- - -
LIMITED HIGHWAY EASEMENT	L---
EXISTING RIGHT OF WAY	---
PROPOSED OR NEW R/W LINE	---
SLOPE INTERCEPT	- - -
REFERENCE LINE	---
EXISTING CULVERT	---
PROPOSED CULVERT (Box or Pipe)	---
COMBUSTIBLE FLUIDS	CAUTION
MARSH AREA	~ ~ ~
WOODED OR SHRUB AREA	~ ~ ~
DITCH FLOW LINE	---

PROFILE

GRADE LINE	---
ORIGINAL GROUND	---
MARSH OR ROCK PROFILE (To be noted as such)	---
SPECIAL DITCH	---
GRADE ELEVATION	95.36
CULVERT (Profile View)	---
UTILITIES	
ELECTRIC	---
FIBER OPTIC	---
GAS	---
SANITARY SEWER	---
STORM SEWER	---
TELEPHONE	---
OVERHEAD COMMUNICATIONS	---
UNDERGROUND COMMUNICATIONS	---
WATER	---
UTILITY PEDESTAL	---
POWER POLE	---
TELEPHONE POLE	---

STATE OF WISCONSIN
DEPARTMENT OF TRANSPORTATION
PLAN OF PROPOSED IMPROVEMENT
STH 26 - BREEZEWOOD LANE
USH 45 - BREEZEWOOD LANE
USH 41
WINNEBAGO COUNTY

STATE PROJECT NUMBER
1120-09-73

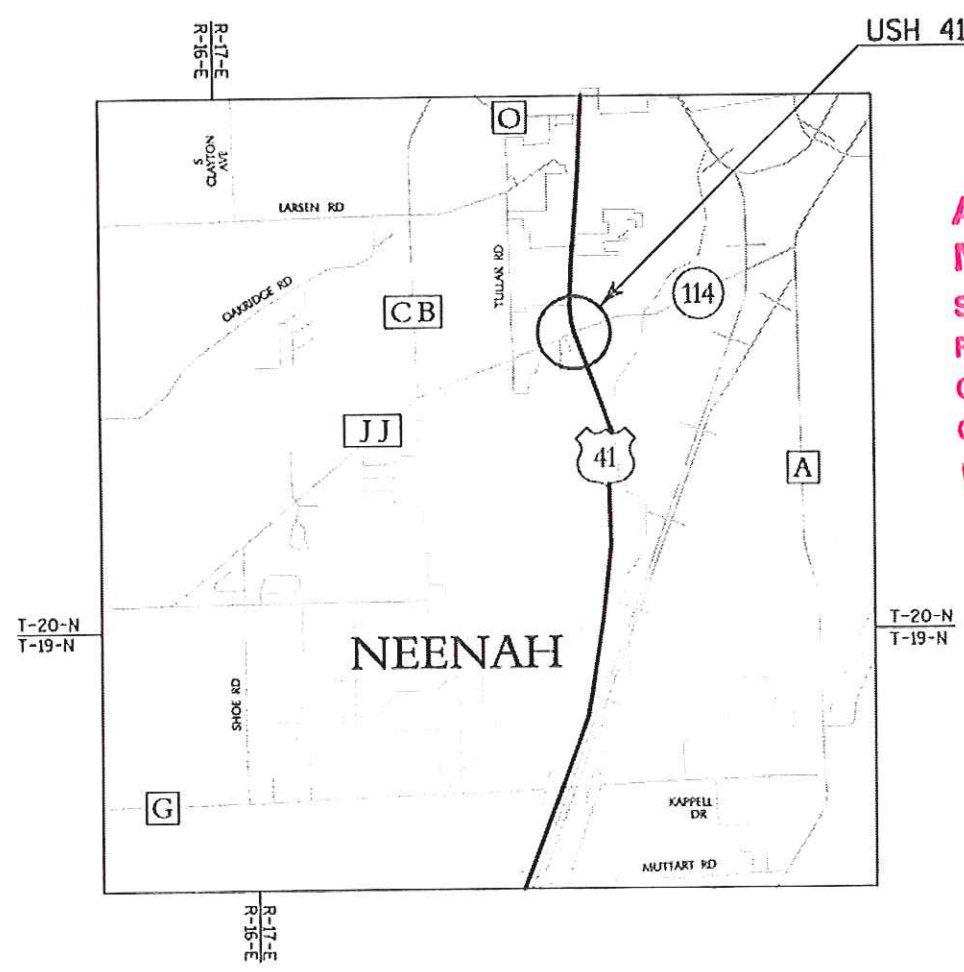

USH 41/STH 114 INTERCHANGE

AS BUILT PLAN NO.
SUPERVISOR Mike Hing
RESIDENT Craig Treadway
CONTRACTOR Paul Fontaine, Patrick Engineering
COMPLETED 10/1/09

ORIGINAL PLANS PREPARED BY
CH2MHILL
MILWAUKEE, WISCONSIN

WISCONSIN
KERRY C. MEYER
E-36986
MILWAUKEE, WI
PROFESSIONAL ENGINEER

3-2-2009 (Date) K.C. Meyer (Signature)

STATE OF WISCONSIN
DEPARTMENT OF TRANSPORTATION

PREPARED BY
Surveyor WISDOT NER
Designer CH2M HILL
Project Manager TOM BUCHHOLZ
District Examiner
District Supervisor
C.O. Examiner

APPROVED FOR DISTRICT OFFICE
DATE: 2-27-2009 Tom Buchholz (Signature)