

1395


WINNEBAGO

1123-05-75, 85

INDEX OF SHEETS

- Sheet No. 1 Title
Sheet No. 2 - 2.100 Typical Sections and Details
Sheet No. 3 - 3.1 Estimate of Quantities
Sheet No. 3A - 3R Miscellaneous Quantities
Sheet No. 4 - 4.15 Right of Way Plat
Sheet No. 5 - 5.15 Plan and Profile
Sheet No. 6 - 6.52 Standard Detail Drawings
Sheet No. 7 - 7.35 Sign Plates
Sheet No. 8 - 8.133 Structure Plans
Sheet No. 9 - 9.1 Computer Earthwork Data
Sheet No. 9.2 - 9.63 Cross Sections

TOTAL SHEETS = 533

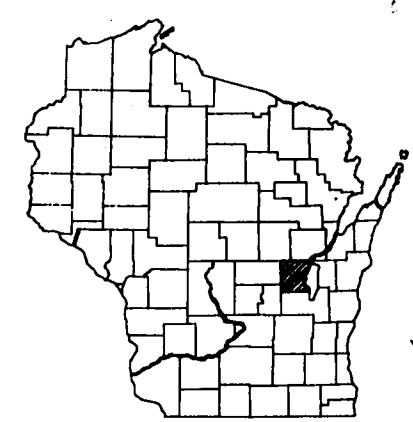

DESIGN DESIGNATION

	URBAN
A.D.T. (1992)	= 40,810
A.D.T. (2002)	= 46,360
A.D.T. (2012)	= 51,910
D.H.V. (2012)	= 5,350
D.	= 60%-40%
T. (%ADT)	= 12.4%
DESIGN SPEED	= 65 MPH
E.S.A.L.S.	= 13,275,000

CONVENTIONAL SIGNS

SECTION LINE	---	COMBUSTIBLE FLUIDS (UNDER PRESSURE)	☼
EDGE OF PAVEMENT	---	UNDERGROUND UTILITIES	
PROPERTY LINE	---	GAS	— G —
EDGE OF GRAVEL	---	ELECTRIC	— E —
LIMITED EASEMENT	---	TELEPHONE	— T —
EXISTING RIGHT OF WAY	---	SERVICE PEDESTAL	■
NEW RIGHT OF WAY	---	POWER POLE	□
REFERENCE LINE	---	LIGHT POLE	⊙
SLOPE INTERCEPT	---	MARSH	~ ~ ~
ORIGINAL GROUND	---	WOODED AREA	☼ ☼ ☼
MARSH OR ROCK PROFILE	---	WATER	— W —
CULVERT IN PLACE	---	SANITARY SEWER	— SAN —
CULVERT REQUIRED	---	CABLE TELEVISION	— TV —
CULVERT REQUIRED (Profile)	---	STORM SEWER	— SS —
FENCE	×	SEPTIC VENT	●
DRIVEWAY/CULVERT-PROPOSED	+	STEEL PLATE BEAMGUARD	—

STATE OF WISCONSIN
DEPARTMENT OF TRANSPORTATION

PLAN OF PROPOSED IMPROVEMENT

BREEZEWOOD LANE - N.C.L. | BREEZEWOOD LANE - N.C.L.

(BREEZEWOOD LANE - CECIL STREET)

(STH 114 SOUTHBOUND STRUCTURE)

U.S.H. 41

U.S.H. 41

WINNEBAGO COUNTY

WINNEBAGO COUNTY

STATE PROJECT NUMBER
1123-05-75

STATE PROJECT NUMBER
1123-05-85

AS BUILT PLAN
NO.

SUPERVISOR RALPH FORSETH
RESIDENT BUD KOEHNKE
CONTRACTOR PHILIPPA BROS. CONST. CO.
COMPLETED 5-26-94

ORIGINAL PLANS PREPARED
BY
SEC DONOHUE, INC.
MILWAUKEE, WISCONSIN



DATE: 11-2-92 Van Winkle
CONSULTING ENGINEER

STATE OF WISCONSIN
DEPARTMENT OF TRANSPORTATION

PREPARED BY
Surveyor SEC DONOHUE
Designer SEC DONOHUE
District Examiner M.D.M.
District Supervisor R.L.S.
C.O. Coordinator D.L.
C.O. Examiner J.E.G.


APPROVED FOR DISTRICT OFFICE
DATE: 11/2/92 Mike Miller
(Signature)

AUTHORIZED FOR CENTRAL OFFICE TRAFFIC
DATE: 12/16/92 Steve T. Fischer
(Signature)

AUTHORIZED FOR CENTRAL OFFICE DESIGN
DATE: 11/10/92 Harold E. Brundage
(Signature)

U.S. DEPARTMENT OF TRANSPORTATION
FEDERAL HIGHWAY ADMINISTRATION
REGION 5 WISCONSIN DIVISION

APPROVED:
DATE: _____
DIVISION ADMINISTRATOR

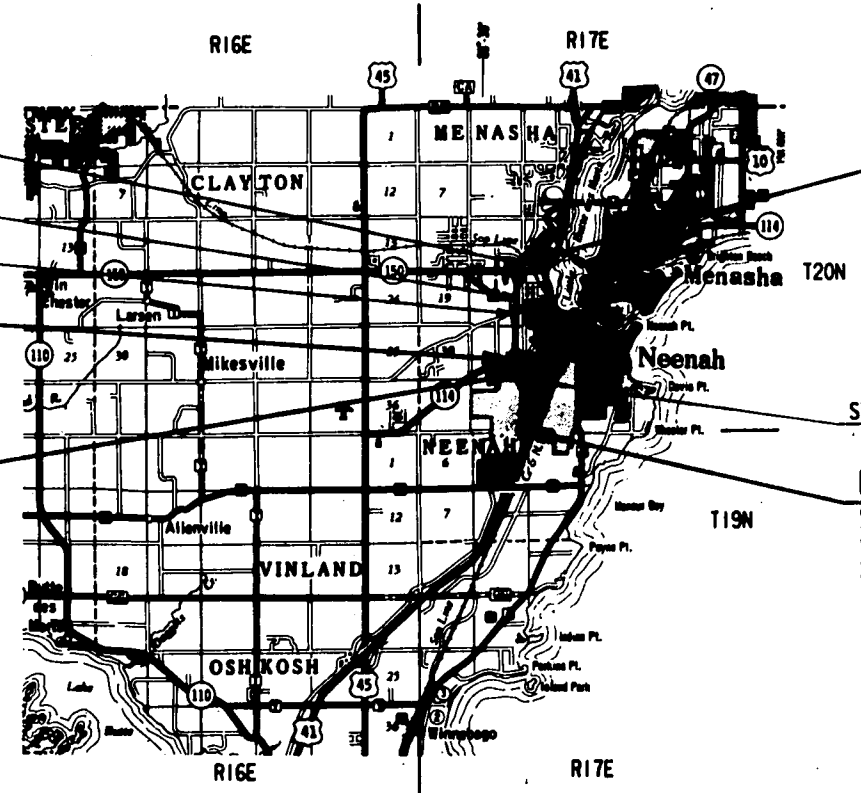

LAYOUT
SCALE 0 2 MI.

TOTAL NET LENGTH OF NORTHBOUND REFERENCE LINE = 1.063 MI. URBAN (1123-05-75)
TOTAL NET LENGTH OF SOUTHBOUND REFERENCE LINE = 0.038 MI. URBAN (1123-05-85)

SEE
REVISED
SHEET
IN
BOOK

COORDINATES ON THIS PLAN ARE
REFERENCED TO THE WISCONSIN
COORDINATE SYSTEM, CENTRAL ZONE

DESIGNED BY: SEC DONOHUE
CHECKED BY: SEC DONOHUE
GRAPHICS BY: SEC DONOHUE
DATE: 11/2/92
PROJECT: 1123-05-75, 85

DONOHUE COMPUTER AIDED DESIGN & DRAFTING