

GRE

FEB 07
ORDER OF SHEETS

Section No. 1	Title
Section No. 2	Typical Sections and Details
Section No. 3	Estimate of Quantities
Section No. 3	Miscellaneous Quantities
Section No. 4	Right of Way Plat
Section No. 5	Plan and Profile
Section No. 6	Standard Detail Drawings
Section No. 7	Sign Plates
Section No. 8	Structure Plans
Section No. 9	Computer Earthwork Data
Section No. 9	Cross Sections

TOTAL SHEETS = 156



DESIGN DESIGNATION

A.A.D.T. 2005	=	6,800
A.A.D.T. 2025	=	7,500
D.H.V.	=	756
D.D.	=	62/38
T.	=	3.2
DESIGN SPEED	=	45 MPH
ESALS	=	459,900

CONVENTIONAL SYMBOLS

PLAN	
CORPORATE LIMITS	////
PROPERTY LINE	PL + 59.1
LOT LINE	----
LIMITED HIGHWAY EASEMENT	----
EXISTING RIGHT OF WAY	----
PROPOSED OR NEW R/W LINE	----
SLOPE INTERCEPT	----
REFERENCE LINE	----
EXISTING CULVERT	----
PROPOSED CULVERT (Box or Pipe)	----
COMBUSTIBLE FLUIDS	CAUTION
MARSH AREA	----
WOODED OR SHRUB AREA	----

PROFILE	
GRADE LINE	----
ORIGINAL GROUND	----
MARSH OR ROCK PROFILE (To be noted as such)	----
SPECIAL DITCH	----
GRADE ELEVATION	95.5
CULVERT (Profile View)	----
UTILITIES	
ELECTRIC	----
FIBER OPTIC	----
GAS	----
SANITARY SEWER	----
STORM SEWER	----
TELEPHONE	----
WATER	----
UTILITY PEDESTAL	----
POWER POLE	----
TELEPHONE POLE	----

STATE OF WISCONSIN DEPARTMENT OF TRANSPORTATION

PLAN OF PROPOSED IMPROVEMENT

APPLETON - LITTLE CHUTE


CTH E TO ADAMS STREET

STH 96

OUTAGAMIE COUNTY

STATE PROJECT NUMBER
4075-14-71

R - 17 - E R - 18 - E

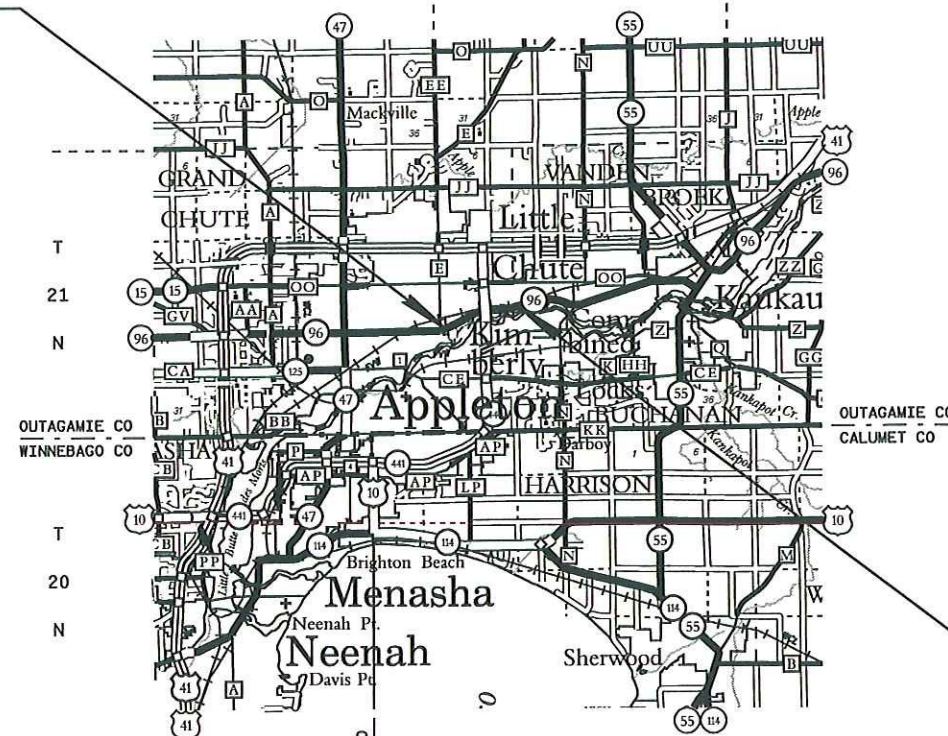

END PROJECT 4075-14-71
STA 729+81

LAYOUT
SCALE 0 2 MI.

TOTAL NET LENGTH OF CENTERLINE = 2.534 MI.

COORDINATES ON THIS PLAN ARE REFERENCED TO THE WISCONSIN
COUNTY COORDINATE SYSTEM (WCCS), OUTAGAMIE COUNTY.

STATE PROJECT

4075-14-71

FEDERAL PROJECT

PROJECT

STP 2007091

CONTRACT

1

REVISED PLAN SHEETS: 2, 3, &
43

ADDENDUM
ATTACHED
TO BACK

AS BUILT PLAN
NO.

SUPERVISOR JIM LAMERS
RESIDENT MIKE GADZIK, TN ASSOCIATES
CONTRACTOR NORTHEAST ASPHALT
COMPLETED 8/9/07

STATE OF WISCONSIN DEPARTMENT OF TRANSPORTATION

PREPARED BY
Surveyor M. VANDEHEI
Designer D. KLUTH
Project Manager T. KOBUS
Regional Examiner
Regional Supervisor J. LAMERS
C.O. Examiner Carl W. Bongiovanni

APPROVED FOR THE DEPARTMENT
DATE: 8-1-06 David Kluth
(Signature)

E