

REVIEWED BY WIS. DEPT. OF TRANS., DIVISION OF HIGHWAYS
REVIEW AS TO COMPLIANCE WITH DESIGN DRAWINGS AND SPECIFICATIONS WITHIN THE LIMITS OF PARA. 506.3.2 OF STANDARD SPECIFICATIONS. REVIEW DOES NOT EXTEND TO DETAIL DIMENSIONS.

DATE 11/7/98 BY Craig W. P.

Notes: Elevations And Endframe Lengths Are Per The Control Plans
Truss Sections MK No's Are Stamped On The Top Of The Bottom Front Flange

Print Item:
1 Req'd ~ Item No. 64166 ~ Sign Bridge, Structure S-05-55
1 Req'd ~ Item No. 64167 ~ Sign Bridge, Structure S-05-56
1 Req'd ~ Item No. 64168 ~ Sign Bridge, Structure S-05-57
1 Req'd ~ Item No. 64169 ~ Sign Bridge, Structure S-05-58

PRINTS ISSUED		REVISED	
FOR NO.	DATE	FOR NO.	DATE
APPR	5 9-3-98		
DEC	8 9-30-98		

Brookfield Fabricating Corp

P.O. Box 406 - Brookfield, Missouri 64628 - (816)258-2214


Customer:
Timings, Inc.

Project:
STPG 1008 (489) Mason Street
City of Green Bay, WI


Description:
Erection Details Of Sign Bridge
Str. No. S-5-55 & S-5-56

Sheet 1 of 11

Printed For	Drawn By	Date	Checked By	Date	Job No.	Rev.
Wisconsin	JW	8/5/98	C.R.	9/3/98	WI-6492	

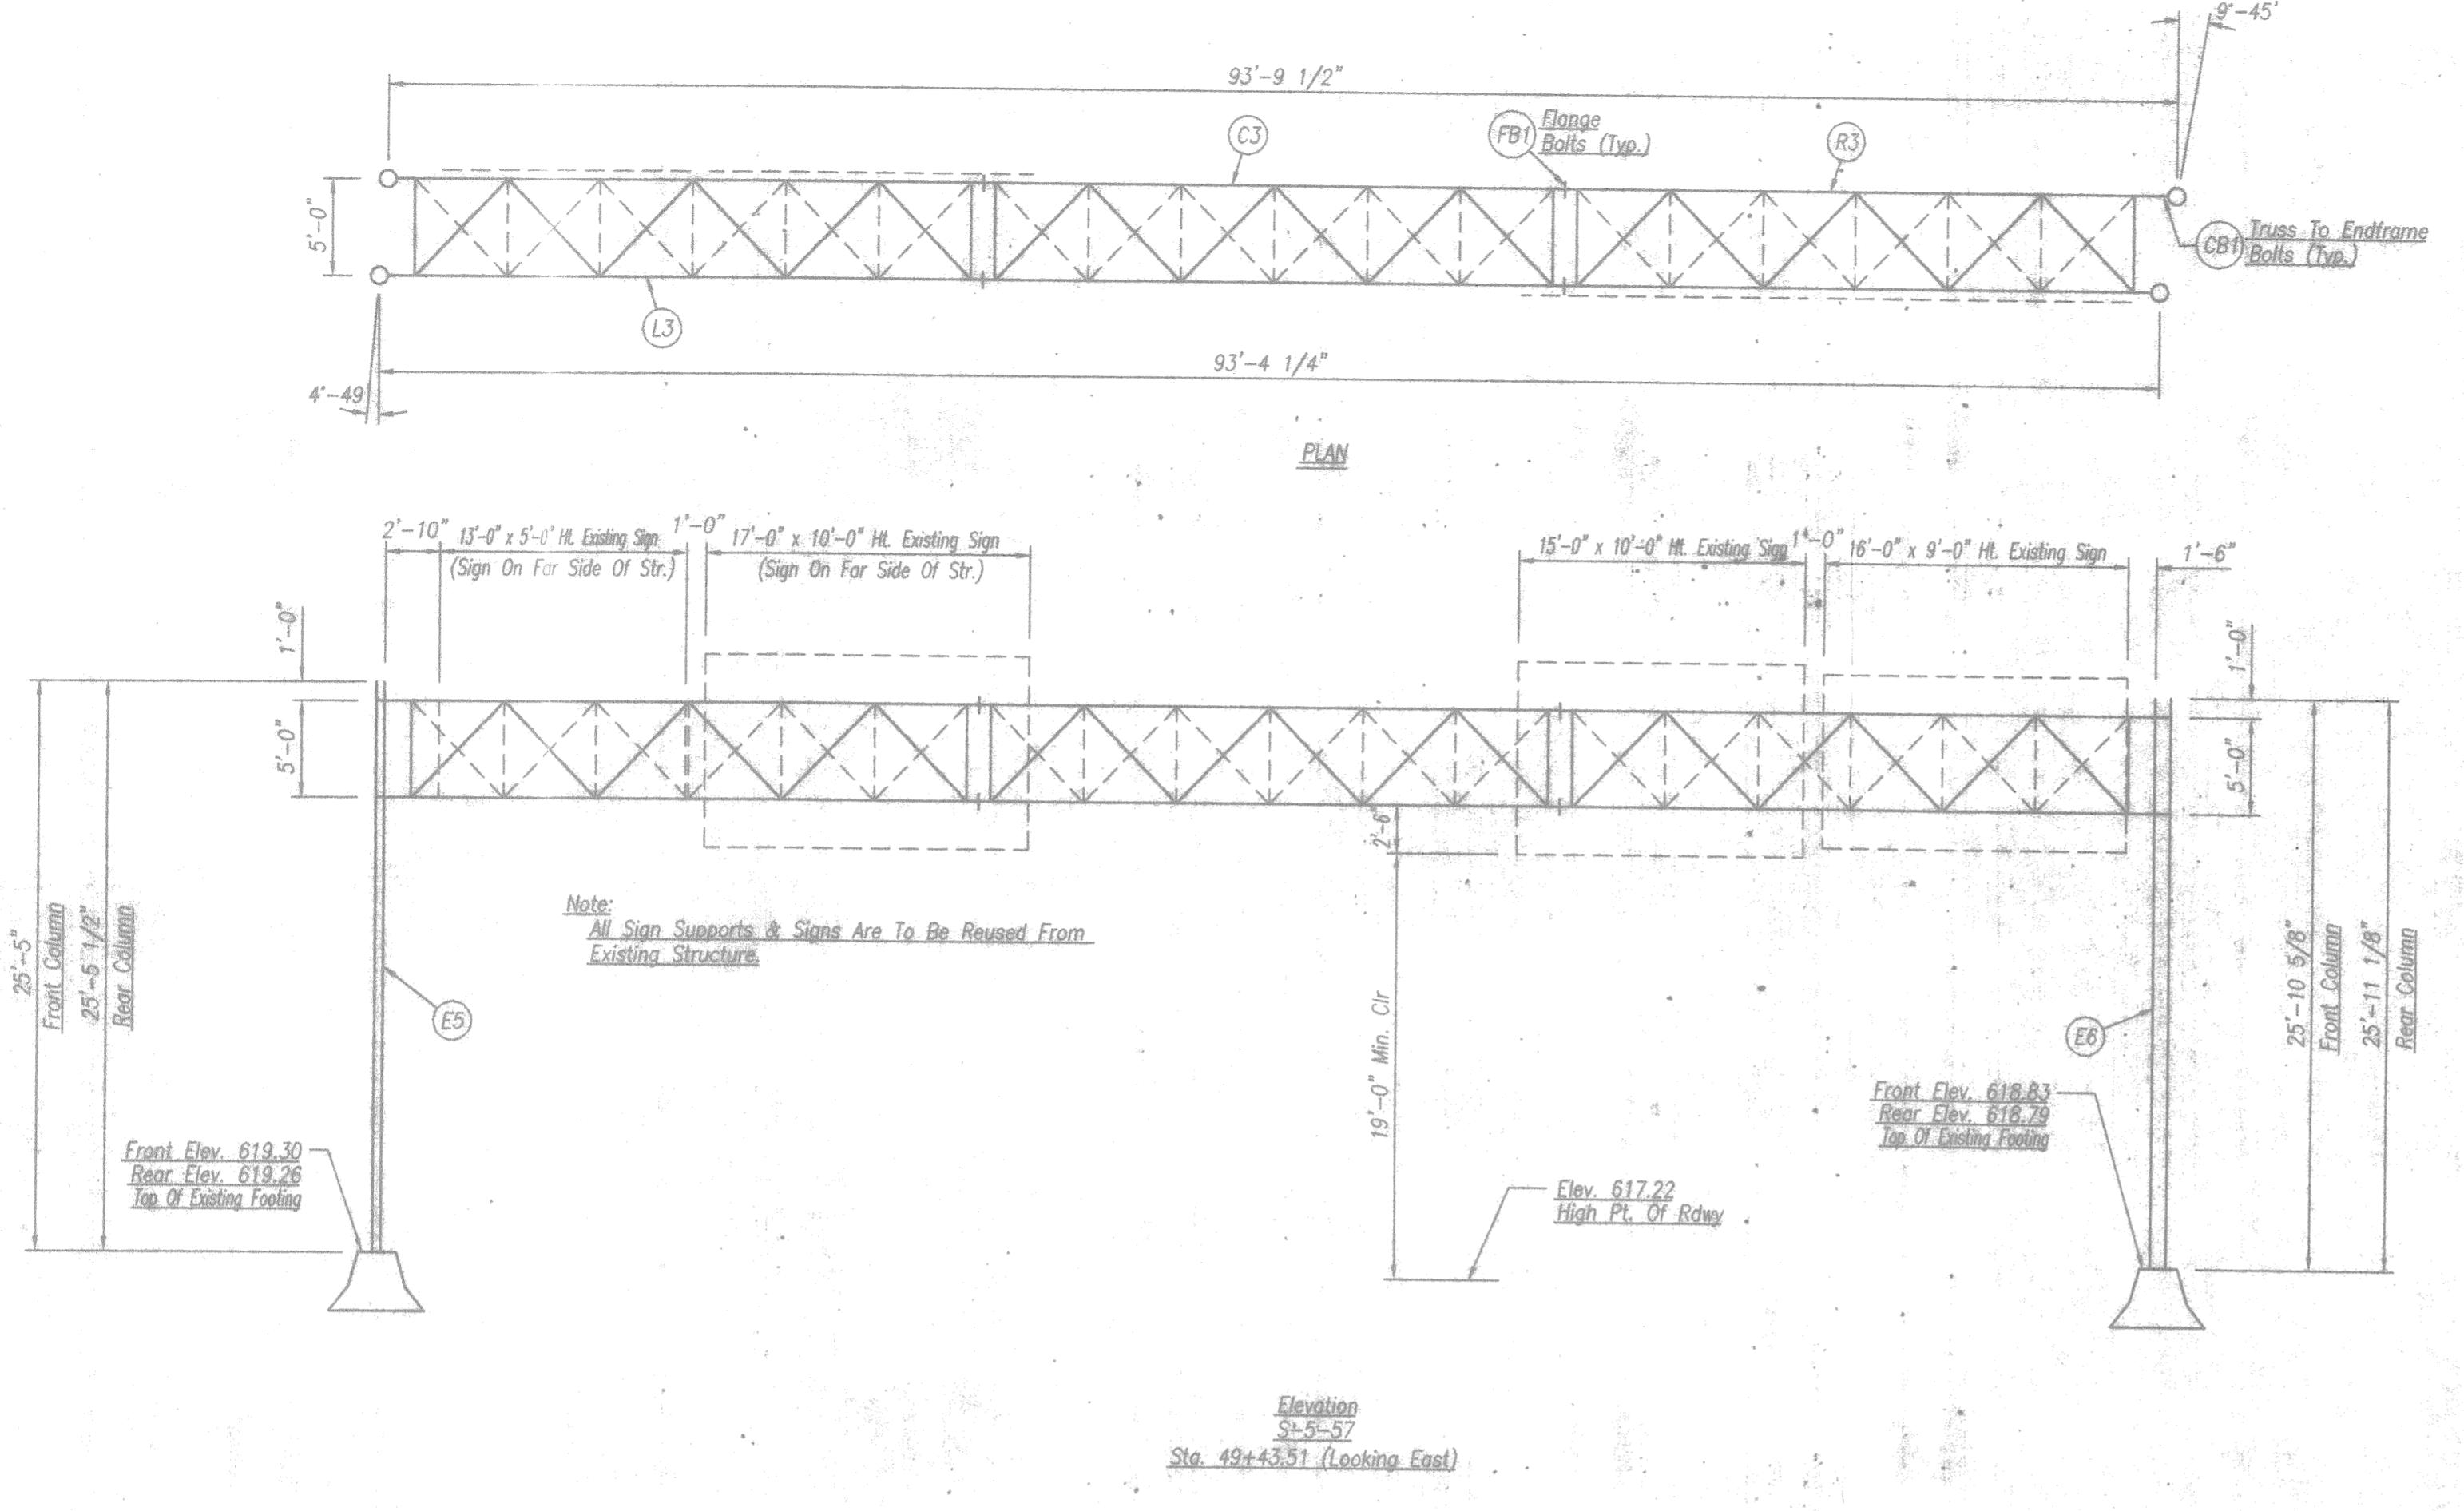

Elevation
S-5-57
Sta. 49+43.51 (Looking East)

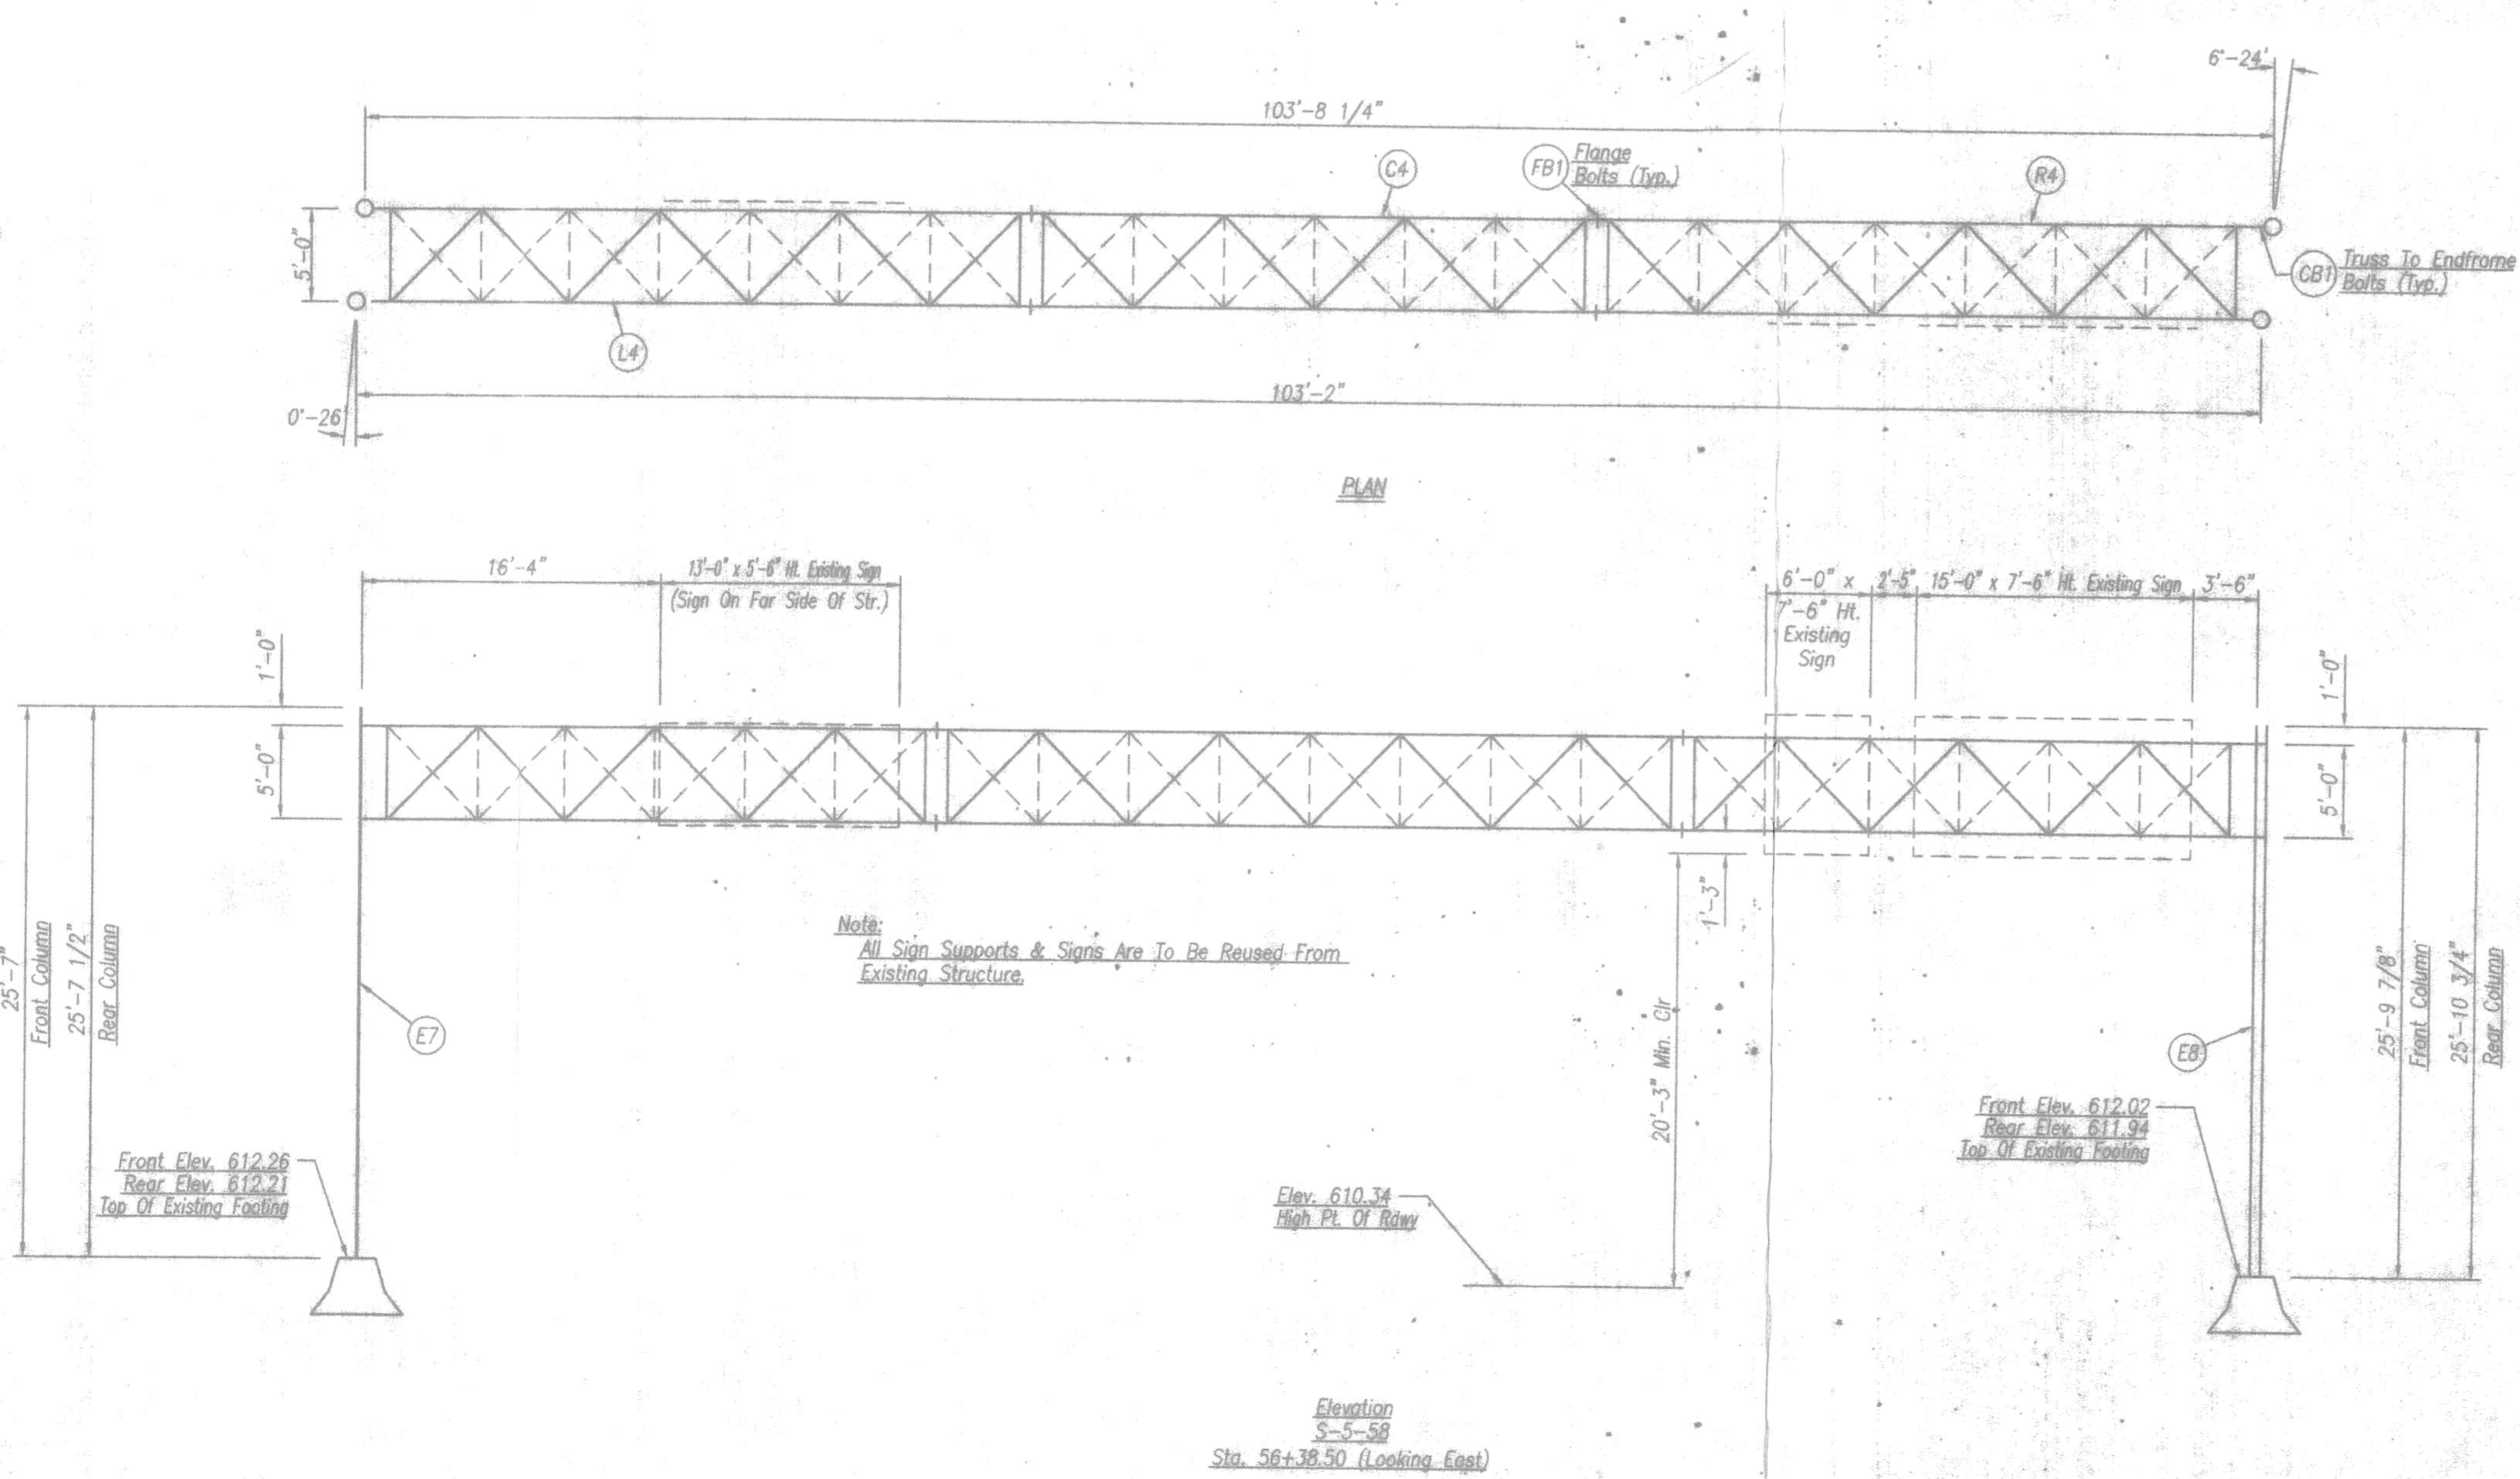




Notes: Elevations And Endframe Lengths Are Per The Contract Plans.
Truss Sections MK No's Are Stamped On The Top Of The Bottom Front Flange

PRINTS ISSUED				REVISIONS			
FOR	NO.	DATE	FOR	NO.	DATE	NO.	DATE



Brookfield Fabricating Corp
P.O. Box 406 - Brookfield, Missouri 64628 - (816)258-2214
Customer: Timme, Inc.
Project: STPG 1908 (489) Mason Street
City Of Green Bay, WI
Description: Erection Details Of Sign Bridge
Str. No. S-5-57 & S-5-58
Printed For: Wisconsin
Drawn By: JW
Date: 8/6/98
Checked By: C.R.
Date: 9/3/98
Job No: WI-6492
Rev: 1

BILL of MATERIAL



QTY.	MK	Description	Length	Remark
2	L1A	5.563"O.D. x .258" W PIPE	31'-4 3/4"	
2	L1B	do	30'-10 3/16"	
4	C1A	do	35'-8 1/4"	
2	R1A	do	30'-10 3/4"	
2	R1B	do	30'-10 3/16"	
16	r1	PL 1"x 11 1/4" DIA.		
64	FB1	3/4"bx 3 1/4" H.S. HEX BOLT & NUT W/2 FLAT WA.		

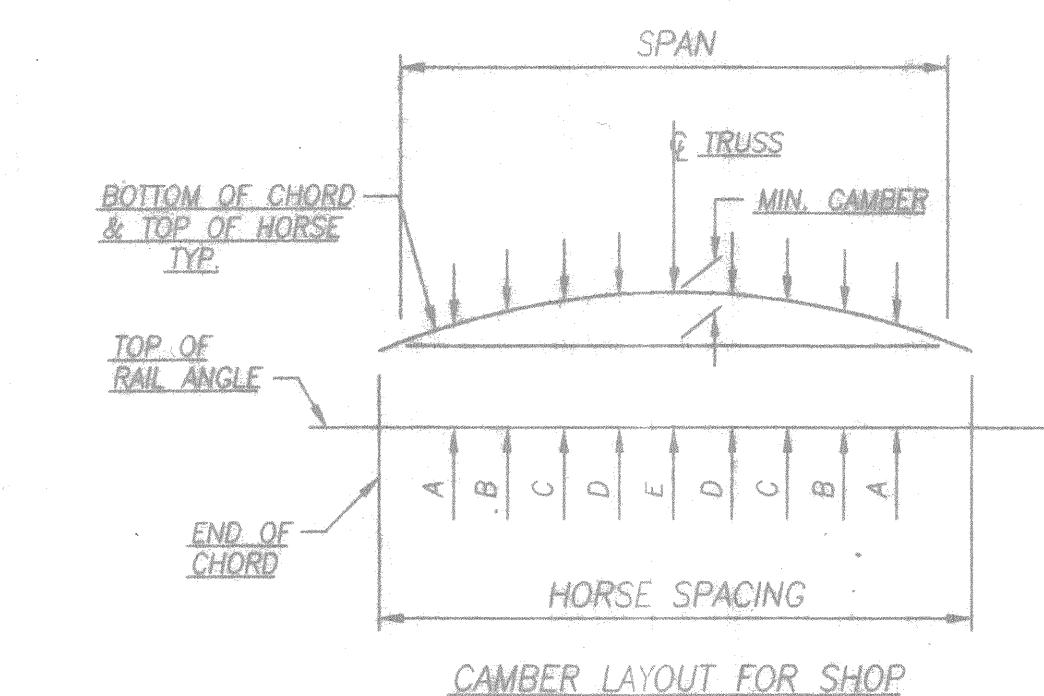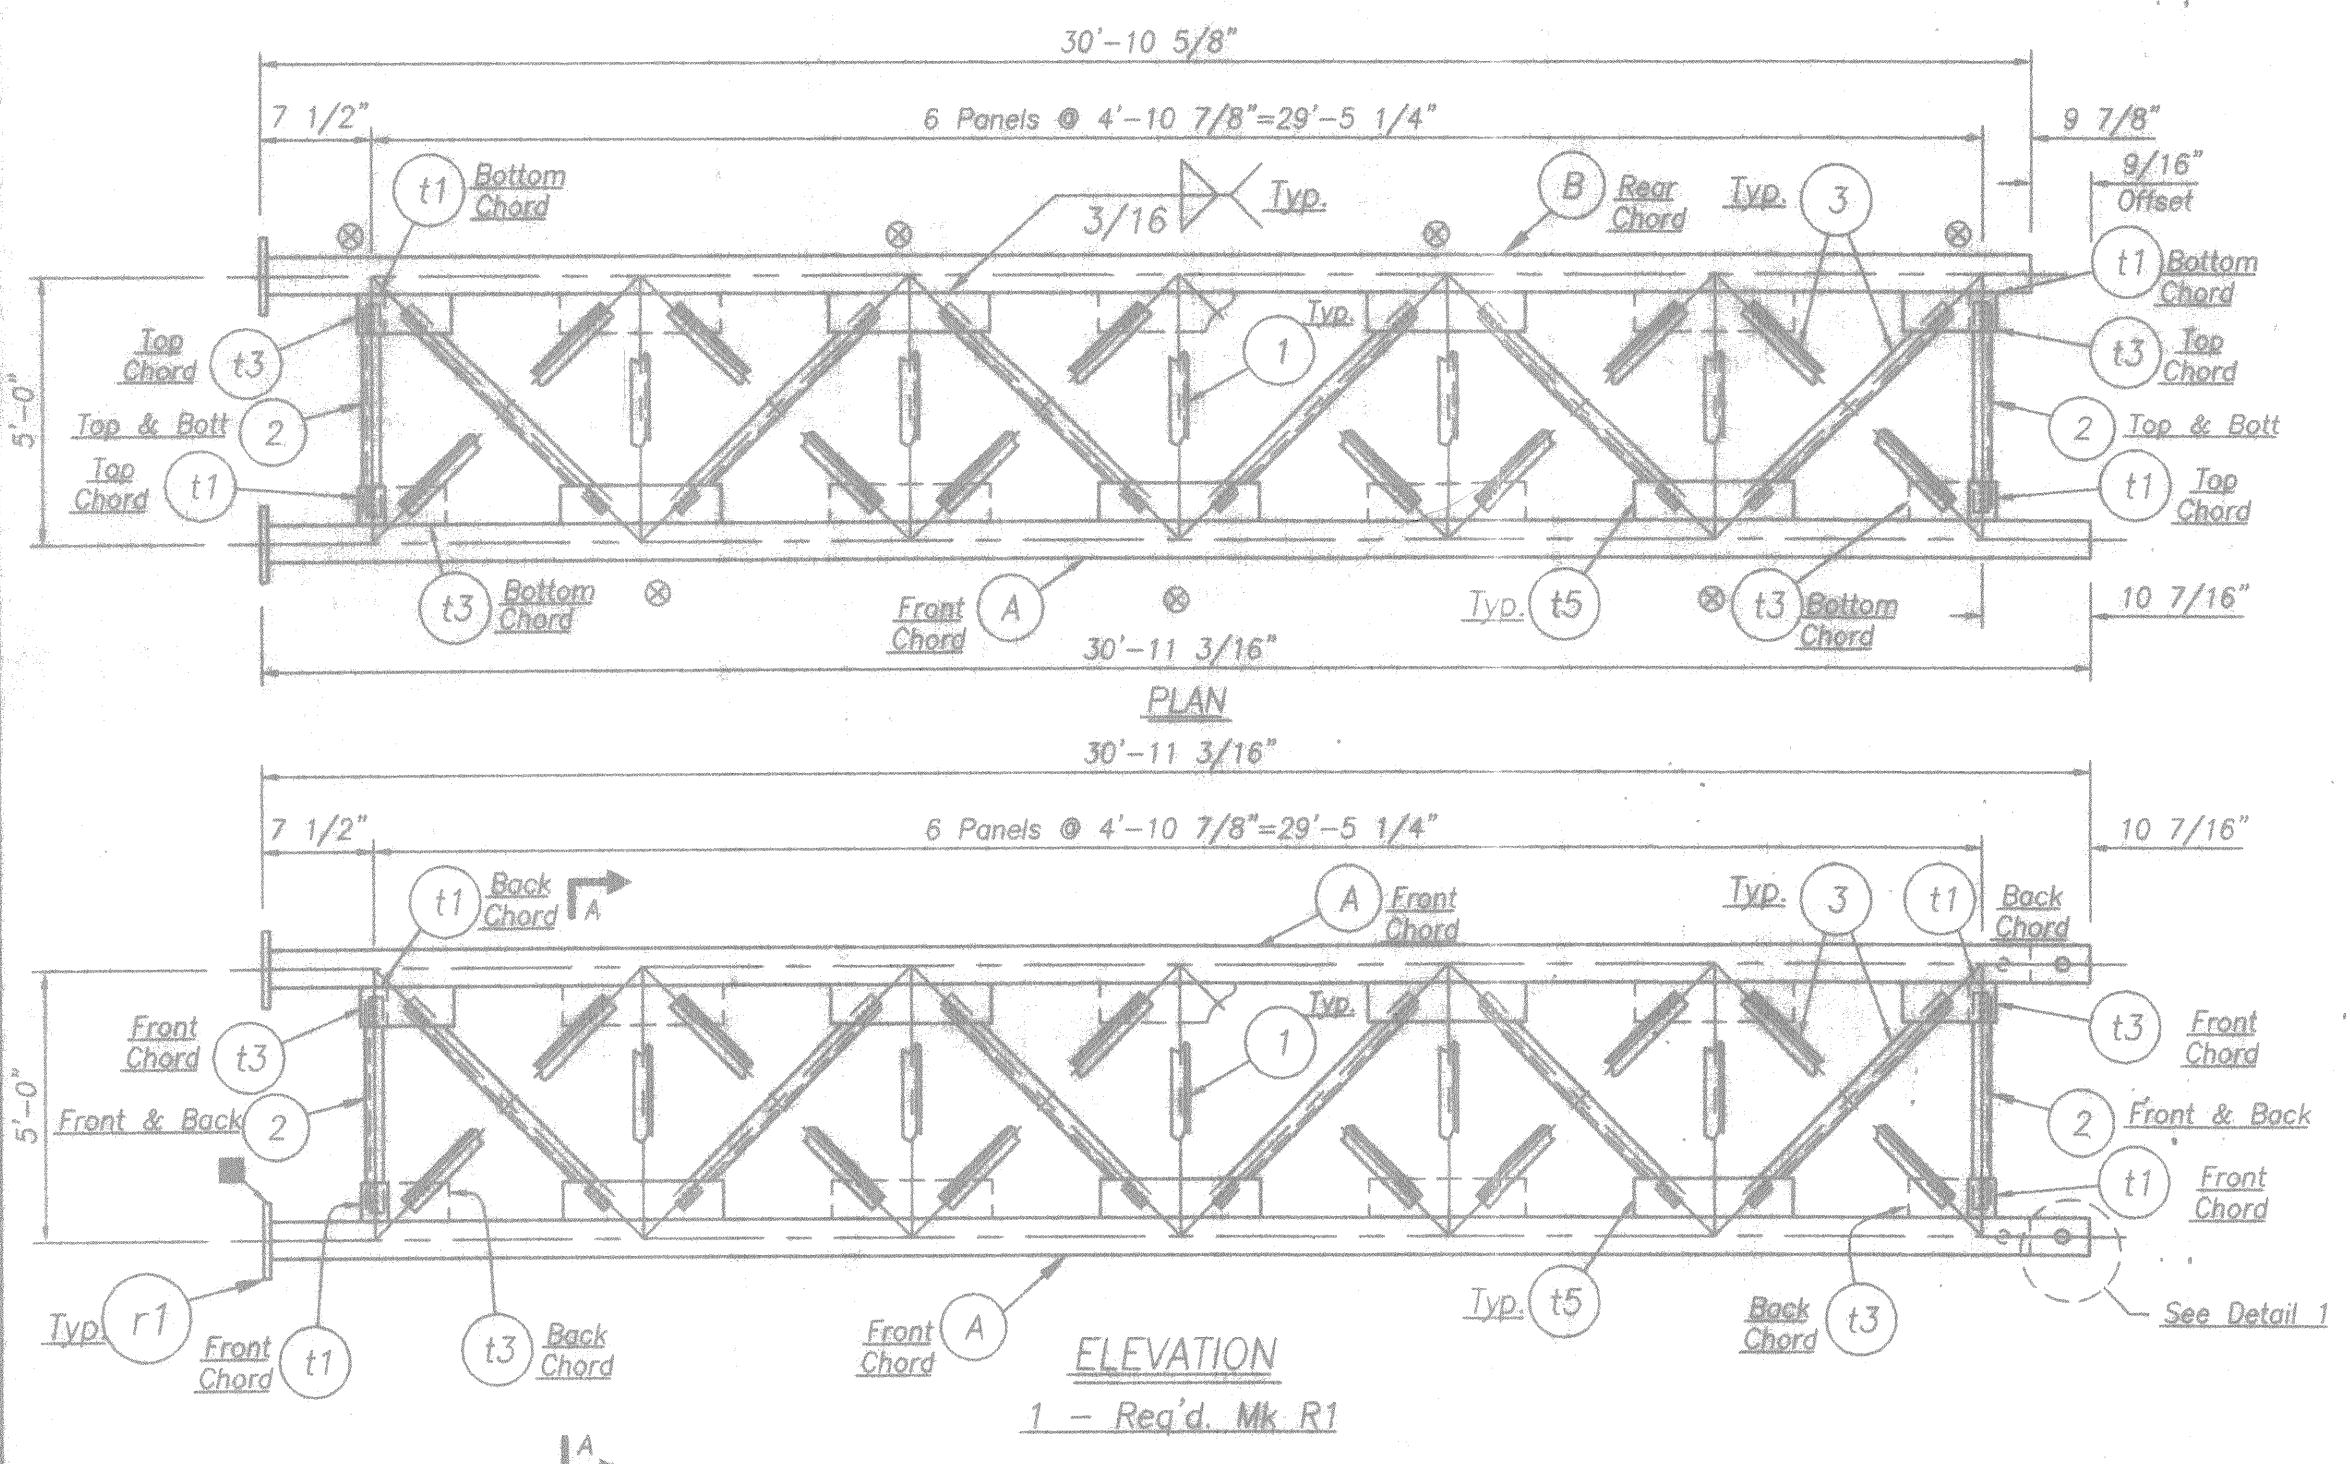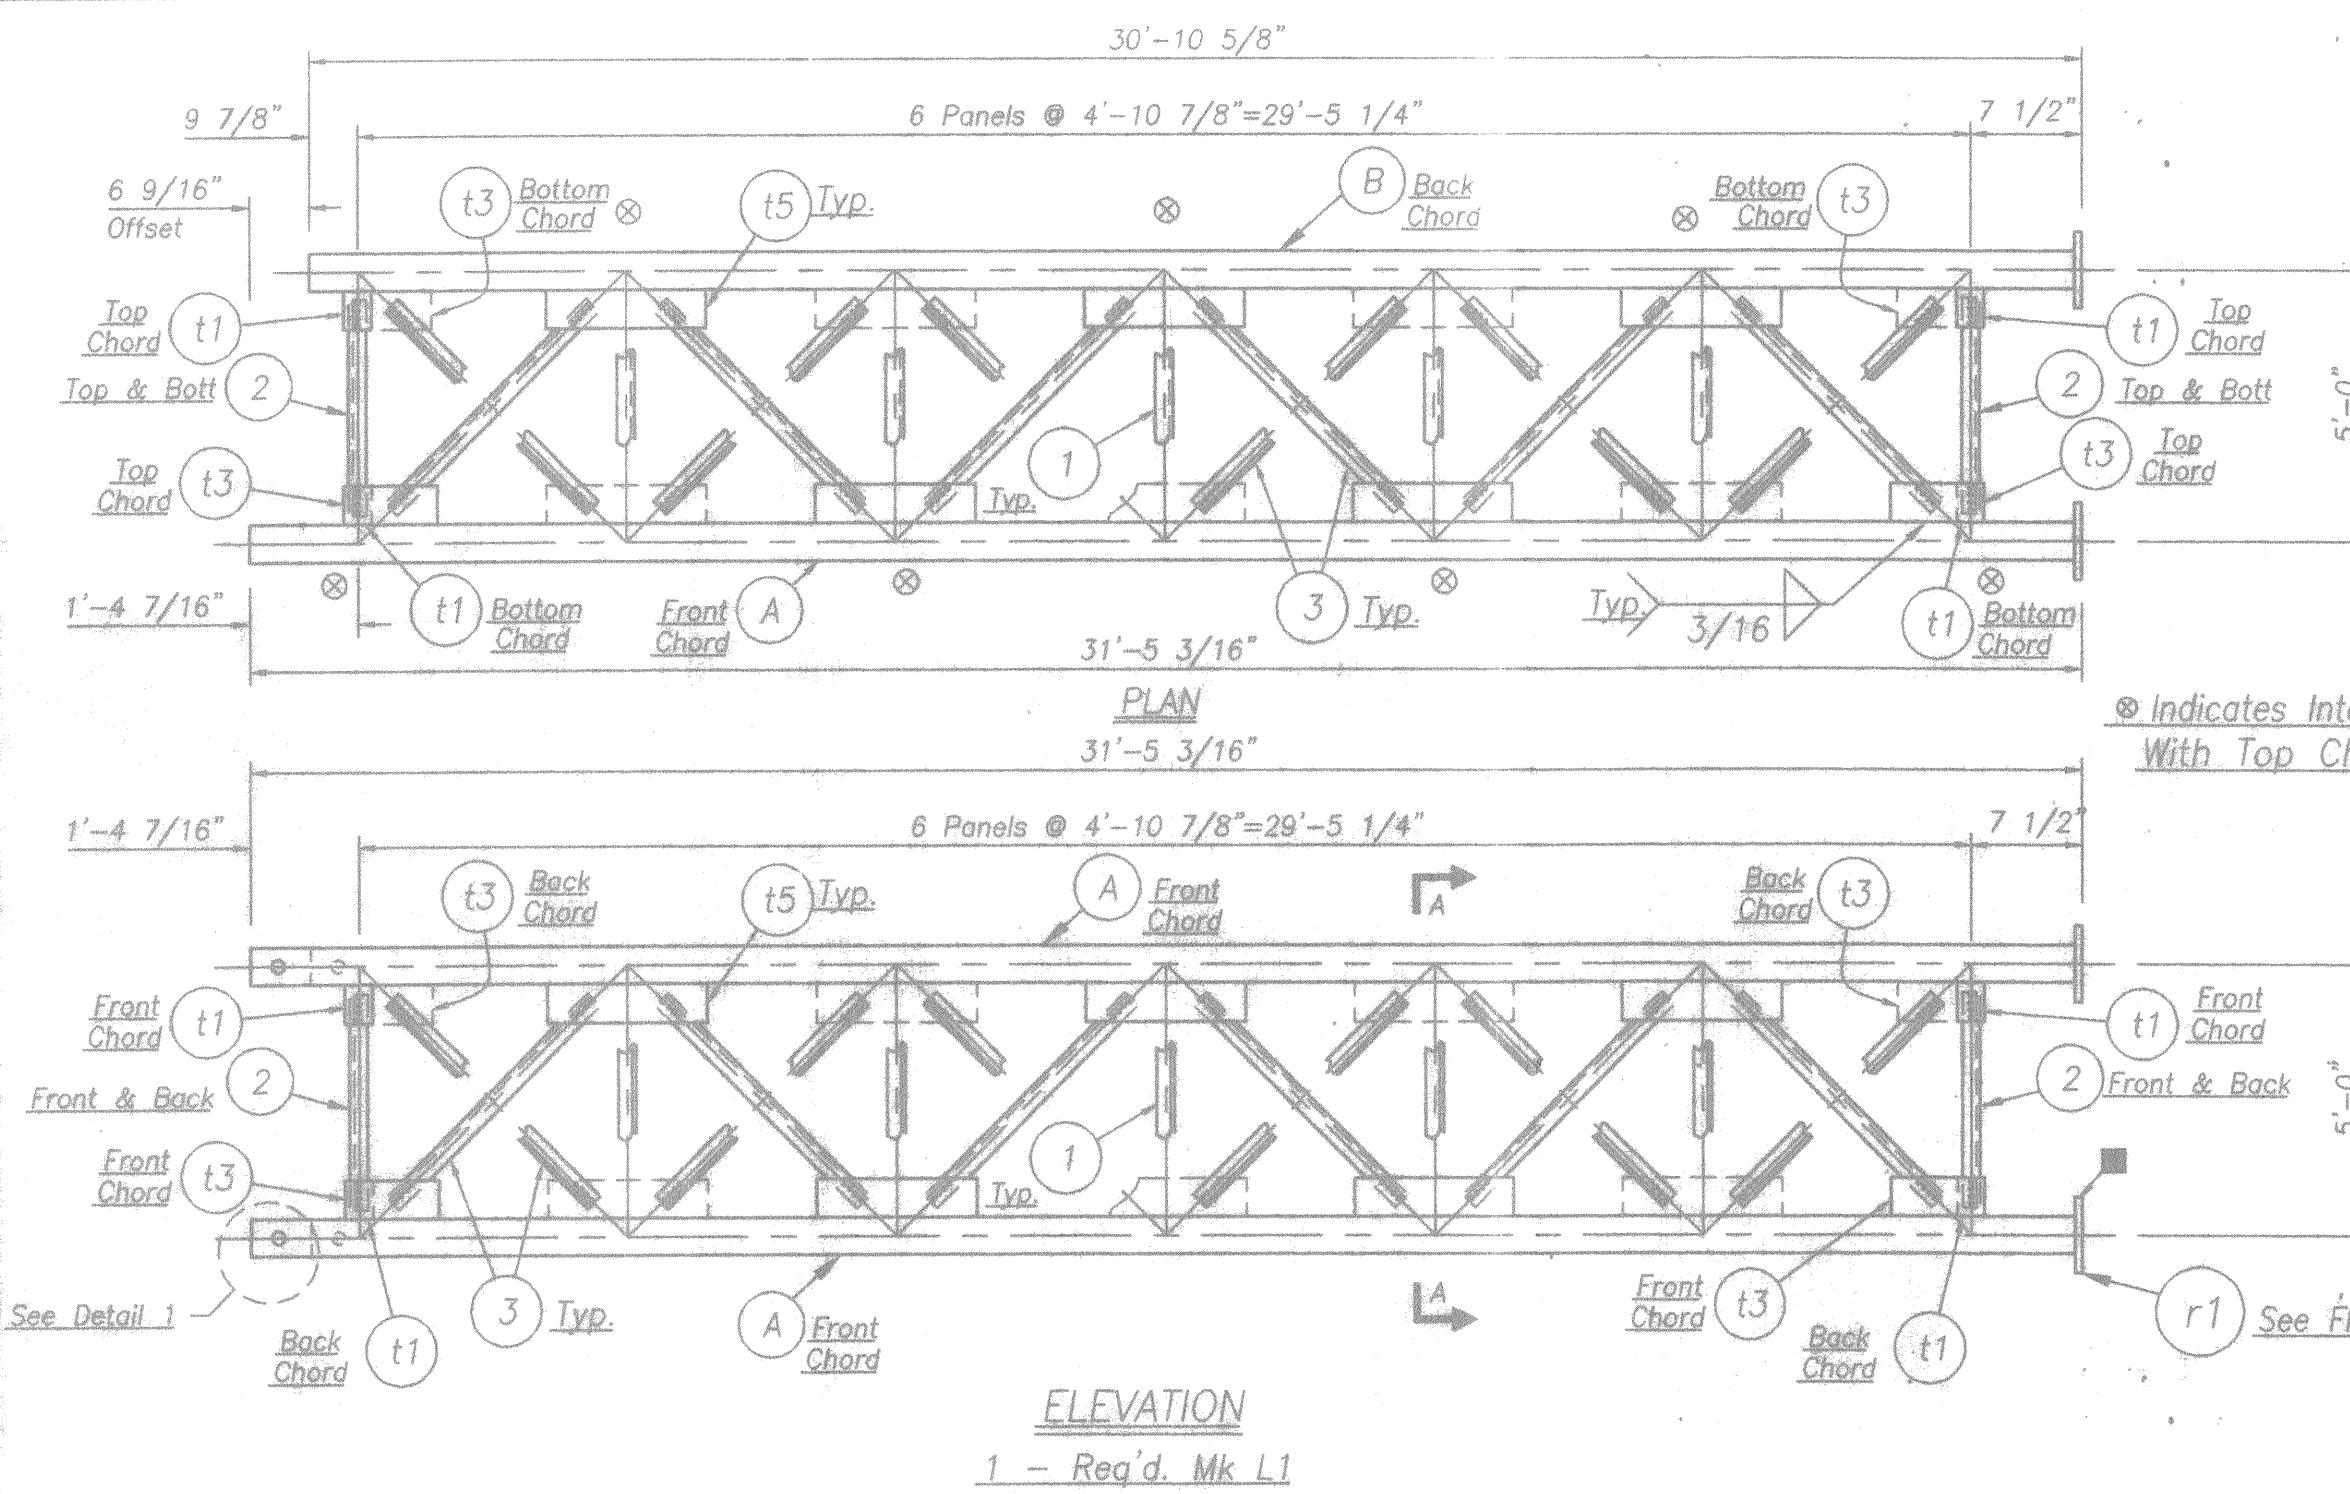

Truss MK	HORSE SPACING	MIN. CAMBER	SPAN	A	B	C	D	E
L1/C1/R1	9 HORSES SPA @ 9'-9 9/16"-	1 3/4"	97'-11 1/2"	1'-7 13/16"	1'-8 7/8"	1'-8 7/8"	1'-9 3/16"	1'-9 1/4"

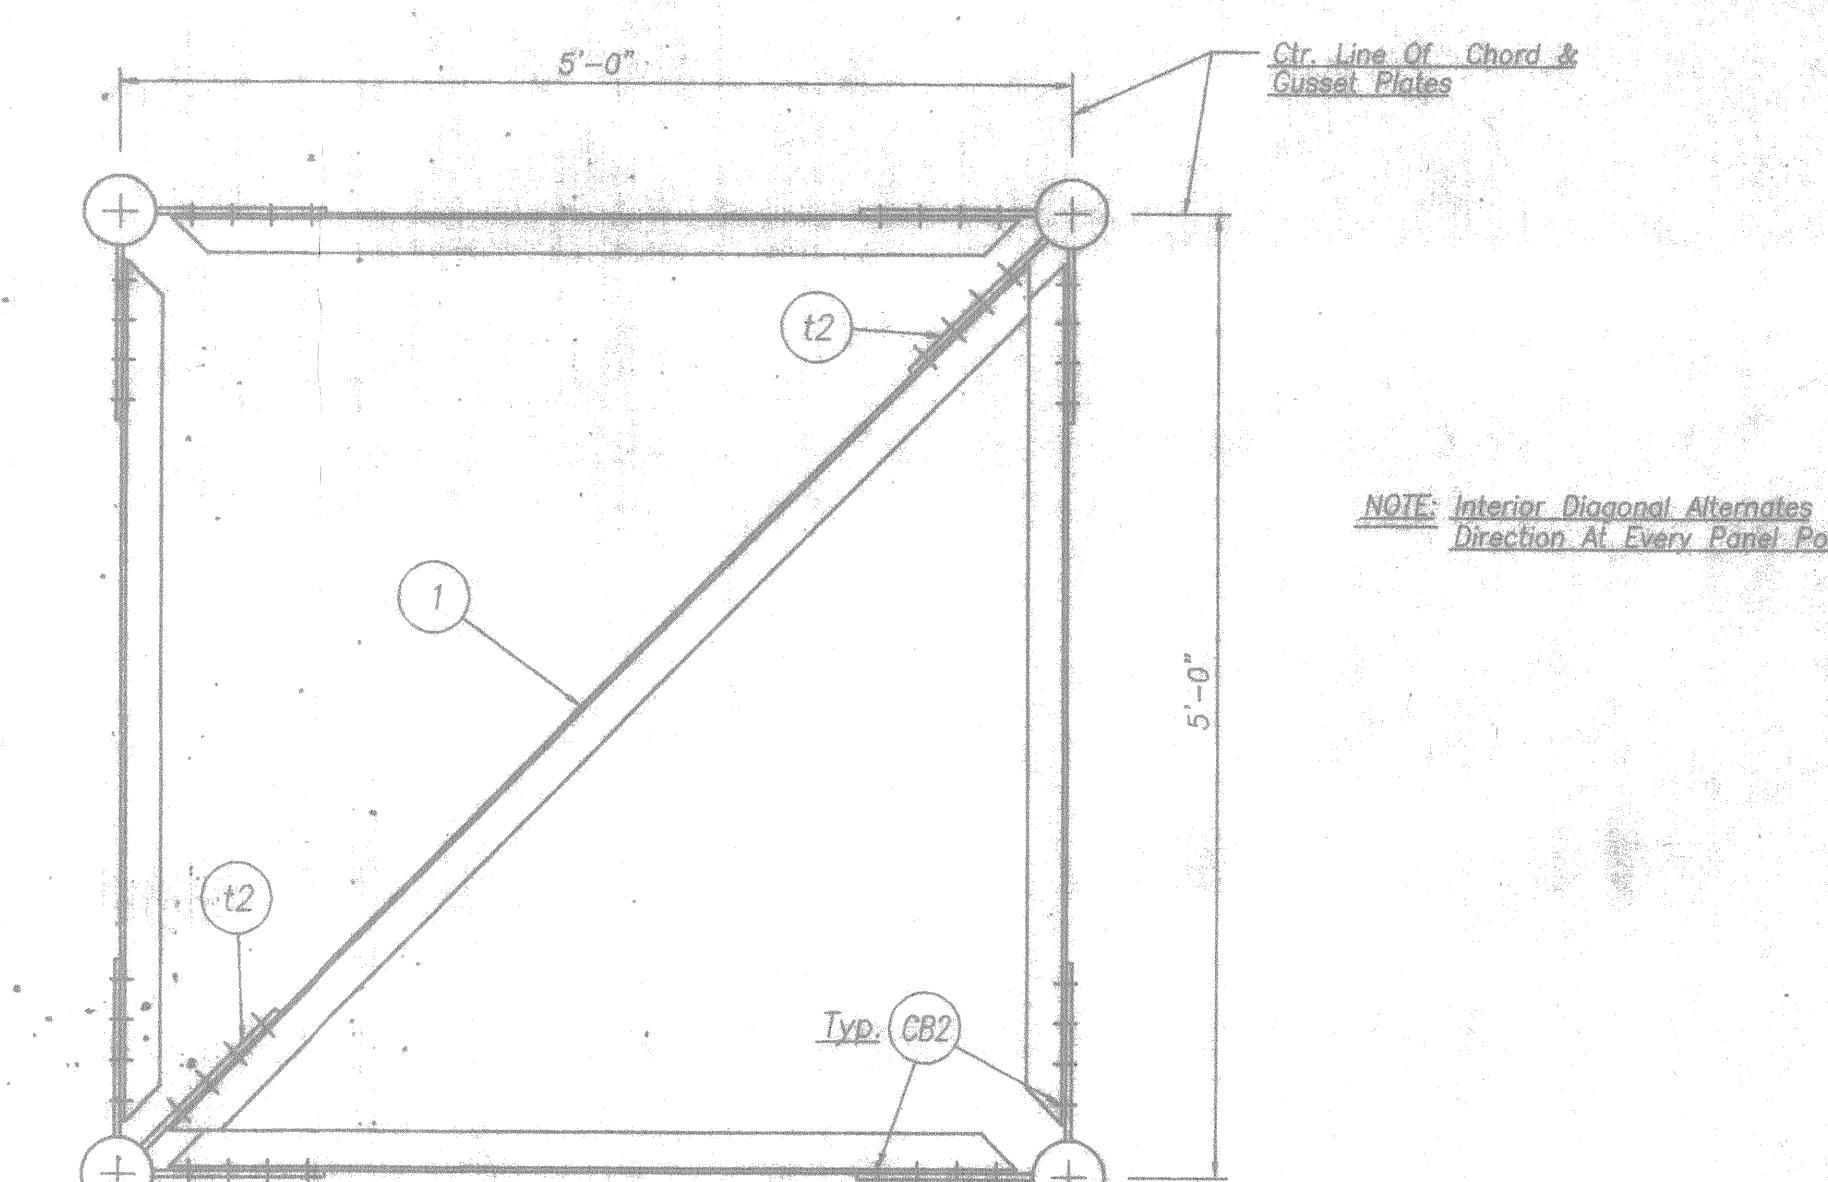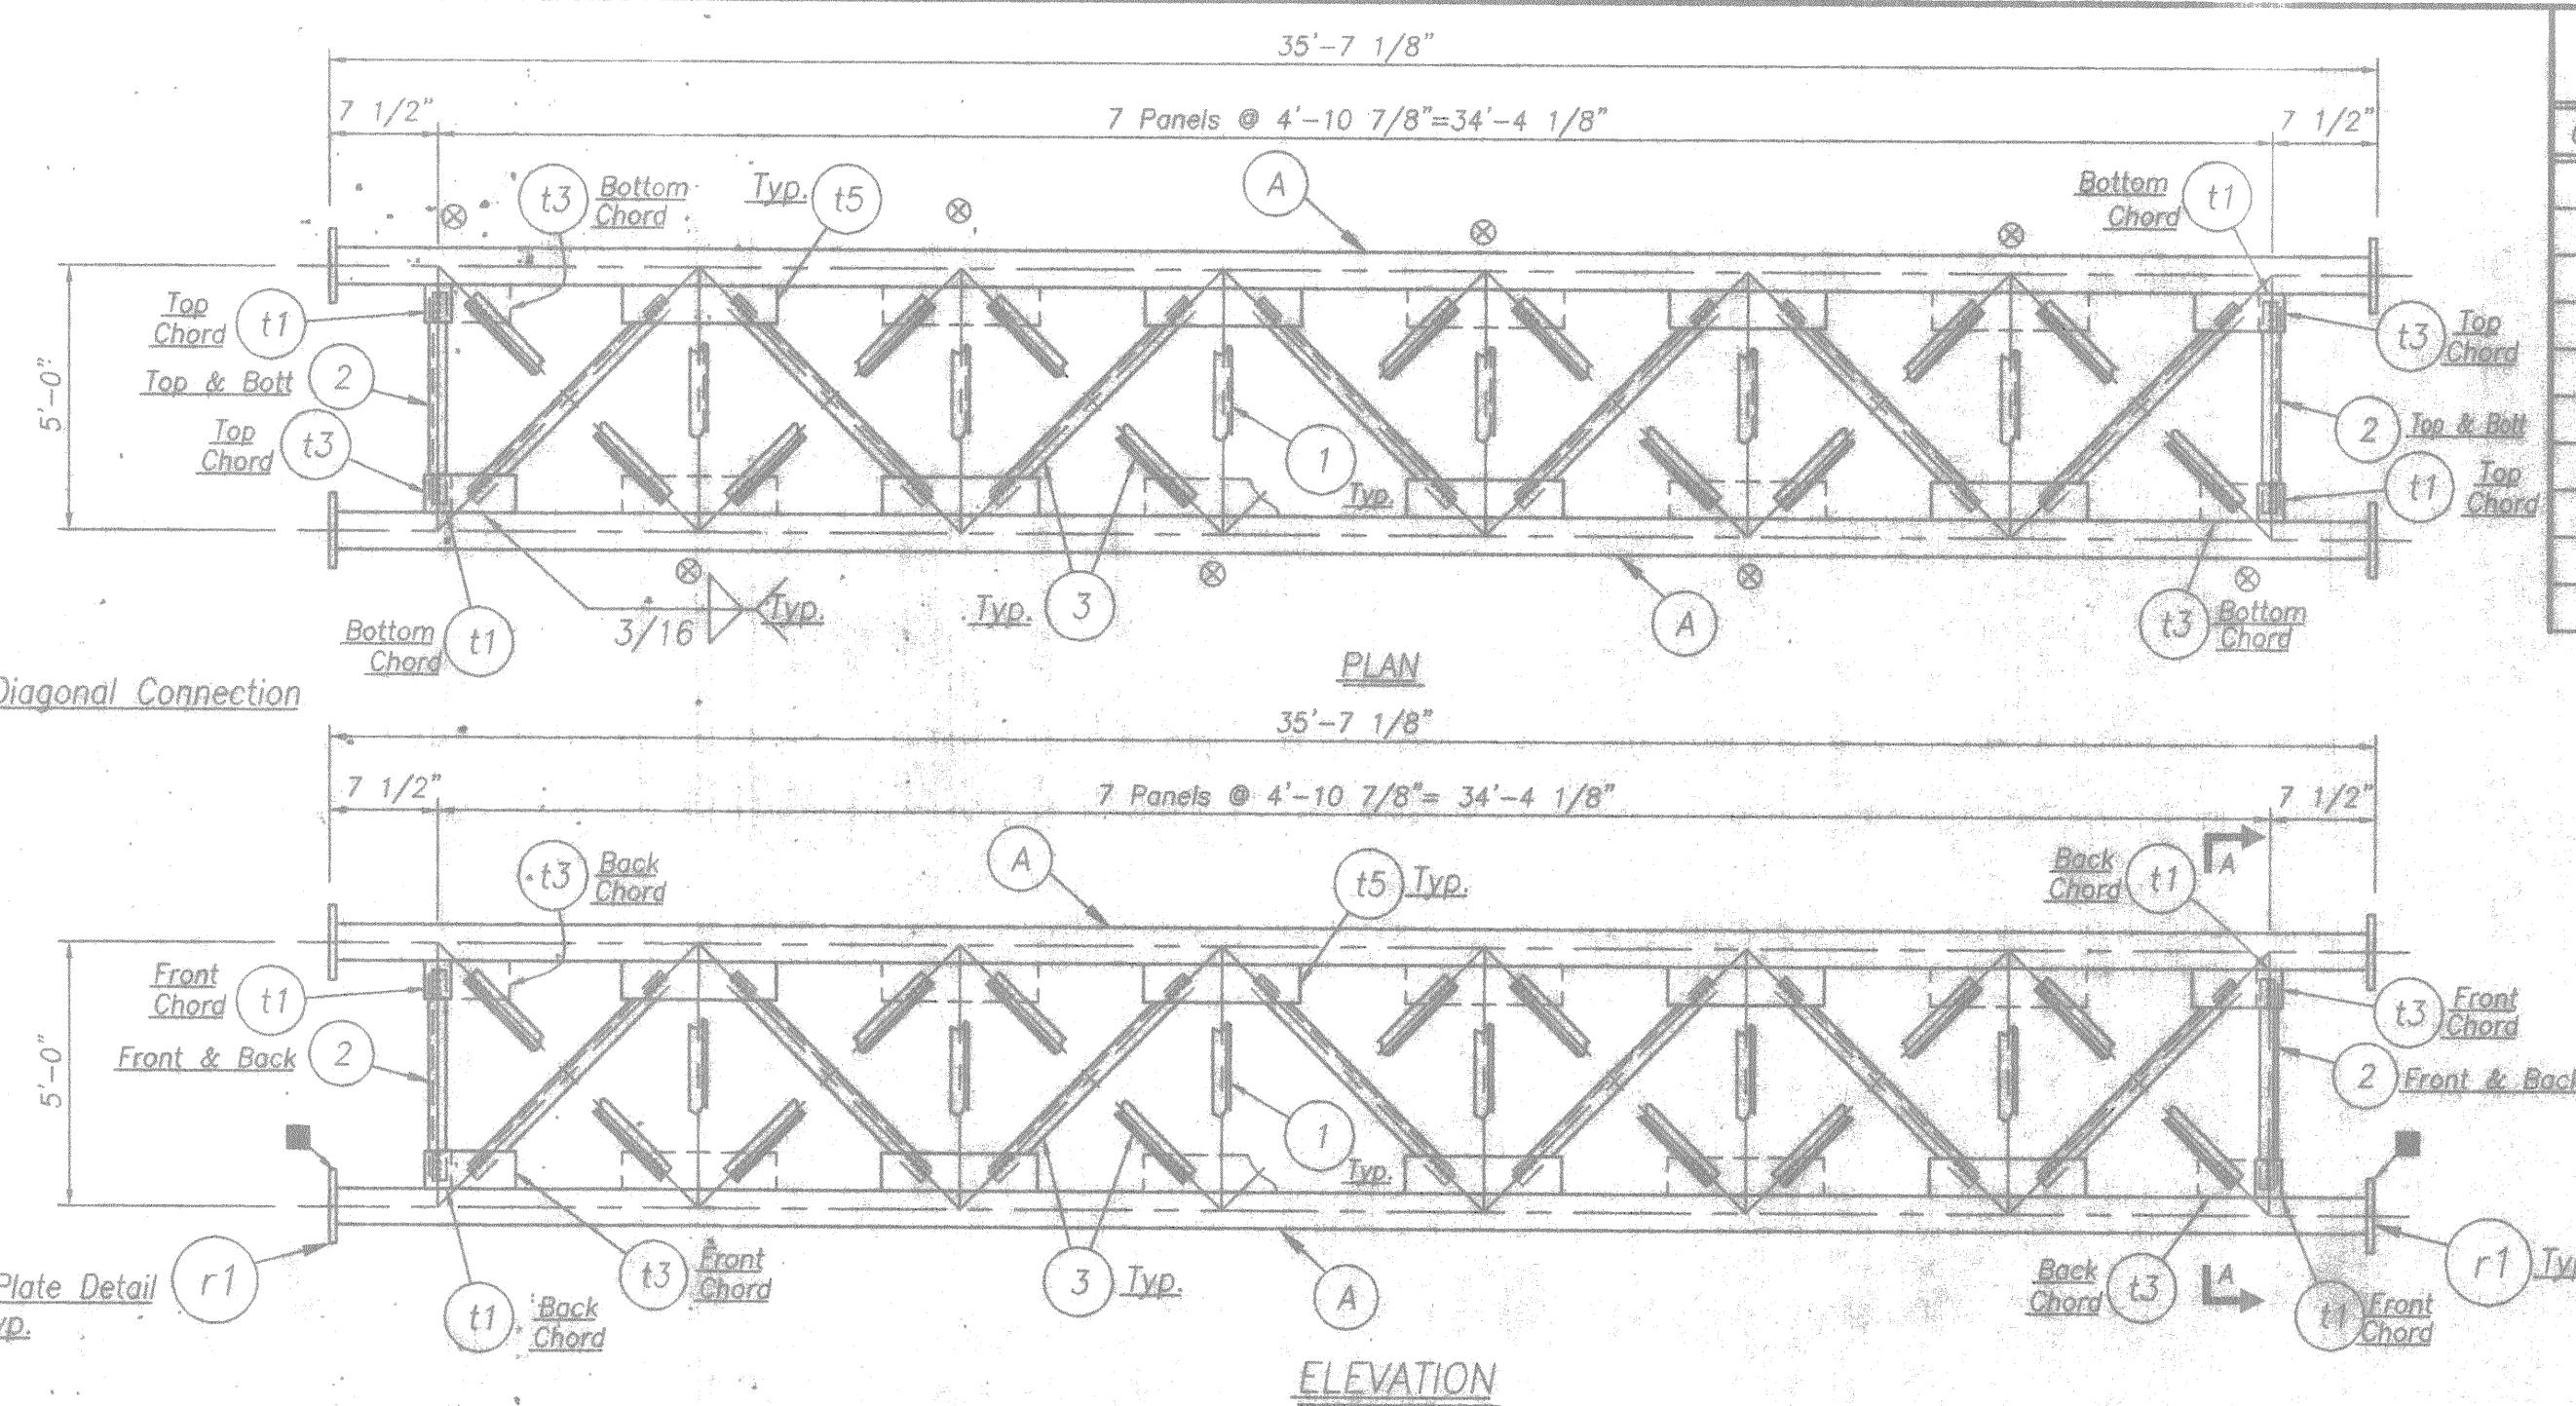

Section A-A

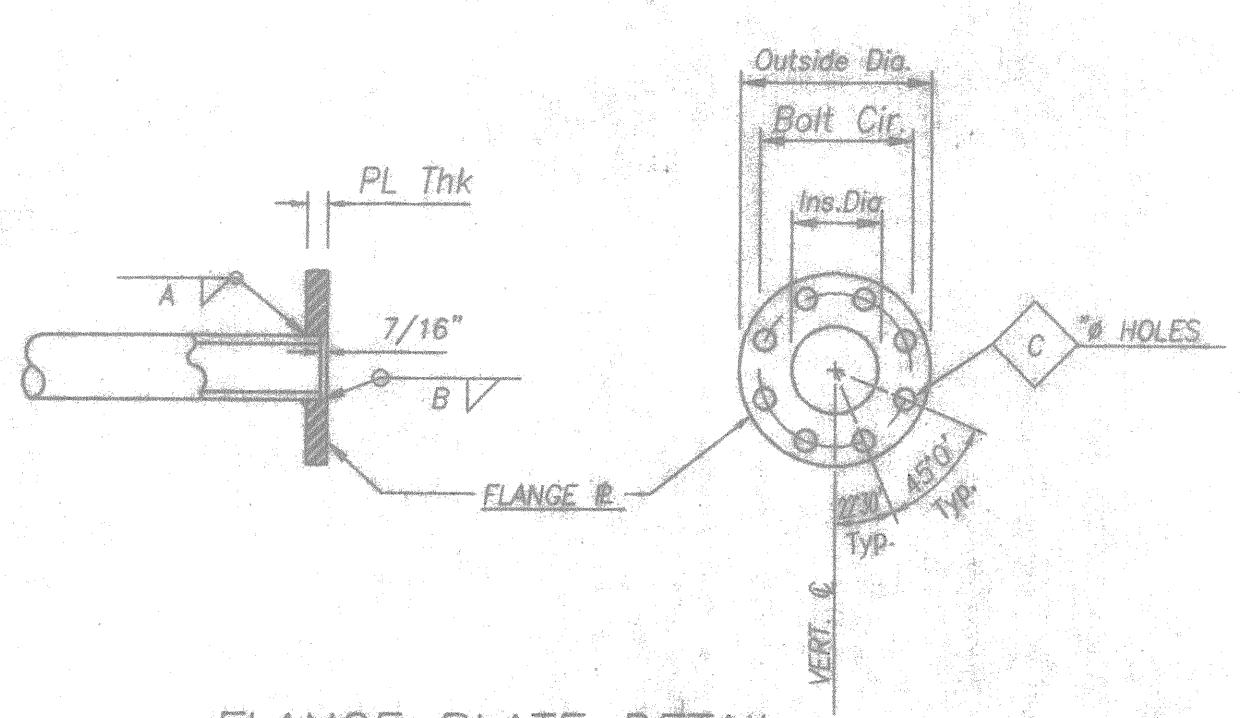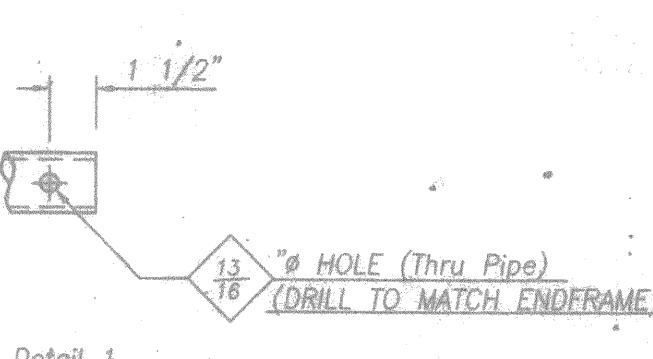

Qty.	MK	Outside Dia.	Bolt Circle	Inside Dia.	Plate Thickness	A	B	C
16	r1	11 1/4"	8 1/4"	5 5/8"	1"	1/4	1/4	13/16"

PRINTS ISSUED	REVISIONS					
FOR NO.	DATE	FOR NO.	DATE	NO.	DATE	DESCRIPTION


Brookfield Fabricating Corp
P.O. Box 406 - Brookfield, Missouri 64628 - (660)258-2214

Customer: Timme, Inc.

Project: STPC 1988 (489)
City of Green Bay, WI

Description: Fabrication Details Of Sign Bridge
For Str. 8-5-55

Printed For: Wisconsin
Drawn By: JW
Date: 8/7/98
Checked By: C.R.
Date: 9/3/98
Job No: WF-6492
Rev: 3 OF 11

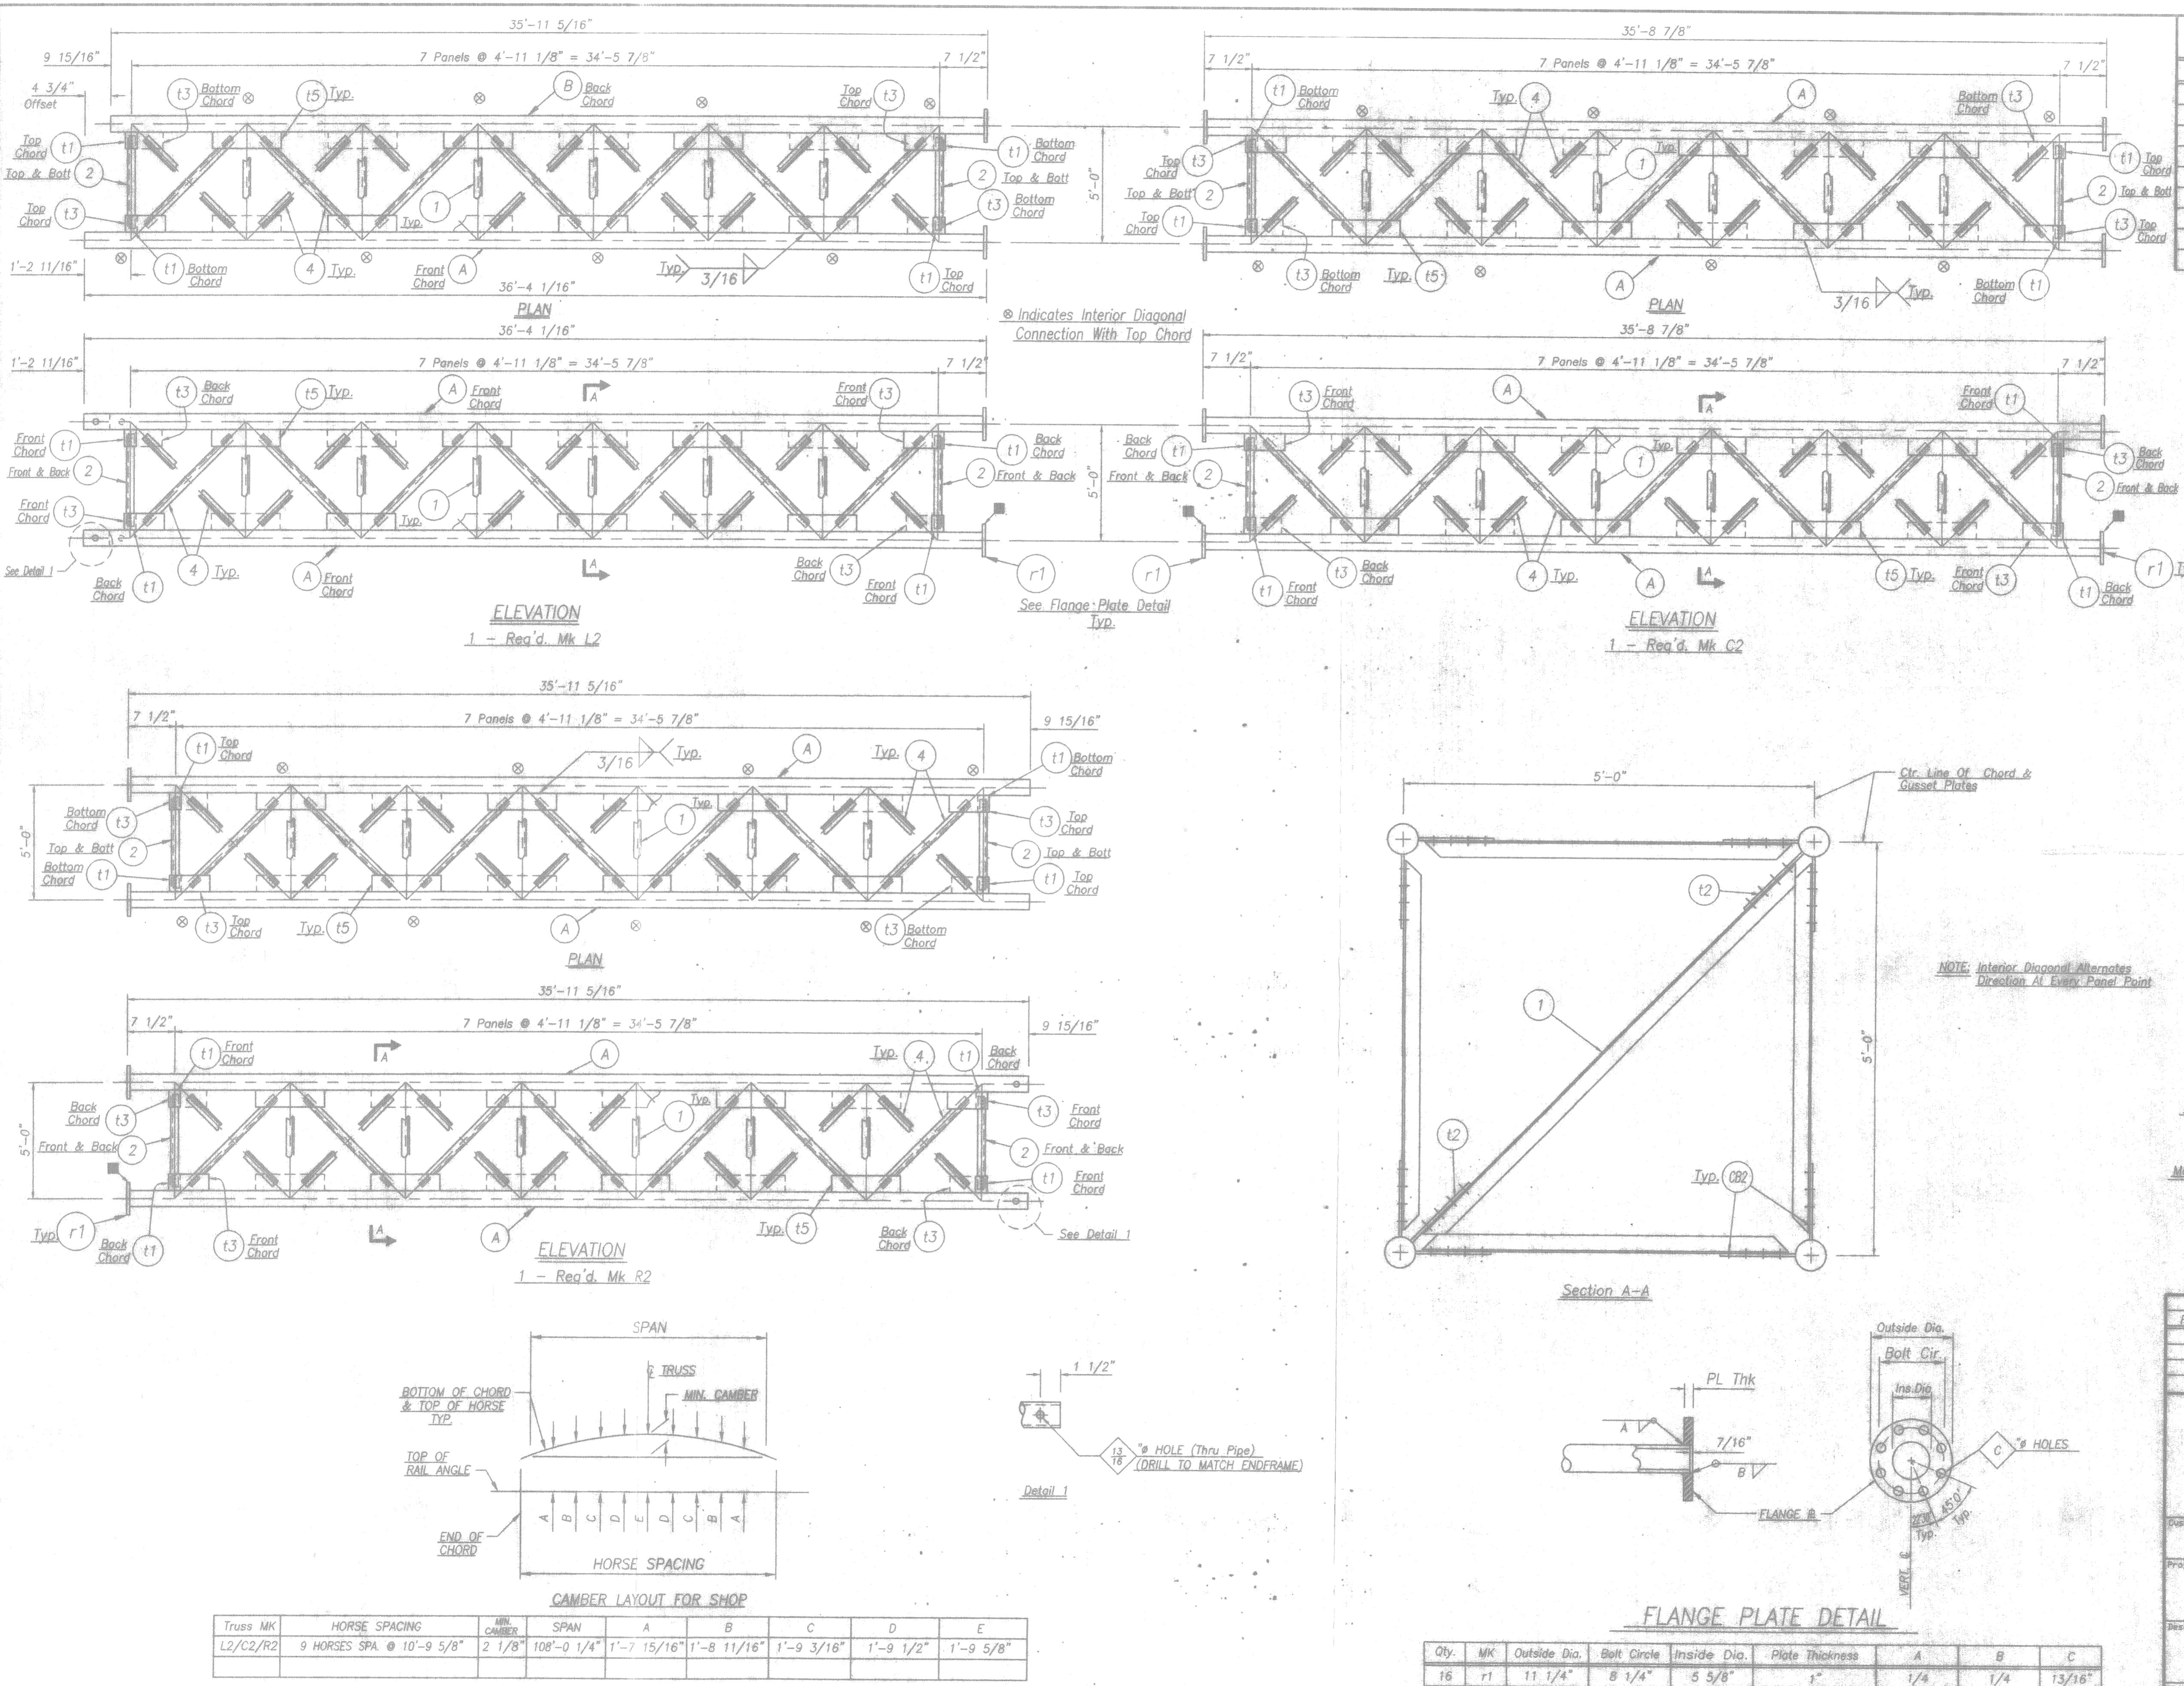


TY.	MK	Description	Length	Remark
2	L2A	5.563"O.D. x .258" W PIPE	36'-3 5/8"	
2	L2B	do	35'-10 7/8"	
4	C2A	do	35'-6"	
4	R2A	do	35'-10 7/8"	
6	r1	PL 1" x 11 1/4" DIA.		
4	FBI	3/4"Øx 3 1/4" H.S. HEX BOLT & NUT W/2 FLAT WASHERS		

BILL of MATERIAL

NOTE: For Angle Braces, Conn. Hardware, & Tab Plates, See Sh. No. 7

Material Specs:
Steel Pipe Shall Be API Spec 5L x 42 FY=42,000 P.S.I.
All Other Steel - A.S.T.M. A709, Gr.36
Galv. Steel Per A.S.T.M. A123
H.S. Hardware To Be A.S.T.M. A325
Galv. Hardware Per A.S.T.M. A157, Gr. 2





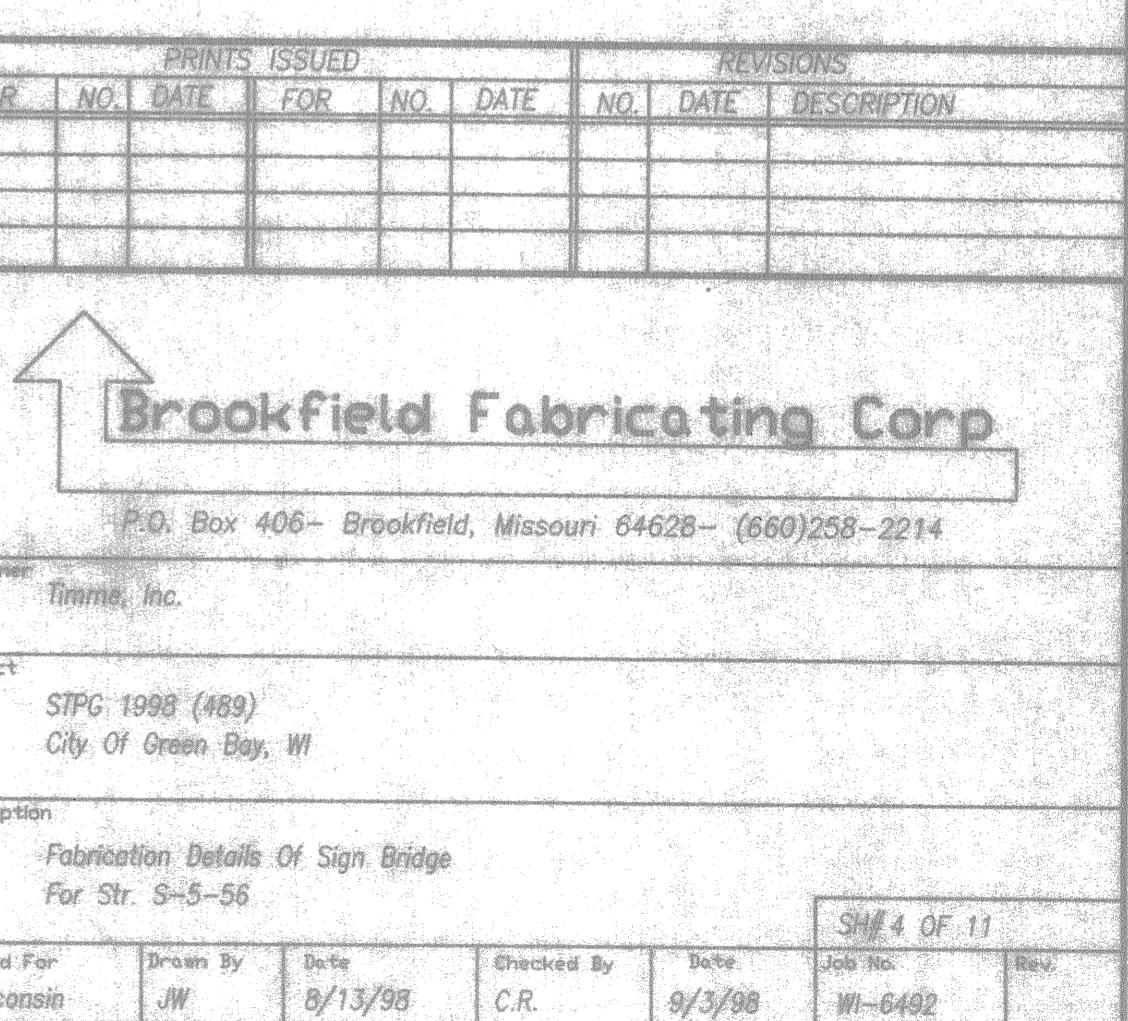


FLANGE PLATE DETAIL



Qty.	MK	Outside Dia.	Bolt Circle	Inside Dia.	Plate Thickness	A	B	C
16	r1	11 1/4"	8 1/4"	5 5/8"	1"	1/4	1/4	13/16"

BILL of MATERIAL

QTY.	MK	Description	Length	Remark
2	L3A	5.563" O.D. x .258" W PIPE	31'-0 1/2"	
2	L3B	do	30'-7 1/2"	
4	C3A	do	30'-4 3/4"	
2	R3A	do	30'-7 1/2"	
2	R3B	do	31'-5 13/16"	
16	r1	PL 1" x 11 1/4" DIA.		
64	FB1	3/4" x 3 1/4" H.S. HEX BOLT & NUT W/ 2 FLAT WA.		

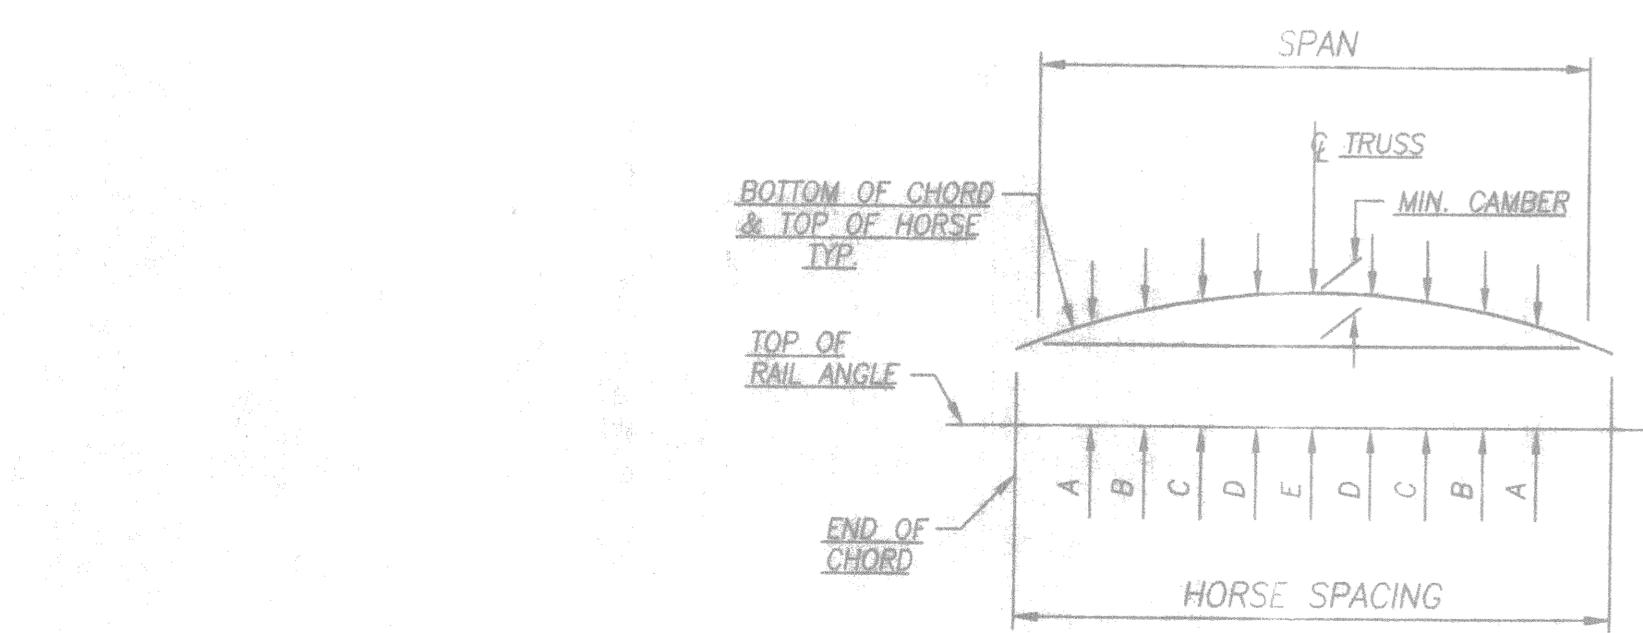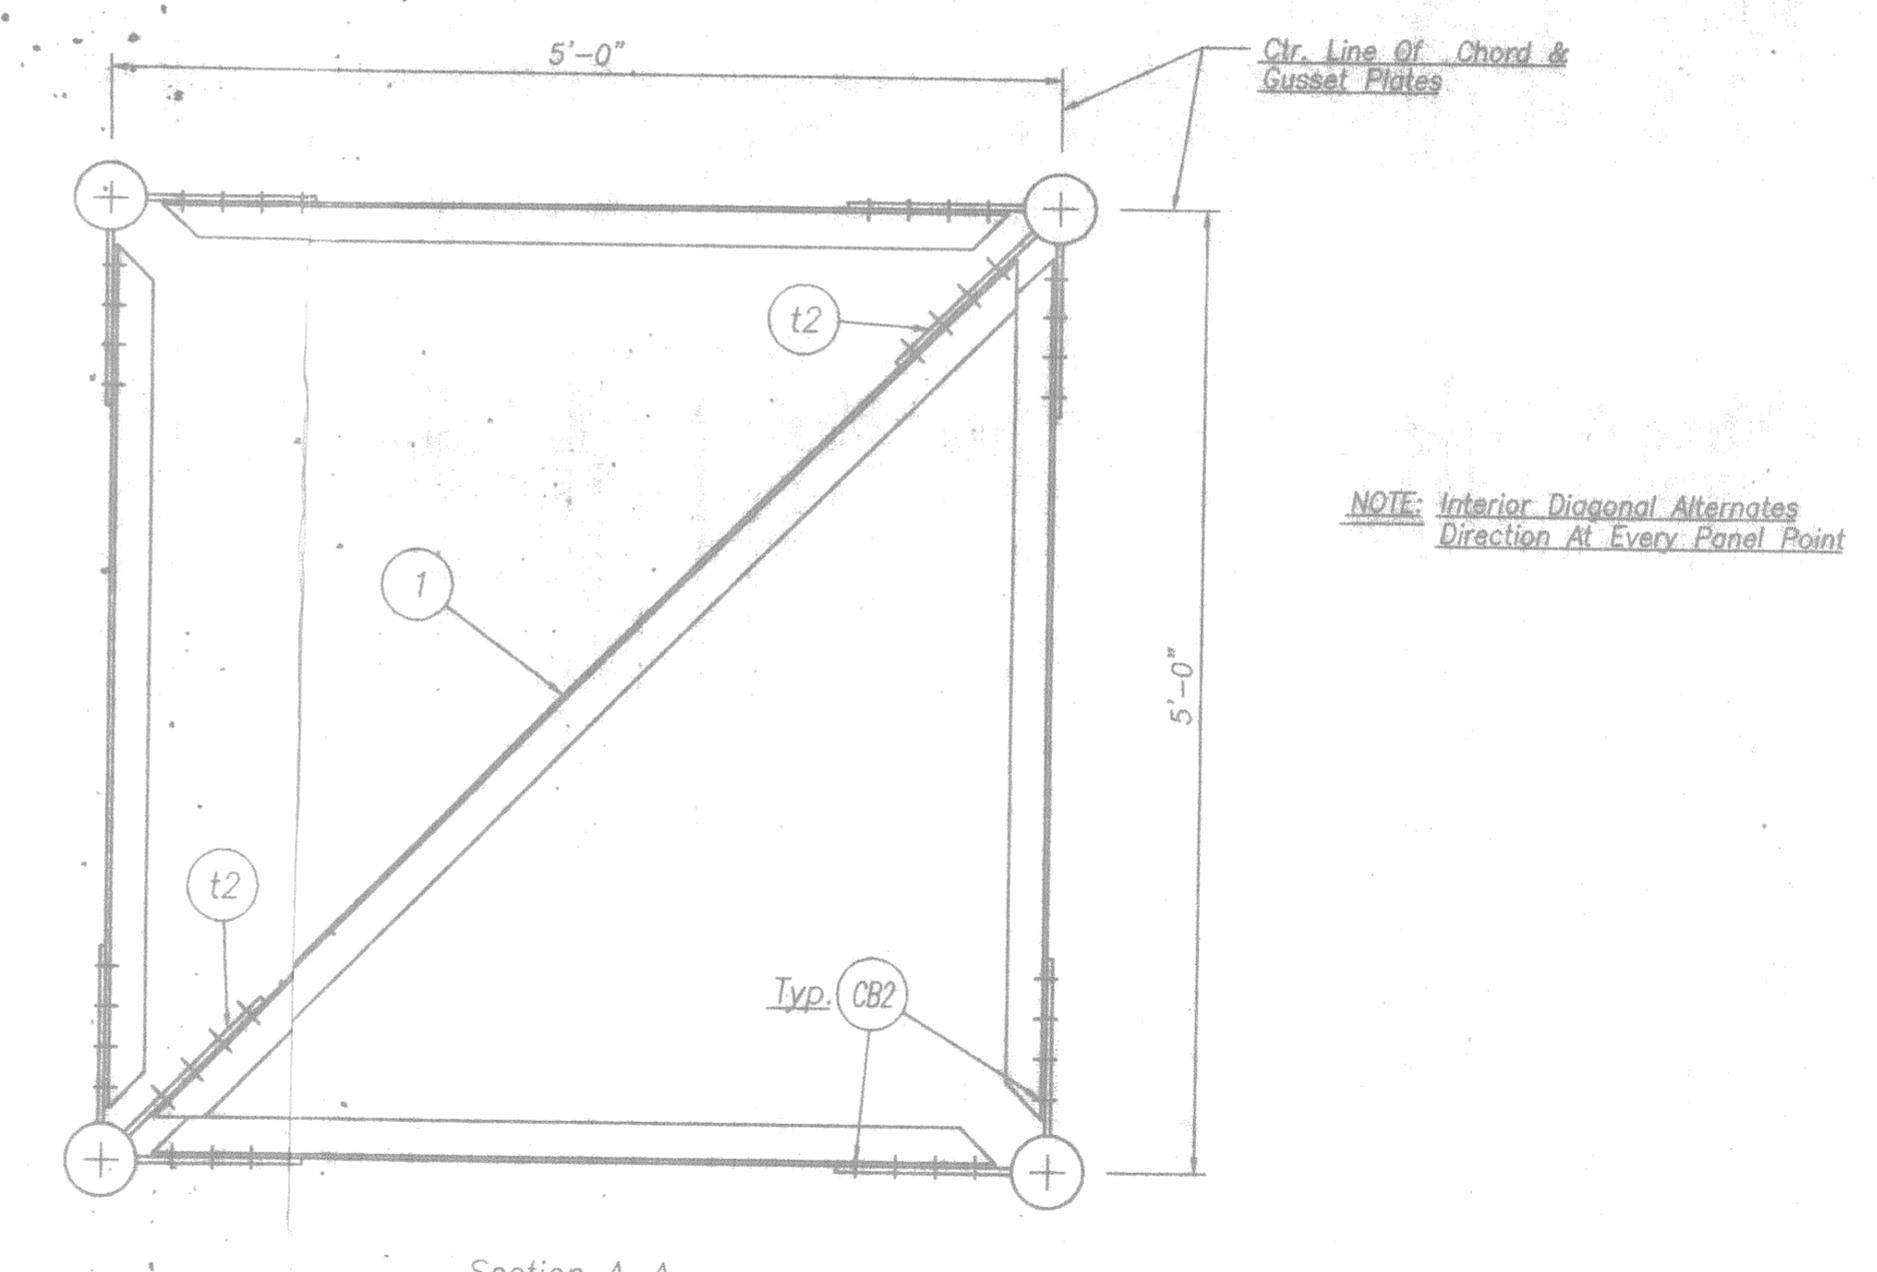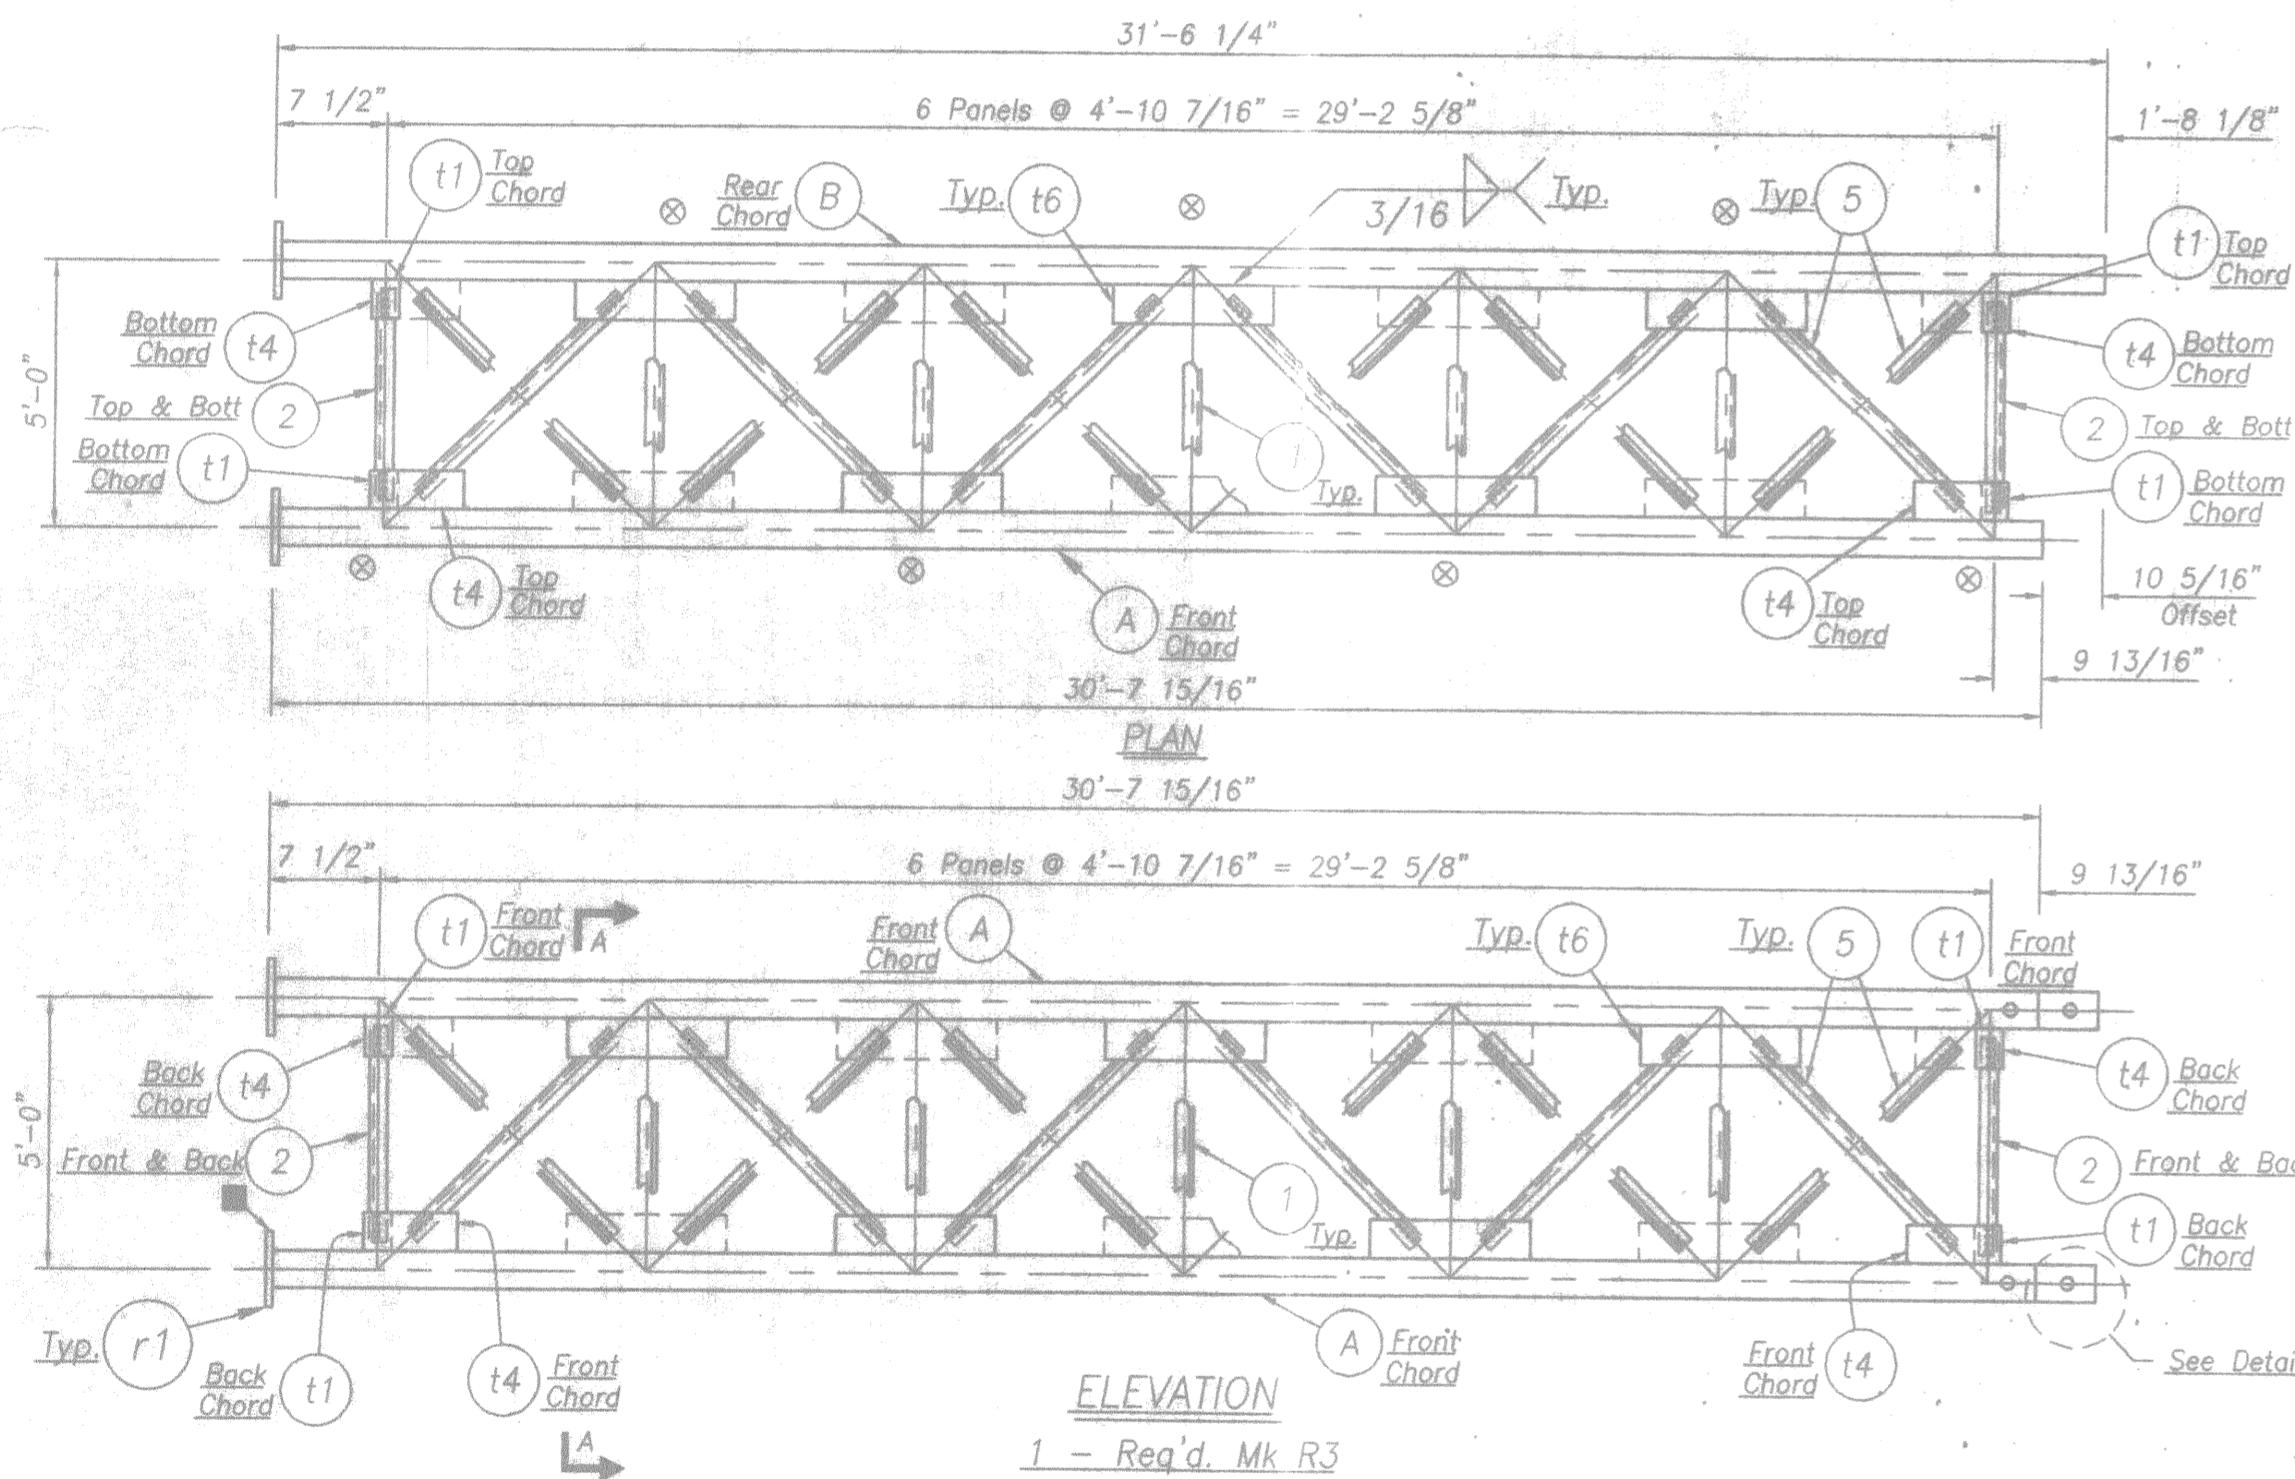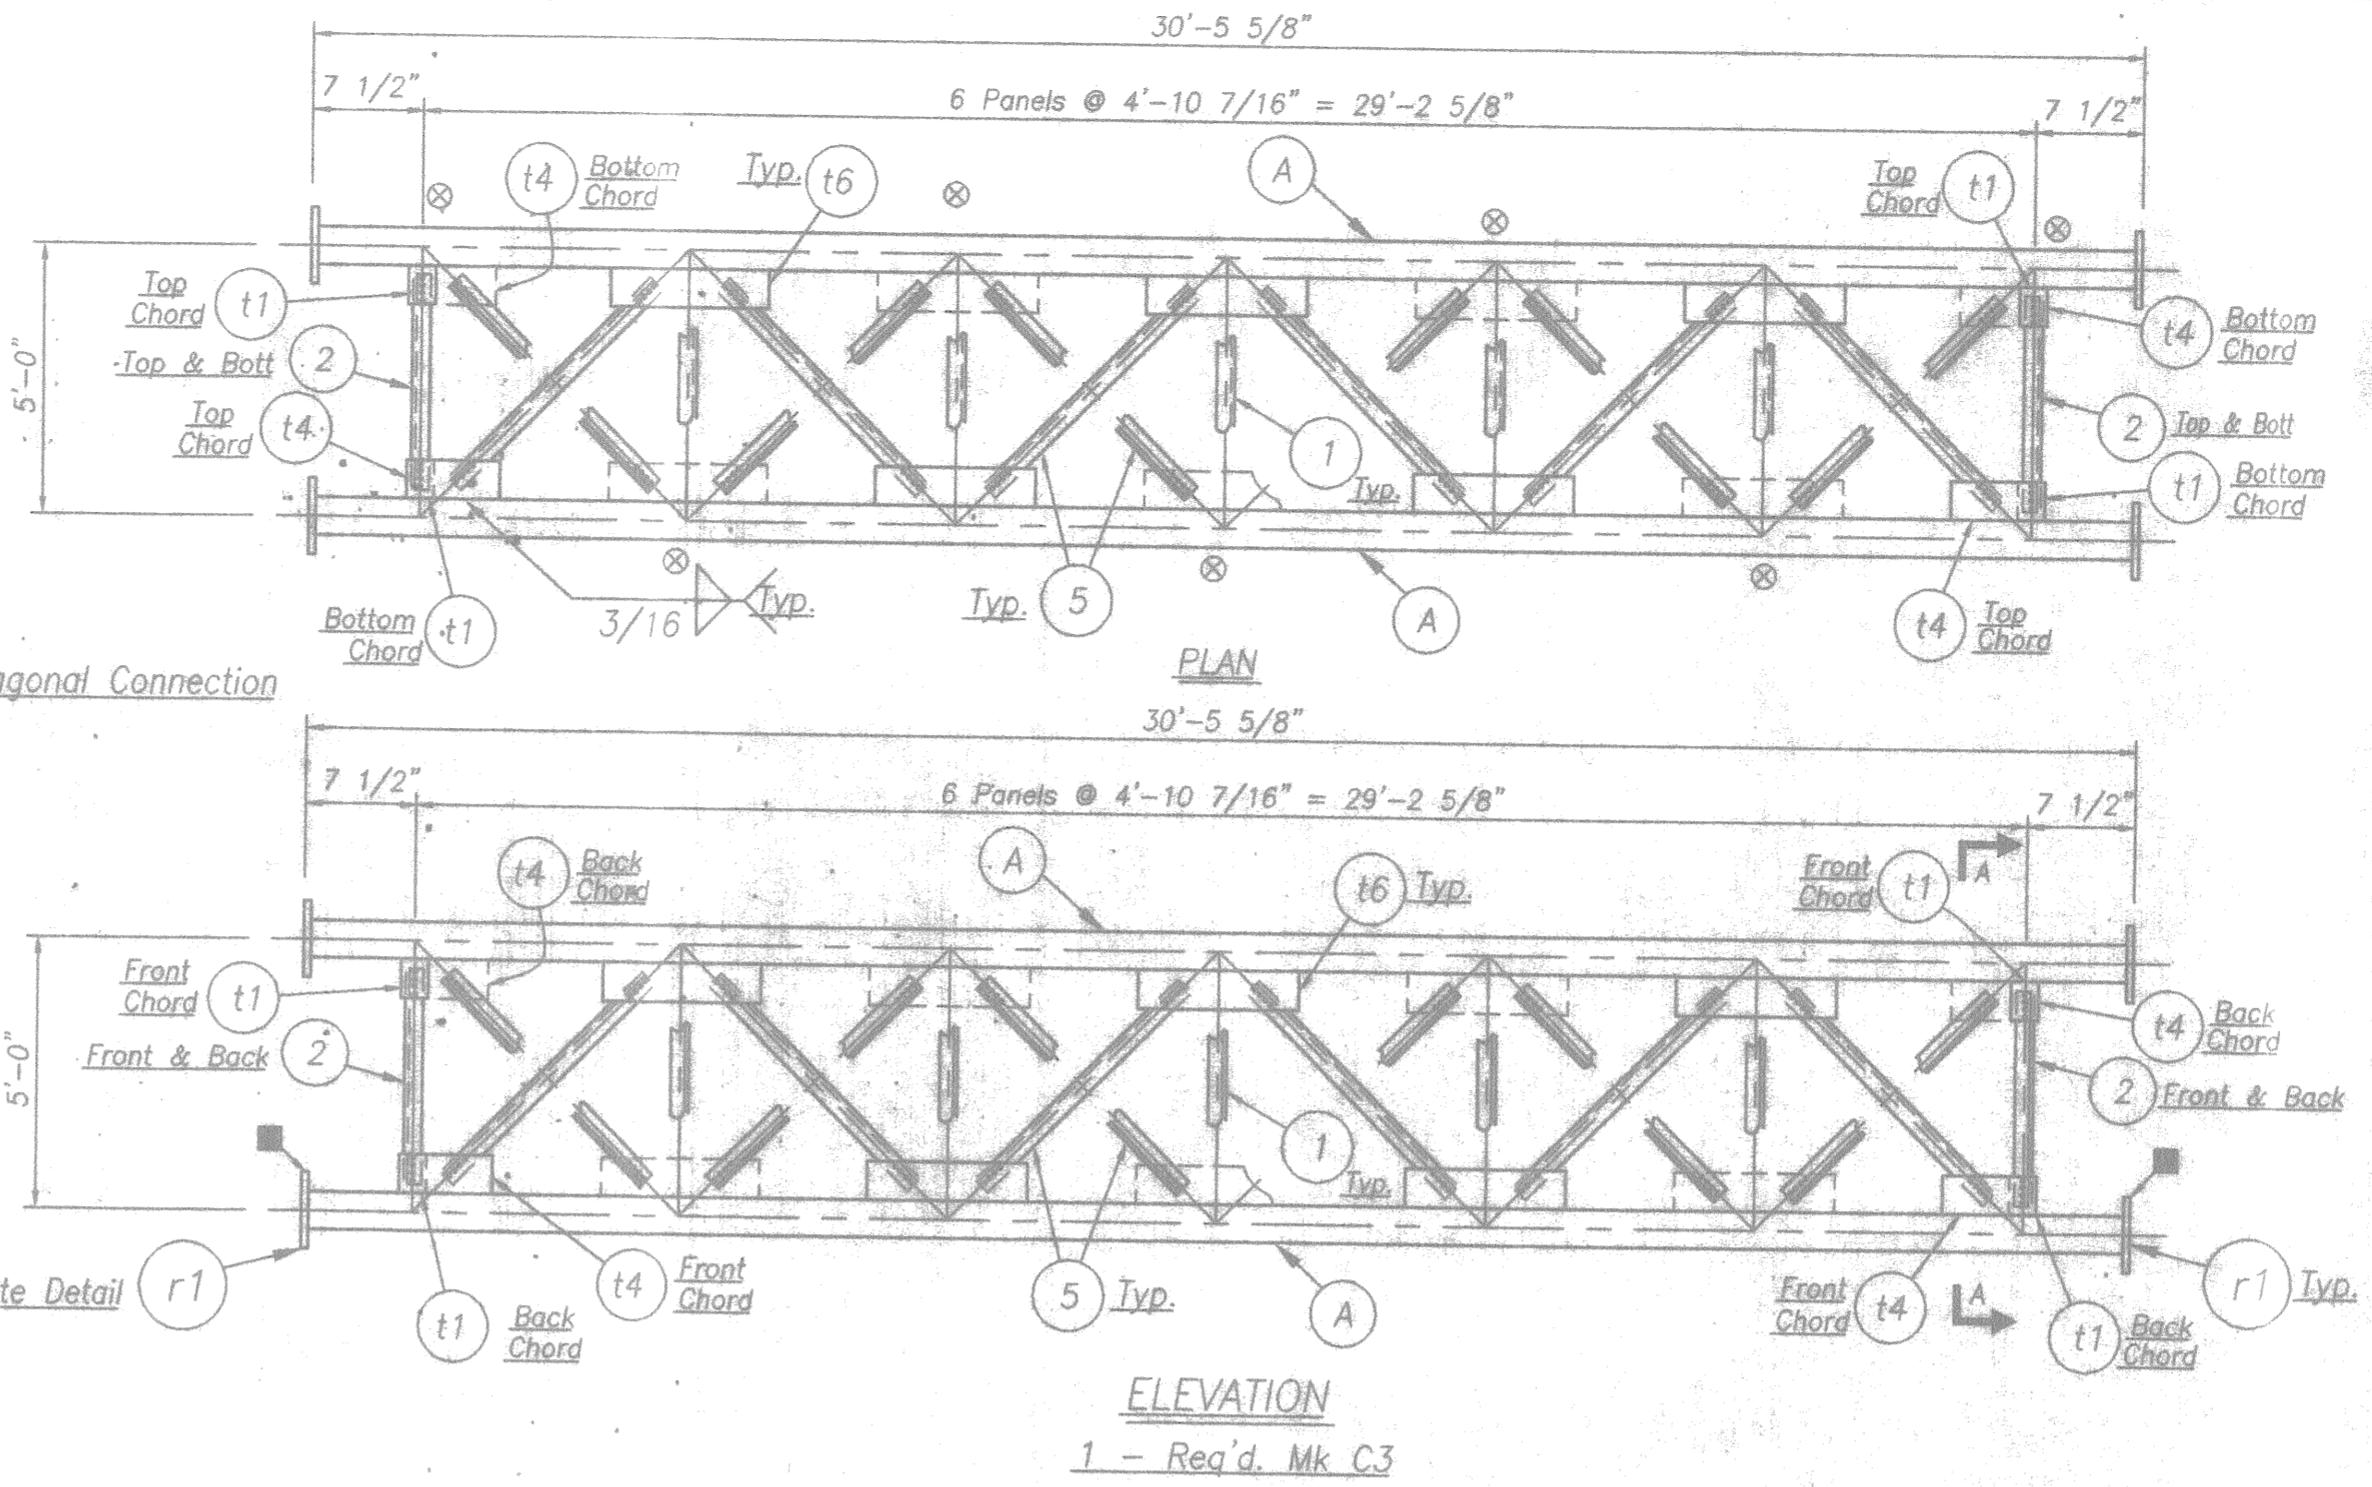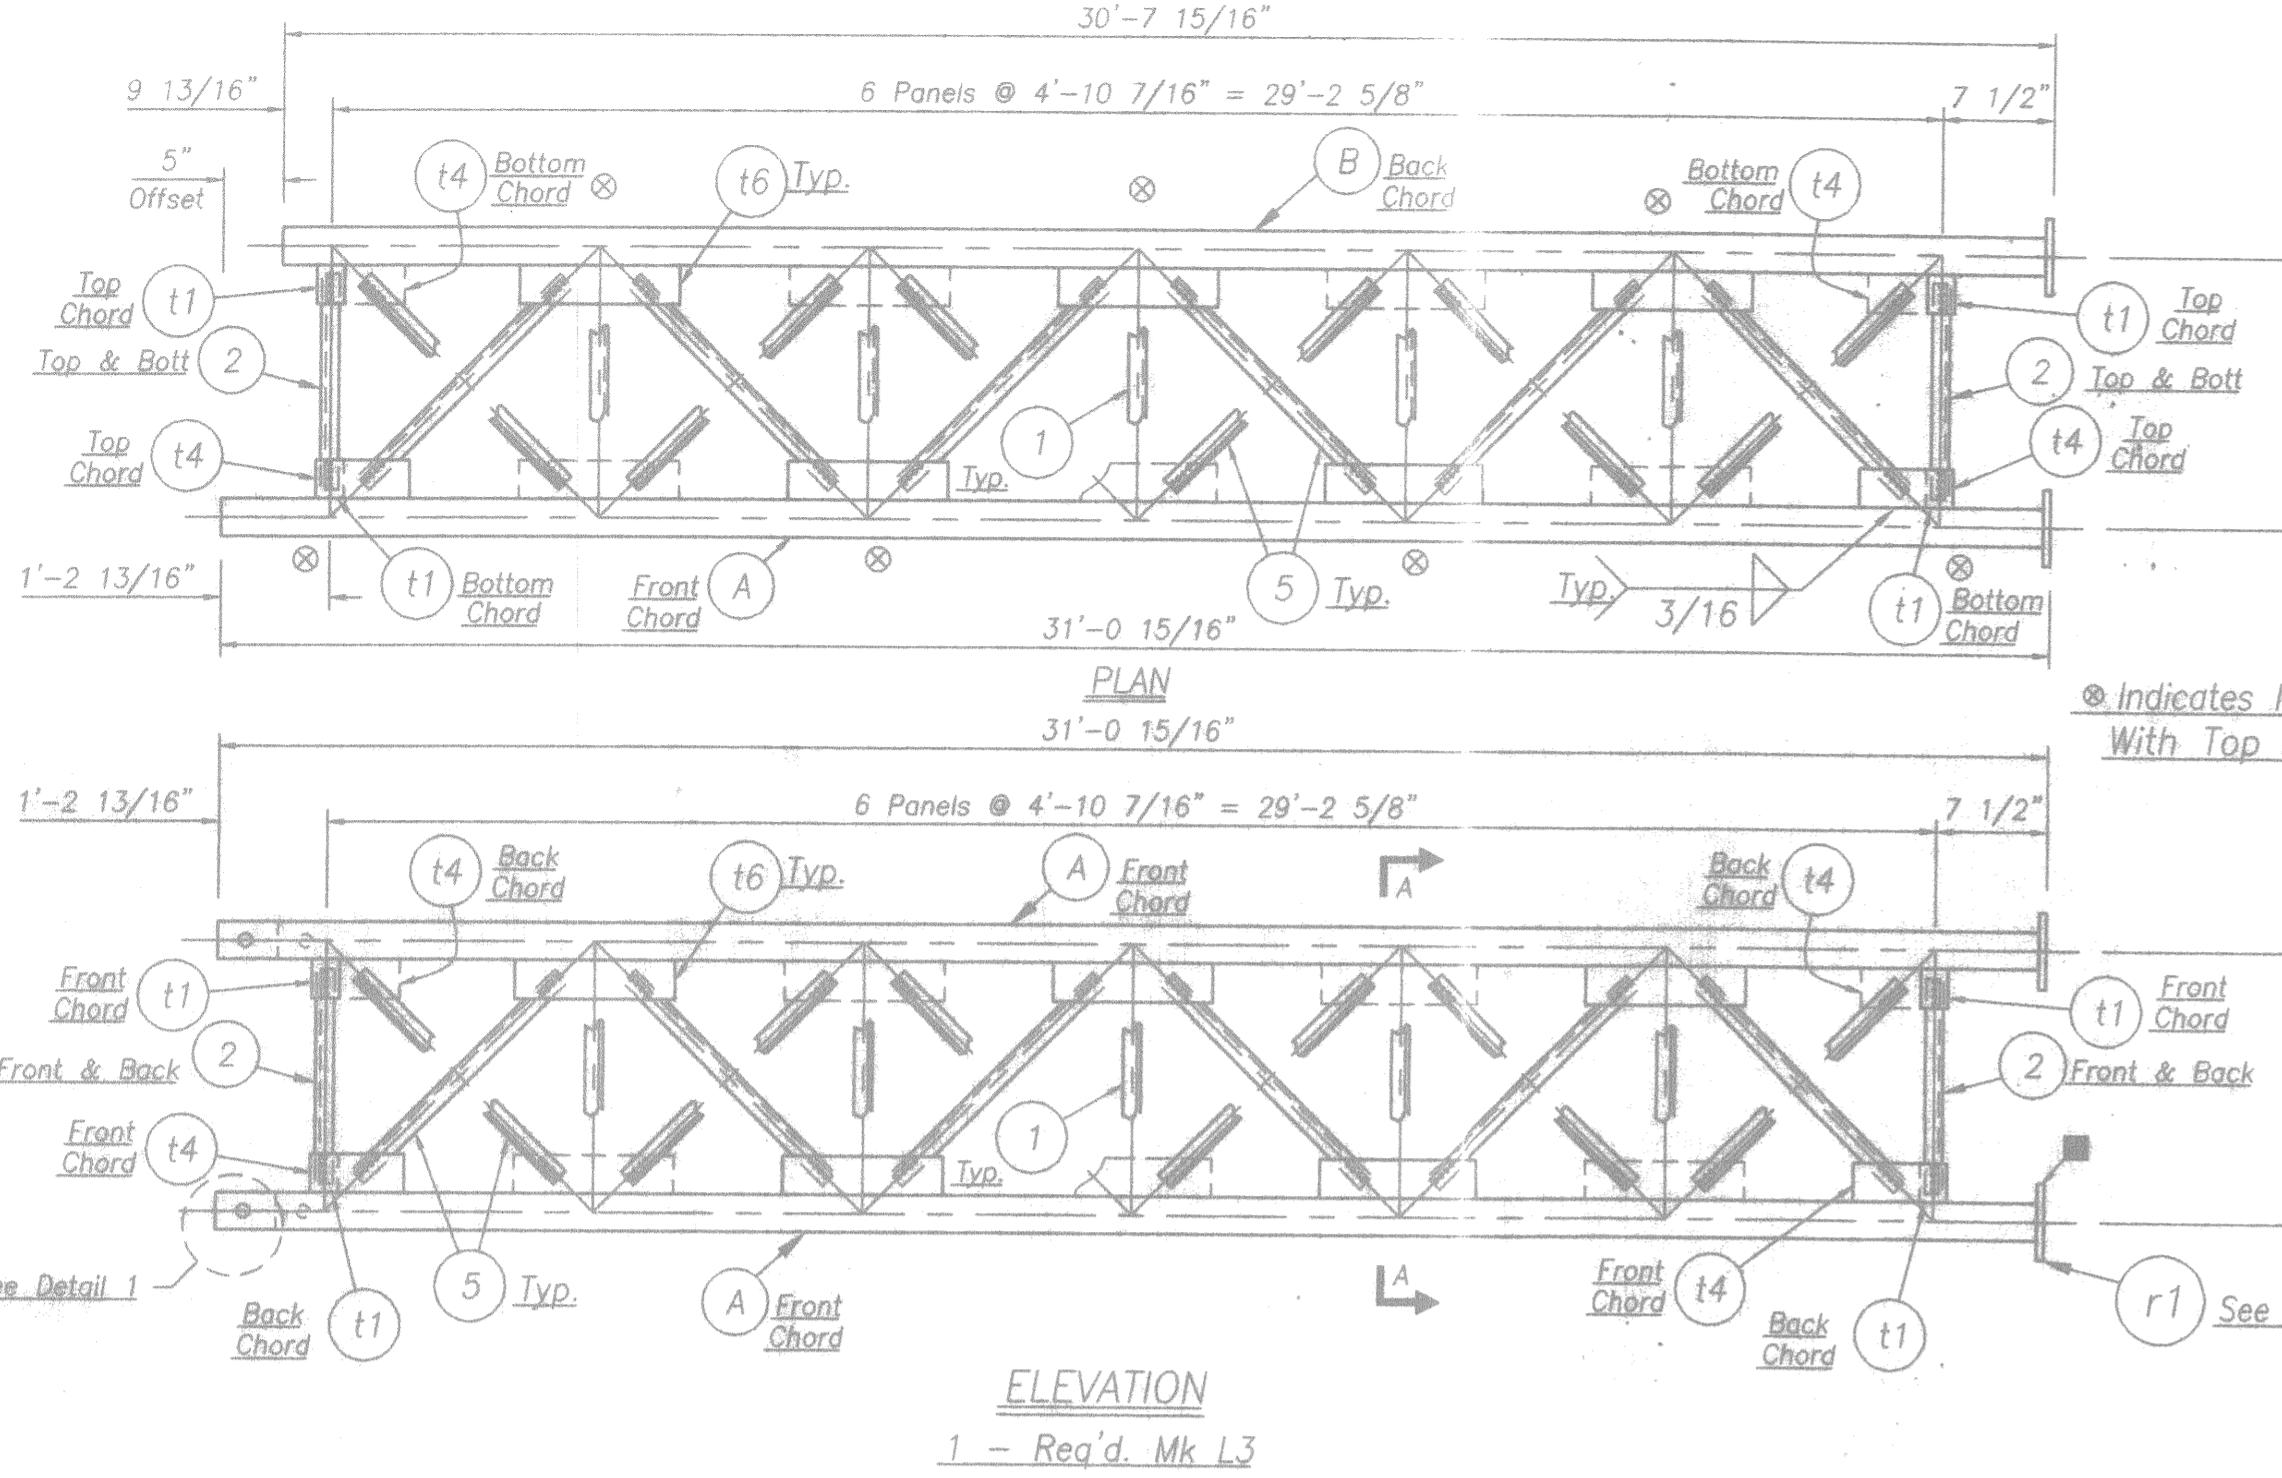

Truss MK	HORSE SPACING	MIN. CAMBER	SPAN	A	B	C	D	E
L3/C3/R3	9 HORSES SPA @ 9'-3 11/16"	1 5/8"	93'-0 13/16"	1'-7 3/4"	1'-8 3/8"	1'-8 13/16"	1'-9"	1'-9 1/8"

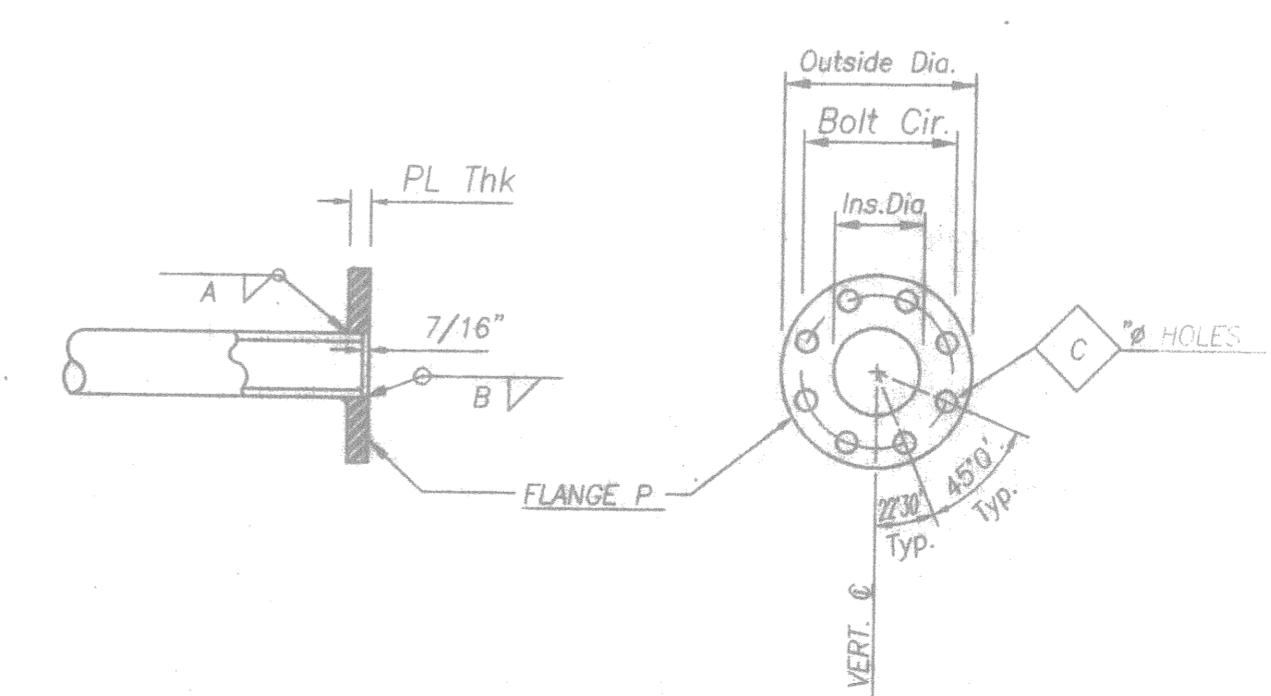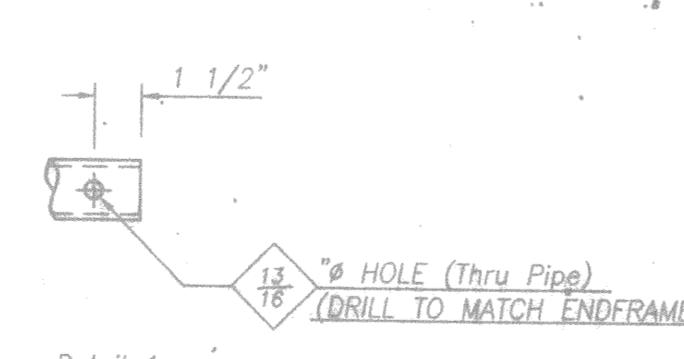


FLANGE PLATE DETAIL

Qty.	MK	Outside Dia.	Bolt Circle	Inside Dia.	Plate Thickness	A	B	C
16	r1	11 1/4"	8 1/4"	5 5/8"	1"	1/4	1/4	13/16"

PRINTS ISSUED				REVISIONS		
FOR	NO.	DATE	FOR	NO.	DATE	DESCRIPTION
Brookfield Fabricating Corp						
P.O. Box 406 - Brookfield, Missouri 64628 - (660)258-2214						
Customer Timme, Inc						
Project STPG 1998 (489) City of Green Bay, WI						
Description Fabrication Details Of Sign Bridge For Str S-5-57						
Printed For Wisconsin Drawn By JW Date 8/14/98 Checked By CR Date 9/3/98 Job No. WI-6492 Rev.						

BILL of MATERIAL

QTY.	MK	Description	Length	Remark
2	L4A	5.563" O.D. x .258" W PIPE	30'-9 5/8"	
2	L4B	do	30'-9 3/16"	
4	C4A	do	40'-3 5/8"	
2	R4A	do	30'-9 3/16"	
2	R4B	do	31'-3 15/16"	
16	r1	PL 1" x 11 1/4" DIA.		
64	FB1	3/4" BX 3 1/4" H.S. HEX BOLT & NUT W/2 FLAT WASHERS		

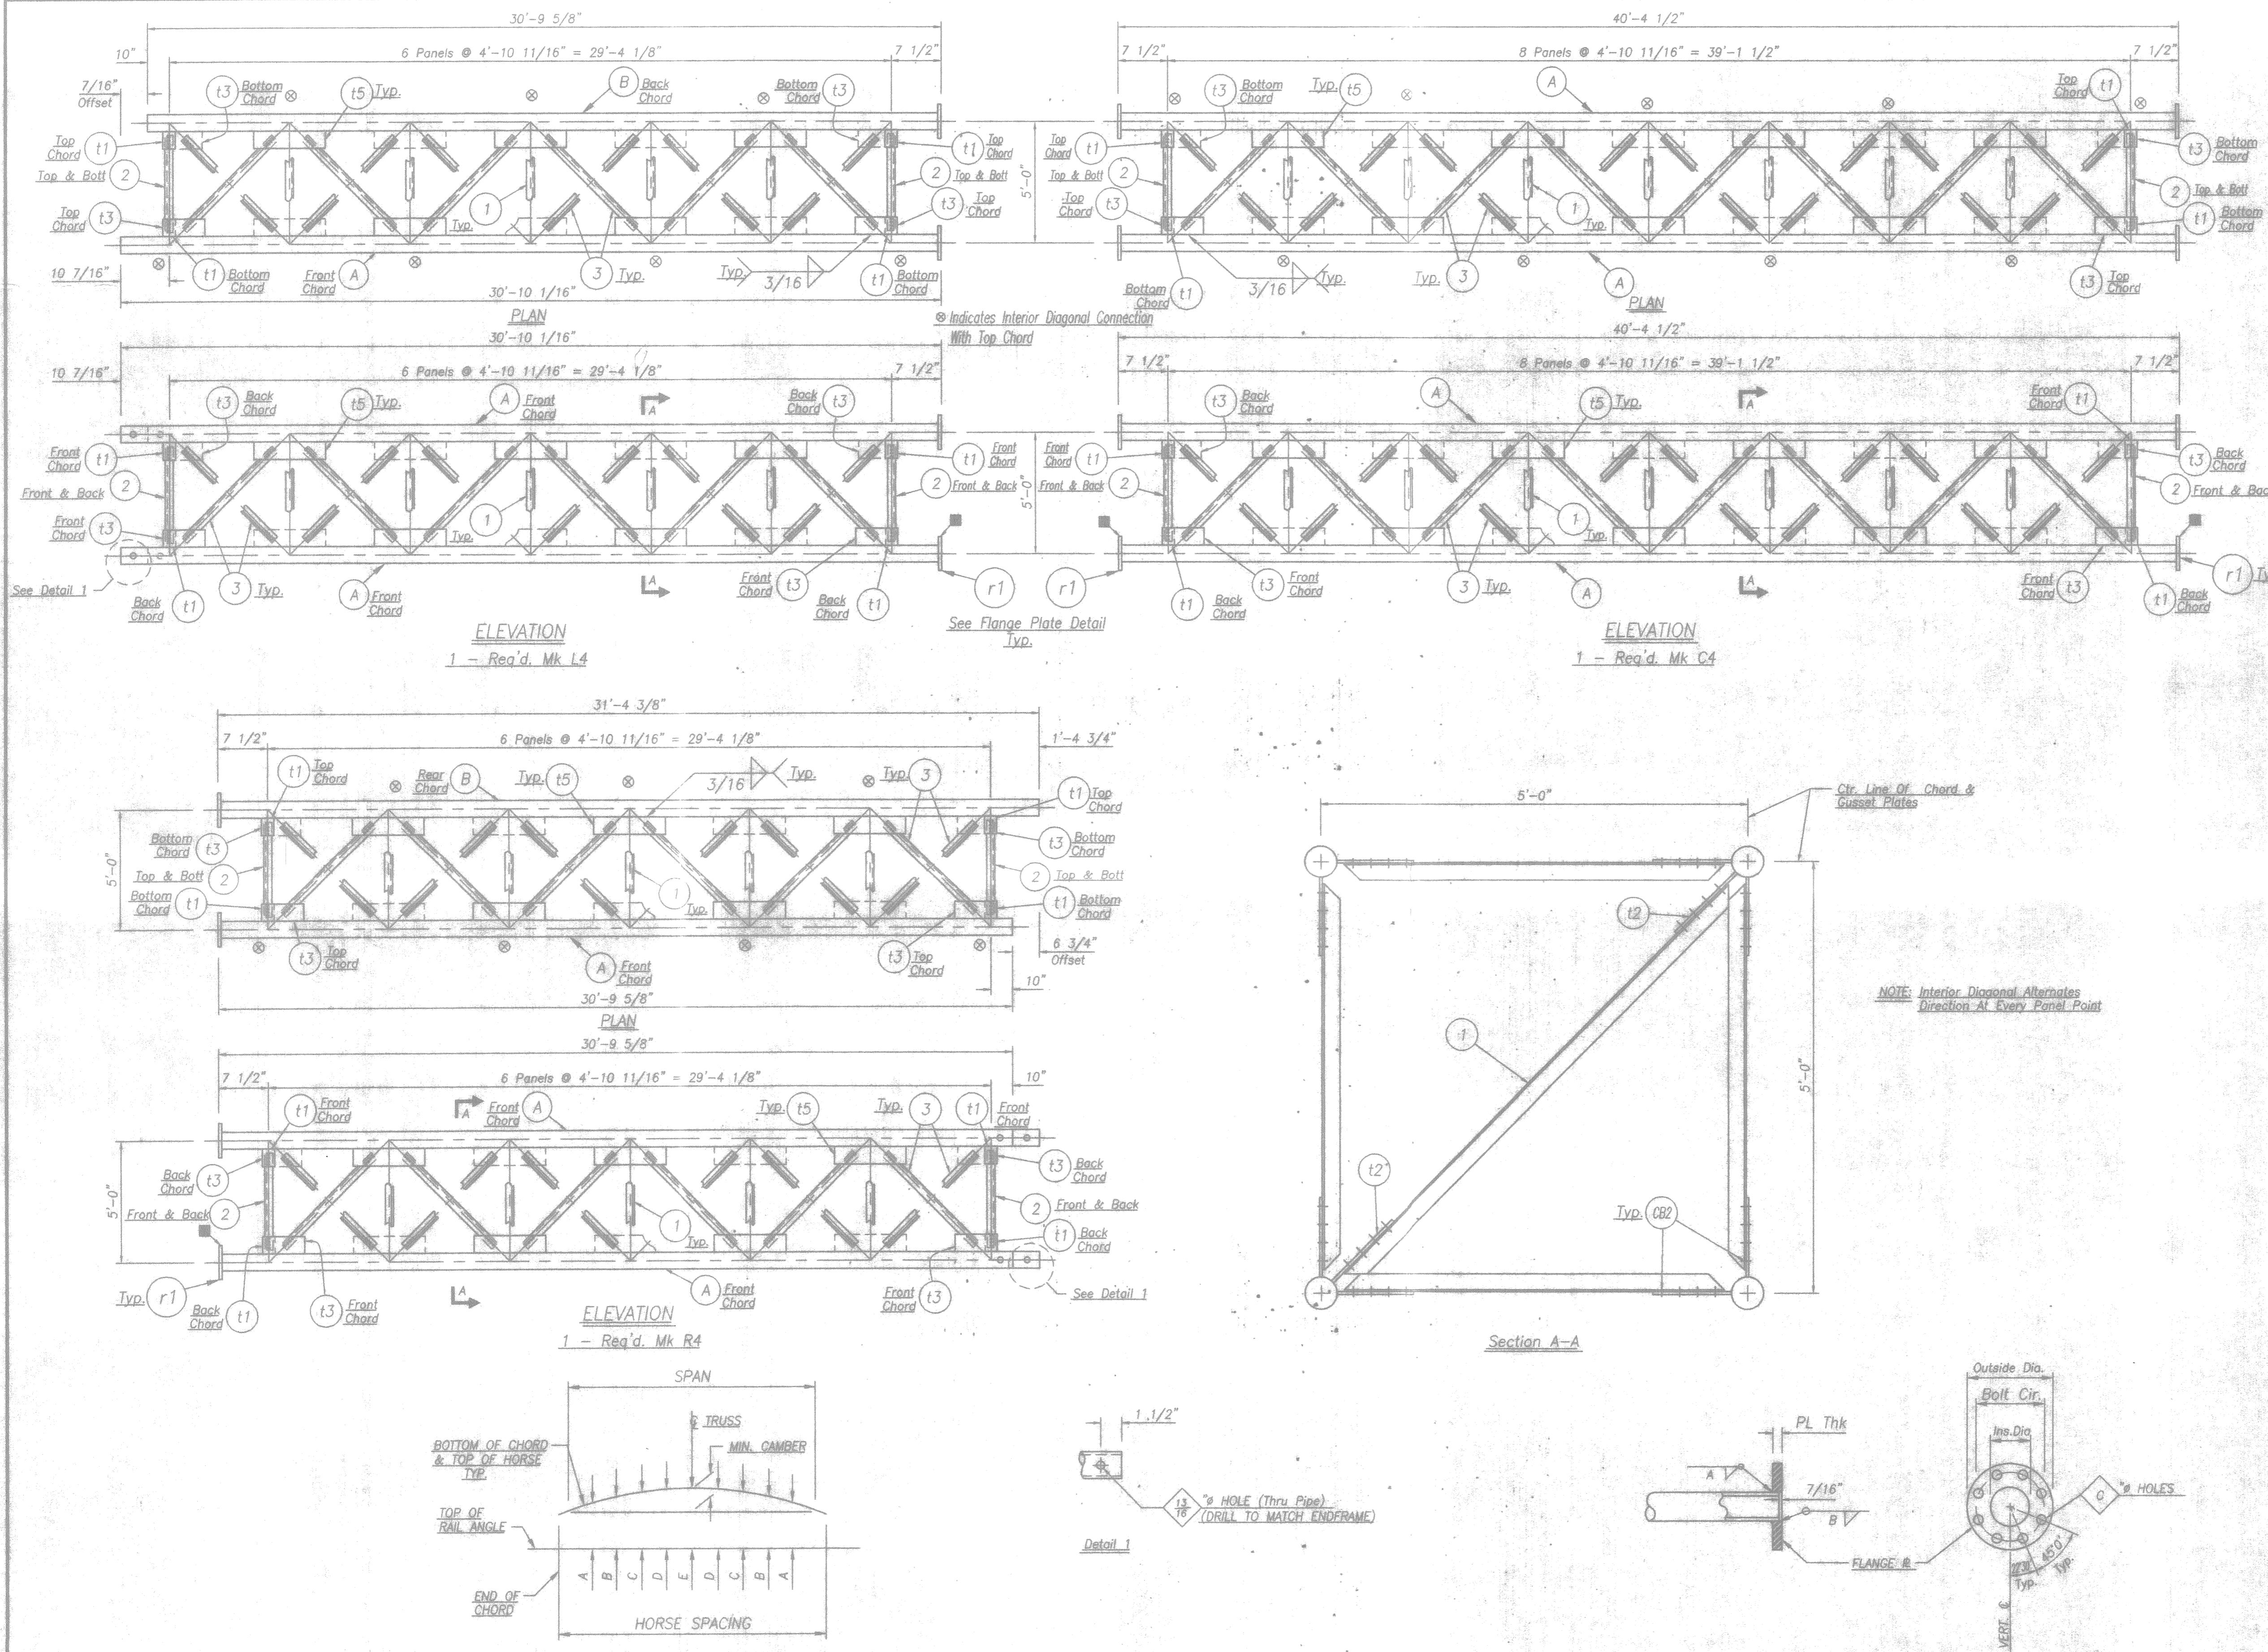

NOTE: For Angle Braces, Conn. Hardware, & Tab Plates, See Sh. No. 7

■ Stamp Truss Section Mk No.'s On The Top Of The Bottom Front Flange

Material Specs:

Steel Pipe Shall Be API Spec. 5L x 42 FY=42,000 P.S.I.


All Other Steel - A.S.T.M. A709, Gr. 36

Galv. Steel Per A.S.T.M. A123

H.S. Hardware To Be A.S.T.M. A325

Galv. Hardware Per A.S.T.M. A153, Class C

PRINTS ISSUED	REVISIONS					
FOR NO.	DATE	FOR NO.	DATE	NO.	DATE	DESCRIPTION

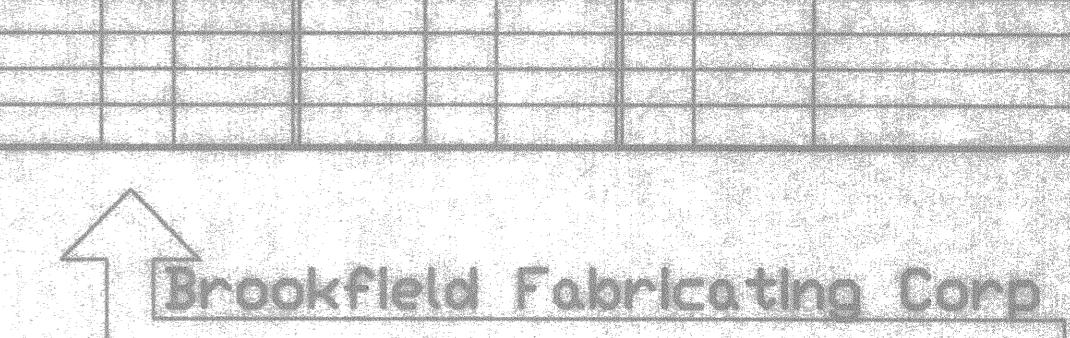

Customer: Timline, Inc.


Project: STPG 1998 (489)
City of Green Bay, WI

Description: Fabrication Details Of Sign Bridge
For Str. S-5-B8

Printed For: Wisconsin
Drawn By: JW
Date: 8/17/98
Checked By: C.R.
Date: 9/3/98
Job No.: WI-6492
Rev: 1

BILL of MATERIAL


QTY.	MK	Description	Length	Remark
90	1	L 3" x 3" x 1/4"	6'-2 13/16"	
96	2	do	4'-6 7/16"	
156	3	do	6'-0"	
84	4	do	6'-0 3/16"	
72	5	do	5'-11 7/8"	
3084	CB2	3/4" dia 2" H.S. HEX BOLT	do	NUT W/2 FLAT WA.
96	t1	FB 6 1/2" x 3/8"	0'-10 1/2"	
180	t2	do	1'-0 1/4"	
72	t3	PL 3/8" x 10 1/2"	1'-1 9/16"	
24	t4	do	1'-1 1/2"	
204	t5	FB 3" x 3/8"	1'-11 1/8"	
60	t6	do	1'-11"	
84	U1	1/2" S.S. U-BOLT W/2 HEX NUTS & 2 FLAT WA.		

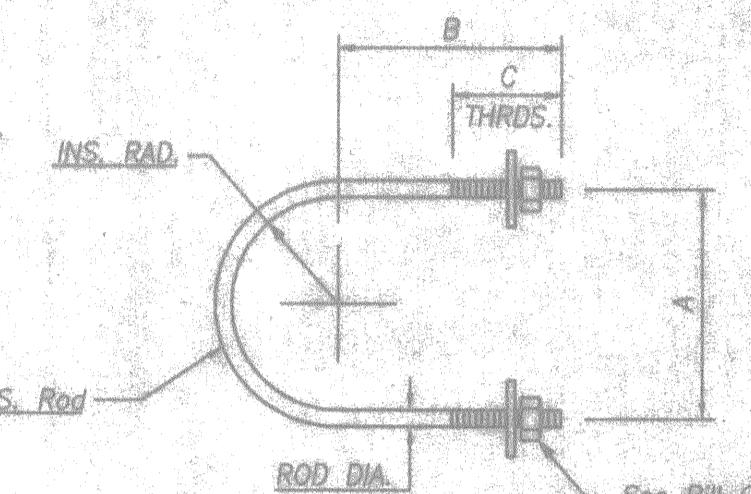

See Bill Of Material For
Hardware To Furnish


U - BOLT DETAIL

QTY	MK	ROD DIA	A	B	C	ROD LENGTH	INS RAD	CONNECTION
84	U1	1/2"	6 1/8"	4 1/4"	1 1/2"	1'-6 1/4"	2 7/8"	Existing Sign Supp's To Truss

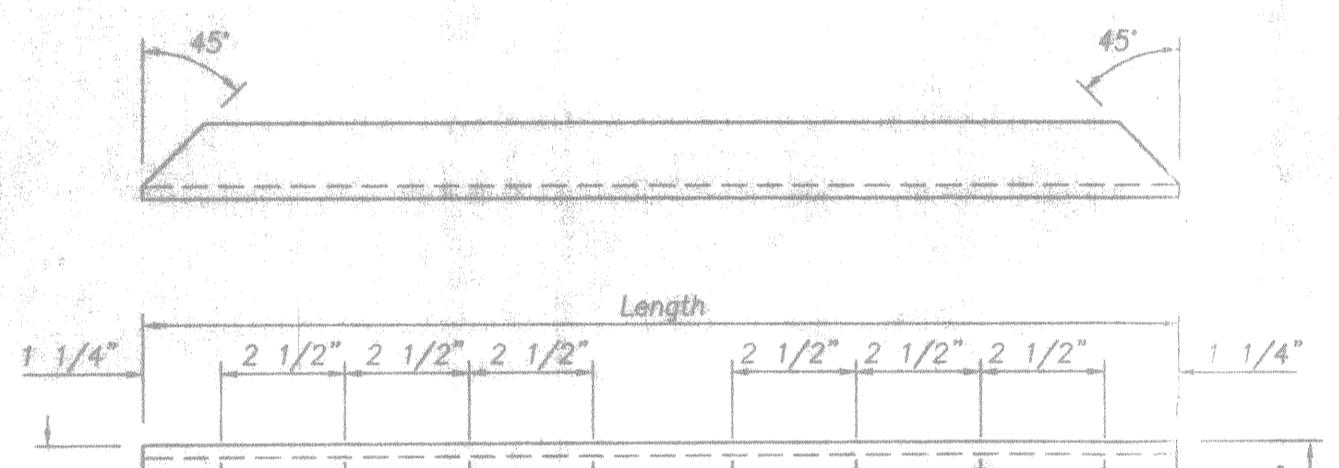

Angle Detail

Qty.	MK	Length
90	1	6'-2 13/16"
96	2	4'-5 7/16"

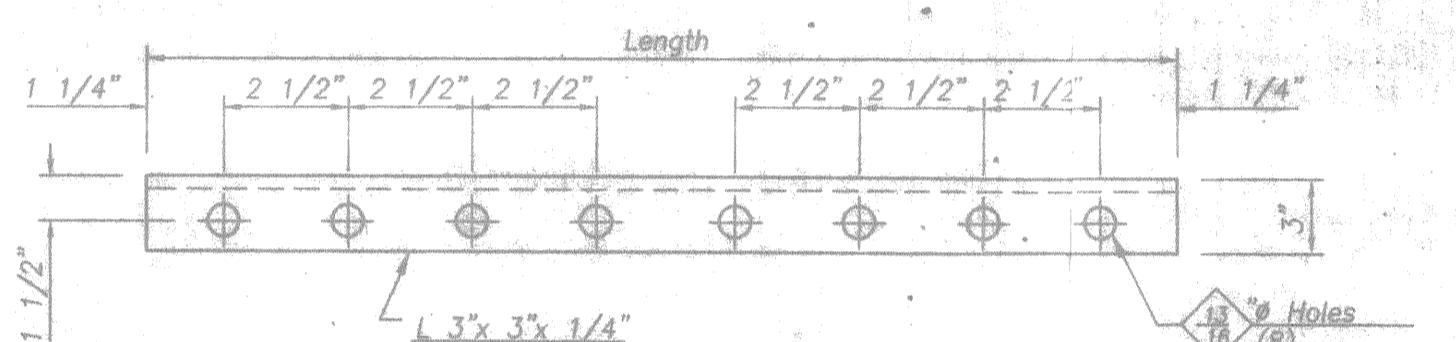


Hole Size (See Table)

(4)

6 Pnl Pt
Plate & Holes

Tab Plate Details

Qty.	MK	Length	Width	A	B	C	D	Hole Size
96	t1	6 1/2"	10 1/2"	1 3/4"	4 1/4"	6 3/4"	9 1/4"	13/16"
180	t2	6 1/2"	1'-0 1/4"	3 1/2"	6"	8 1/2"	11"	13/16"

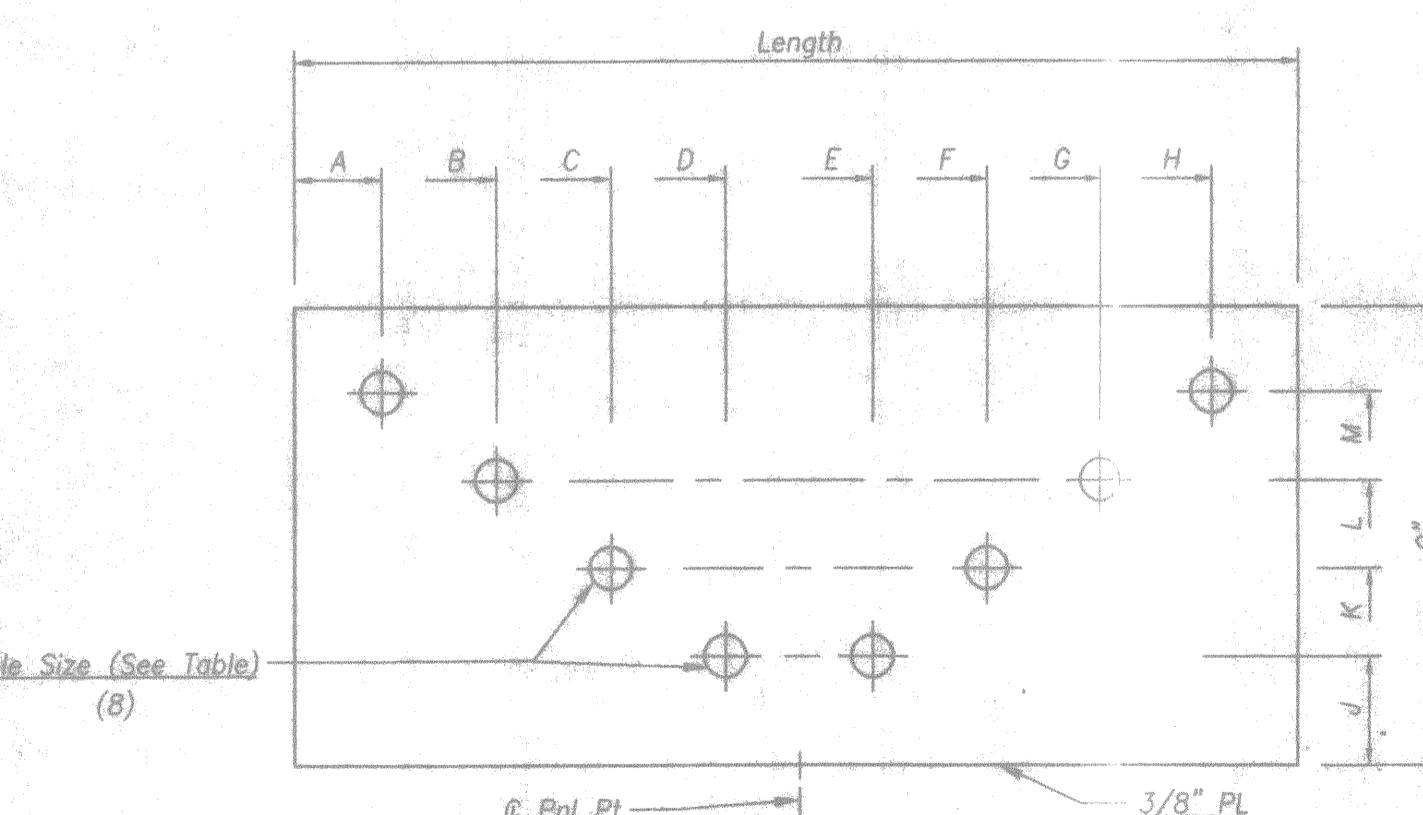


Hole Size (See Table)

(8)

6 Pnl Pt
Plate & Holes

Tab Plate Details

Qty.	MK	Length	A	B	C	D	E	F	G	H	J	K	L	M	Hole Size
204	t5	1'-11 1/8"	1 1/4"	3"	4 3/4"	6 1/2"	1'-4 5/8"	1'-6 3/8"	1'-8 1/8"	1'-2 7/8"	2 3/8"	4 3/16"	5 15/16"	7 3/4"	13/16"
60	t6	1'-11"	1 1/4"	3"	4 3/4"	6 1/2"	1'-4 1/2"	1'-6 1/4"	1'-8"	1'-9 3/4"	2 3/8"	4 3/16"	5 15/16"	7 3/4"	13/16"

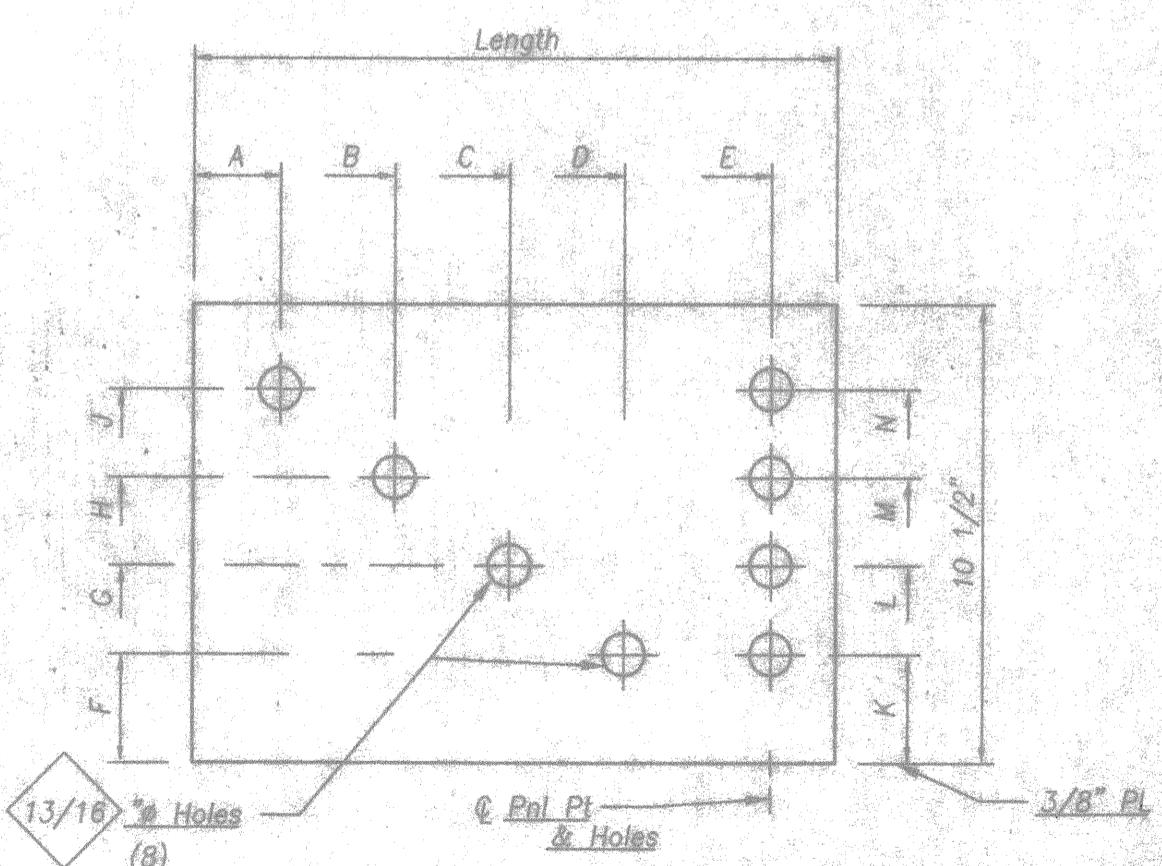

13/16" Holes

(8)

6 Pnl Pt
Plate & Holes

Tab Plate Details

Qty.	MK	Length	A	B	C	D	E	F	G	H	J	K	L	M	N
72	t3	1'-1 9/16"	1 1/4"	3"	4 3/4"	6 1/2"	11 9/16"	2 3/8"	4 3/16"	5 15/16"	7 3/4"	1 3/4"	4 1/4"	6 3/4"	9 1/4"
24	t4	1'-1 1/2"	1 1/4"	3"	4 3/4"	6 1/2"	11 1/2"	2 3/8"	4 3/16"	5 15/16"	7 3/4"	1 3/4"	4 1/4"	6 3/4"	9 1/4"

Material Specs:

All Steel - A.S.T.M. A709 Gr. 36

Galv. Steel Per A.S.T.M. A123

High Strength Bolts, Nuts, & Washers - A.S.T.M. A325

Galv. Bolts, Nuts, & Washers Per A.S.T.M. A153

Stainless Steel Bolts & U-Bolts To Be A.S.T.M. A276 And

Any Type In The 300 Series Having A Minimum Yield Strength Of 40,000 P.S.I. And A Minimum Elongation In Two Inches Of 15 Percent. The Bolt Heads Shall Conform To ANSI Finished Hexagon

ANSI Specification B-18.2.1. Threads Shall Conform To The Standards Of Class 2A Or 2B

Stainless Steel Nuts To Be A.S.T.M. A194 Grade B, PC, ST, or BF

The Nuts Shall Conform To ANSI Finished Hexagon

ANSI Specification B-18.2.2. Threads Shall Conform To The Standards Of Class 2A Or 2B

Stainless Steel Washers To Be A.S.T.M. A240 Type 302, 304, 304L, 305 or 309S

PRINTS ISSUED	REVISIONS							
FOR	NO.	DATE	FOR	NO.	DATE	NO.	DATE	DESCRIPTION



P.O. Box 406 - Brookfield, Missouri 64528-2214

Customer

Timme, Inc.

Project

STPG 1998(400)

City Of Green Bay, WI







Description

Fabrication Details Of Connection Plates, Bracing Angles & U-Bolts

Sheet 7 OF 11								
Printed For	Driven By	Date	Checked By	Date	Job No.	Rev.	WISCONSIN	W-6402
PLT	JW	08/19/98	JW	8/19/98	C.R.	8/3/98		

BILL of MATERIAL

QTY.	MK	Description	Length	Remarks
1	E1L	10 3/4" O.D. x .365" W	25'-9"	
1	E1R	do	25'-8 5/8"	
1	E2L	do	25'-7"	
1	E2R	do	25'-7 1/4"	
5	d1	L 4"x 4"x 3/8"	5'-1 1/2"	
5	d2	do	5'-0 15/16"	
2	h1	do	3'-11 5/8"	
2	h2	do	3'-11 1/4"	
4	b1	PL 1 1/2" x 10"	1'-11"	
16	gp1	FB 6"x 1/2"	1'-0"	
16	1a	FB 6 1/2" x 1/2"	0'-0 13/16"	
8	2a	FB 4 1/2"x 1/2"	0'-5 5/8"	
4	1b	PL 3/8"x 10"	1'-1"	
4	2b	do	2'-2"	
8	3b	do	2'-4"	
16	EC1	PL 1/4" x 10 3/4" DIA.	-----	
48	bc	FB 2" x 1/4"	0'-2"	
48	End Cap Screws	5/16" x 3/4" S.S. Rd. Hd. Set Screw		
8	OB1	3/4"x 8" H.S. Hex Bolt & Nut W/2 Flat Wa.		

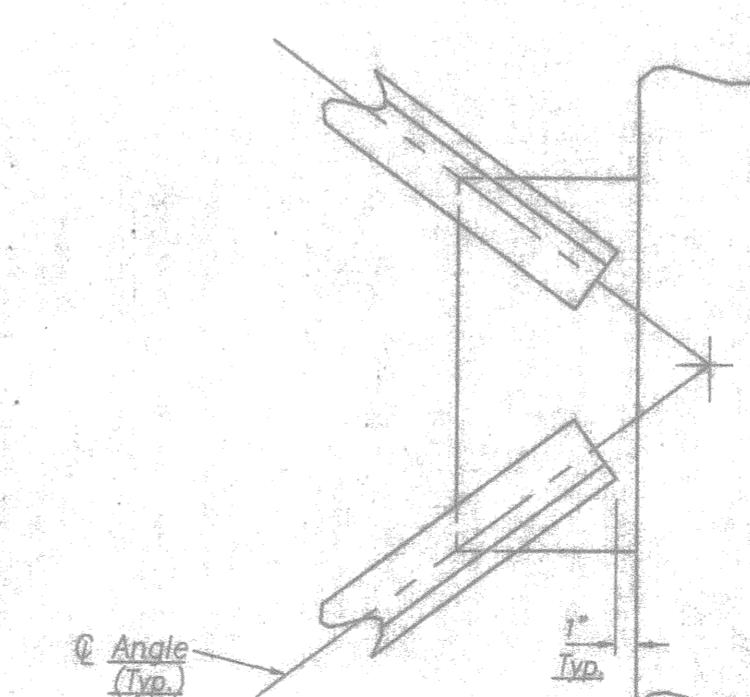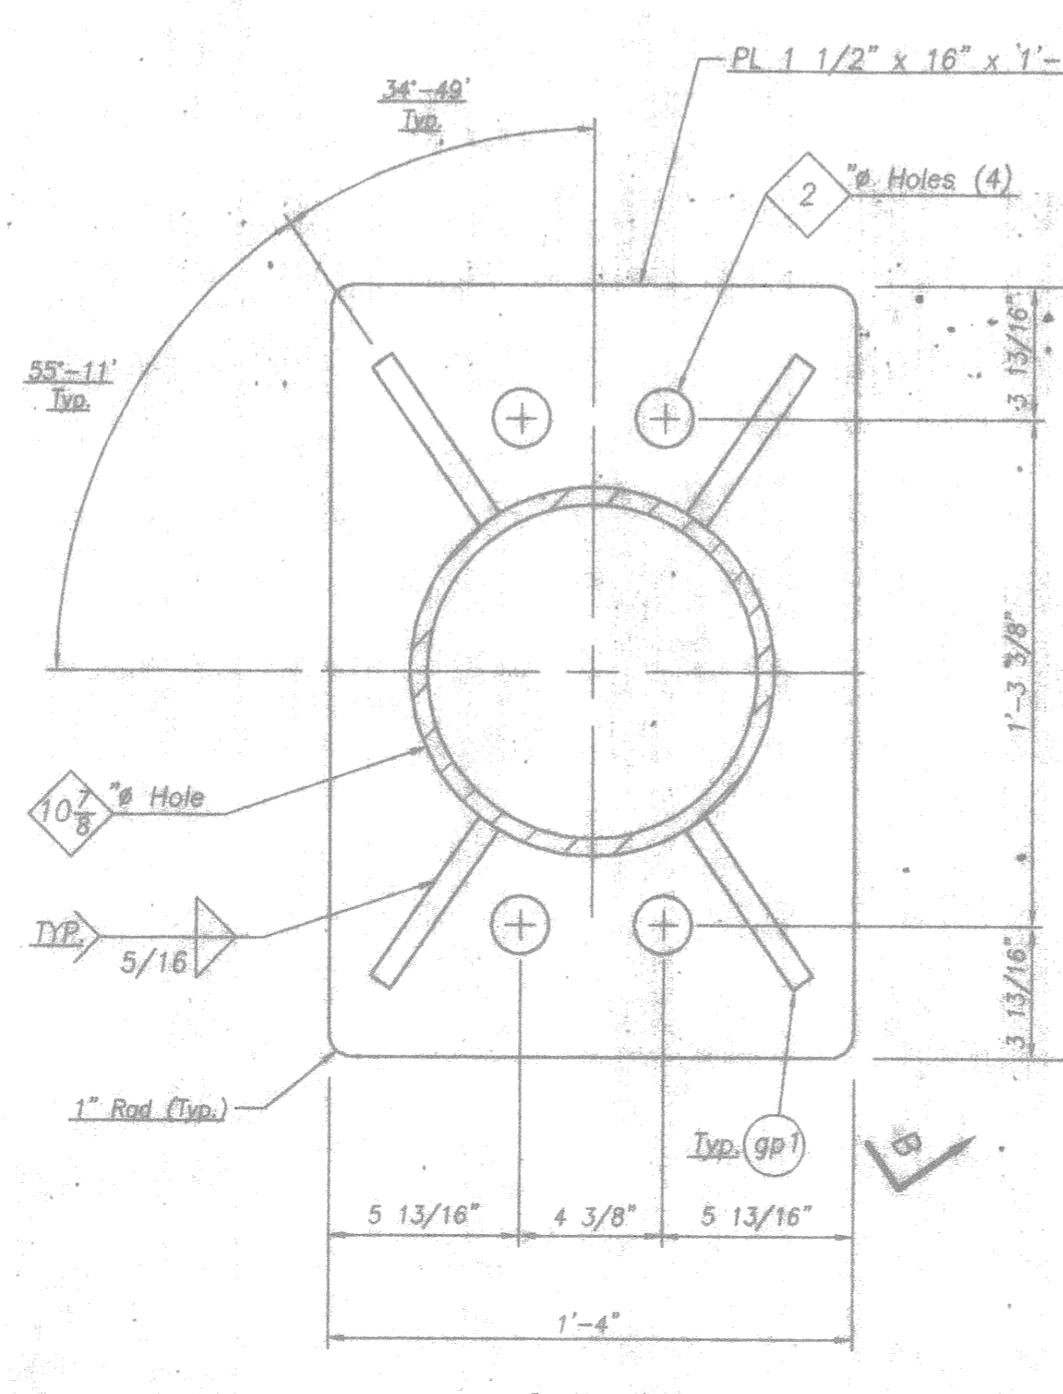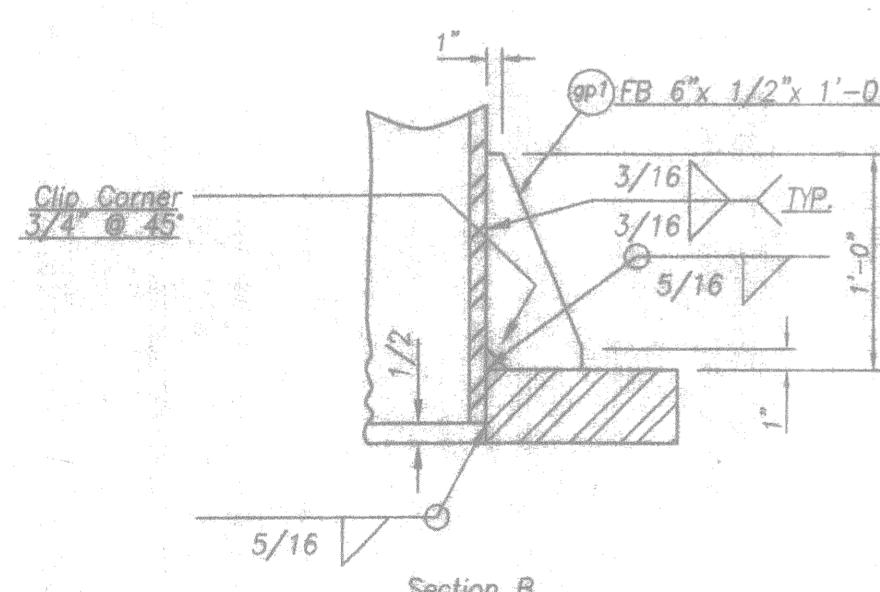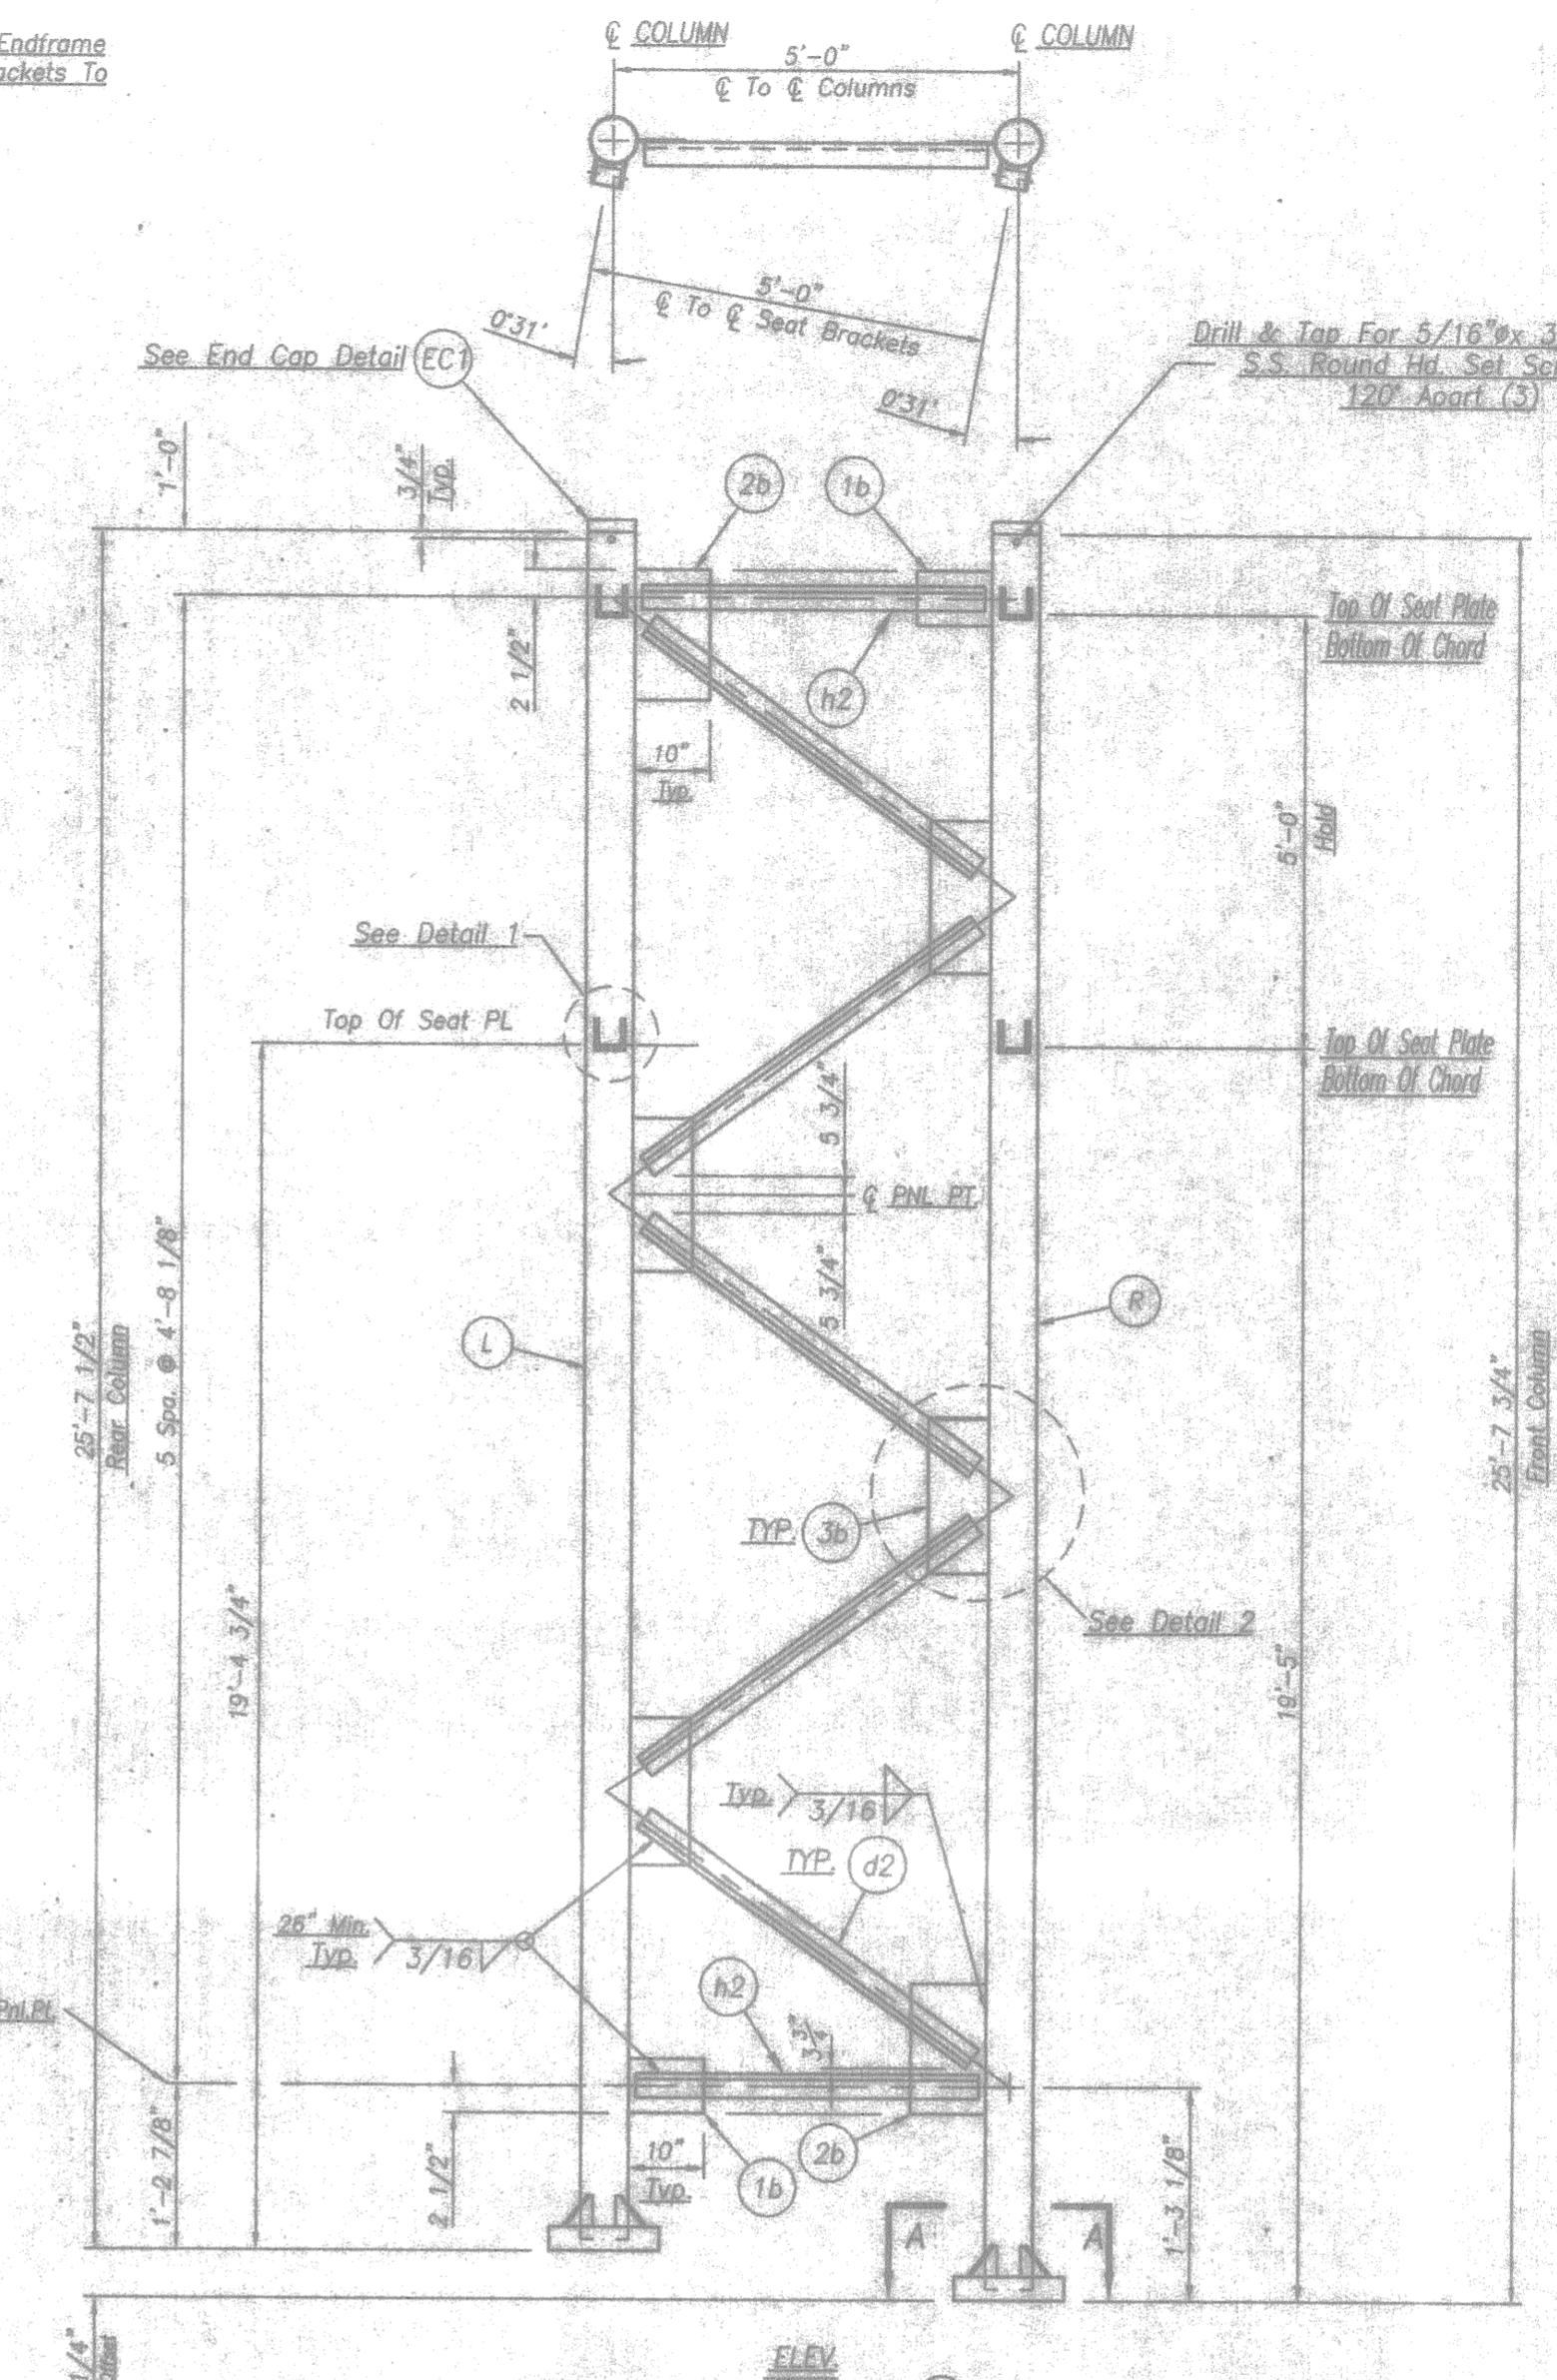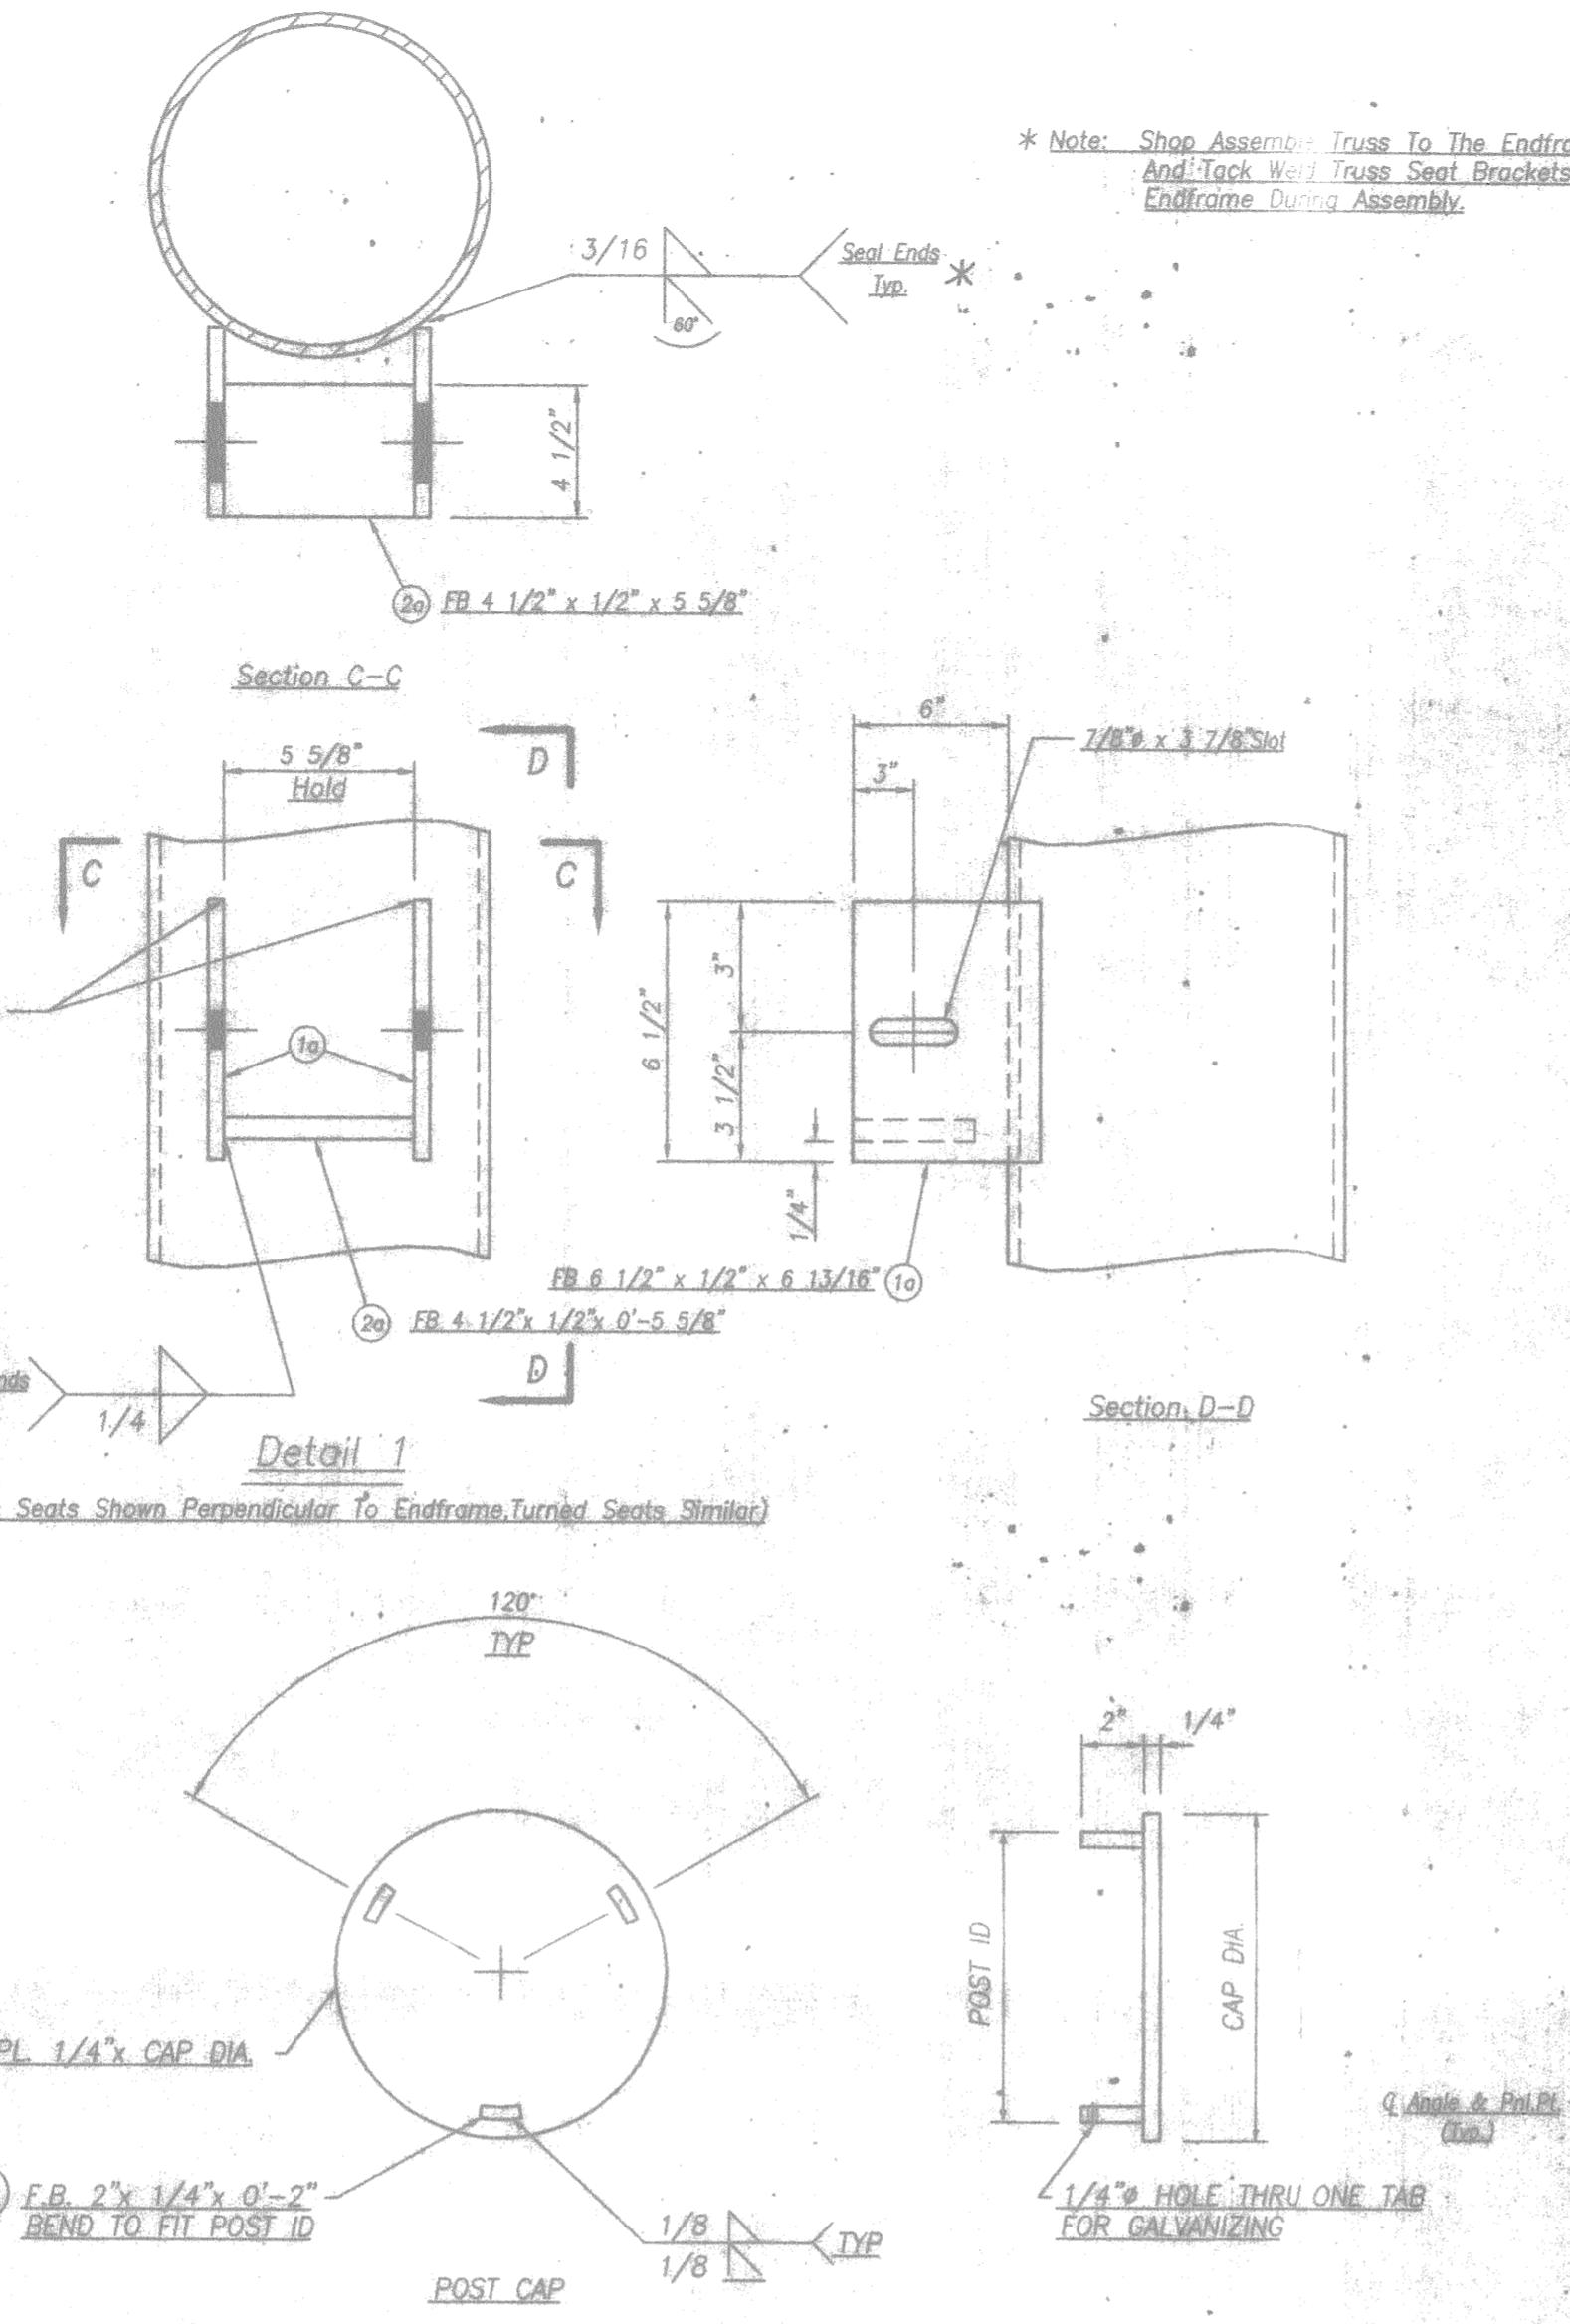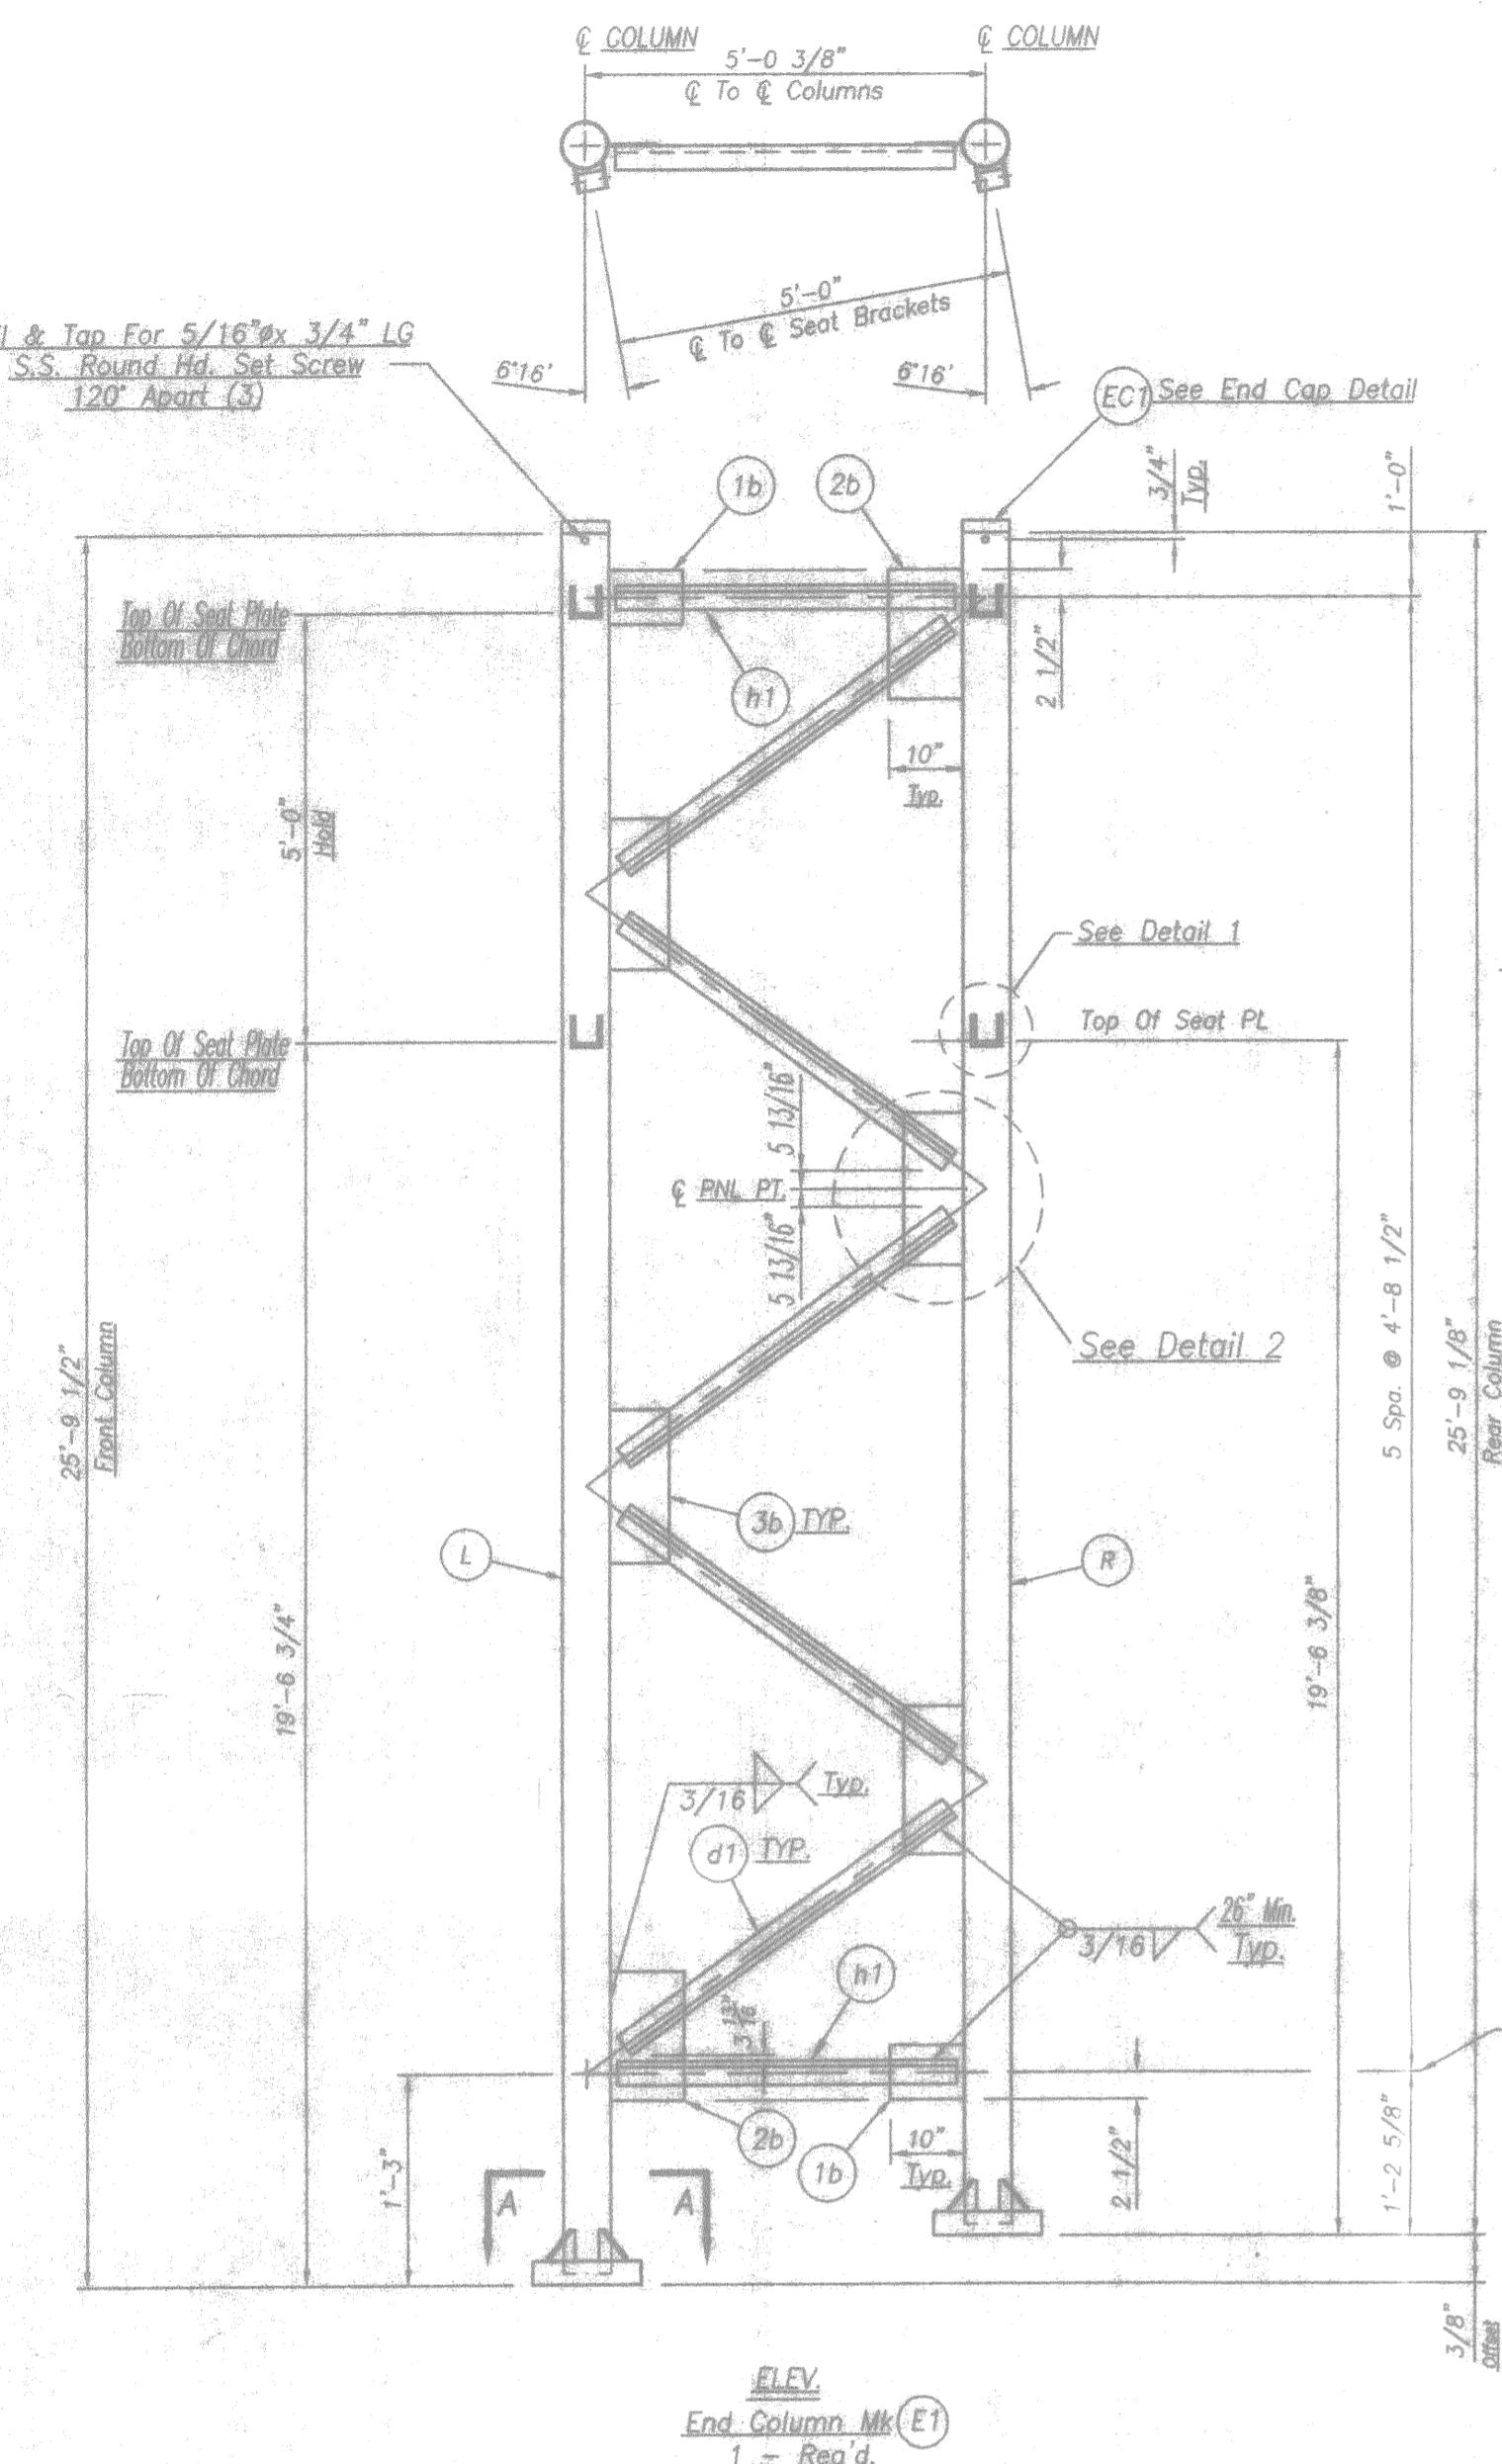

Material Specs:

Steel Pipe Shall Be API Spec 5L x 42 FY=42,000 P.S.I.

All Other Steel - A.S.T.M. A709, Gr.36







Galv. Steel Per A.S.T.M. A123

H.S. Hardware To Be A.S.T.M. A325

Galv. Step Per A.S.T.M. A153

BILL of MATERIAL

QTY.	MK	Description	Length	Remarks
1	E3L	10 3/4" O.D. x .365" W	25'-1 3/8"	
1	E3R	do	25'-1"	
1	E4L	do	25'-6"	
1	E4R	do	25'-6 1/4"	
5	d3	L 4" x 4" x 3/8"	5'-0 11/16"	
5	d2	do	5'-0 15/16"	
2	h3	do	3'-11 1/2"	
2	h2	do	3'-11 1/4"	
4	b1	PL 1 1/2" x 16"	1'-11"	
16	gp1	FB 6" 1/2"	1'-0"	
16	ta	FB 6 1/2" x 1/2"	0'-6 13/16"	
8	2a	FB 4 1/2" x 1/2"	0'-5 5/8"	
4	tb	PL 3 3/8" x 10"	1'-1"	
4	2b	do	2'-2"	
8	3b	do	2'-4"	
8	CB1	3/4" x 8" H.S. Hex Bolt & Nut W/2 Flat Wash.		

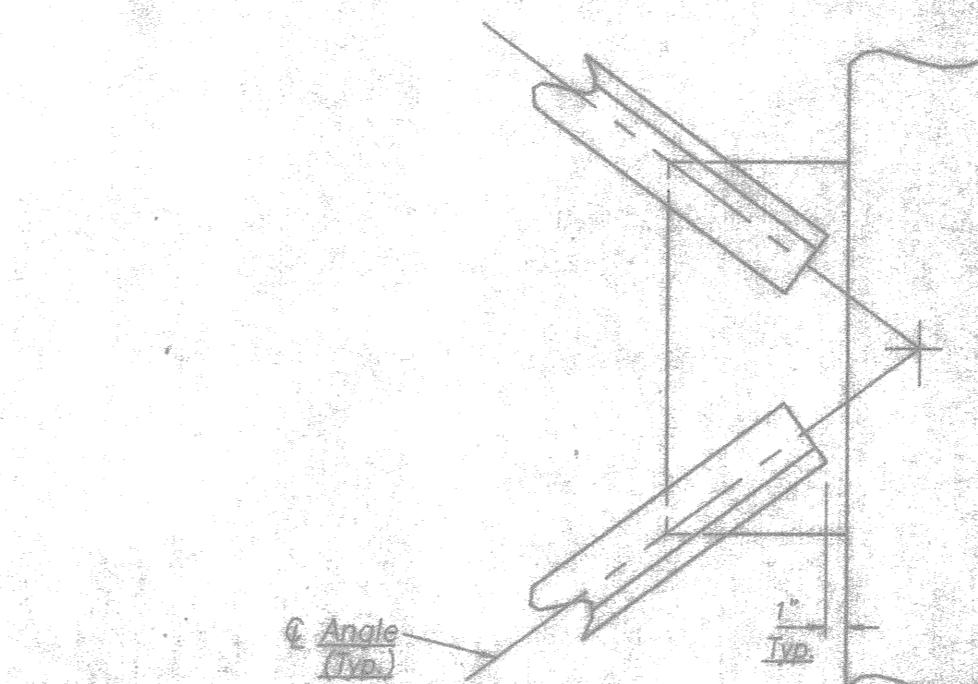
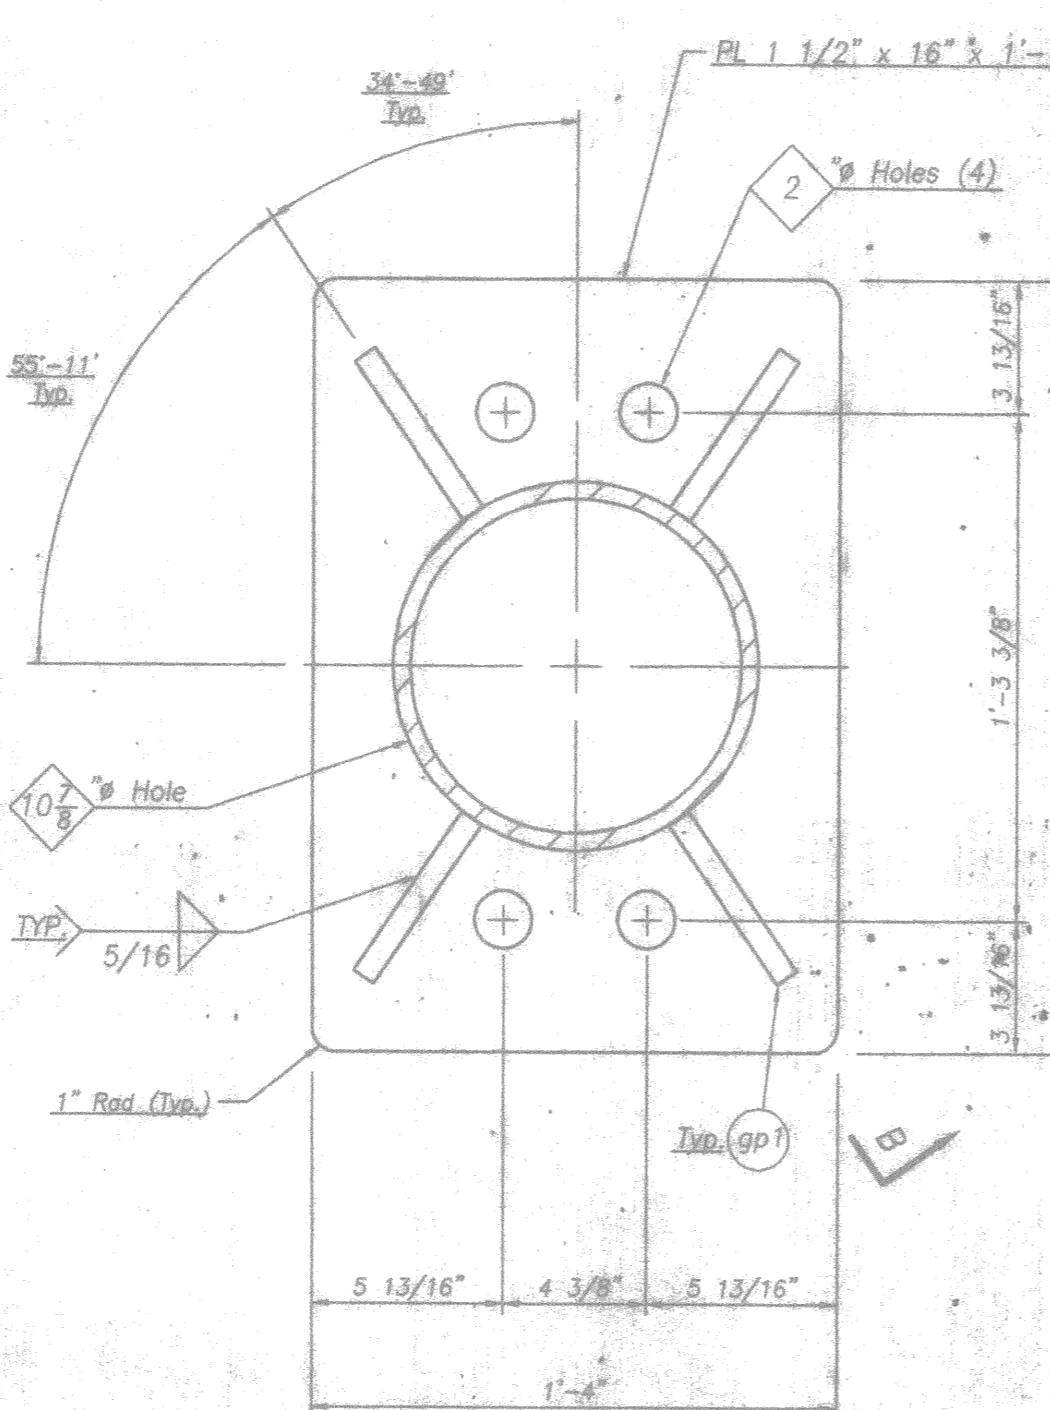
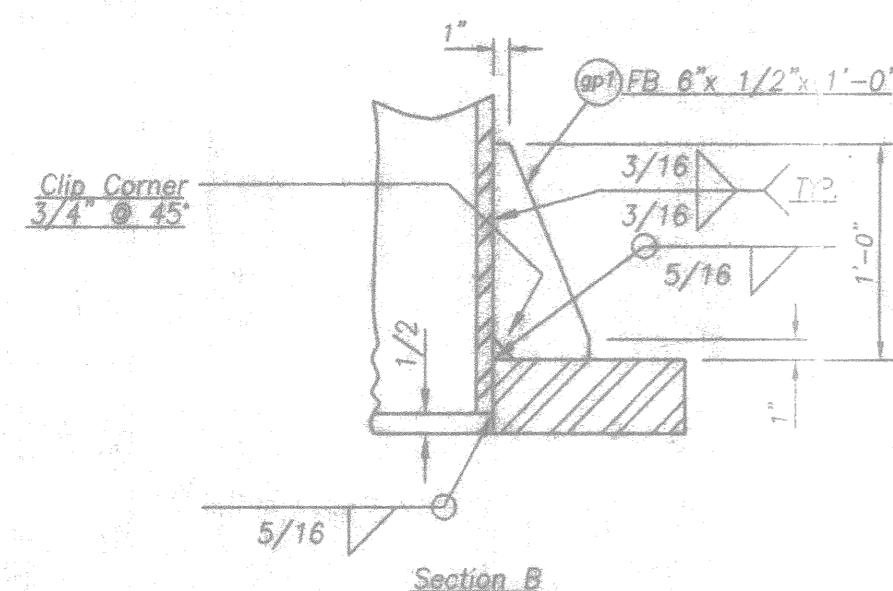
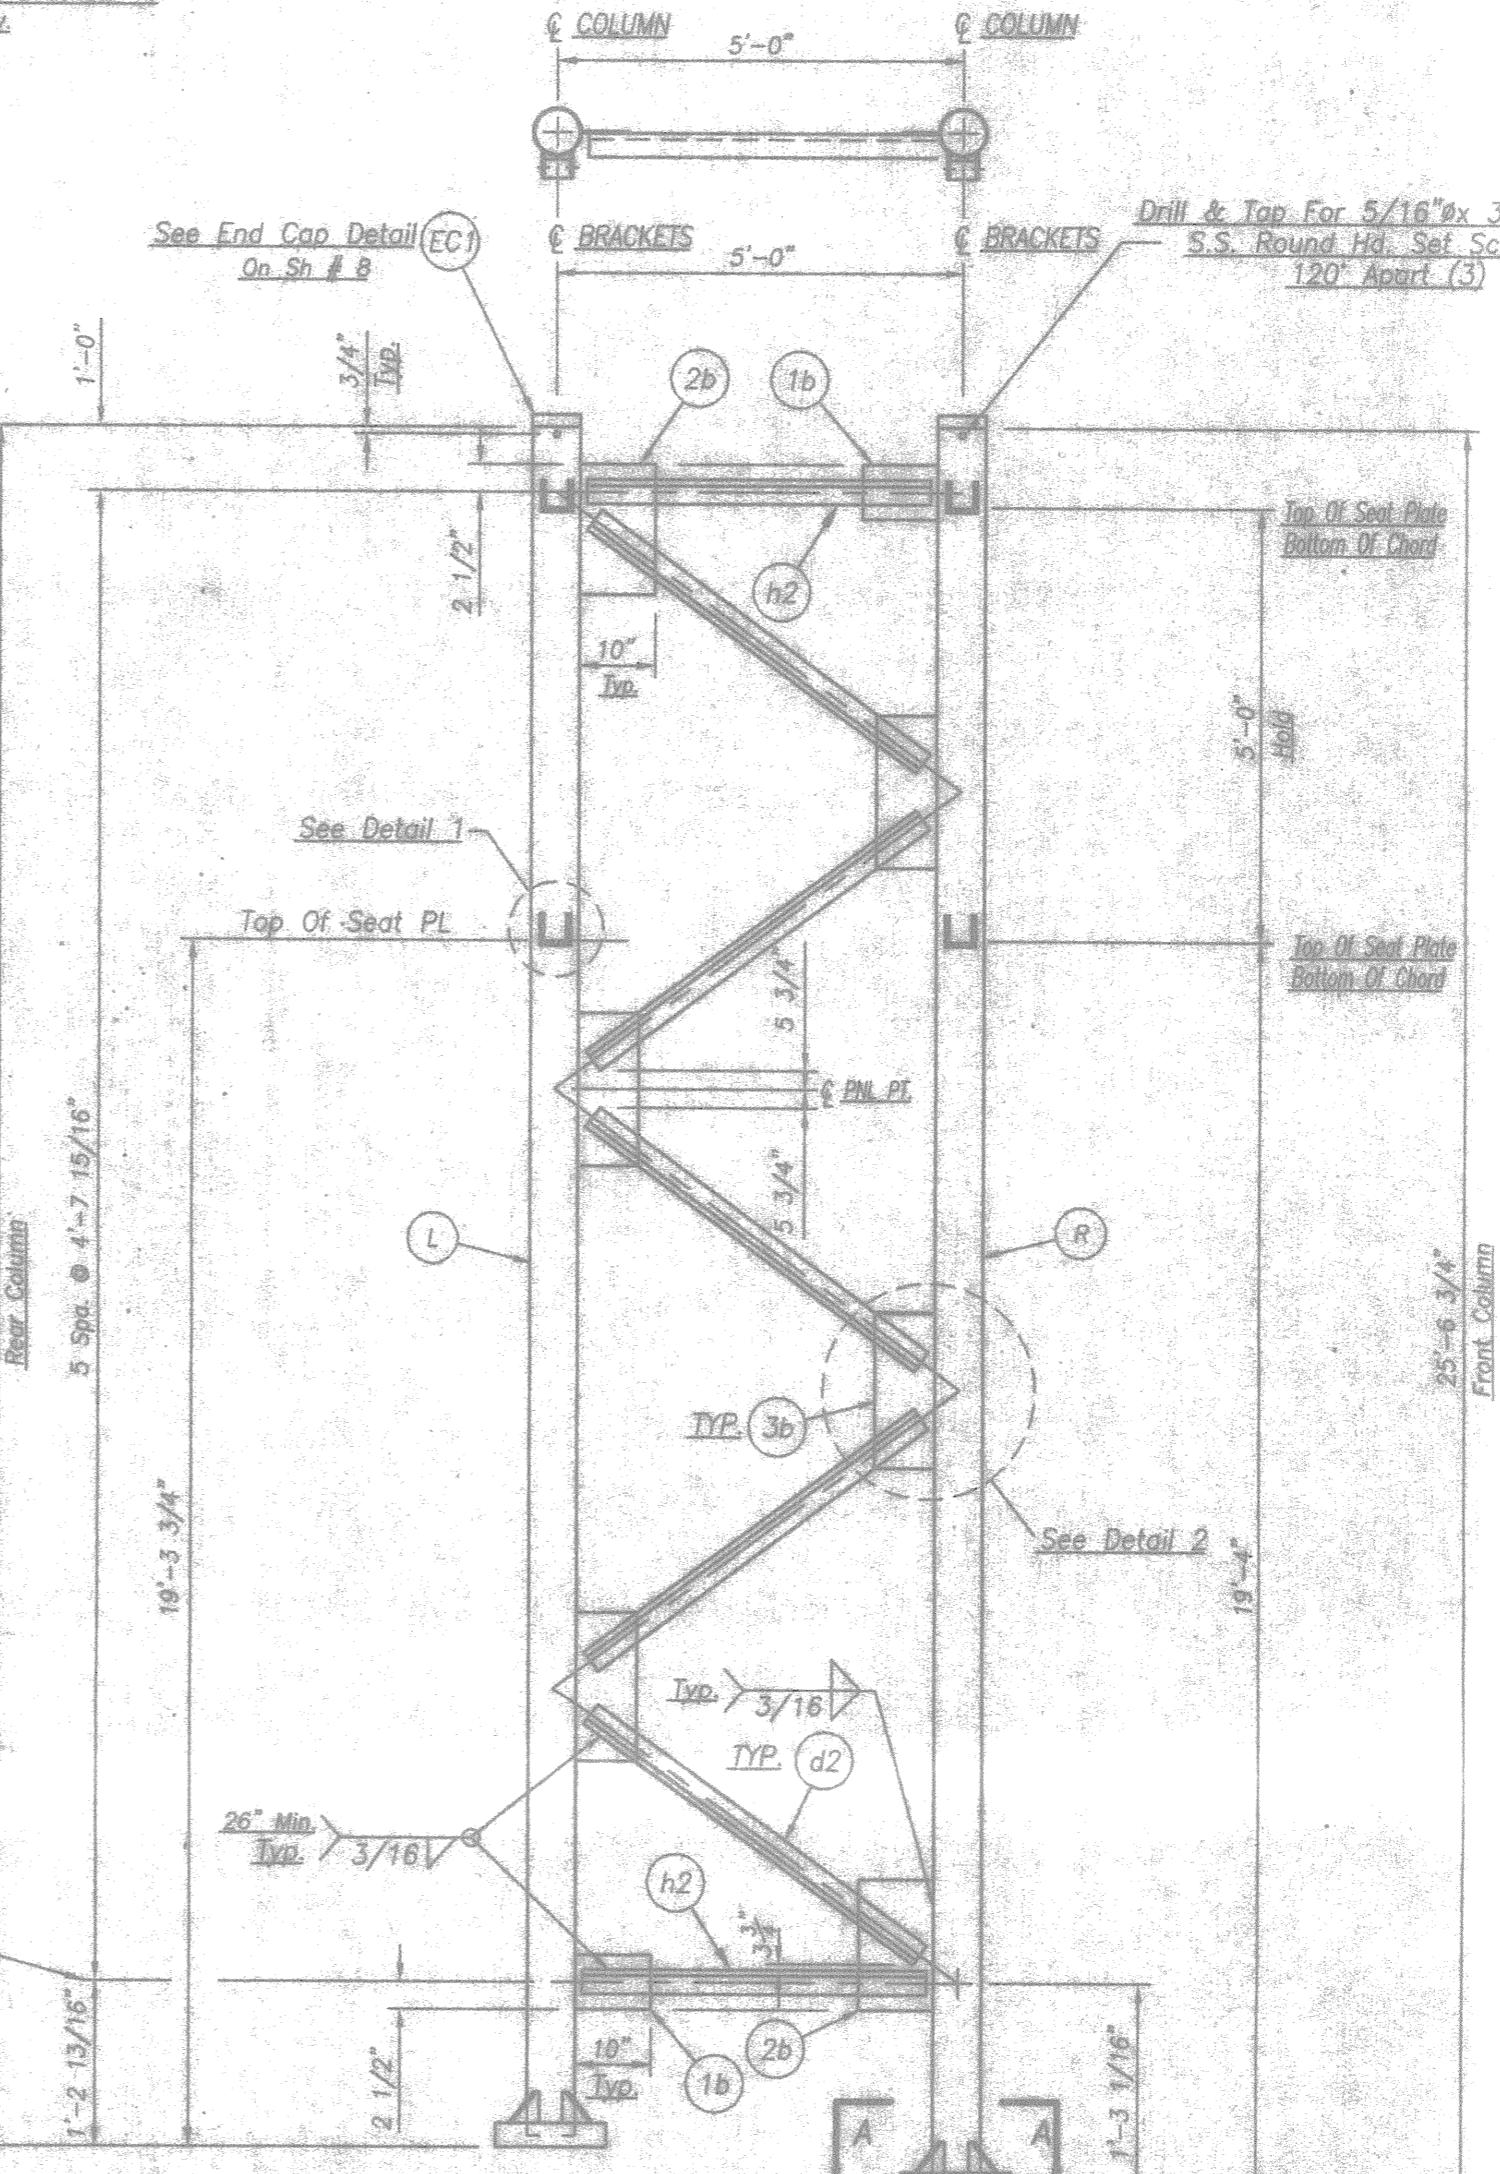
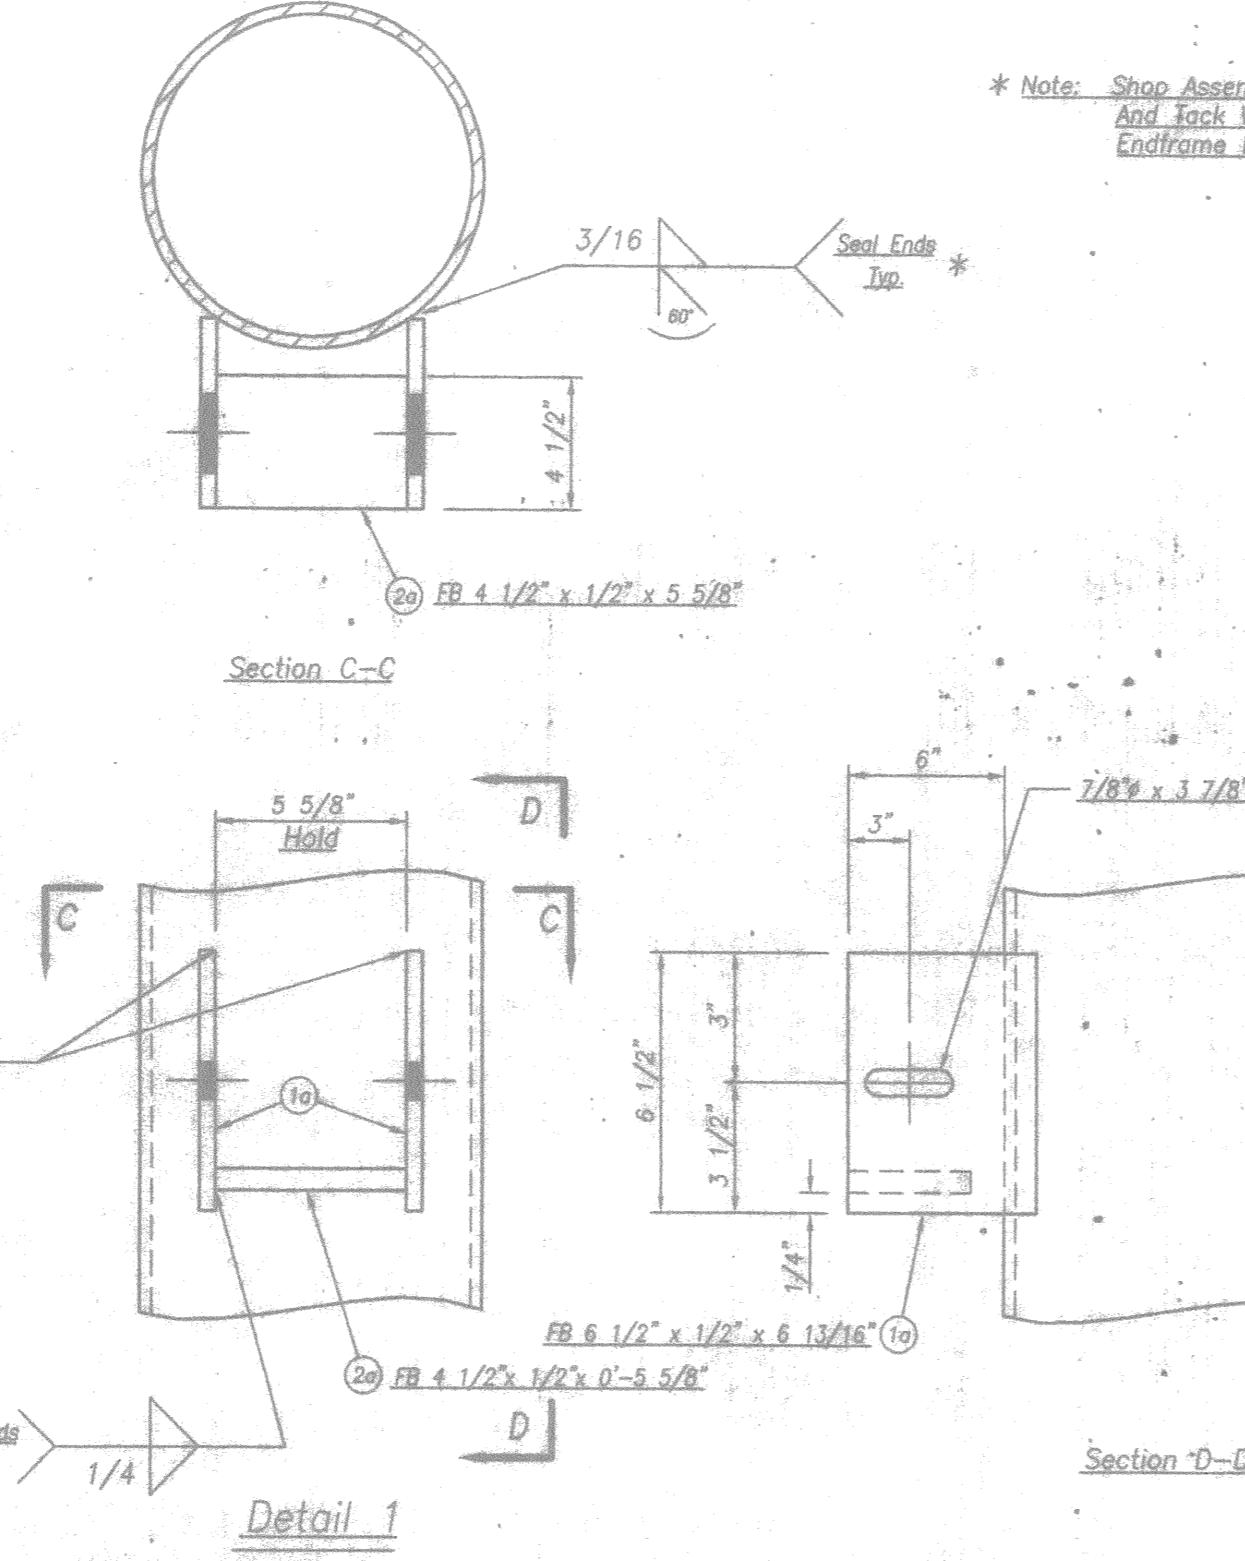
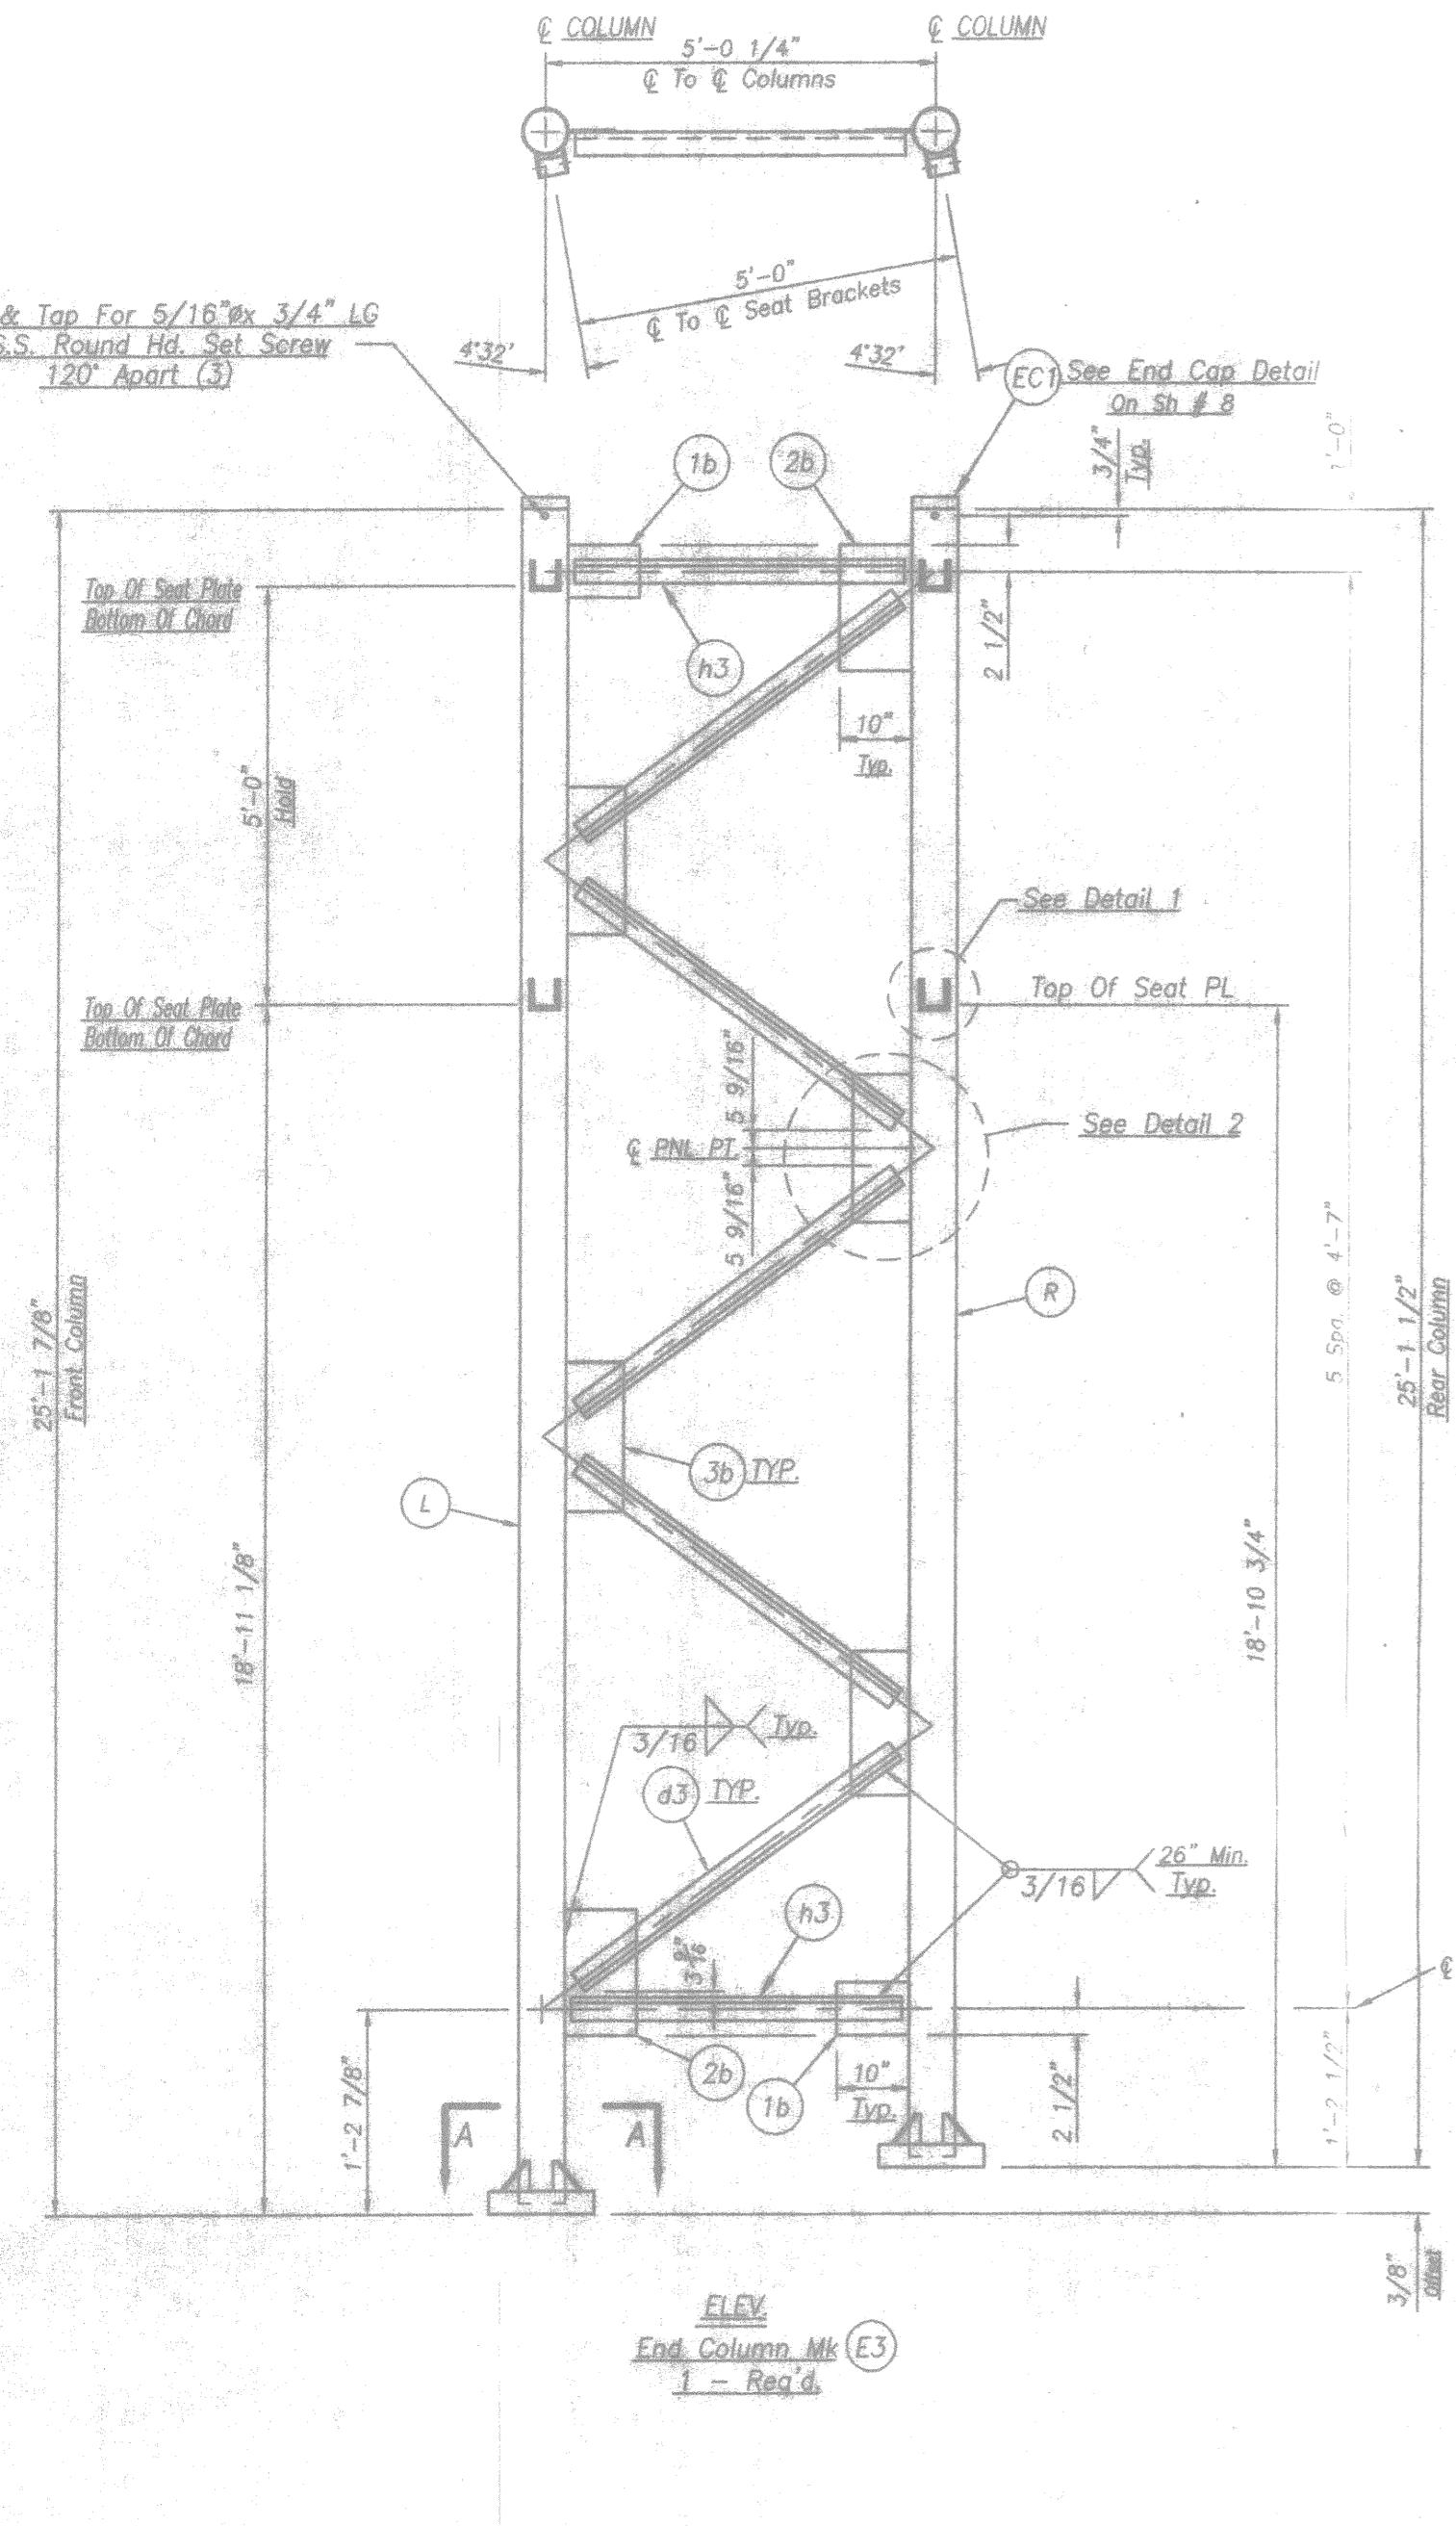


Material Specs:
 Steel Pipe Shall Be API Spec. SL x 42 FY=42,000 PSI.
 All Other Steel - A.S.T.M. A108, Gr. 36
 Galv. Steel Per A.S.T.M. A123
 H.S. Hardware To Be A.S.T.M. A325
 Galv. Steel Per A.S.T.M. A153


PRINTS ISSUED		REVISIONS	
FOR NO.	DATE	FOR NO.	DATE
Brookfield Fabricating Corp.			
P.O. Box 406 - Brookfield, Missouri 64626 - (660)258-2214			
Customer: Timme, Inc.			
Project: STPG 1996 (489) Mason Street City of Green Bay, WI			
Description: Fabrication Details Of End Columns For Str S-5-56			
Printed For: Wisconsin	Drawn By: JW	Date: 8/24/98	Checked By: C.R.
		Date: 9/3/98	Job No. W-6492

BILL of MATERIAL

QTY.	MK	Description	Length	Remarks
1	E5L	10 3/4" O.D. x .365" W	25'-4 1/2"	
1	E5R	do	25'-5"	
1	E6L	do	25'-10 5/8"	
1	E6R	do	25'-10 1/8"	
5	d2	L 4"x 4"x 3/8"	5'-0 15/16"	
5	d6	do	5'-2 1/8"	
2	h3	do	3'-11 1/2"	
2	h6	do	4'-0 1/8"	
4	b1	PL 1 1/2" x 16"	1'-11"	
16	gp1	FB 6"x 1/2"	1'-0"	
16	1a	FB 6 1/2" x 1/2"	0'-6 13/16"	
8	2a	FB 4 1/2" x 1/2"	0'-5 5/8"	
4	1b	PL 3/8"x 10"	1'-1"	
4	2b	do	2'-2"	
8	3b	do	2'-4"	
8	CB1	3/4" x 8" H.S. Hex Bolt & Nut w/2 Flat Wa.		

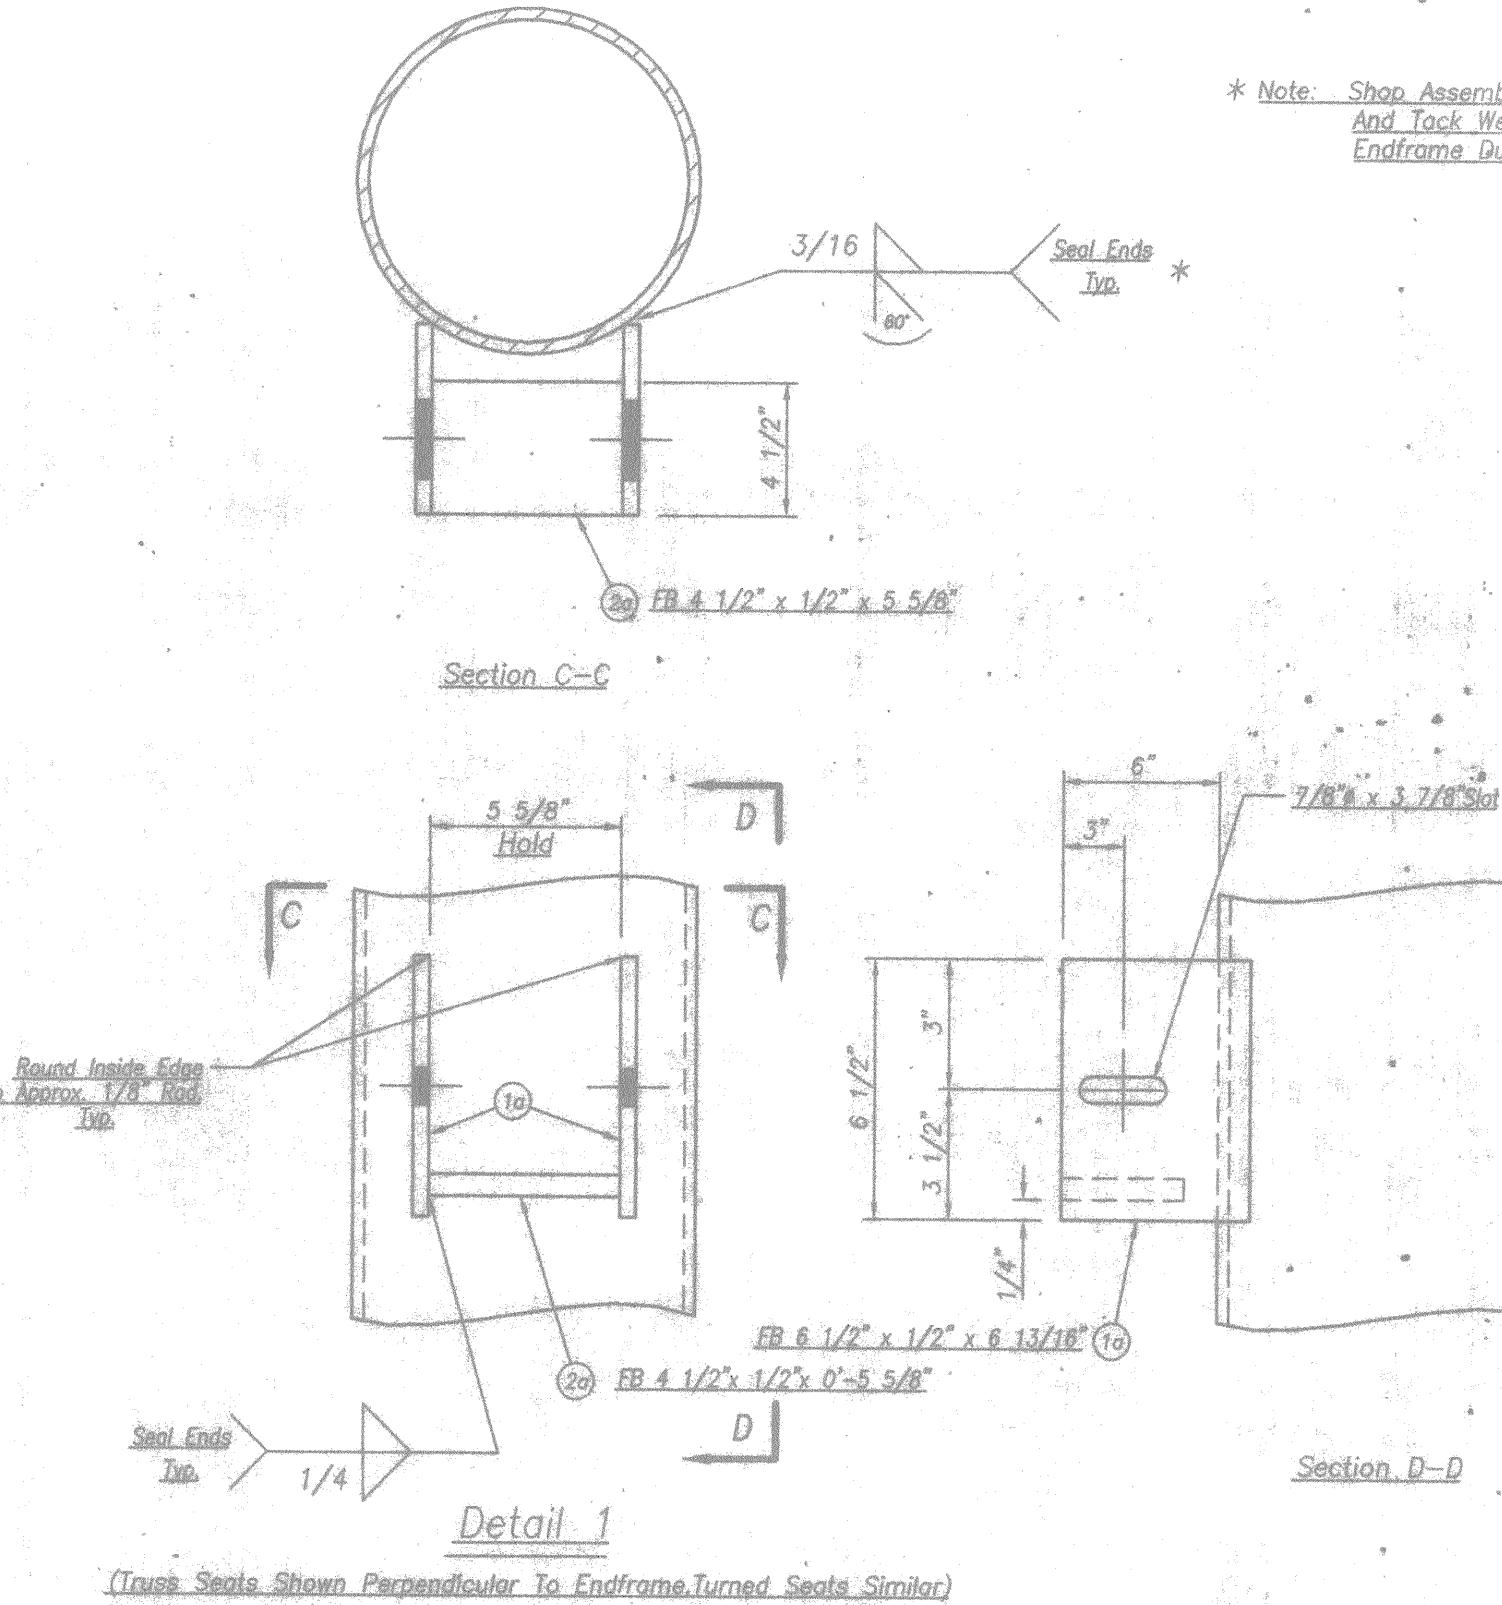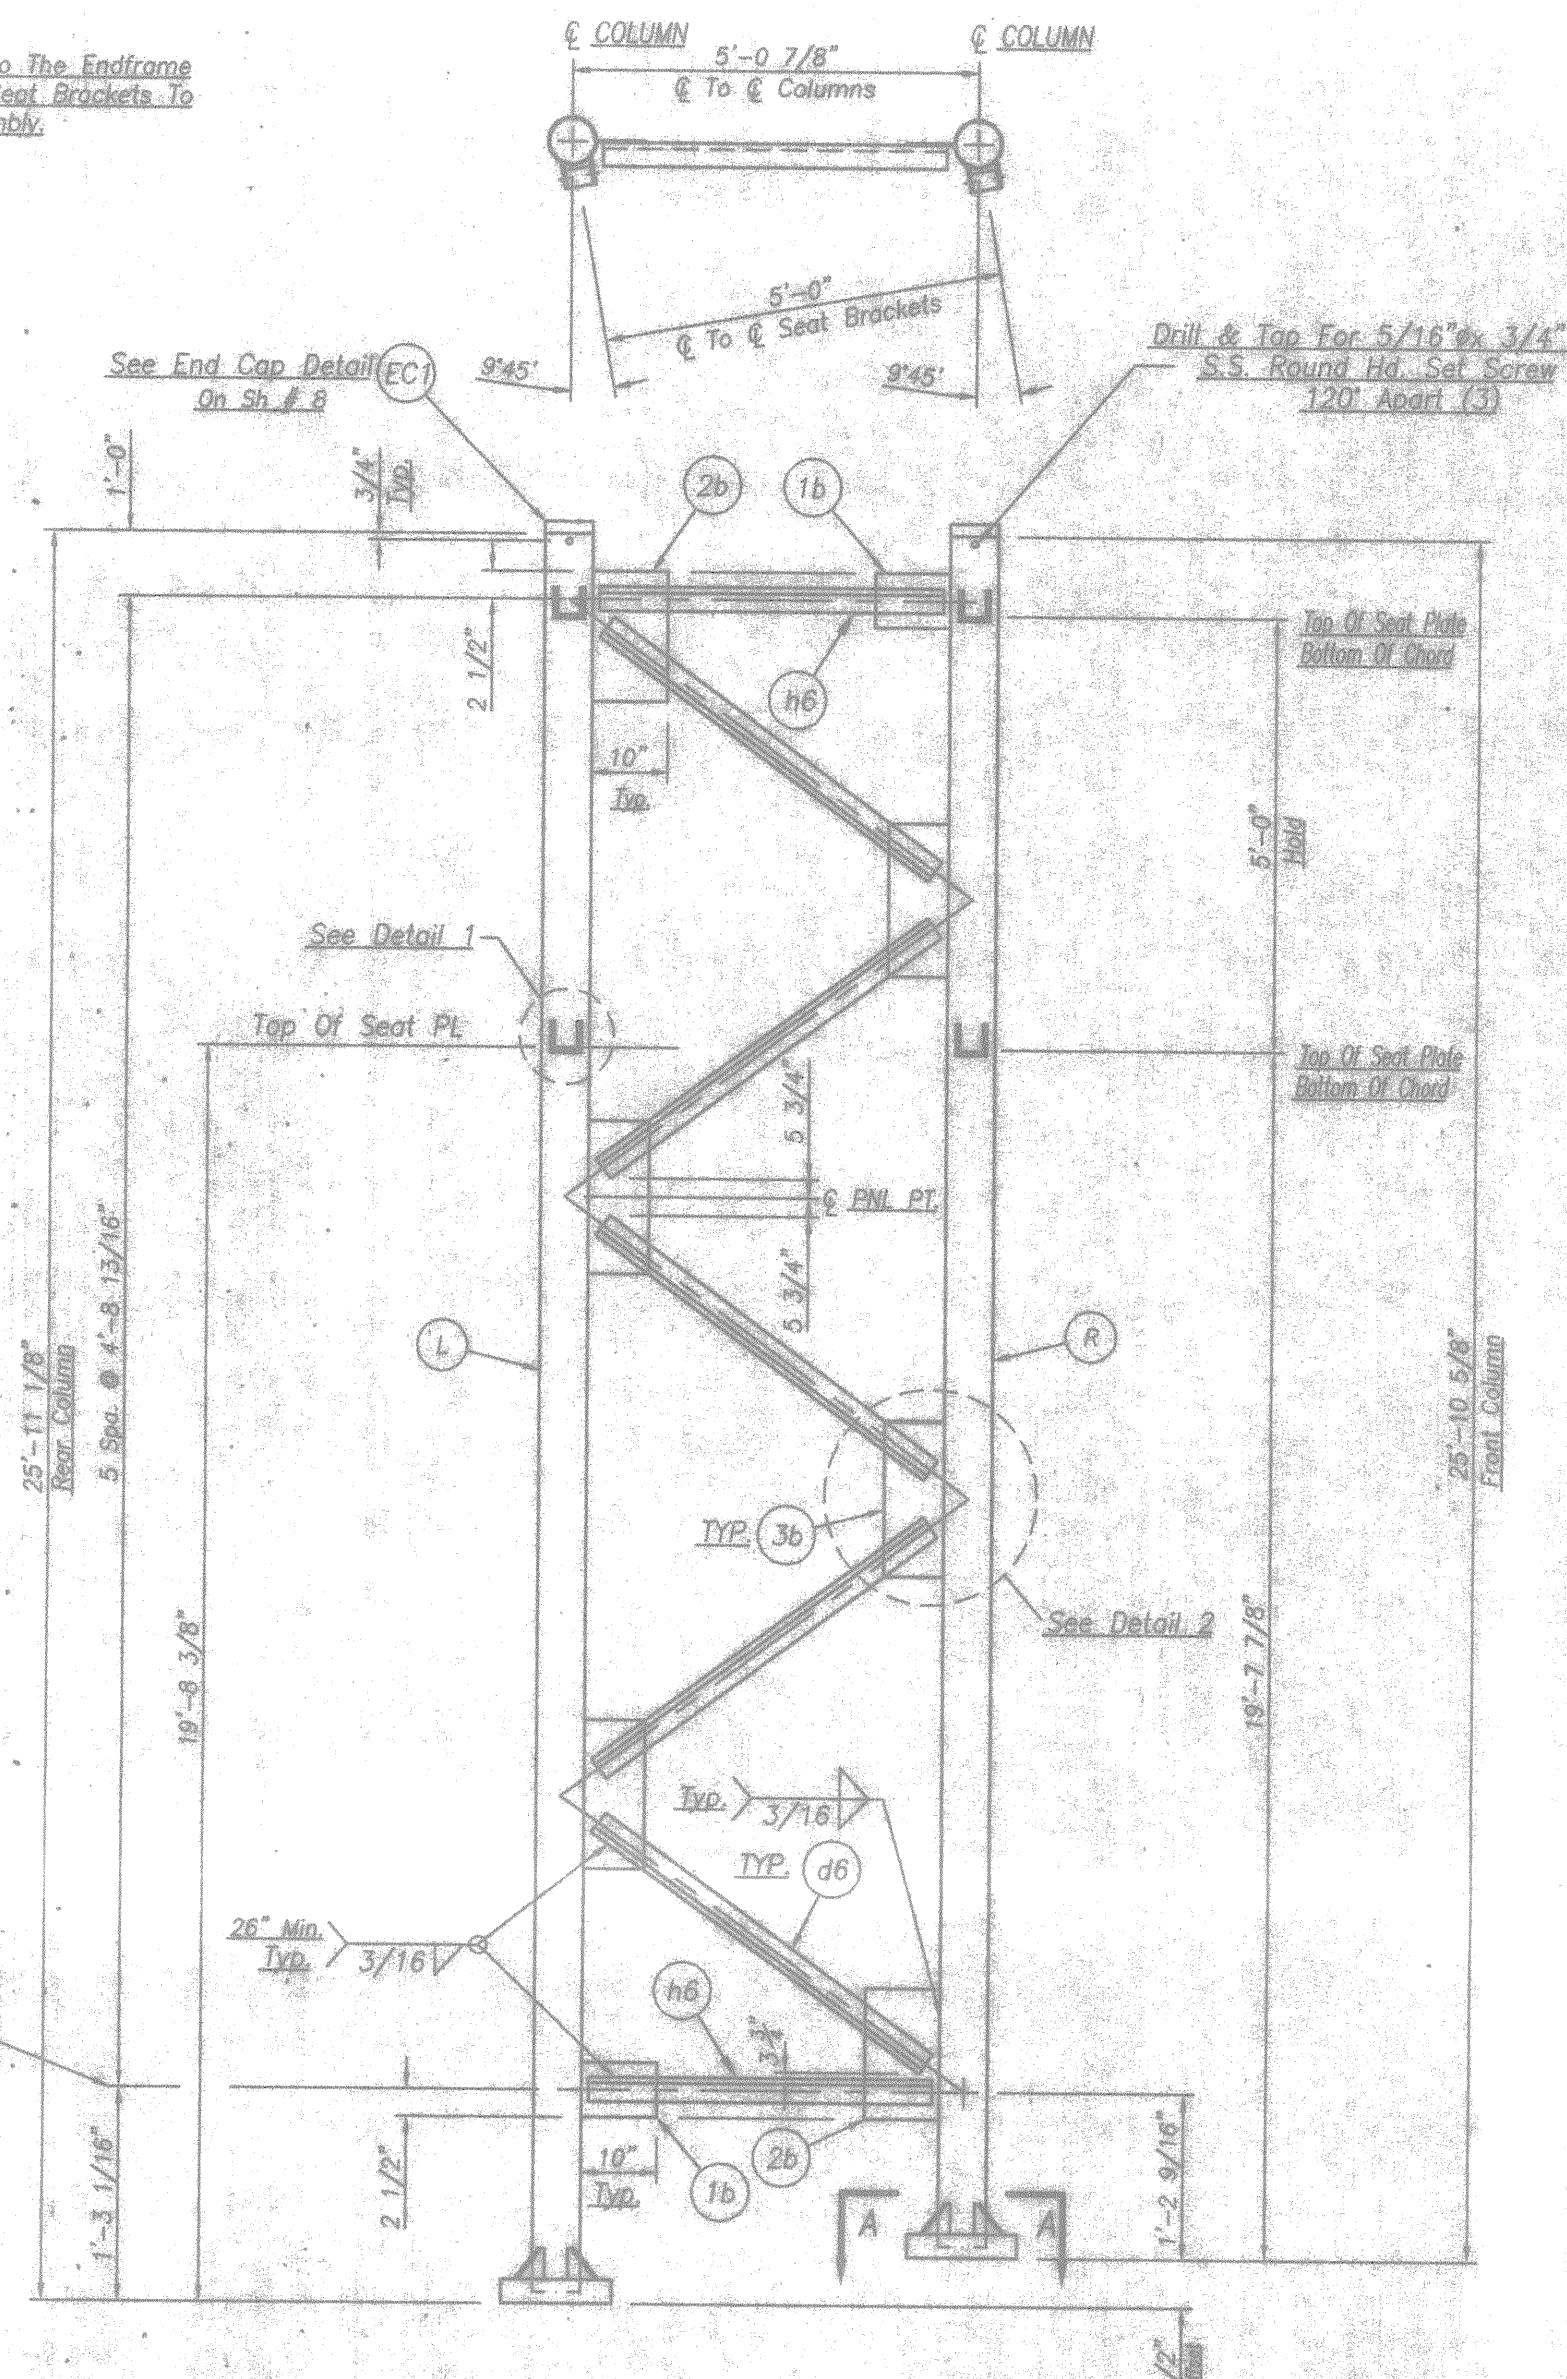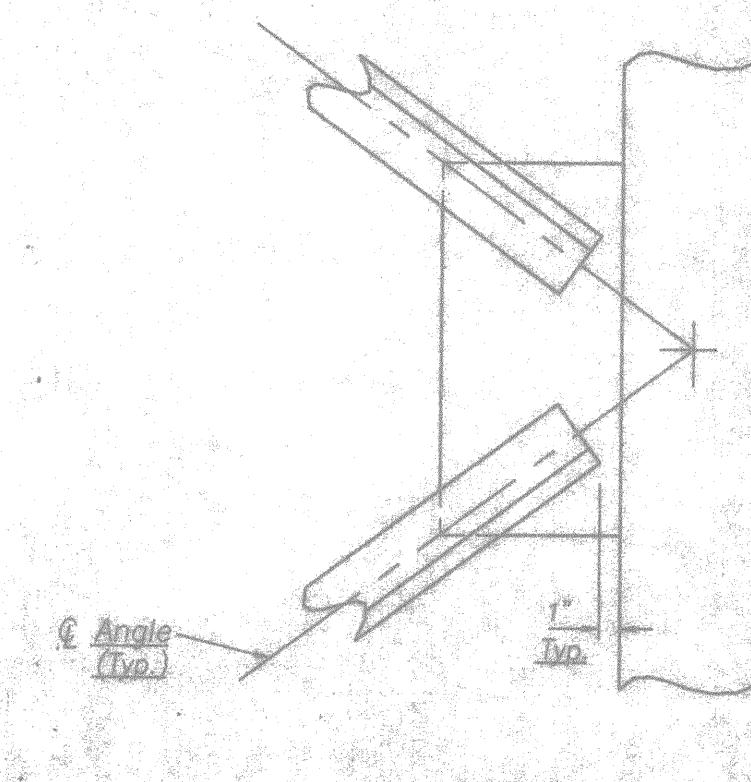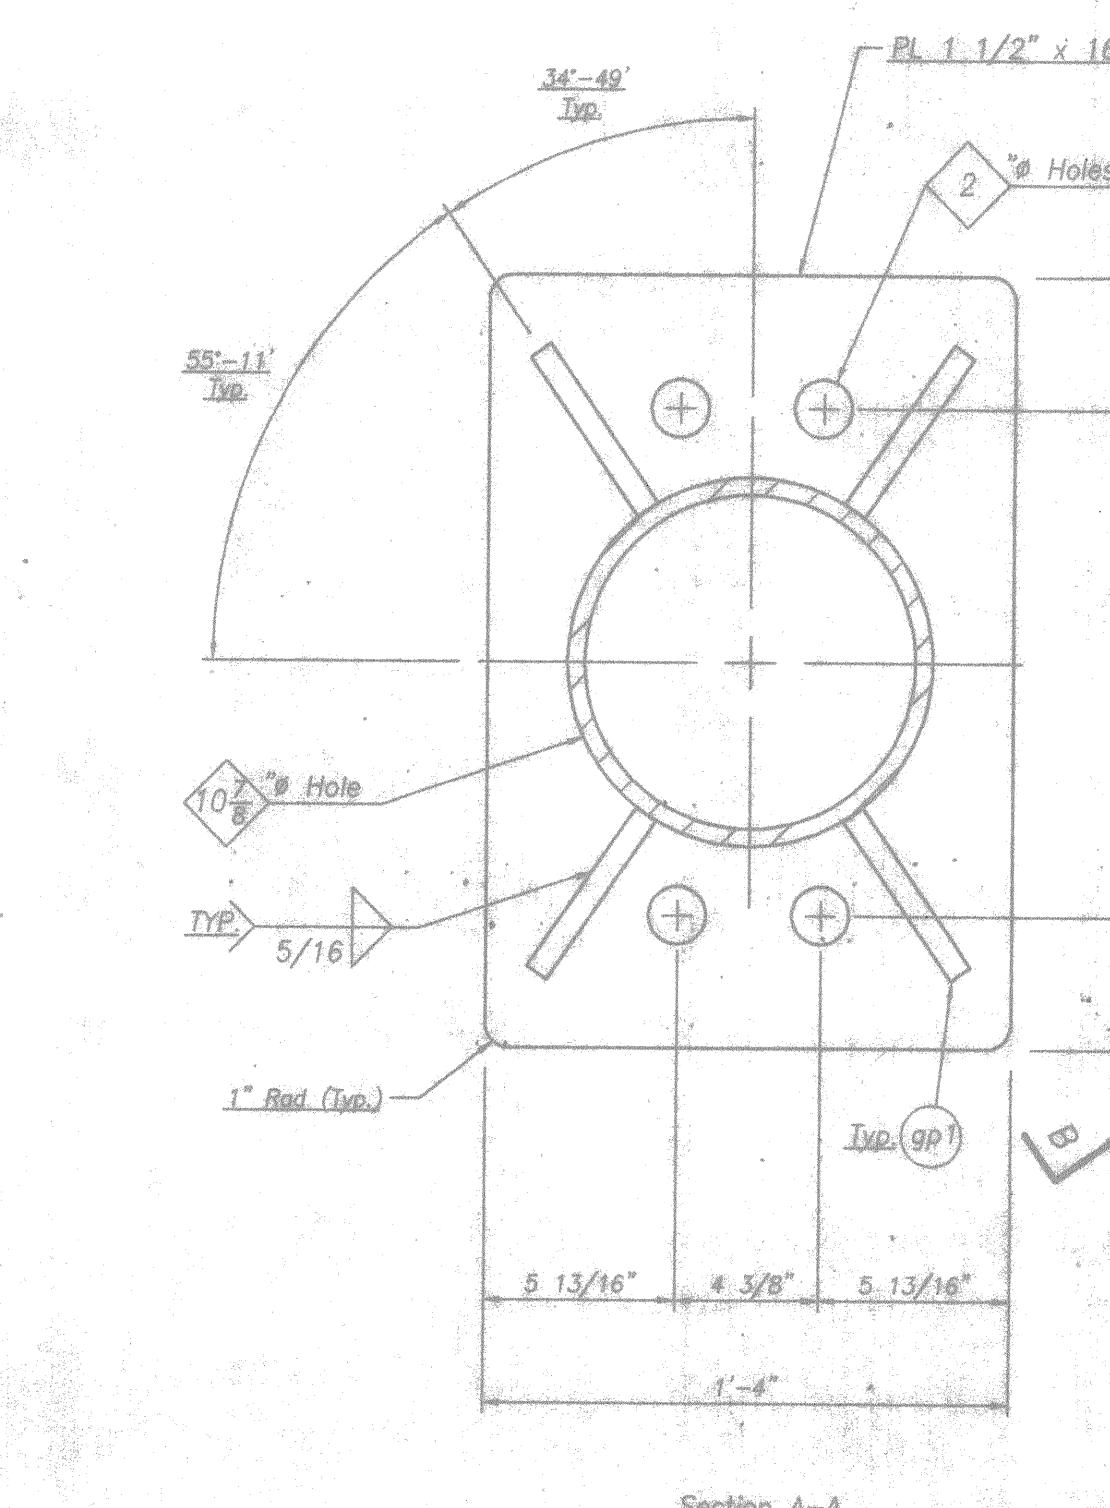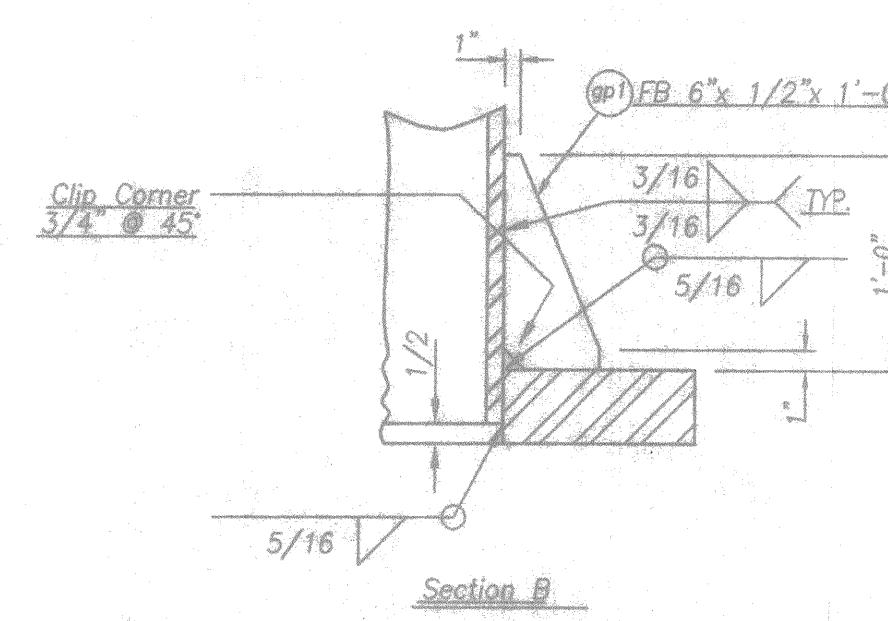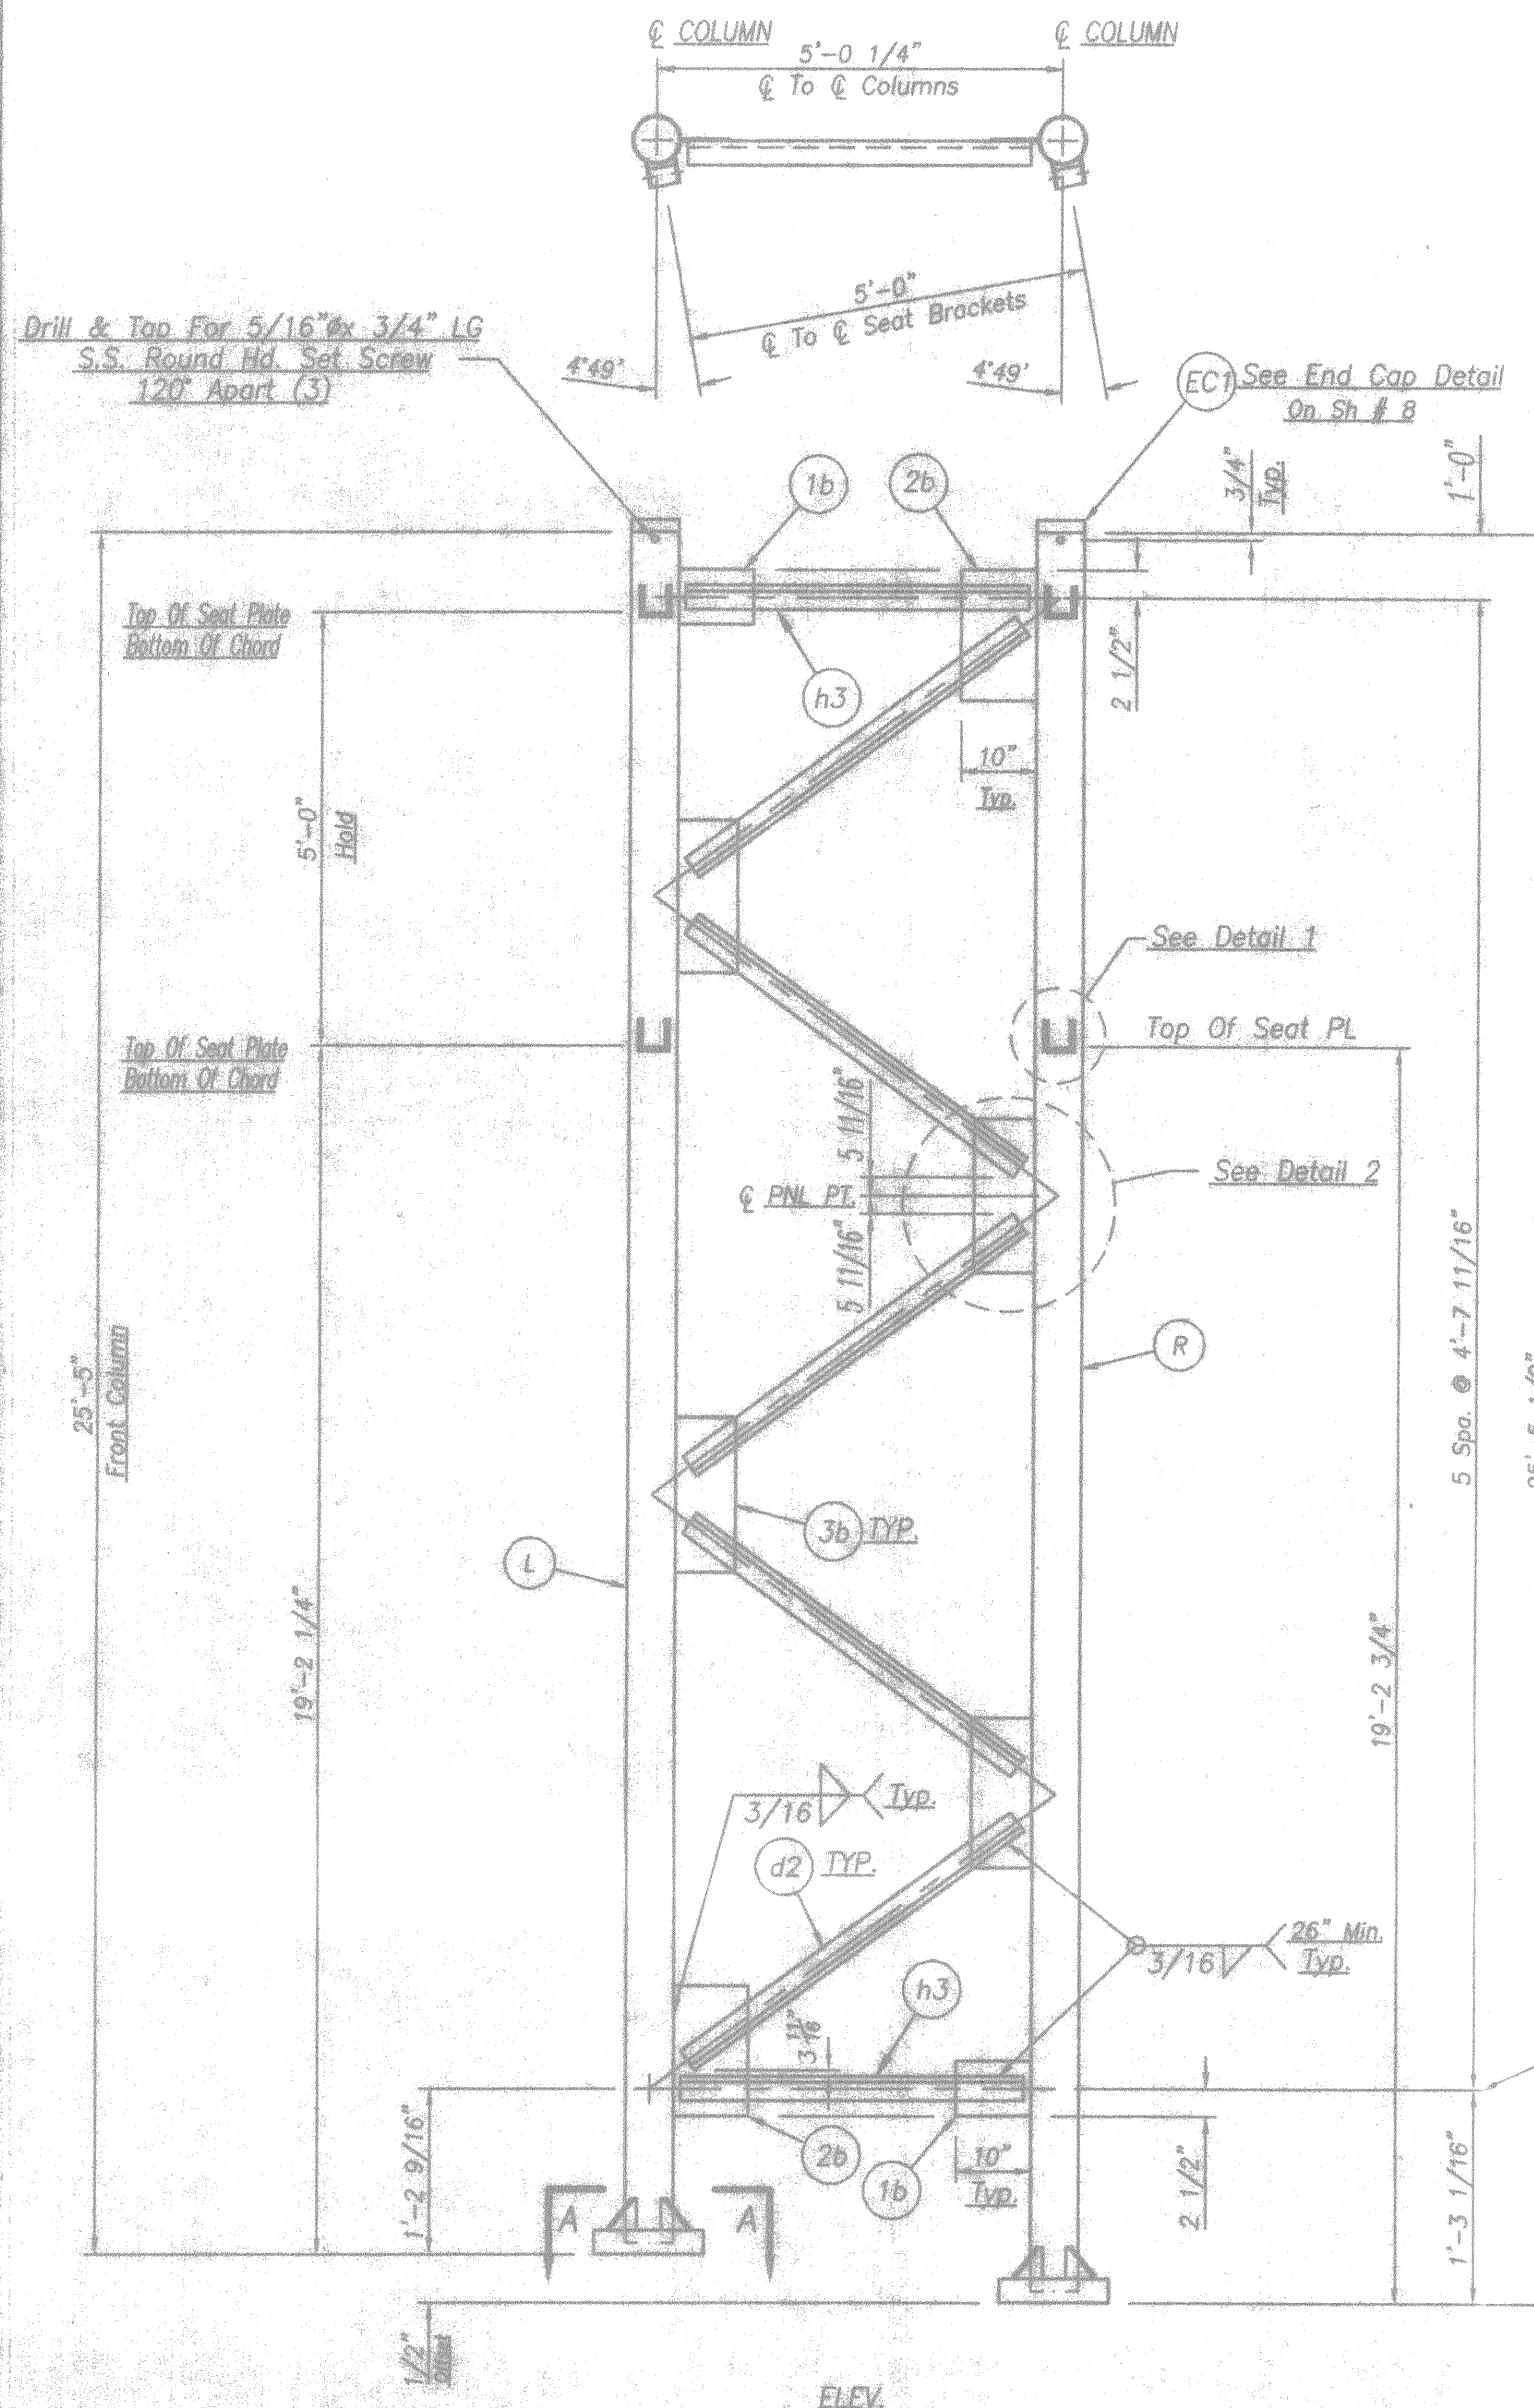


* Note: Shop Assemble Truss To The Endframe
And Tack Weld Truss Seat Brackets To
Endframe During Assembly.

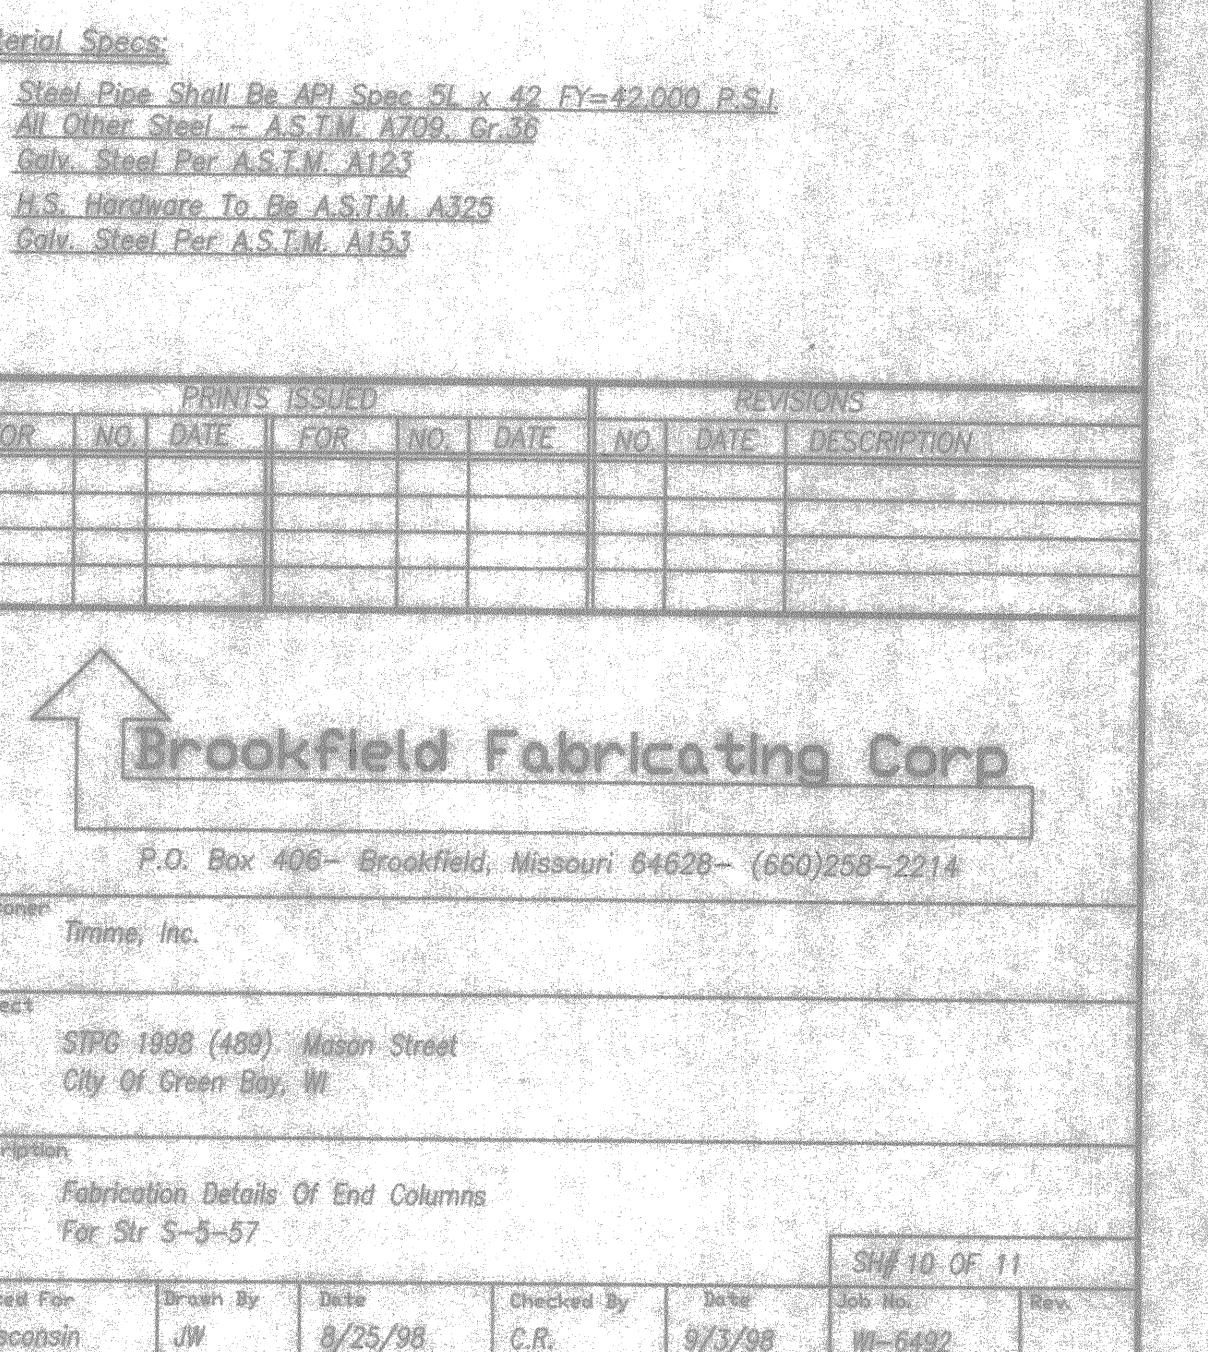


BILL of MATERIAL



QTY.	MK	Description	Length	Remarks
1	E7L	10 3/4" O.D. x 365" W	25'-6 1/2"	
1	E7R	do	25'-7"	
1	EBL	do	25'-10 1/4"	
1	EZR	do	25'-9 3/8"	
5	d2	L 4"x 4" x 3/8"	5'-0 15/16"	
5	d1	do	5'-1 1/2"	
2	h2	do	3'-11 1/4"	
2	h1	do	3'-11 5/8"	
4	b1	PL 1 1/2" x 16"	1'-11"	
16	gp1	FB 6"x 1/2"	1'-0"	
16	ta	FB 6-1/2" x 1/2"	0'-6 13/16"	
8	2a	FB 4 1/2"x 1/2"	0'-5 3/8"	
4	1b	PL 3/8"x 10"	1'-4"	
4	2b	do	21-2"	
8	3b	do	2'-4"	
8	CB1	3/4"x 8" H.S. Hex Bolt & Nut w/2 Flat Wa.		

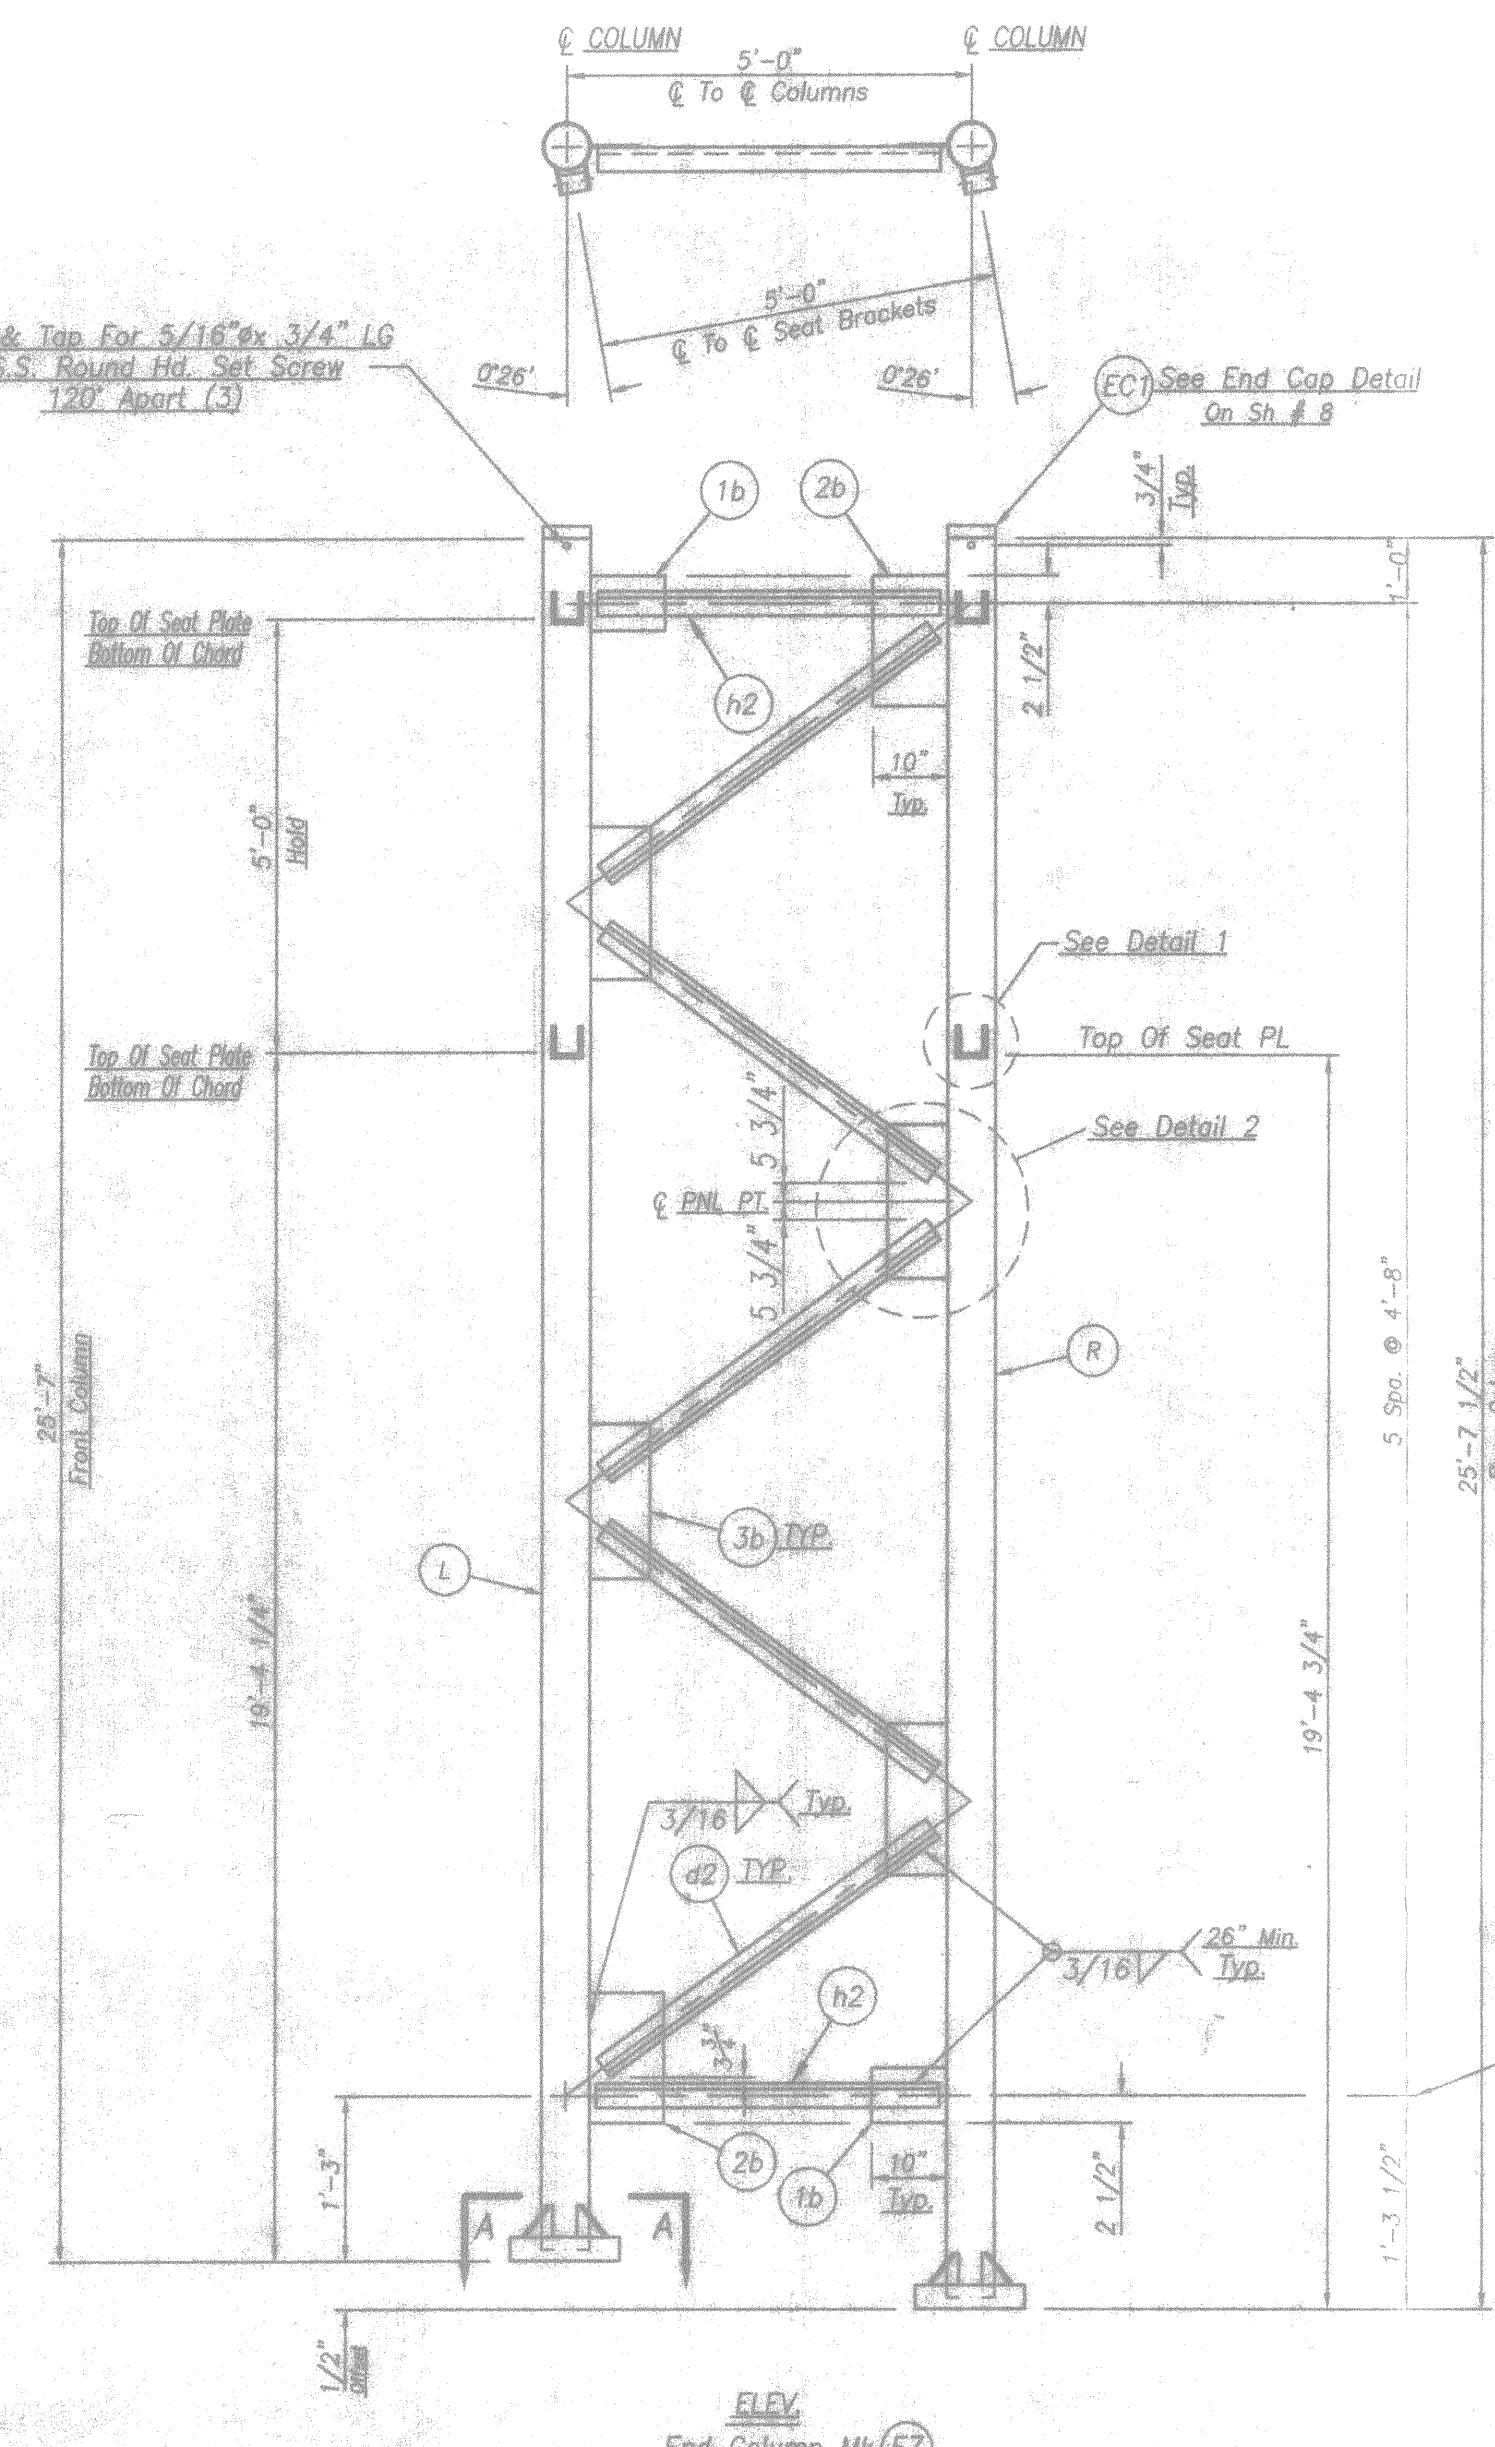

ELEV
End Column Mk (E7)
1 - Req'd.

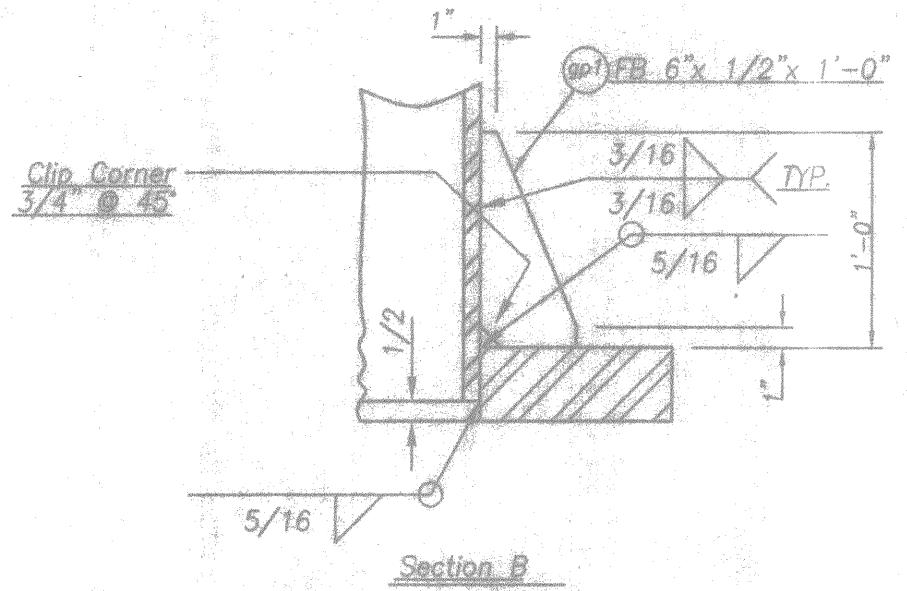


Section B

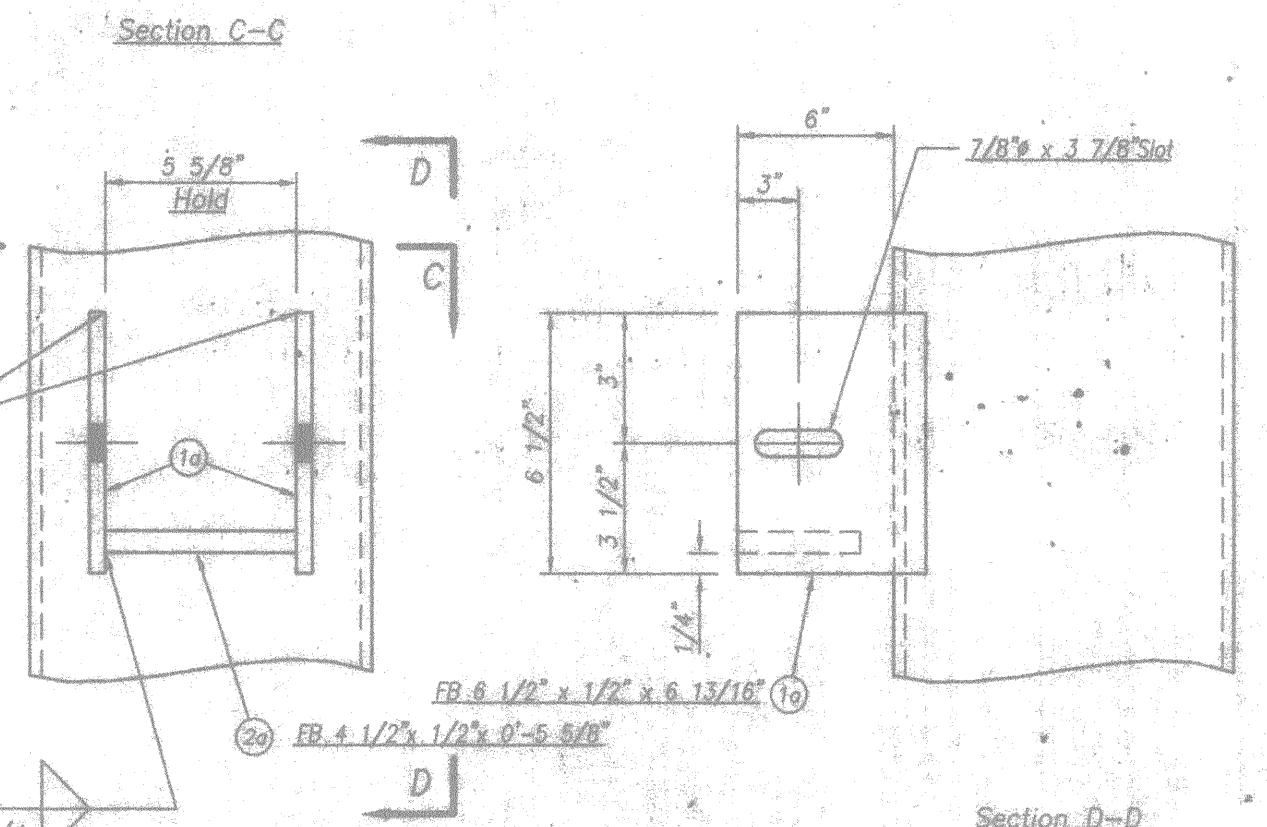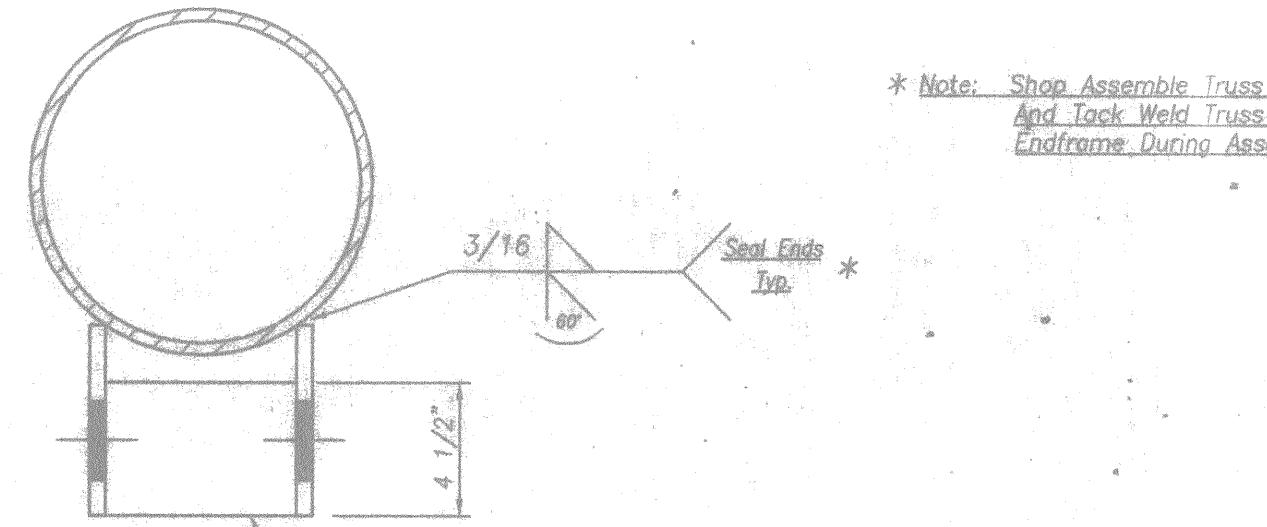


Detail 1


(Truss Seats Shown Perpendicular To Endframe, Turned Seats Similar.)

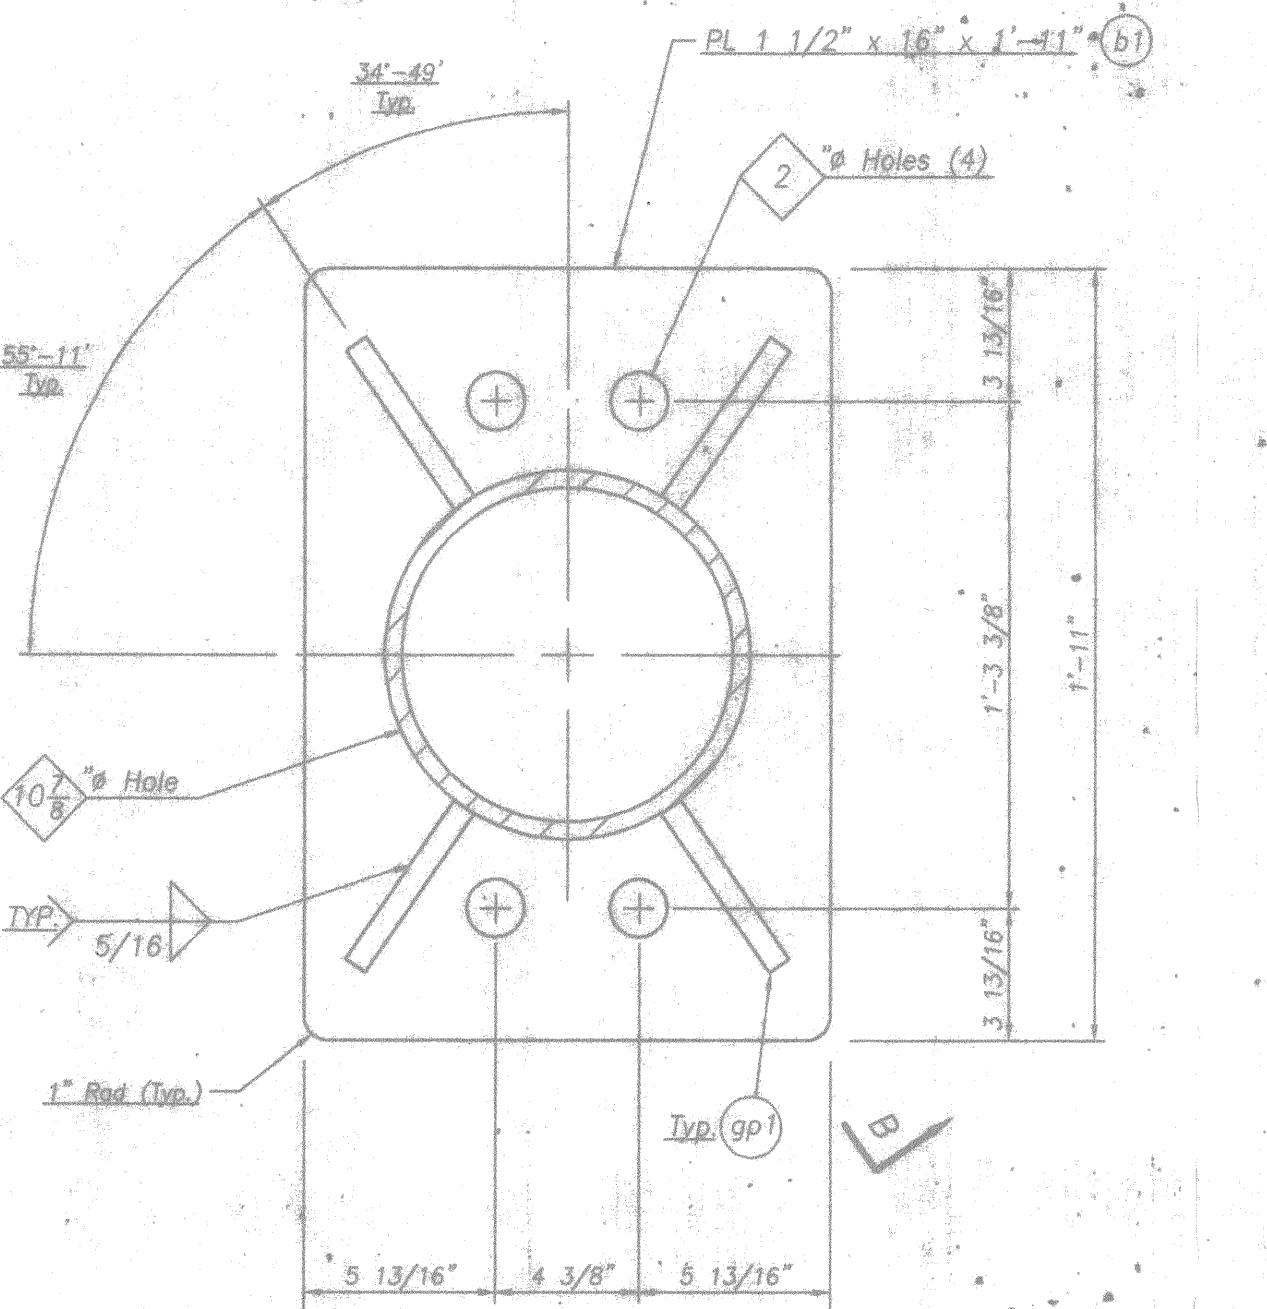

Section A-A

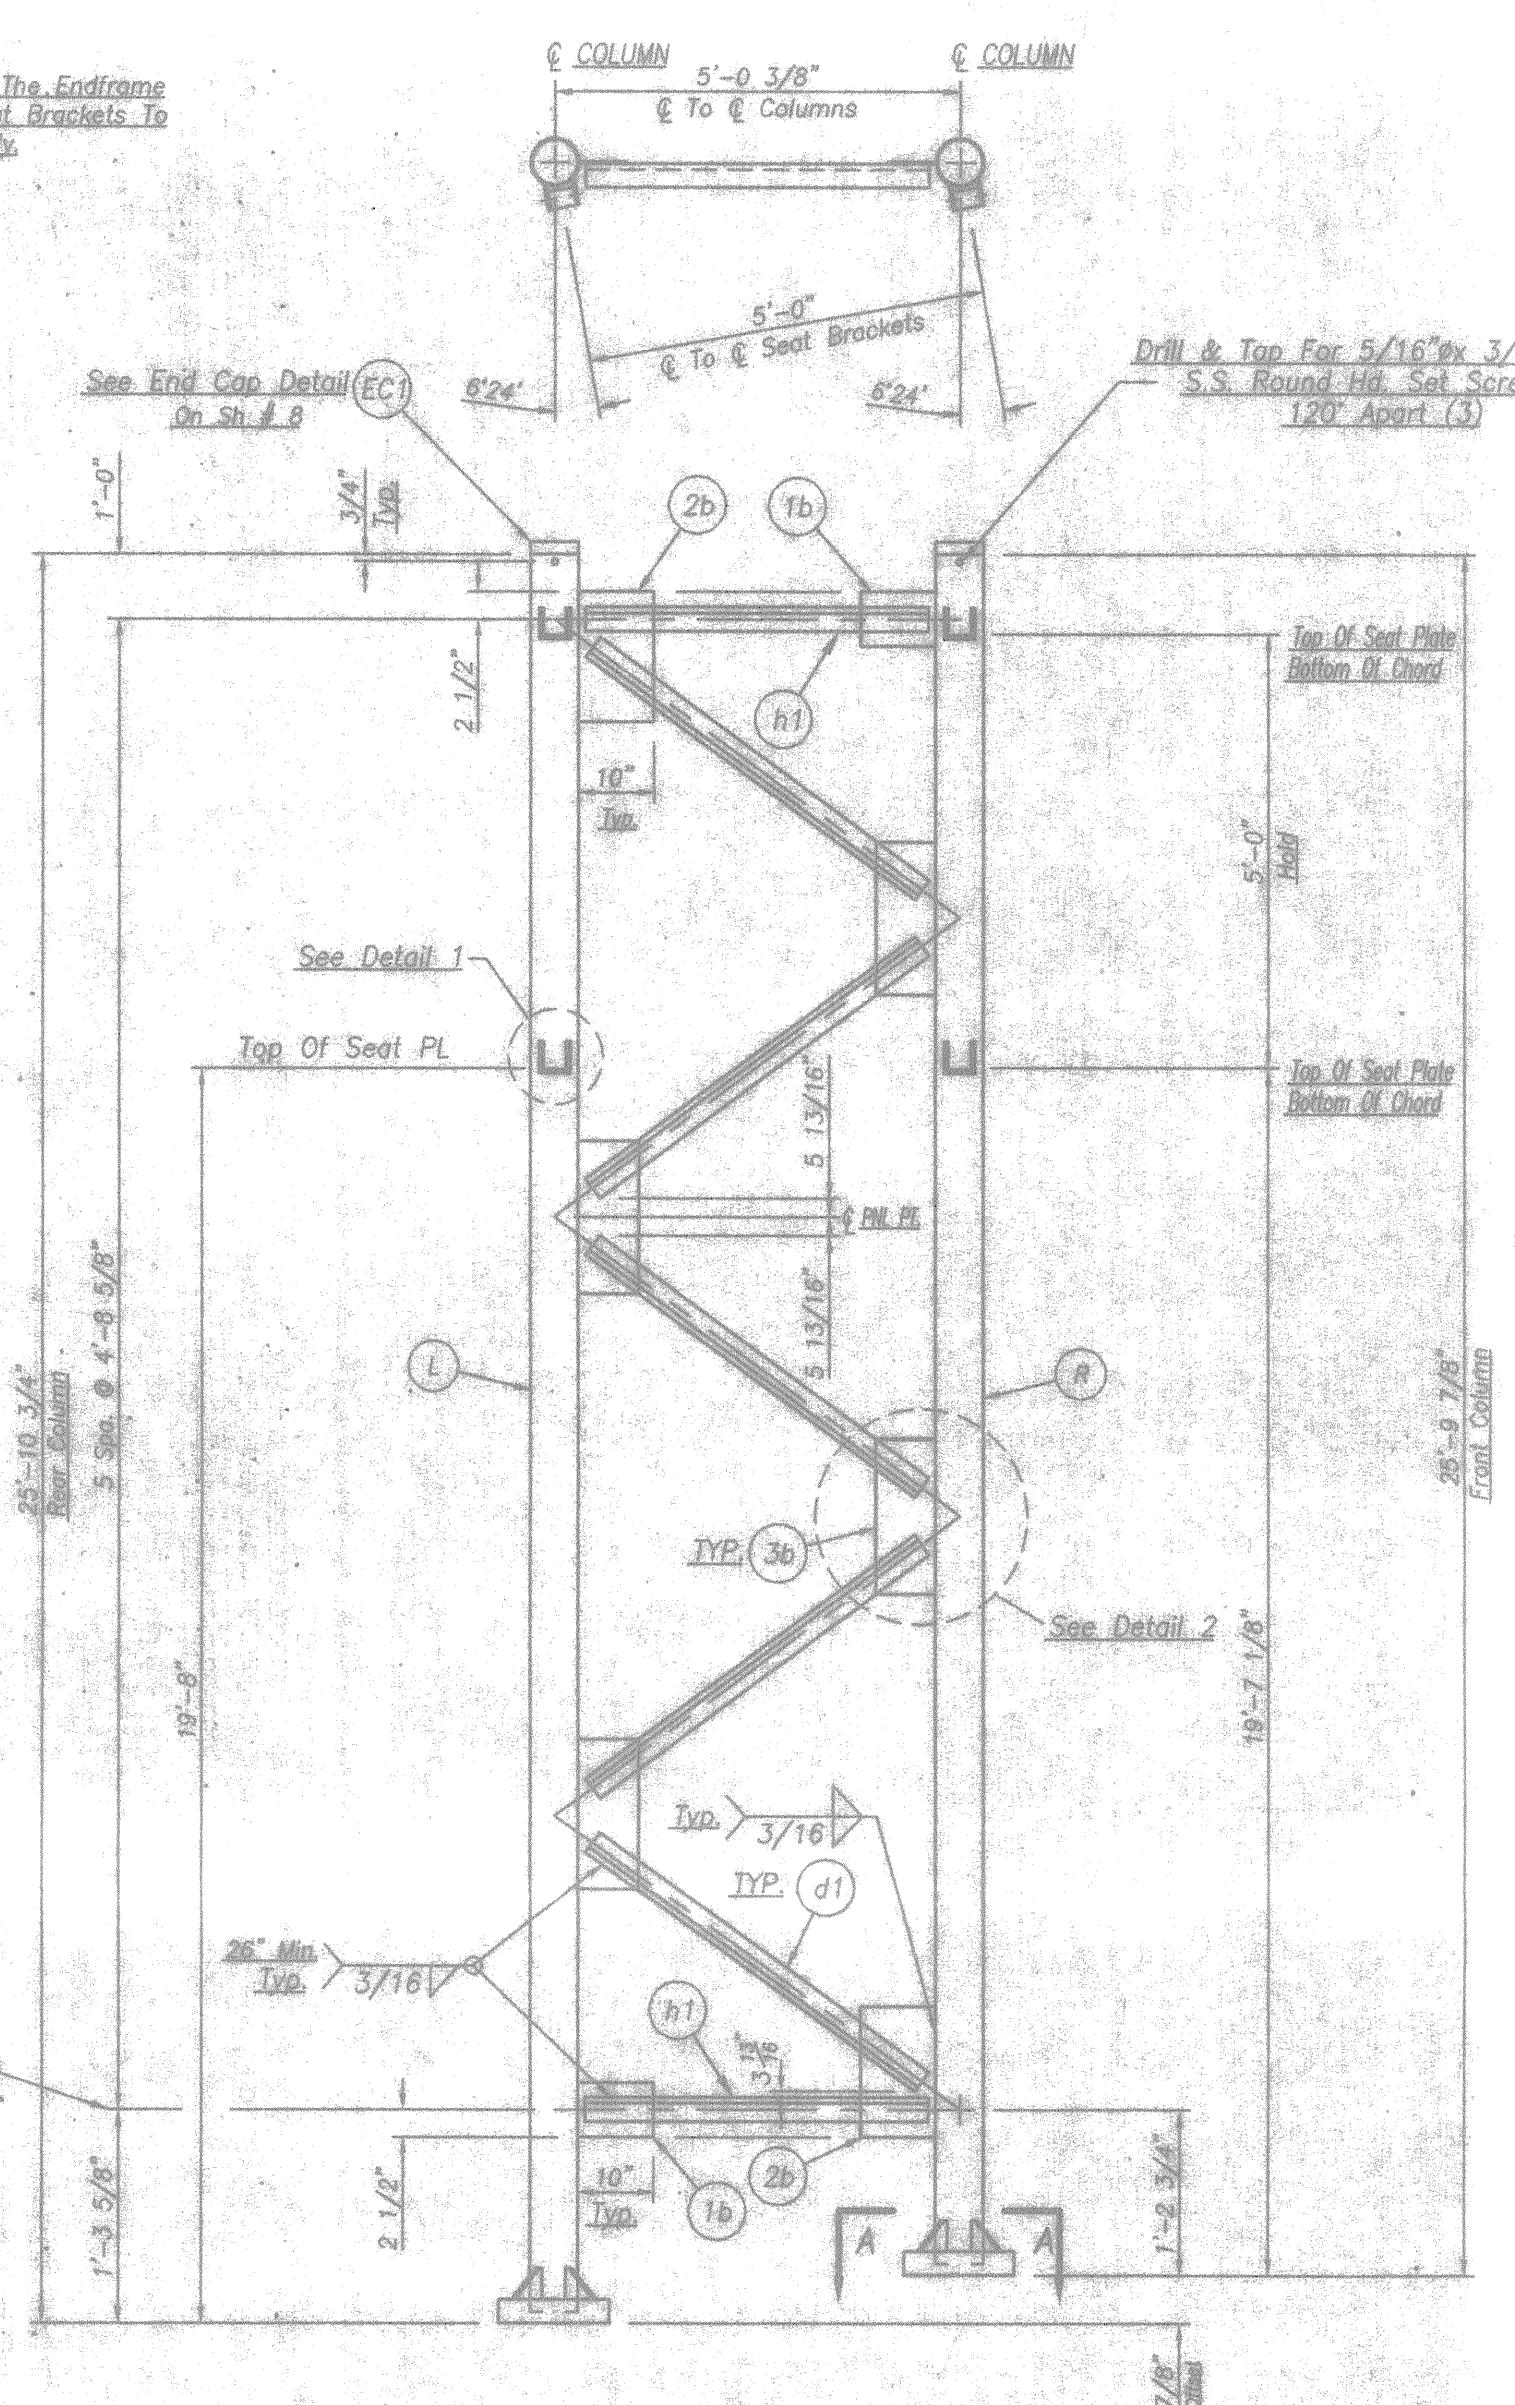

ELEV
End Column Mk (E8)
1 - Req'd.

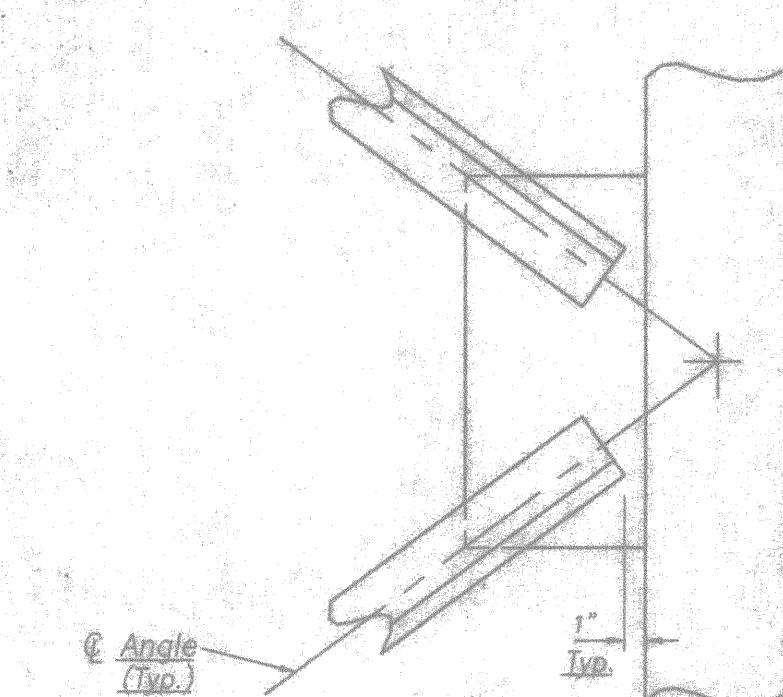

Detail 2

Material Specs:
Steel Pipe Shall Be API Spec 5L x 42 Fy=42,000 PSI.
All Other Steel - A.S.T.M. A202, Gr. 36
Galv. Steel Per A.S.T.M. A123
H.S. Hardware To Be A.S.T.M. A325
Galv. Steel Per A.S.T.M. A153

PRINTS ISSUED		REVISIONS				
FOR	NO.	DATE	FOR	NO.	DATE	DESCRIPTION
Brookfield Fabricating Corp. P.O. Box 406 - Brookfield, Missouri 64628- (660)258-2274						
Customer: Timme, Inc.						
Project: STPG 1989 (489) Mason Street City of Green Bay, WI						
Description: Fabrication Details Of End Columns for Str S-5-50						
Printed For:	Wisconsin	Drawn By:	JW	Revised:	C.R.	Date:
						9/3/98
Job No.:	WI-6402	Rev.:				