

STATE PROJECT NUMBER	SHEET NO.
1166-07-74	

DESIGN DATA

SIGN BRIDGE	DESIGN SIGN AREA (SQ. FT.)
S-37-55	396 (TOTAL OF 2 SIDES)
S-37-56	402
S-37-57	660

GENERAL NOTES



- DRAWINGS SHALL NOT BE SCALED.
- EXACT LOCATIONS OF SIGN BRIDGES SHALL BE LOCATED BY THE ENGINEER.
- SUBSURFACE INVESTIGATION WAS PERFORMED BY STS CONSULTANTS. A COMPLETE SOILS REPORT IS AVAILABLE FROM THE DEPARTMENT OF TRANSPORTATION.
- ALTERNATE DESIGNS ARE NOT ALLOWED.
- PROVIDE SIGN BRIDGE IDENTIFICATION PLAQUE FOR ALL SIGN BRIDGES.
- HANDHOLES ARE NOT REQUIRED.
- THE DESIGN DOES NOT ALLOW FUTURE CATWALKS OR LIGHTING.

TOTAL ESTIMATED QUANTITIES

SIGN SUPPORTS CONCRETE MASONRY	52 CY
SIGN SUPPORTS STEEL COATED REINFORCEMENT HS	4080 LB
SIGN BRIDGE (S-37-56)	1LS
SIGN BRIDGE (S-37-57)	1LS
SIGN BRIDGE CANTILEVERED (S-37-55)	1LS


LIST OF DRAWINGS

- 1-3. SIGN BRIDGE LAYOUTS
4. F1 FOOTING DETAILS
5. CANTILEVER TRUSS FOOTING
6. 4-CHORD GALVANIZED STEEL SIGN BRIDGE
7. 4-CHORD SIGN BRIDGE DETAILS
8. GALVANIZED STEEL CANTILEVER SIGN TRUSS
9. GALVANIZED STEEL CANTILEVER SIGN TRUSS DETAILS

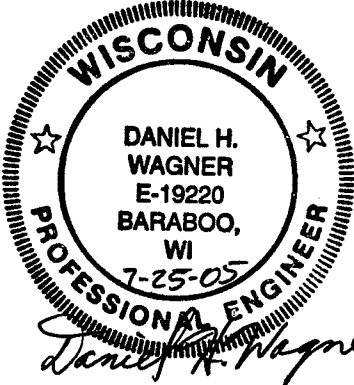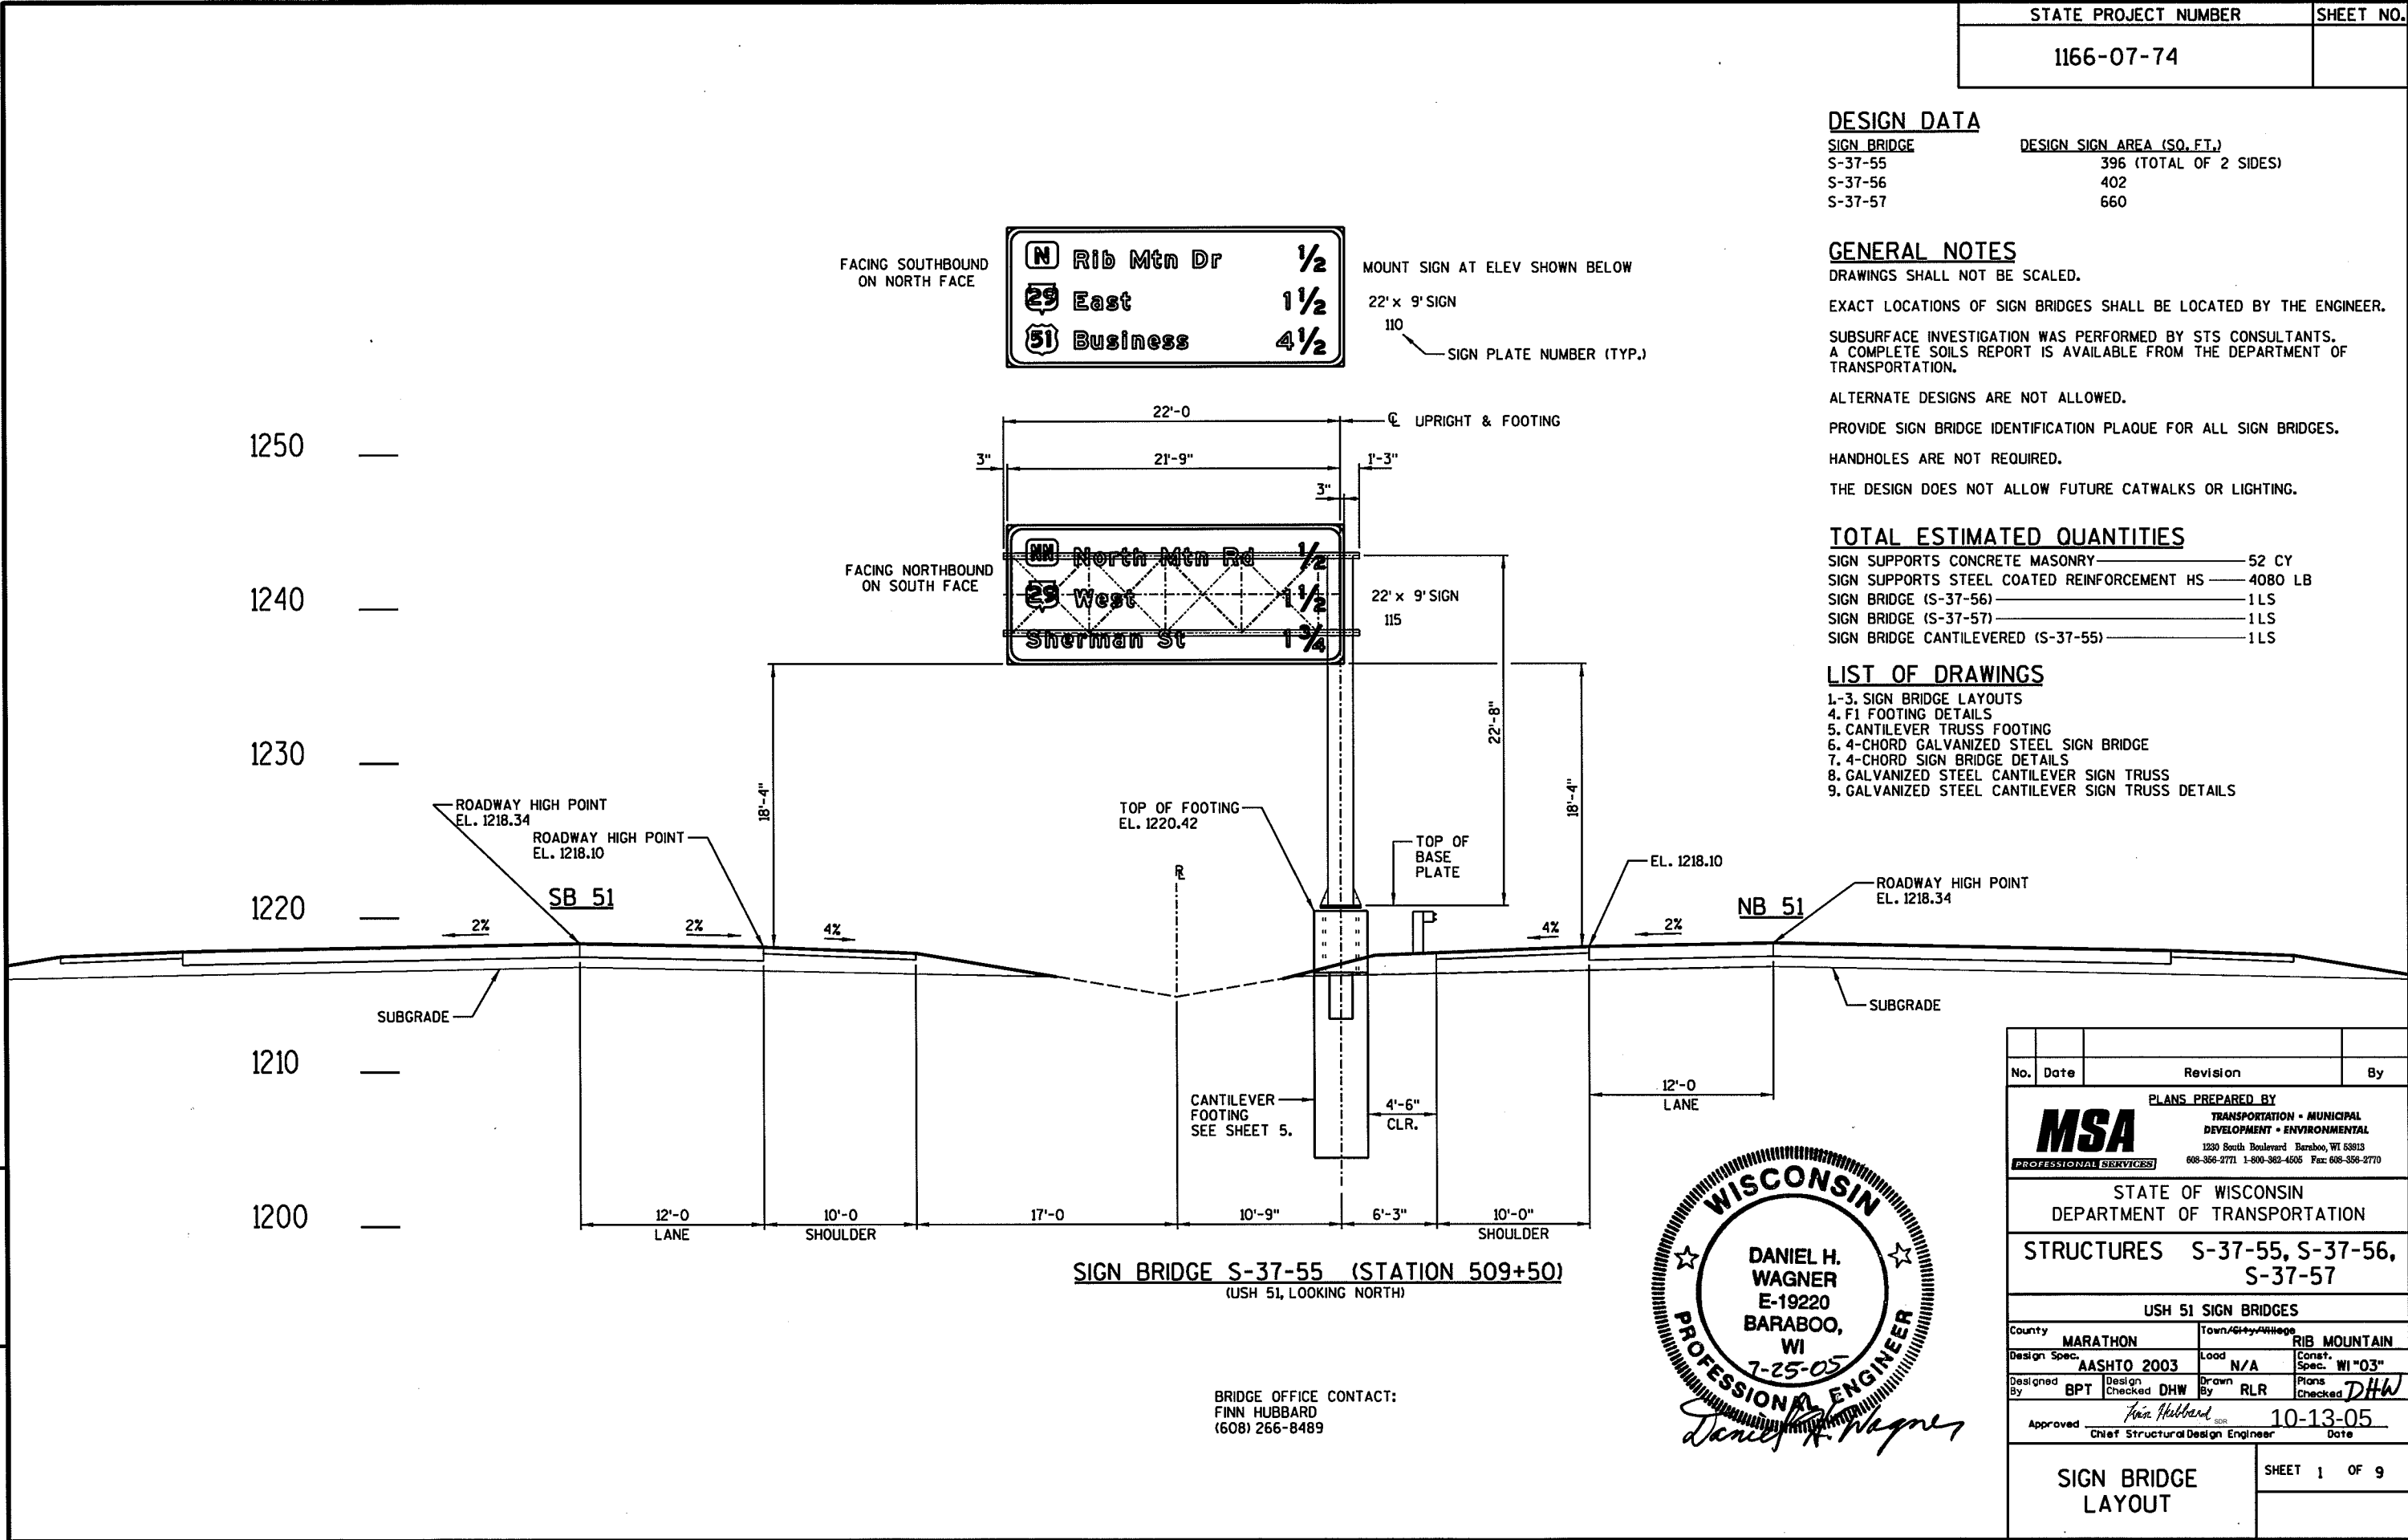

BRIDGE OFFICE CONTACT:
FINN HUBBARD
(608) 266-8489


No.	Date	Revision	By
PLANS PREPARED BY			
MSA TRANSPORTATION • MUNICIPAL DEVELOPMENT • ENVIRONMENTAL 1230 South Boulevard Baraboo, WI 53813 608-366-2771 1-800-362-4505 Fax: 608-358-2770			
PROFESSIONAL SERVICES			
STATE OF WISCONSIN DEPARTMENT OF TRANSPORTATION			
STRUCTURES S-37-55, S-37-56, S-37-57			
USH 51 SIGN BRIDGES			
County	MARATHON	Town/Village	RIB MOUNTAIN
Design Spec.	AASHTO 2003	Load	N/A
Design By	BPT	Design Checked	DHW
Drawn By	RLR	Plans Checked	DHW
Approved	Finn Hubbard Chief Structural Design Engineer		10-13-05 Date
SIGN BRIDGE LAYOUT			SHEET 1 OF 9

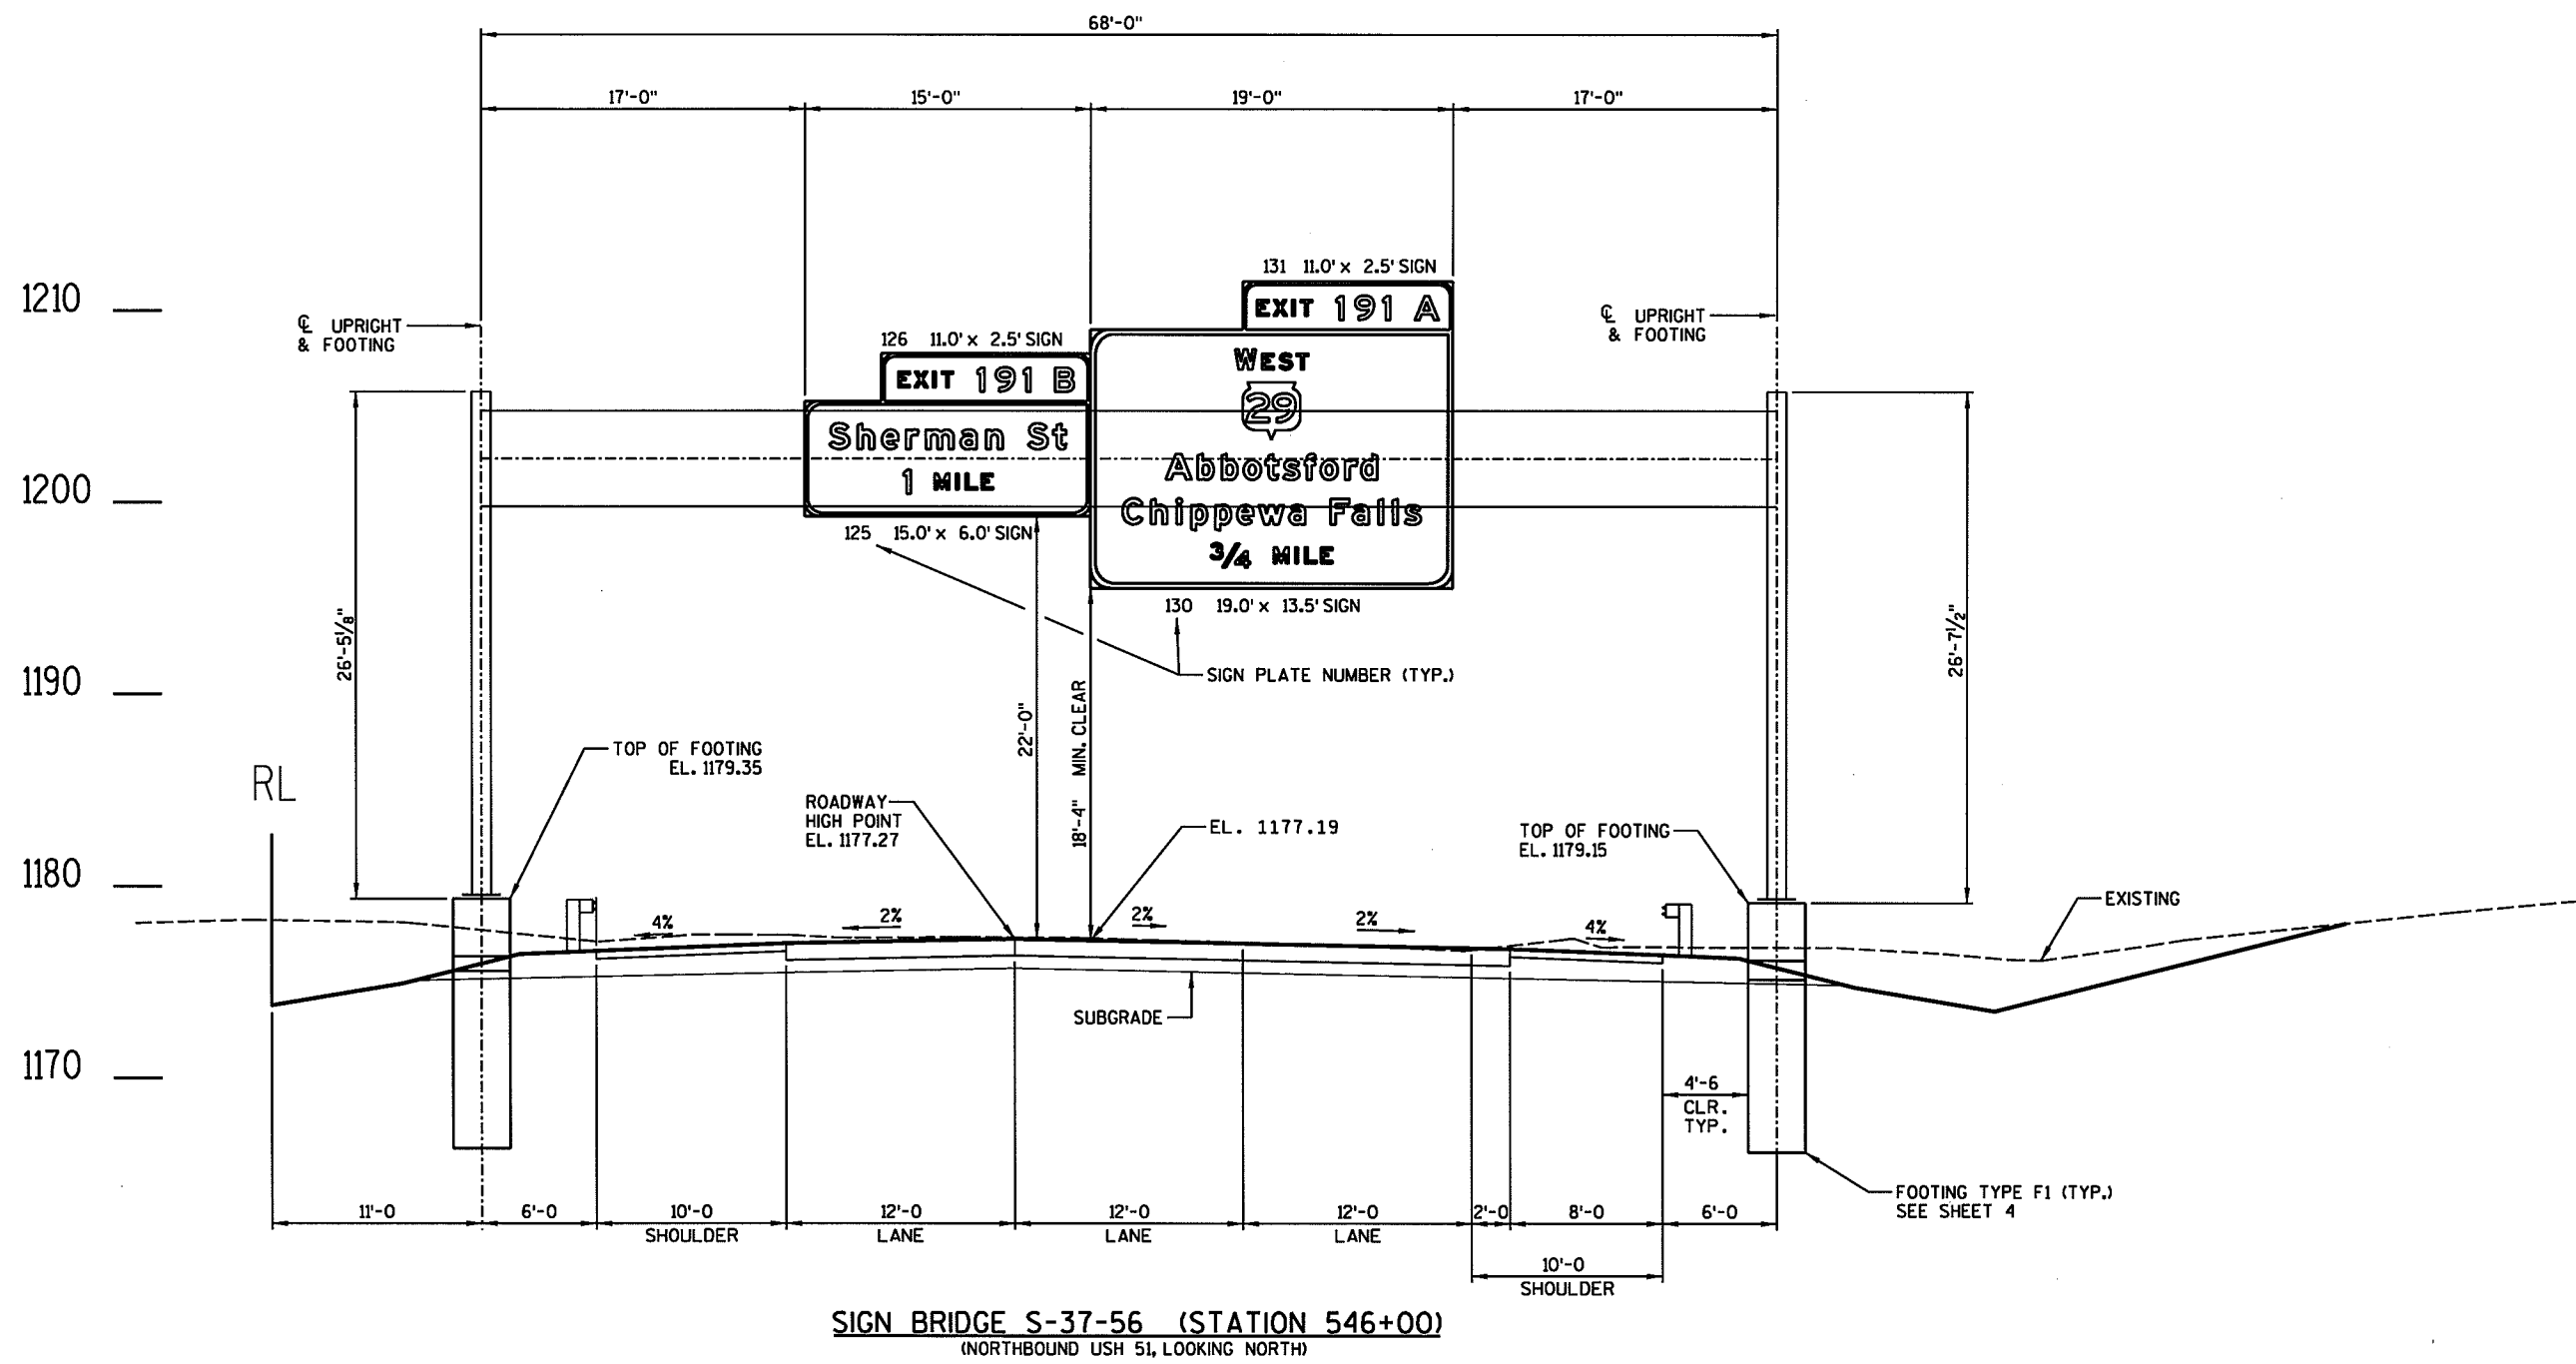

8

8

STATE OF WISCONSIN DEPARTMENT OF TRANSPORTATION			
STRUCTURE S-37-56			
Const. Spec. WI "03"	Drawn By RLR	Plans Checked DHW	
SIGN BRIDGE LAYOUT		SHEET 2 OF 9	

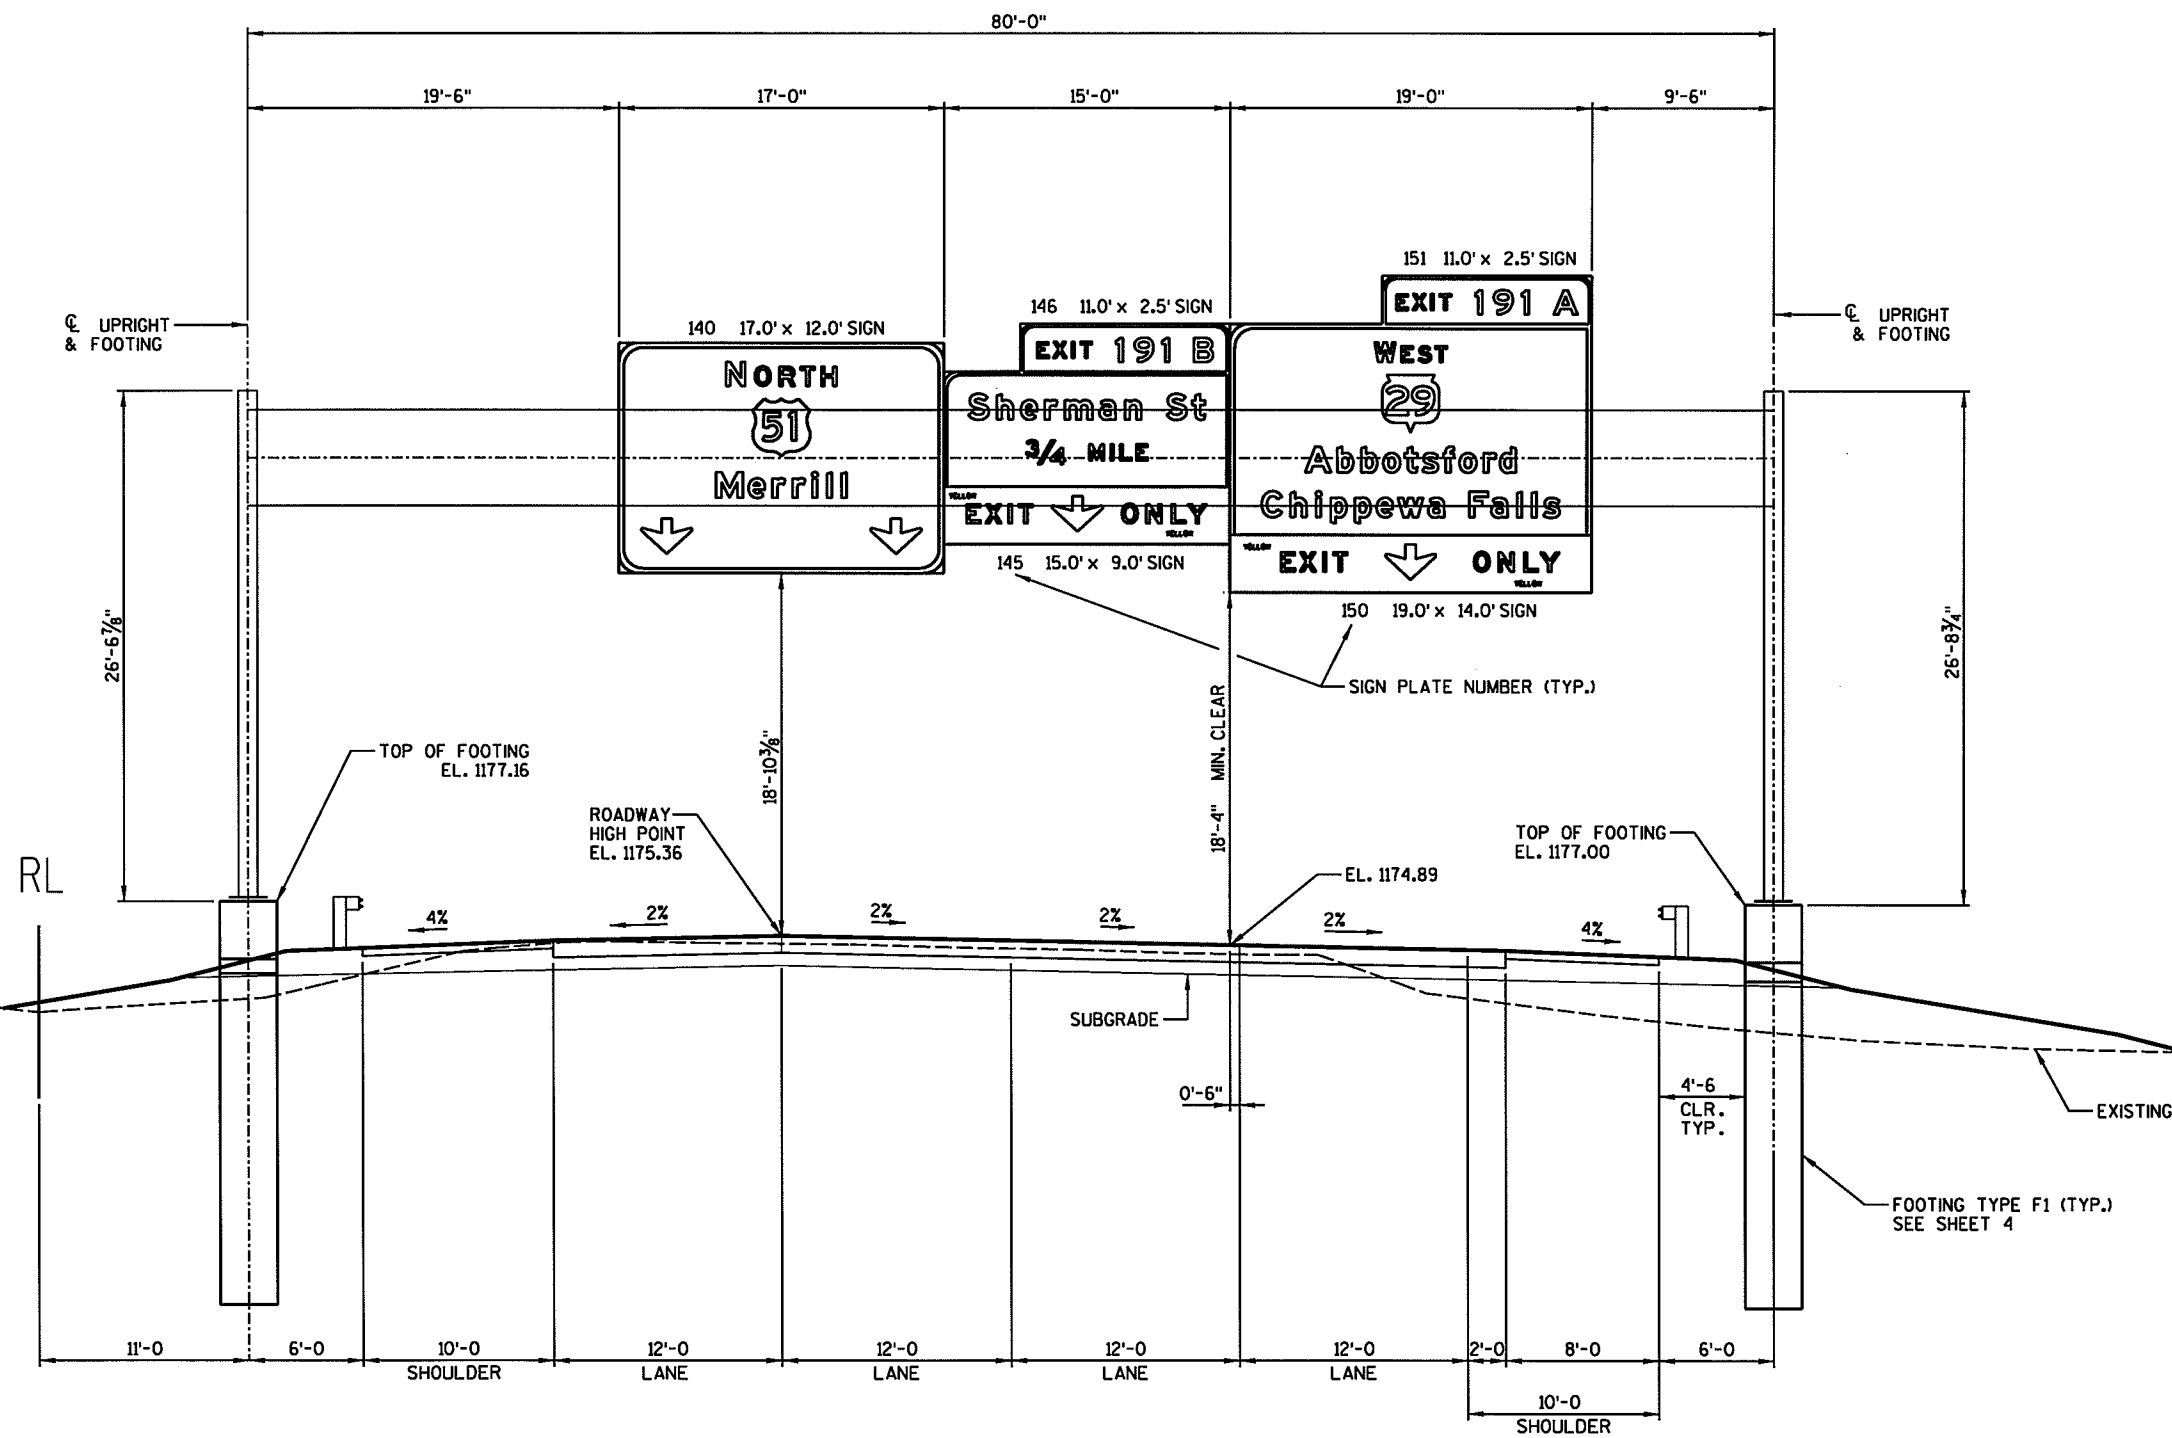

SIGN BRIDGE S-37-57 (STATION 562+00)
(NORTHBOUND USH 51, LOOKING NORTH)

No.	Date	Revision	By
STATE OF WISCONSIN DEPARTMENT OF TRANSPORTATION			
STRUCTURE S-37-57			
Const. Spec. WI "03"	Drawn By RLR	Plans Checked DHW	
SIGN BRIDGE LAYOUT			SHEET 3 OF 9

BILL OF BARS (COATED) 980 LBS.

BAR MARK	NO. REQ'D	LENGTH	BENT	LOCATION
A701	12	15'-6"		FOOTING - COLUMN/TOP
A402	16	10'-6"	X	FOOTING - COLUMN/TOP
A703	12	15'-0"		FOOTING - WINGS
A404	12	7'-6"	X	FOOTING - WINGS
A405	10	8'-0"	X	FOOTING - TOP
A406	4	3'-6"		FOOTING - TOP - COLUMNS

NOTE:
THE FIRST DIGIT OF A BAR MARK SIGNIFIES THE BAR SIZE.
DIMENSIONS IN BENDING DETAILS ARE OUT TO OUT OF BAR.
EPOXY COAT ALL BARS.

GENERAL NOTES

DRAWINGS SHALL NOT BE SCALED.
BAR STEEL REINFORCEMENT SHALL
BE EMBEDDED 3" CLEAR UNLESS
DETAILED OTHERWISE.

ALLOWABLE DESIGN STRESSES

CONCRETE MASONRY $f'_c=3,500$ P.S.I.
BAR STEEL REINFORCEMENT HS COATED $f_y=60,000$ P.S.I.
ANCHOR BOLTS A.A.S.H.T.O. M314 GRADE 60 $f_y=55,000$ P.S.I.




FOUNDATION DATA

ALLOWABLE SOIL BEARING PRESSURE = 2T/SQ. FT.


TOTAL ESTIMATED QUANTITIES (1 FTG.)

SIGN SUPPORTS CONCRETE MASONRY 8 C.Y.
SIGN SUPPORTS STEEL COATED REINFORCEMENT HS 980 LB.

No.	Date	Revision	By
STATE OF WISCONSIN DEPARTMENT OF TRANSPORTATION			
STRUCTURE S-37-55			
Const. Spec. WI "03"	Drawn By RLR	Plans Checked DHW	
CANTILEVER TRUSS FOOTING			SHEET 5 OF 9

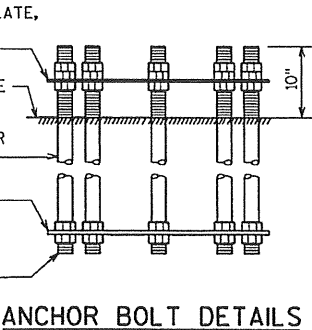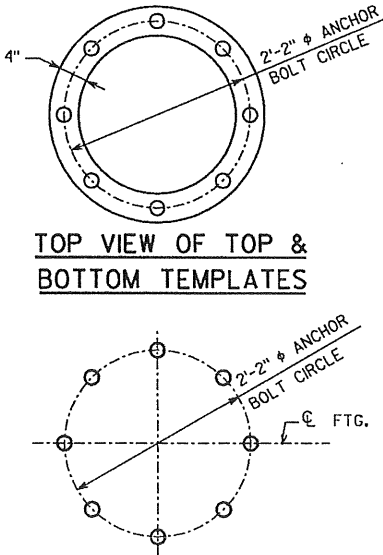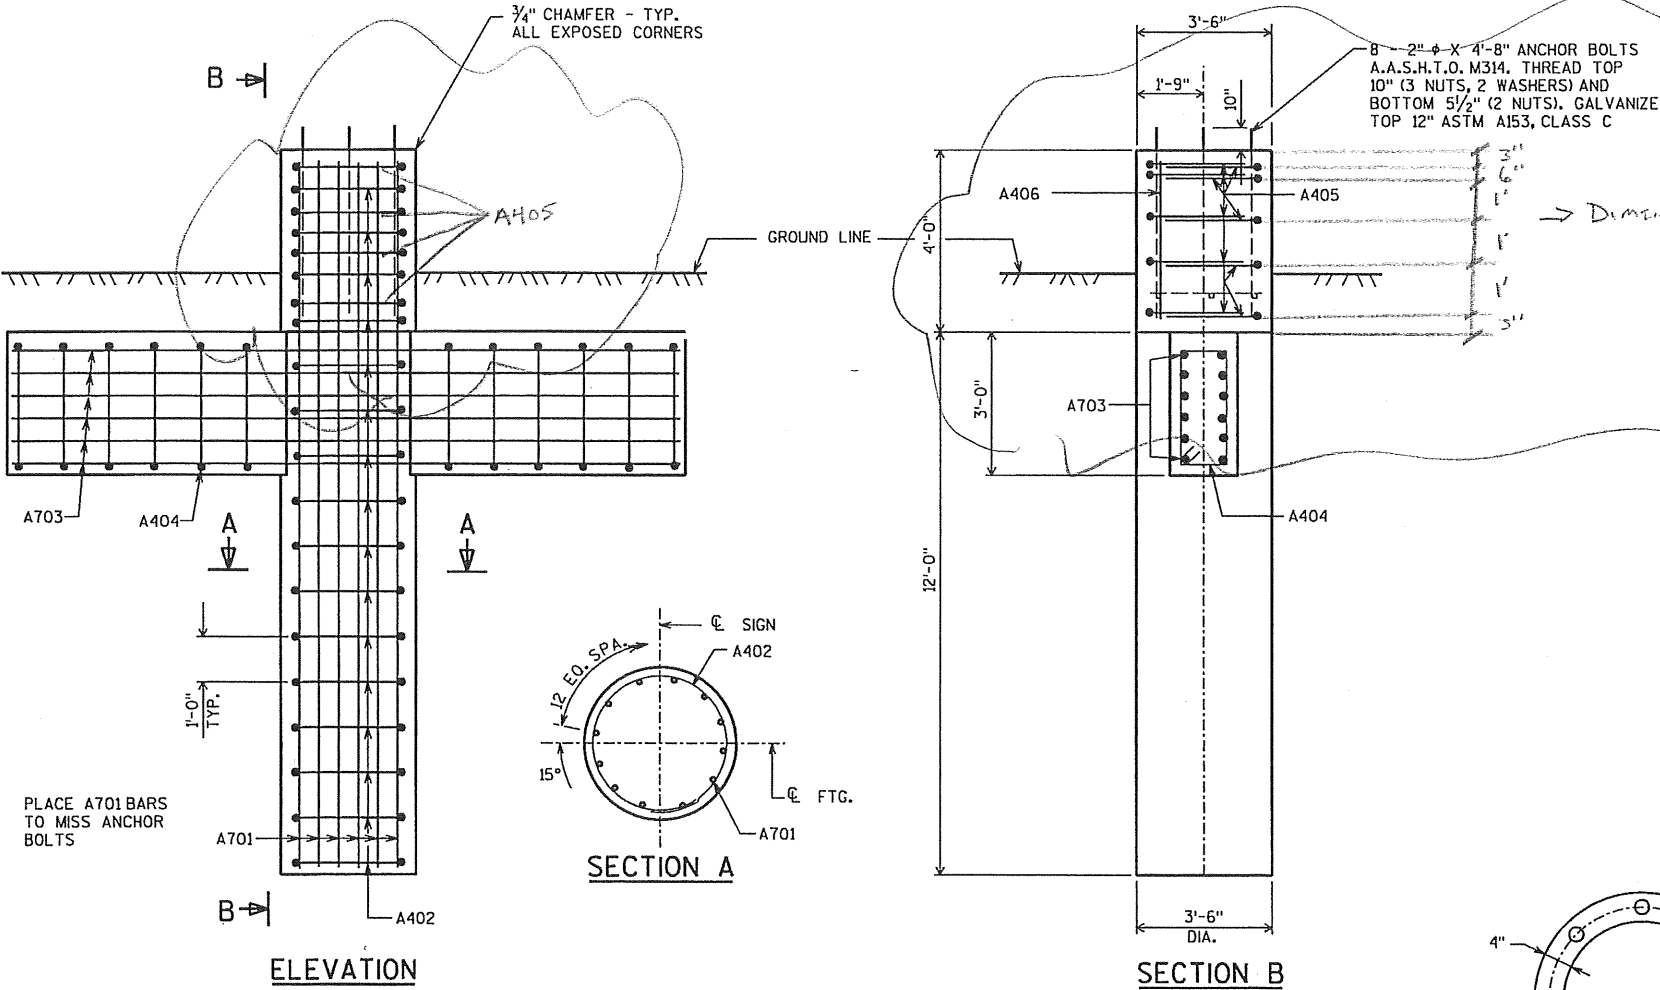

ANCHOR BOLT DETAILS

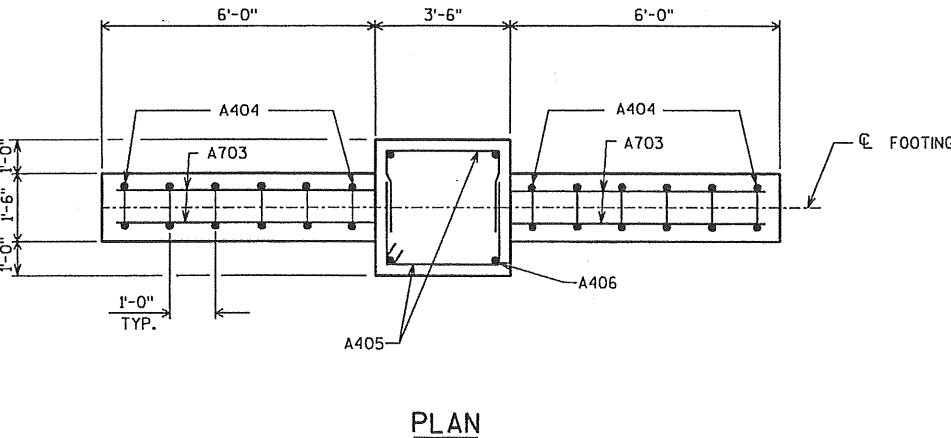

PLAN



NOTES

DESIGN DATA


1. DEAD
2. DEAD + WIND
3. DEAD + ICE + $\frac{1}{2}$ (WIND*)

*MIN. VALUE OF 25 PSF FOR G








STRUCTURE	A	B	C	CHORDS O.D. X THK.	TOP & BOTTOM WEB	FRONT & REAR WEB	COUPLING PLATE "D1" & "T"	BOLT CIRCLE DIA. "O2"	NO. OF BOLTS IN COUPLING	CAMBER	COLUMN O.D. X THK.	TOWER WEBS	"L"
S-37-56	26'-2 $\frac{5}{8}$ "	26'-5"	5	3.50" X 0.216"	L 3" X 3" X $\frac{3}{16}$ "	L 3" X 3" X $\frac{3}{16}$ "	9" X 1"	6"	4	1"	10.75" X 0.365"	L 3" X 3" X $\frac{1}{4}$ "	66'-10' $\frac{1}{2}$
S-37-57	26'-4 $\frac{3}{8}$ "	26'-6 $\frac{1}{4}$ "	5	3.50" X 0.216"	L 3" X 3" X $\frac{3}{16}$ "	L 3" X 3" X $\frac{3}{16}$ "	9" X 1"	6"	4	1 $\frac{1}{4}$ "	12.75" X 0.375"	L 3" X 3" X $\frac{1}{4}$ "	78'-8 $\frac{1}{2}$ "

No.	Date	Revision	By
STATE OF WISCONSIN DEPARTMENT OF TRANSPORTATION			
STRUCTURES S-37-56, 57			
Const. Spec.	WI "03"	Drawn By	Plans Checked <i>DHW</i>
4-CHORD GALVANIZED STEEL SIGN BRIDGE		SHEET 6 OF 9	

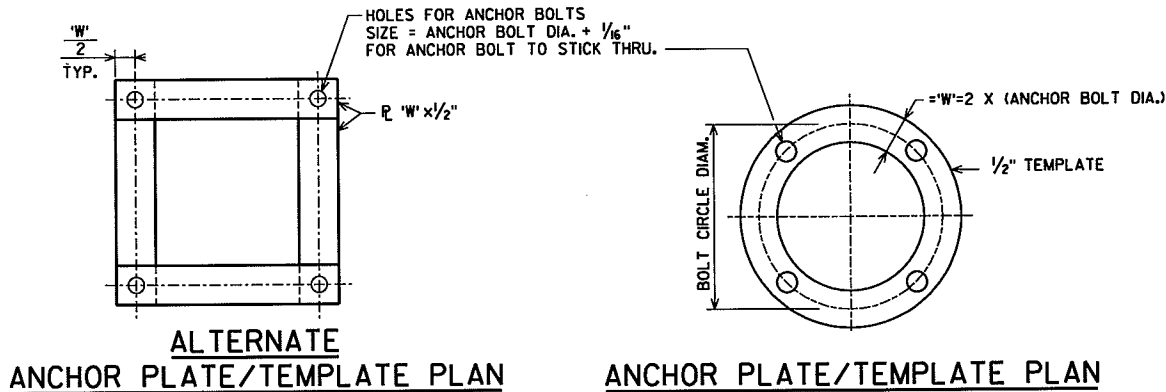


CAP FABRICATED FROM STEEL PLATES (MIN. THICKNESS 3/16") WILL BE ACCEPTABLE, SUBJECT TO APPROVAL BY THE ENGINEER.

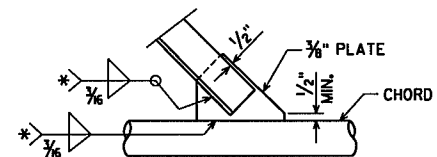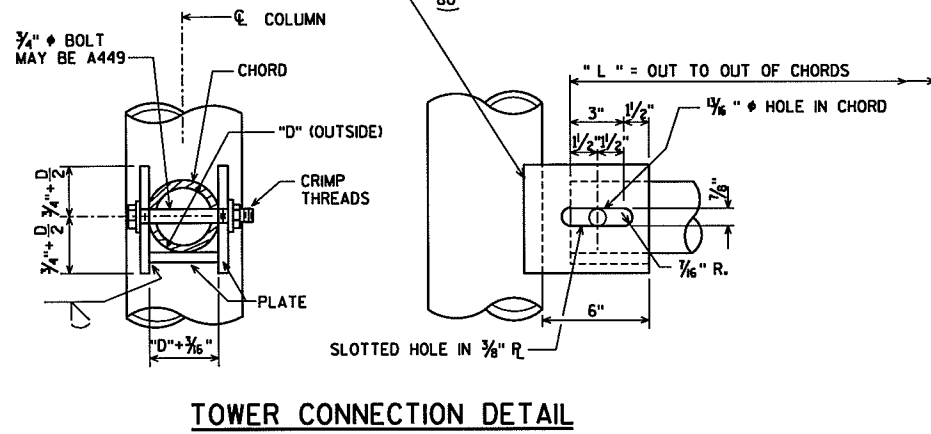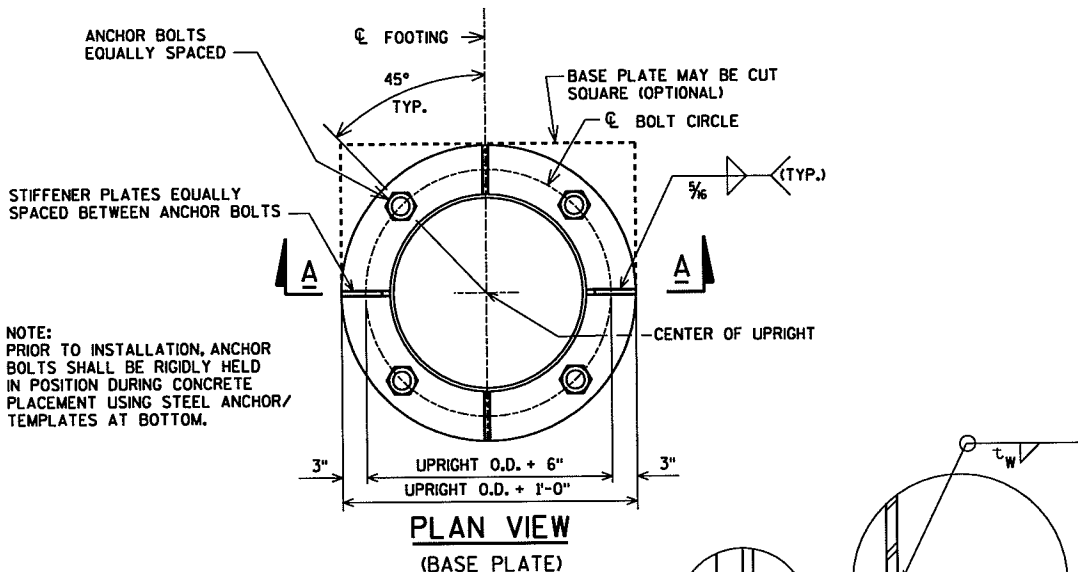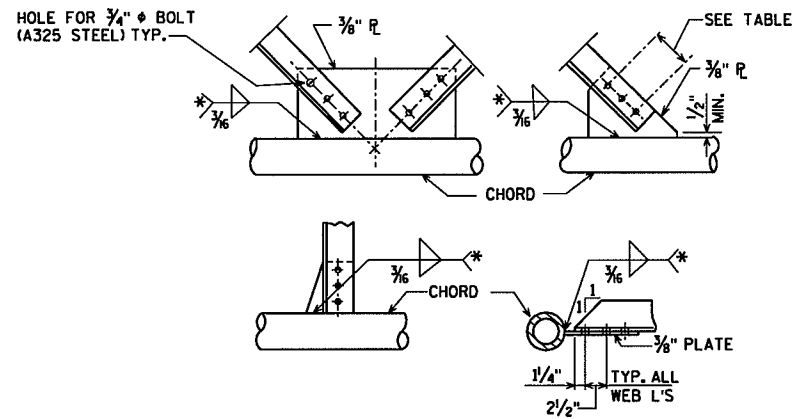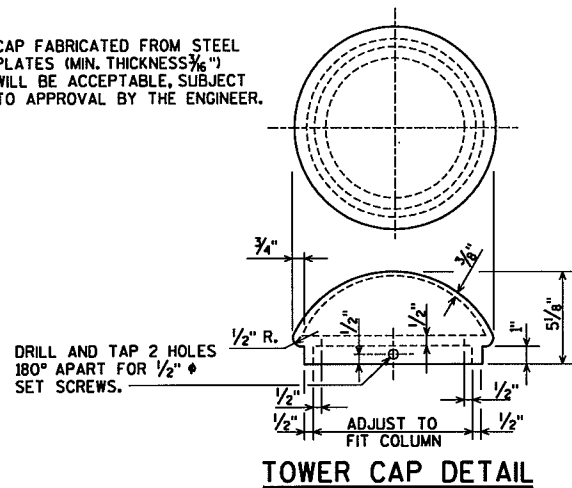

TYPICAL WELDED ALTERNATE


*ANGLE	WELD LENGTH	NO. OF BOLTS
2 1/2" x 2 1/2" x 1/4"	11"	3
3" x 3" x 3/16"	10"	3
3" x 3" x 1/4"	13"	4
3" x 3" x 3/8"	16 1/2"	5
3" x 3" x 1/2"	19 1/2"	6
4" x 4" x 1/4"	18"	5
4" x 4" x 3/8"	22"	6
4" x 4" x 1/2"	26"	8
4" x 4" x 3/4"	30"	9
4" x 4" x 1"	34"	10

● ONLY USED FOR BOXED END AND TRANSVERSE BRACING.

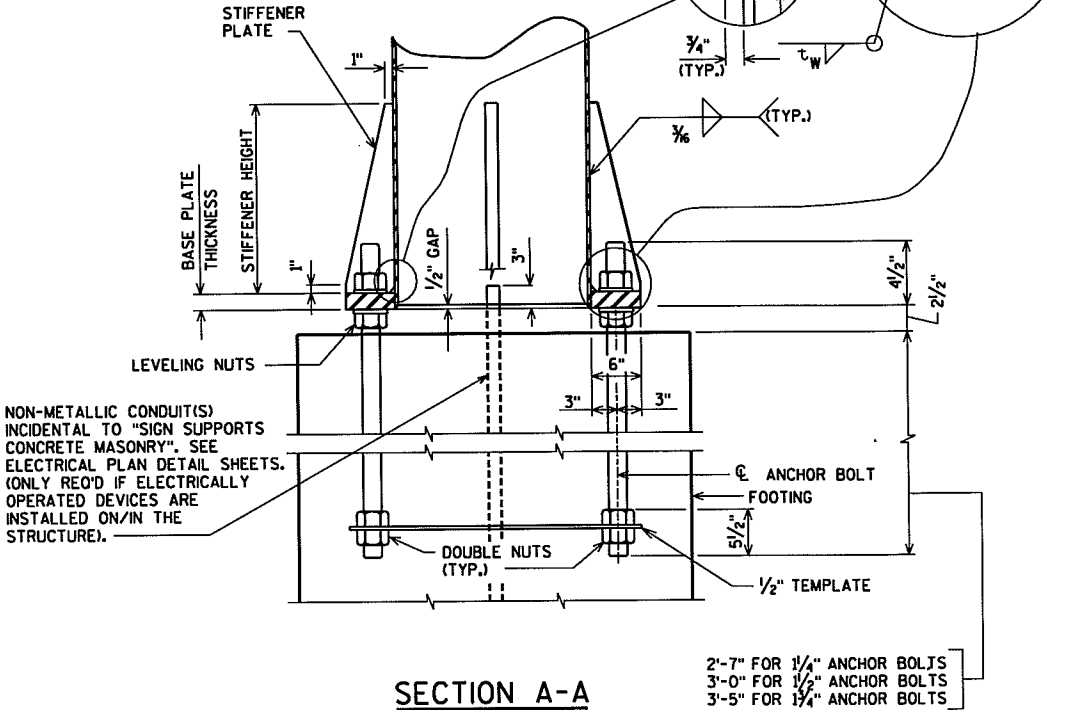


BASE PLATE & UPRIGHT COLUMN DETAILS


STRUCTURE	COLUMN O.D. X THK.	ANCHOR BOLTS	BASE PLATE THICKNESS (IN.)	STIFFENER PLATE THICKNESS (IN.)	STIFFENER PLATE HEIGHT (IN.)	t _w (IN.)
S-37-56	10.75" x 0.365"	4 - 1 1/4" ♦	1 1/4"	1/2"	10"	1/4"
S-37-57	12.75" x 0.375"	4 - 1 1/4" ♦	1 1/4"	1/2"	10"	1/4"

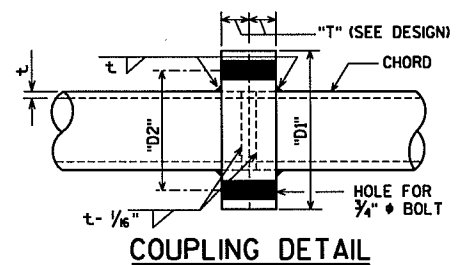

No.	Date	Revision	By
STATE OF WISCONSIN DEPARTMENT OF TRANSPORTATION			
STRUCTURES S-37-56, 57			
Const. Spec. WI "03"	Drawn By RLR	Plans Checked PHW	
4-CHORD SIGN BRIDGE DETAILS			SHEET 7 OF 9

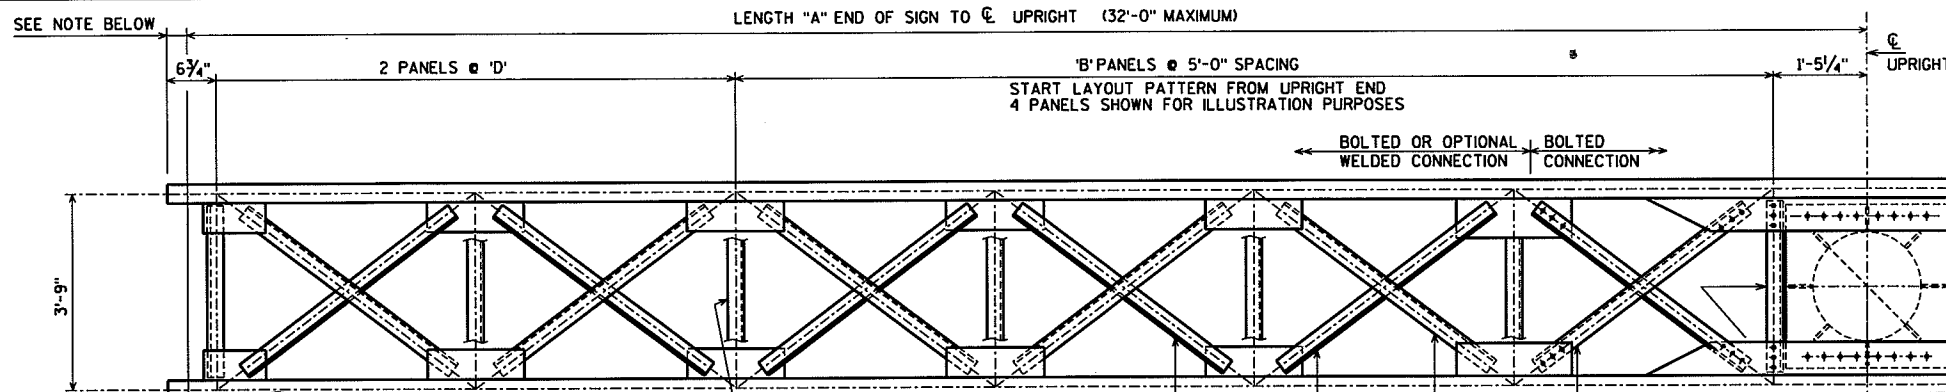

PLAN

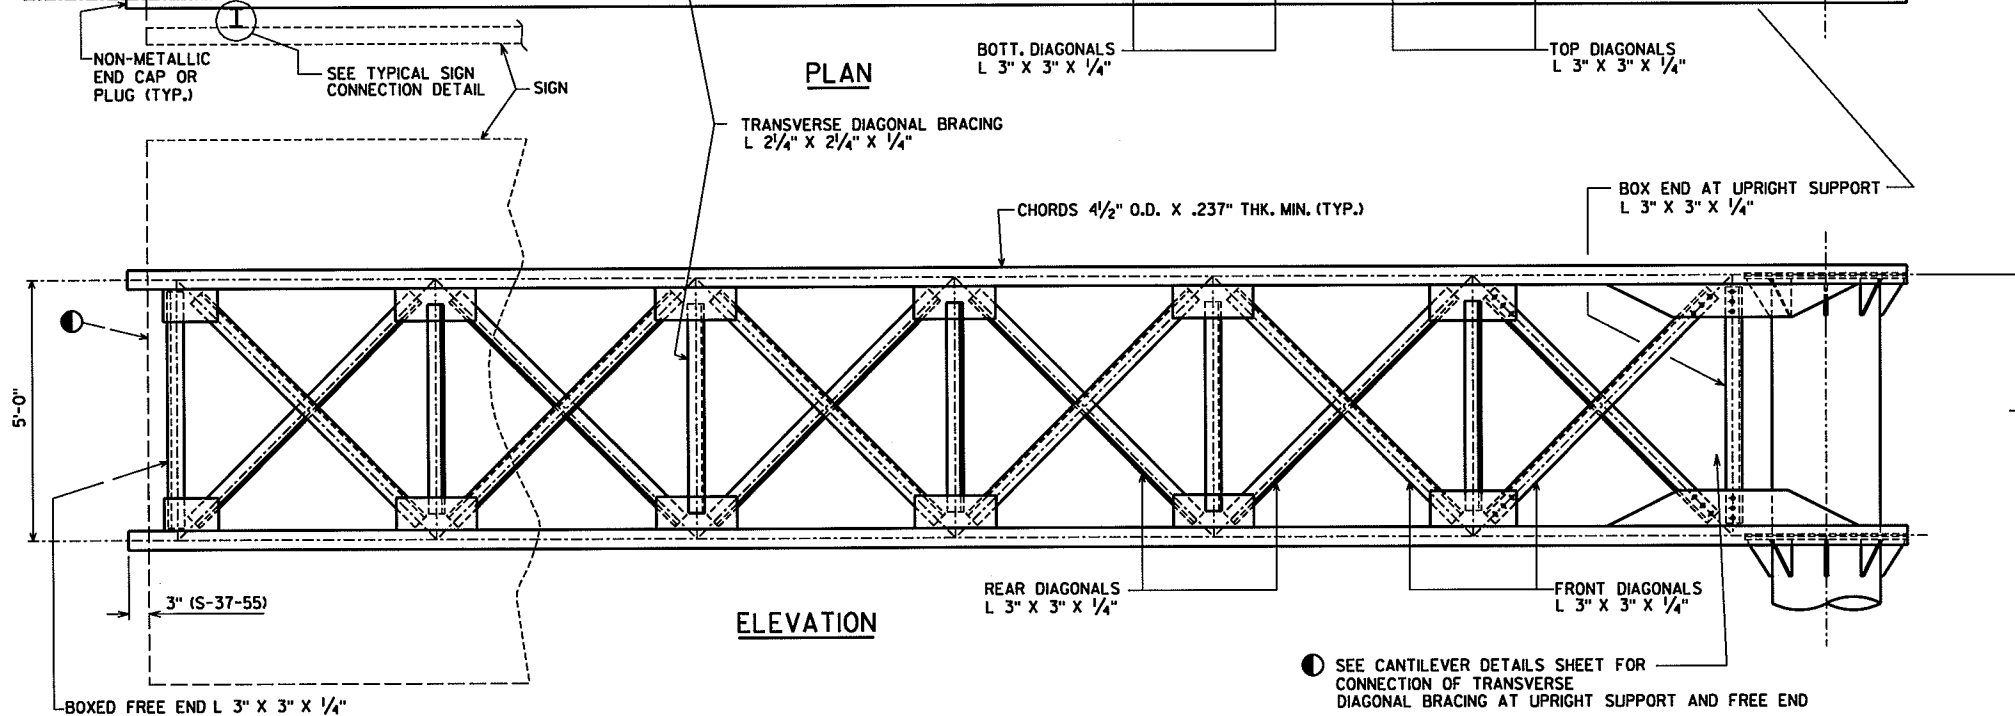

ELEVATION


GENERAL NOTES

DRAWINGS SHALL NOT BE SCALED.


DESIGNED ACCORDING TO A.A.S.H.T.O. "STANDARD SPECIFICATIONS FOR STRUCTURAL SUPPORTS FOR HIGHWAY SIGNS, LUMINAIRES AND TRAFFIC SIGNALS"

WIND VELOCITY = 90 M.P.H. (3-SECOND GUST SPEED)


STRUCTURES ARE DESIGNED FOR MAXIMUM SIGN SIZE OF 12'-0" X 22'-0".

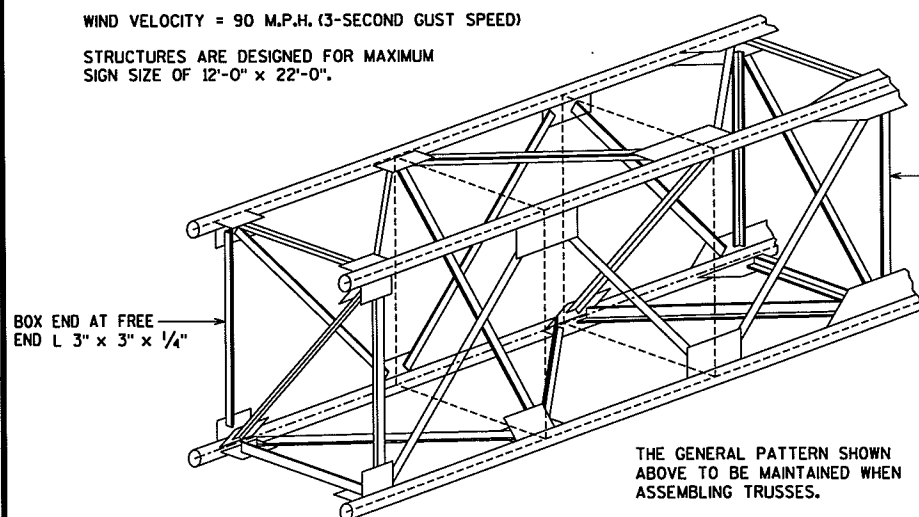


TYPICAL TRUSS SECTION

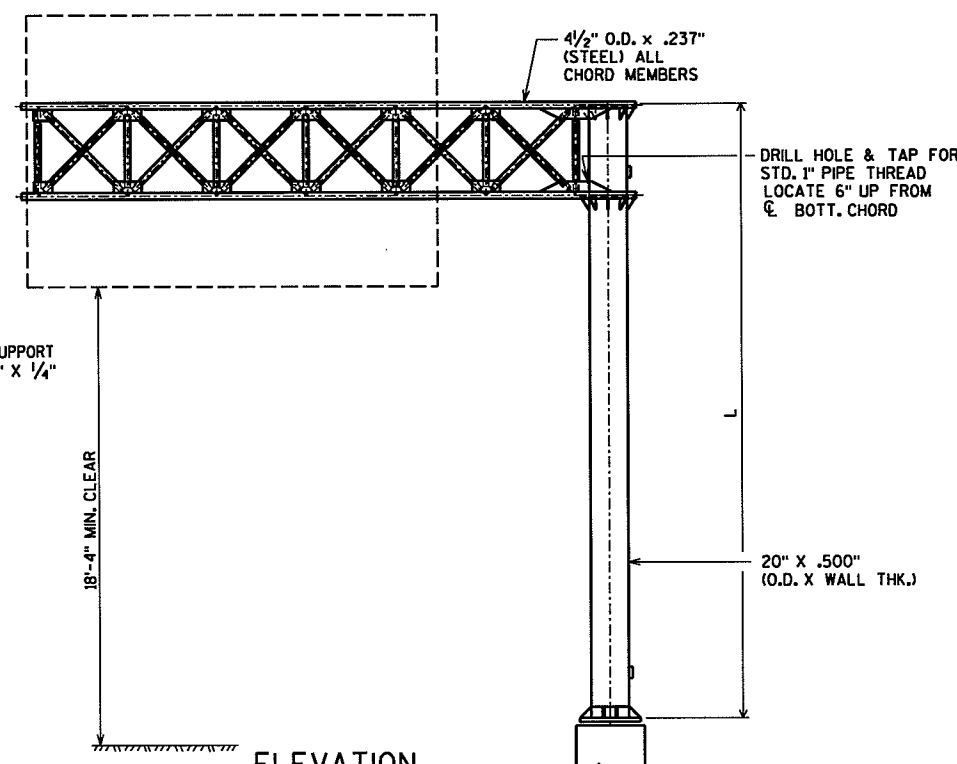

ELEVATION

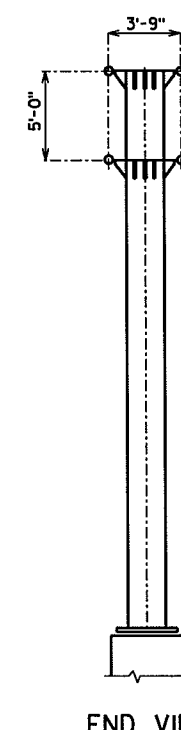


END VIEW

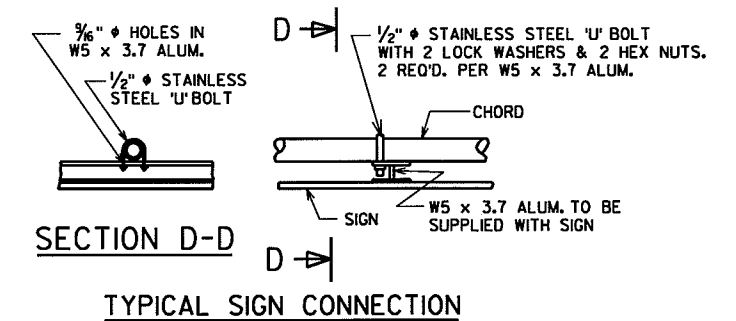


ALLOWABLE DESIGN STRESSES

CHORDS & COLUMN (INCLD. HANDHOLE) — API-5L-X42 — $f_y=42,000$ P.S.I.
 STRUCTURAL ANGLES — A.S.T.M. A709 GRADE 36 — $f_y=36,000$ P.S.I.
 PLATES & BARS — A.S.T.M. A709 GRADE 36 — $f_y=36,000$ P.S.I.
 ANCHOR BOLTS — A.A.S.H.T.O. M314 — $f_y=55,000$ P.S.I.
 HIGH STRENGTH BOLTS — A325 — $f_y=92,000$ P.S.I.
 STRUCTURAL MEMBERS GALVANIZED A123
 HARDWARE GALVANIZED — A153 CLASS C


STRUCTURE	"A"	"L"	"B"	"D"	"X"	"Y"
S-37-55	21'-9"	22'-8"	2	5'-0"	3/8"	1 1/8"

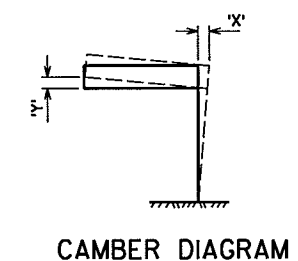

No.	Date	Revision	By
STATE OF WISCONSIN DEPARTMENT OF TRANSPORTATION			
STRUCTURE S-37-55			
Const. Spec. WI "03"	Drawn By RLR	Plans Checked DHW	
GALVANIZED STEEL CANTILEVER SIGN TRUSS			SHEET 8 OF 9

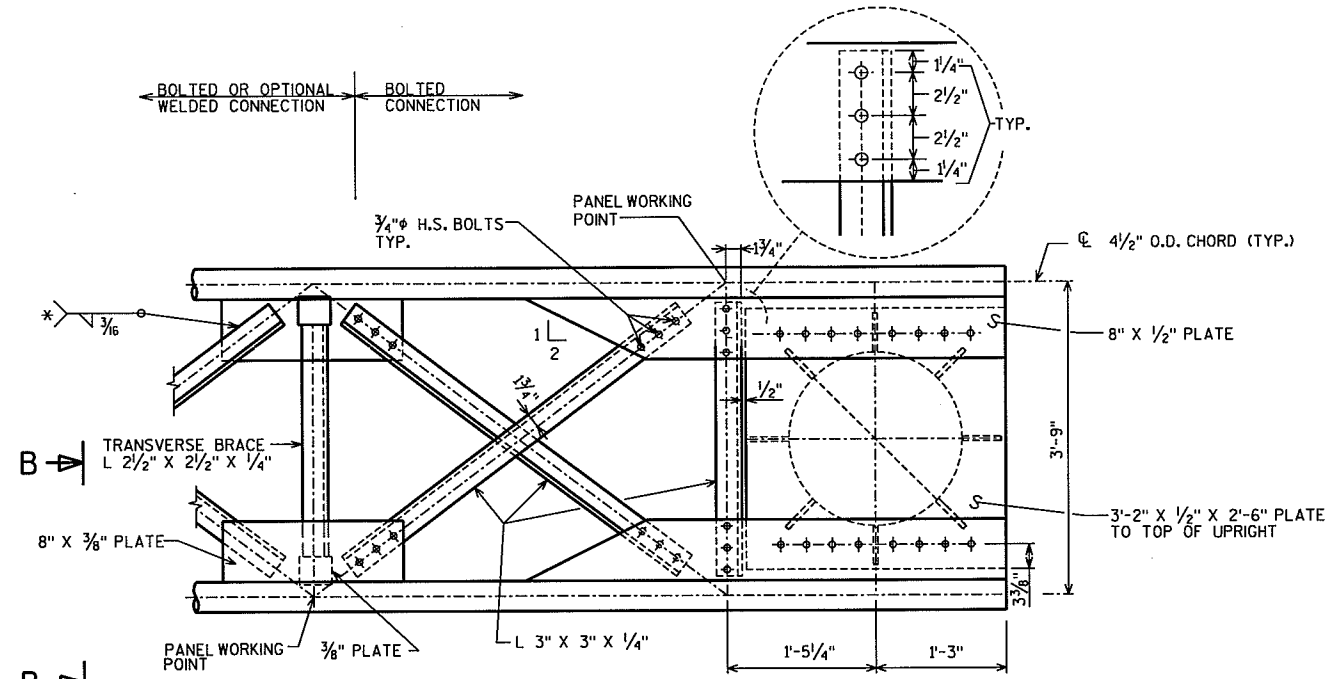


PLAN TRUSS TO UPRIGHT

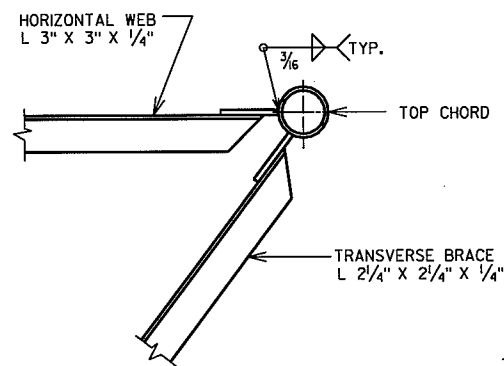


SECTION B-B

* ANGLE	WELD LENGTH (MIN.)
L 2 1/2" x 2 1/2" x 1/4"	7"
L 3" x 3" x 1/4"	8"

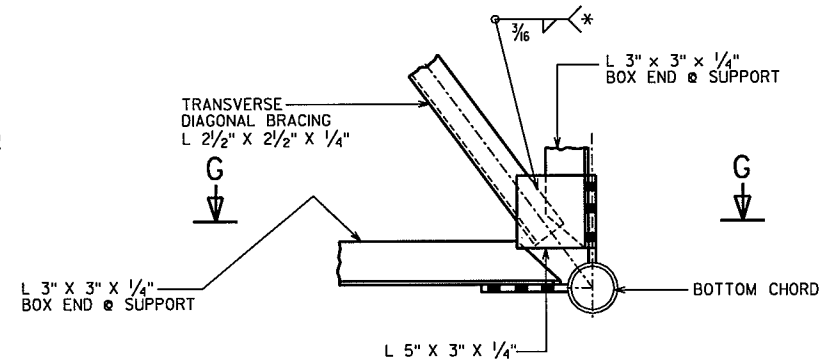


SECTION H-H

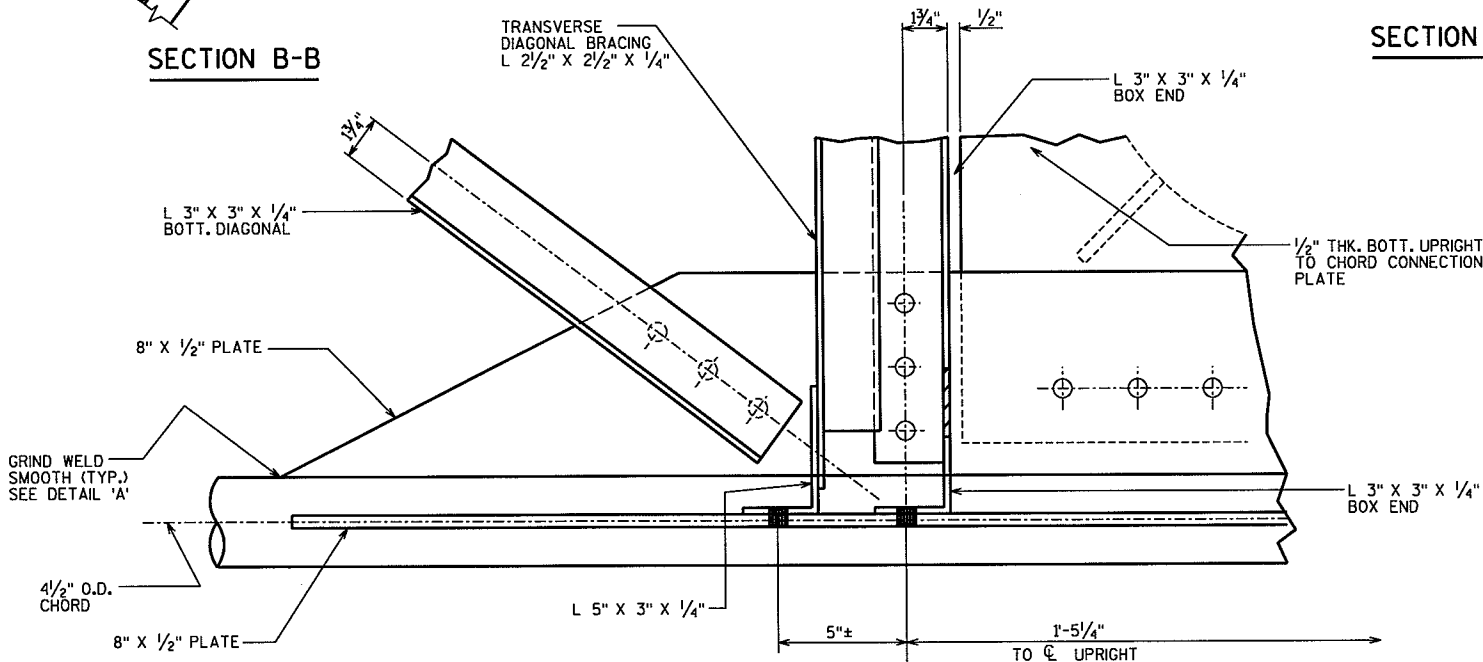


SECTION G-G


(LOOKING DOWN @ BOTT. HORIZ. PLANE @ FRONT CHORD)

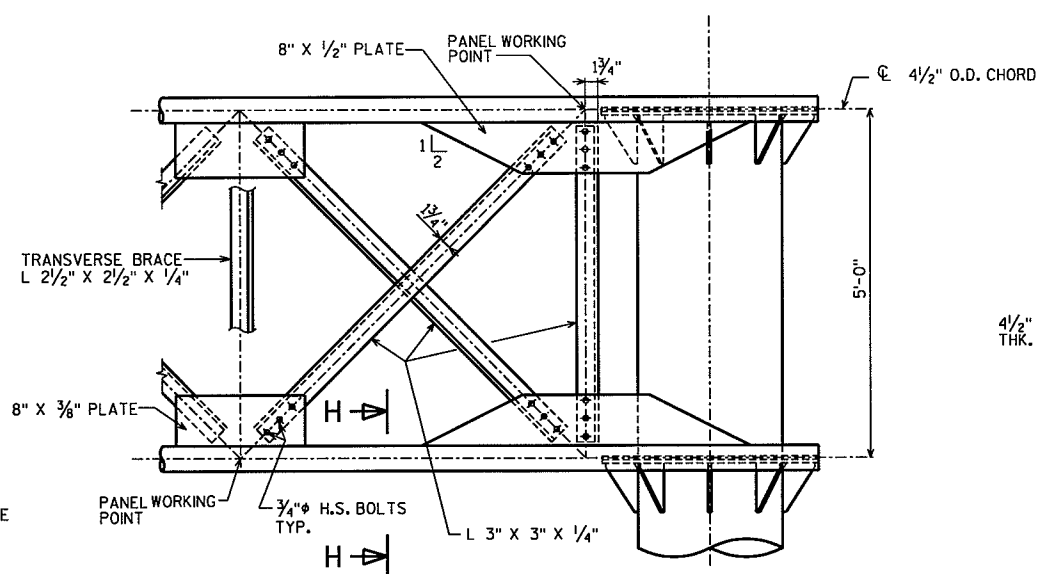


ELEVATION TRUSS TO UPRIGHT

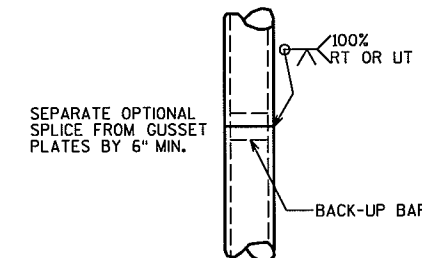



OPTIONAL COLUMN OR CHORD SPLICE DETAIL

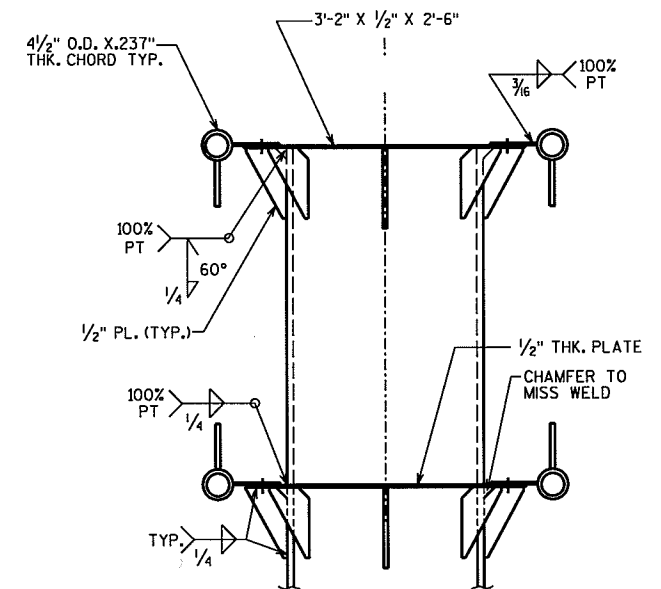

END VIEW TRUSS TO UPRIGHT

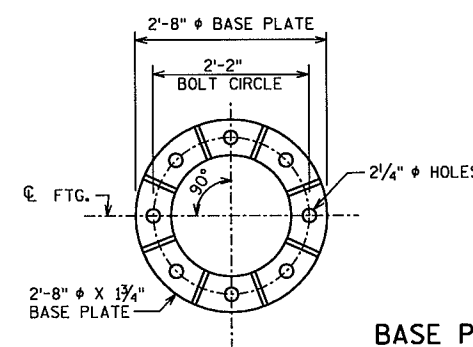

BASE PLATE DETAILS

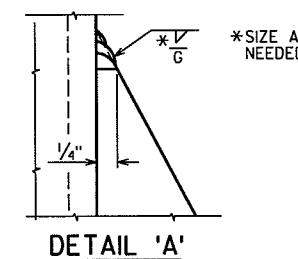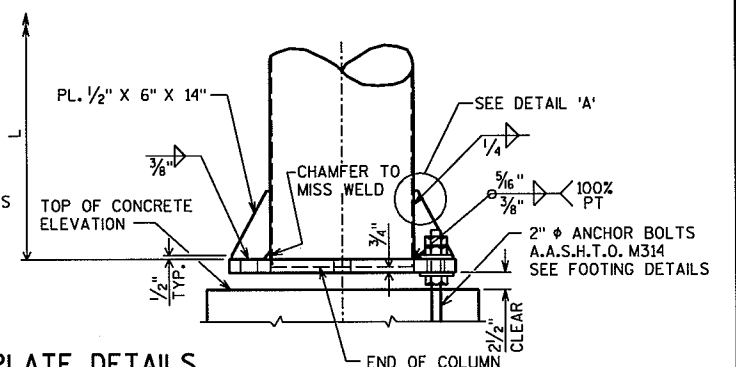

DETAIL 'A'

No.	Date	Revision	By
STATE OF WISCONSIN DEPARTMENT OF TRANSPORTATION			
STRUCTURE S-37-55			
Const. Spec. WI "03"	Drawn By RLR	Plans Checked DHW	
GALVANIZED STEEL CANTILEVER SIGN TRUSS DETAILS			SHEET 9 OF 9