UTILITY WORKSHEET

DT2236 6/2009 s.84.063 Wis. Stats.

Utility Company Name	PLEASE RETURN THIS WORKSHEET BY
ANR Pipeline	November 20, 2018
Project Description – Include Project ID, Title, Limits, Highway, County	RETURN TO
Design Project ID: 6590-02-05	John Beckfield
Construction Project ID: 6590-02-75	CBS Squared, Inc.
WAUPACA - CLINTONVILLE	770 Technology Way
WCL RR BRIDGE - STH 110S	Chippewa Falls,WI 54729
STH 022, Waupaca County	jbeckfield@cbssquaredinc.com

1. Describe your proposed relocation plan for the above project, as requested in the enclosed letter, using highway stationing whenever possible. Attach extra sheets if needed.

TransCanada (ANR Pipeline) has a 24" gas pipeline that crosses STH 022 about 250' NE of the intersection of STH 022 & Sunny View Road. The scope of work at this location is a mill re-lay of the existing pavement. Relocation of the pipeline is not required to accommodate this construction.

2. Conflicting utility facilities will need to be relocated prior to construction. If this is not feasible, provide an explanation and an indication of what work will require coordination with the highway contractor during construction.

N/A

3.	Anticipated Start Date N/A
4.	Estimated construction time required (In working days) N/A
_	

5. List the approvals required and the expected time schedule to obtain those approvals.

N/A

6. Include a list of the real estate parcels that the Wisconsin Department of Transportation (DOT) must have acquired to enable your company to complete the necessary facility installations and relocations prior to construction.

N/A

7. Review the enclosed plans for the above project. Are your facilities correct as shown? If not, list the errors. In some cases, it may be easier to return a marked up copy of the plan. It is very important that your facilities are shown correctly because all construction field personnel will use this information. Uncorrected location errors could create construction delays or damage to utility facilities.

Rev #1; The plans do not show the location of the 24" pipeline crossing STH 022. See attached plan mark-up showing the pipeline crossing location.

8. Is this work dependent on work by other utilities? If so, which other utilities, and what time schedule has been coordinated with them?

N/A

10

11.

9. Please provide the name, address, telephone number and e-mail address of the field contact person for this project, so that we may place this information on the highway plan.

Name Todd Brister
Address W 3925 Pipeline Lane
City, State, ZIP Code Eden, WI, 53019
Area Code - Telephone Number Area Code - Telephone Number (Mobile) 920-477-2235 920-979-0060
E-mail Address Todd_Brister@transcanada.com
List any other relevant information that may impact the ultimate goal of preventing construction delay due to uncertain scheduling of utility facility relocations.
N/A
Yes No No No No No No No No

	Does the line have any remaining product?
	Does the line have any asbestos wrap or any other hazardous materials associated with it?
	Does any part of the line conflict directly with the proposed highway project? If so, what
	arrangements have been made to remove those portions? This should be mentioned as part of your work plan in question number 1 on this form.

Is there any reason the highway contractor cannot remove portions of the line left in pla		Is there any reason th	e highway contractor	cannot remove p	portions of the line	left in place?
-------------------------------------------------------------------------------------------	--	------------------------	----------------------	-----------------	----------------------	----------------


If you answered "Yes" to any of the questions above, please attach additional pages.

involved?

Preparer Area Code – Telephone #, Ext.	er Area Code – Telephone #, Ext. Preparer E-Mail Address	
248-205-7550	lawrence_jaskowiec@transcanada.com	
	L.J. Jaskowiec, P.E.	10/17/2018

(Name of Person Who Prepared this Worksheet)

NOTE DOT will be sending to you a Trans 220 Work Plan Approval letter and a Start Work Notice after we complete the review of your Work Plan.

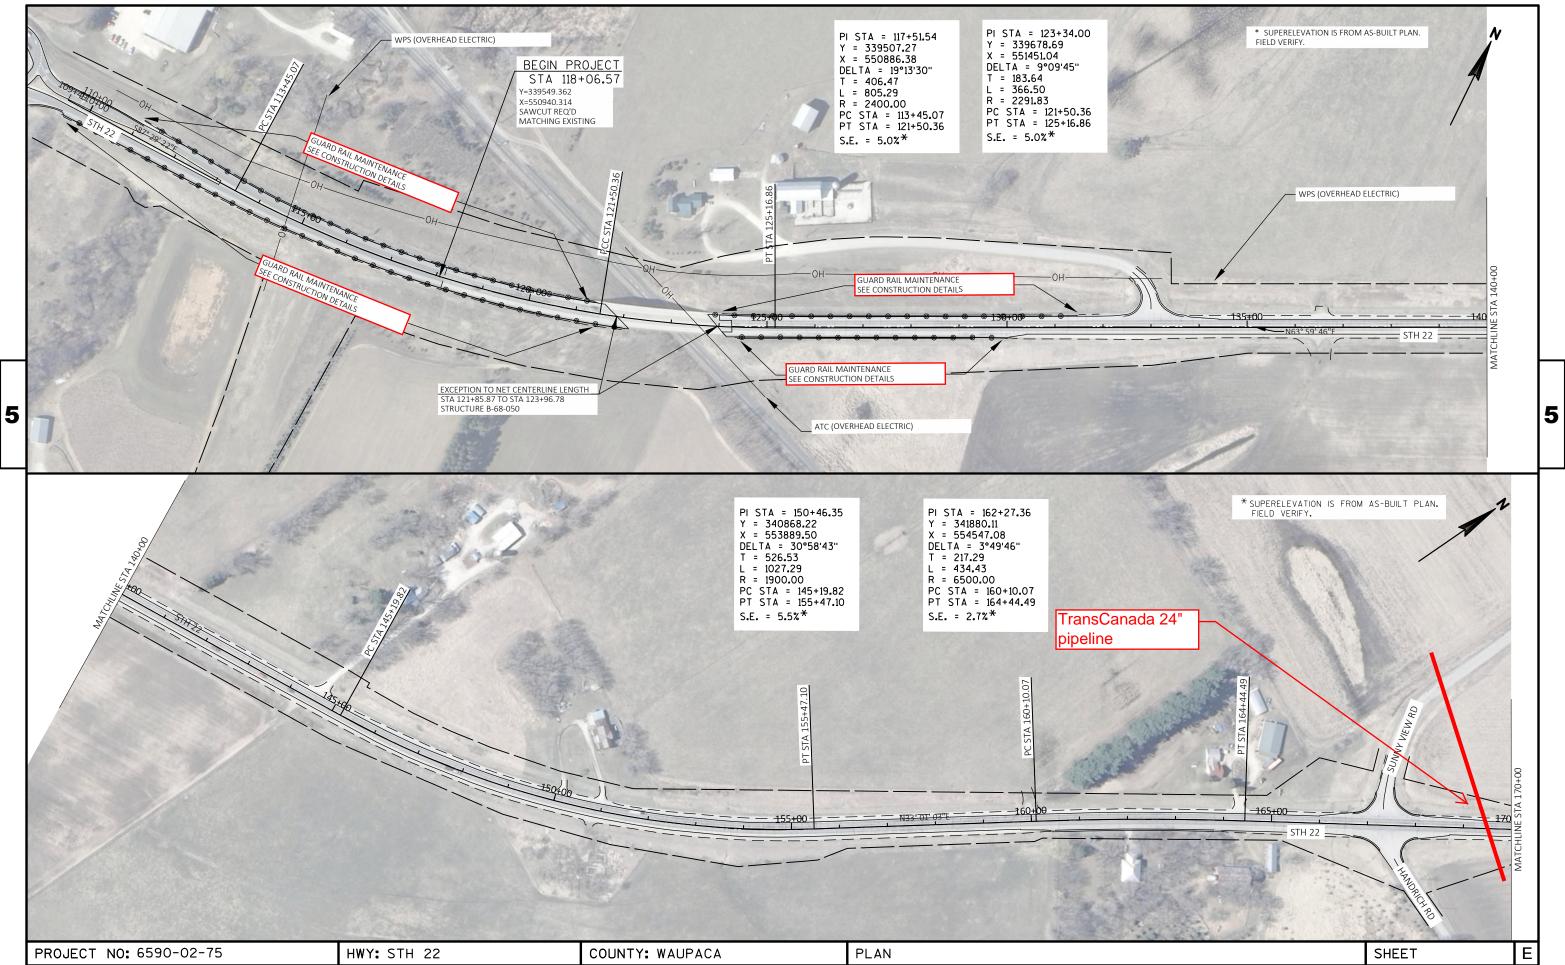

FILE NAME : N: \PDS\C3D\65900205\SHEETSPLAN\PPSTH22.DWG

SHEET NAME: PPSTH22 (1)