

INDEX OF SHEETS

Sheet No. 1	Title
Sheet No. 2.1-2.162	Typical Sections and Details
Sheet No. 3.1-3.11	Estimate of Quantities
Sheet No. 3A-3.44	Miscellaneous Quantities
Sheet No. 4.1-4.23	Right of Way Plot
Sheet No. 5.1-5.49	Plan and Profile
Sheet No. 6.1-6.51	Standard Detail Drawings
Sheet No. 7.1-7.33	Sign Plates
Sheet No. 8.1-8.5	Structure Plans
Sheet No. 9.1-9.2	Computer Earthwork Data
Sheet No. 9.3-9.77	Cross Sections

TOTAL SHEETS = 446

DIARY TYPE: FIELD MANAGER

CONSTRUCTION START: 3/19/2001
OPEN TO TRAFFIC: 11/15/2001
CONSTRUCTION FINISH: 11/27/2002



DESIGN DESIGNATION

A.D.T. 2000	=	23,540
A.D.T. 2020	=	33,440
D.H.V. 2020	=	3,280
D.	=	60-40
T. (% D.H.V.)	=	8.2%
DESIGN SPEED	=	60 km/h (S.T.H. 23)
	=	30 km/h (FRONTAGE ROAD)
ESALS	=	N/A

CONVENTIONAL SYMBOLS

COUNTY LINE	---
CORPORATE LIMITS	---
PROPERTY LINE	---
LOT LINE	---
LIMITED EASEMENT	---
EXISTING RIGHT OF WAY	---
PROPOSED OR NEW R/W LINE	---
SURVEY LINE	---
SLOPE INTERCEPT	---
ORIGINAL GROUND	---
MARSH OR ROCK PROFILE	---
EXISTING CULVERT	---
PROPOSED CULVERT (Box or Pipe)	---
ERT (Profile View)	---
ALL FLUIDS	---
UNDERGROUND UTILITIES	---
GAS	---
ELECTRIC	---
TELEPHONE OR TELEGRAPH	---
FIBER OPTIC	---
WATER MAIN	---
WATER MAIN (PROPOSED)	---
SANITARY SEWER	---
SANITARY SEWER (PROPOSED)	---
SERVICE PEDESTAL	---
CABLE MARKER	---
POWER POLE	---
TELEPHONE POLE	---
LIGHT	---
RAILROAD	---
MARSH AREA	---
WOODED OR SHRUB AREA	---

STATE OF WISCONSIN DEPARTMENT OF TRANSPORTATION PLAN OF PROPOSED IMPROVEMENT

PROJECT MANAGER: MARK KLIPSTEIN
PROJECT ENGINEER: CRAIG MCKINNEY
ASSISTANT ENGINEER: ROBERT ANDERSON
PROJECT PERSONNEL: JANELLE HILT
TRAVIS KLOETZKE
DAKE BRANSON
JOAN BONACK
JAY PANETTIZ
DAVE ROBERTS
STEVEN GRAETZ

JOHNSON STREET
EAST OF PIONEER ROAD TO EAST OF MAIN STREET
S.T.H. 23
FOND DU LAC COUNTY

STATE PROJECT NUMBER
1442-04-70

PRIME CONTRACTOR: ZIGNEGO
SUBCONTRACTORS:
DORNOR-STAHLL, INC.; WATER, SANITARY AND
STORM SEWER CONSTRUCTION
EARTH TECH, INC.; CONSTRUCTION STAKING
FERRON CONST.; LIGHTING & SIGNALS
GEO TEST; QMP TESTING
INTERSTATE SAWING CO., INC.; PAVEMENT SAWING
MICHELS CORP.; PIPE UNDER DRAIN CONSTRUCTION
MIRRS TREE SERVICE; CLEARING & GRUBBING
MUSSON BROS., INC.; REMOVALS & GRADING
NORTHEAST ASPHALT, INC.; ASPHALT PAVING
RADEMANN STONE & LANDSCAPE CO., INC.;
LANDSCAPING & EROSION CONTROL
SYKES CONSTRUCTION; BOX CULVERT CONSTRUCTION

METRIC PLAN
TSM; TRAFFIC CONTROL
BRICKLINE INC; PAVEMENT MARKING

ACCEPTED FOR
CITY OF FOND DU LAC

8-28-00
Date
Signature
Director of Public Works

ORIGINAL SANITARY SEWER AND WATER MAIN
PLANS PREPARED BY
THE CITY OF FOND DU LAC AND
KAEMPFER & ASSOCIATES, INC.



8-28-00
Date
Signature

ORIGINAL PLANS PREPARED BY

BRW
13255 W. Bluemound Rd.
Suite 202
Brookfield, WI 53005
262-782-7281



8-31-00
Date
Signature


STATE OF WISCONSIN
DEPARTMENT OF TRANSPORTATION

PREPARED BY
Surveyor
Designer
District Examiner
District Supervisor
Proj. Dev. Engineer
C. O. Examiner
KL Engineering, Inc.
BRW, Inc.
M.A.K.
J.M.F.
M.E.H.
E.N.B.

APPROVED FOR DISTRICT OFFICE
DATE: 9/1/00
Signature
Mark Klipstein

AUTHORIZED FOR BUREAU OF HIGHWAY OPERATIONS
DATE: 11/15/00
Signature
Mark Klipstein

AUTHORIZED FOR BUREAU OF HIGHWAY DEVELOPMENT
DATE: 11/15/00
Signature
Mark Klipstein

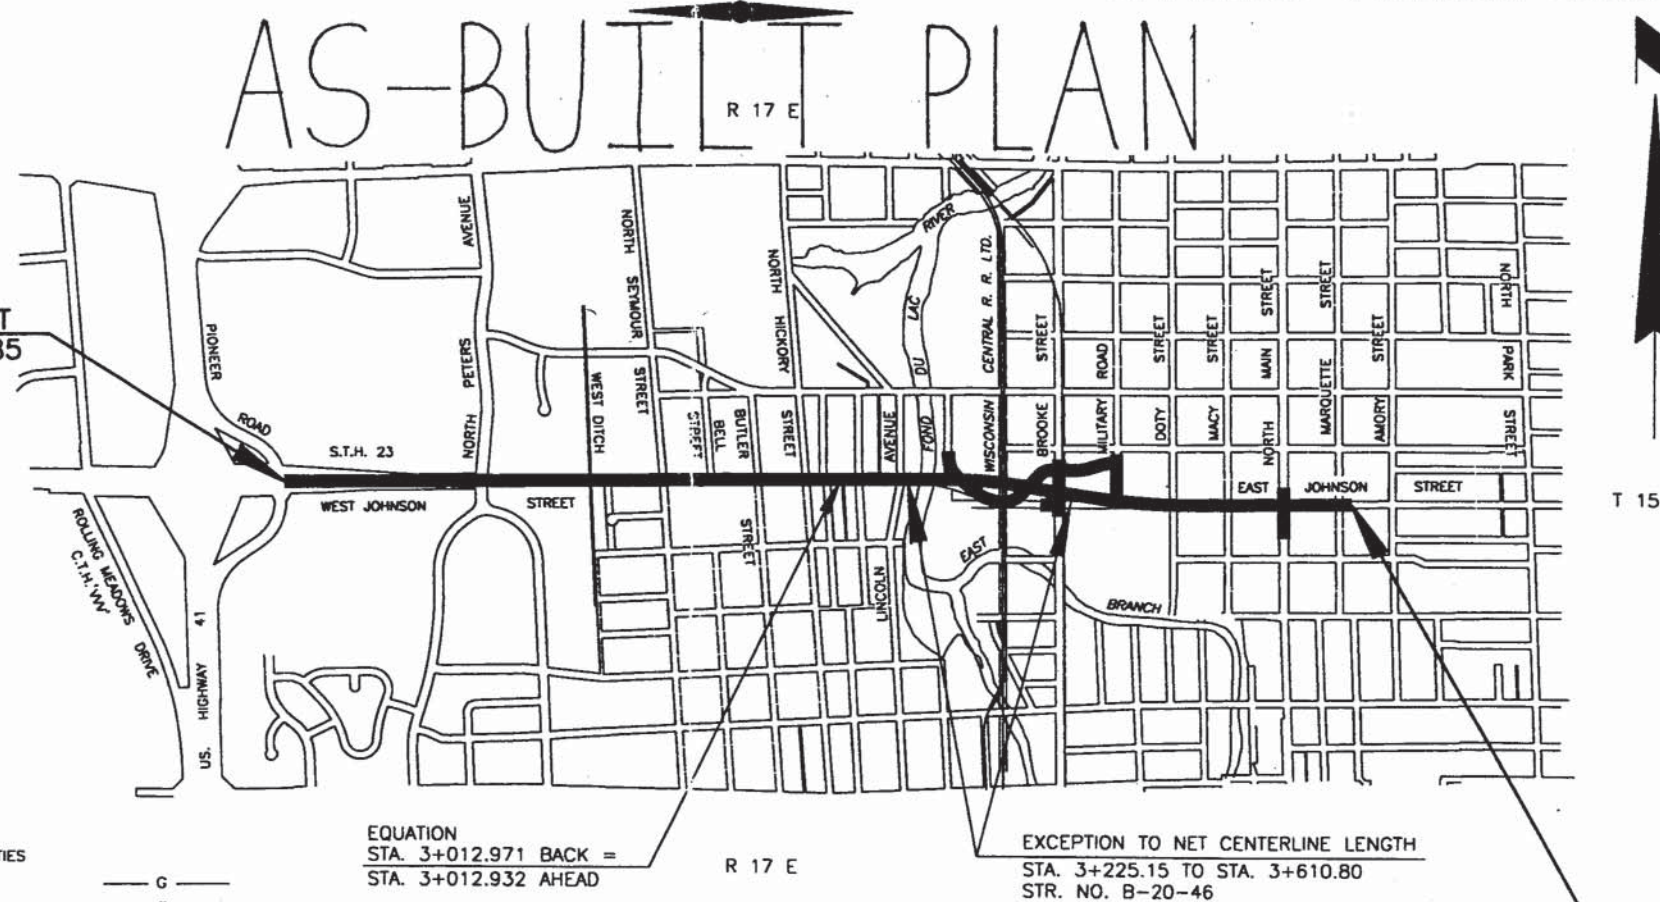

EQUATION
STA. 3+012.971 BACK =
STA. 3+012.932 AHEAD

EXCEPTION TO NET CENTERLINE LENGTH
STA. 3+225.15 TO STA. 3+610.80
STR. NO. B-20-46

END PROJECT
STA. 4+360.000

LAYOUT
SCALE 0 250 m

TOTAL NET LENGTH OF CENTERLINE = 2.411 km (URBAN)

ALL COORDINATES SHOWN ON THIS PLAN ARE GROUND (N, E)
COORDINATES AND ARE REFERENCED TO THE WISCONSIN
STATE PLANE COORDINATE SYSTEM, SOUTH ZONE, NAD83(91).

TO CONVERT COORDINATES SHOWN ON THIS PLAN TO GRID
(Y, X) COORDINATES, MULTIPLY BY 0.9999143.

ALL ELEVATIONS SHOWN ON THIS PLAN ARE REFERENCED TO
NAVD29.

1442-04-70

FOND DU LAC COUNTY

FILE NAME: P:\JOHNSON\CA00\SHEET23A.TITLE-2