



BRW CAD Sheet - MSECTION
Drawing File : XS1560

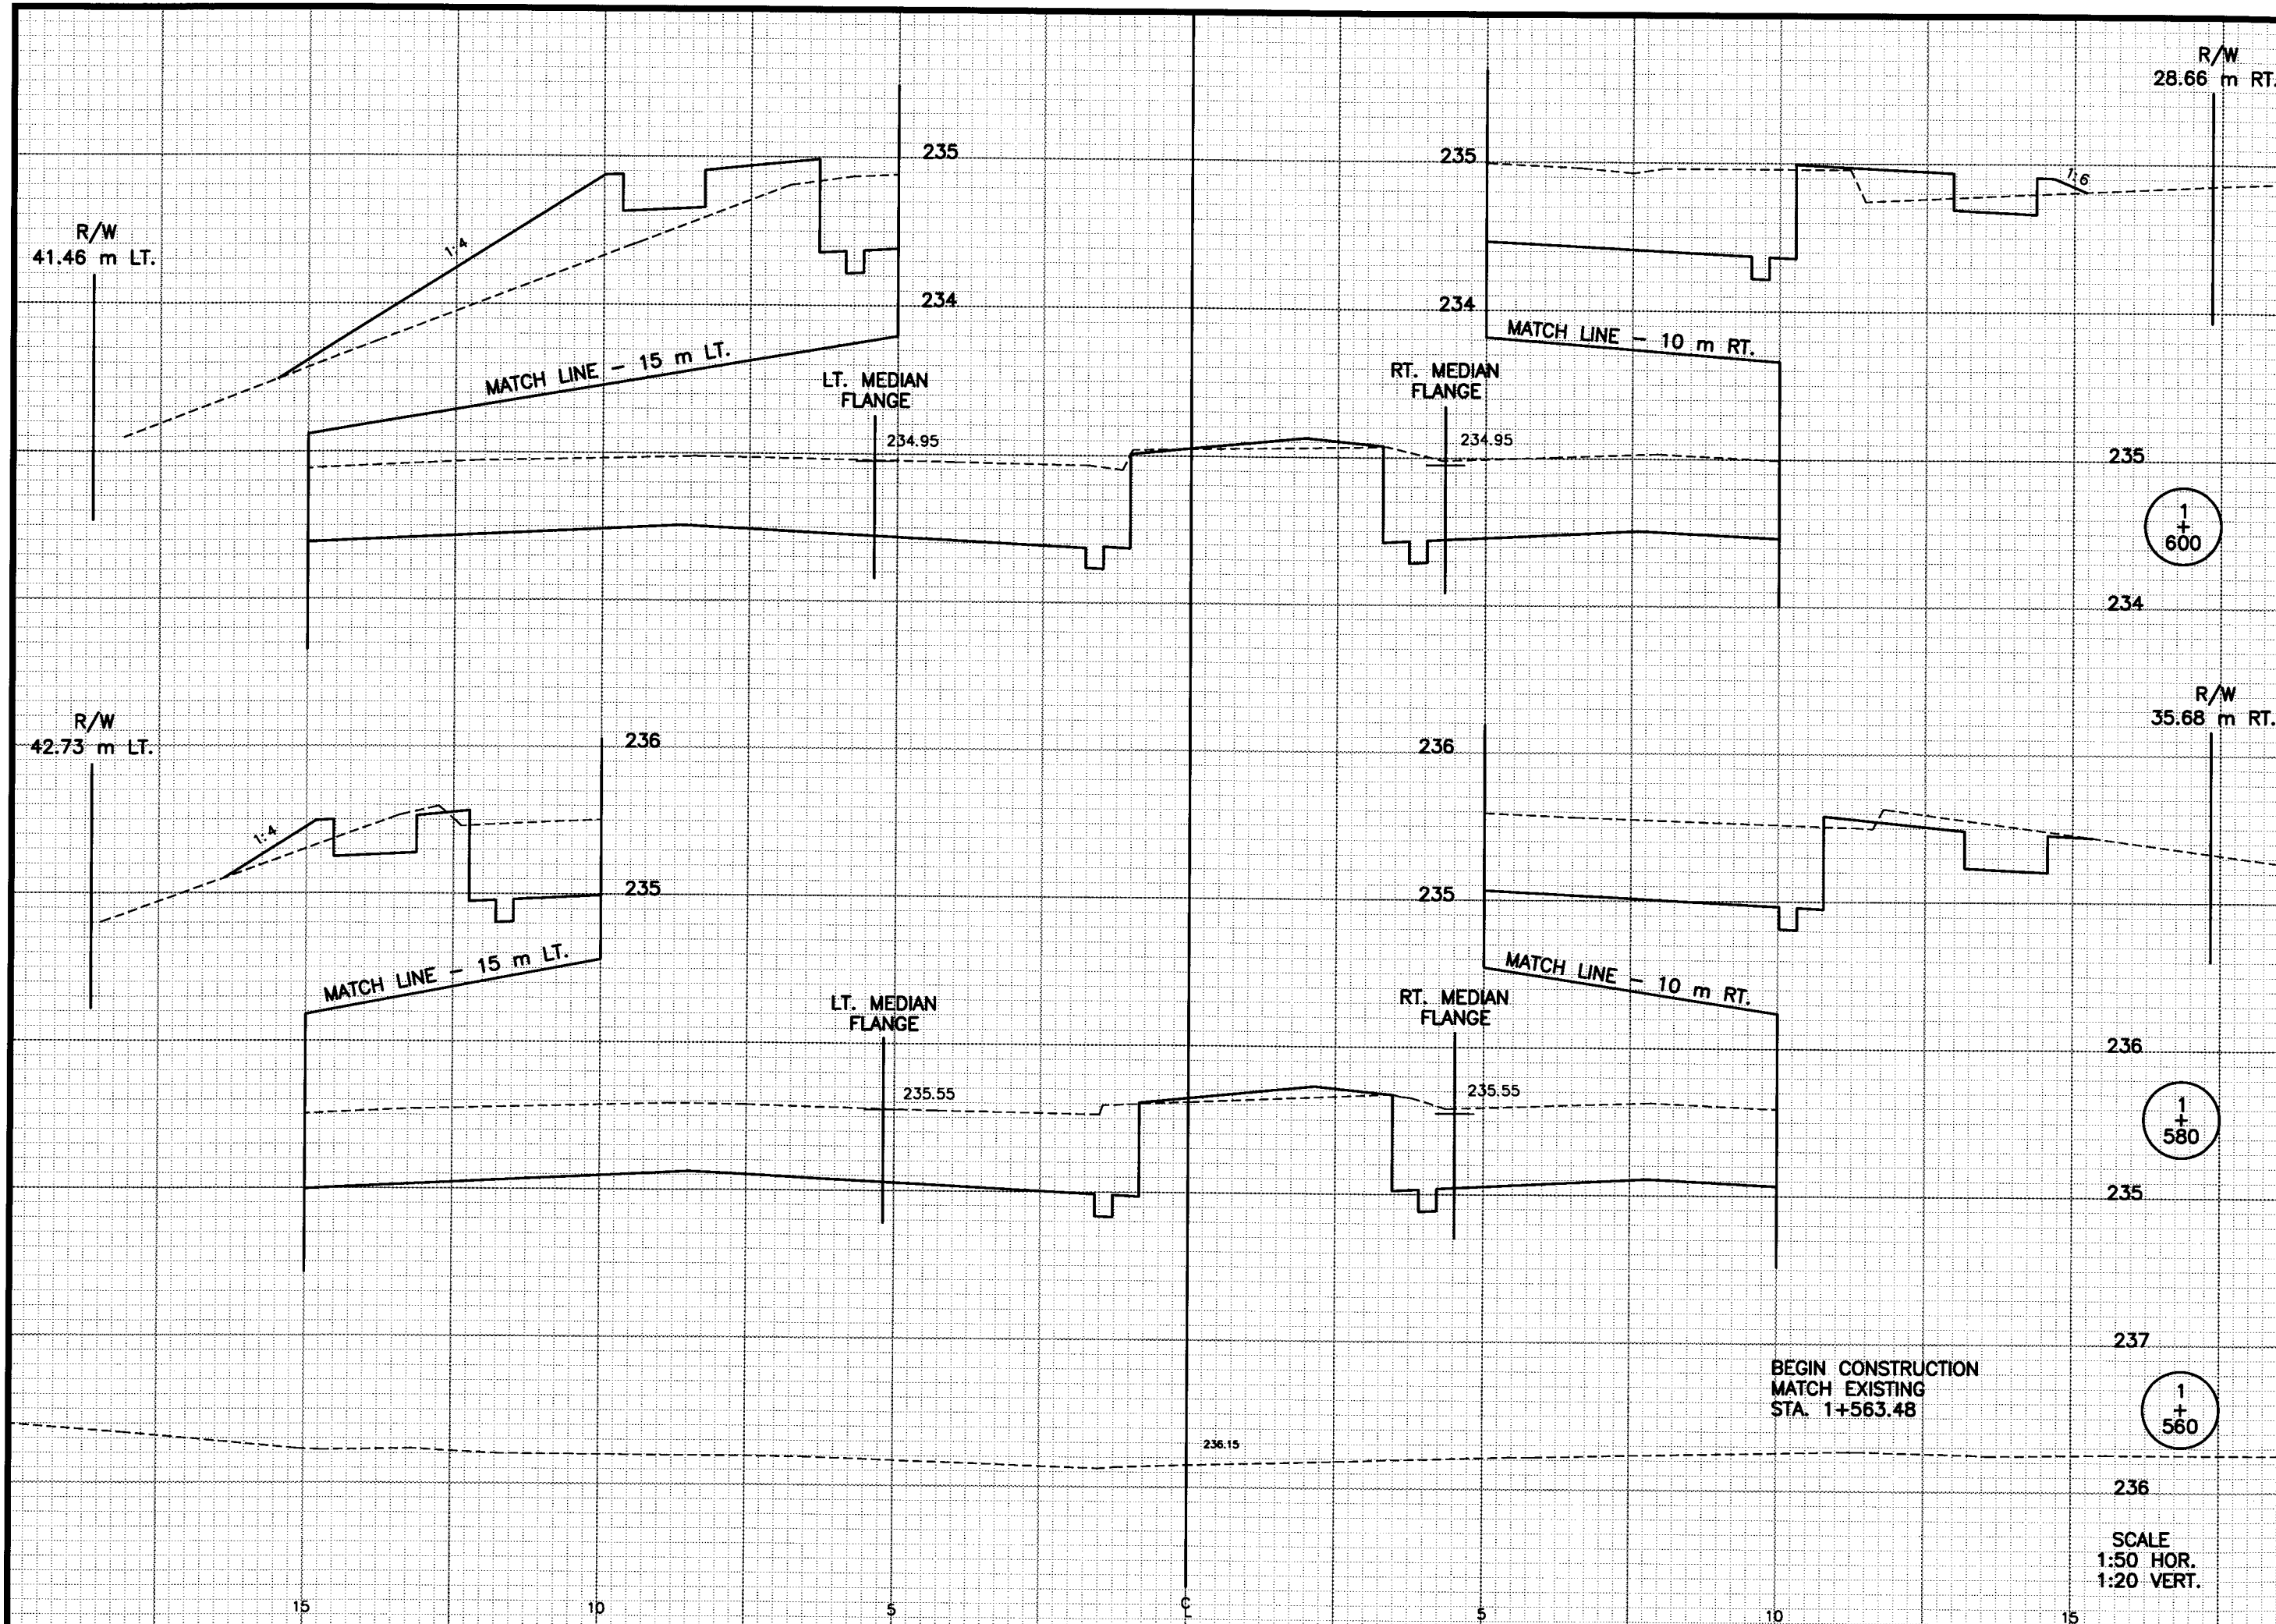

BRW CDD Sheet - MSECTION
Drawing File : XS1620

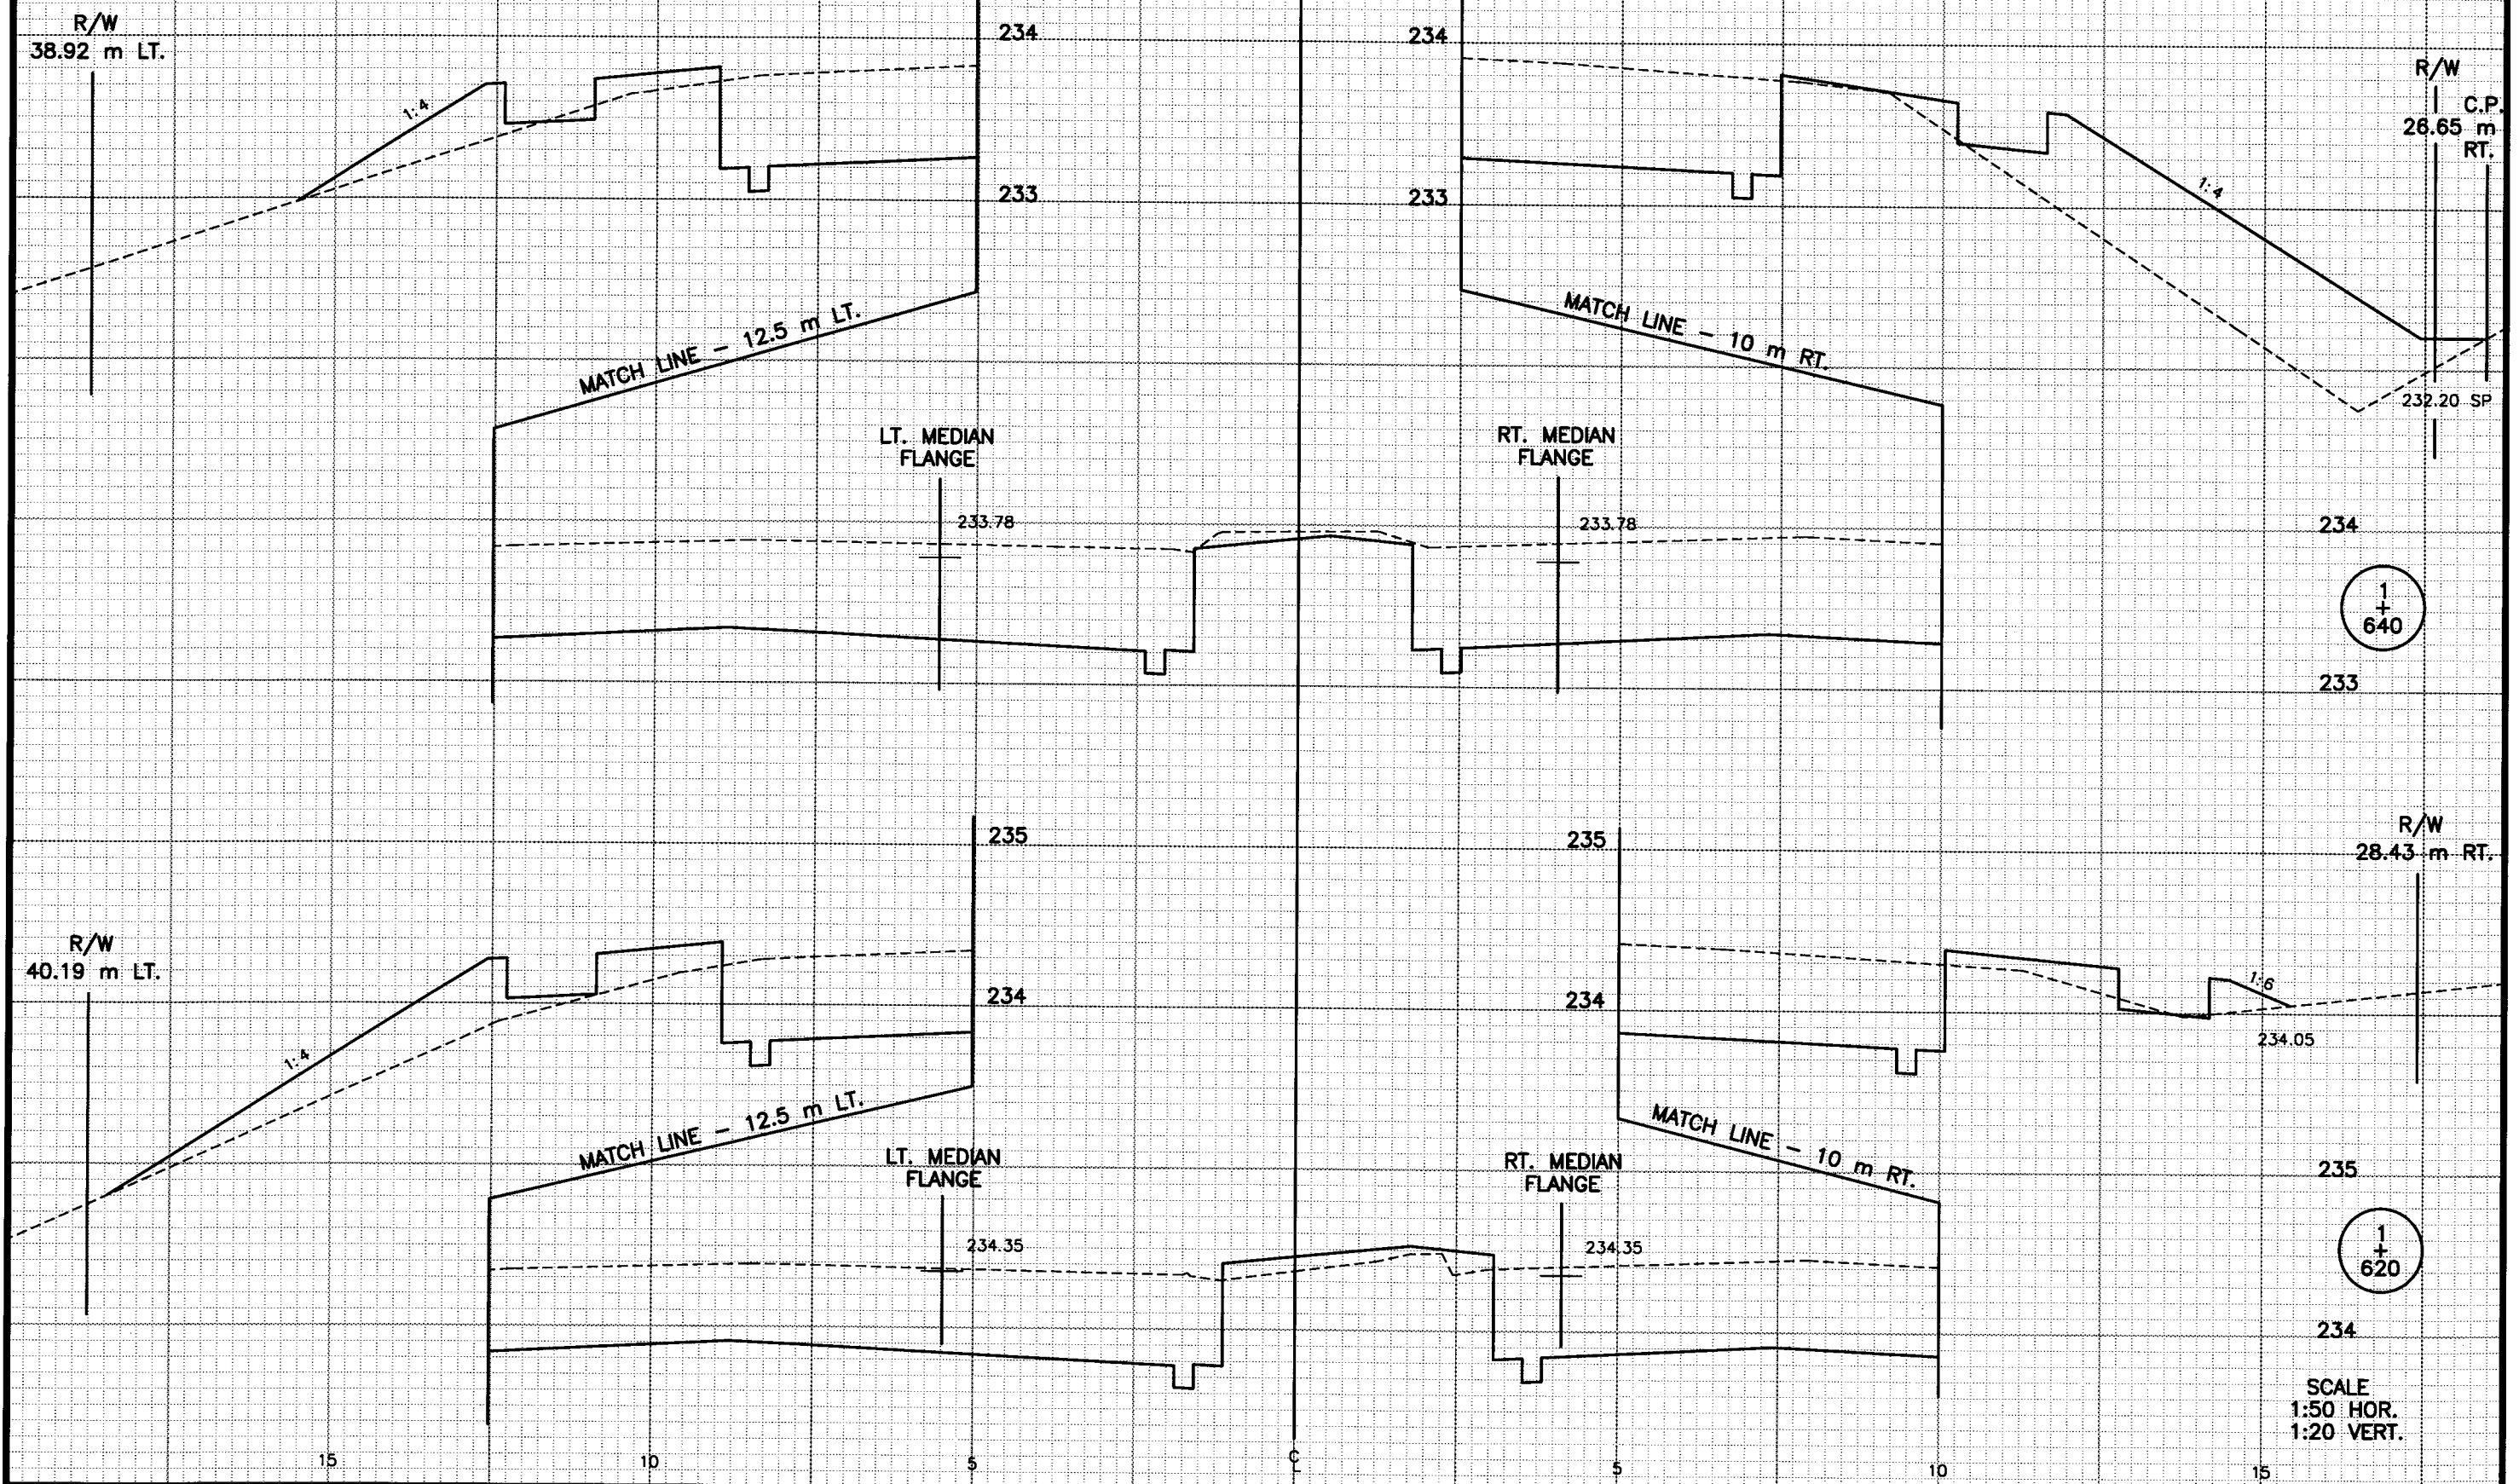

Drawing File : XS1660

BRW CADD Sheet - MSECTION

R/W
36.37 m LT.

R/W
37.65 m LT.

R/W

C.P.

1
+
680

1
+
660

SCALE
1:50 HOR.
1:20 VERT.

CROSS SECTIONS


STA. 1+660 - STA. 1+680

HWY: S.T.H. 23 COUNTY: FOND DU LAC


STATE PROJECT NO.: 1442-04-70

SHEET NO.: 9.5

M

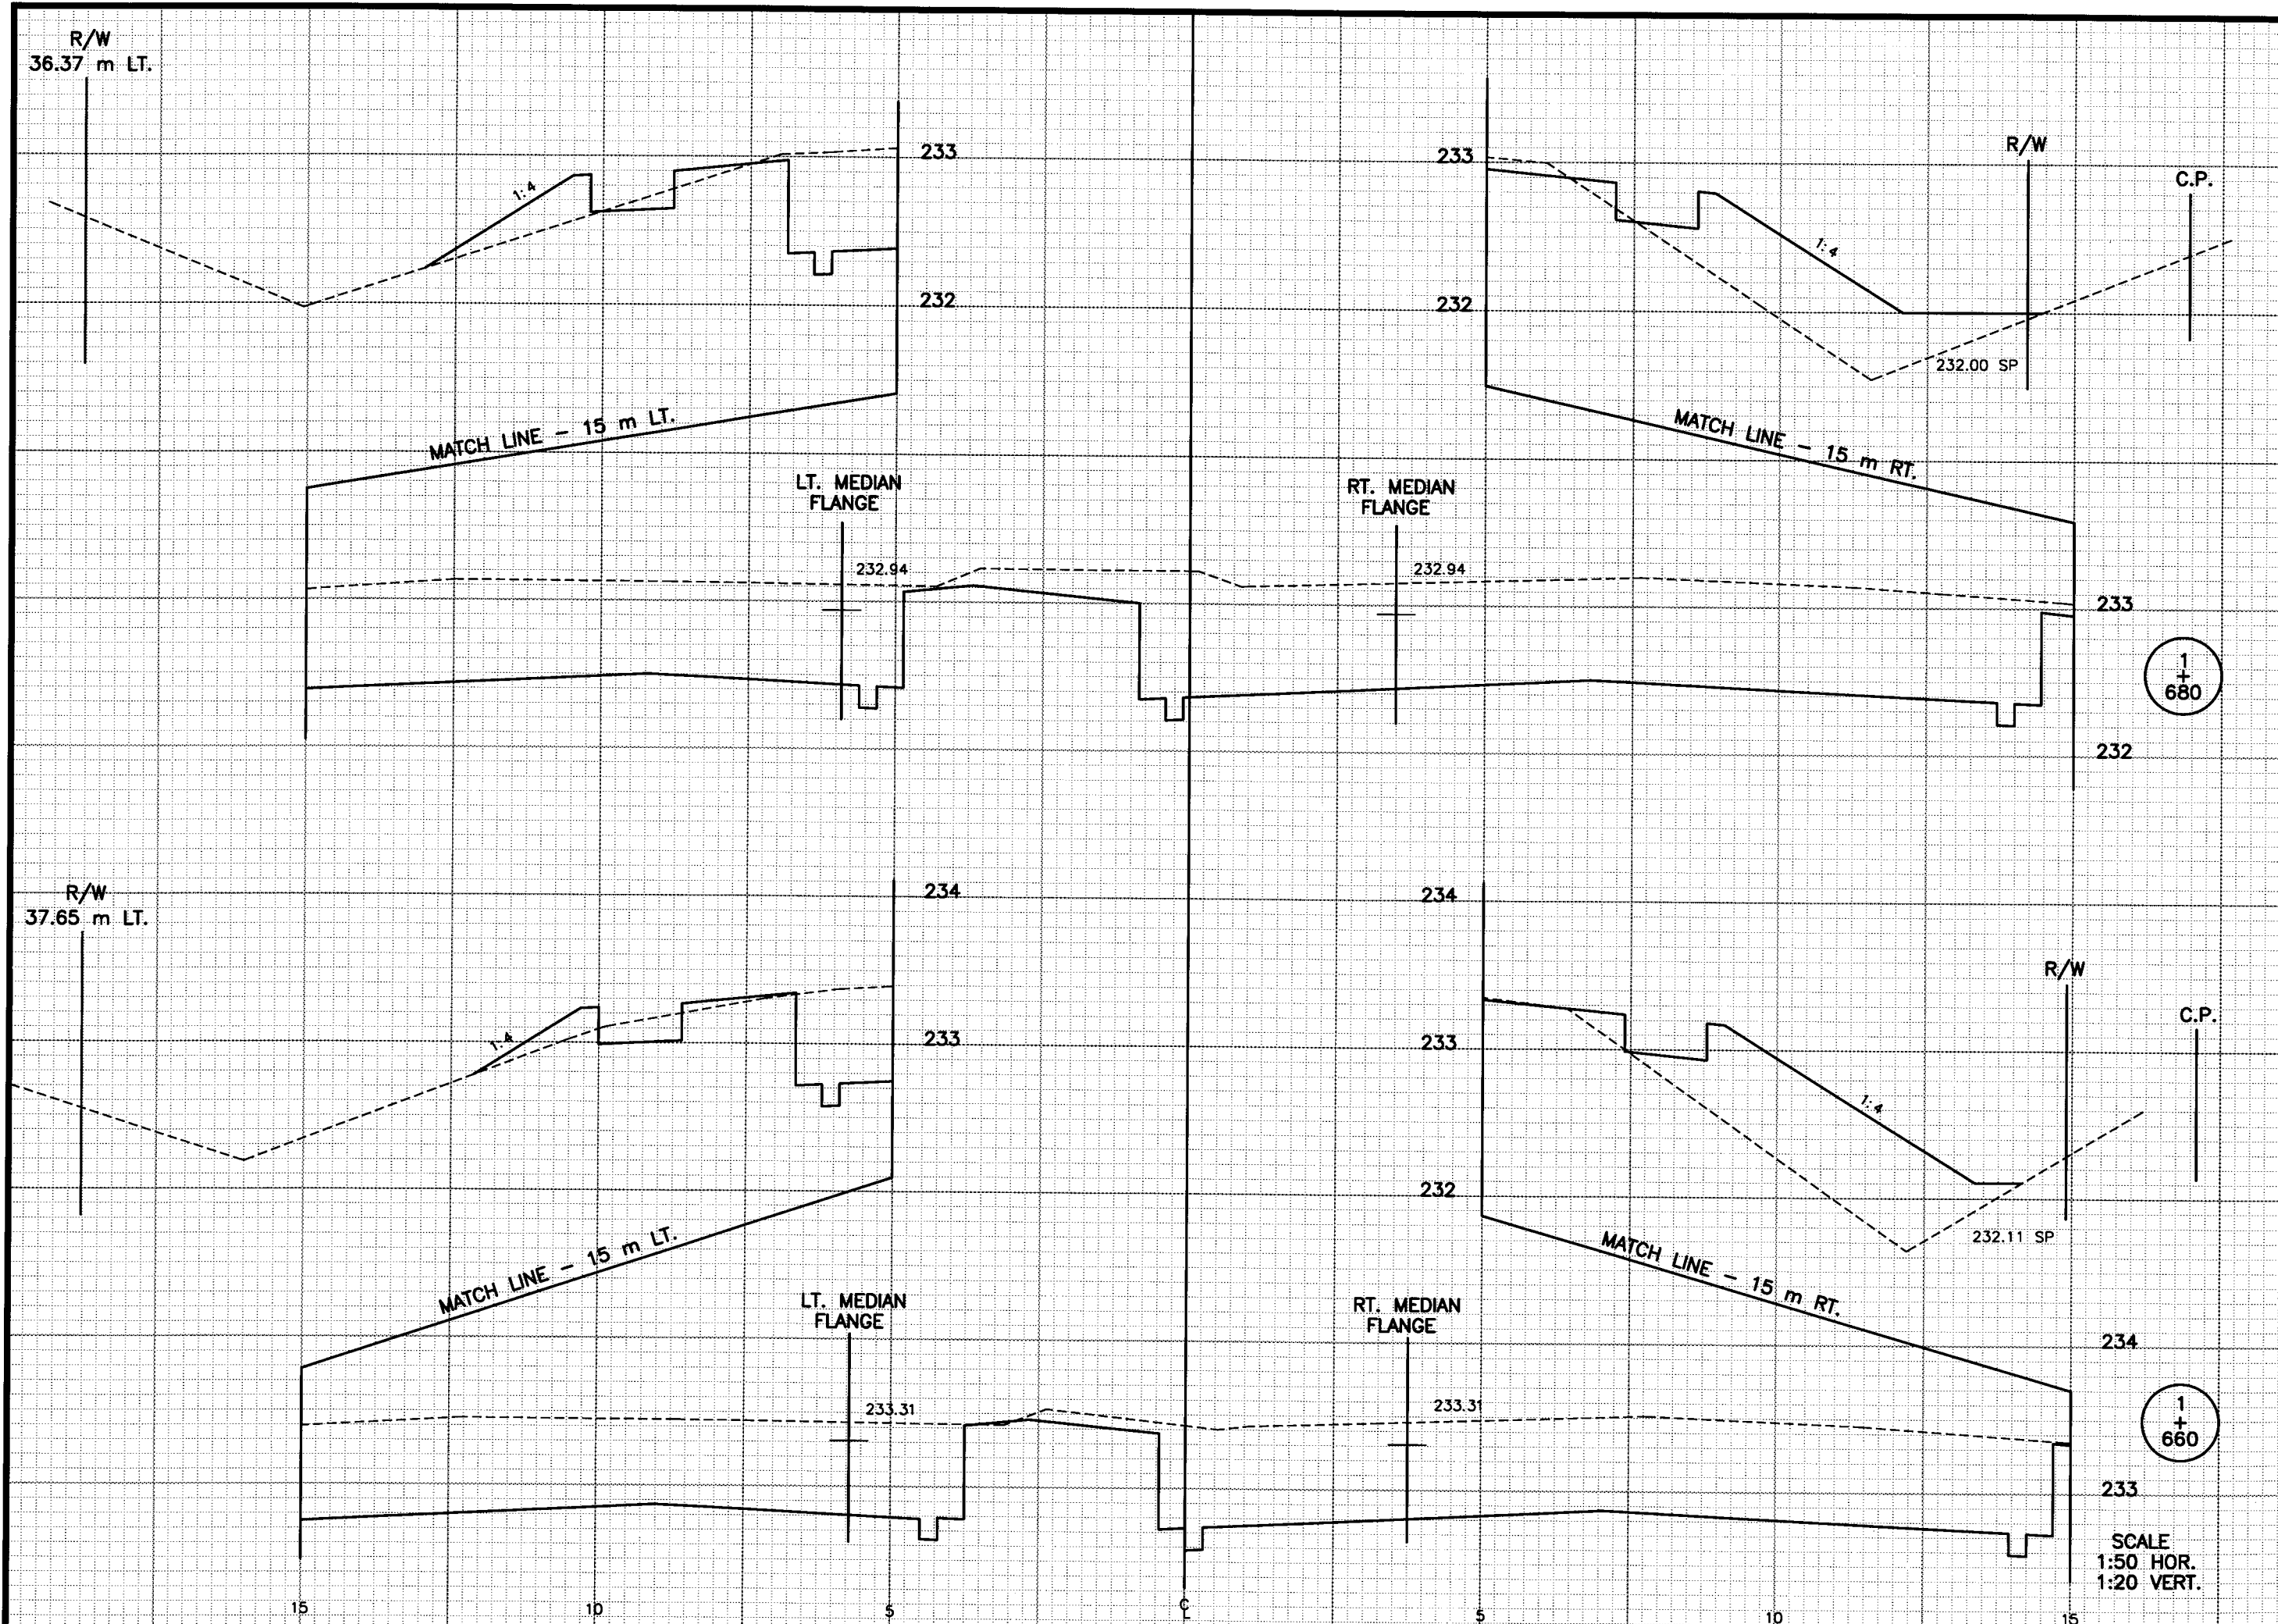

BRW CADD Sheet - MSECTION
Drawing File : XS1700

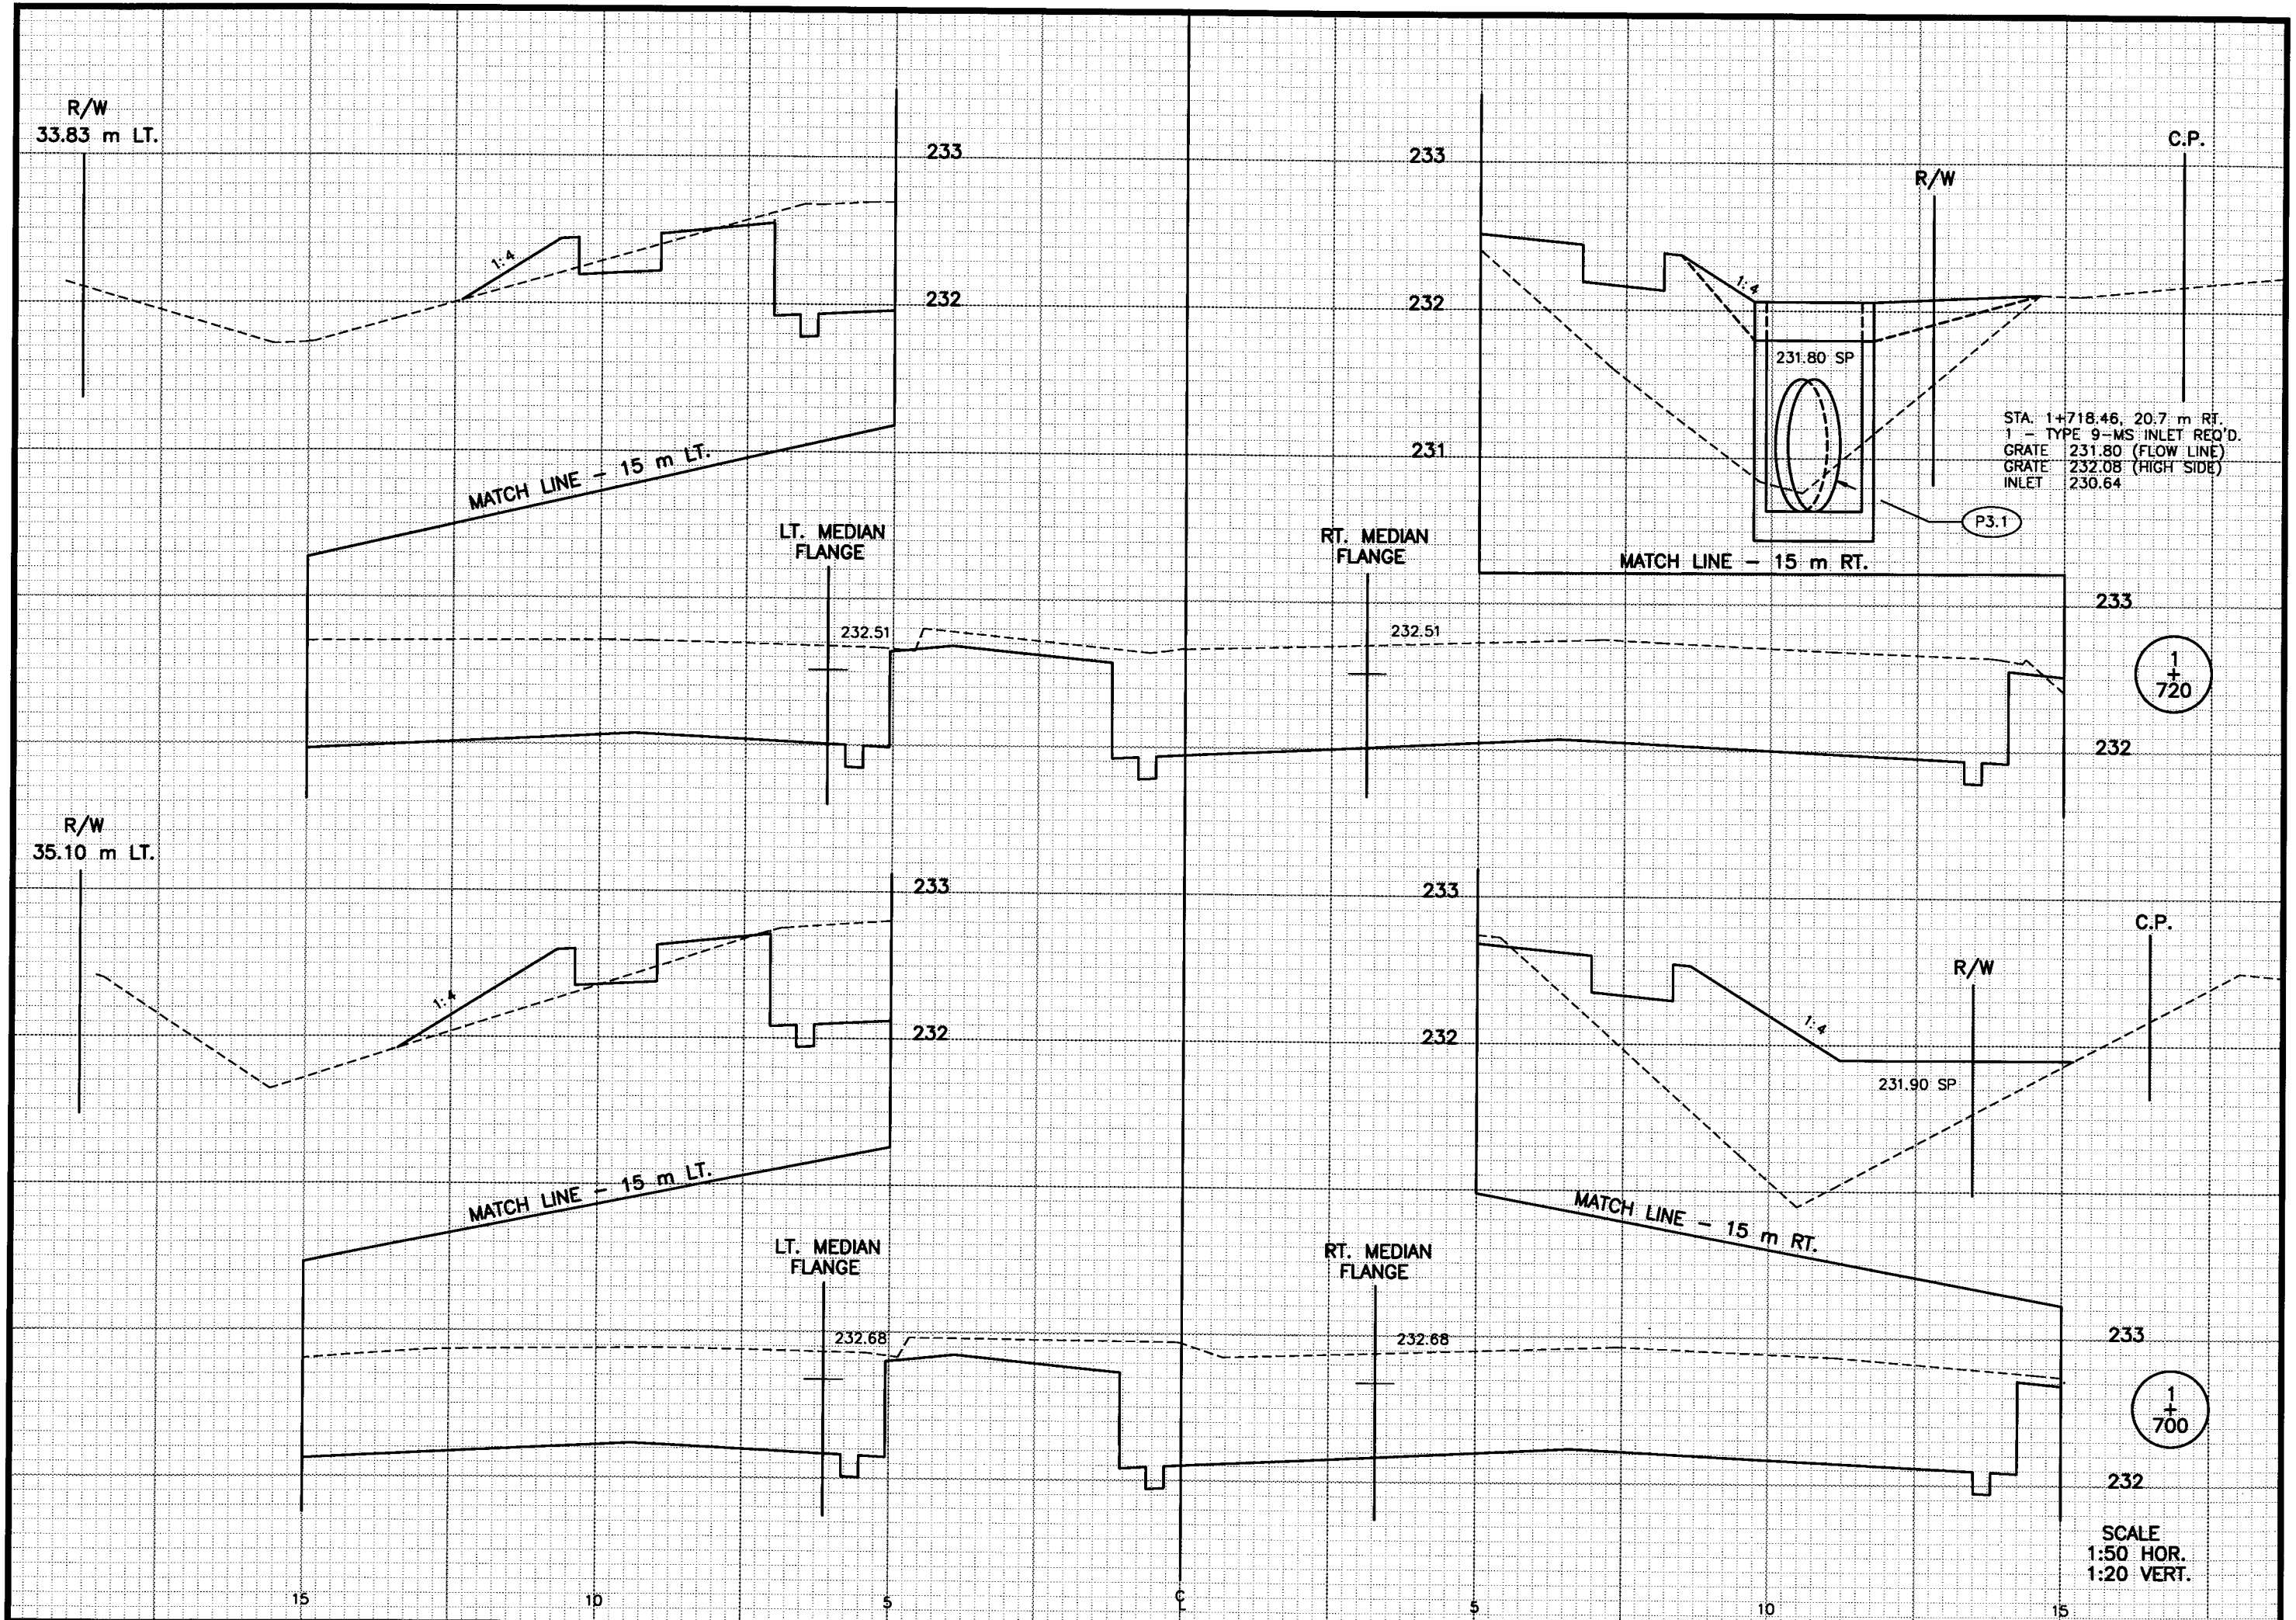

BRW CADD Sheet - MSECTION
Drawing File : XS1740

R/W
31.29 m LT.

1:4

MATCH LINE - 15 m LT.

LT. MEDIAN
FLANGE

232.34

RT. MEDIAN
FLANGE

232.34

R/W

C.P.
26.92 m RT.

MATCH LINE - 15 m RT.

233

1
+
760

232

R/W
32.56 m LT.

MATCH LINE - 12.5 m LT.

LT. MEDIAN
FLANGE

232.43

RT. MEDIAN
FLANGE

232.43

R/W

C.P.
27.03 m RT.

MATCH LINE - 15 m RT.

233

1
+
740

232

SCALE
1:50 HOR.
1:20 VERT.

CROSS SECTIONS

STA. 1+740 - STA. 1+760

HWY: S.T.H. 23 COUNTY: FOND DU LAC


STATE PROJECT NO.: 1442-04-70

SHEET NO.: 9.7

M

BRW CADD Sheet - MSECTION
Drawing File : XS1780

R/W
28.75 m LT.

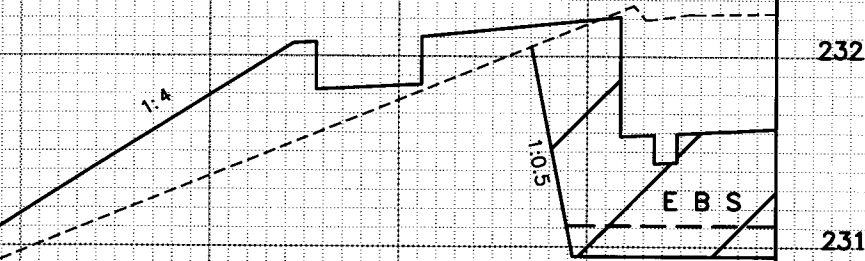

MATCH LINE - 15 m LT.

LT. MEDIAN
FLANGE


232.17

RT. MEDIAN
FLANGE

232.17

APPROX. ELEV. 230.95

R/W

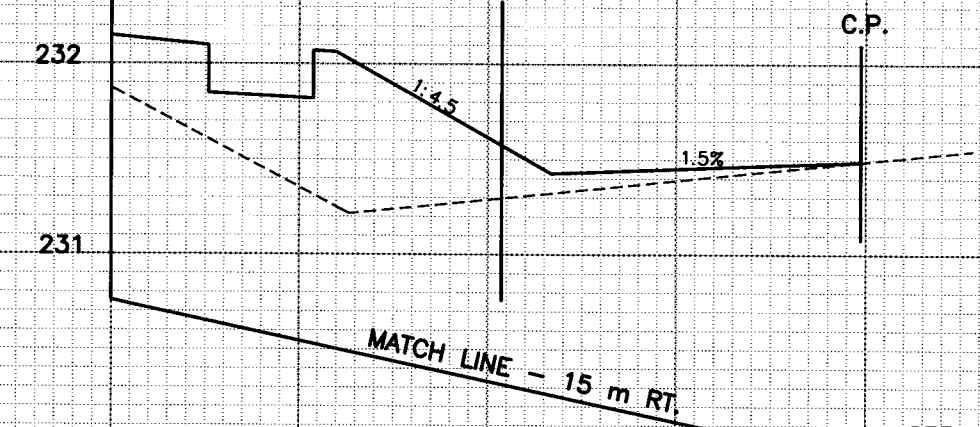

MATCH LINE - 15 m RT.

233


232

231

1
+
800

NOTE: ESTIMATED LIMITS OF EBS ARE
STA. 1+760 - STA. 1+840

R/W
30.02 m LT.

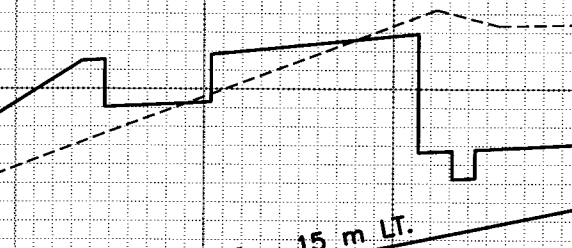

MATCH LINE - 15 m LT.


LT. MEDIAN
FLANGE

232.26

RT. MEDIAN
FLANGE

232.26

R/W

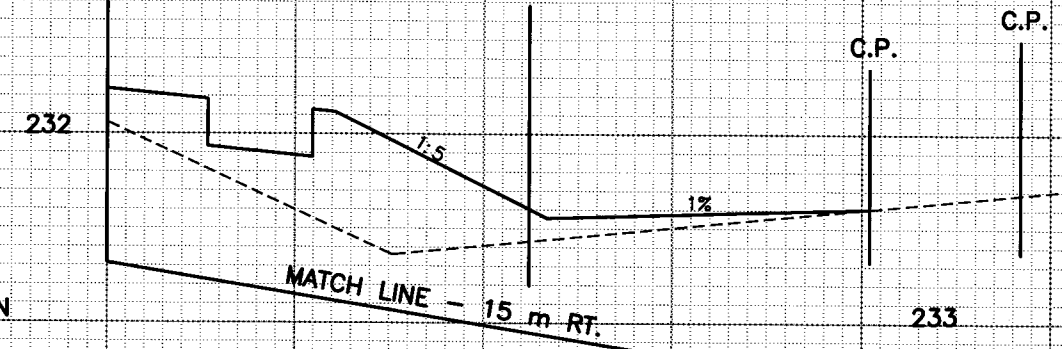

MATCH LINE - 15 m RT.

233


232

231


1
+
780

SCALE
1:50 HOR.
1:20 VERT.

BRW CADD Sheet - MSECTION
Drawing File : XS1820

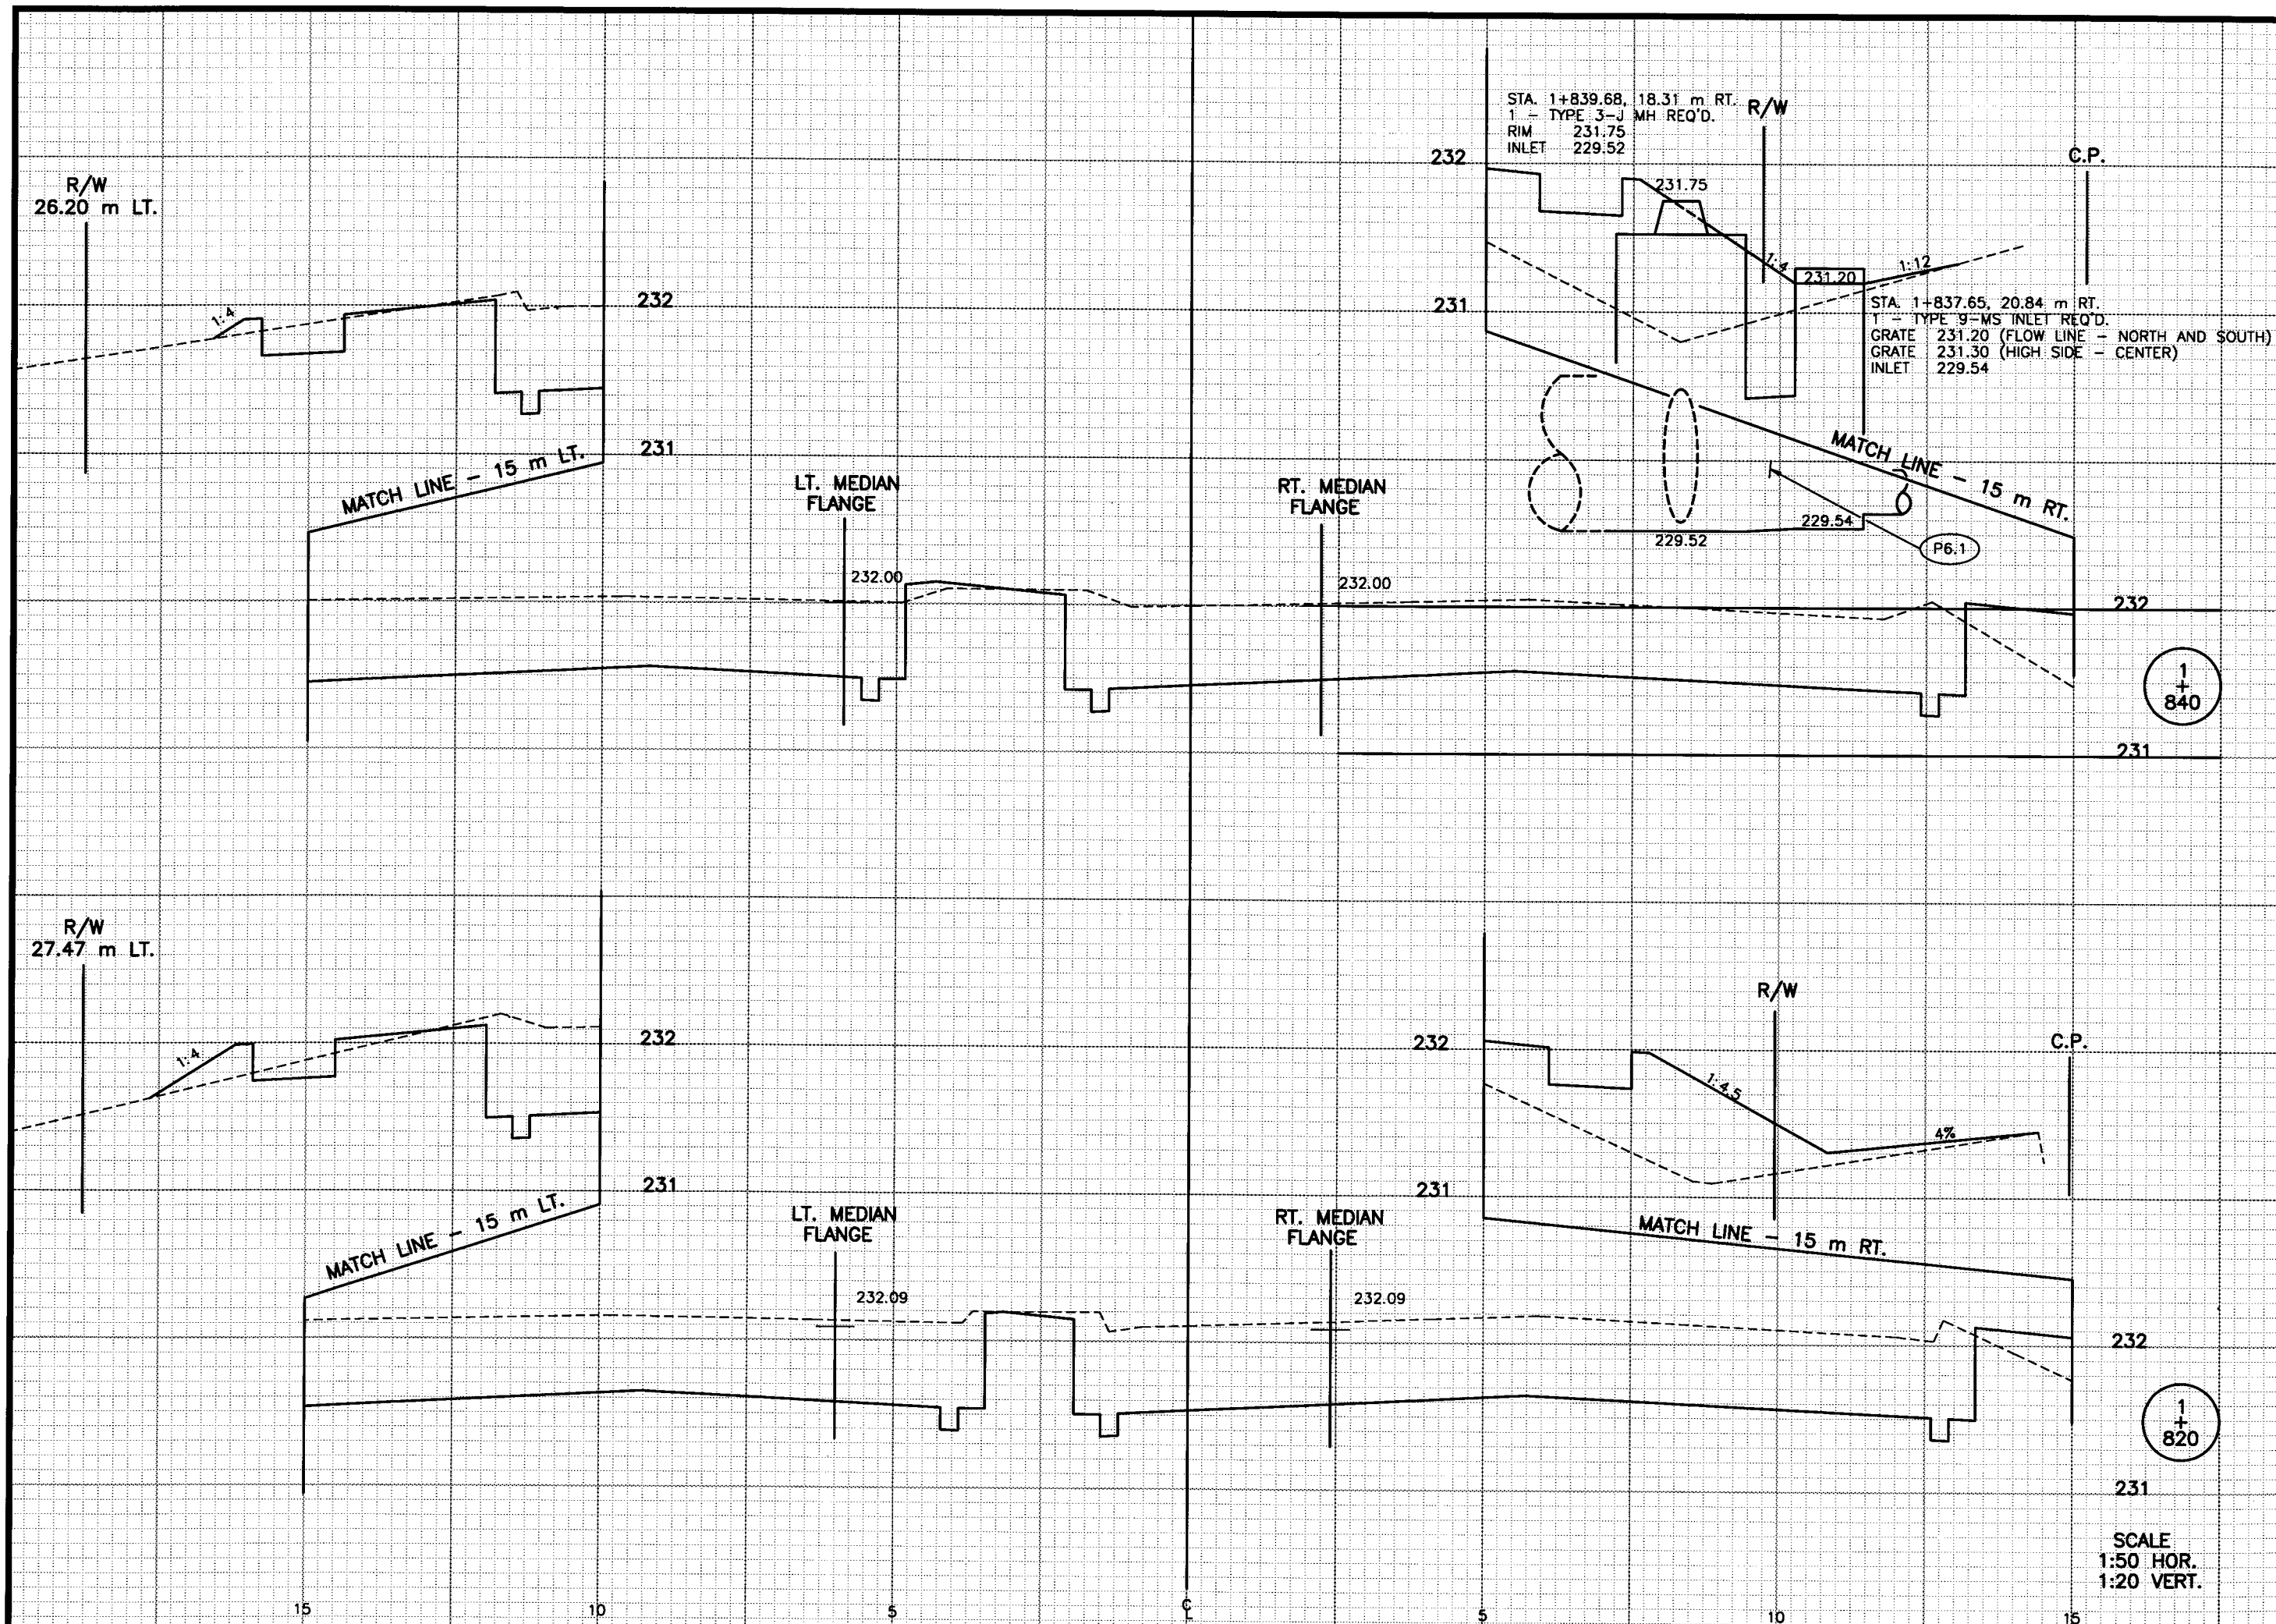

BRW CAD Sheet - INSECTION
Drawing File : XS1860

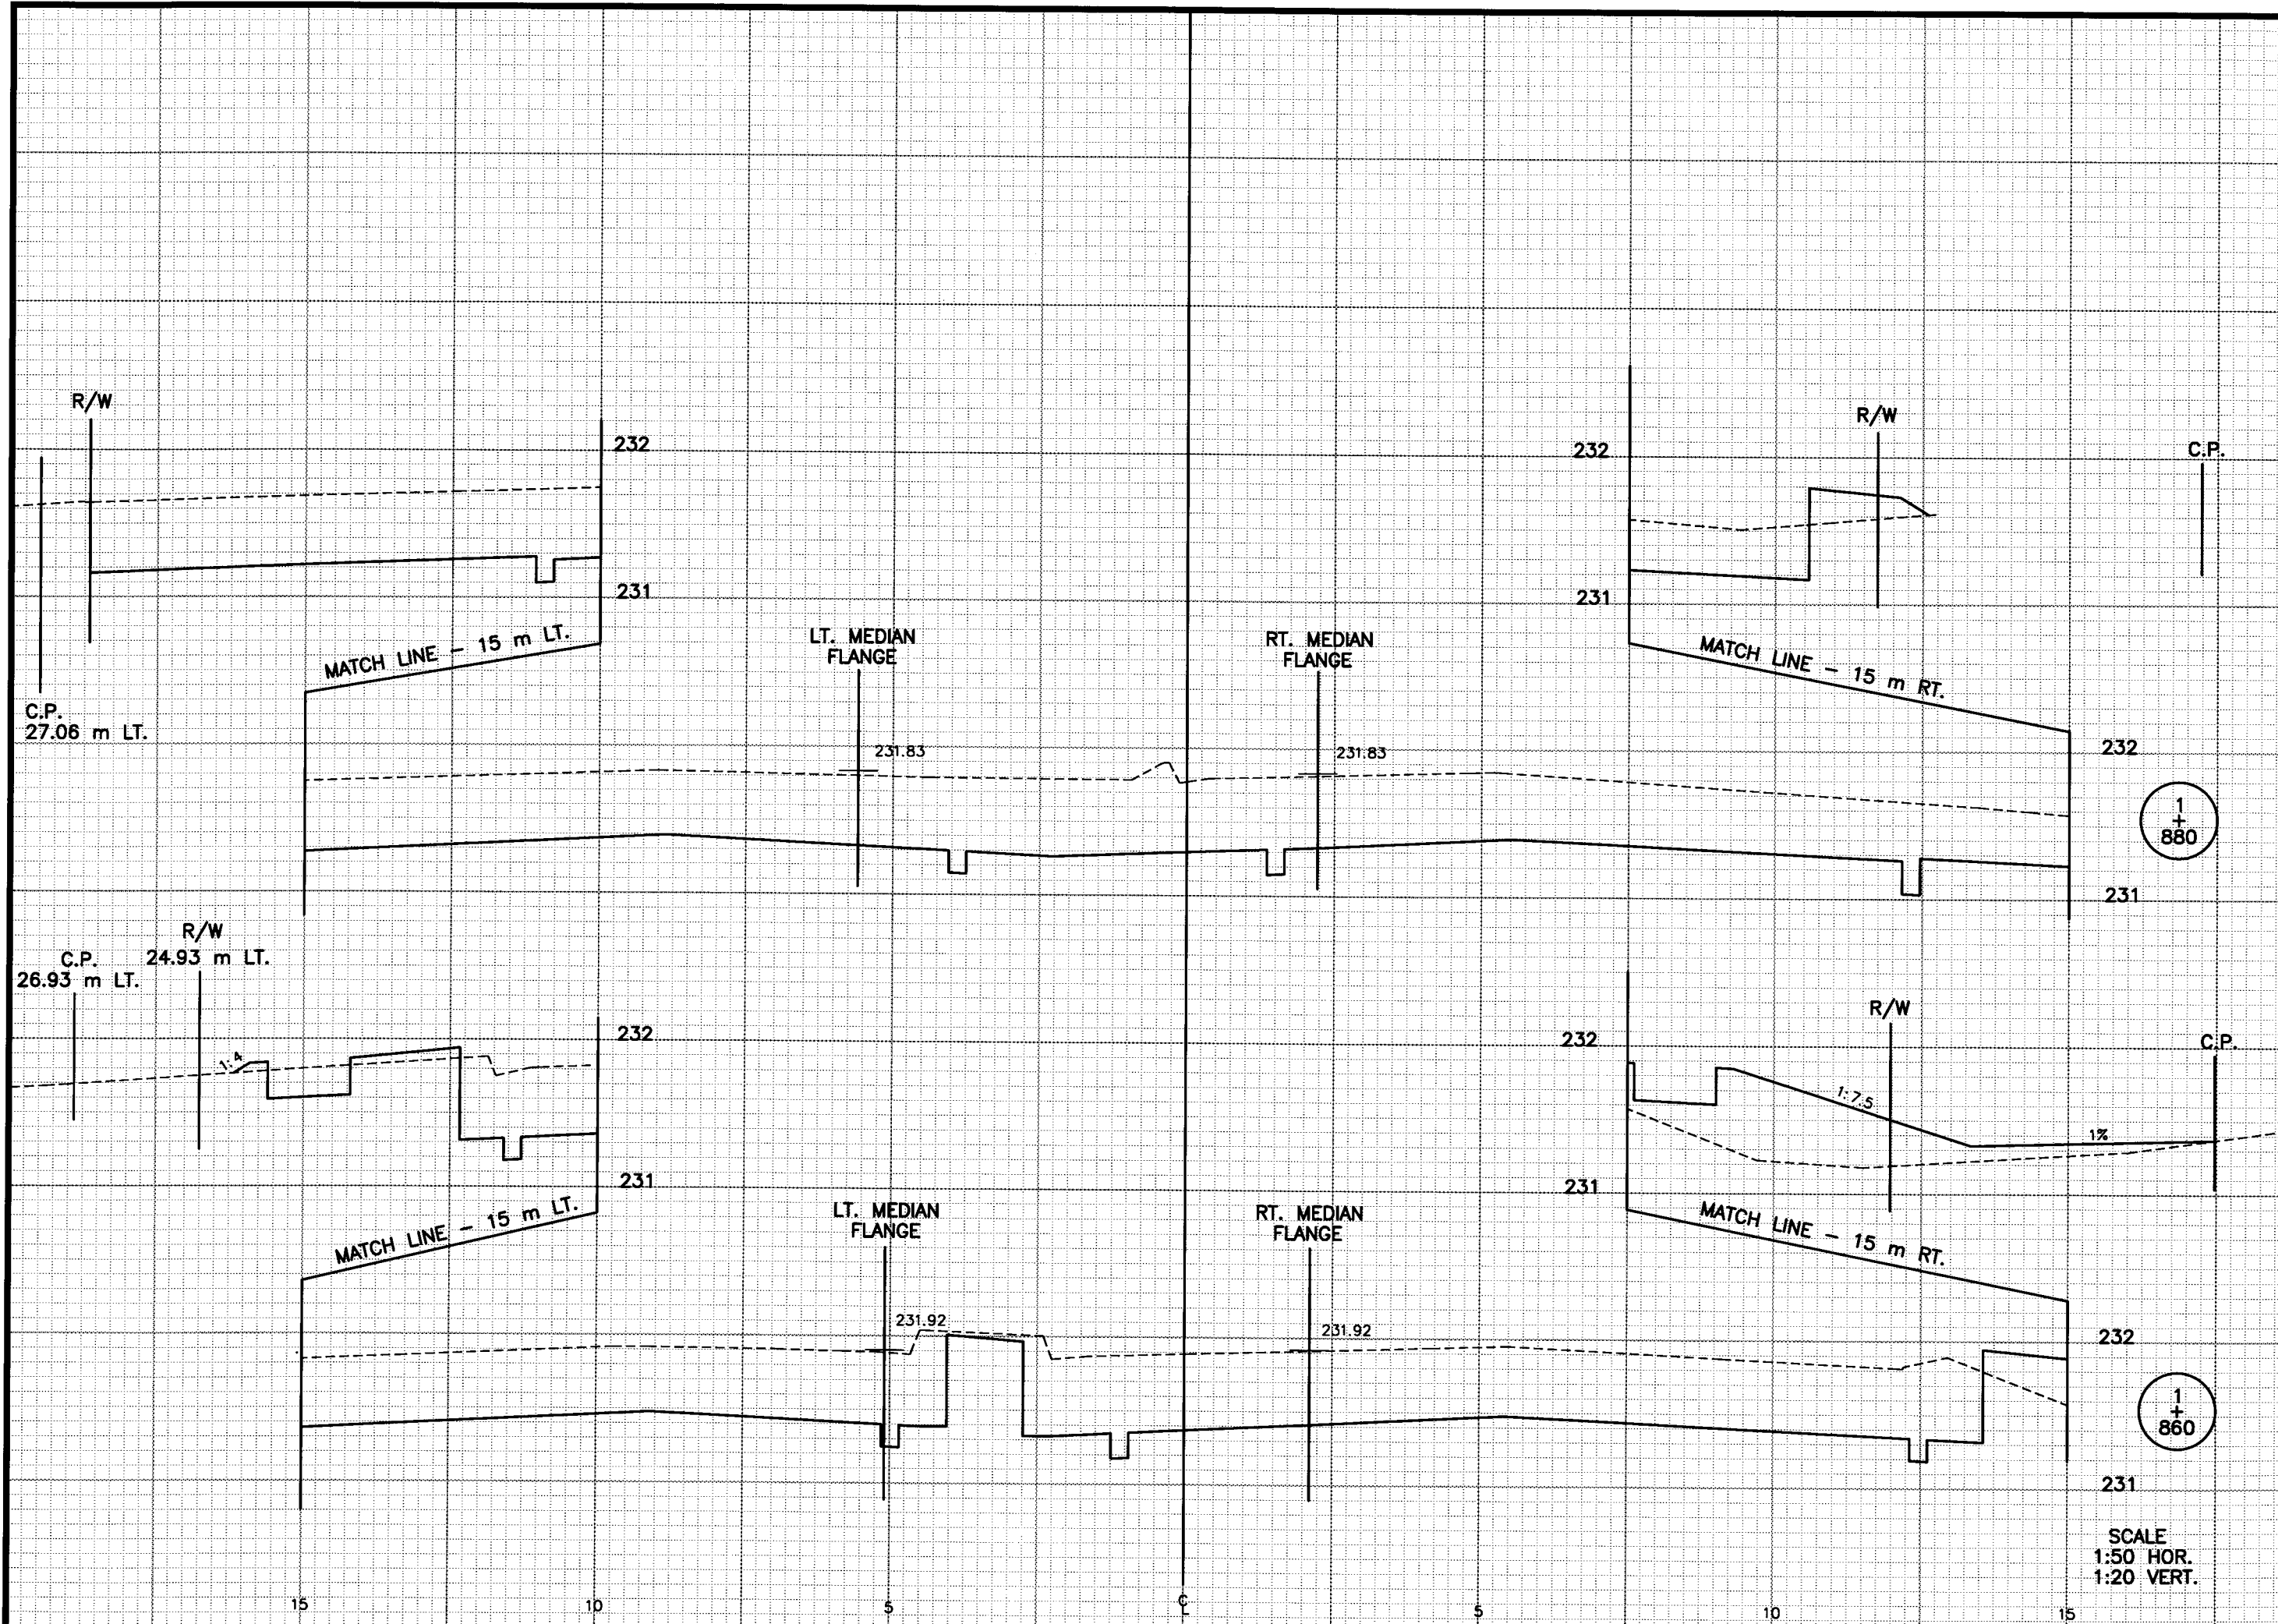

CROSS SECTIONS

STA. 1+860 - STA. 1+880


HWY: S.T.H. 23 COUNTY: FOND DU LAC

STATE PROJECT NO.: 1442-04-70

SHEET NO.: 9.10


M

BRW 0400 Sheet - MSECTION
Drawing File : XS1900

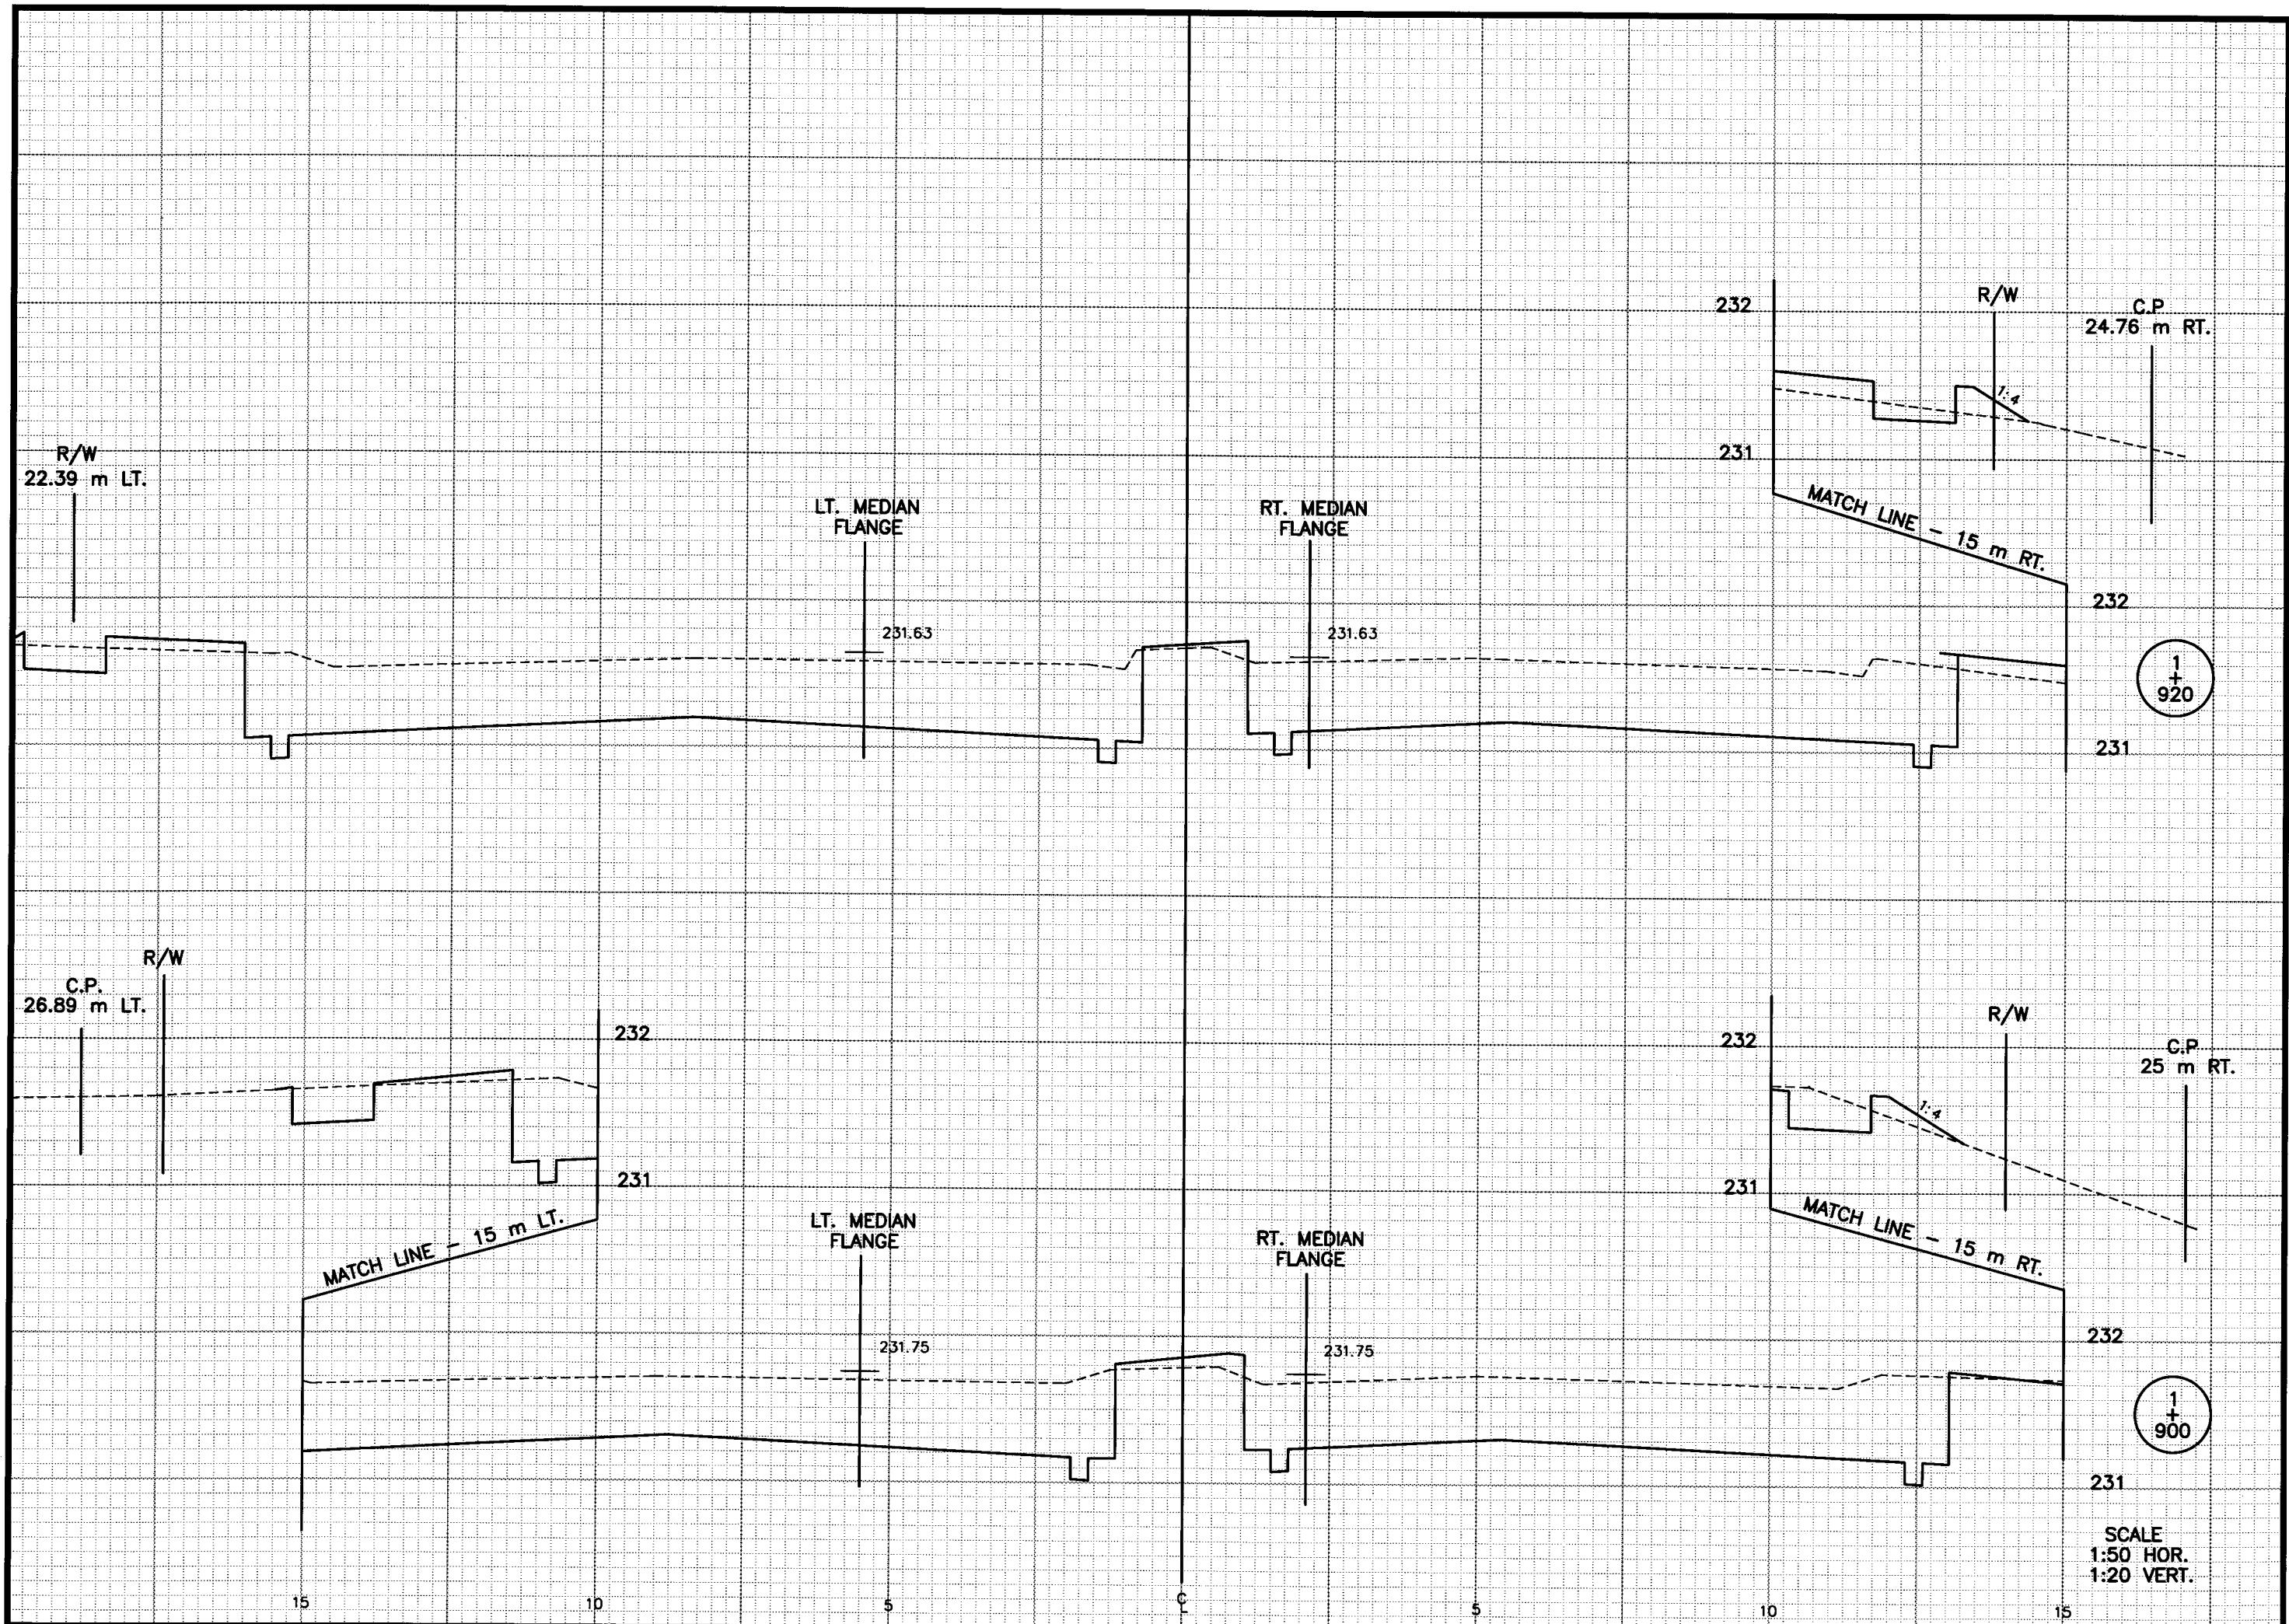

Drawing File : XS1940

BRW CAD Sheet - MSECTION

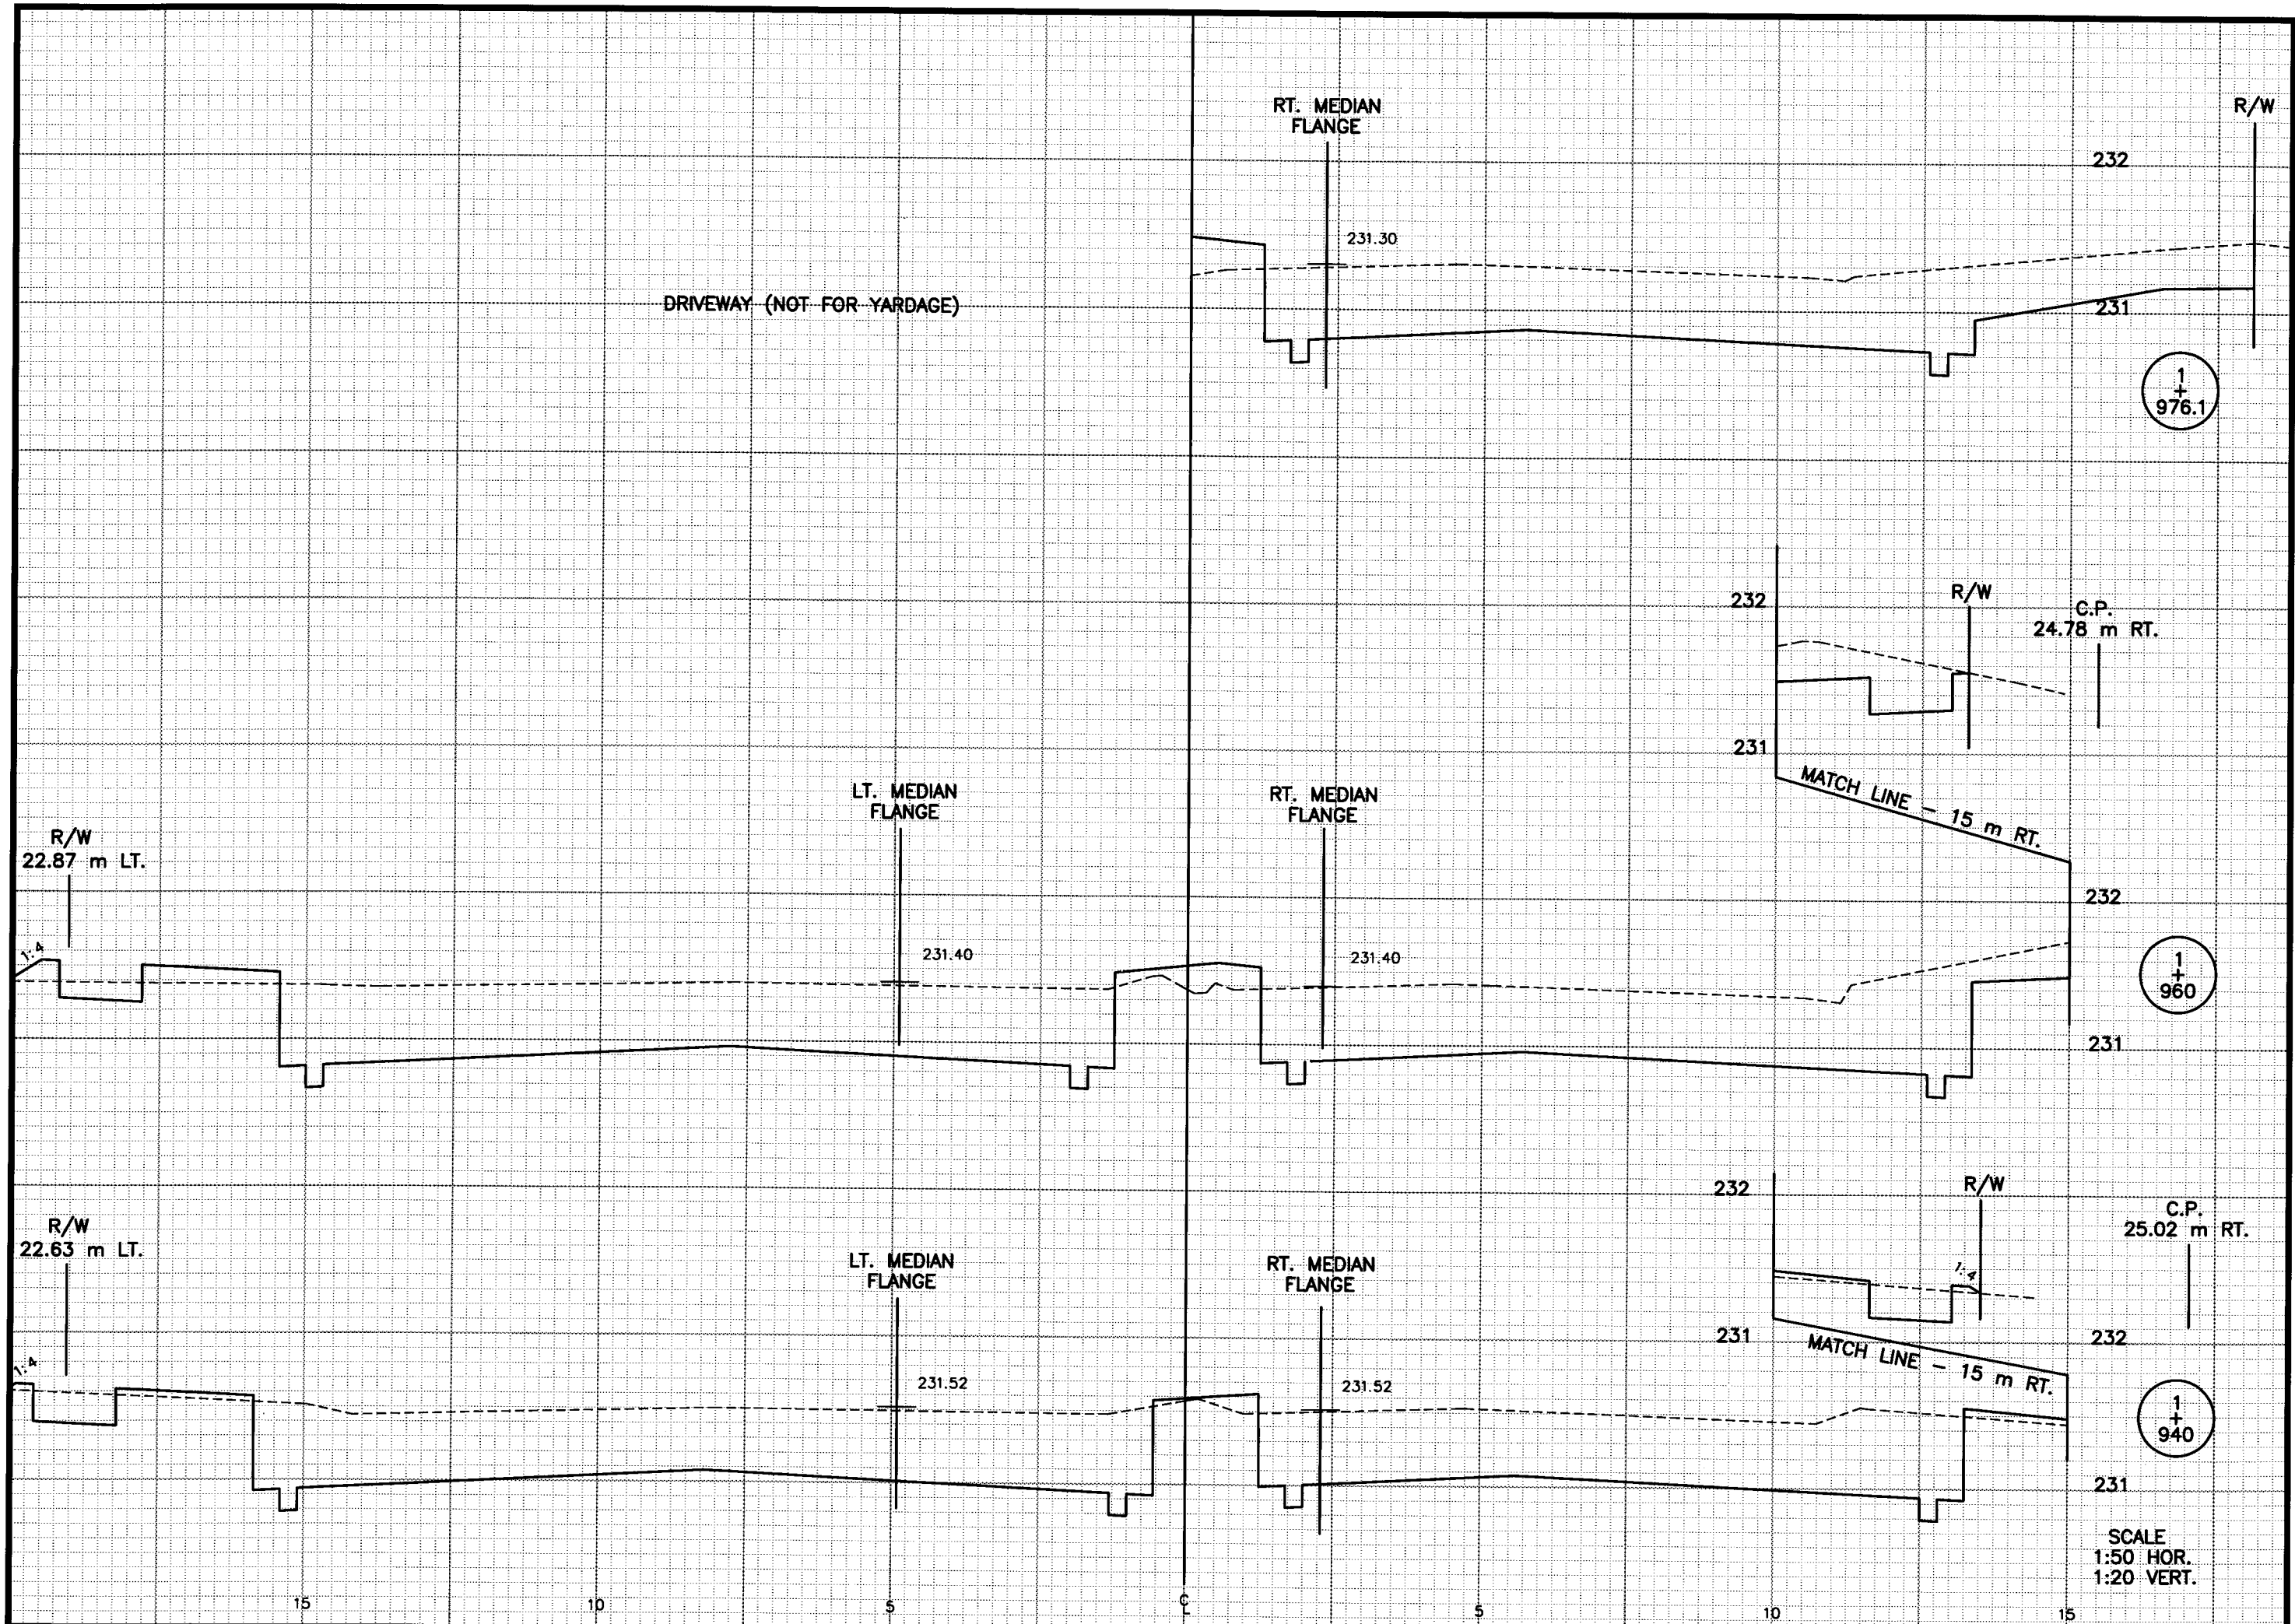

Drawing File : XS1980

BRW CADD Sheet - MSECTION

R/W
23.81 m LT.

R/W
23.58 m LT.

R/W
23.34 m LT.

R/W
23.10 m LT.

LT. MEDIAN
FLANGE

RT. MEDIAN
FLANGE

LT. MEDIAN
FLANGE

RT. MEDIAN
FLANGE

LT. MEDIAN
FLANGE

RT. MEDIAN
FLANGE

LT. MEDIAN
FLANGE

RT. MEDIAN
FLANGE

231

230

MATCH LINE - 15 m RT.

R/W

T.L.E.

1:6

231

230

2+040

R/W

2+020

R/W

231

230

2+000

232

231

R/W

SCALE
1:50 HOR.
1:20 VERT.

CROSS SECTIONS

STA. 1+980 - STA. 2+040

HWY: S.T.H. 23


COUNTY: FOND DU LAC


STATE PROJECT NO.: 1442-04-70

SHEET NO.: 9,13


M

BRW CAUD Sheet - ASECTION
Drawing File : XS2060

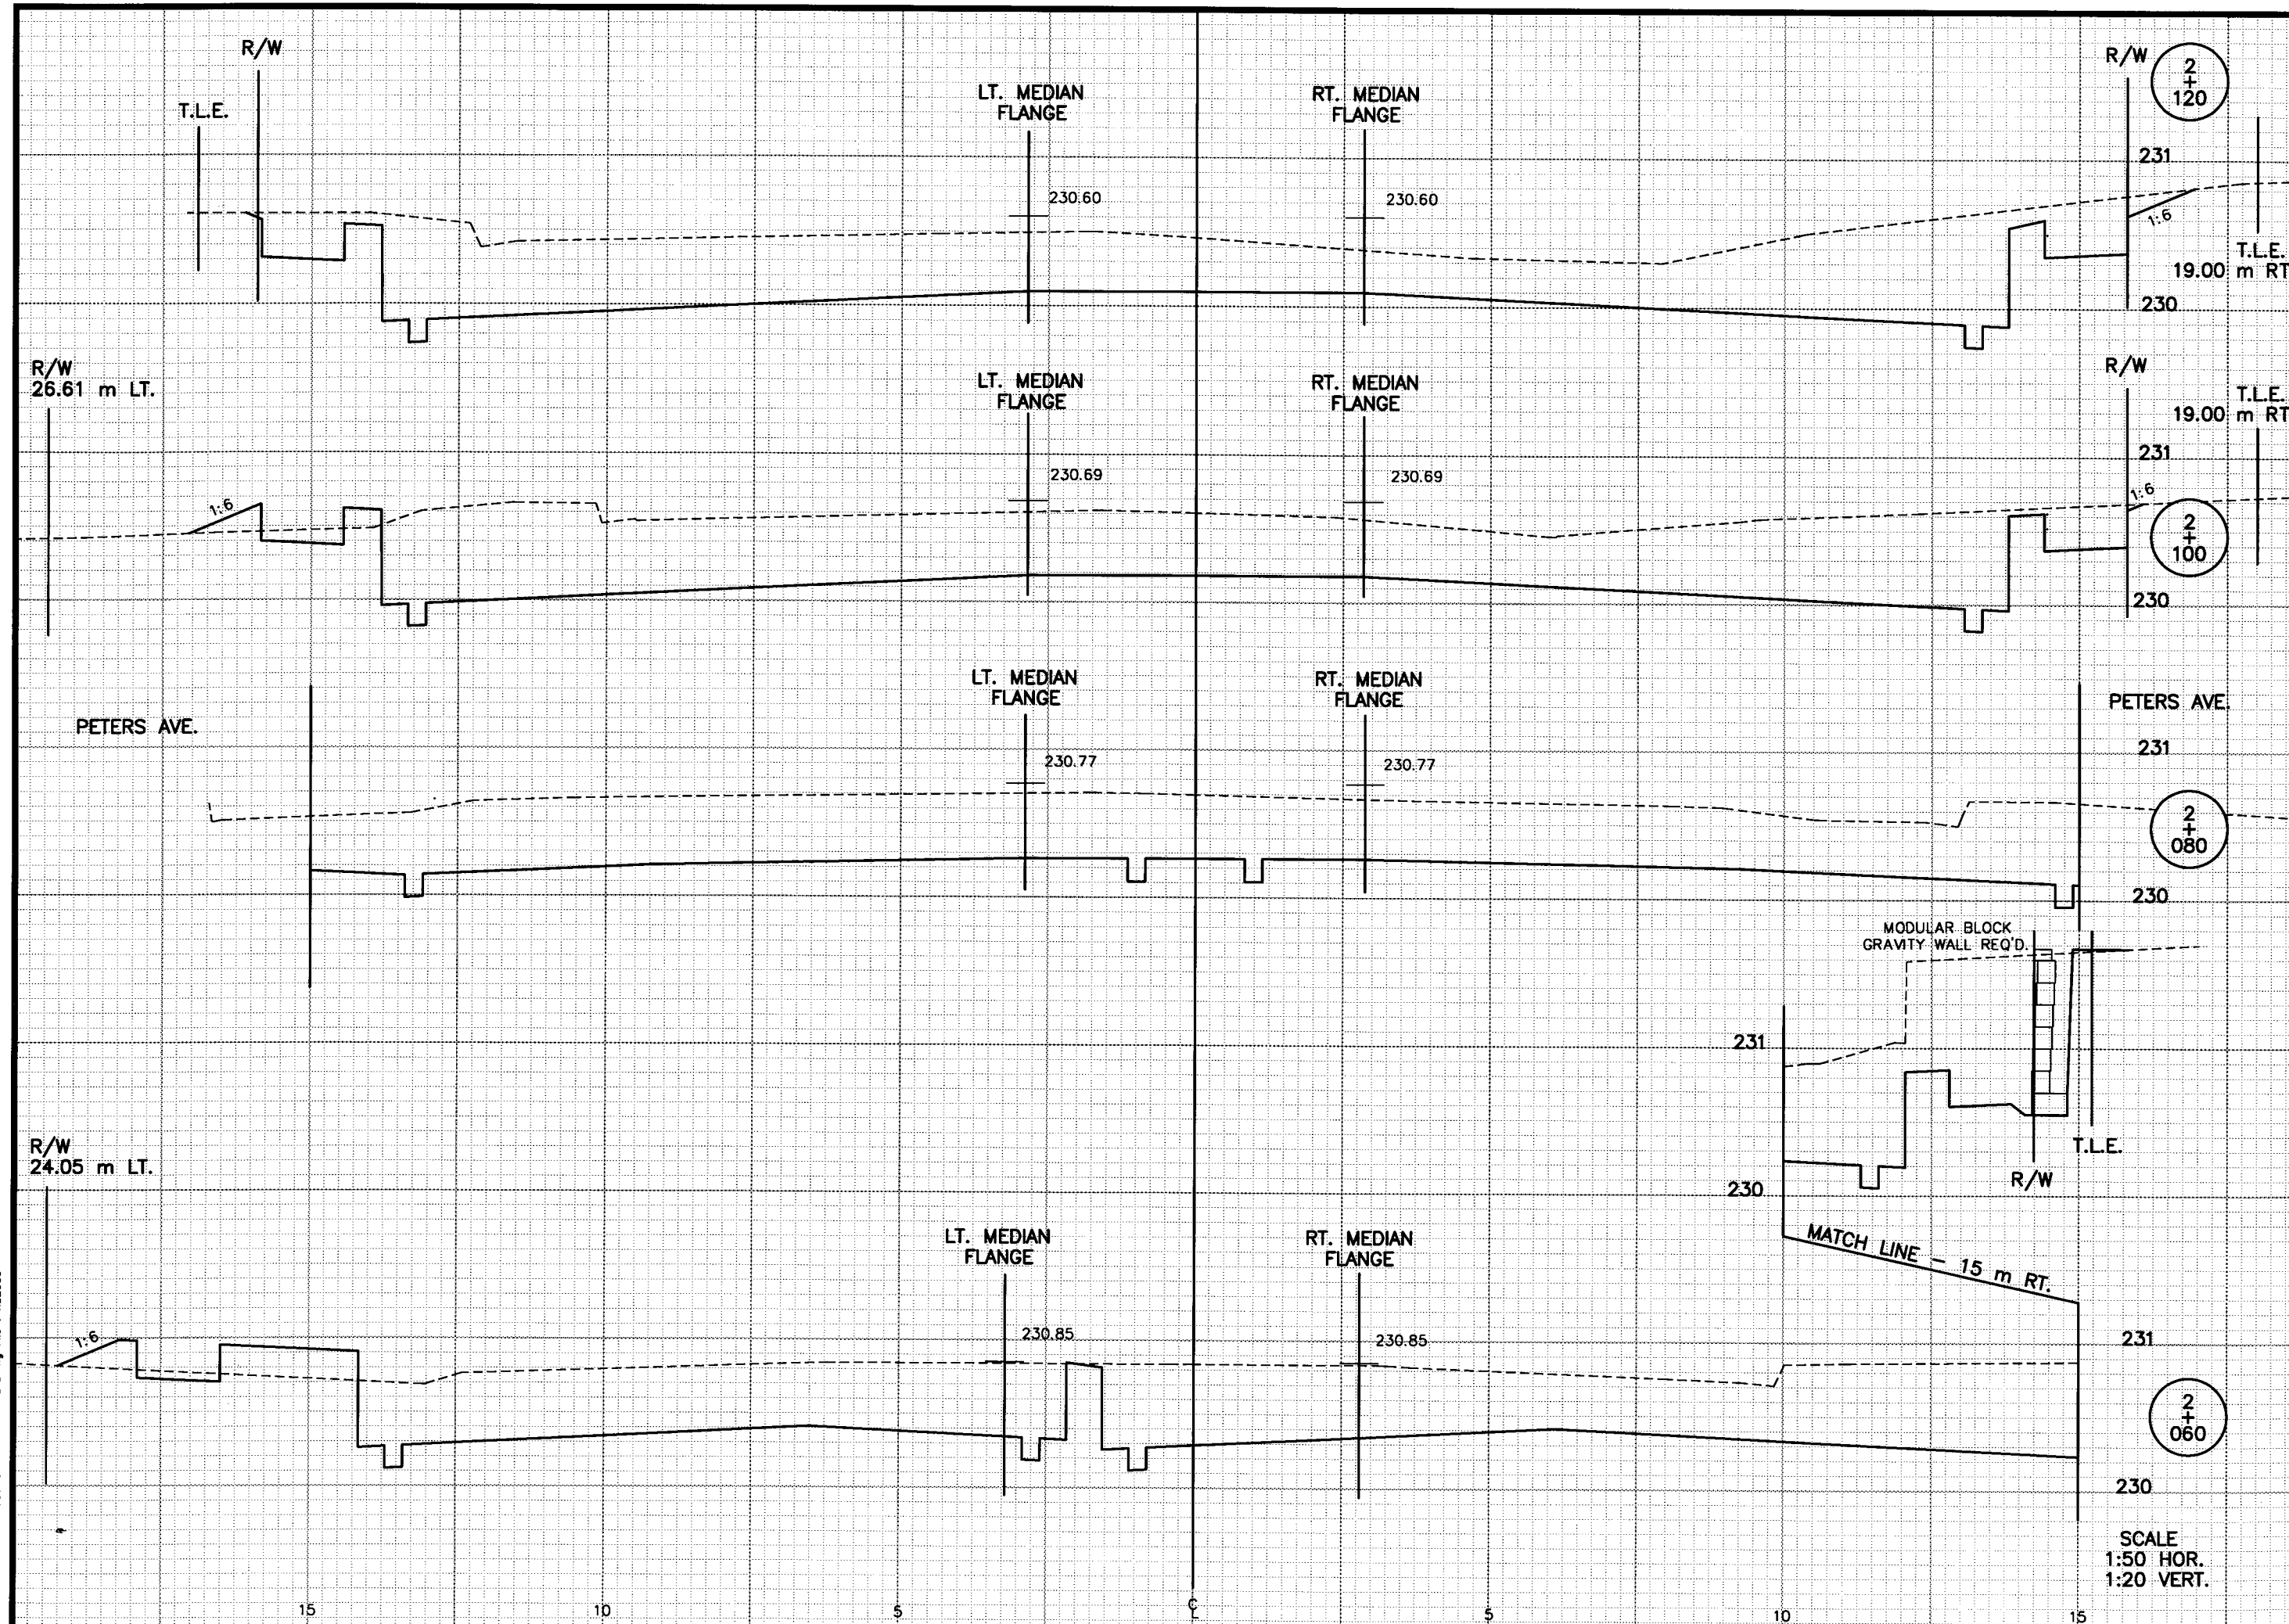


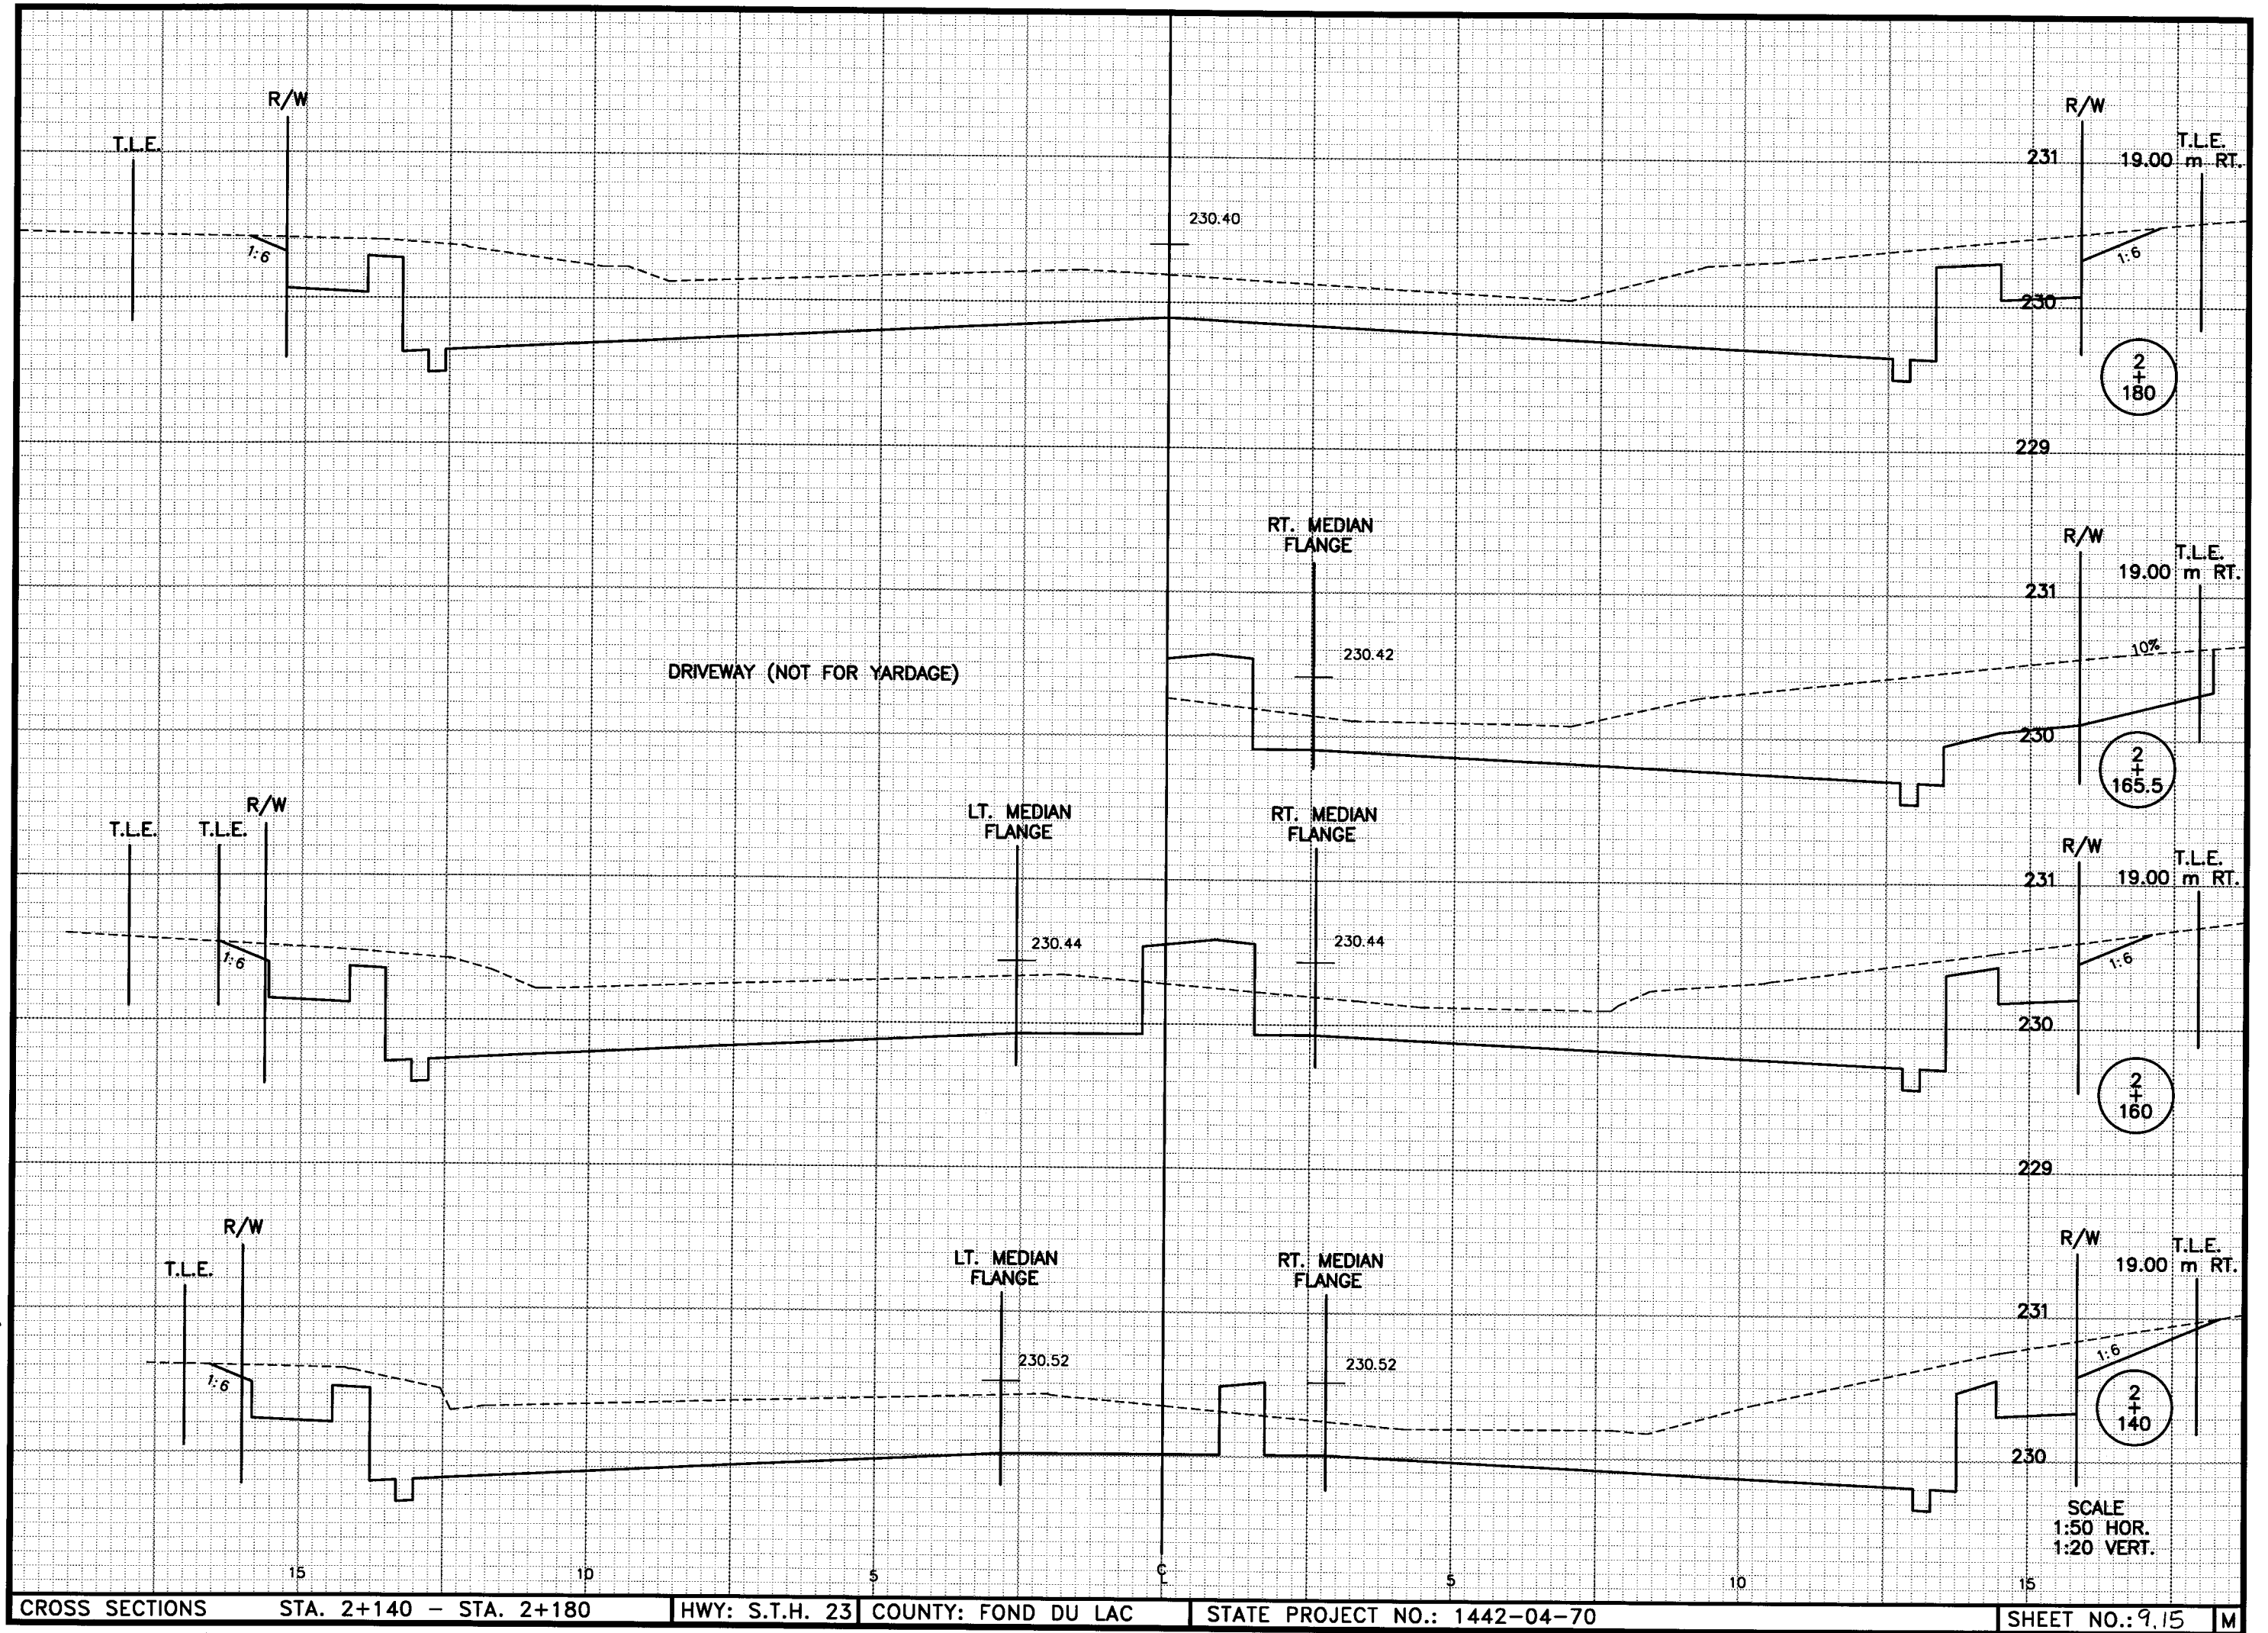



BRW CADD Sheet - MSECTION
Drawing File : XS2200

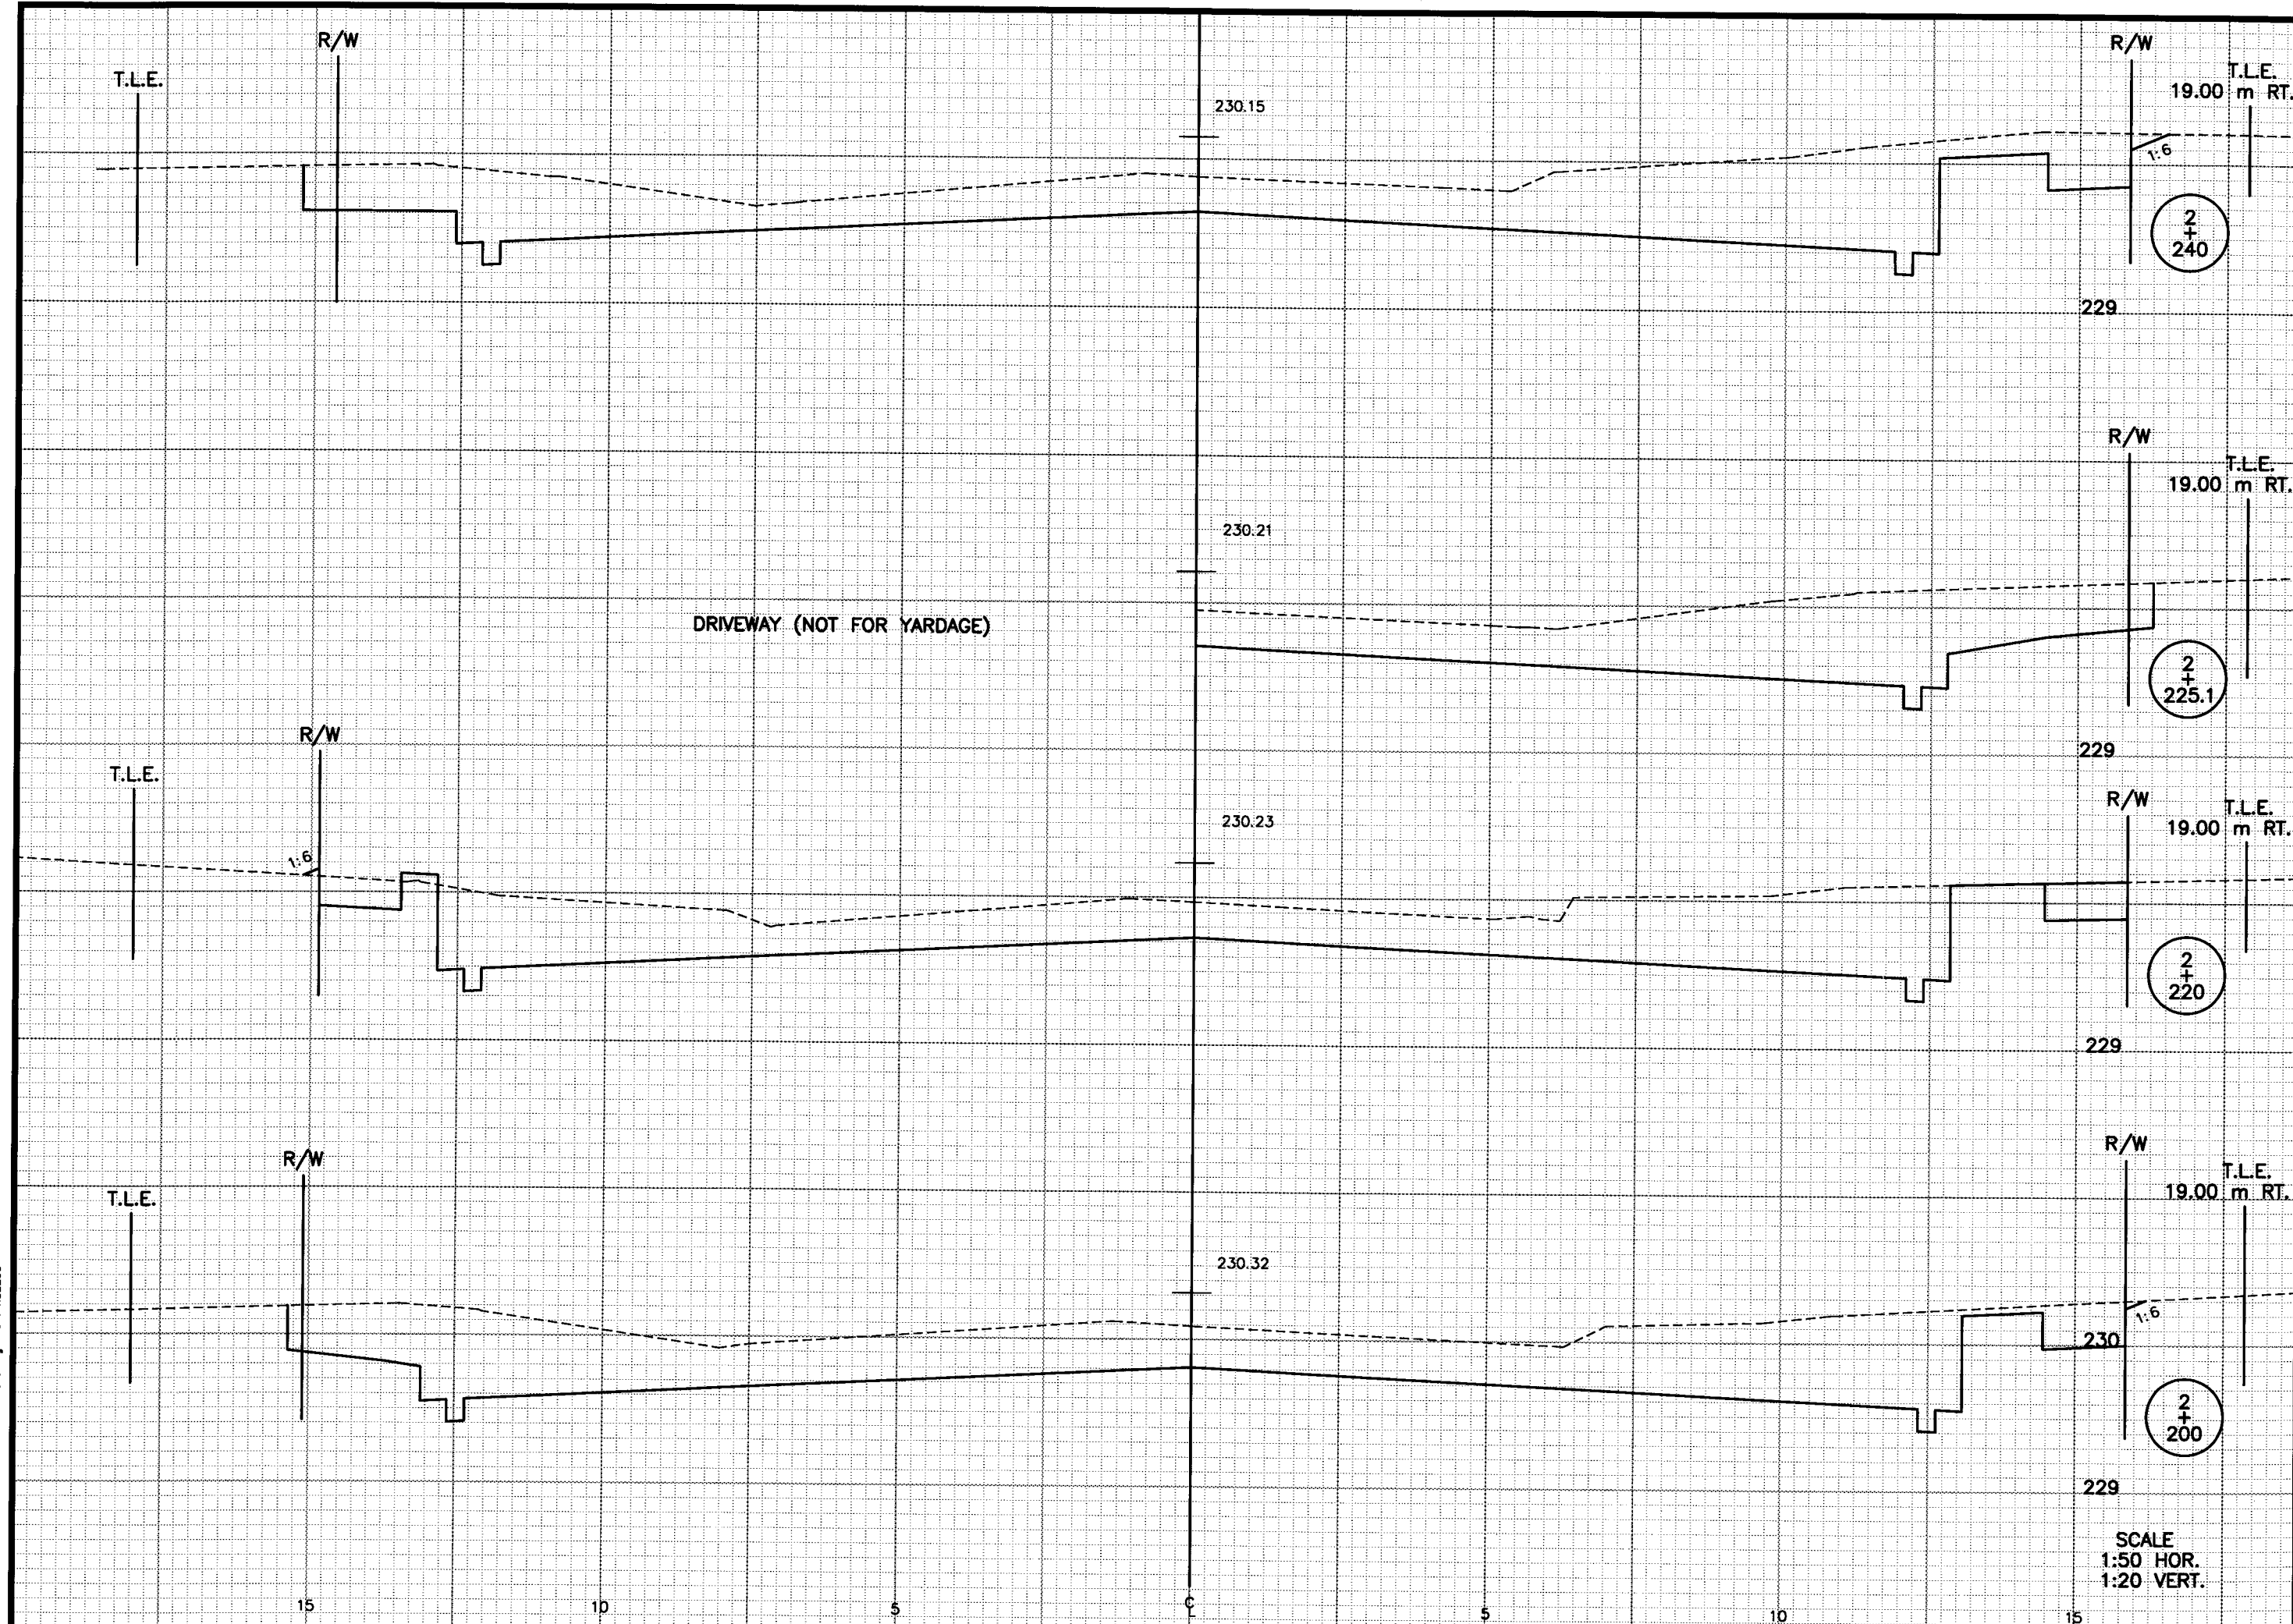

BRW CDD Sheet - MSECTION
Drawing File : XS2257

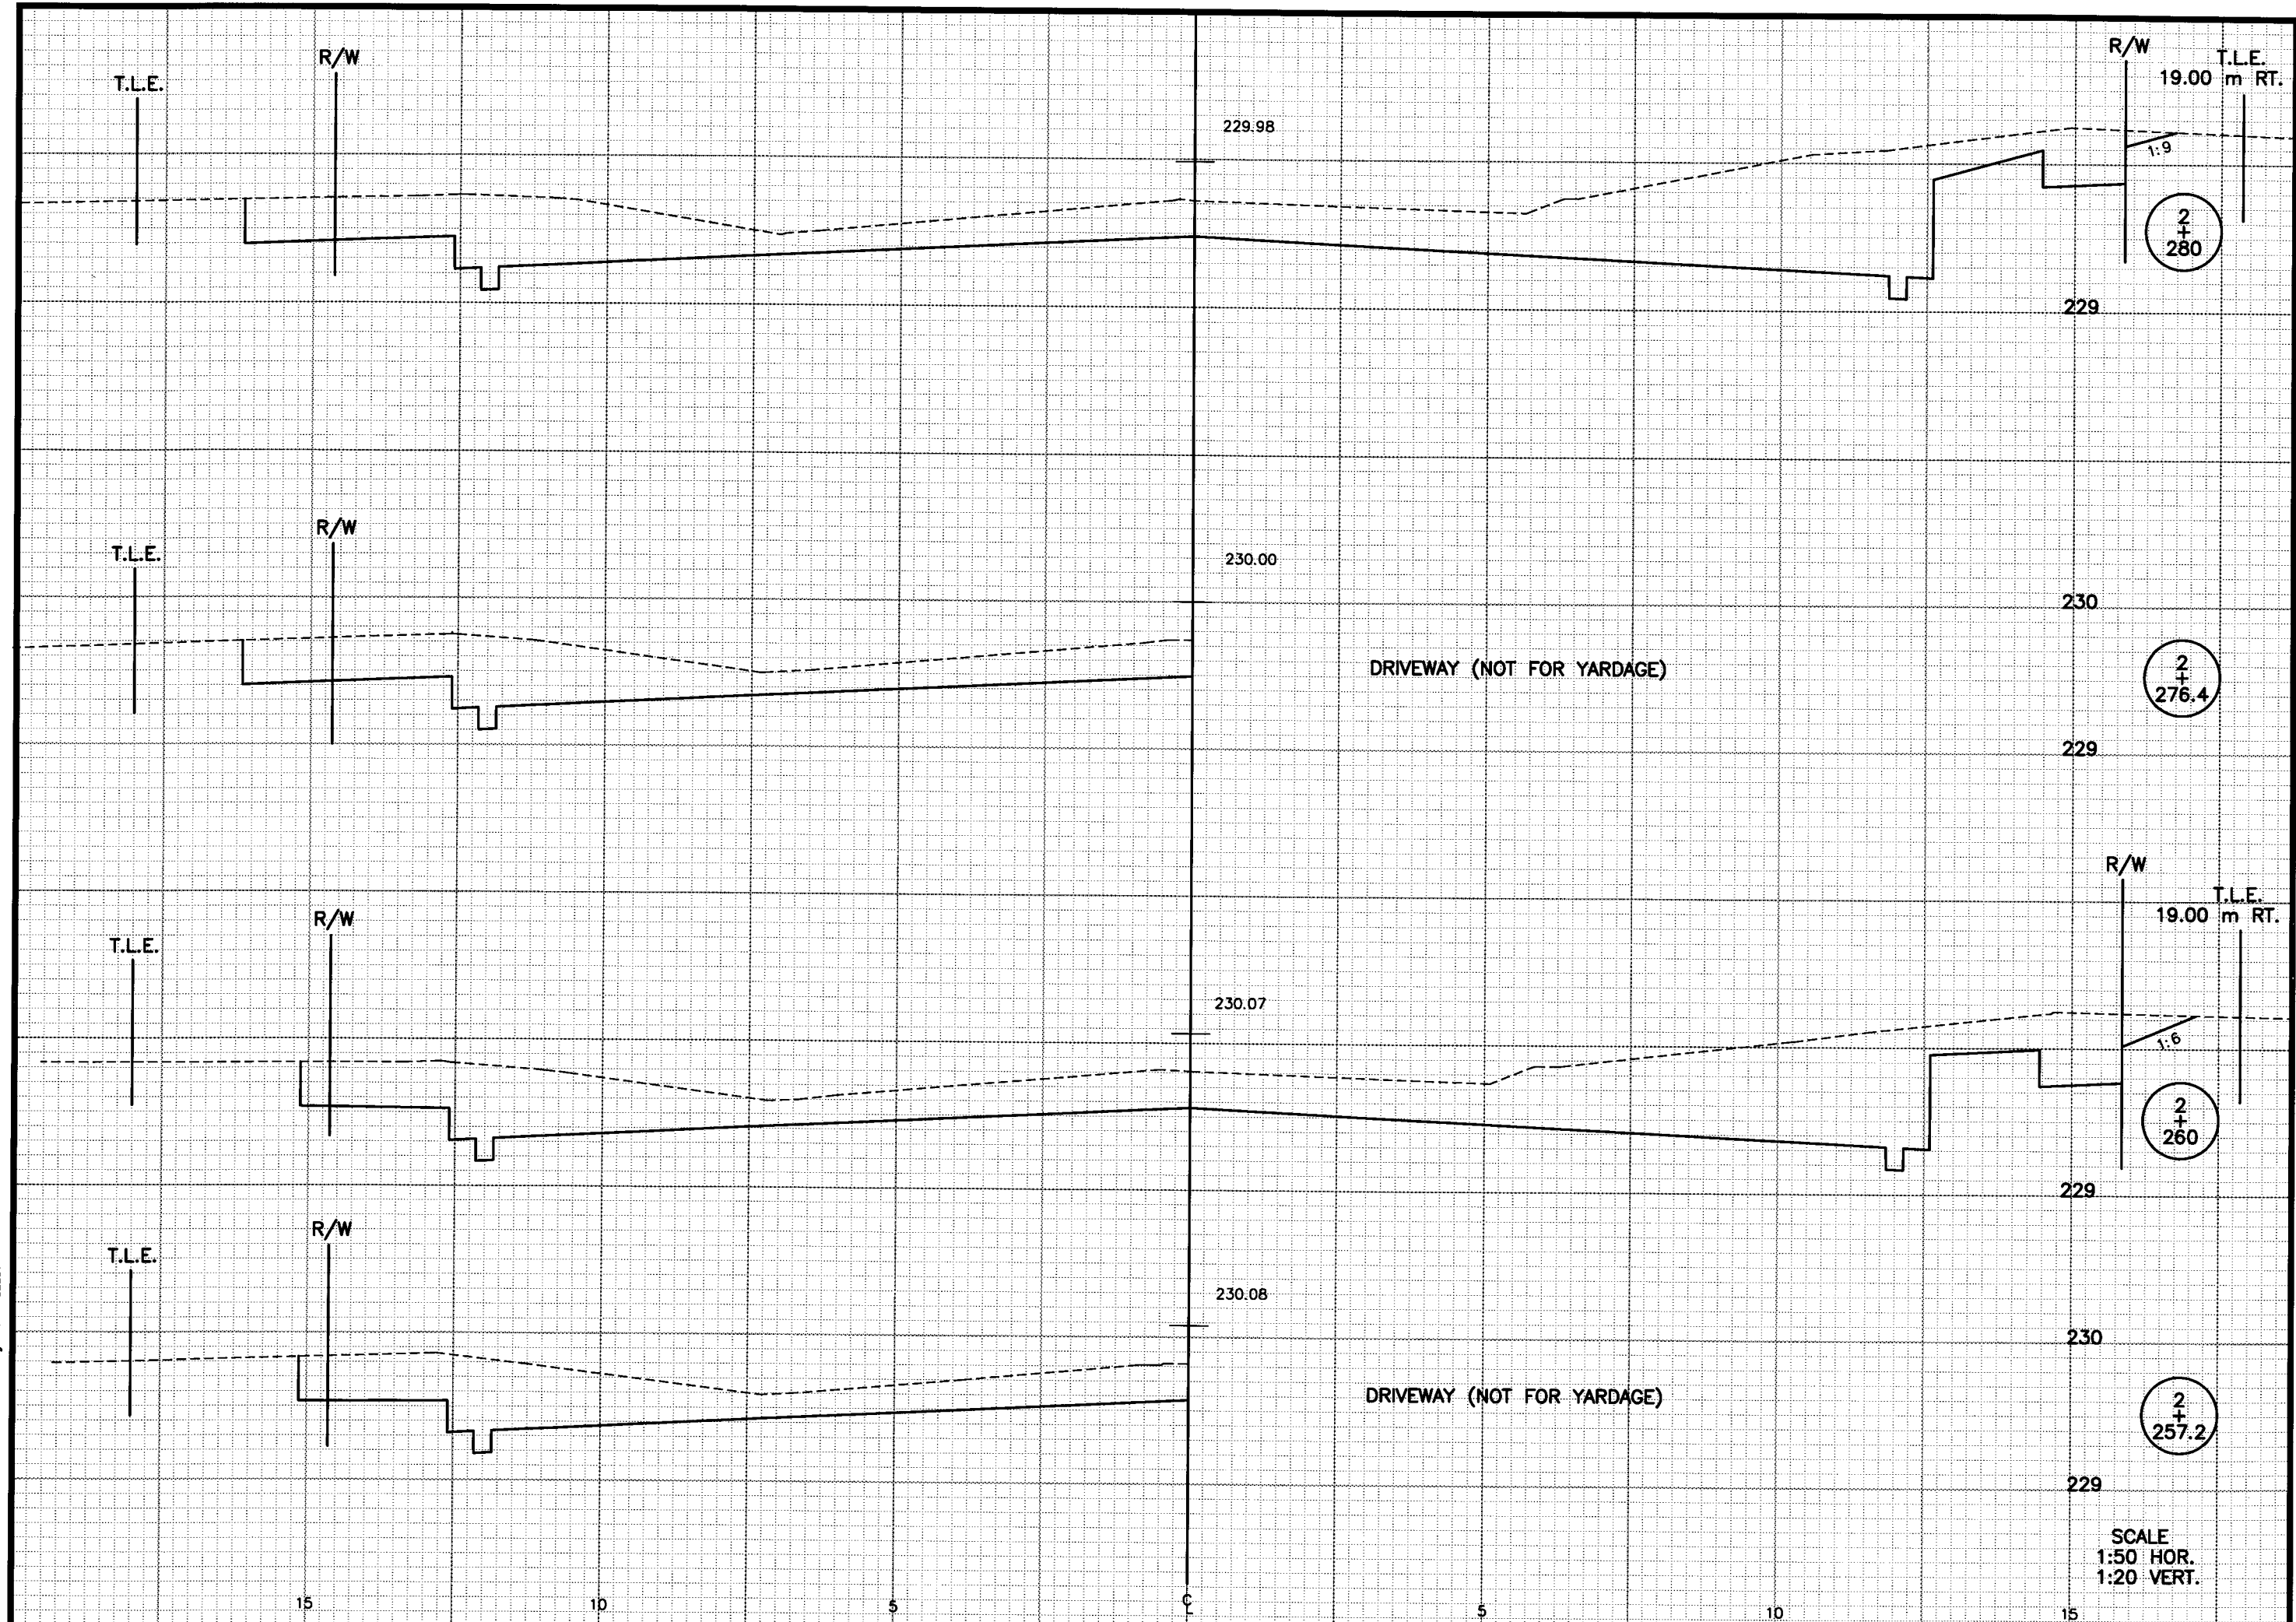

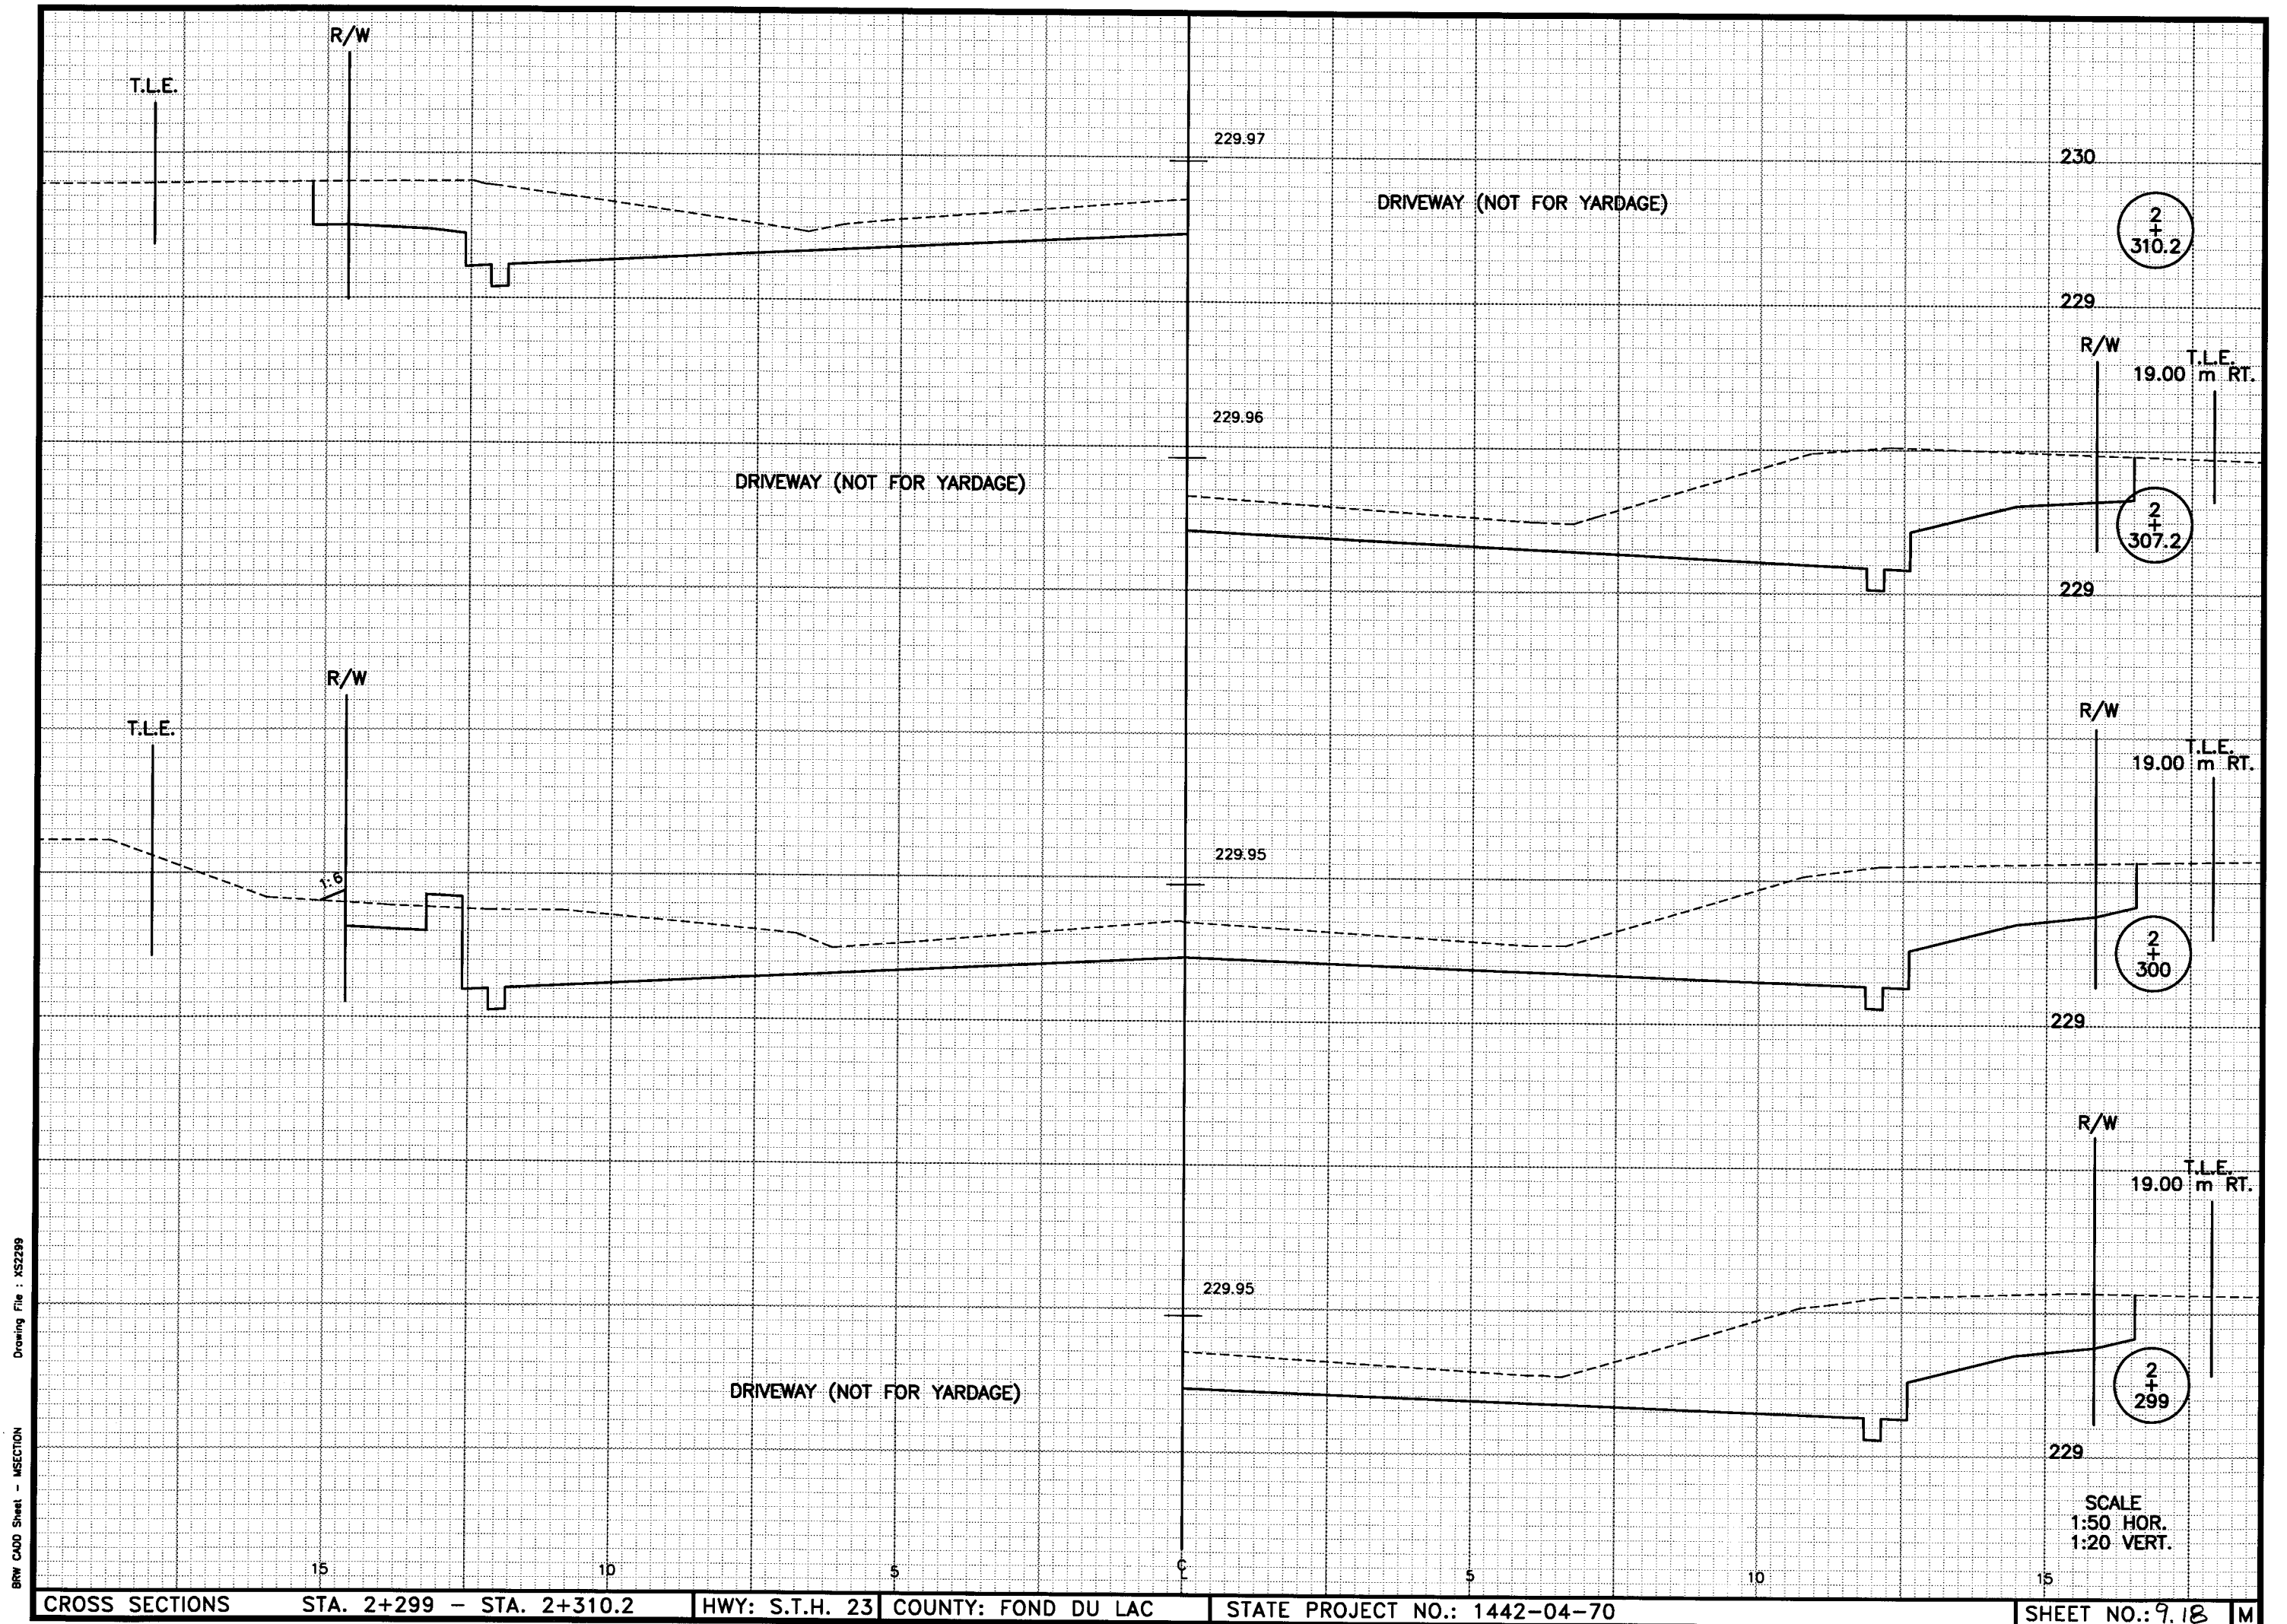

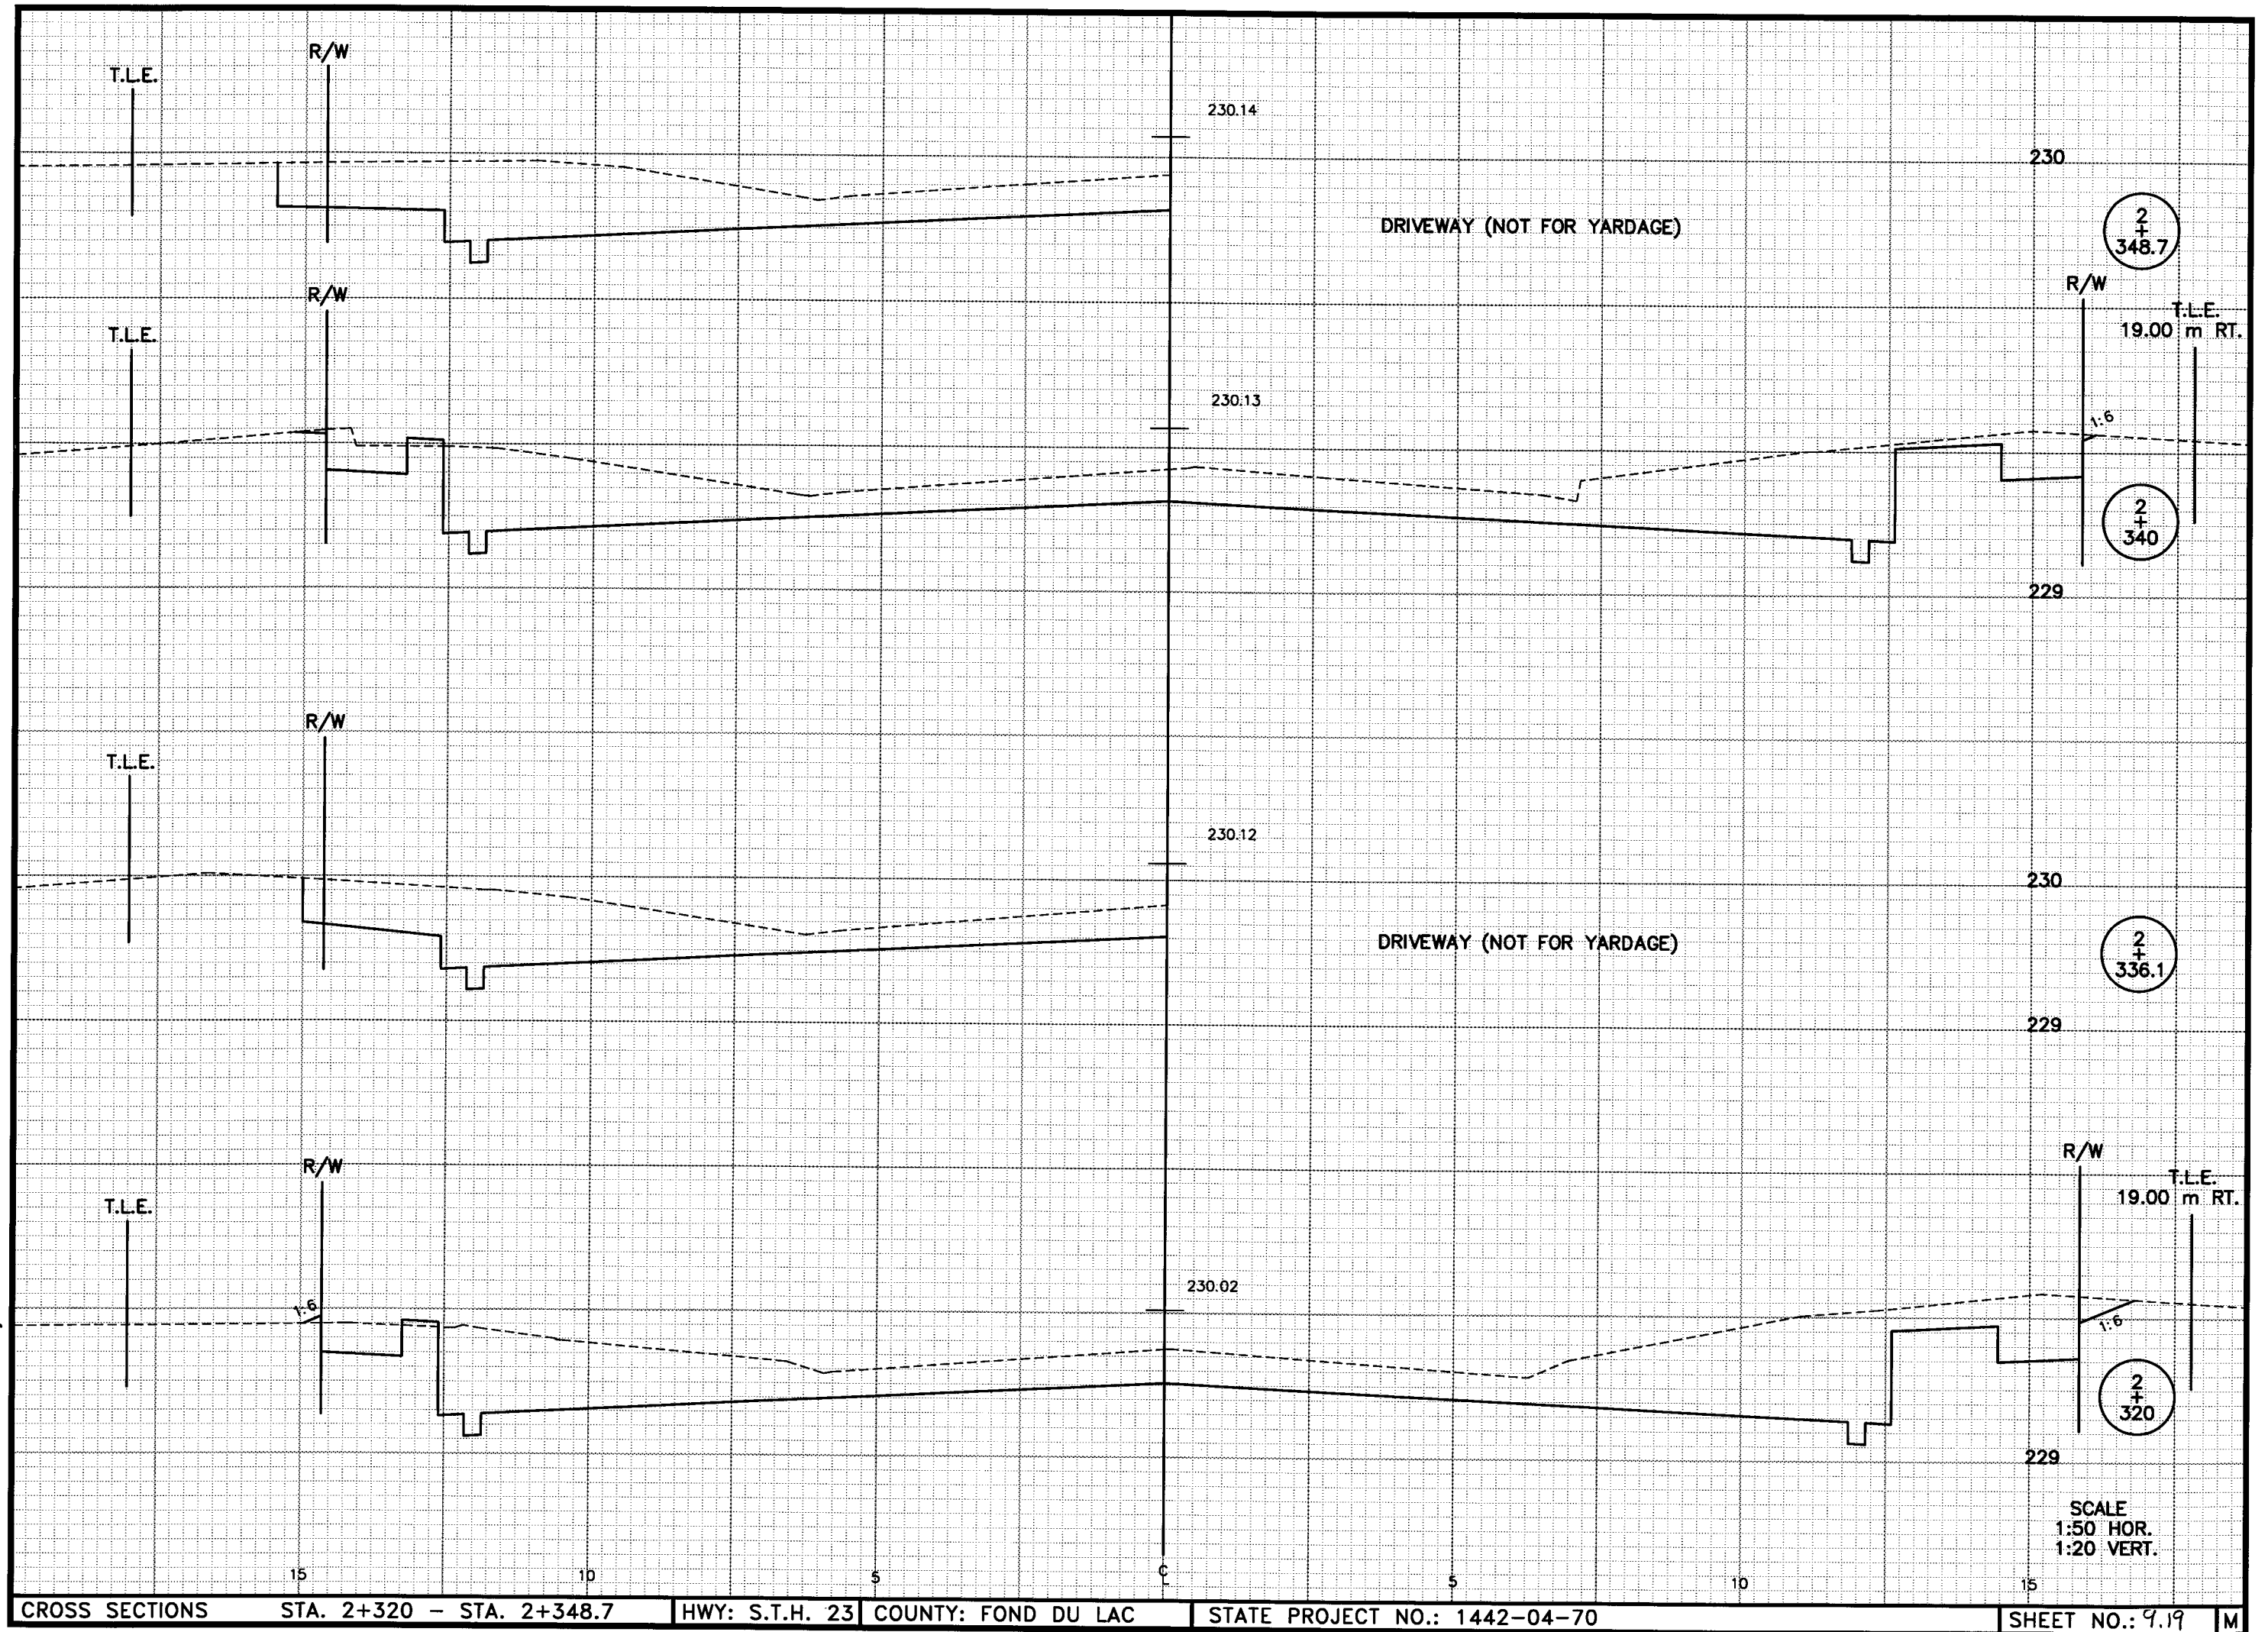


Drawing File : XS2320

BRW CADD Sheet - MSECTION


Drawing File : XS2360

BRW CAD Sheet - MSECTION

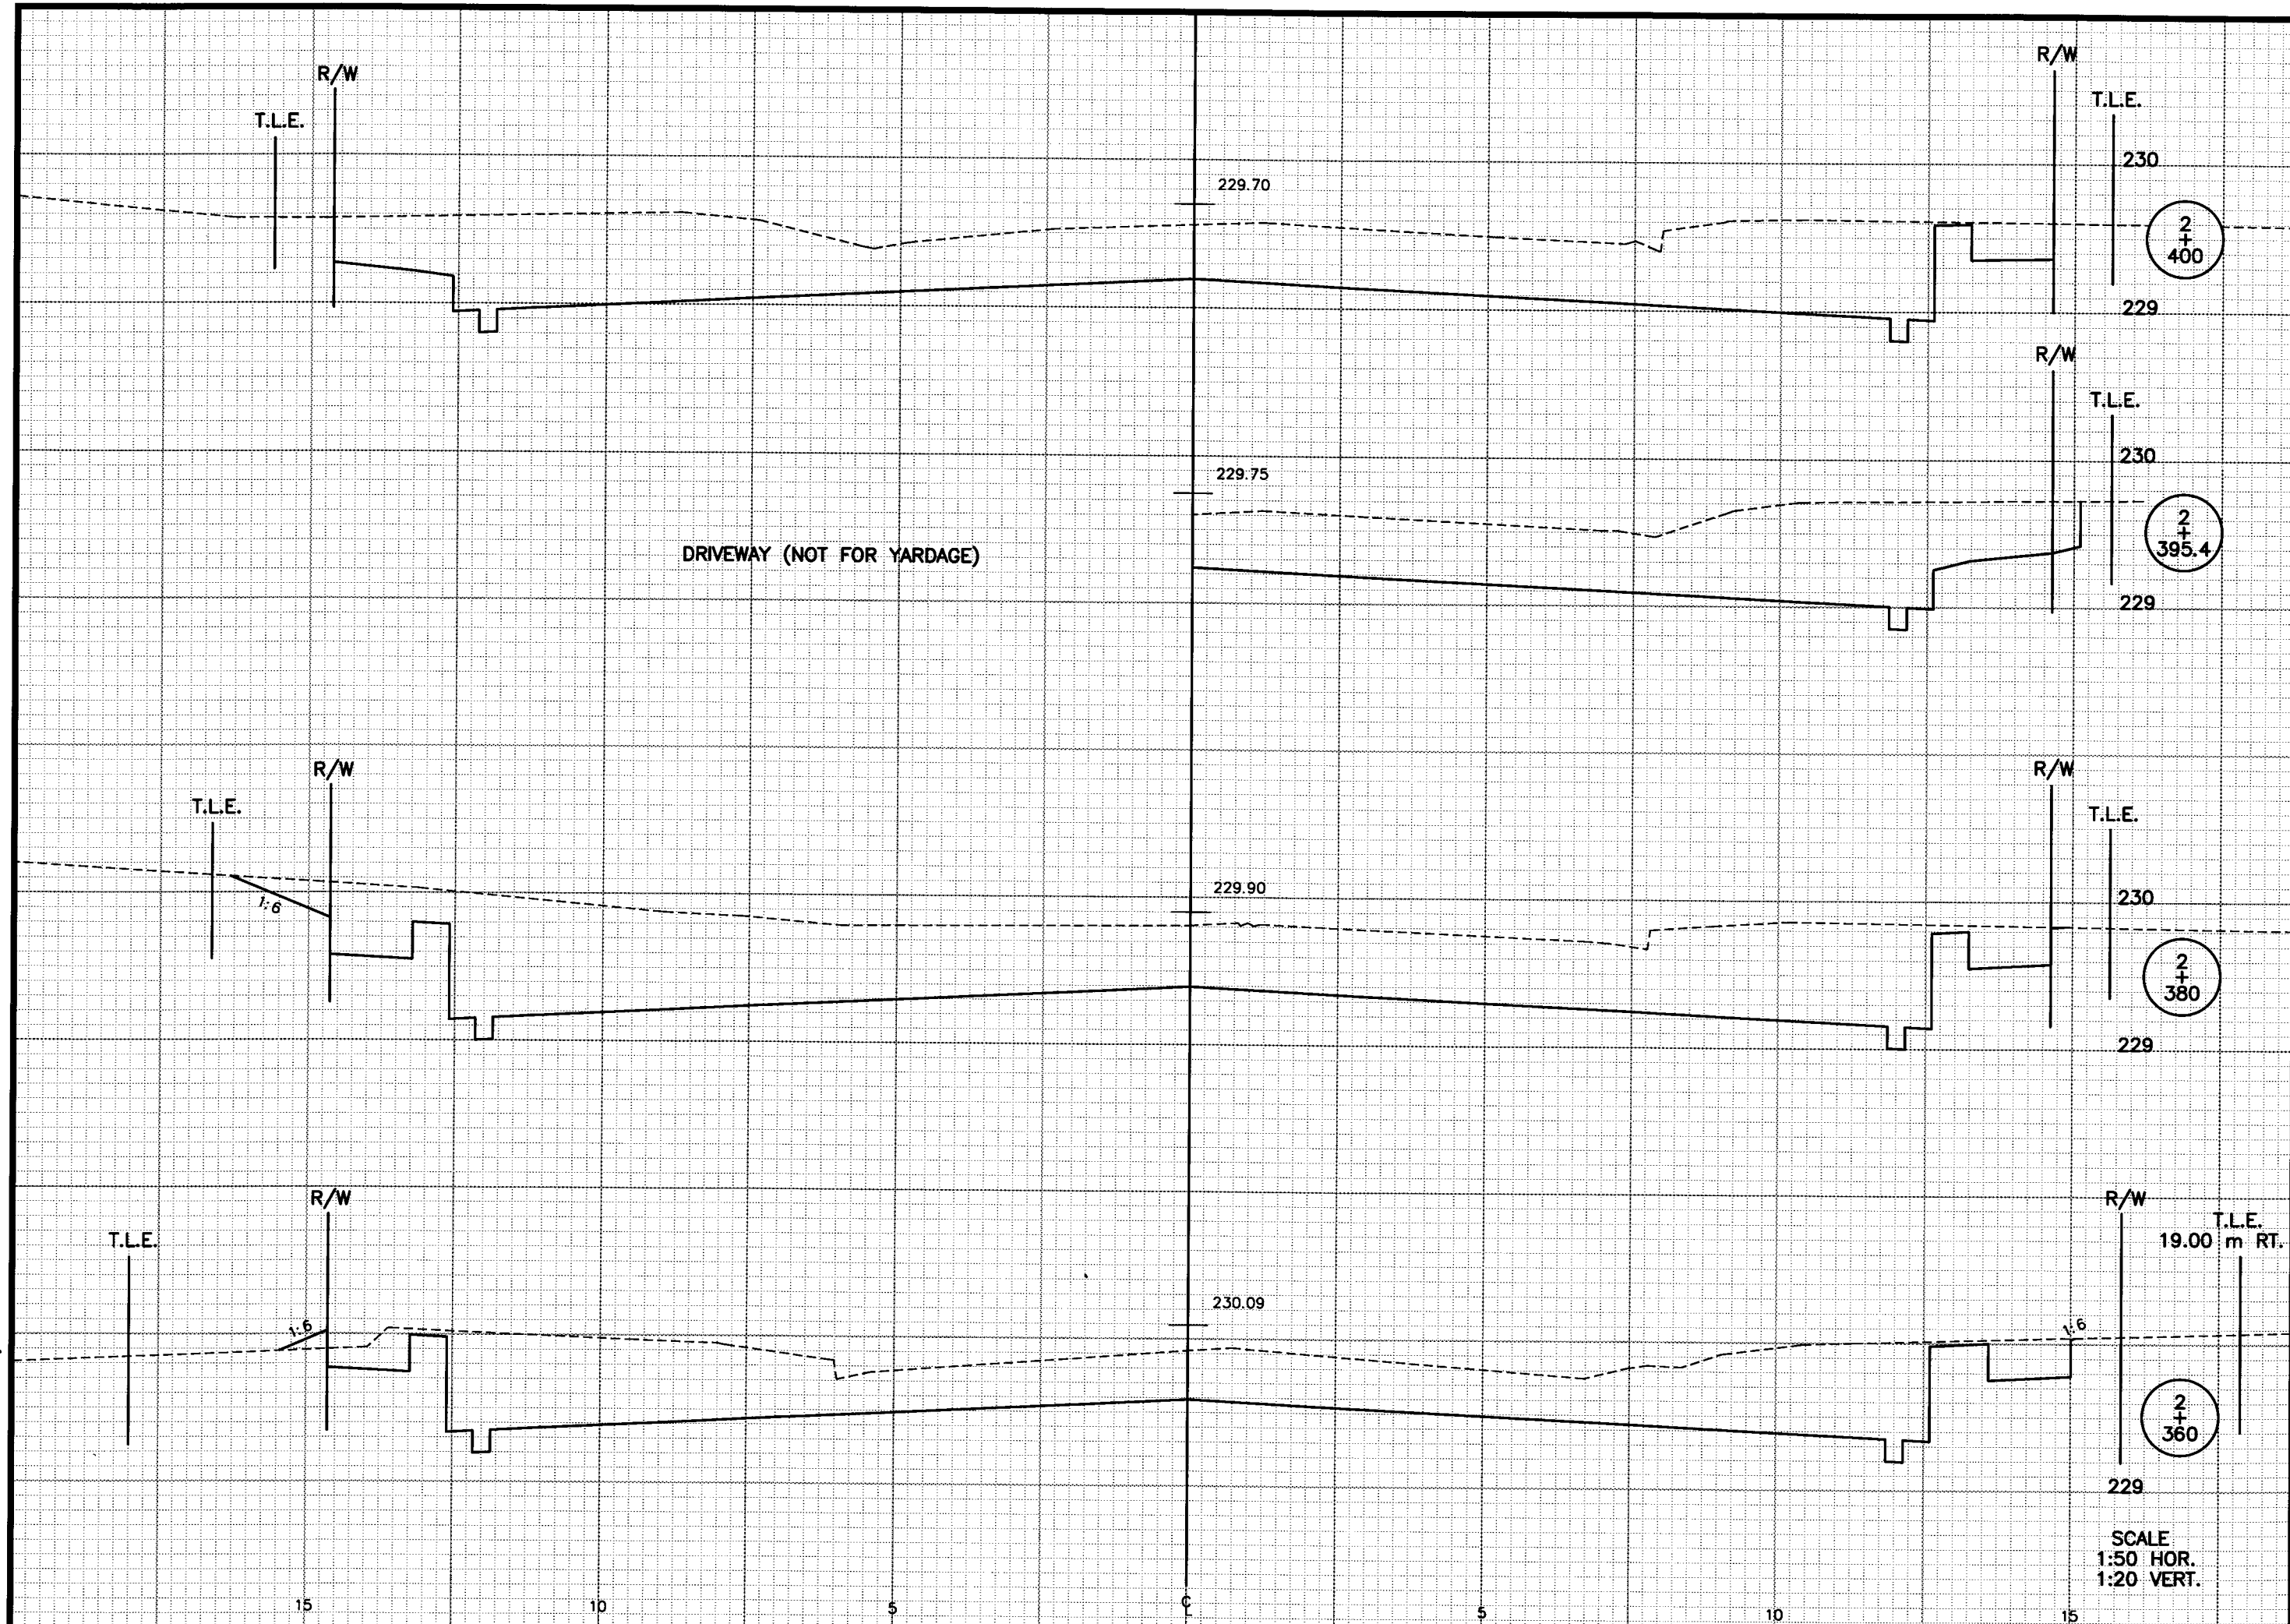

Drawing File : XS2413

BRW CADD Sheet - MSECTION

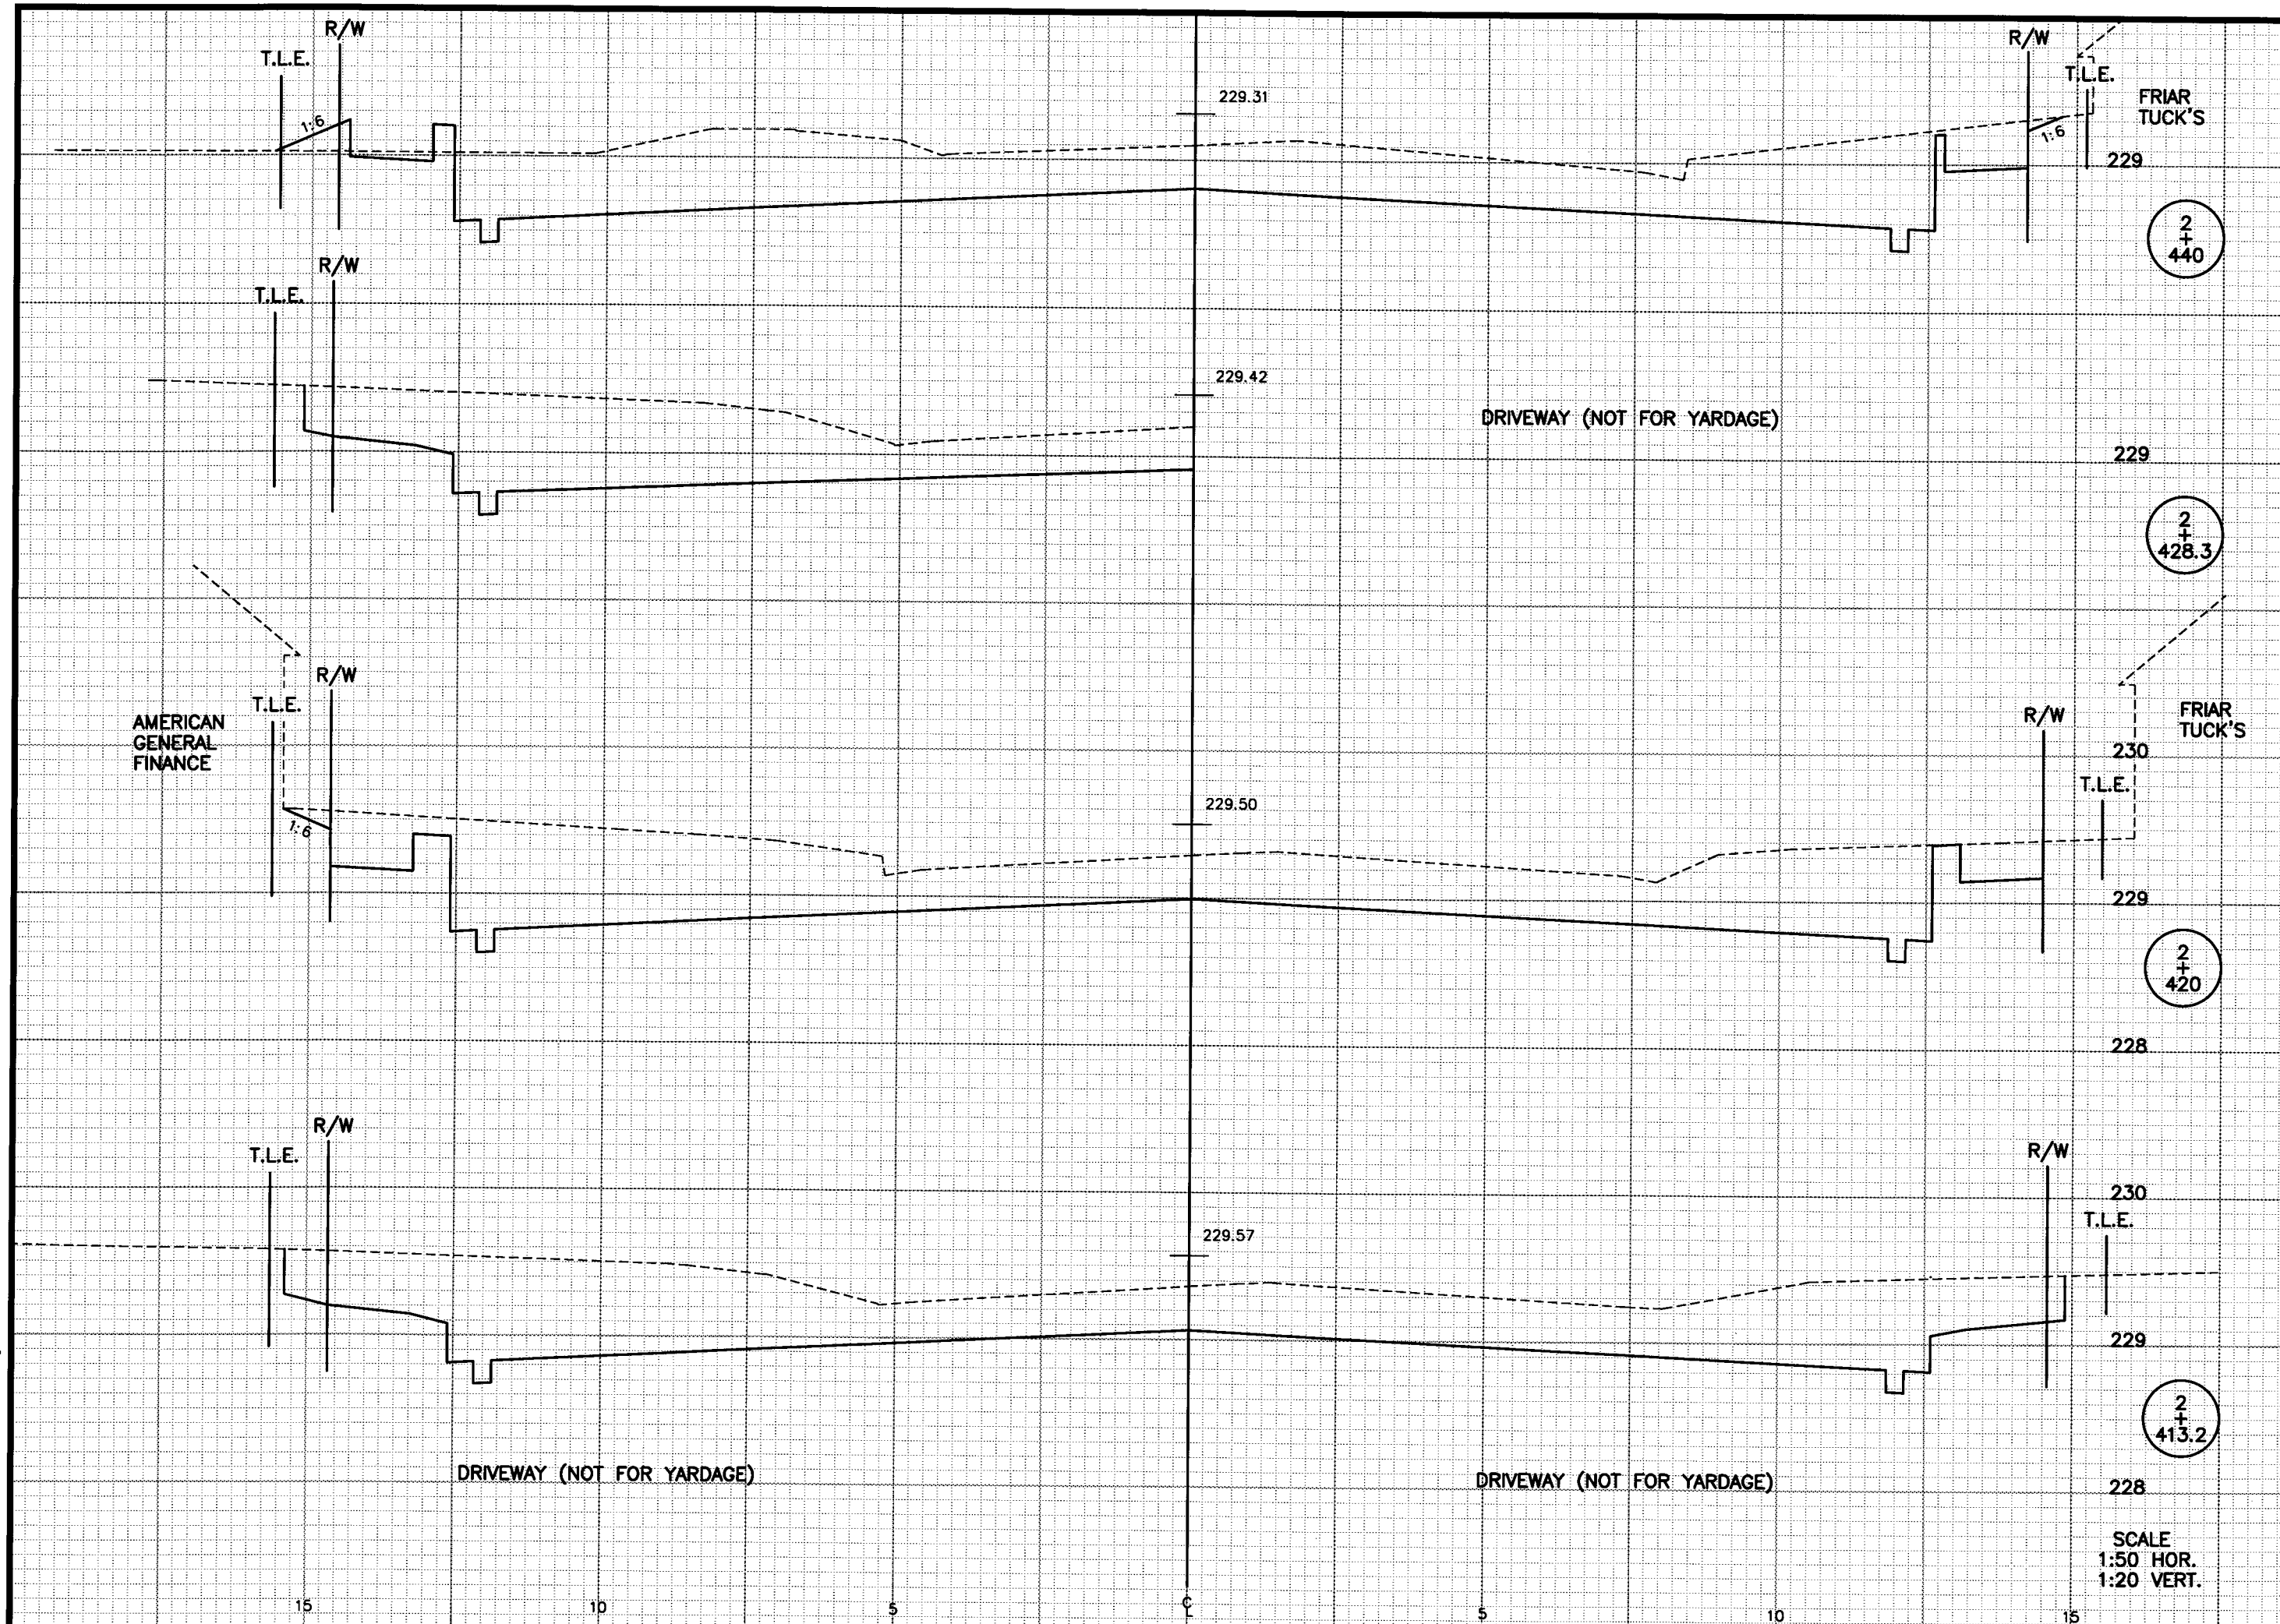

CROSS SECTIONS

STA. 2+413.2 - STA. 2+440

HWY: S.T.H. 23 COUNTY: FOND DU LAC


STATE PROJECT NO.: 1442-04-70

SHEET NO.: 7.2


M

Drawing File : XS2446


BRW CADD Sheet - MSECTION

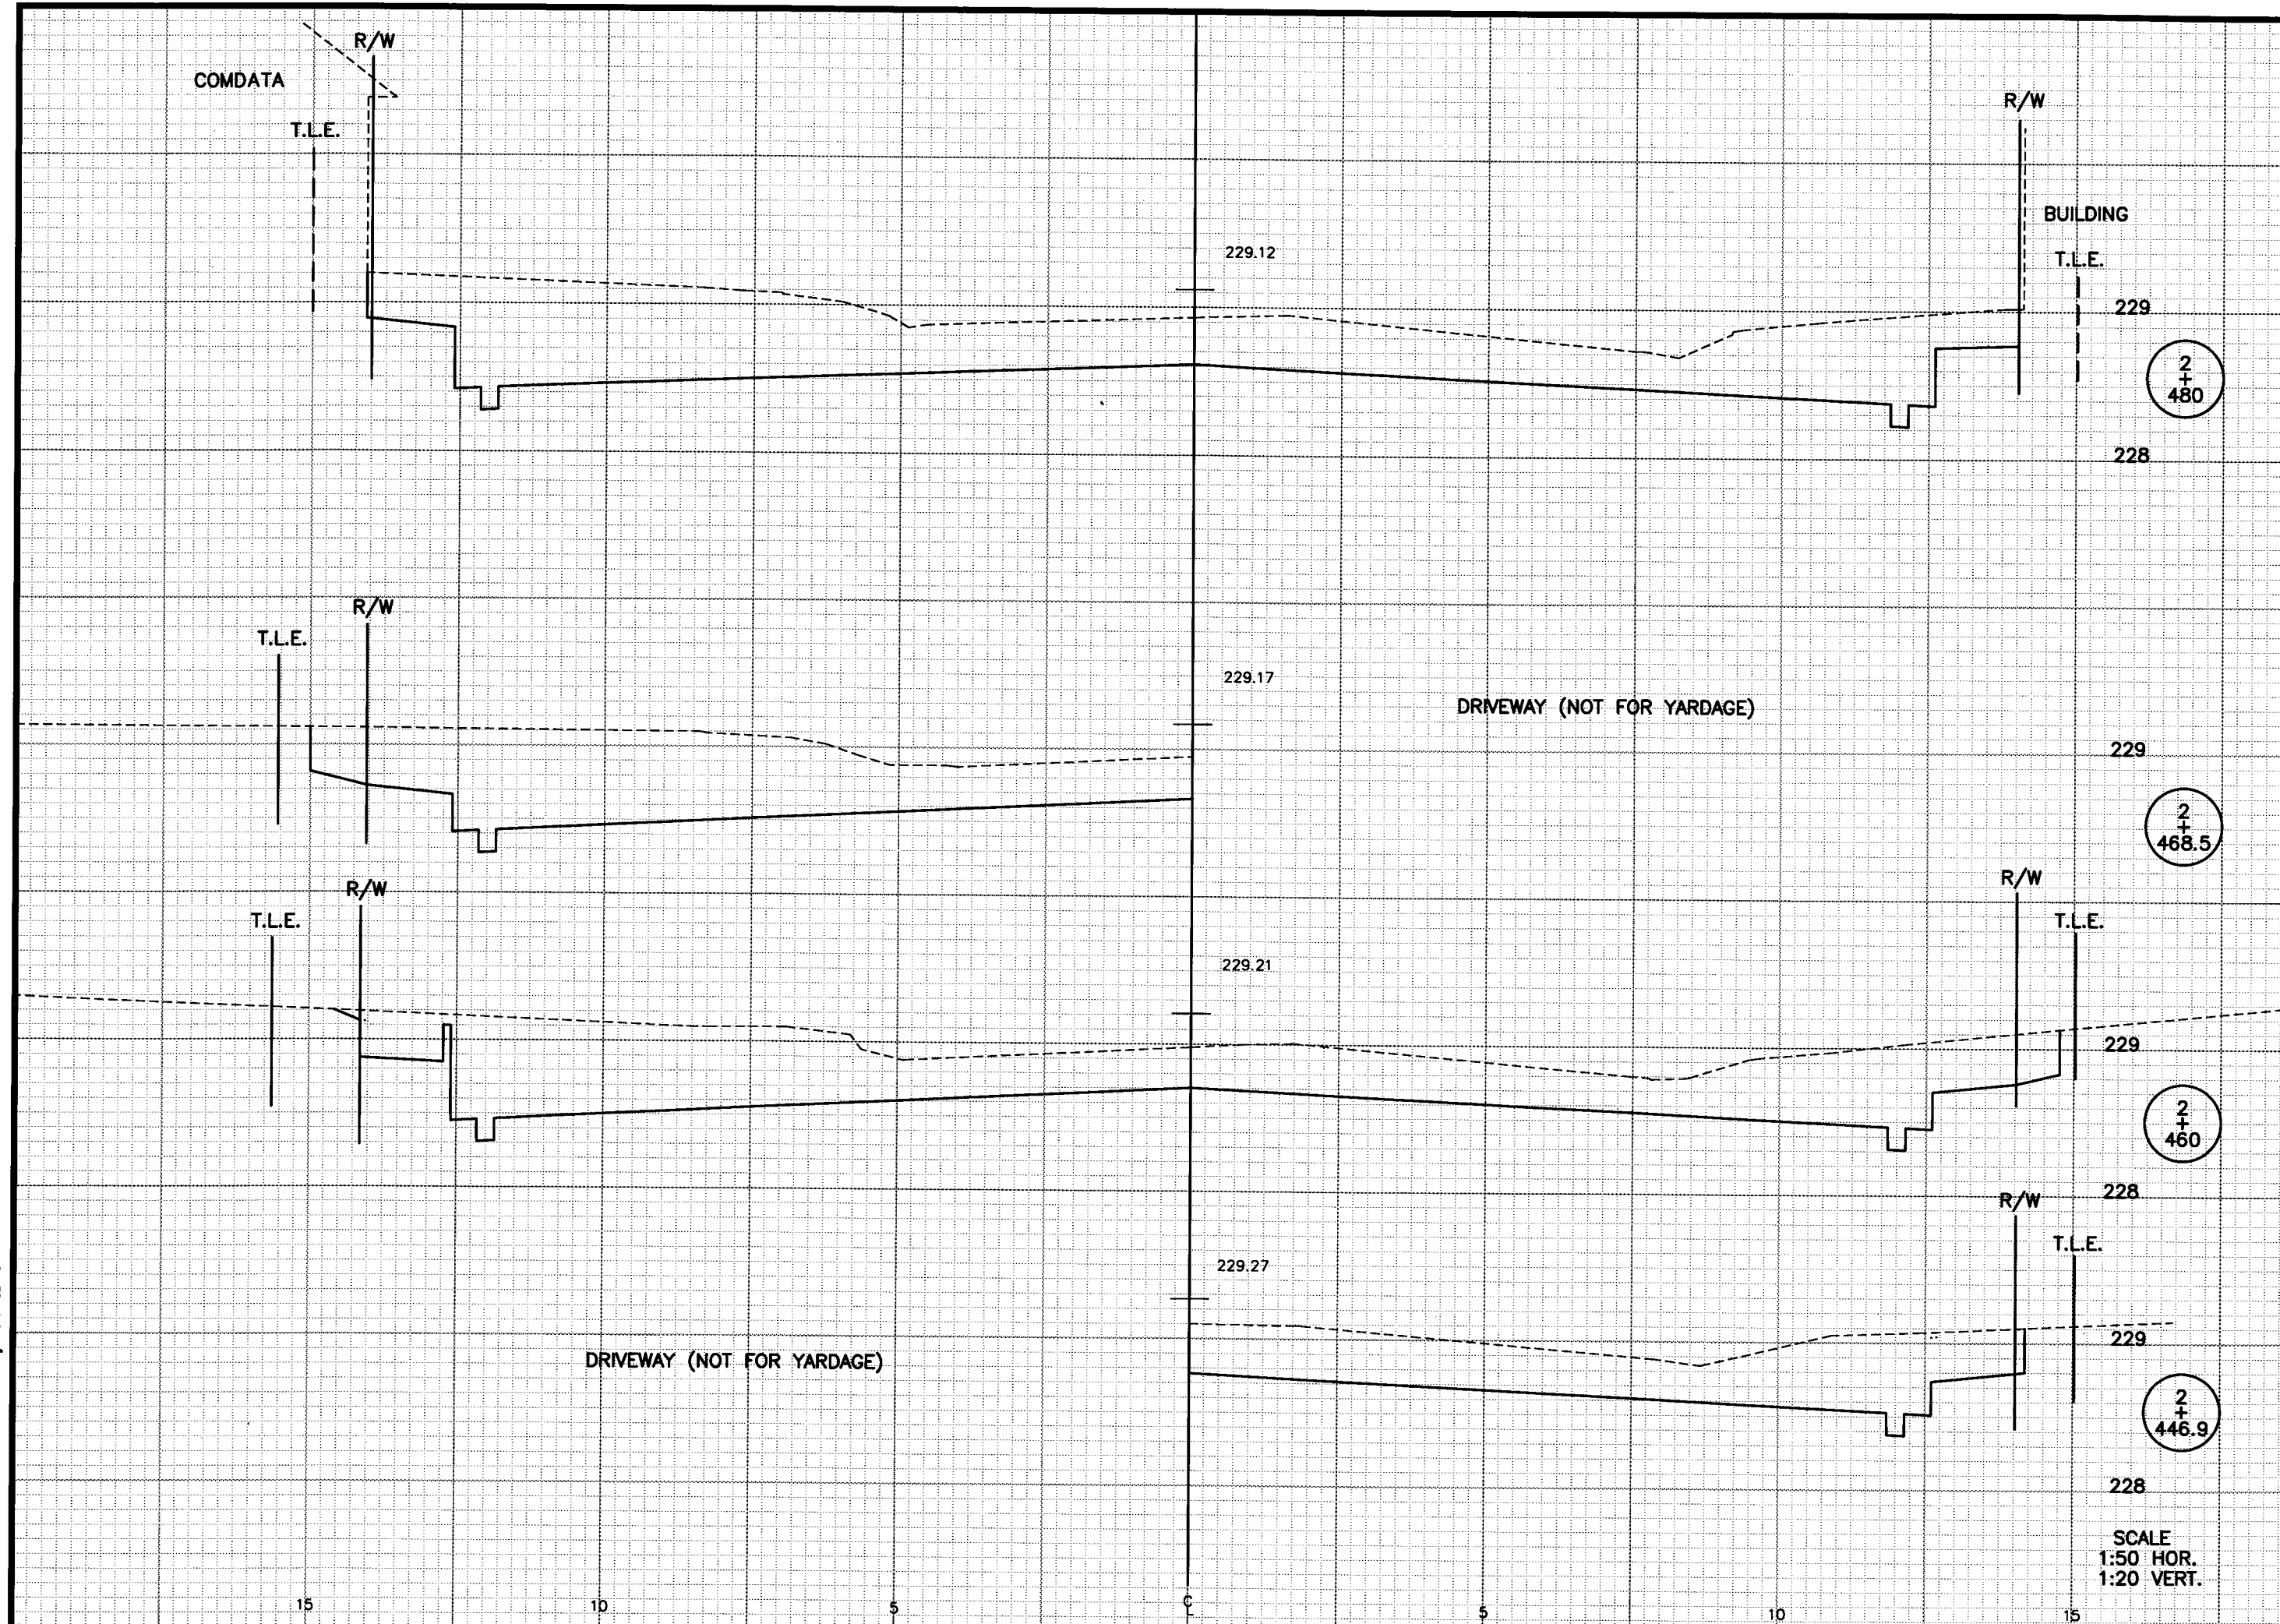

BRW CAD Sheet - WSECTION
Drawing File : X52496

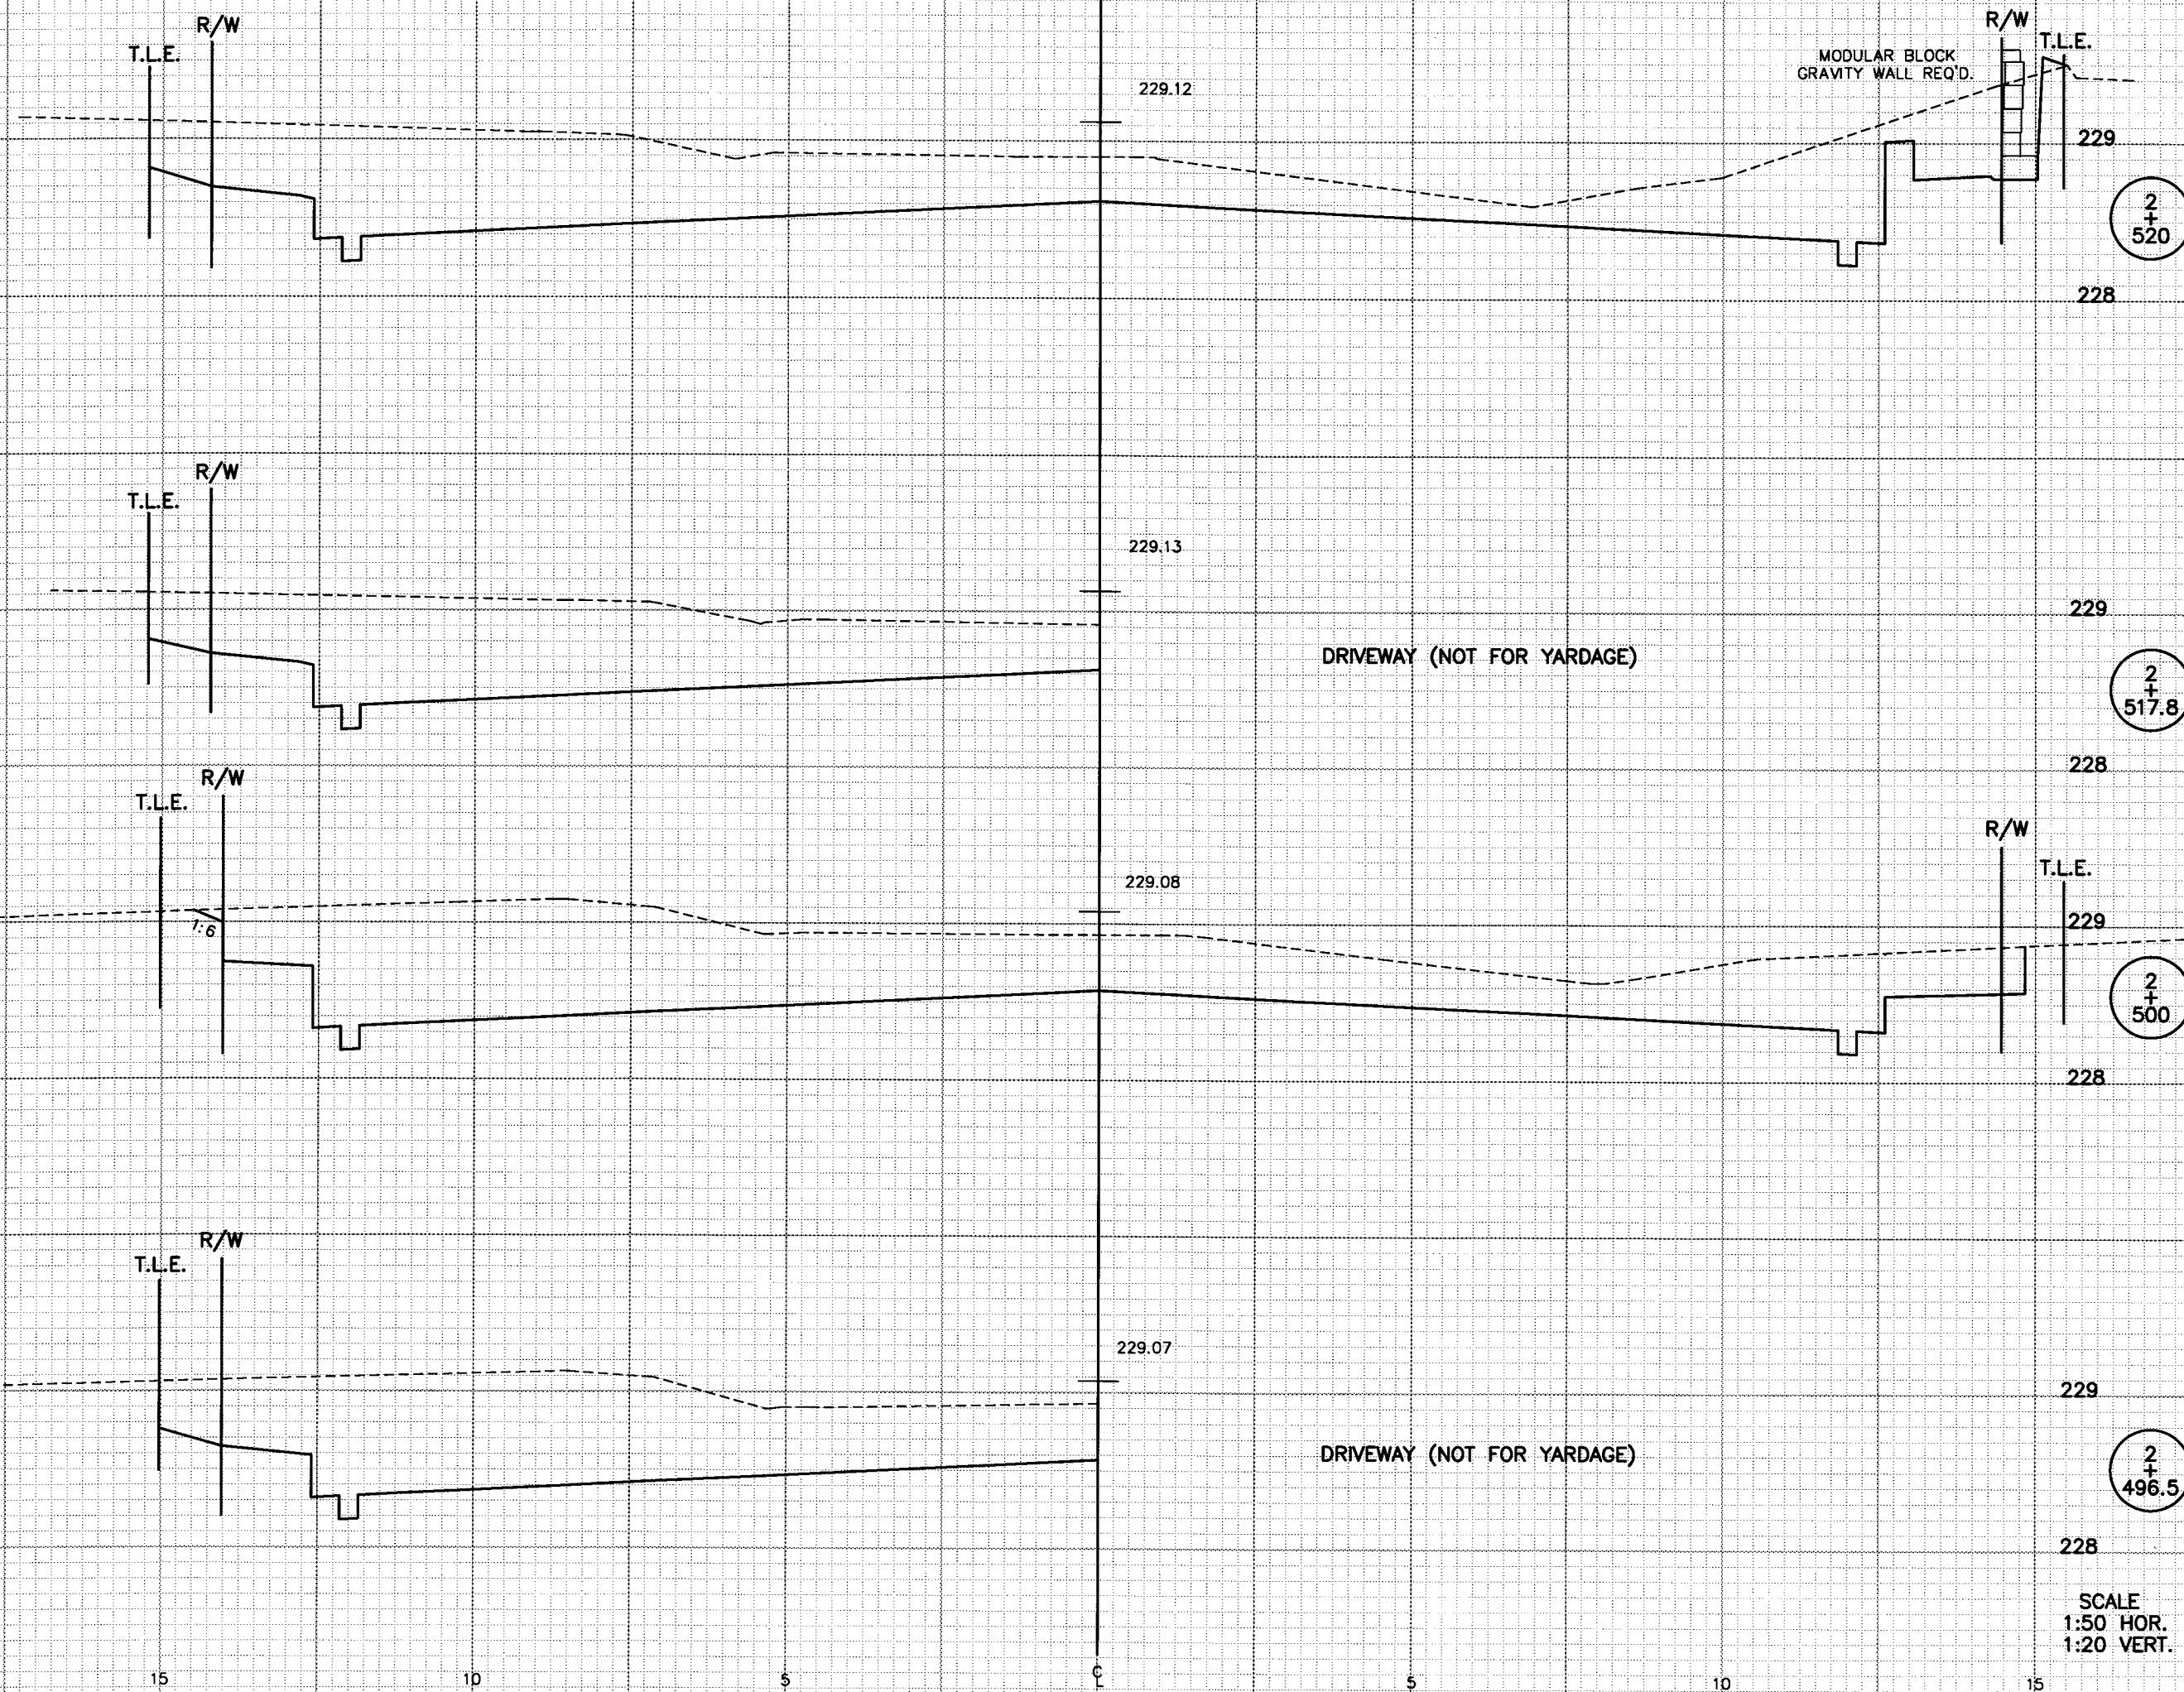

BRW CADD Sheet - MSECTION
Drawing File : XS2540

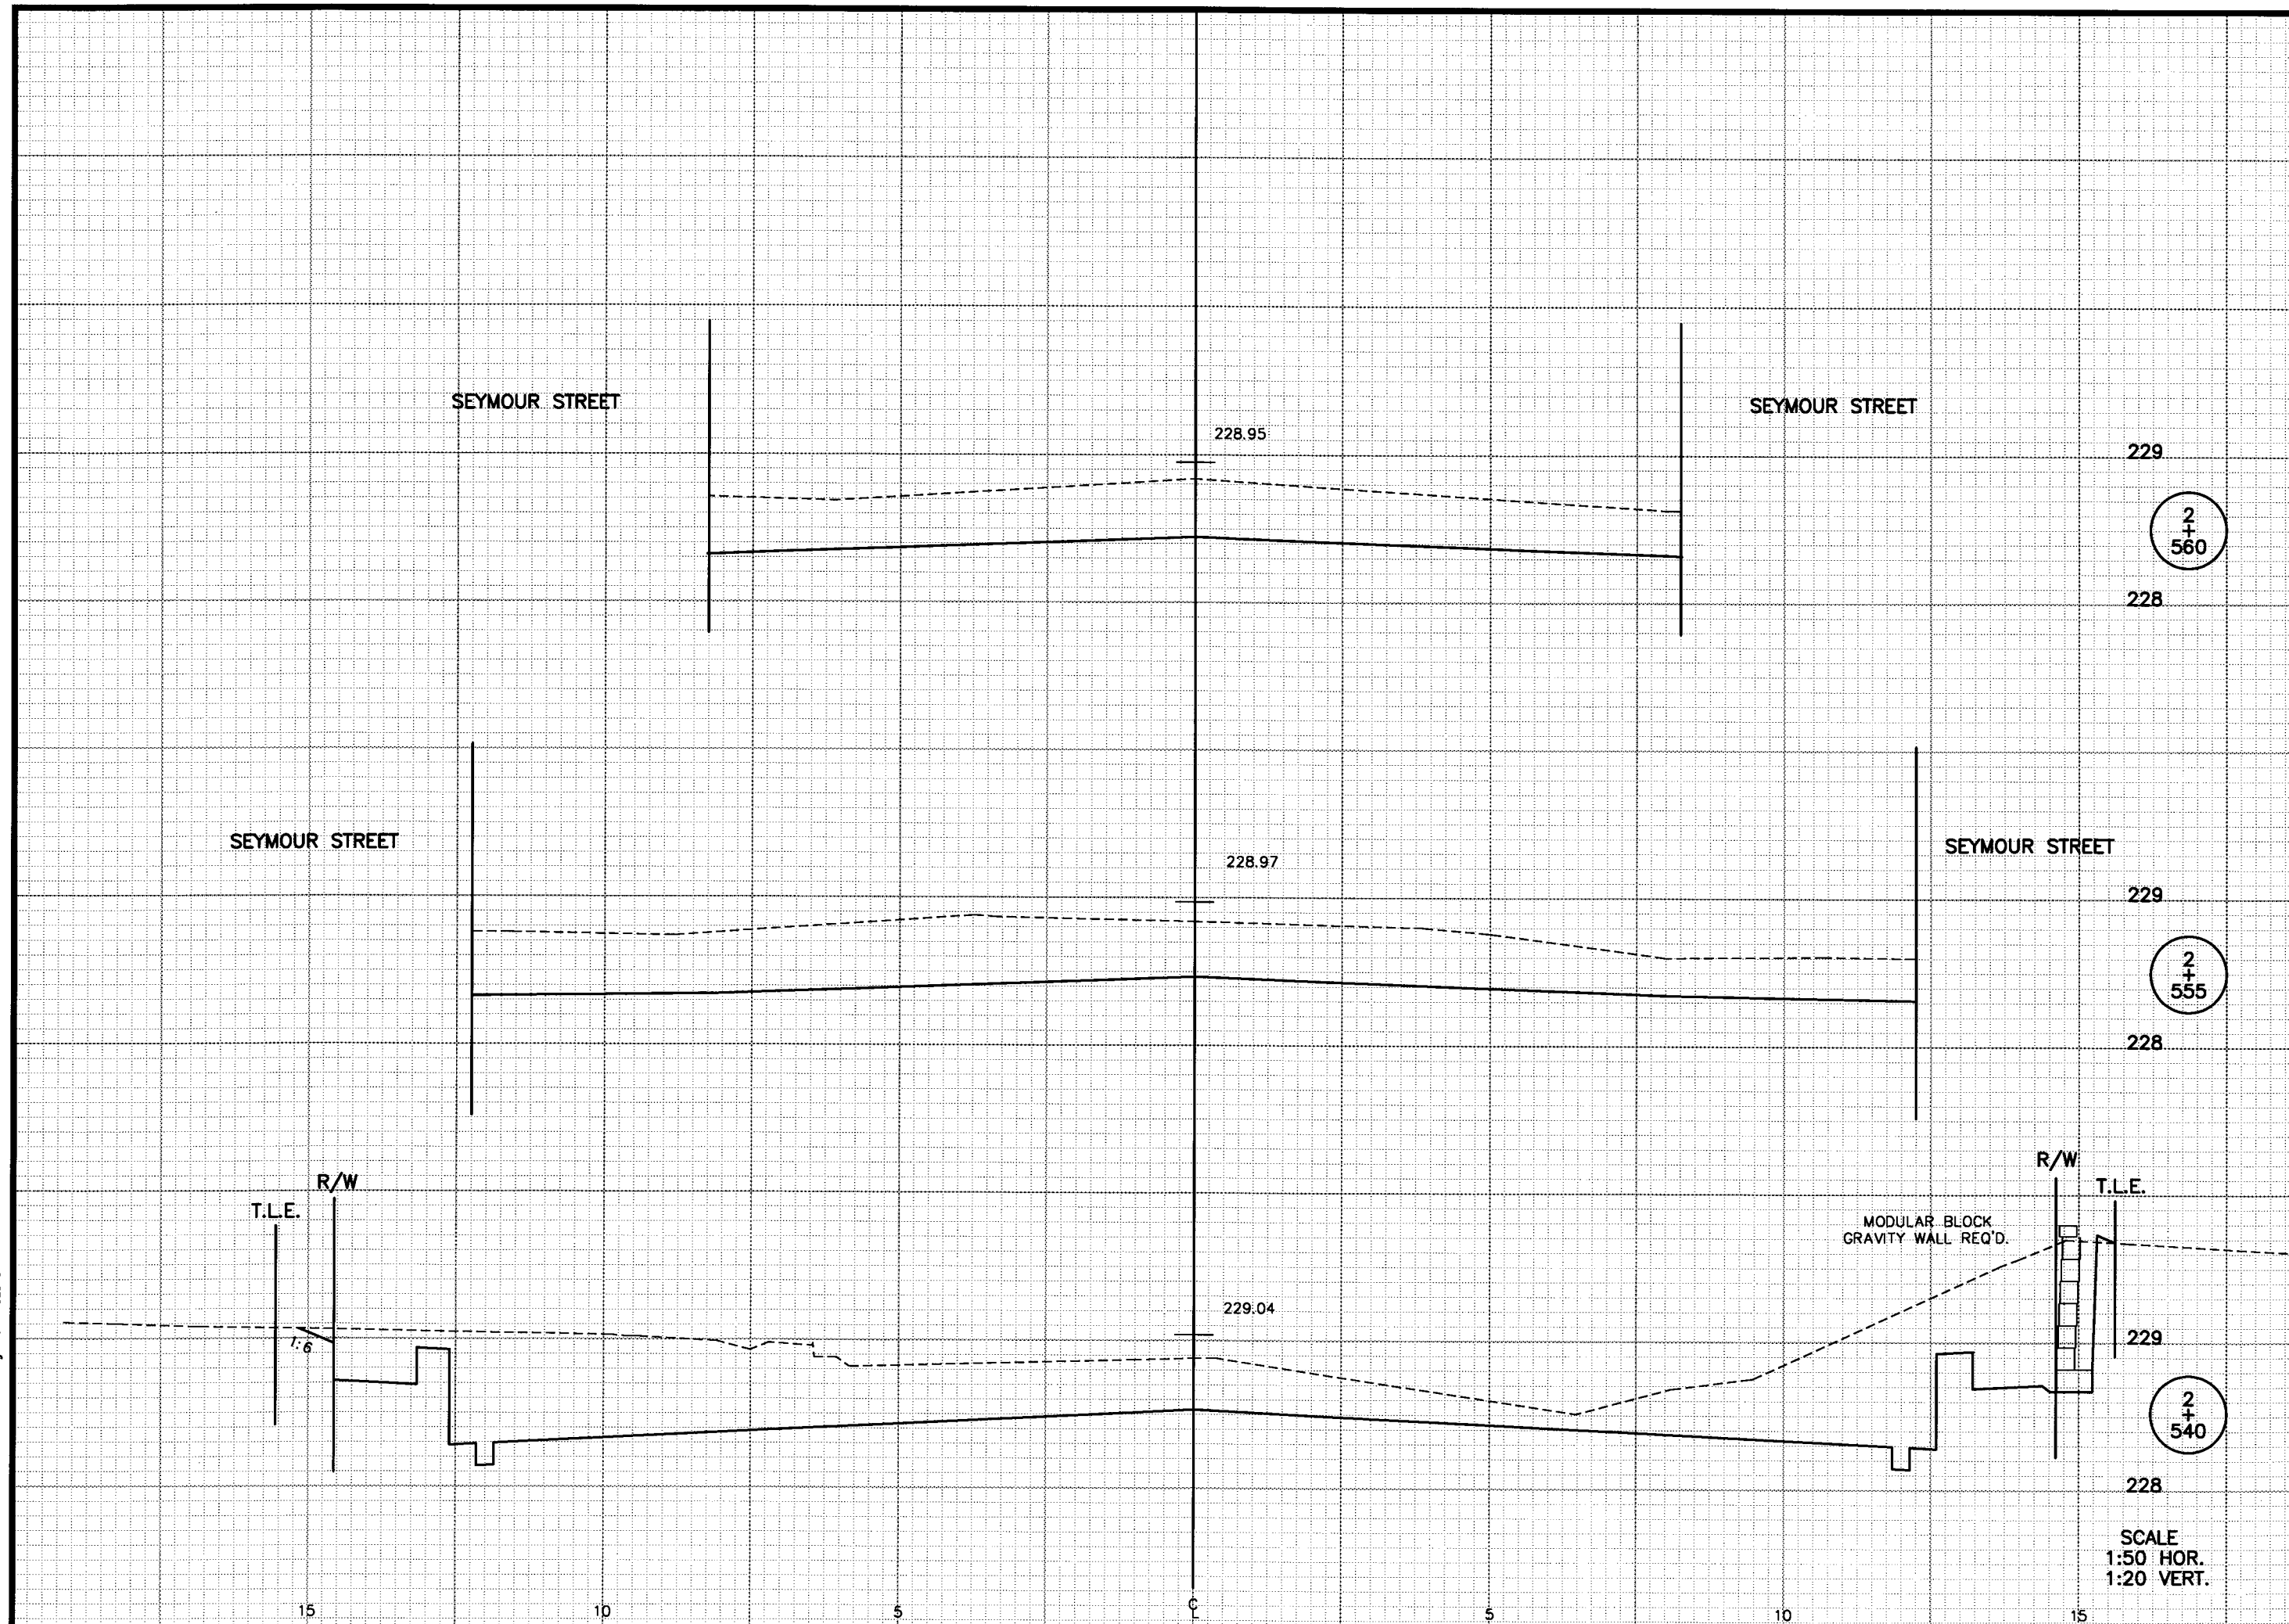

BRW CDD Sheet - MSECTION
Drawing File : XS2580

T.L.E.
R/W

228.69

DRIVEWAY (NOT FOR YARDAGE)

229

228

2
+
617.5

T.L.E.
R/W

228.74

DRIVEWAY (NOT FOR YARDAGE)

229

228

2
+
607

T.L.E.
R/W

228.77

R/W

T.L.E.

229

228

2
+
600

T.L.E.
R/W

228.86

R/W

T.L.E.

1/6

229

228

2
+
580

SCALE
1:50 HOR.
1:20 VERT.

CROSS SECTIONS

STA. 2+580 - STA. 2+617.5


HWY: S.T.H. 23 COUNTY: FOND DU LAC

STATE PROJECT NO.: 1442-04-70


SHEET NO.: 9.25

M


BRW CAD Sheet - MSECTION
Drawing File : MS2620

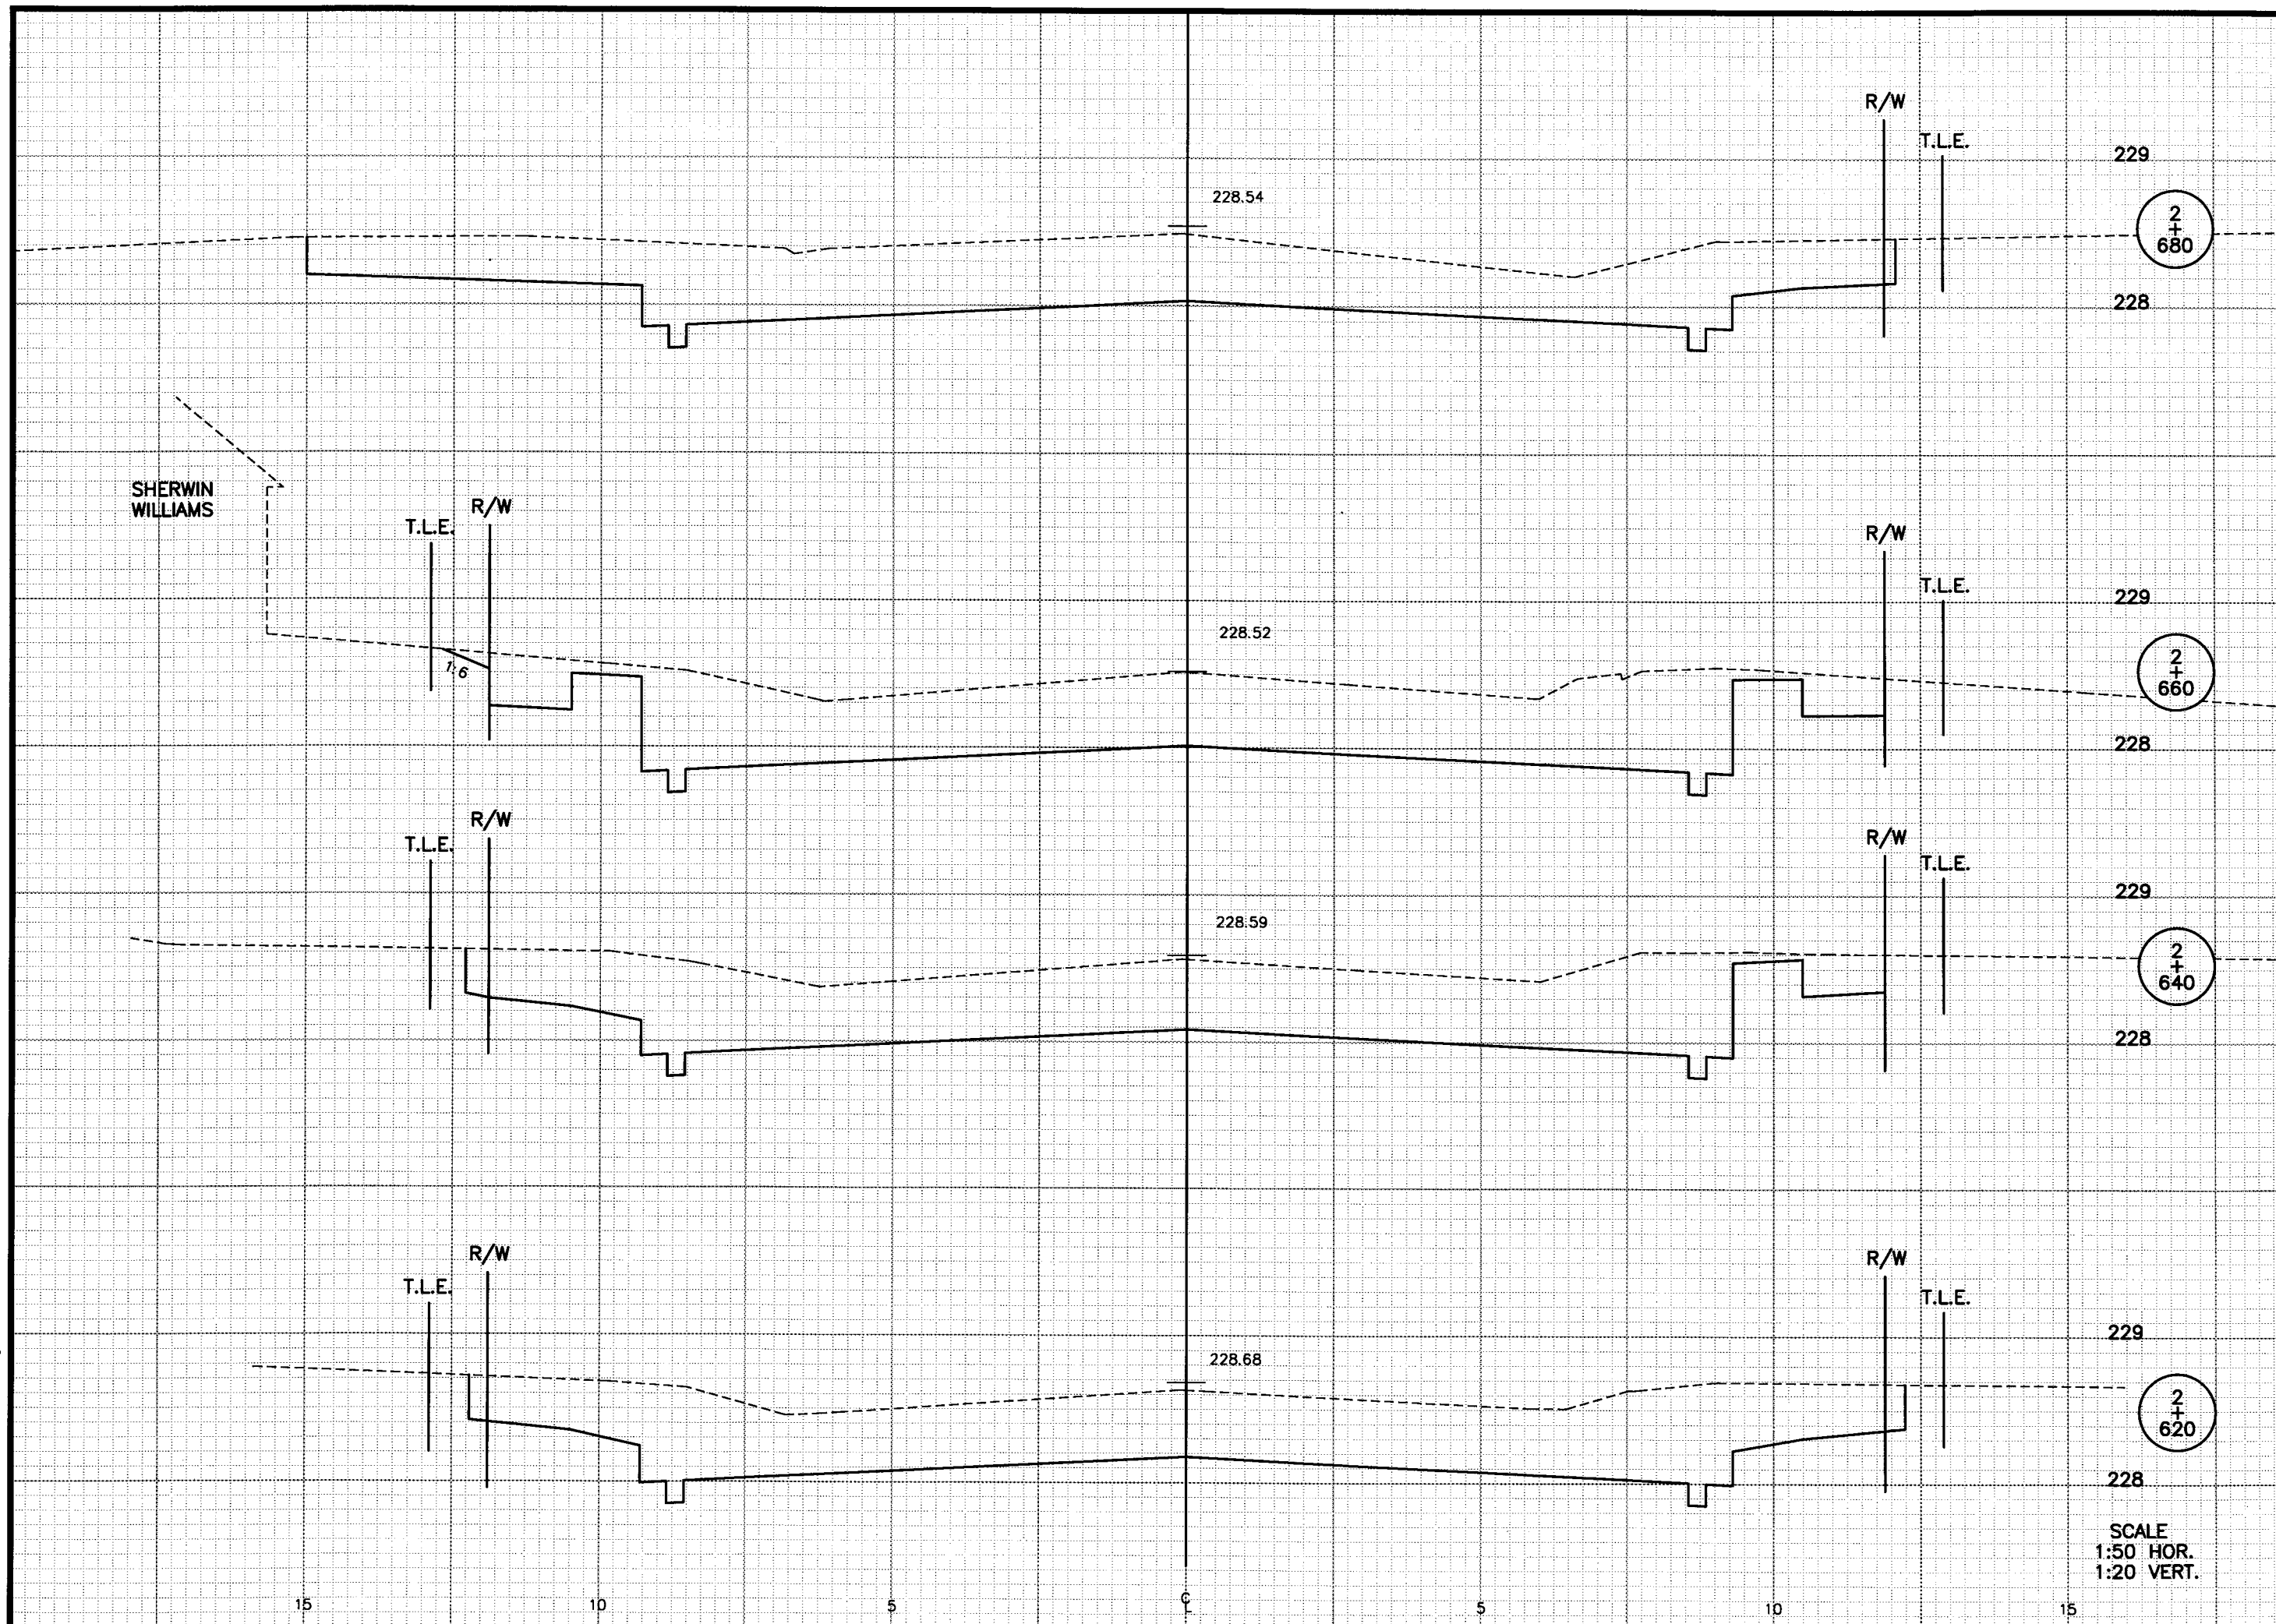


BRW CADD Sheet - MSECTION
Drawing File : XS2700

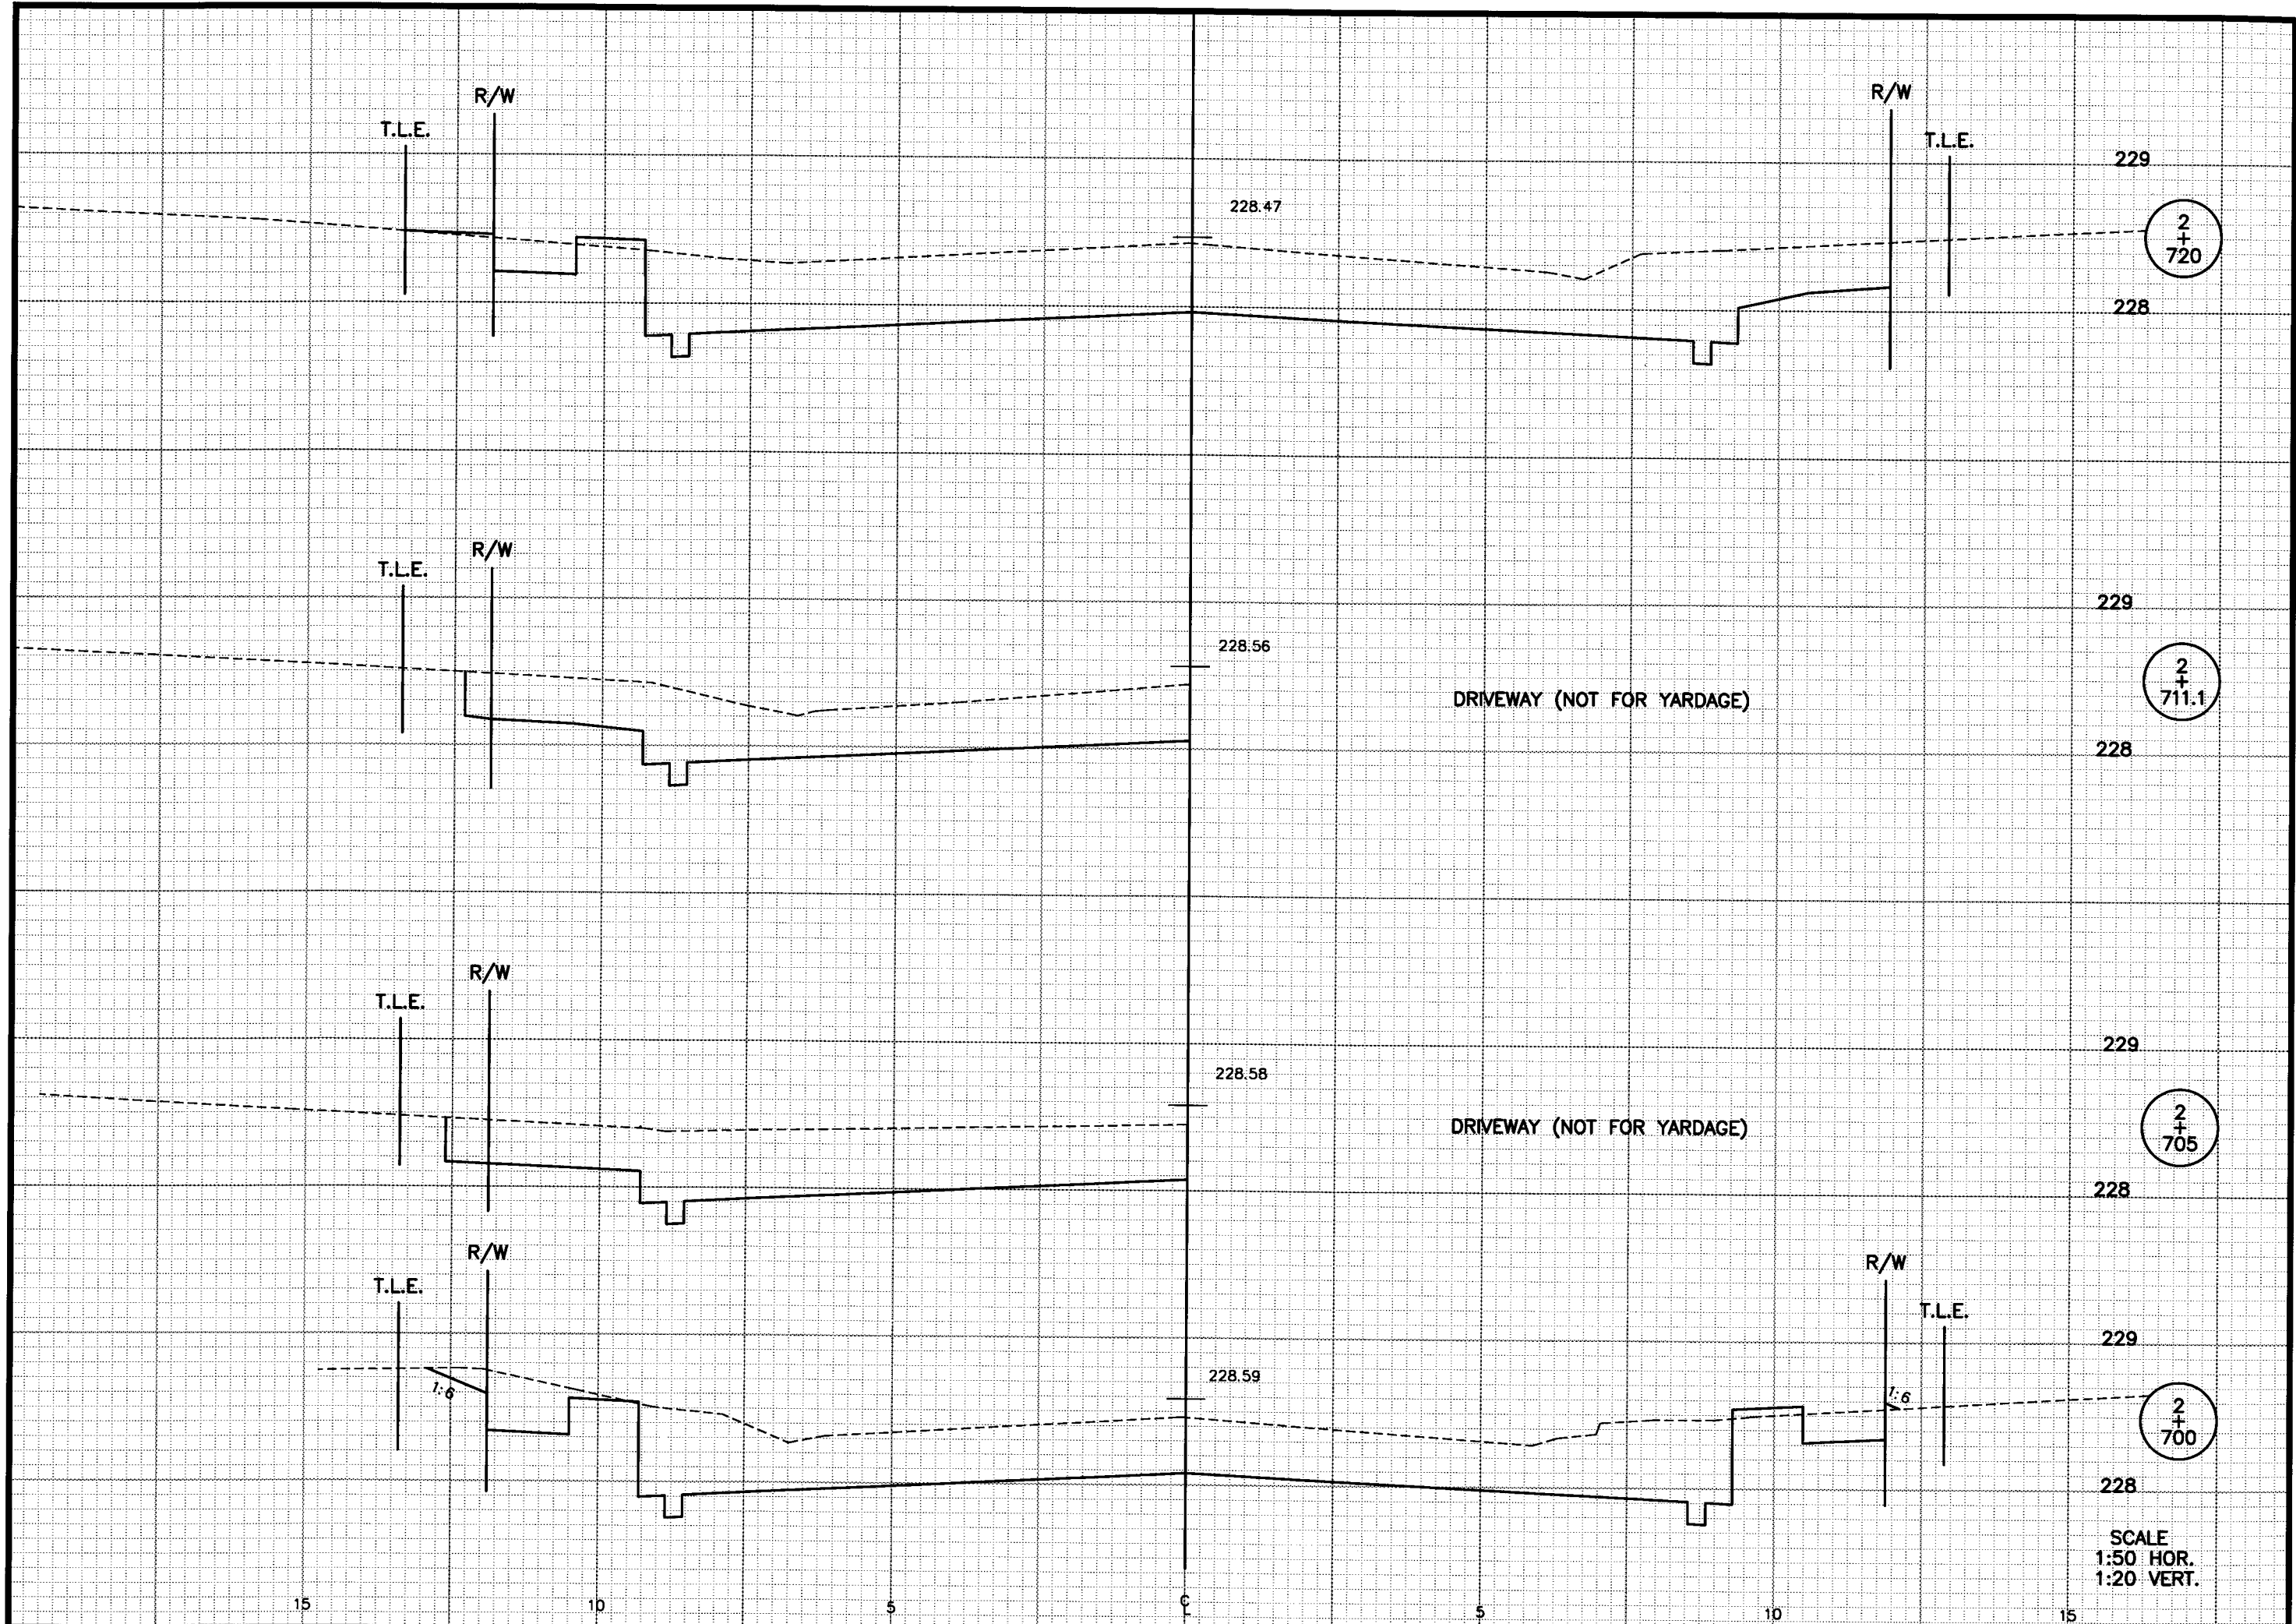


BRW CAD Sheet - INSECTION
Drawing File : XS2738

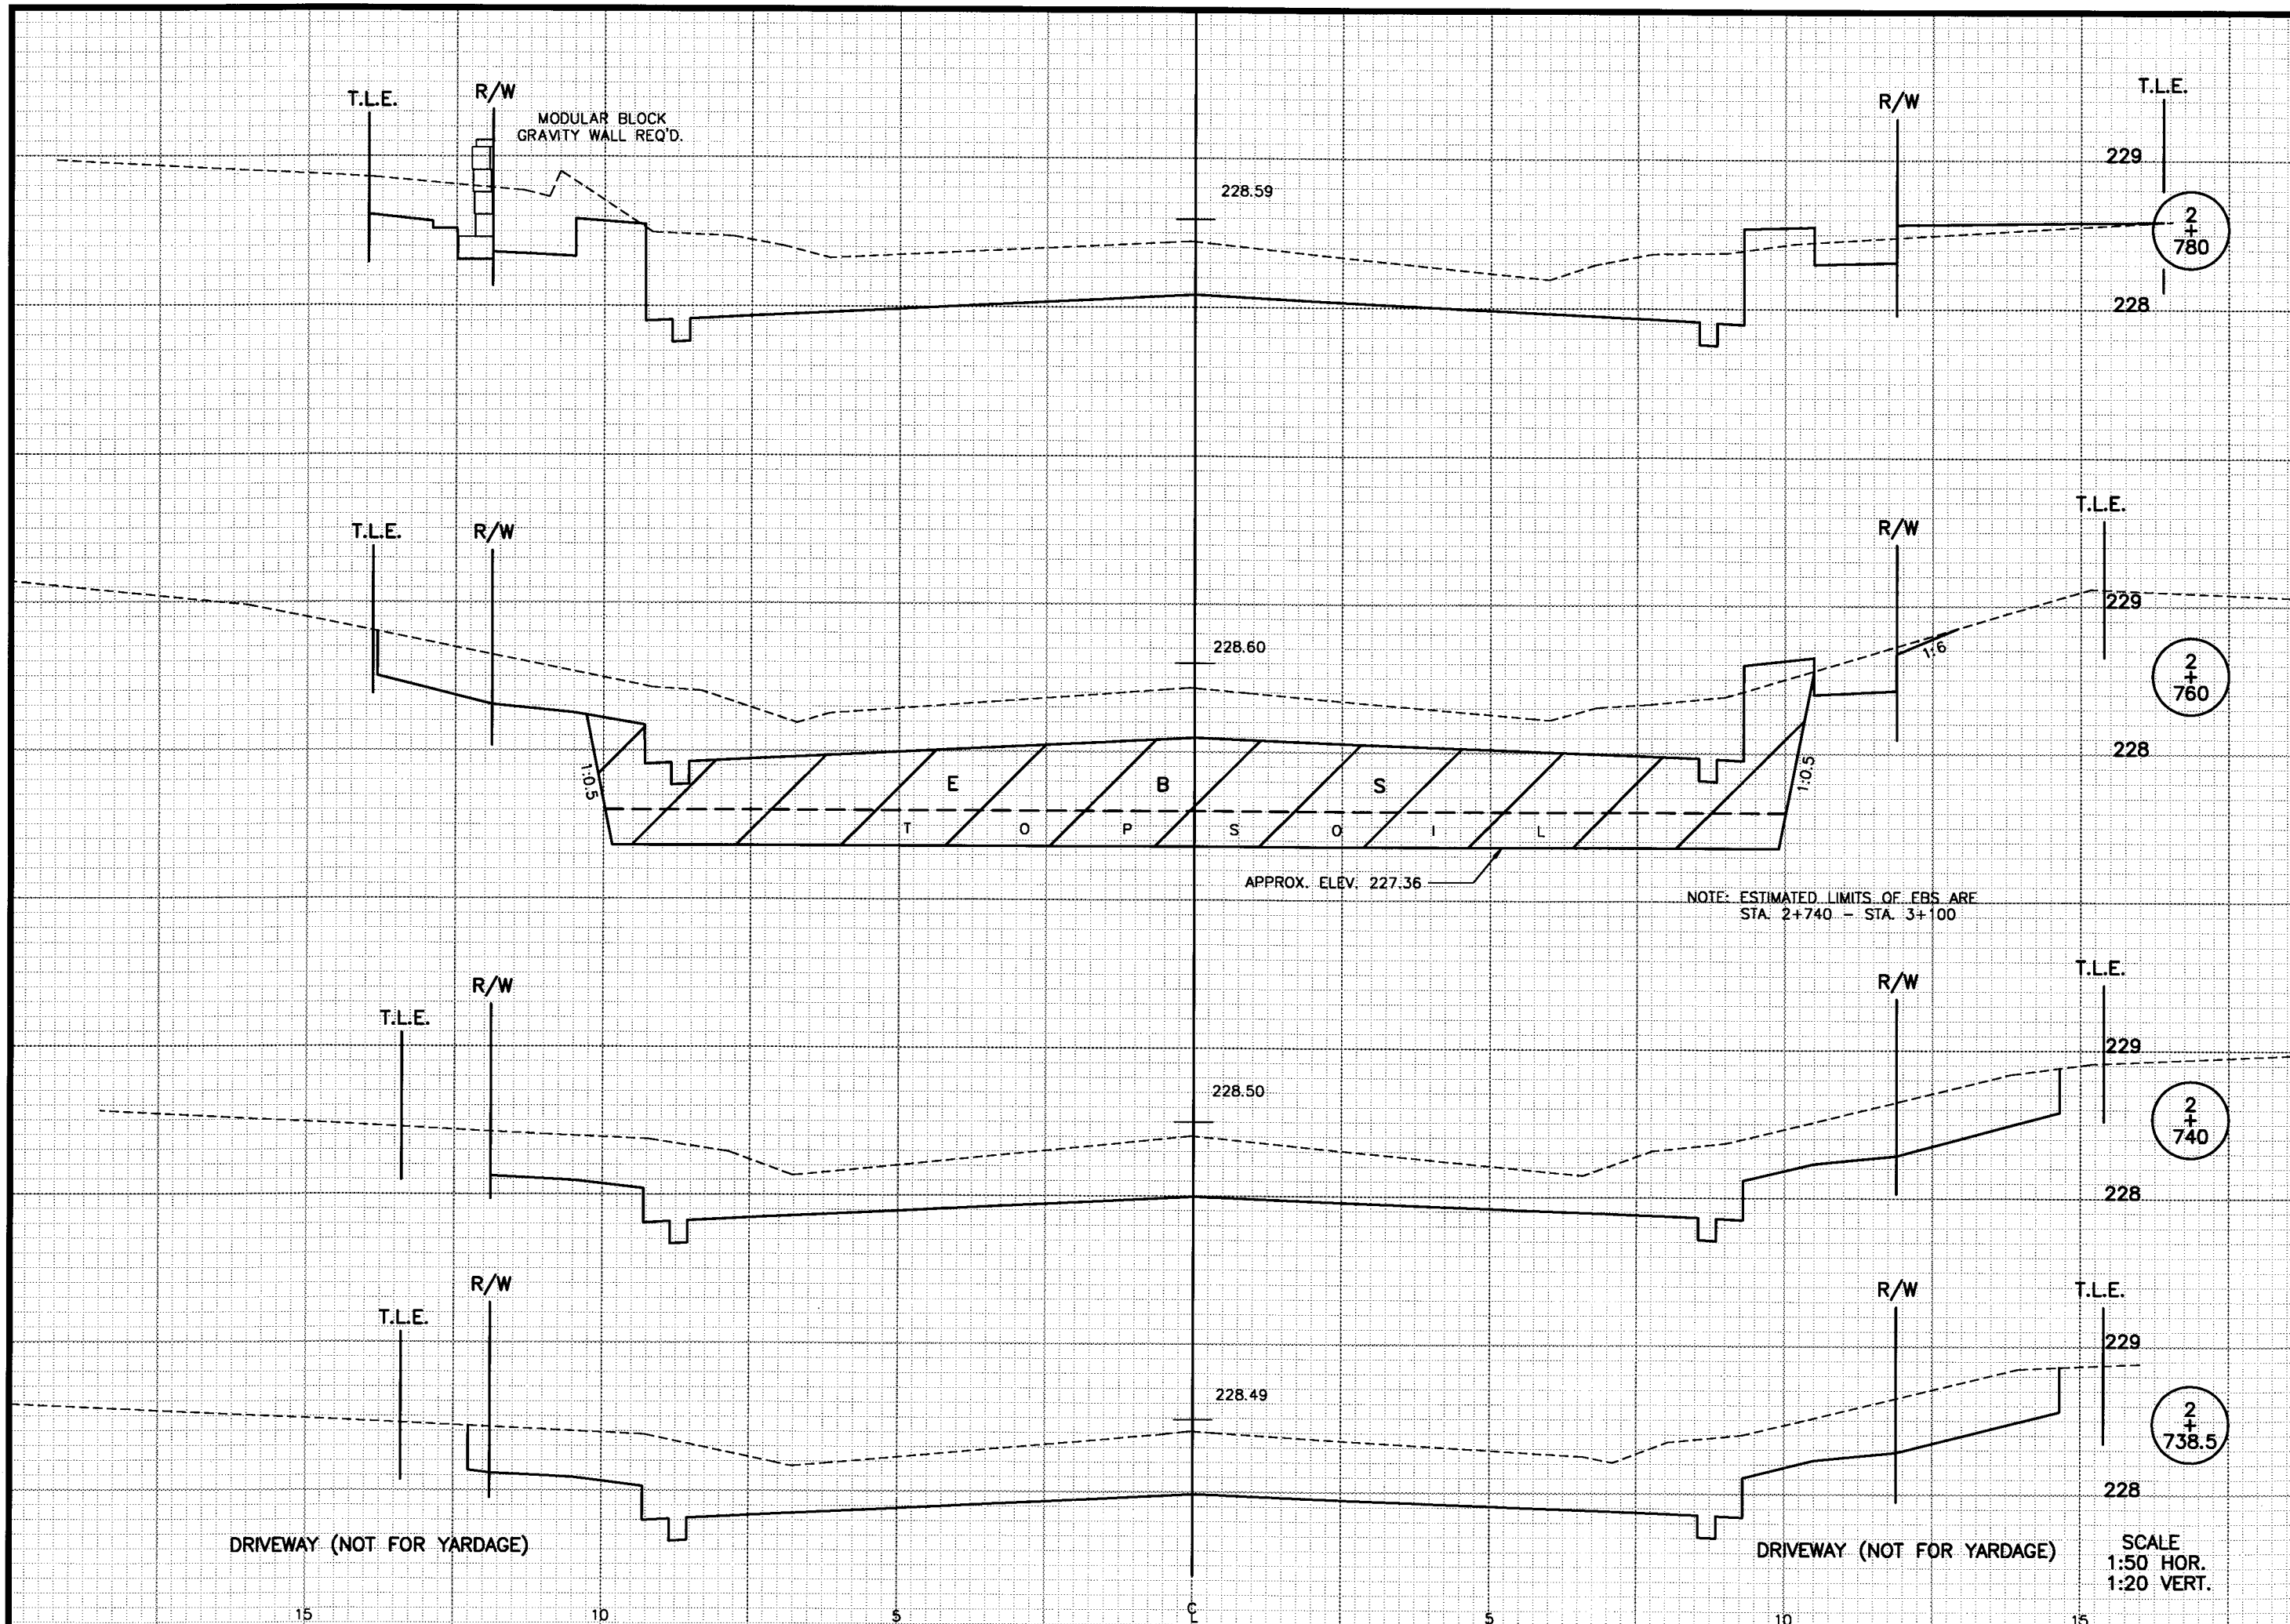


BRW CADD Sheet - MSECTION
Drawing File : X52800

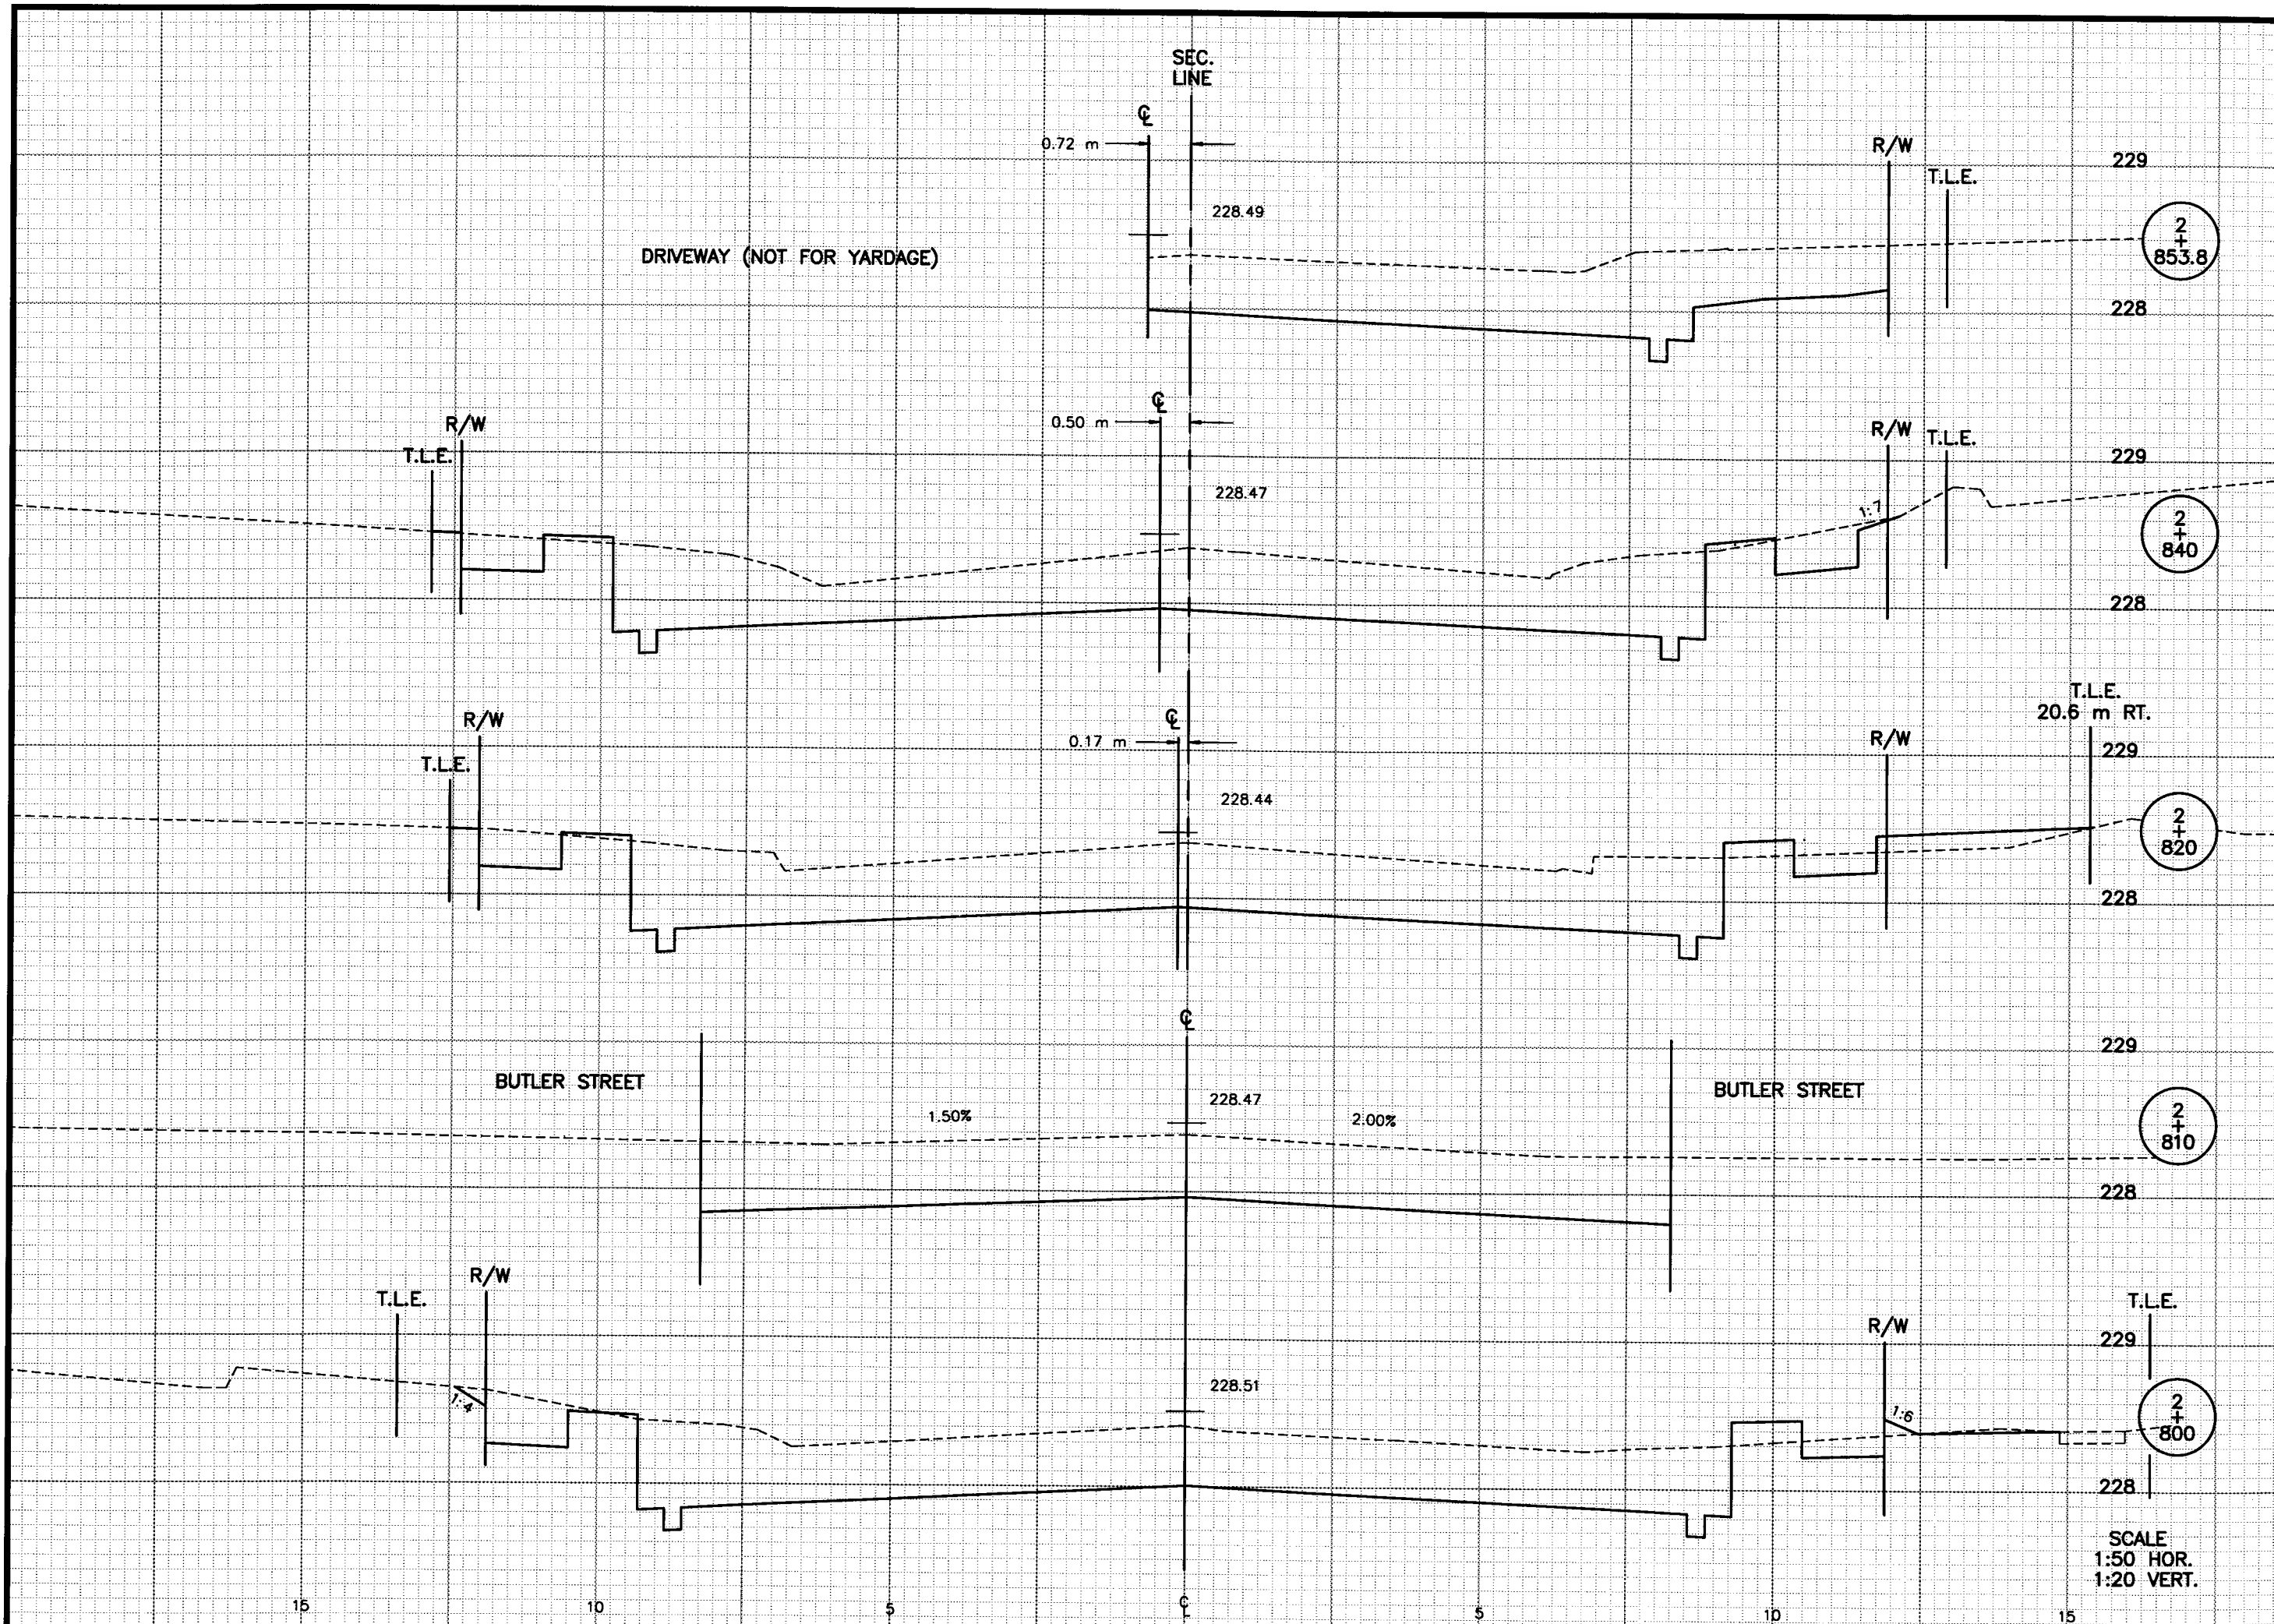


BRW CADD Sheet - MSECTION
Drawing File : XS2860

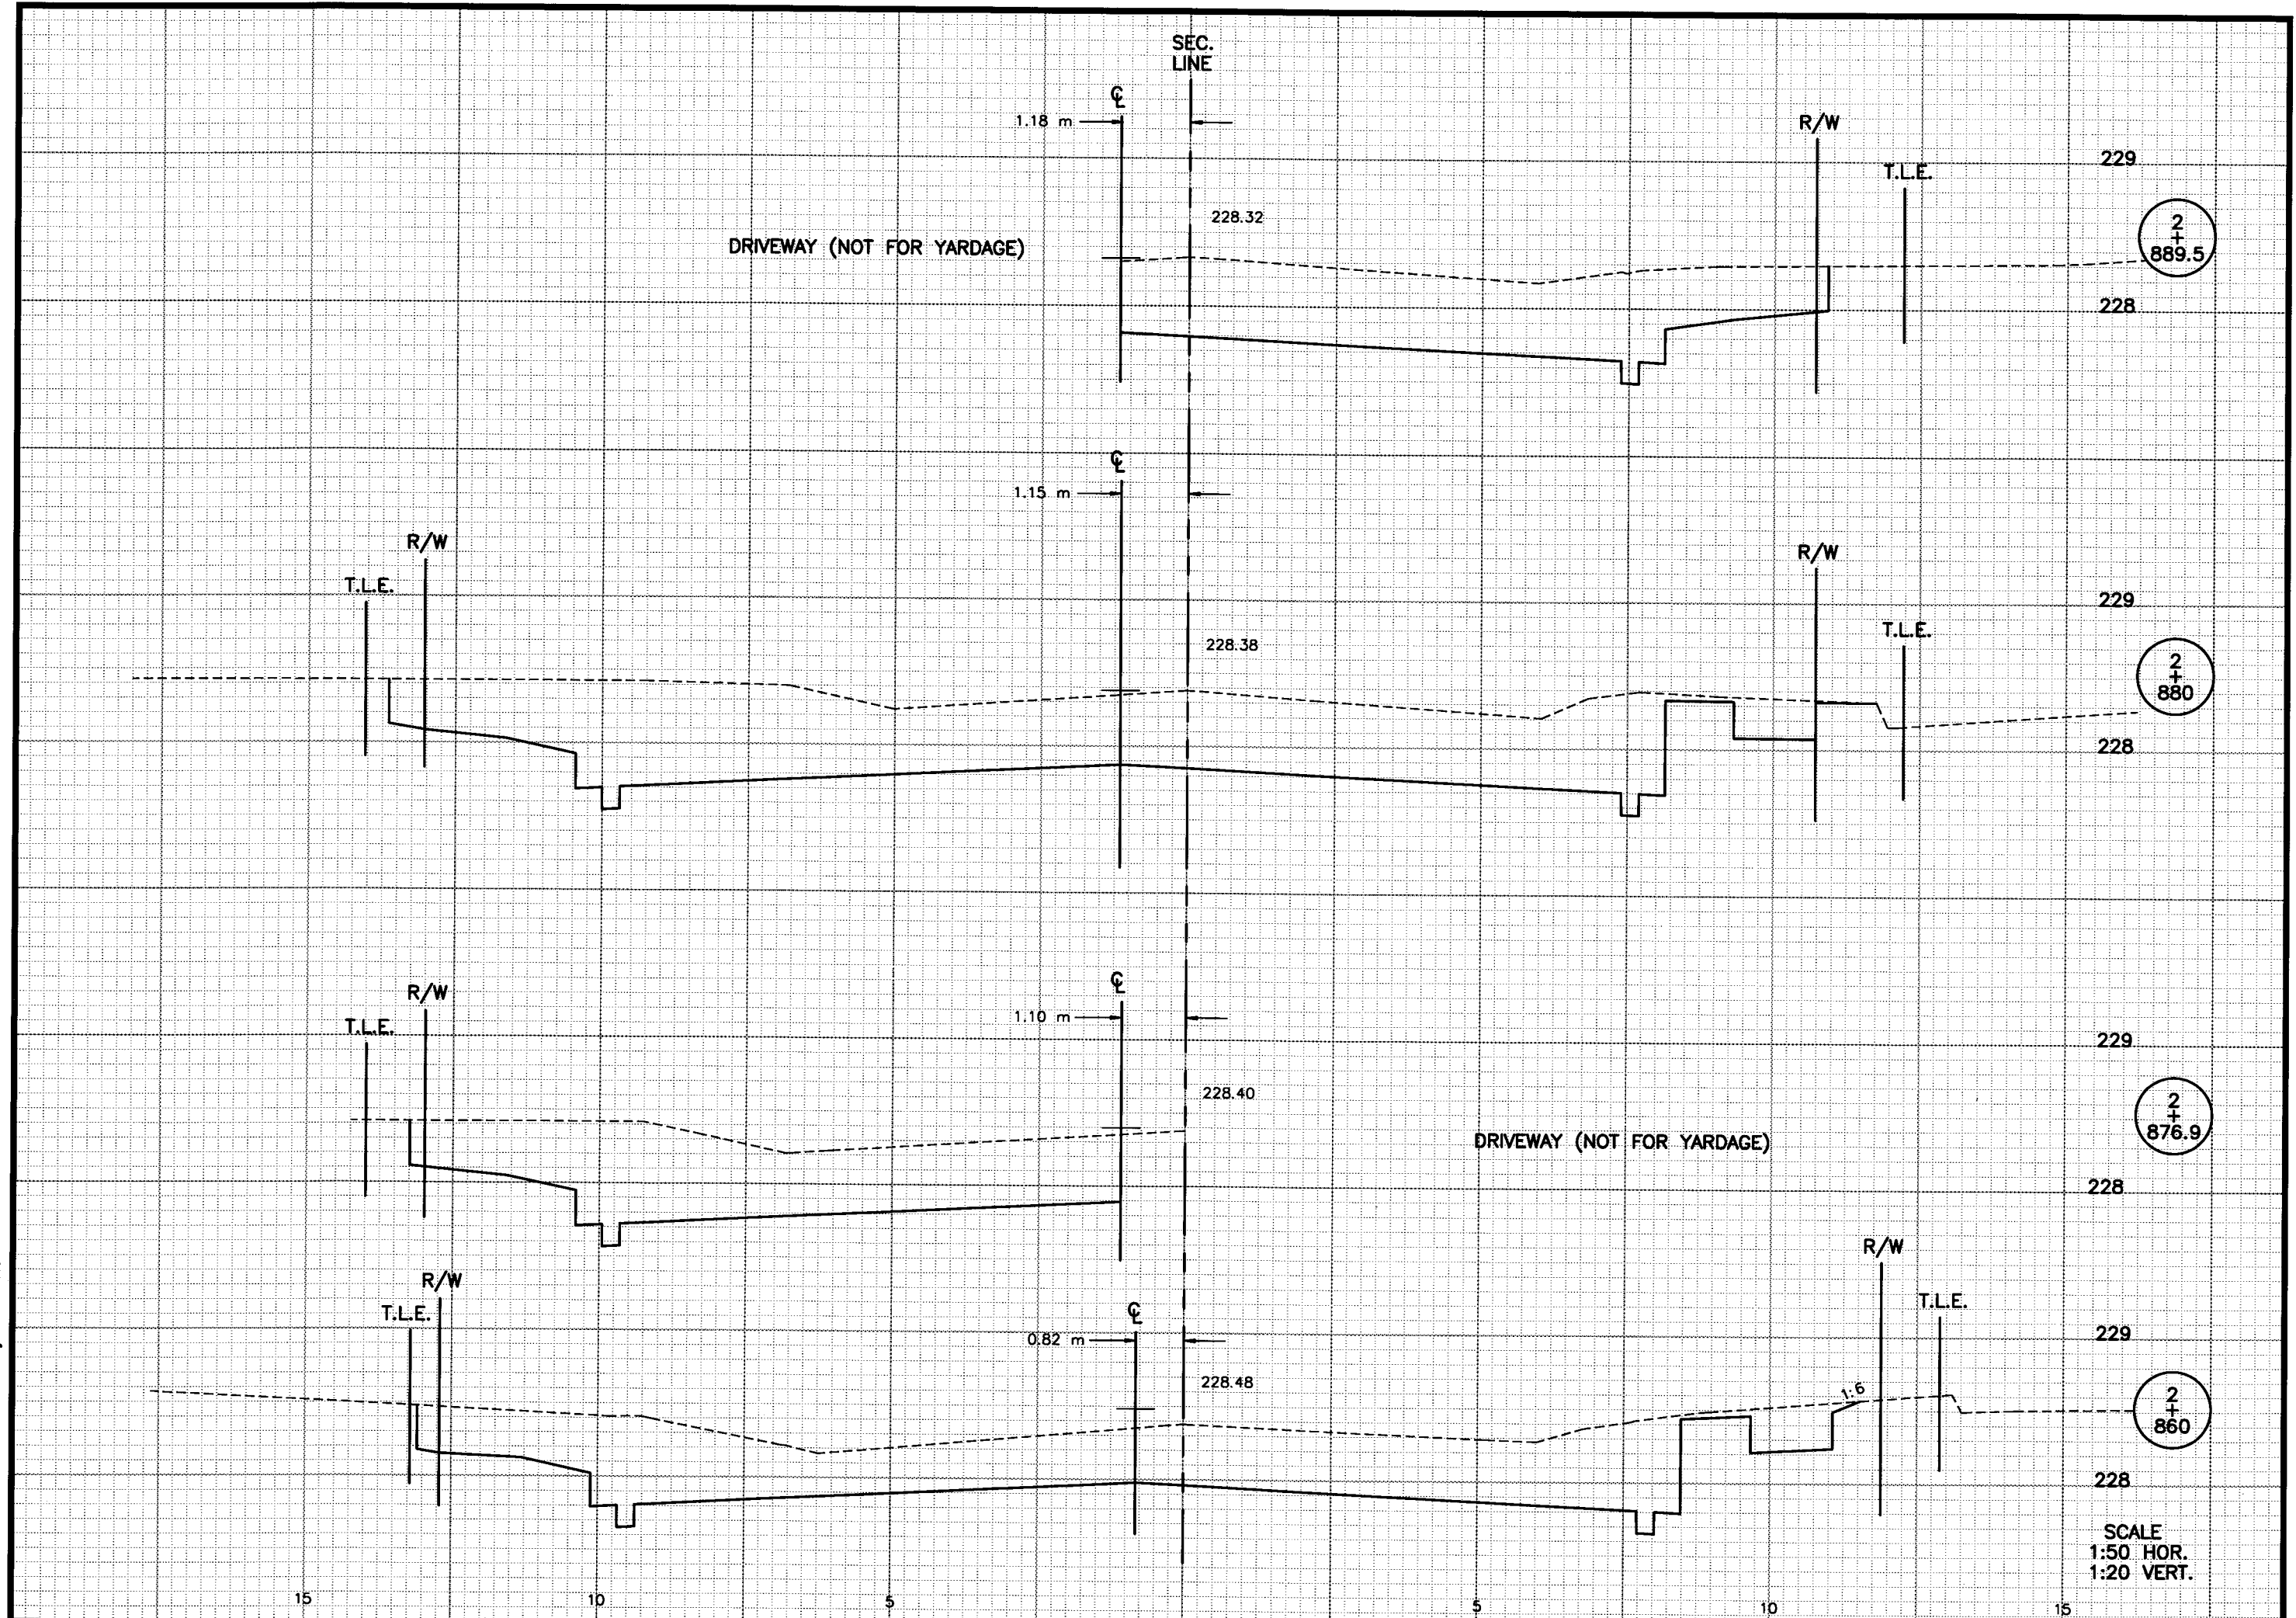


BRW CUD Sheet - MSECTION
Drawing File : XS2900

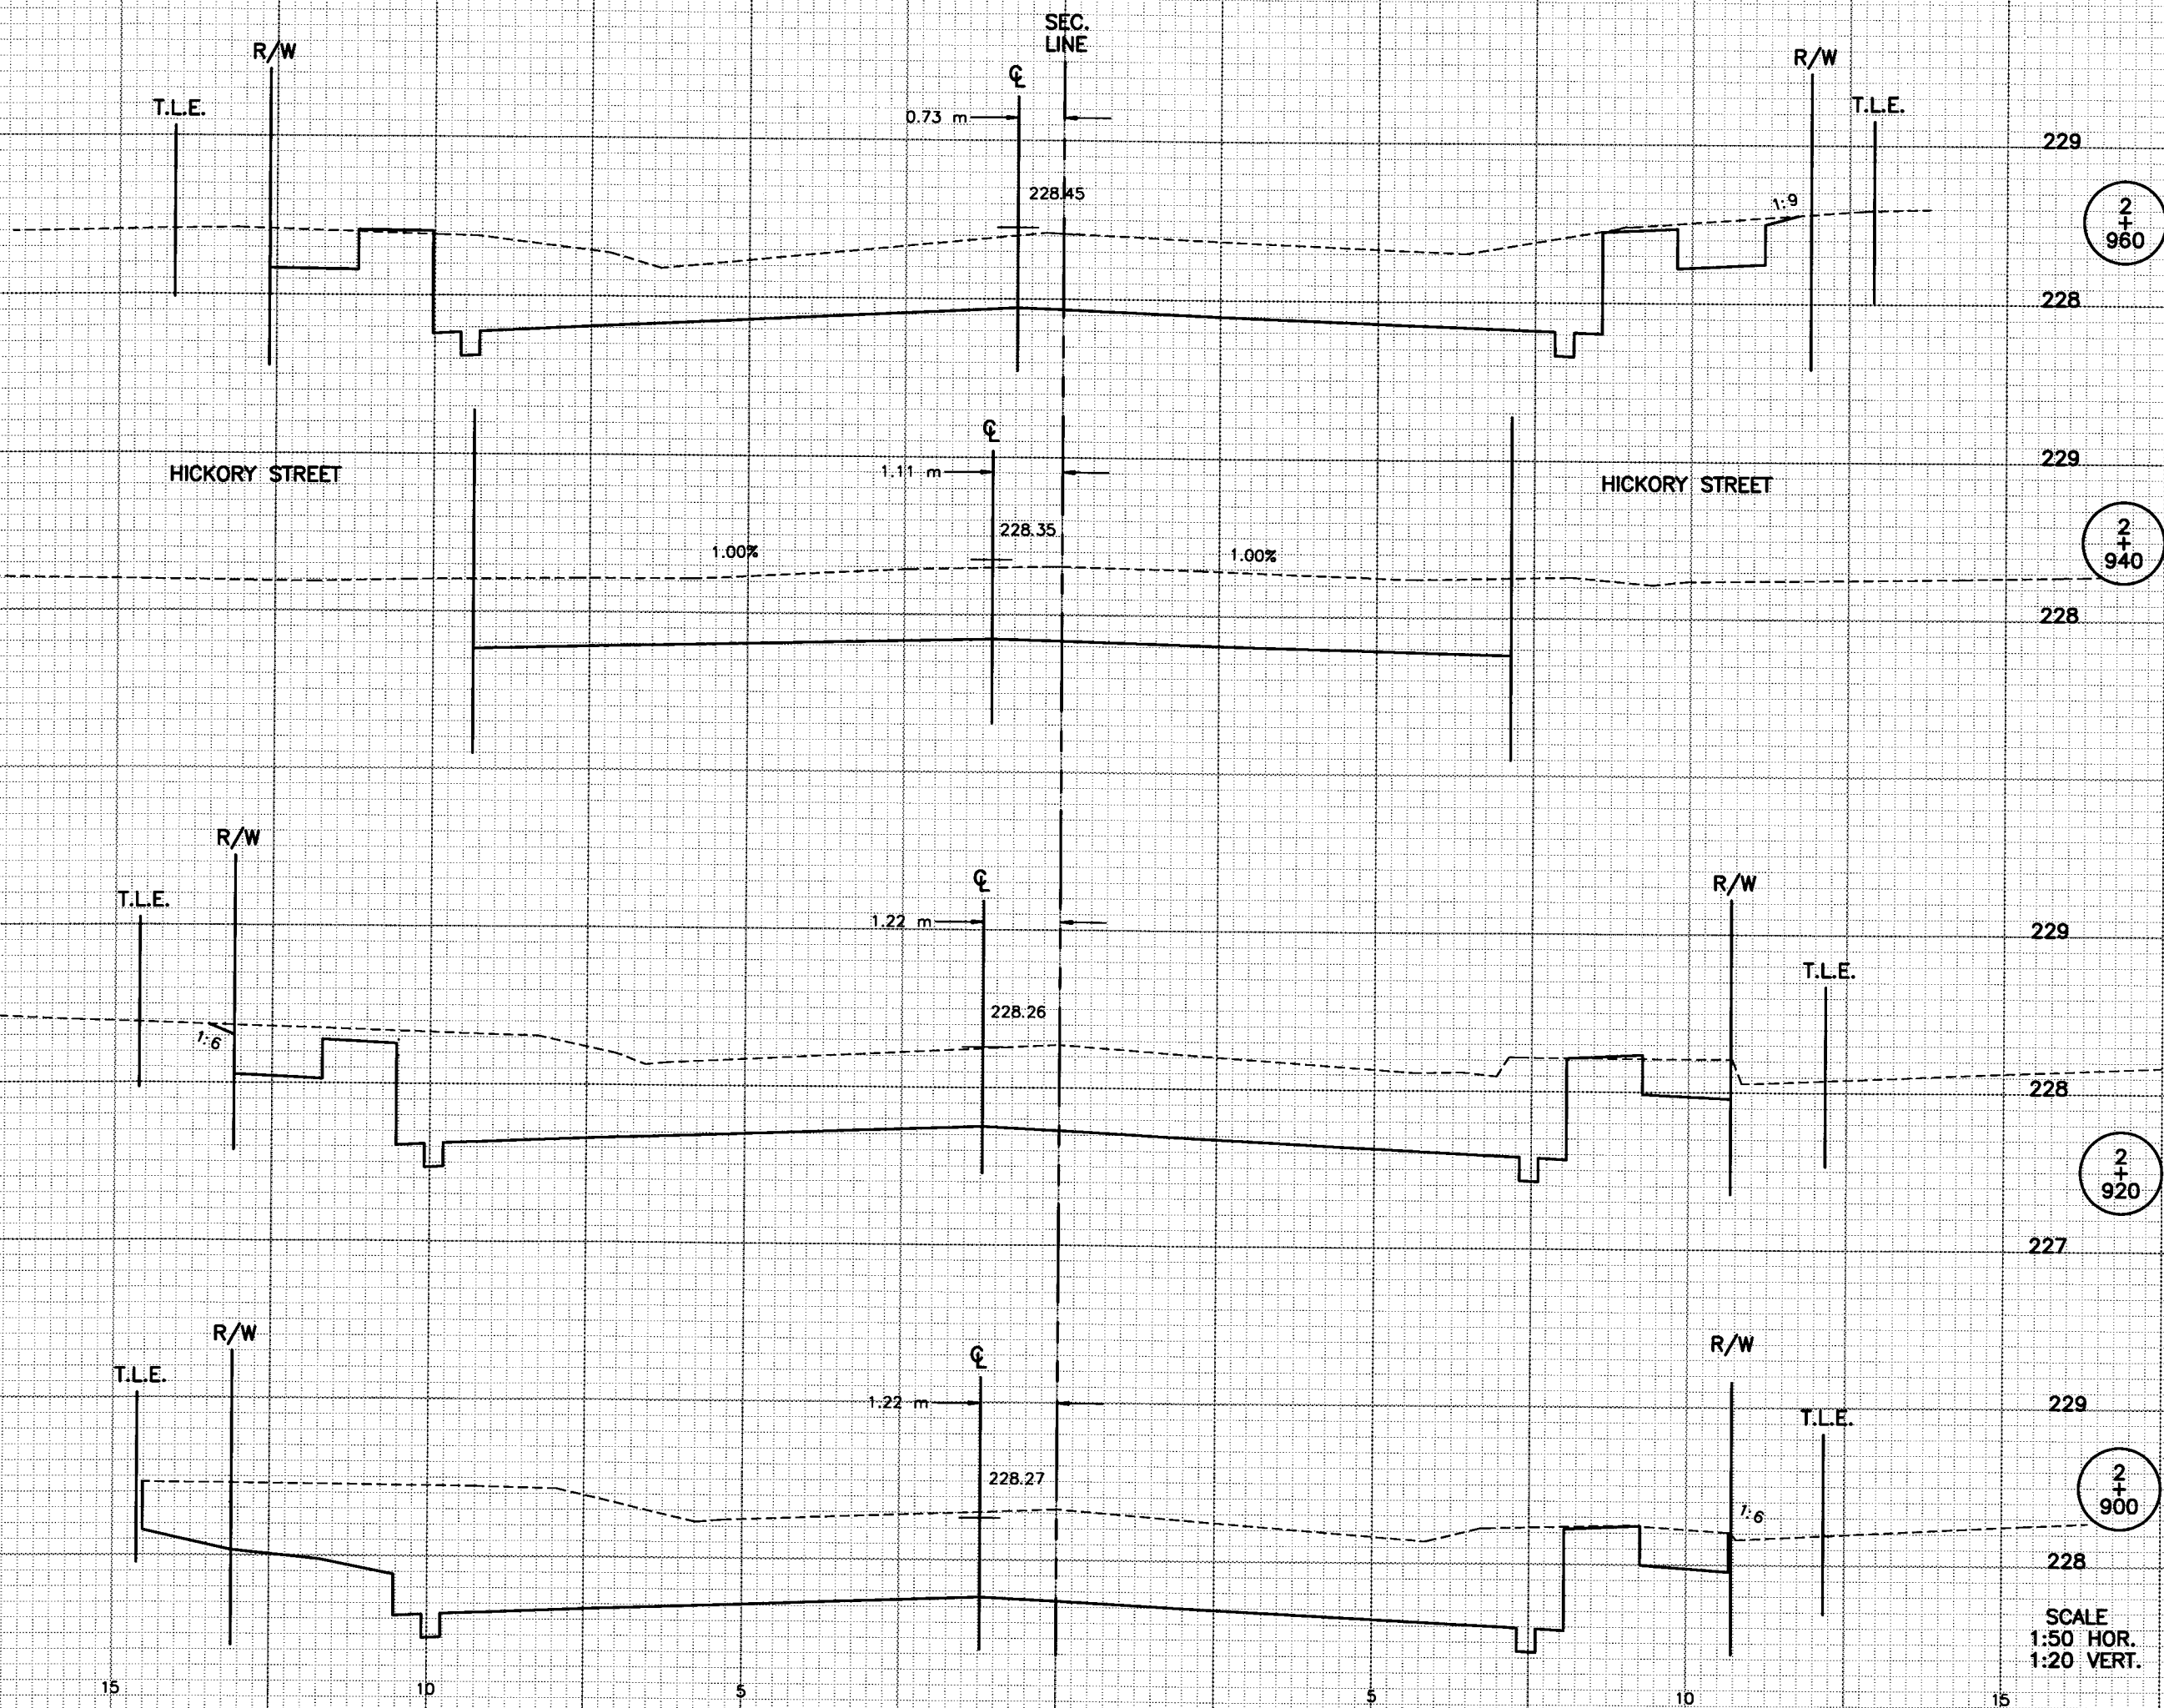


BRW CUD Sheet - MSECTION
Drawing File : XS2964

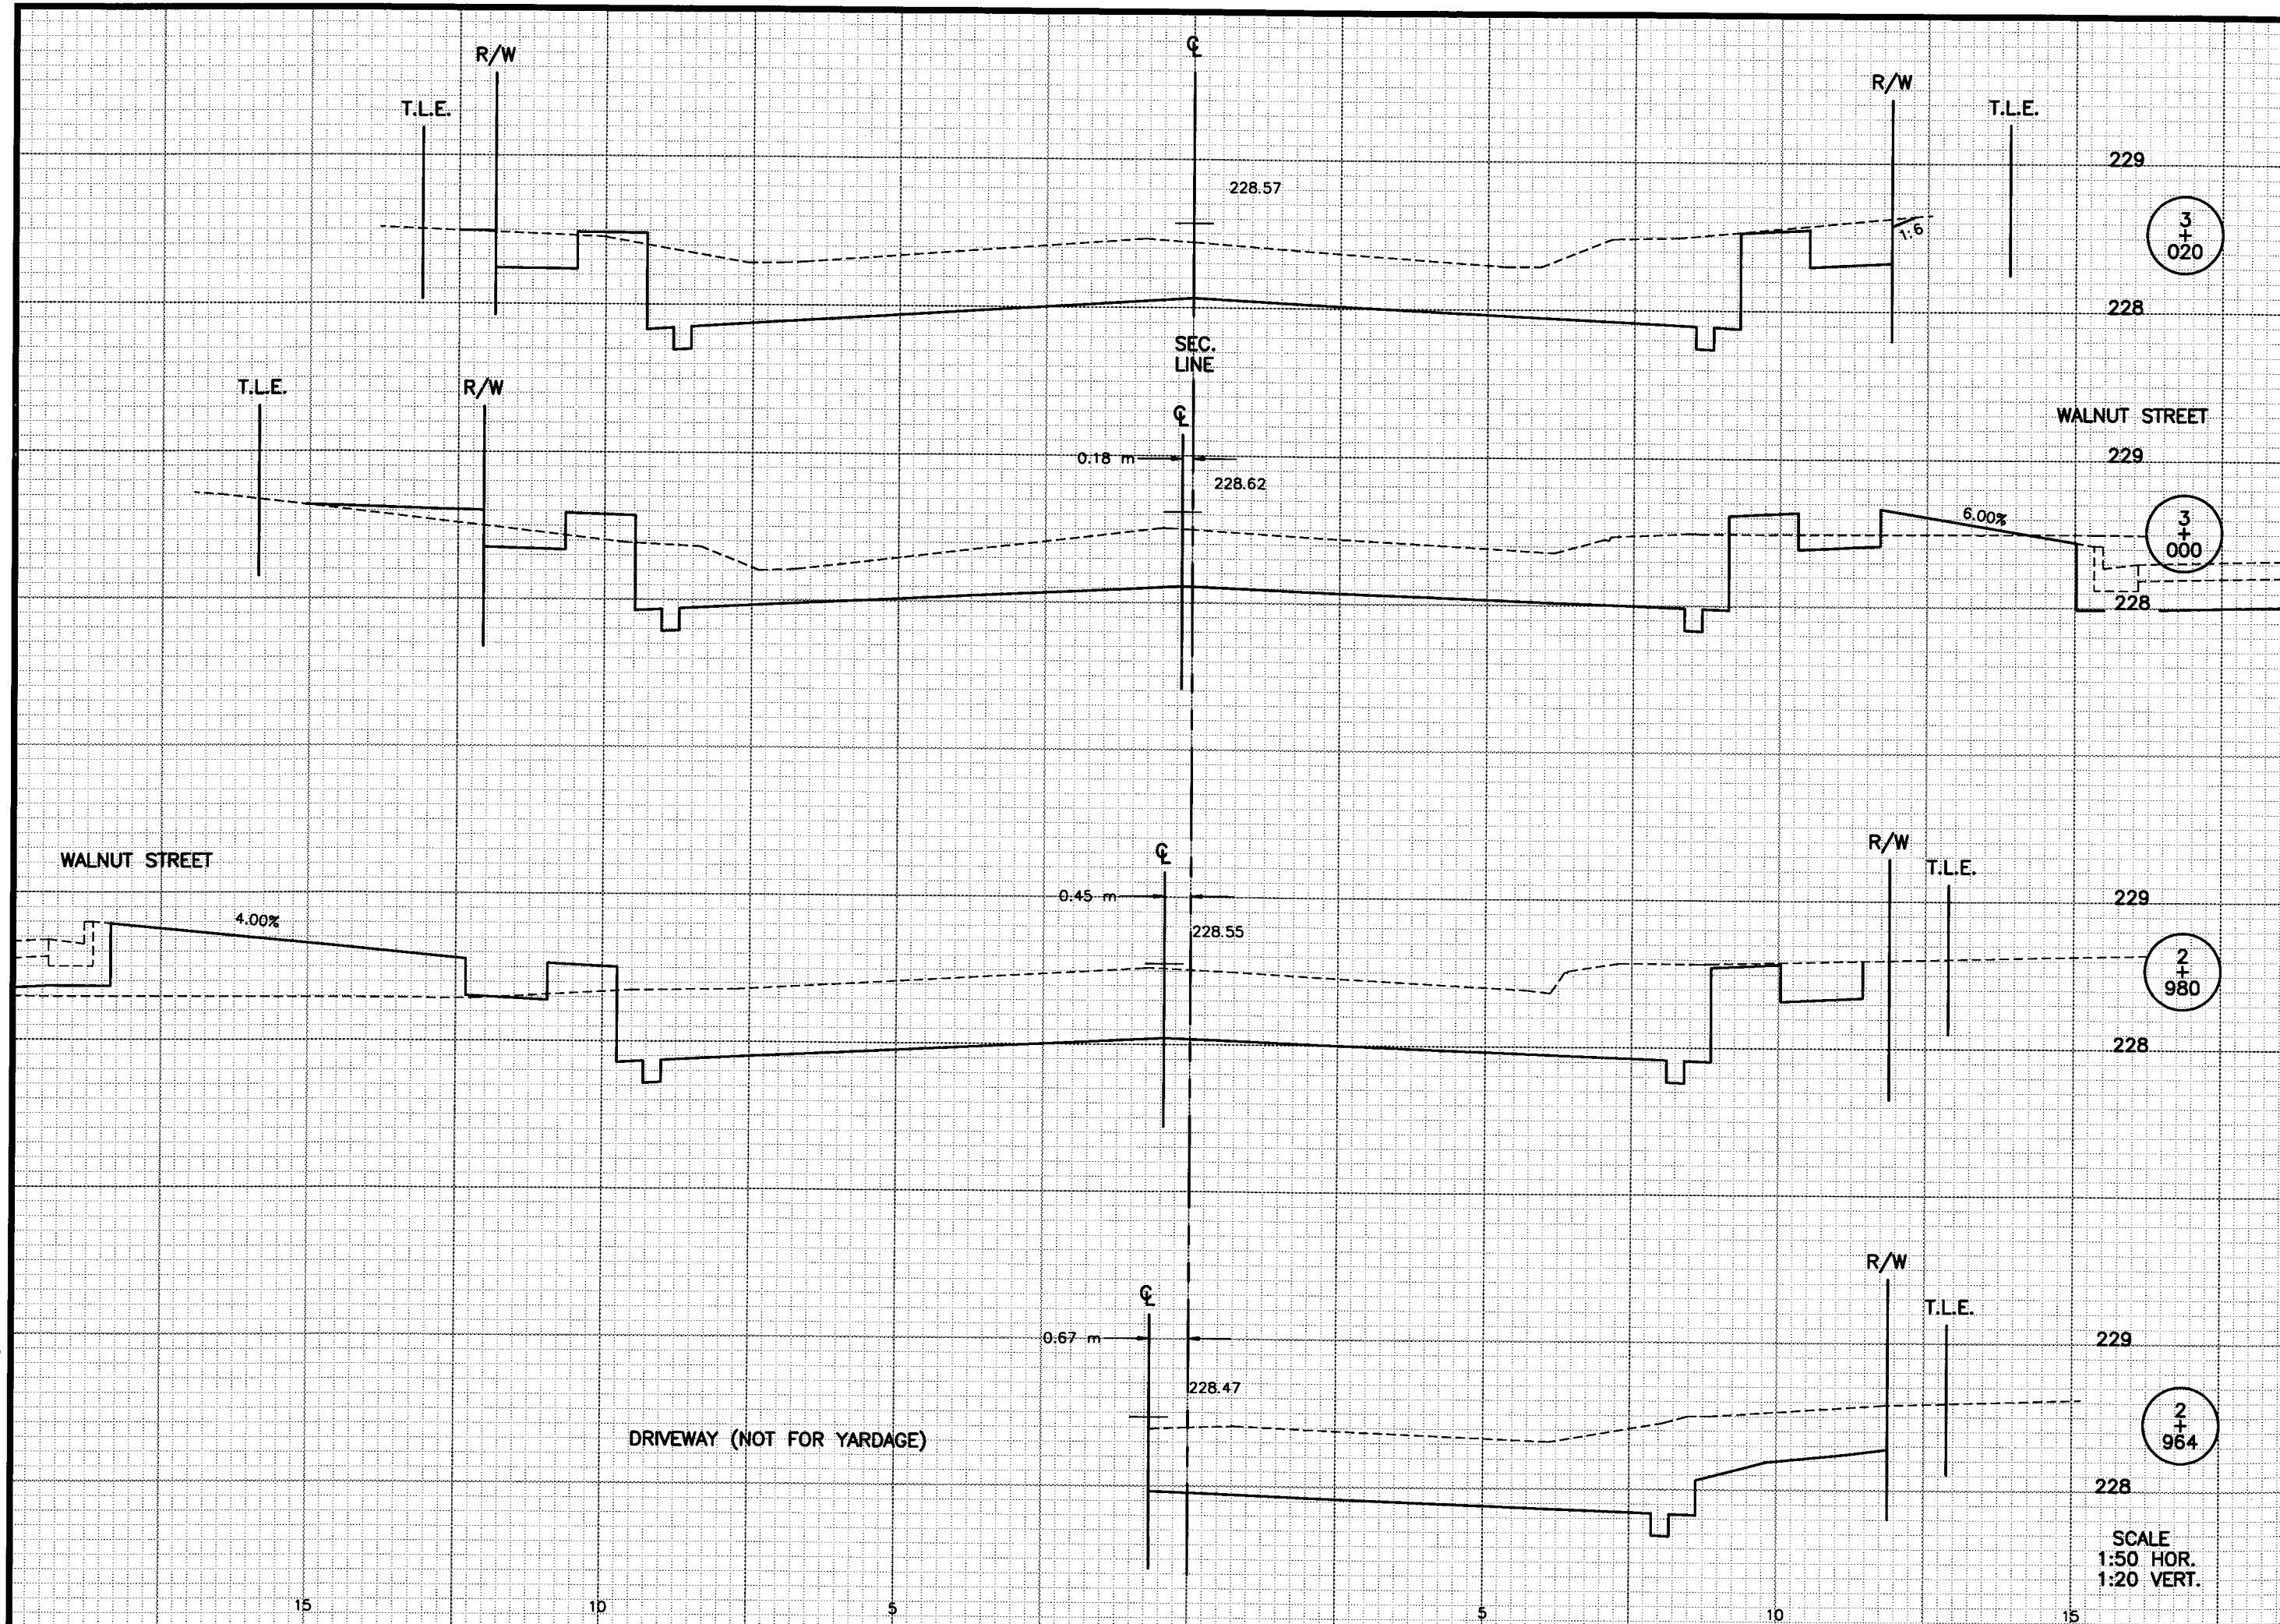


BRW CADD Sheet - MSECTION
Drawing File : XS3032

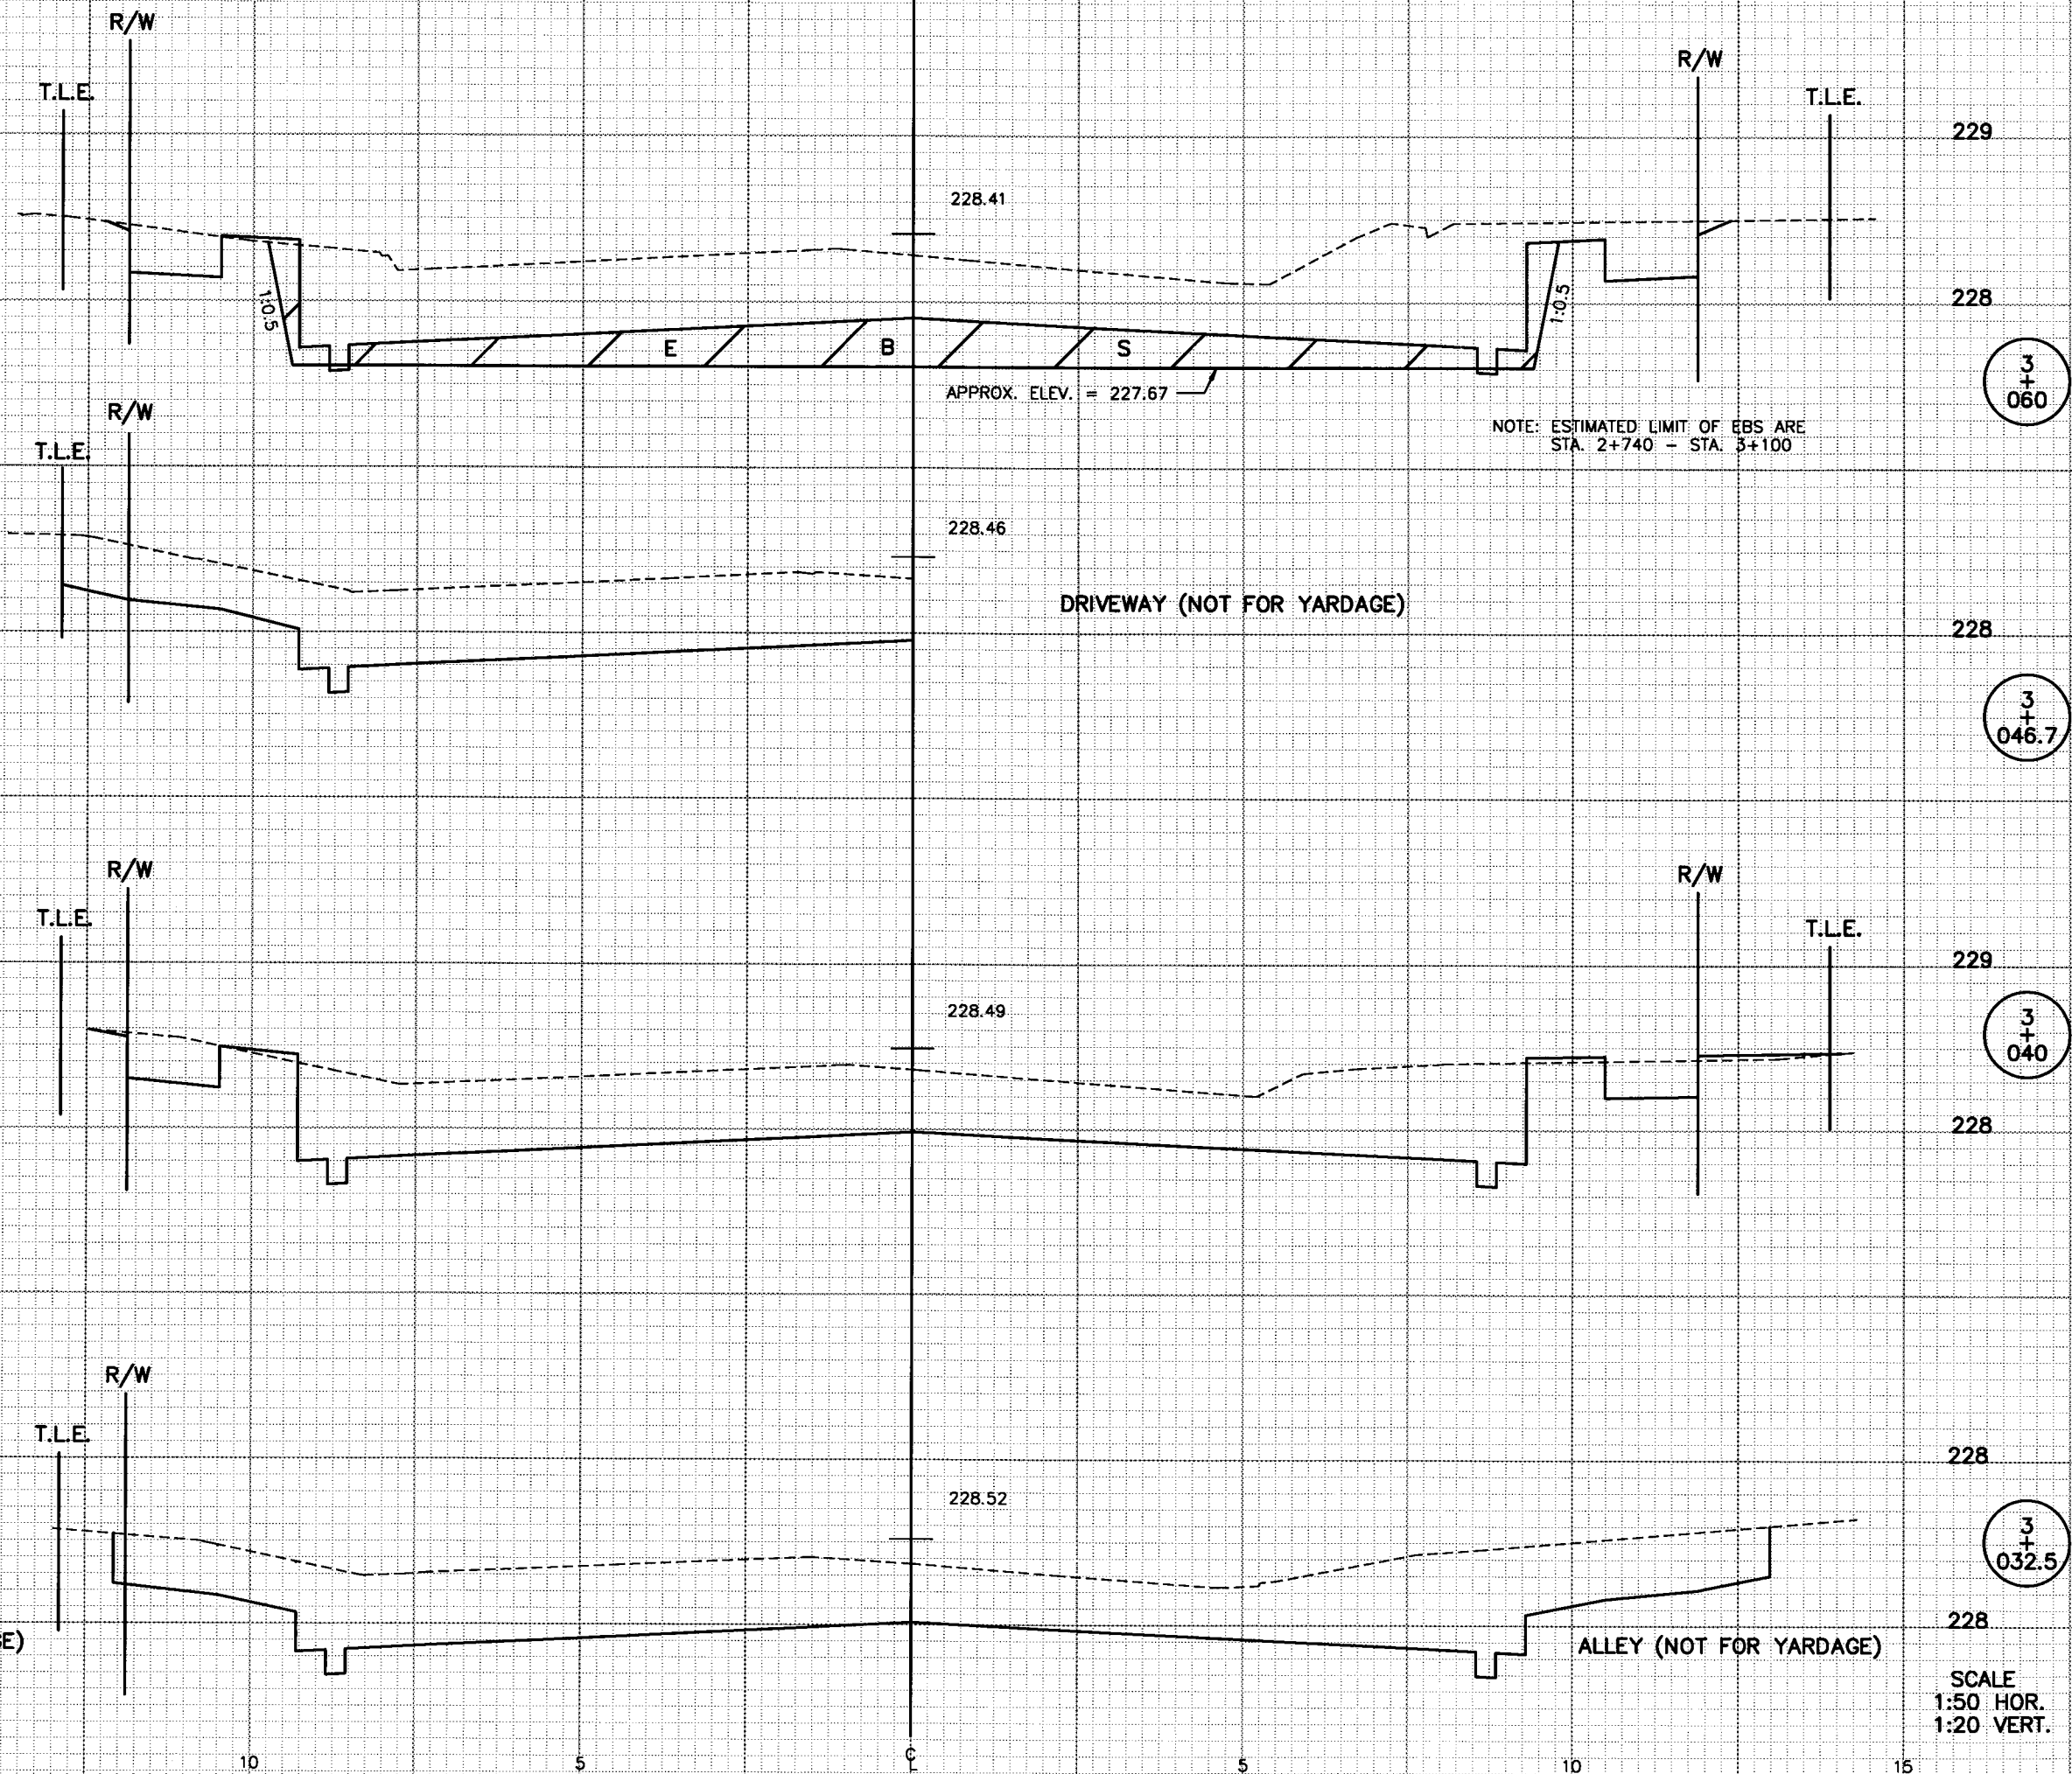

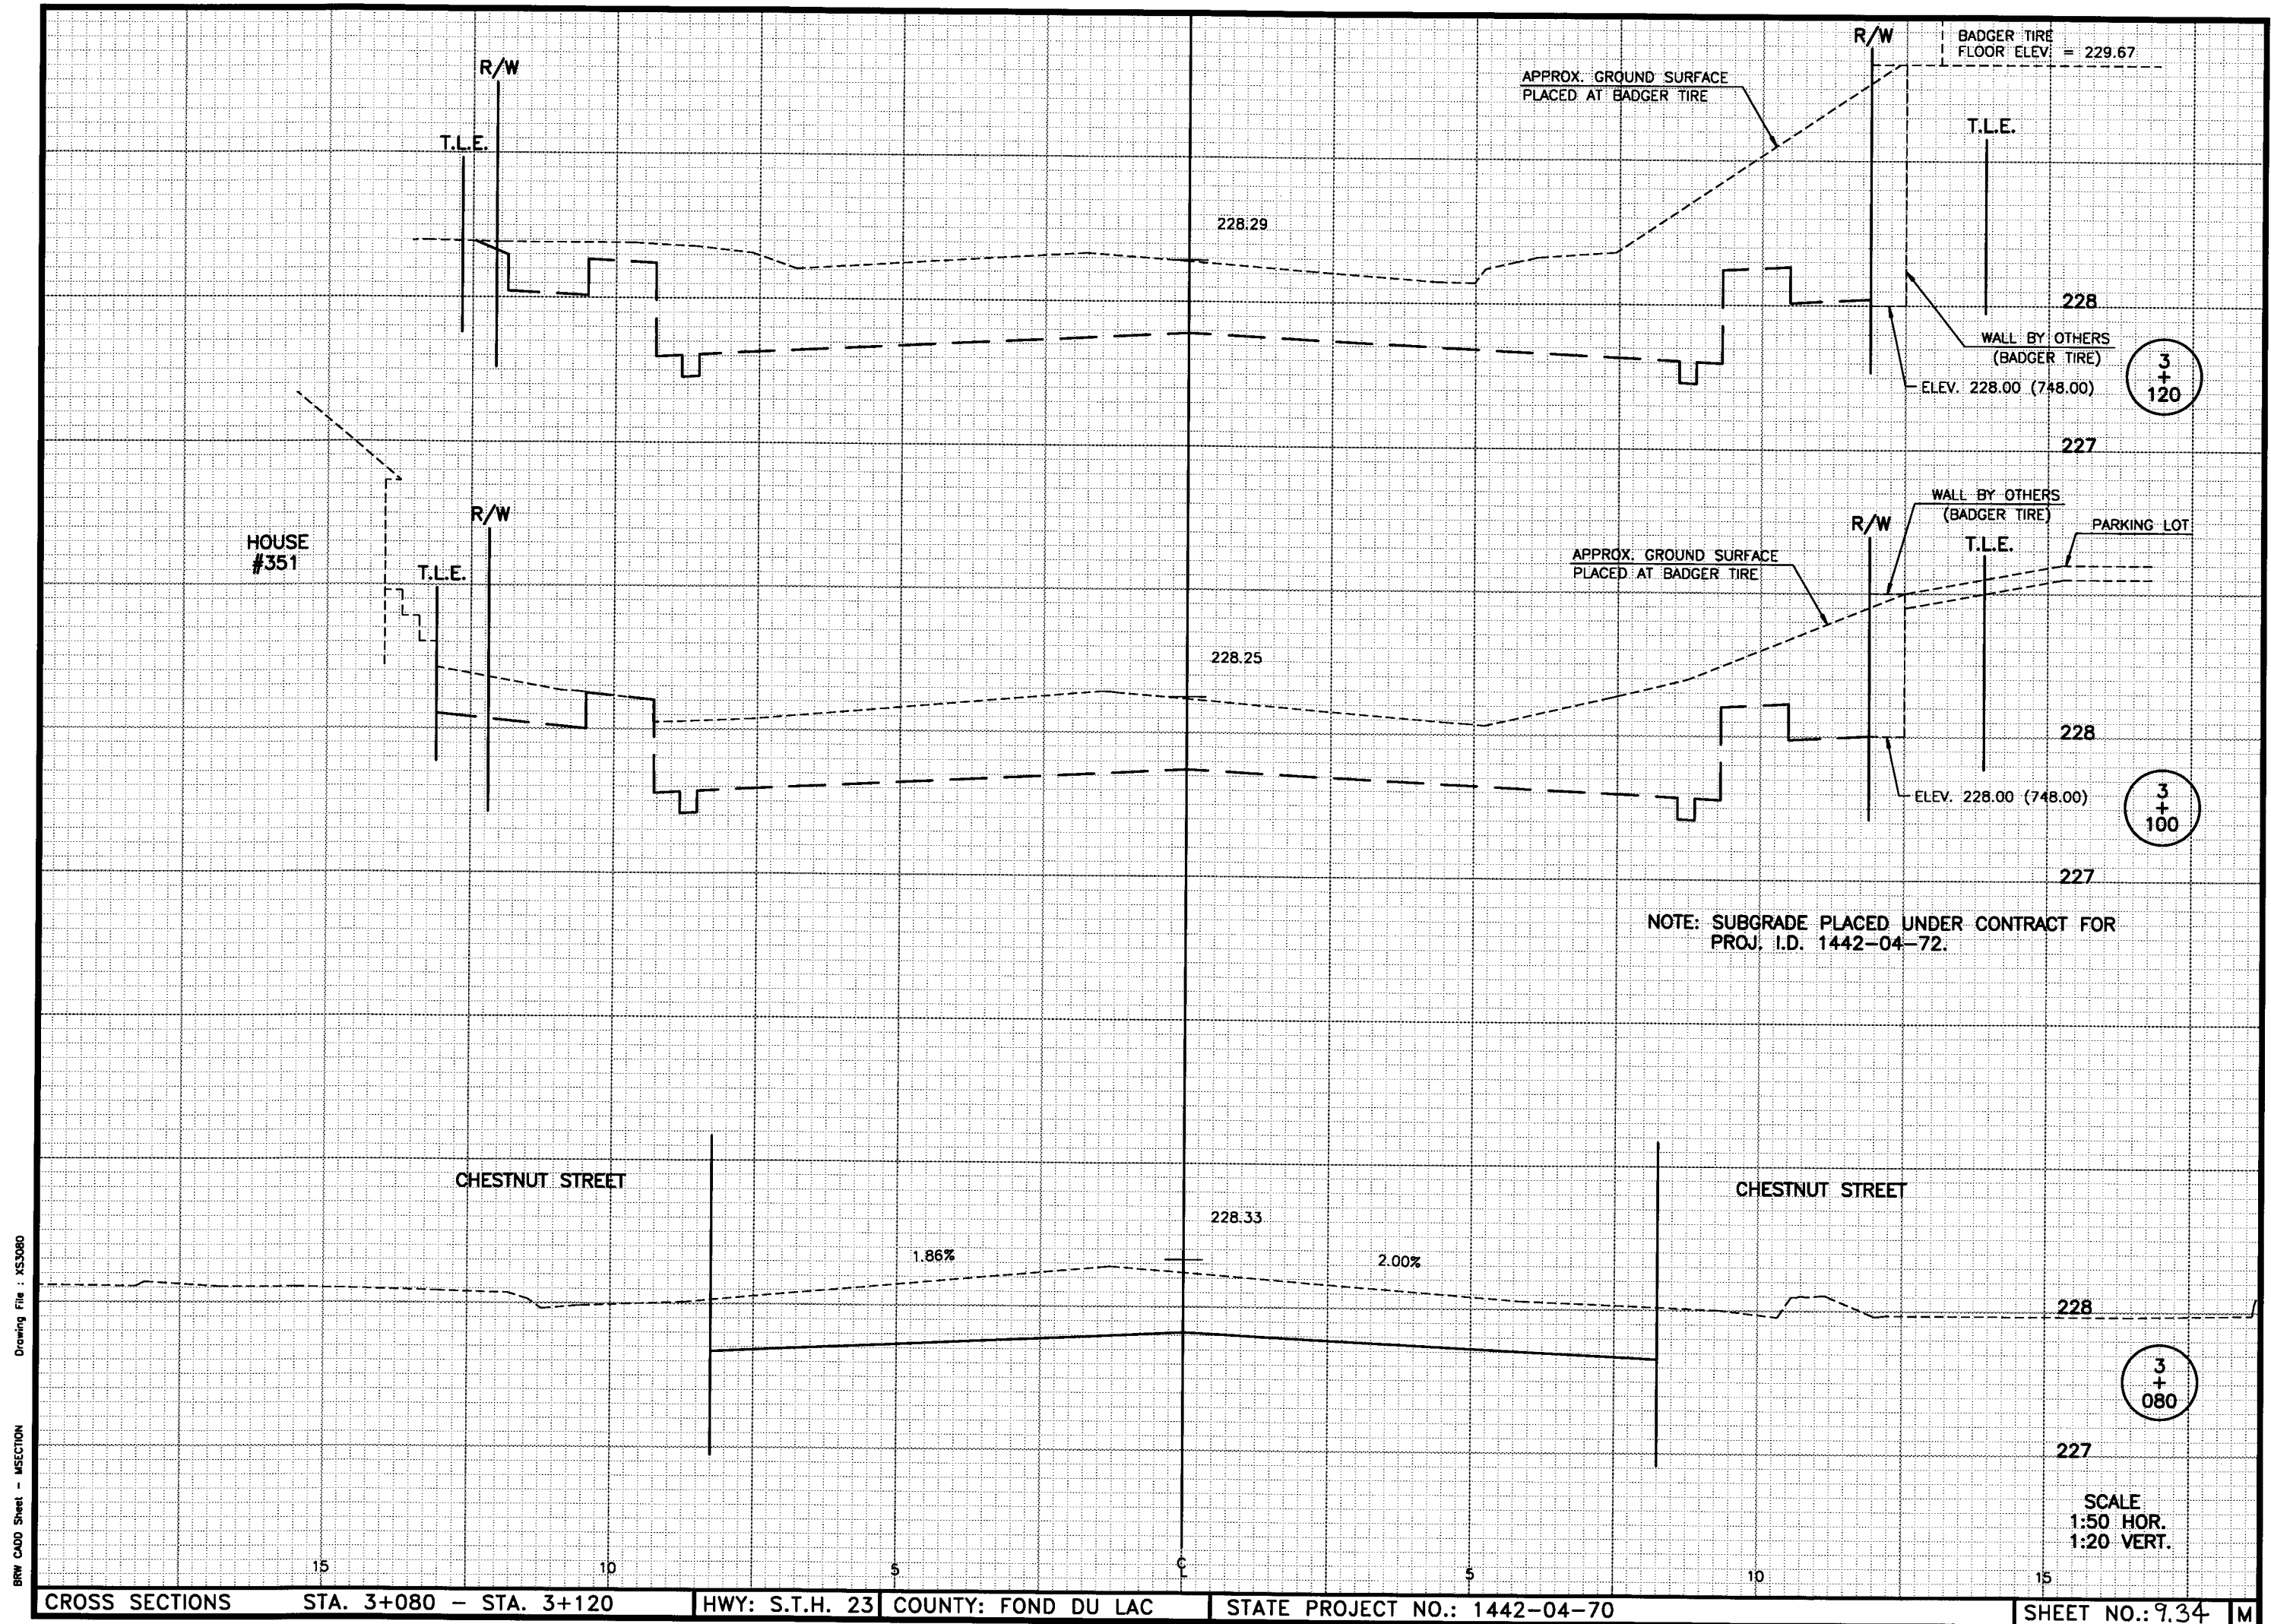


Drawing File : XS3127

Brw CUD Sheet - MSECTION

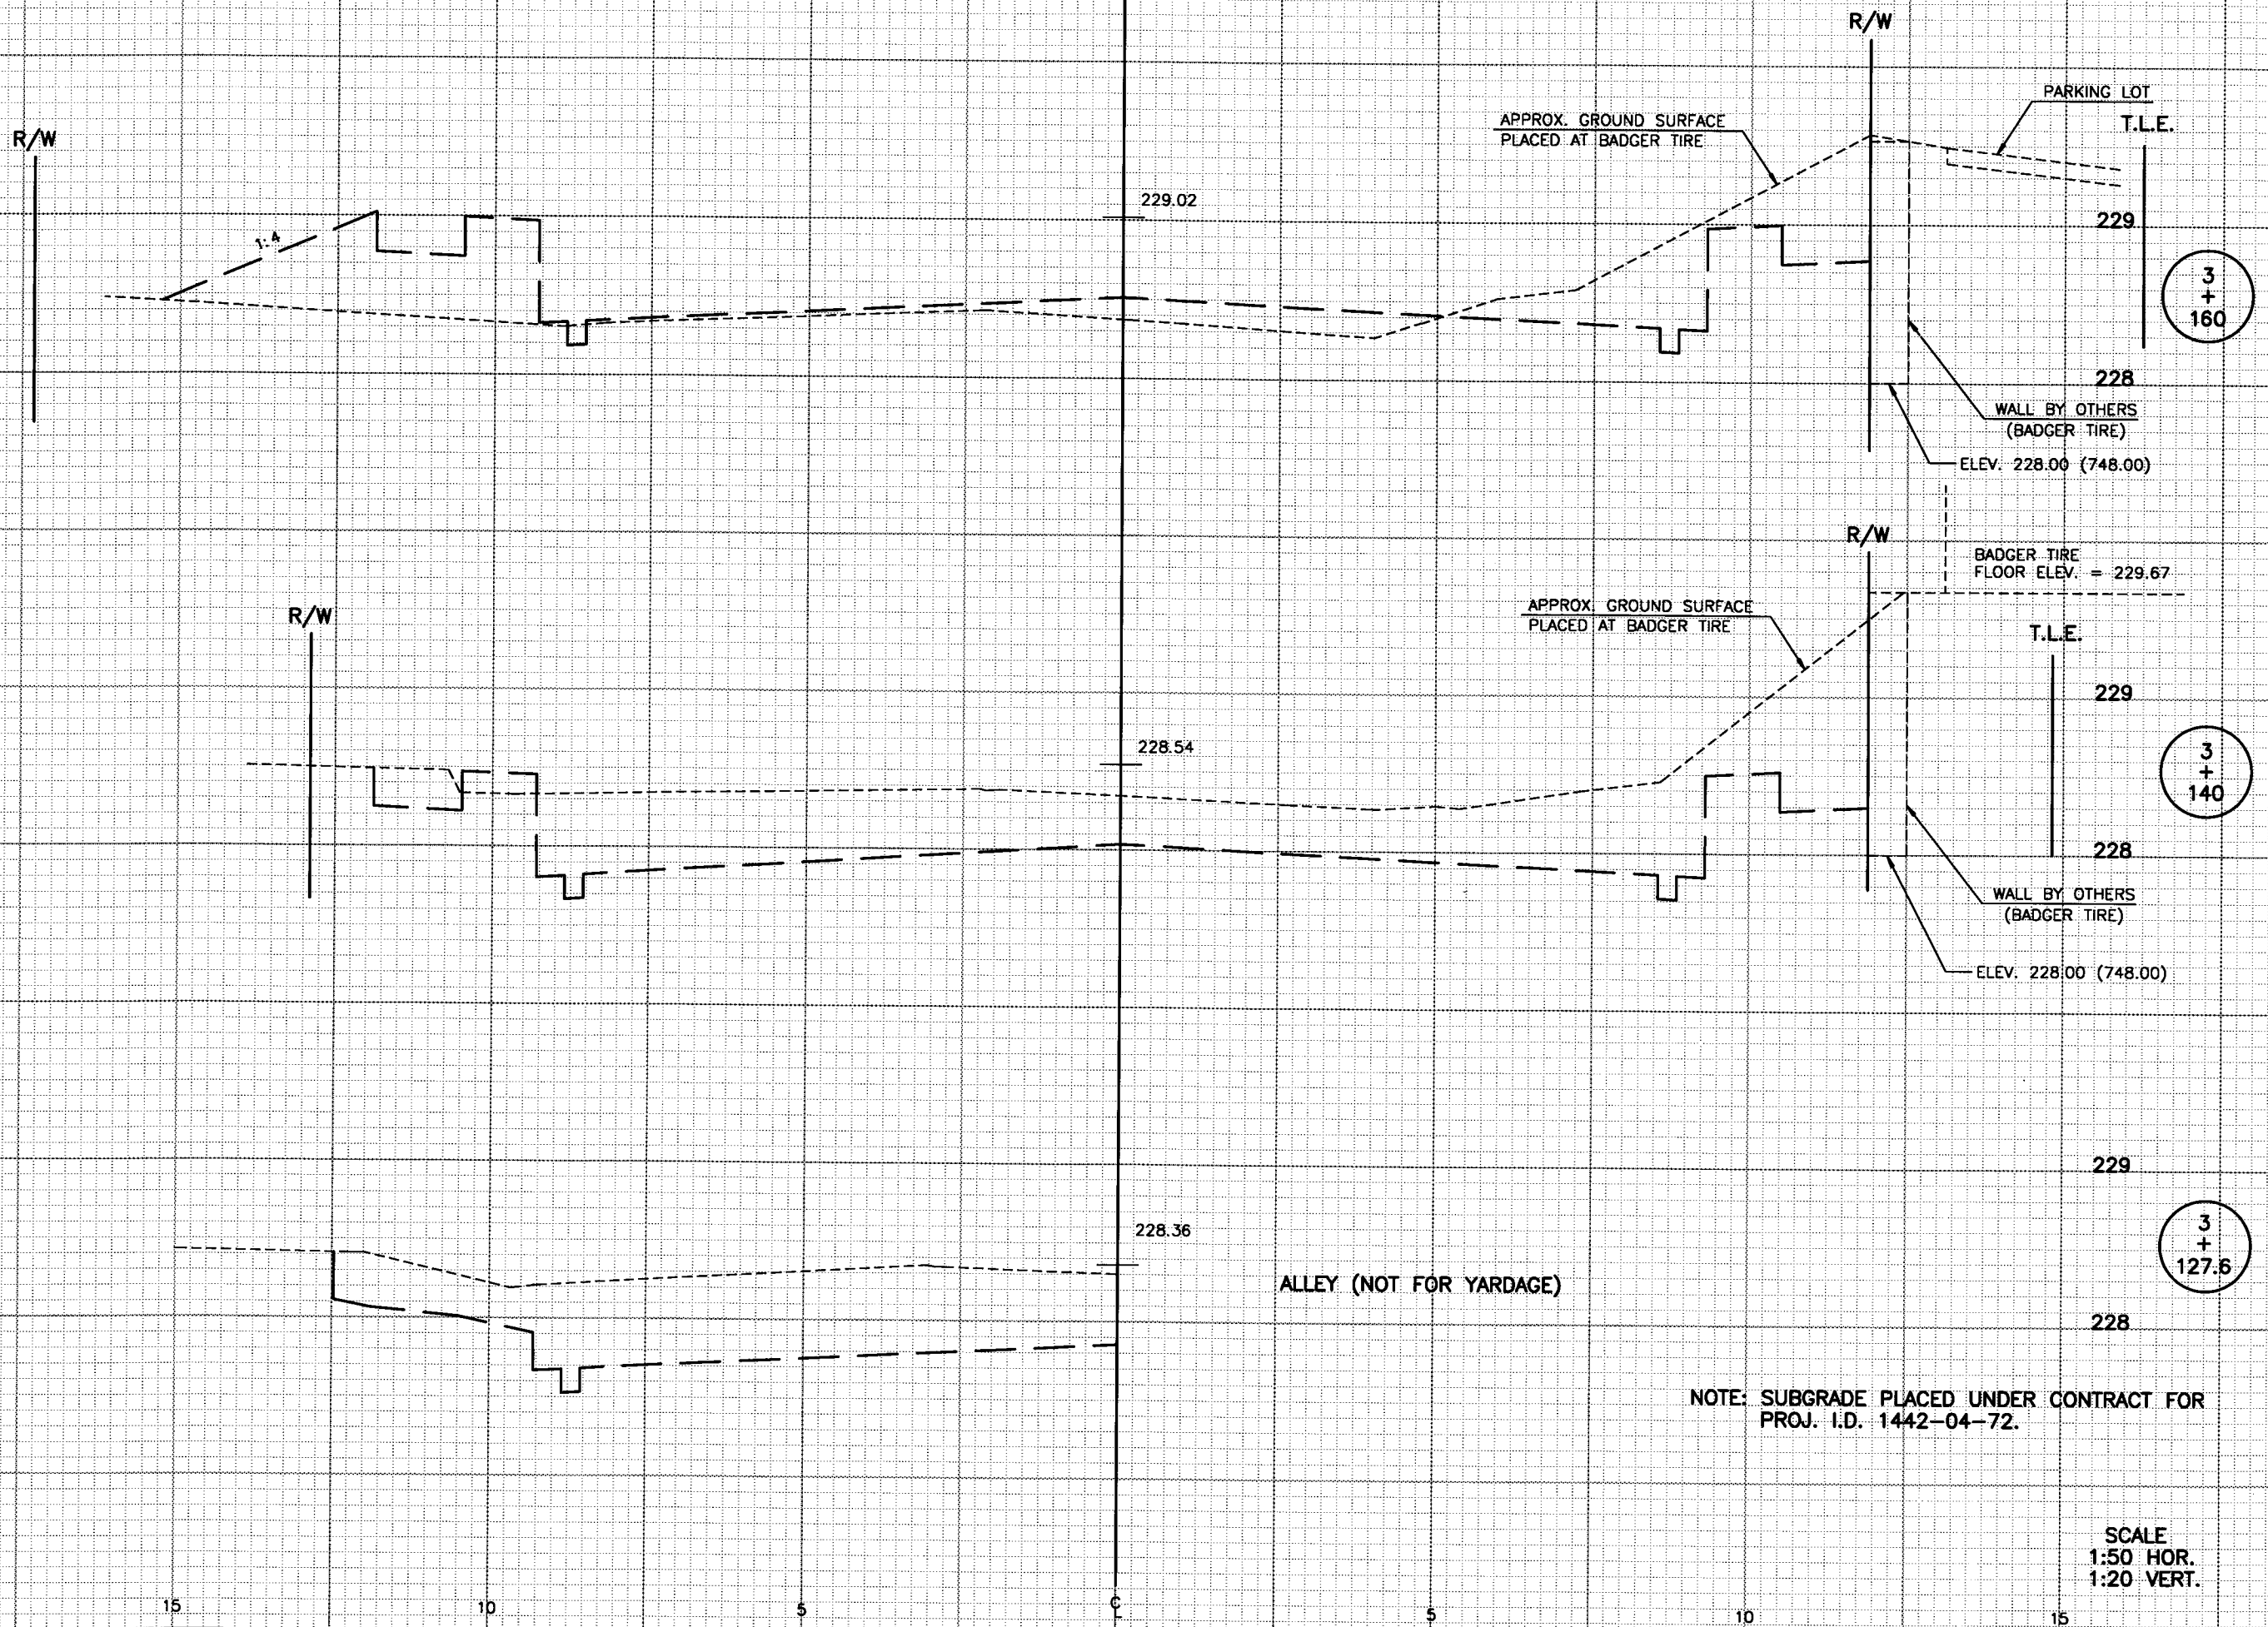

Drawing File : XS3180

BRW CAD Sheet - MSECTION

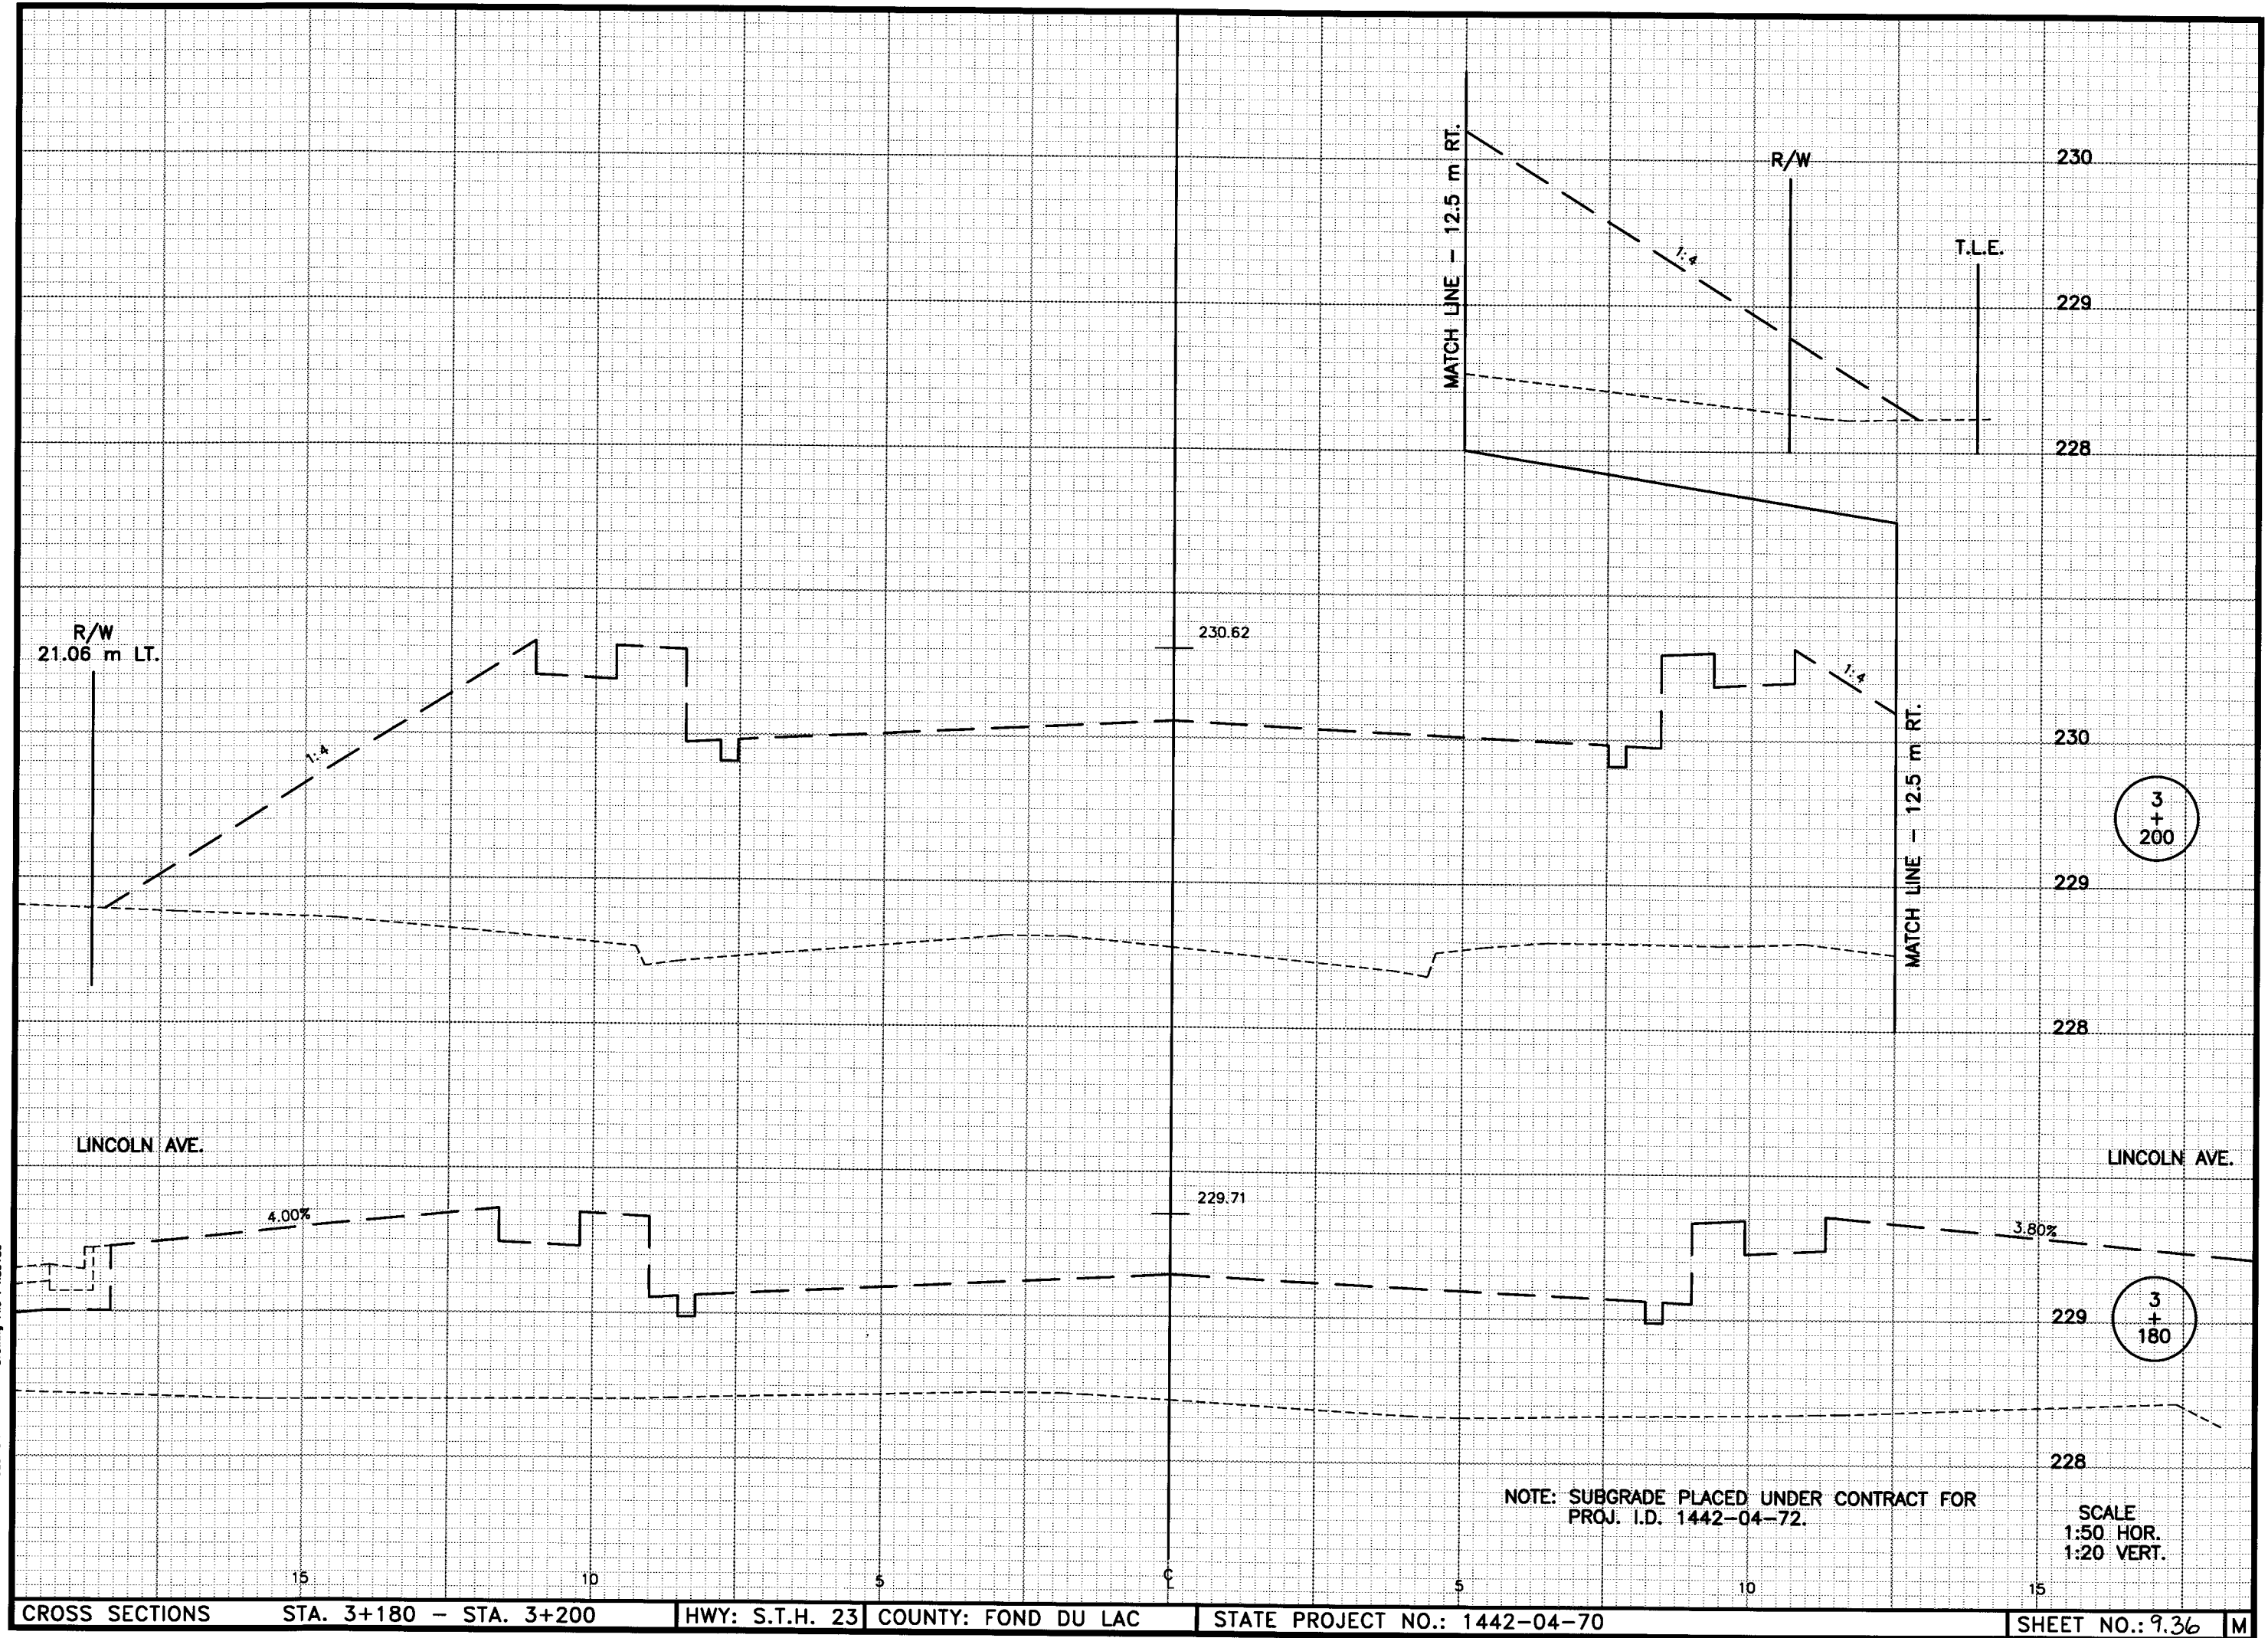

CROSS SECTIONS

STA. 3+180 - STA. 3+200

HWY: S.T.H. 23 COUNTY: FOND DU LAC

STATE PROJECT NO.: 1442-04-70

M

Drawing File : XS3220

BRW CUD Sheet - MSECTION



CROSS SECTIONS

STA. 3+220

HWY: S.T.H. 23

COUNTY: FOND DU LAC


STATE PROJECT NO.: 1442-04-70

SHEET NO.: 9.37

M

Drawing File : XS3620

BRW CADD Sheet - MSECTION

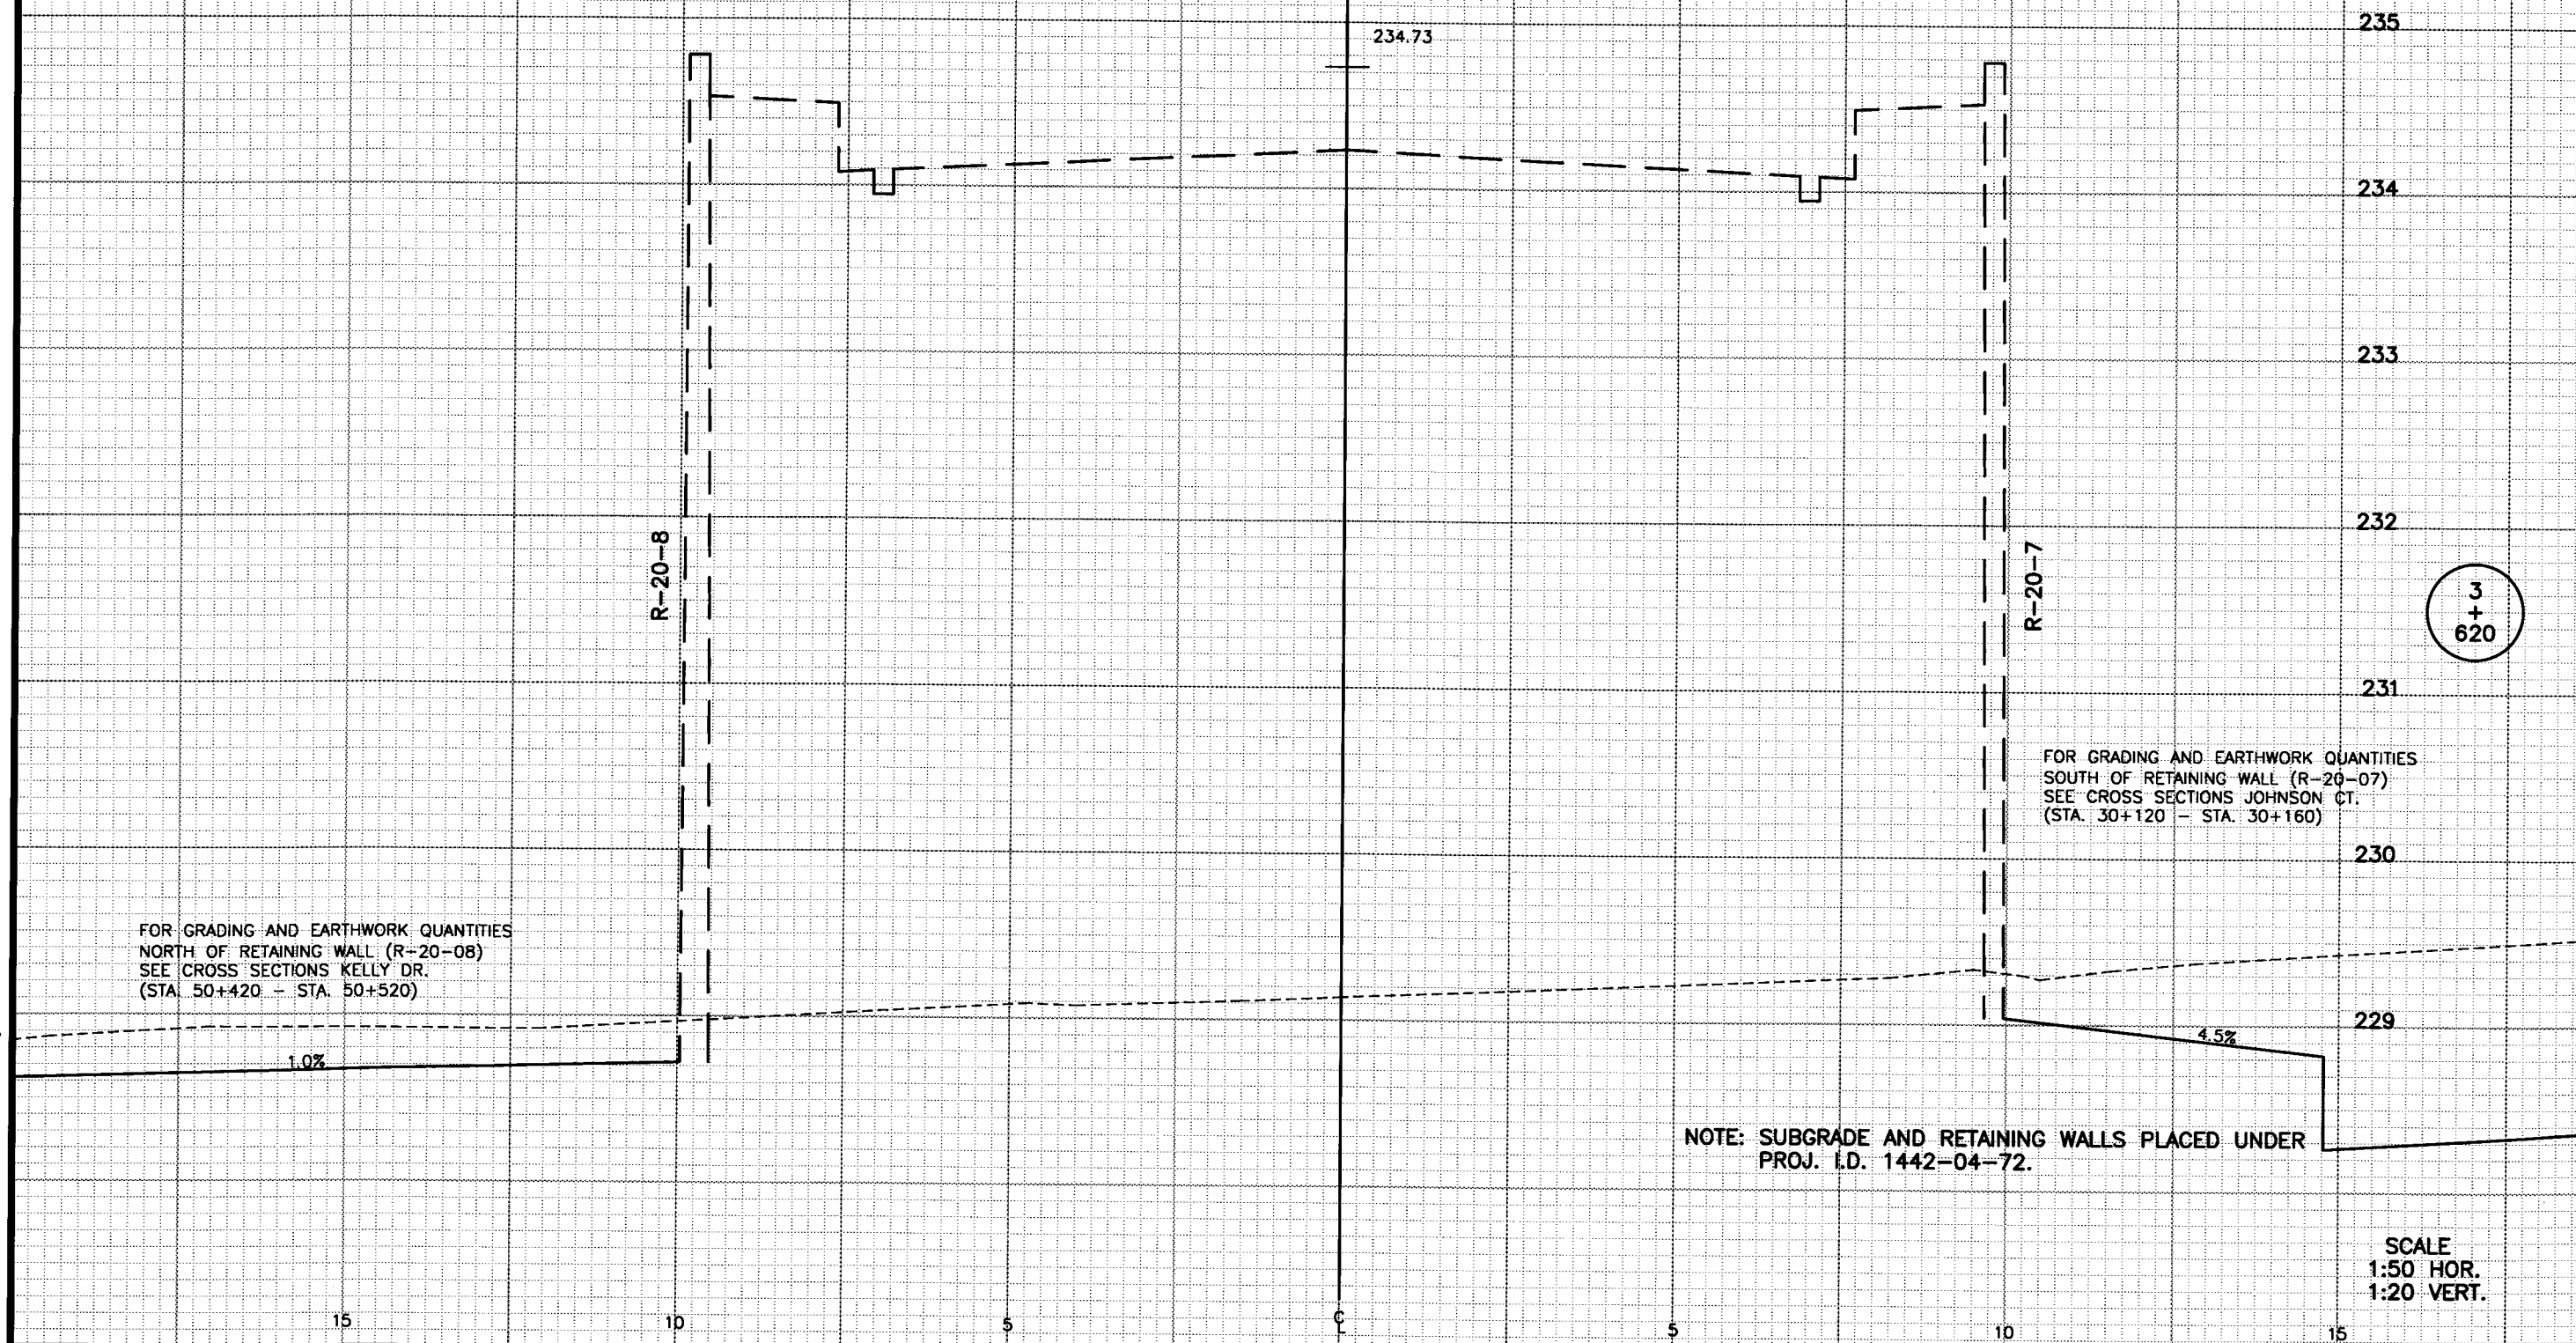

CROSS SECTIONS

STA. 3+620

HWY: S.T.H. 23

COUNTY: FOND DU LAC

STATE PROJECT NO.: 1442-04-70

SHEET NO.: 9,38

M

Drawing File : X53840

BRW CAD Sheet - MSECTION

FOR GRADING AND EARTHWORK QUANTITIES
NORTH OF RETAINING WALL (R-20-08)
SEE CROSS SECTIONS KELLY DR.
(STA. 50+420 - STA. 50+540)

FOR GRADING AND EARTHWORK QUANTITIES
SOUTH OF RETAINING WALL (R-20-07)
SEE CROSS SECTIONS JOHNSON CT.
(STA. 30+120 - STA. 30+160)

NOTE: SUBGRADE AND RETAINING WALLS PLACED UNDER
PROJ. I.D. 1442-04-72.

SCALE
1:50 HOR.
1:20 VERT.

CROSS SECTIONS

STA. 3+640

HWY: S.T.H. 23


COUNTY: FOND DU LAC

STATE PROJECT NO.: 1442-04-70


SHEET NO.: 9.39

M


BRW CAD Sheet - MSECTION
Drawing File : XS3660

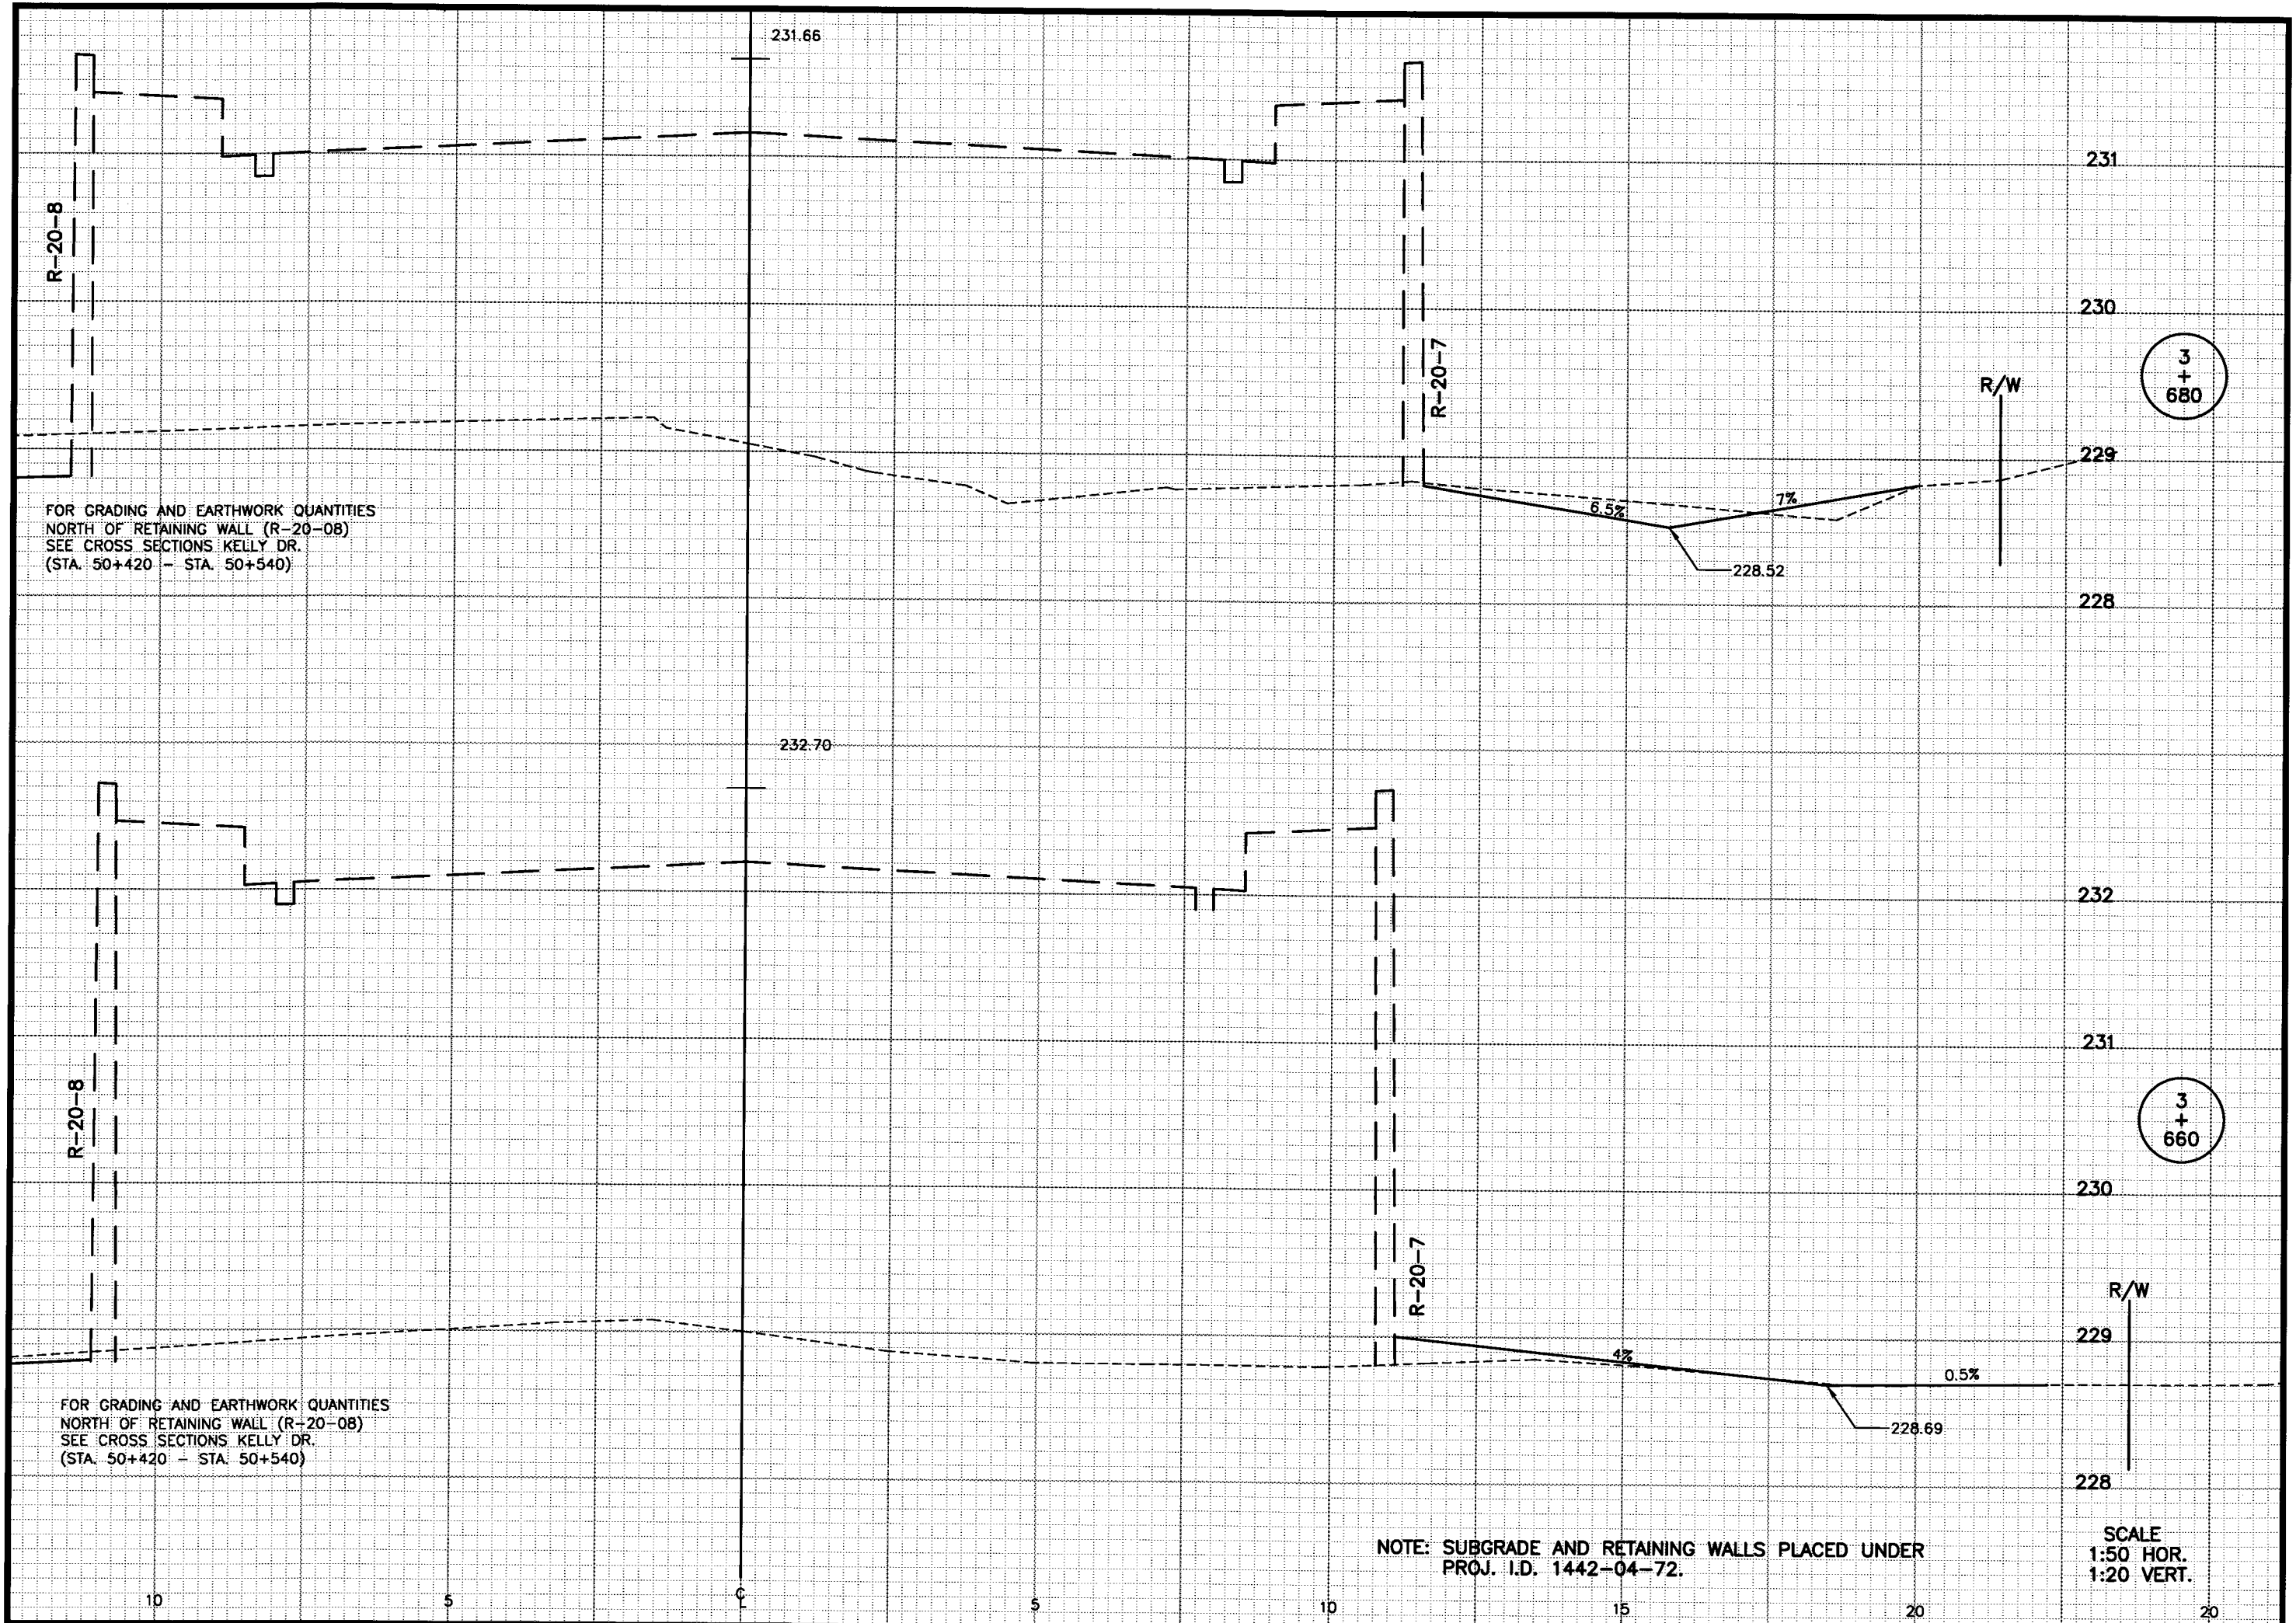

BRW CADD Sheet - MSECTION
Drawing File : XS3700

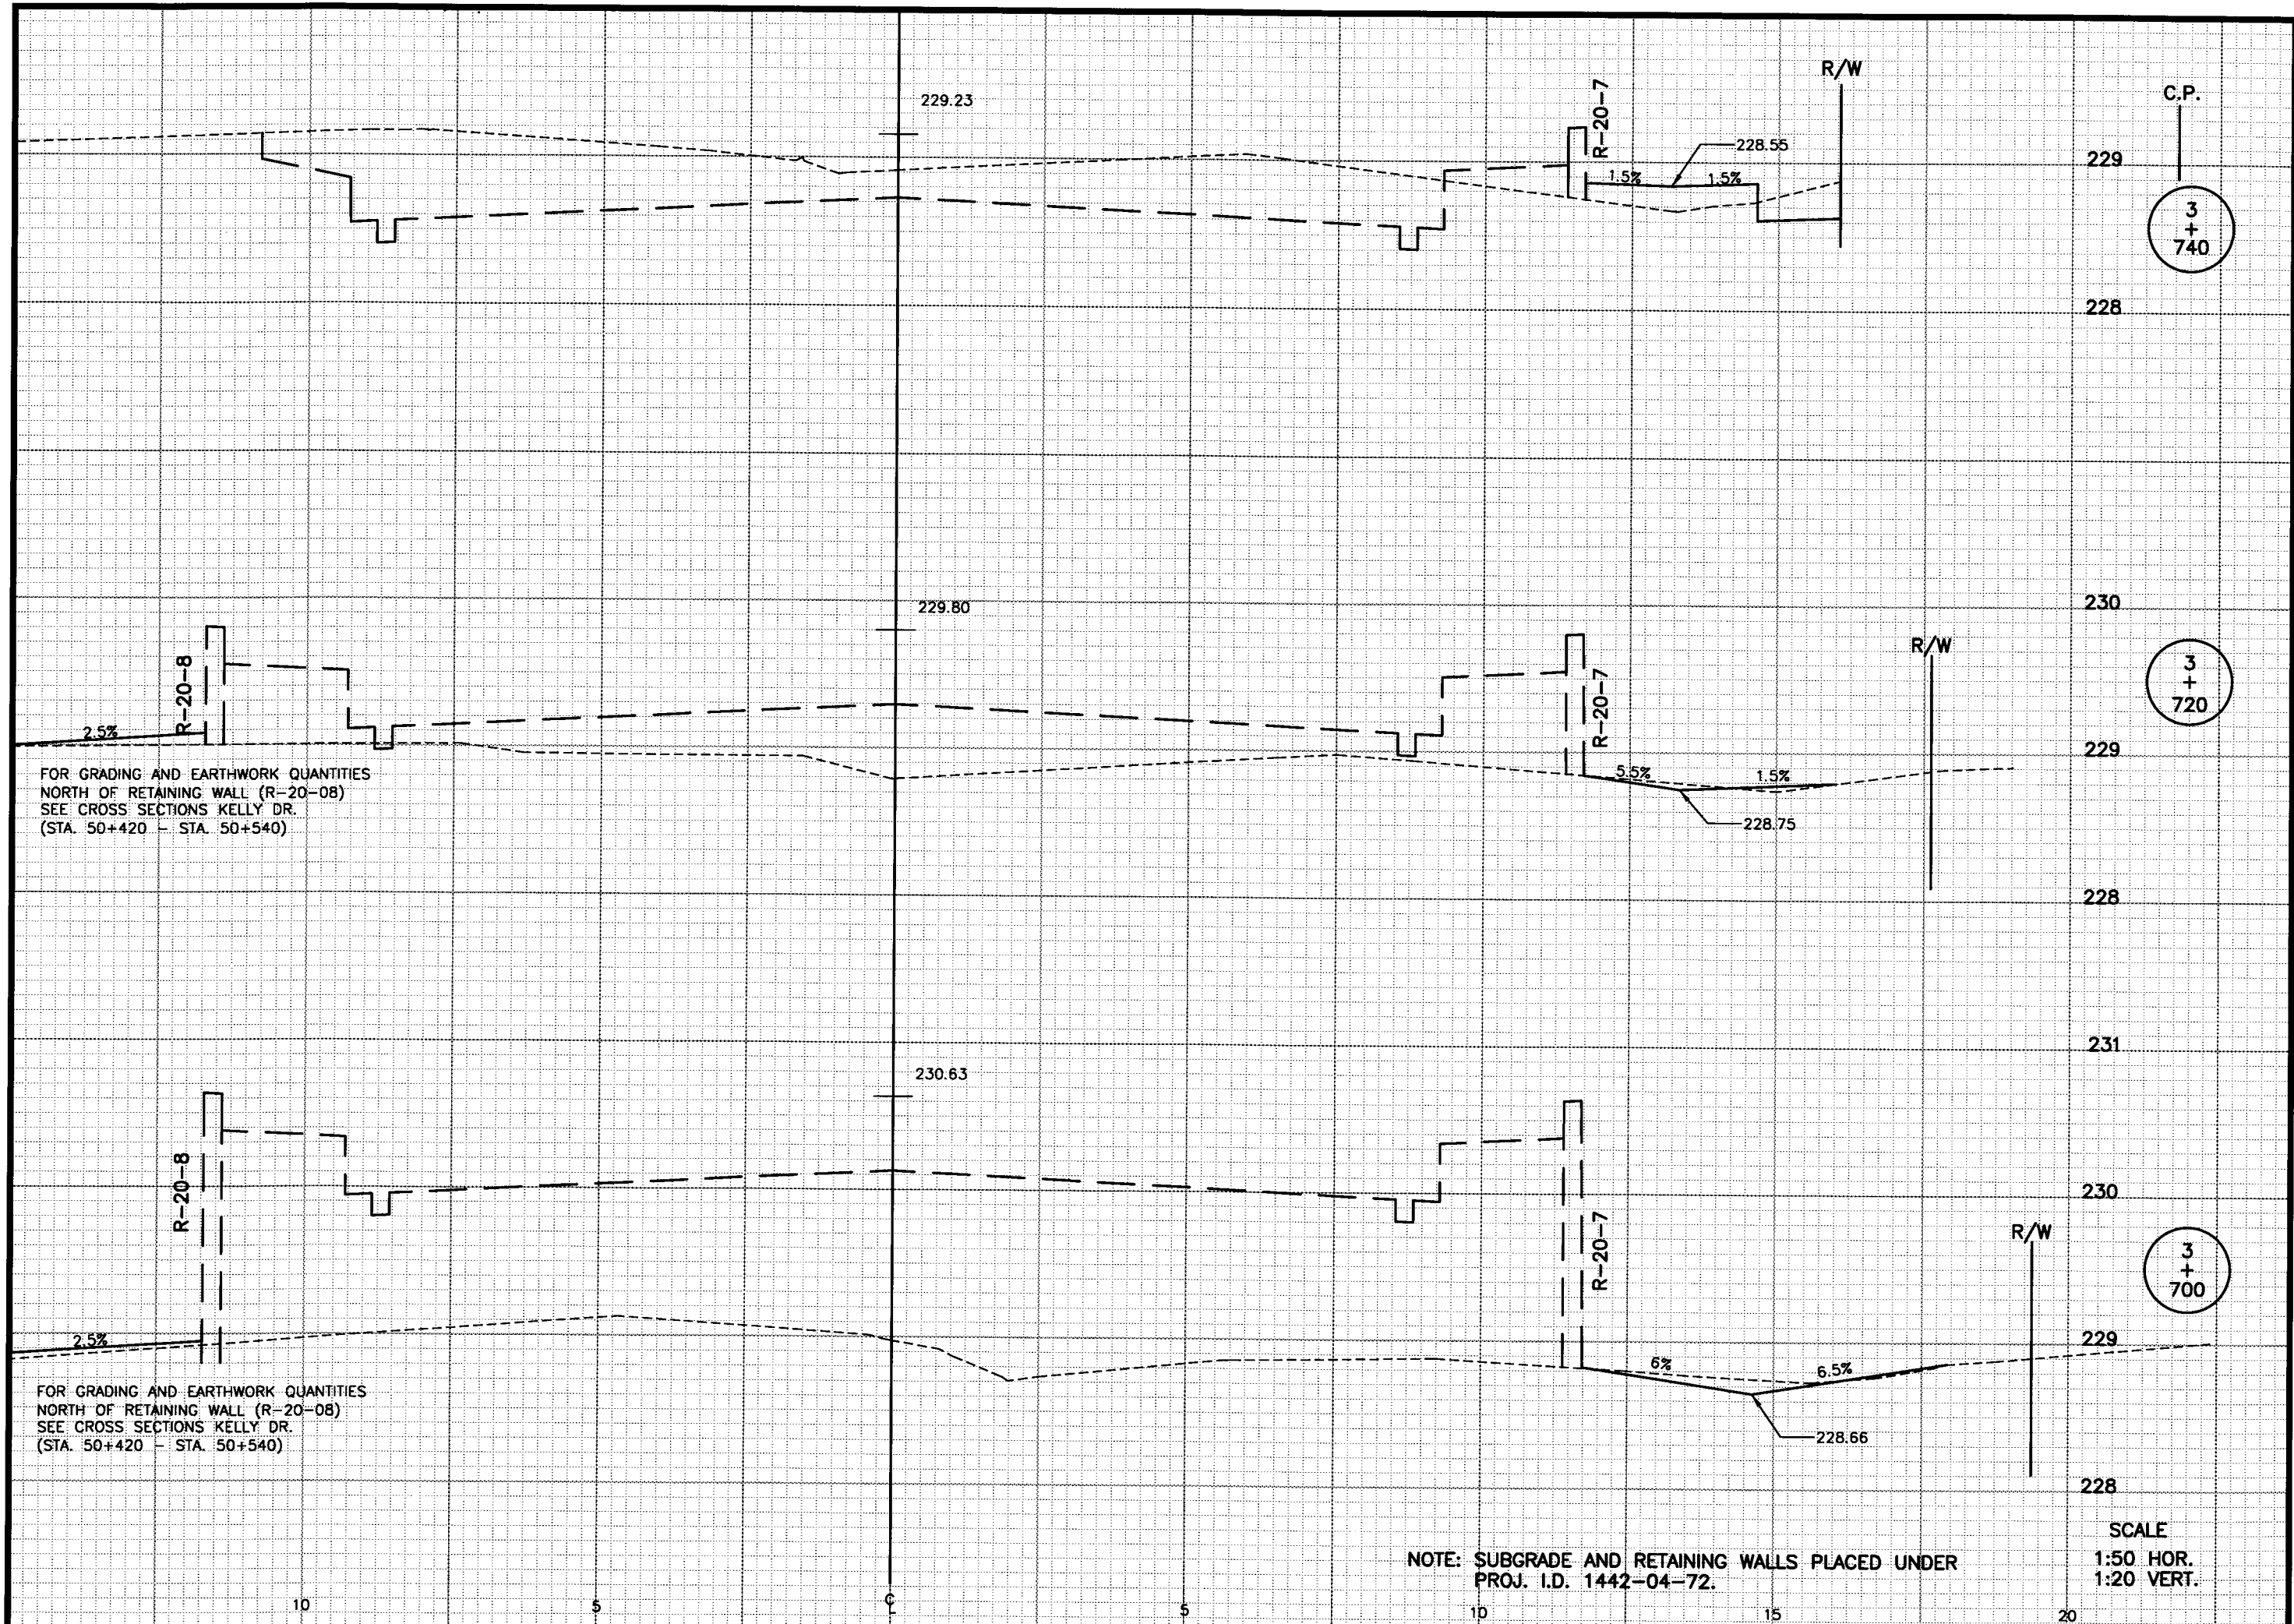

BRW CADD Sheet - MSECTION
Drawing File : XS3760

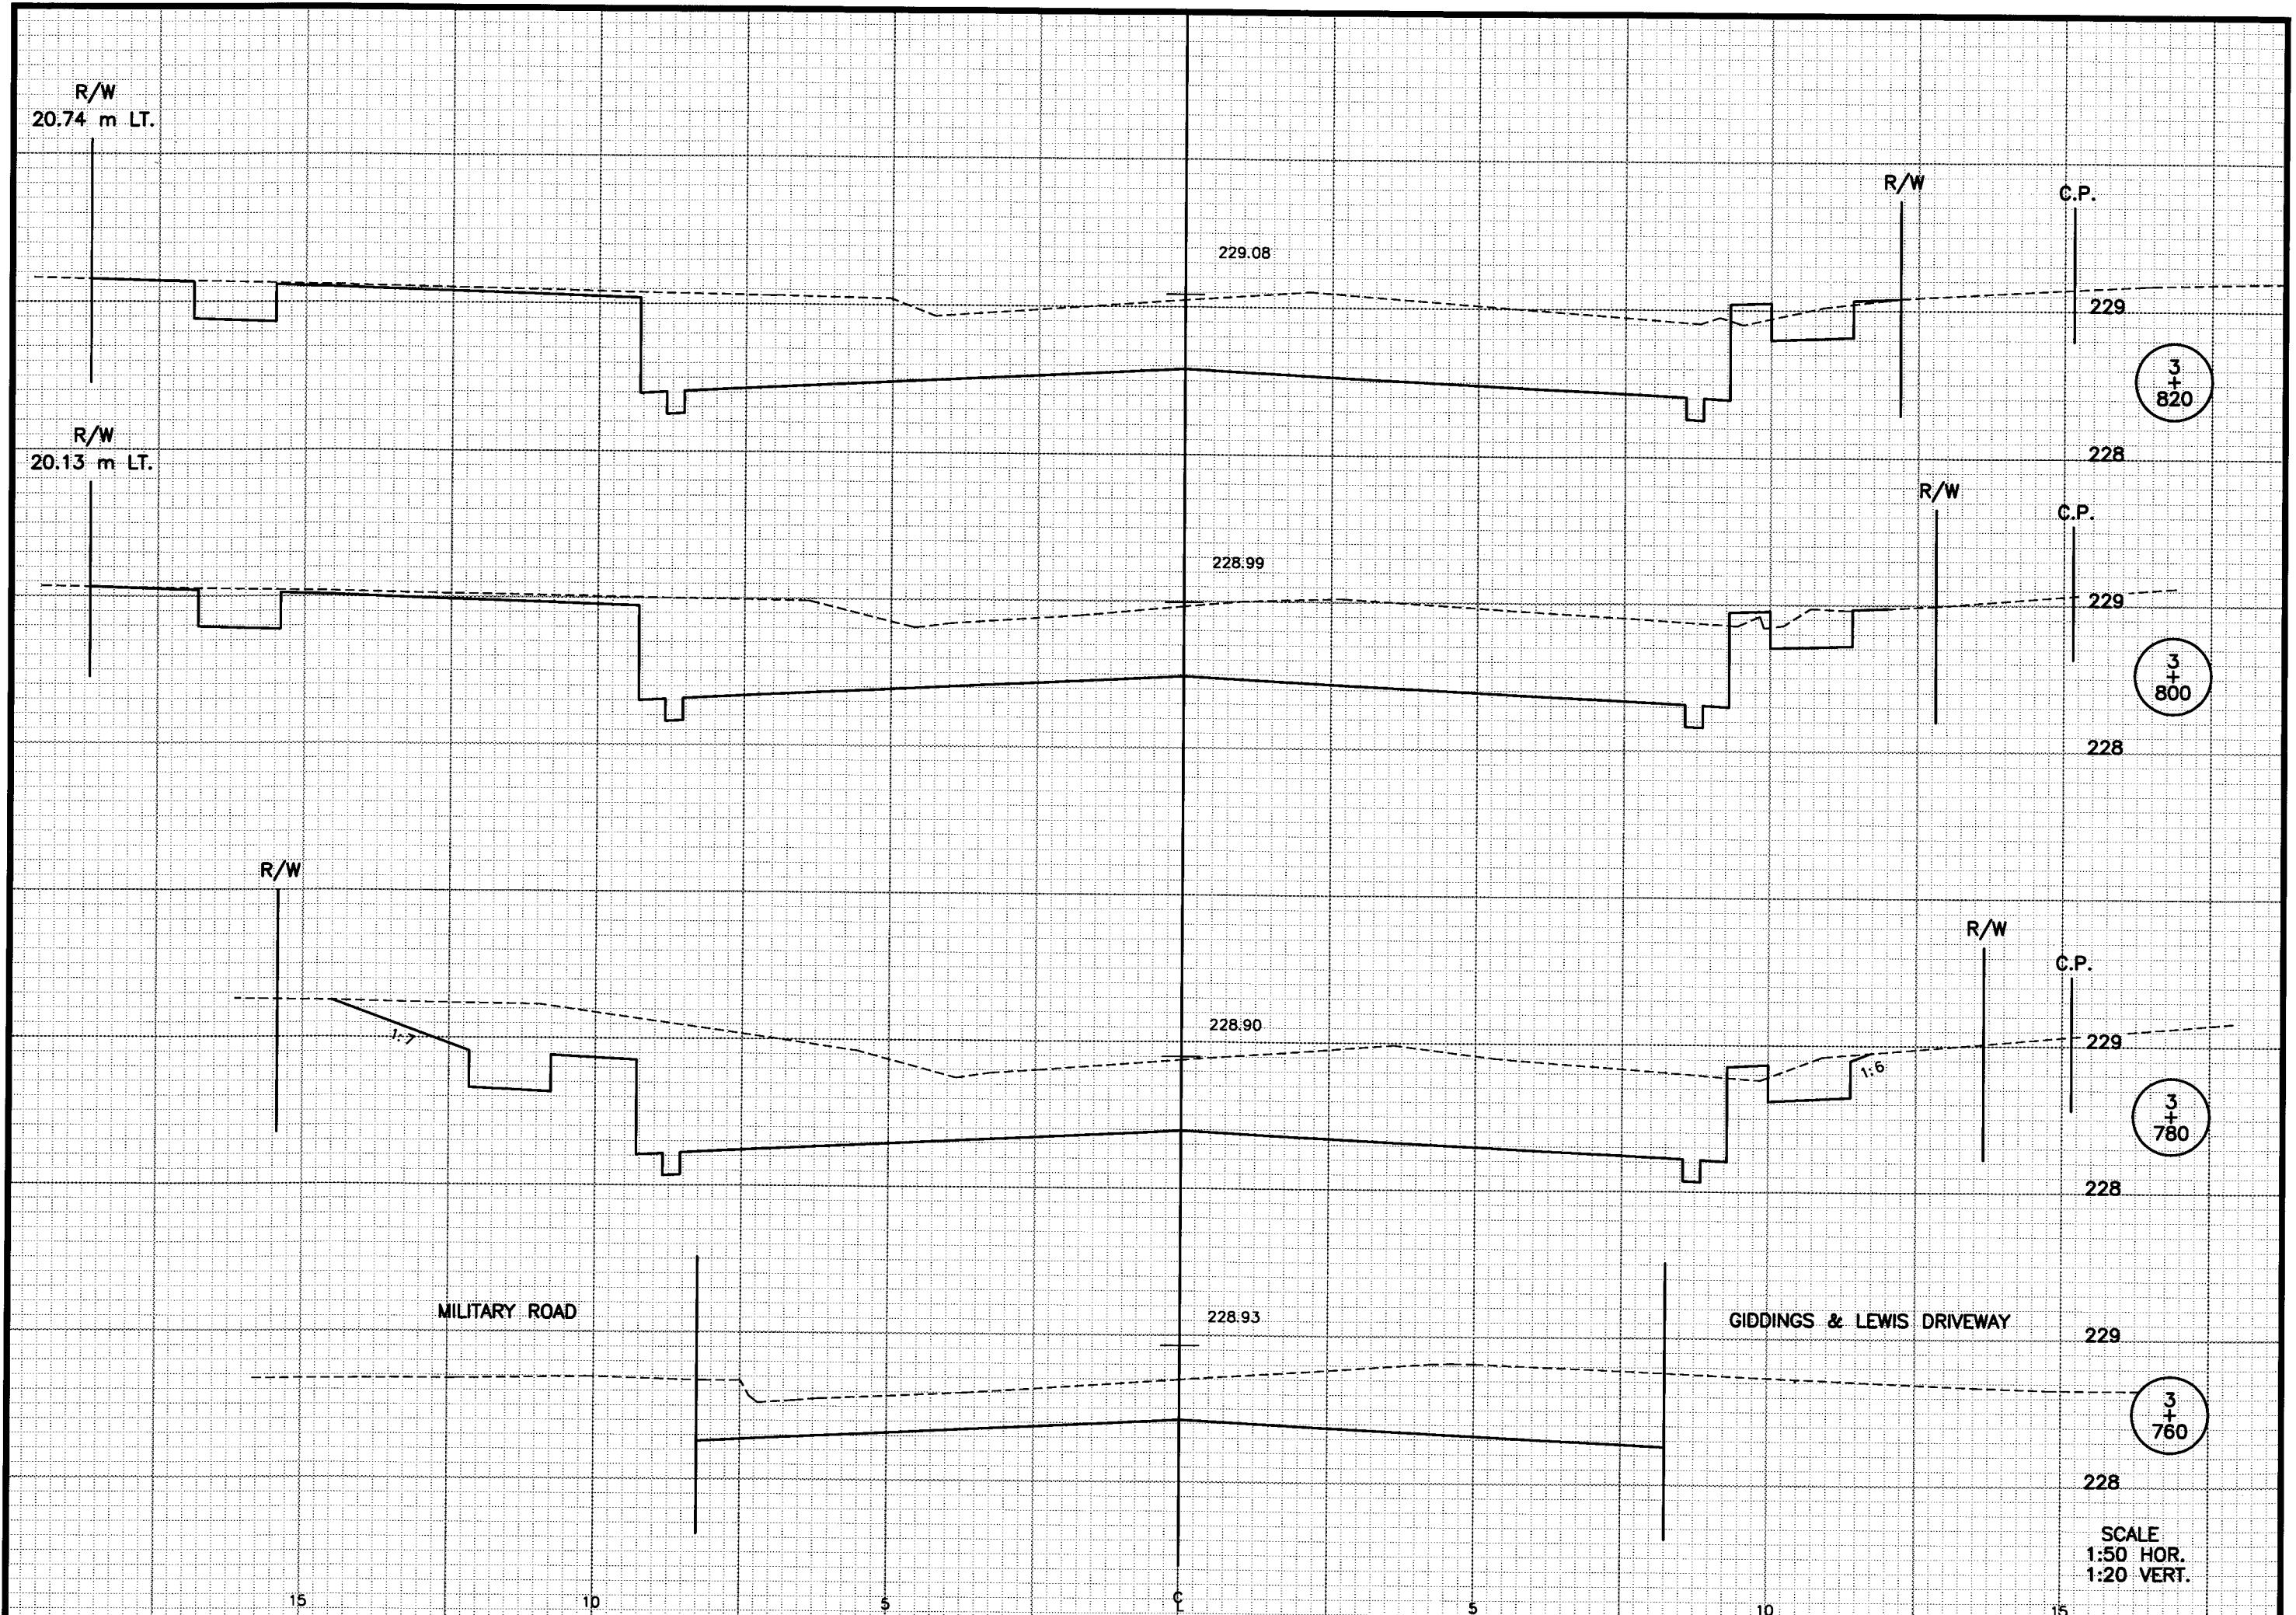

BRW CADD Sheet - MSECTION
Drawing File : X53024

R/W

229.09

R/W

C.P.

229

3
+
880

228

R/W

229.13

R/W

C.P.

229

3
+
860

R/W

229.16

R/W

C.P.

228

3
+
840

229

228

229.11

R/W

C.P.

229

3
+
824.5

228

SCALE
1:50 HOR.
1:20 VERT.

CROSS SECTIONS

STA. 3+824.5 - STA. 3+880


HWY: S.T.H. 23 COUNTY: FOND DU LAC

STATE PROJECT NO.: 1442-04-70

SHEET NO.: 9.43


M

BRW CADD Sheet - MSECTION
Drawing File : X53900

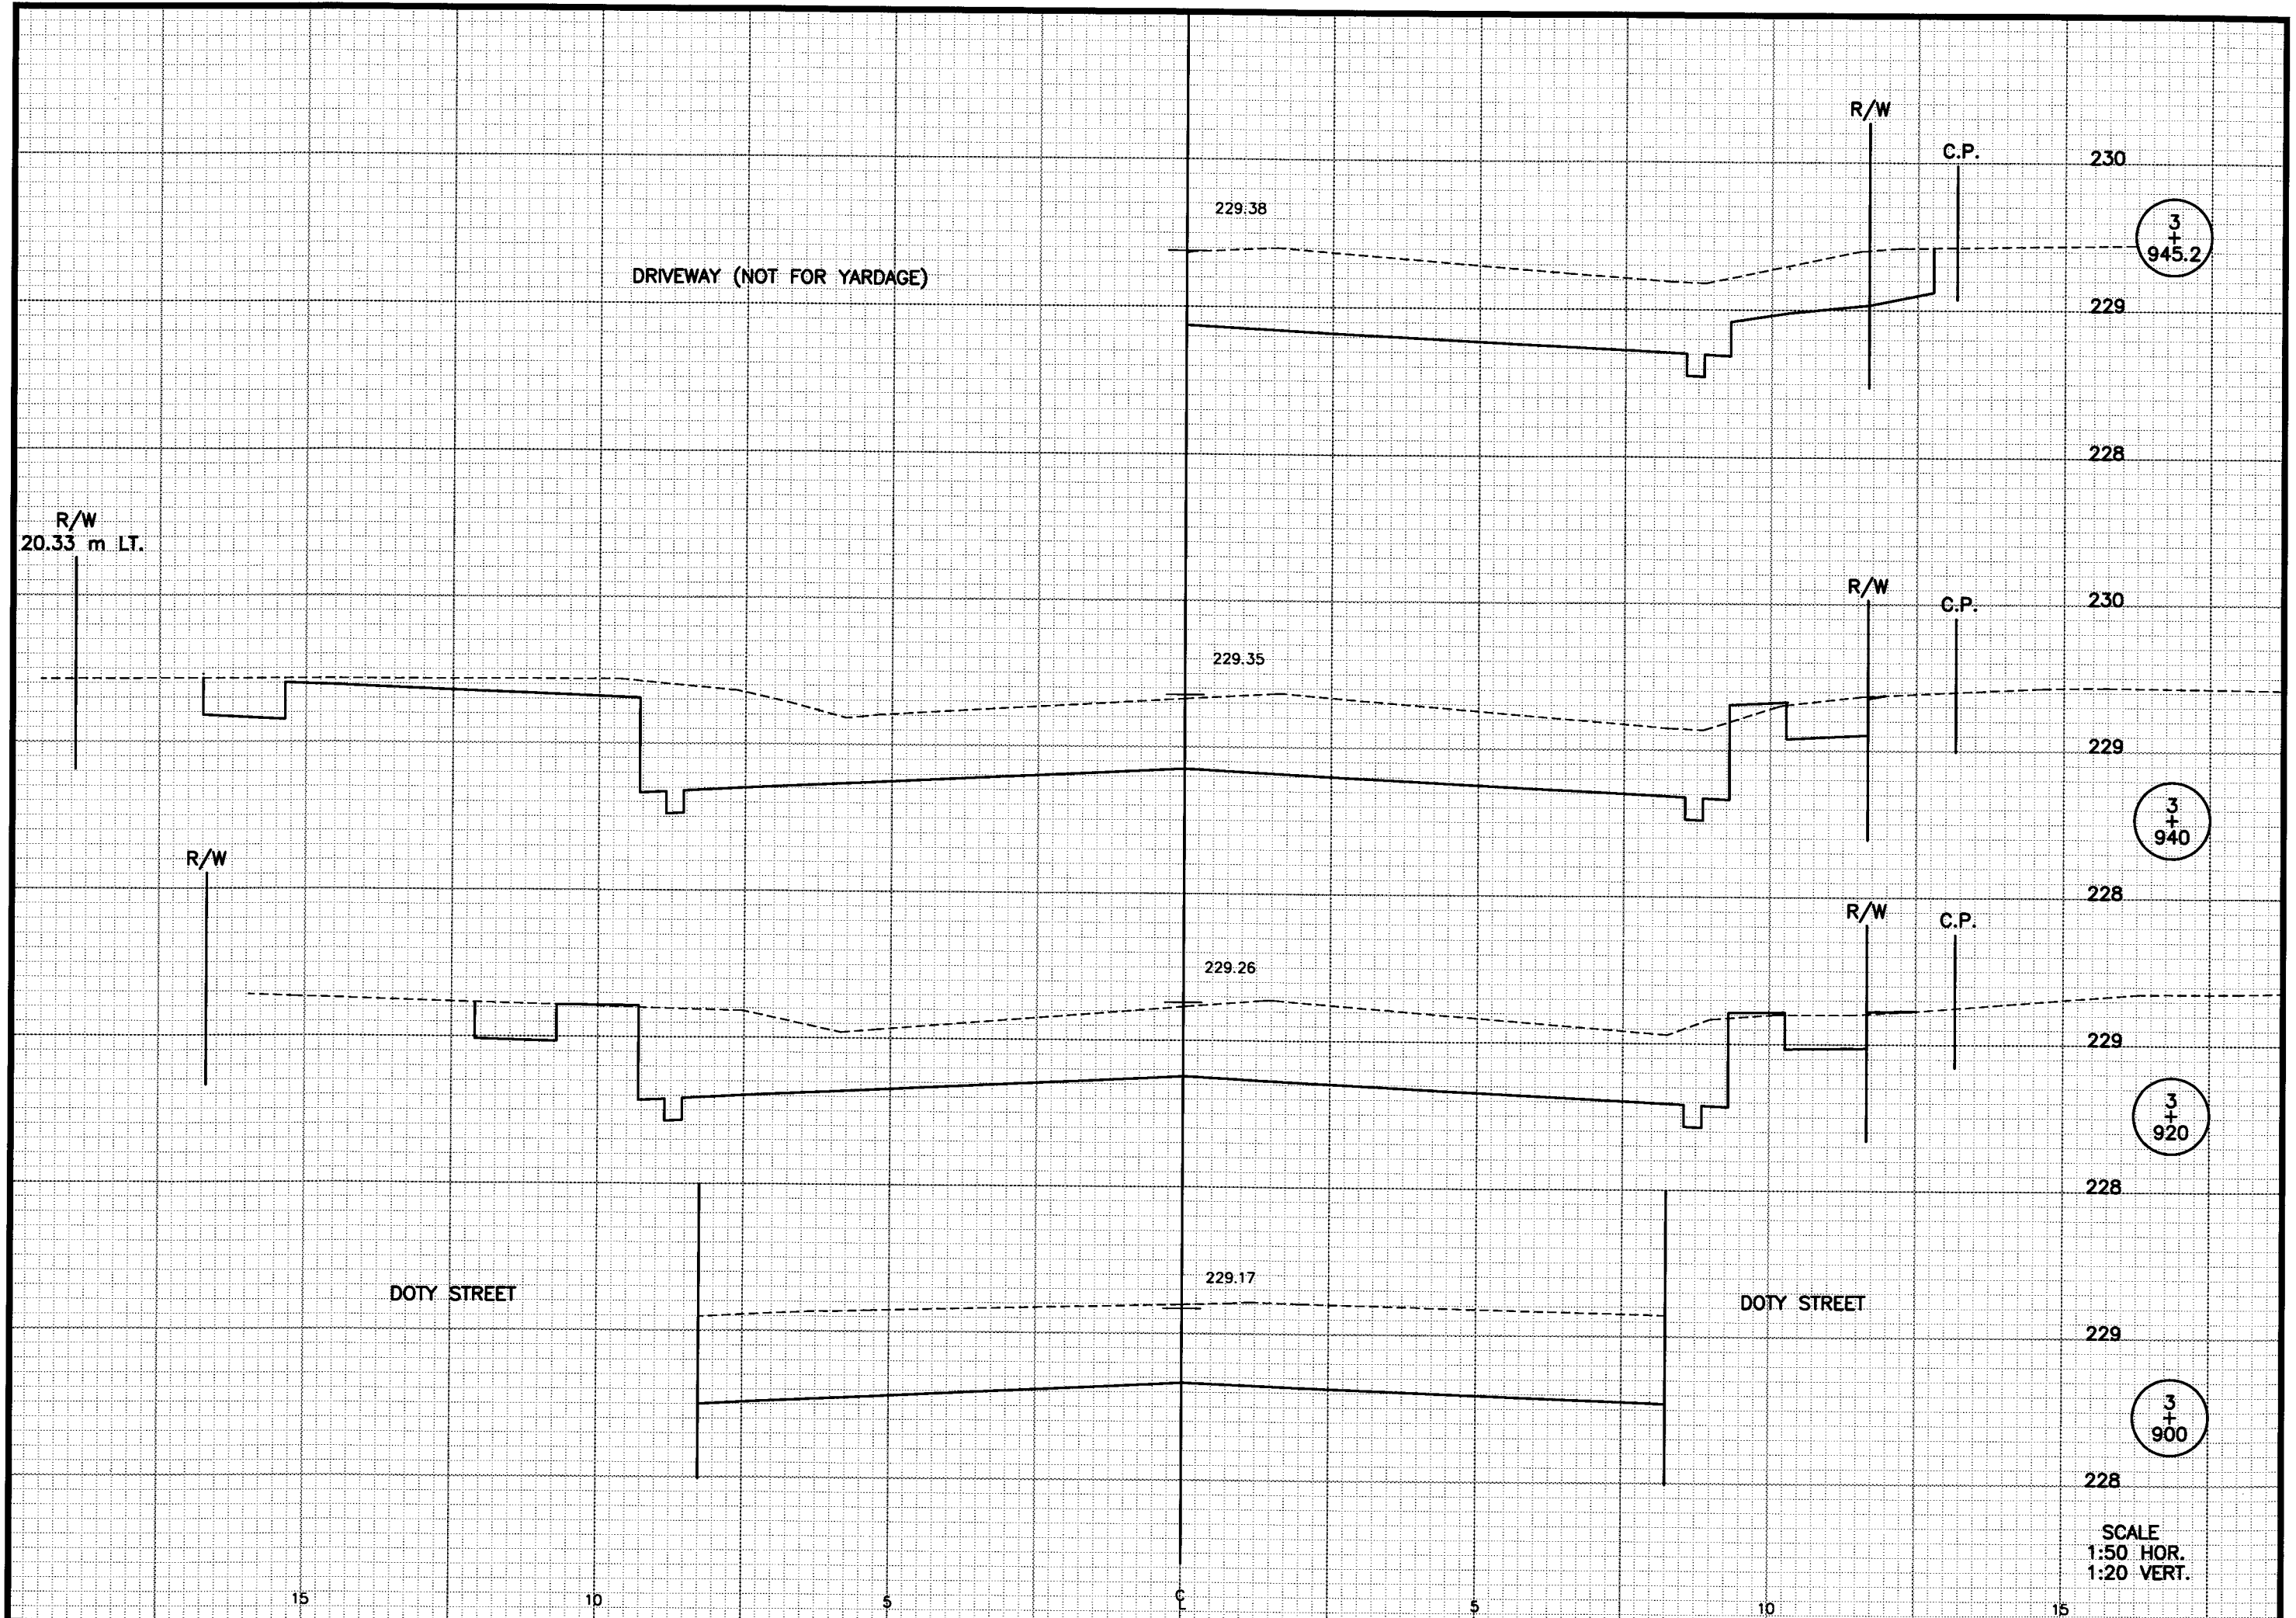


Drawing File : XS3960

BRW CADD Sheet - MSECTION

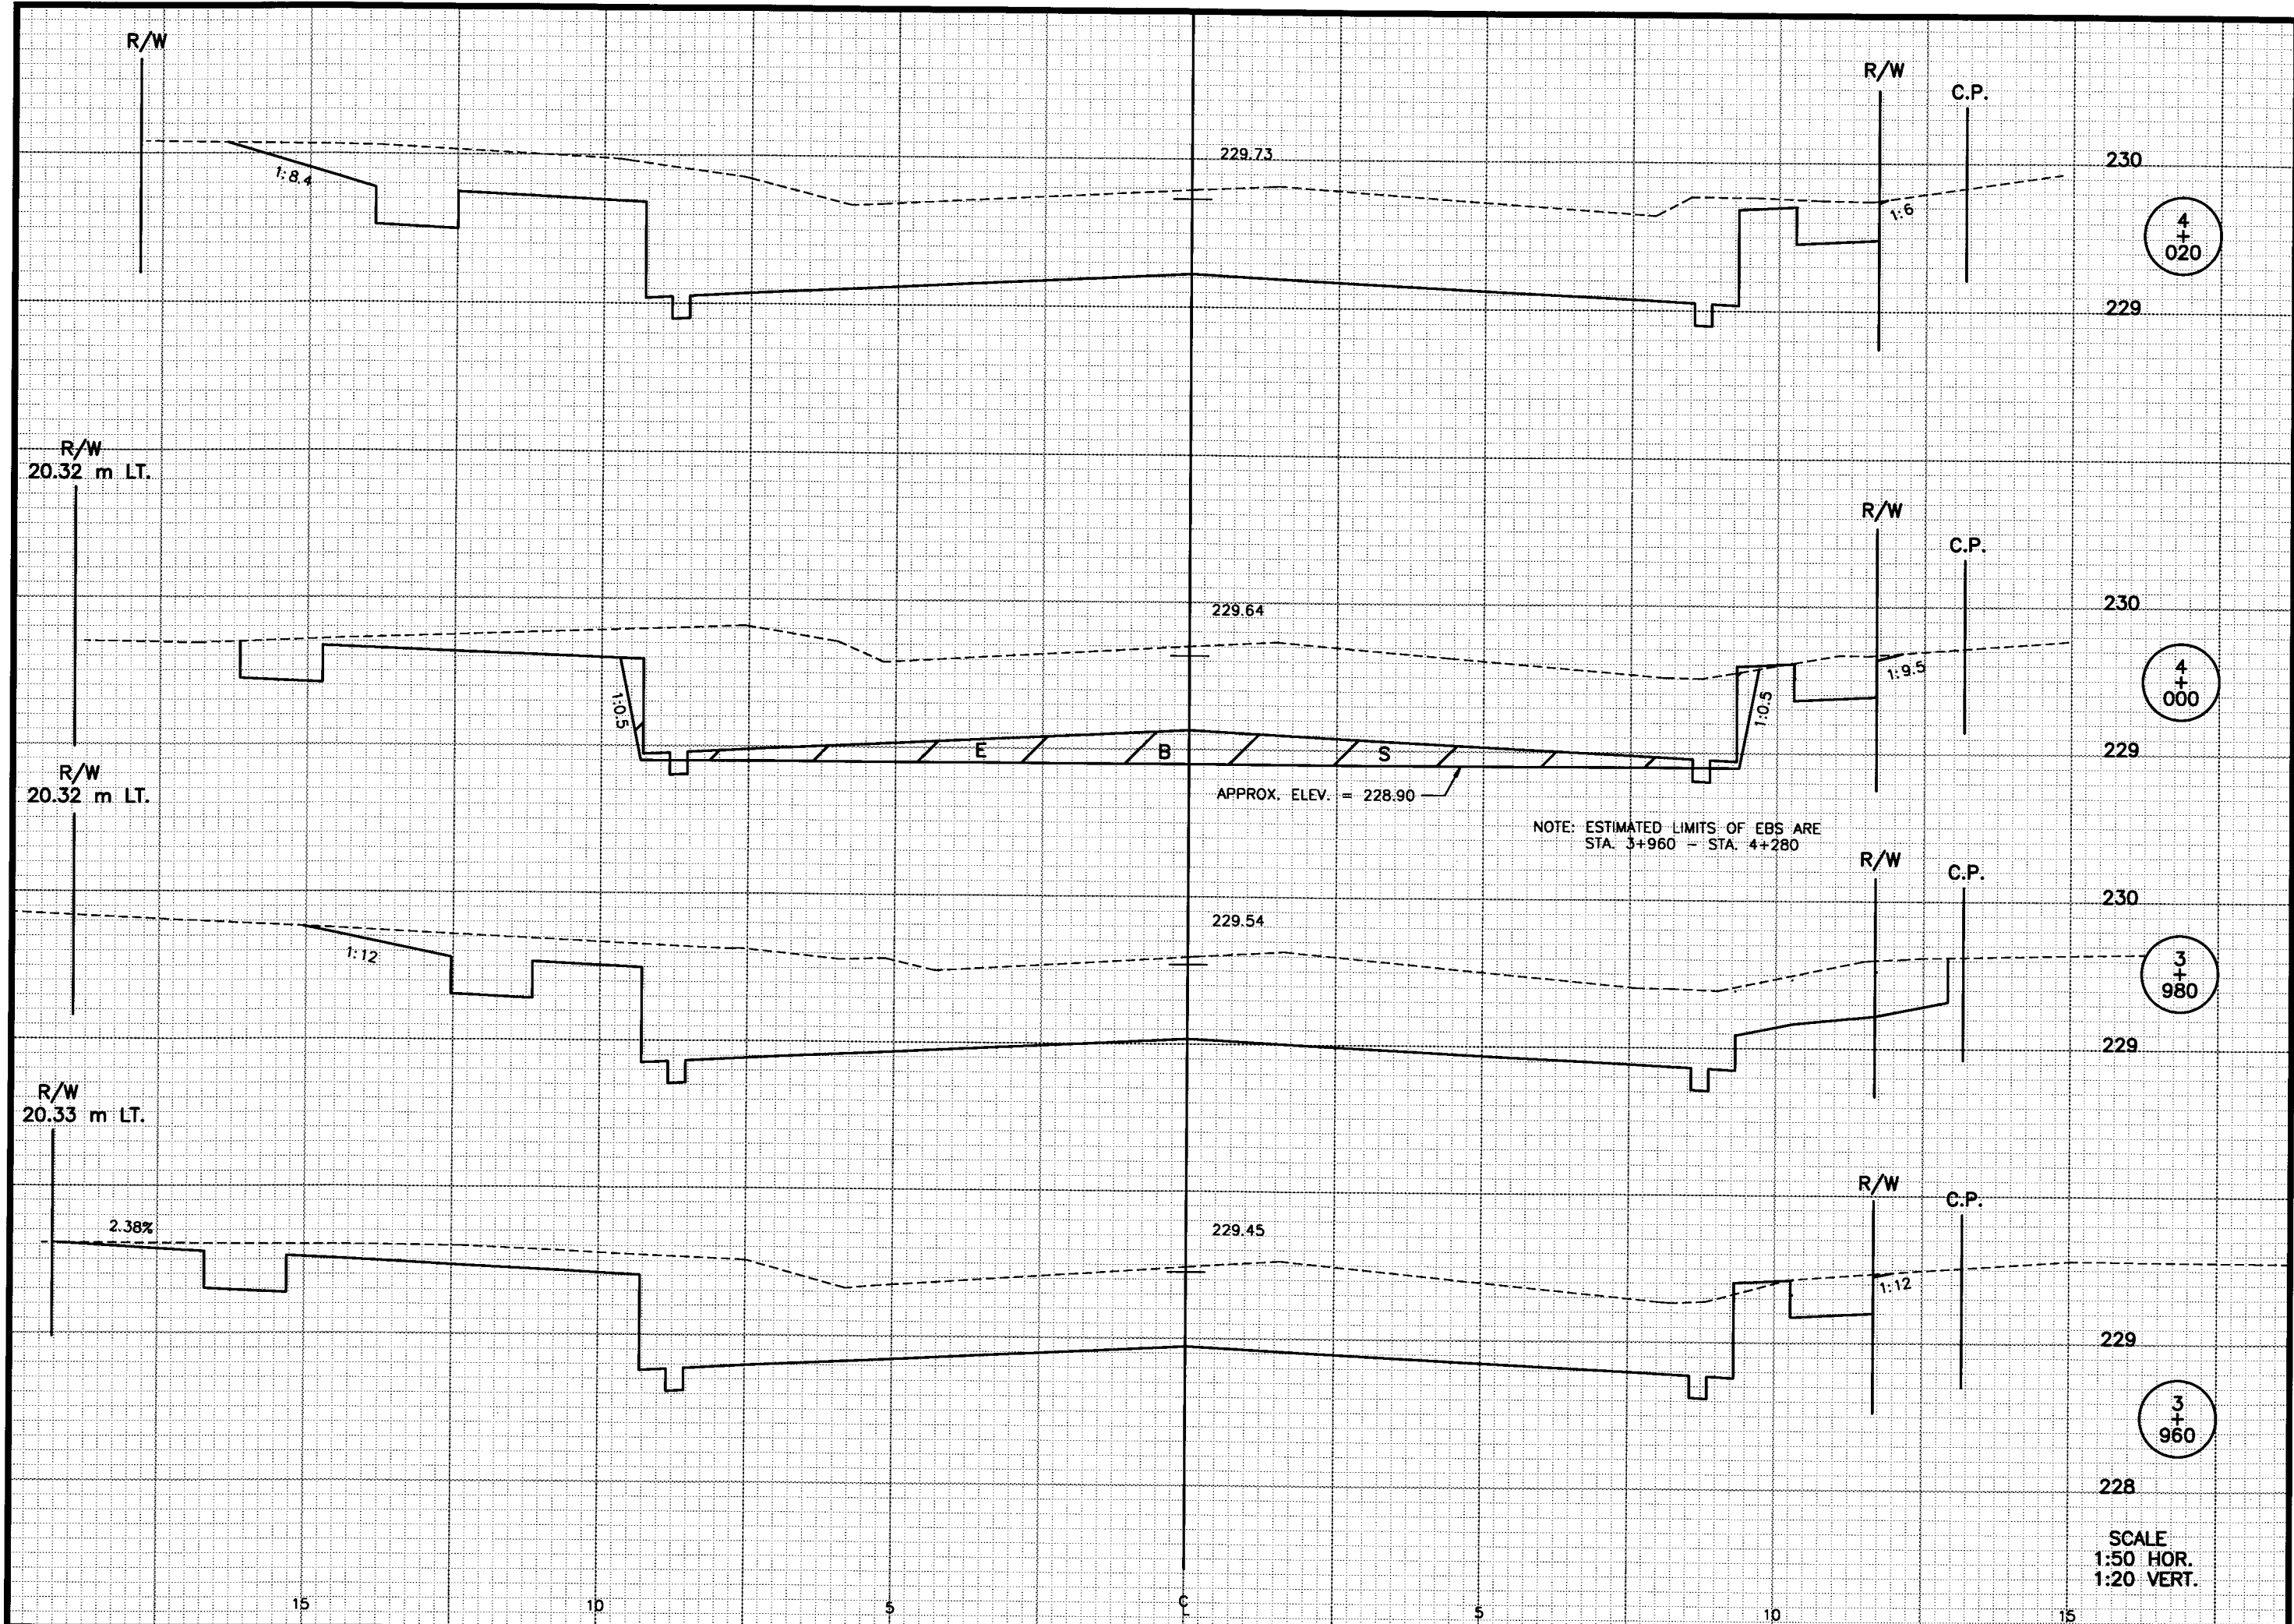


BRW CADD Sheet - MSECTION
Drawing File : XS4040

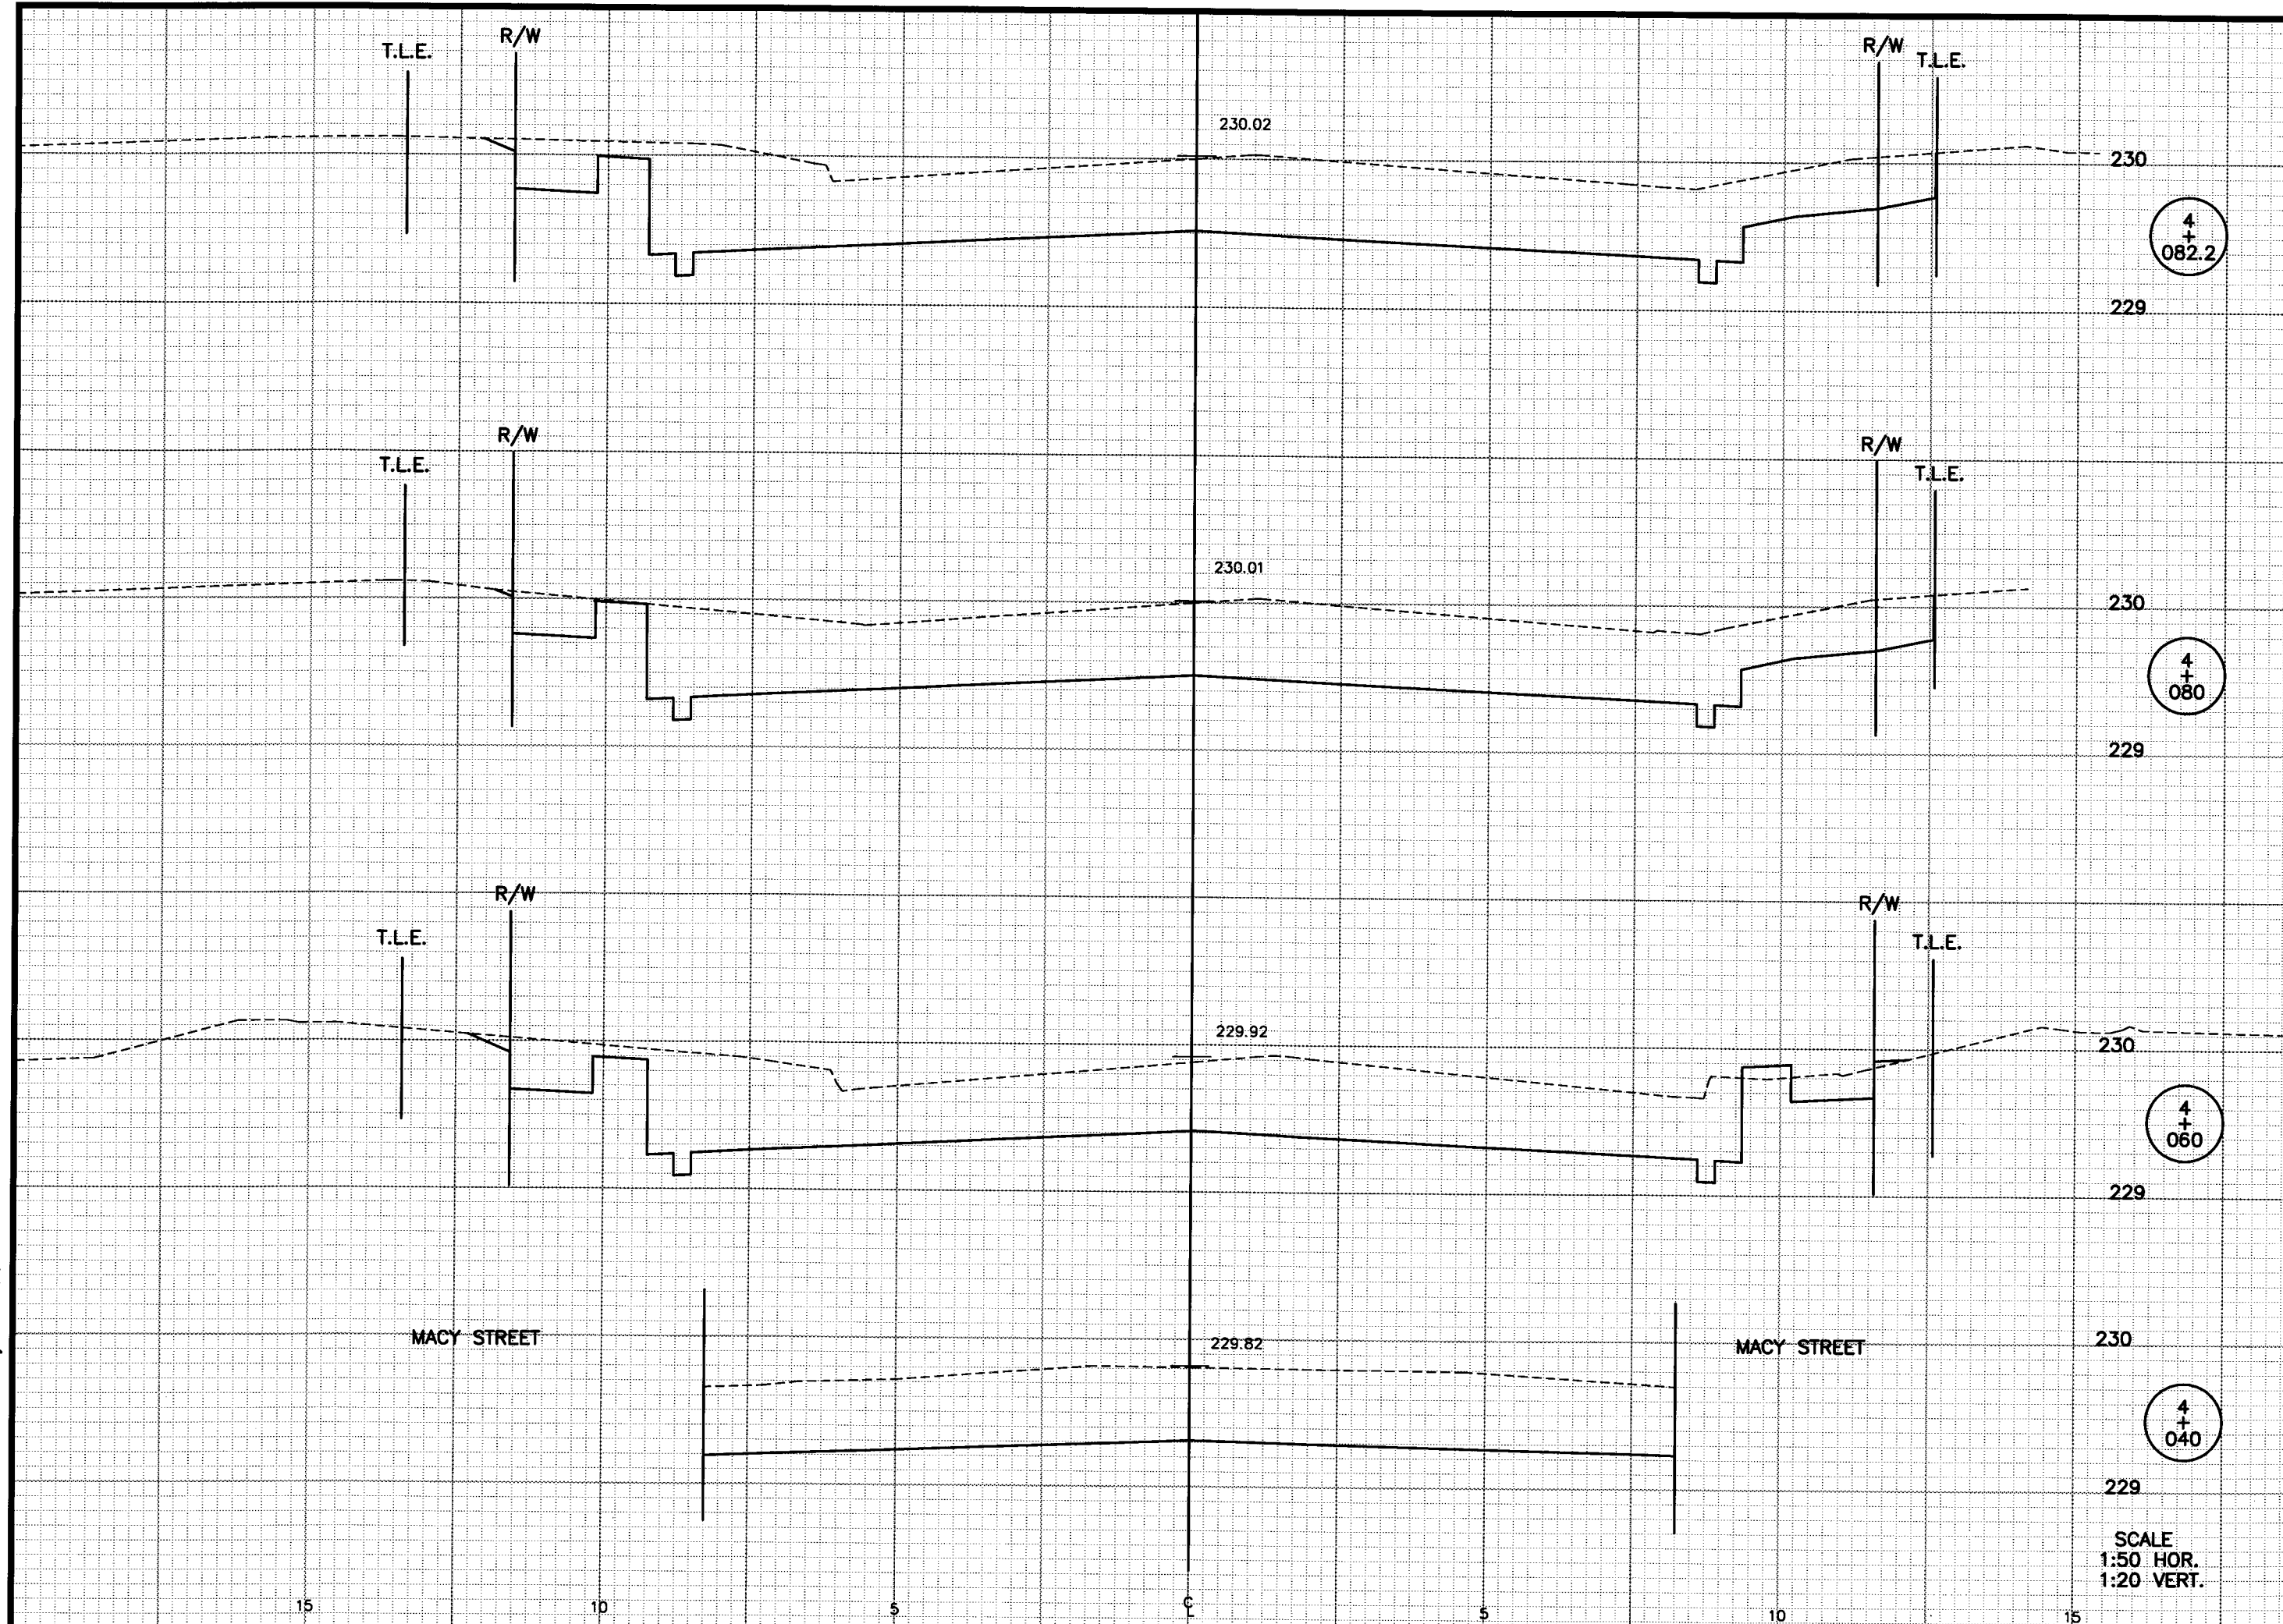


Drawing File : XS4096


BRW CUD Sheet - MSECTION

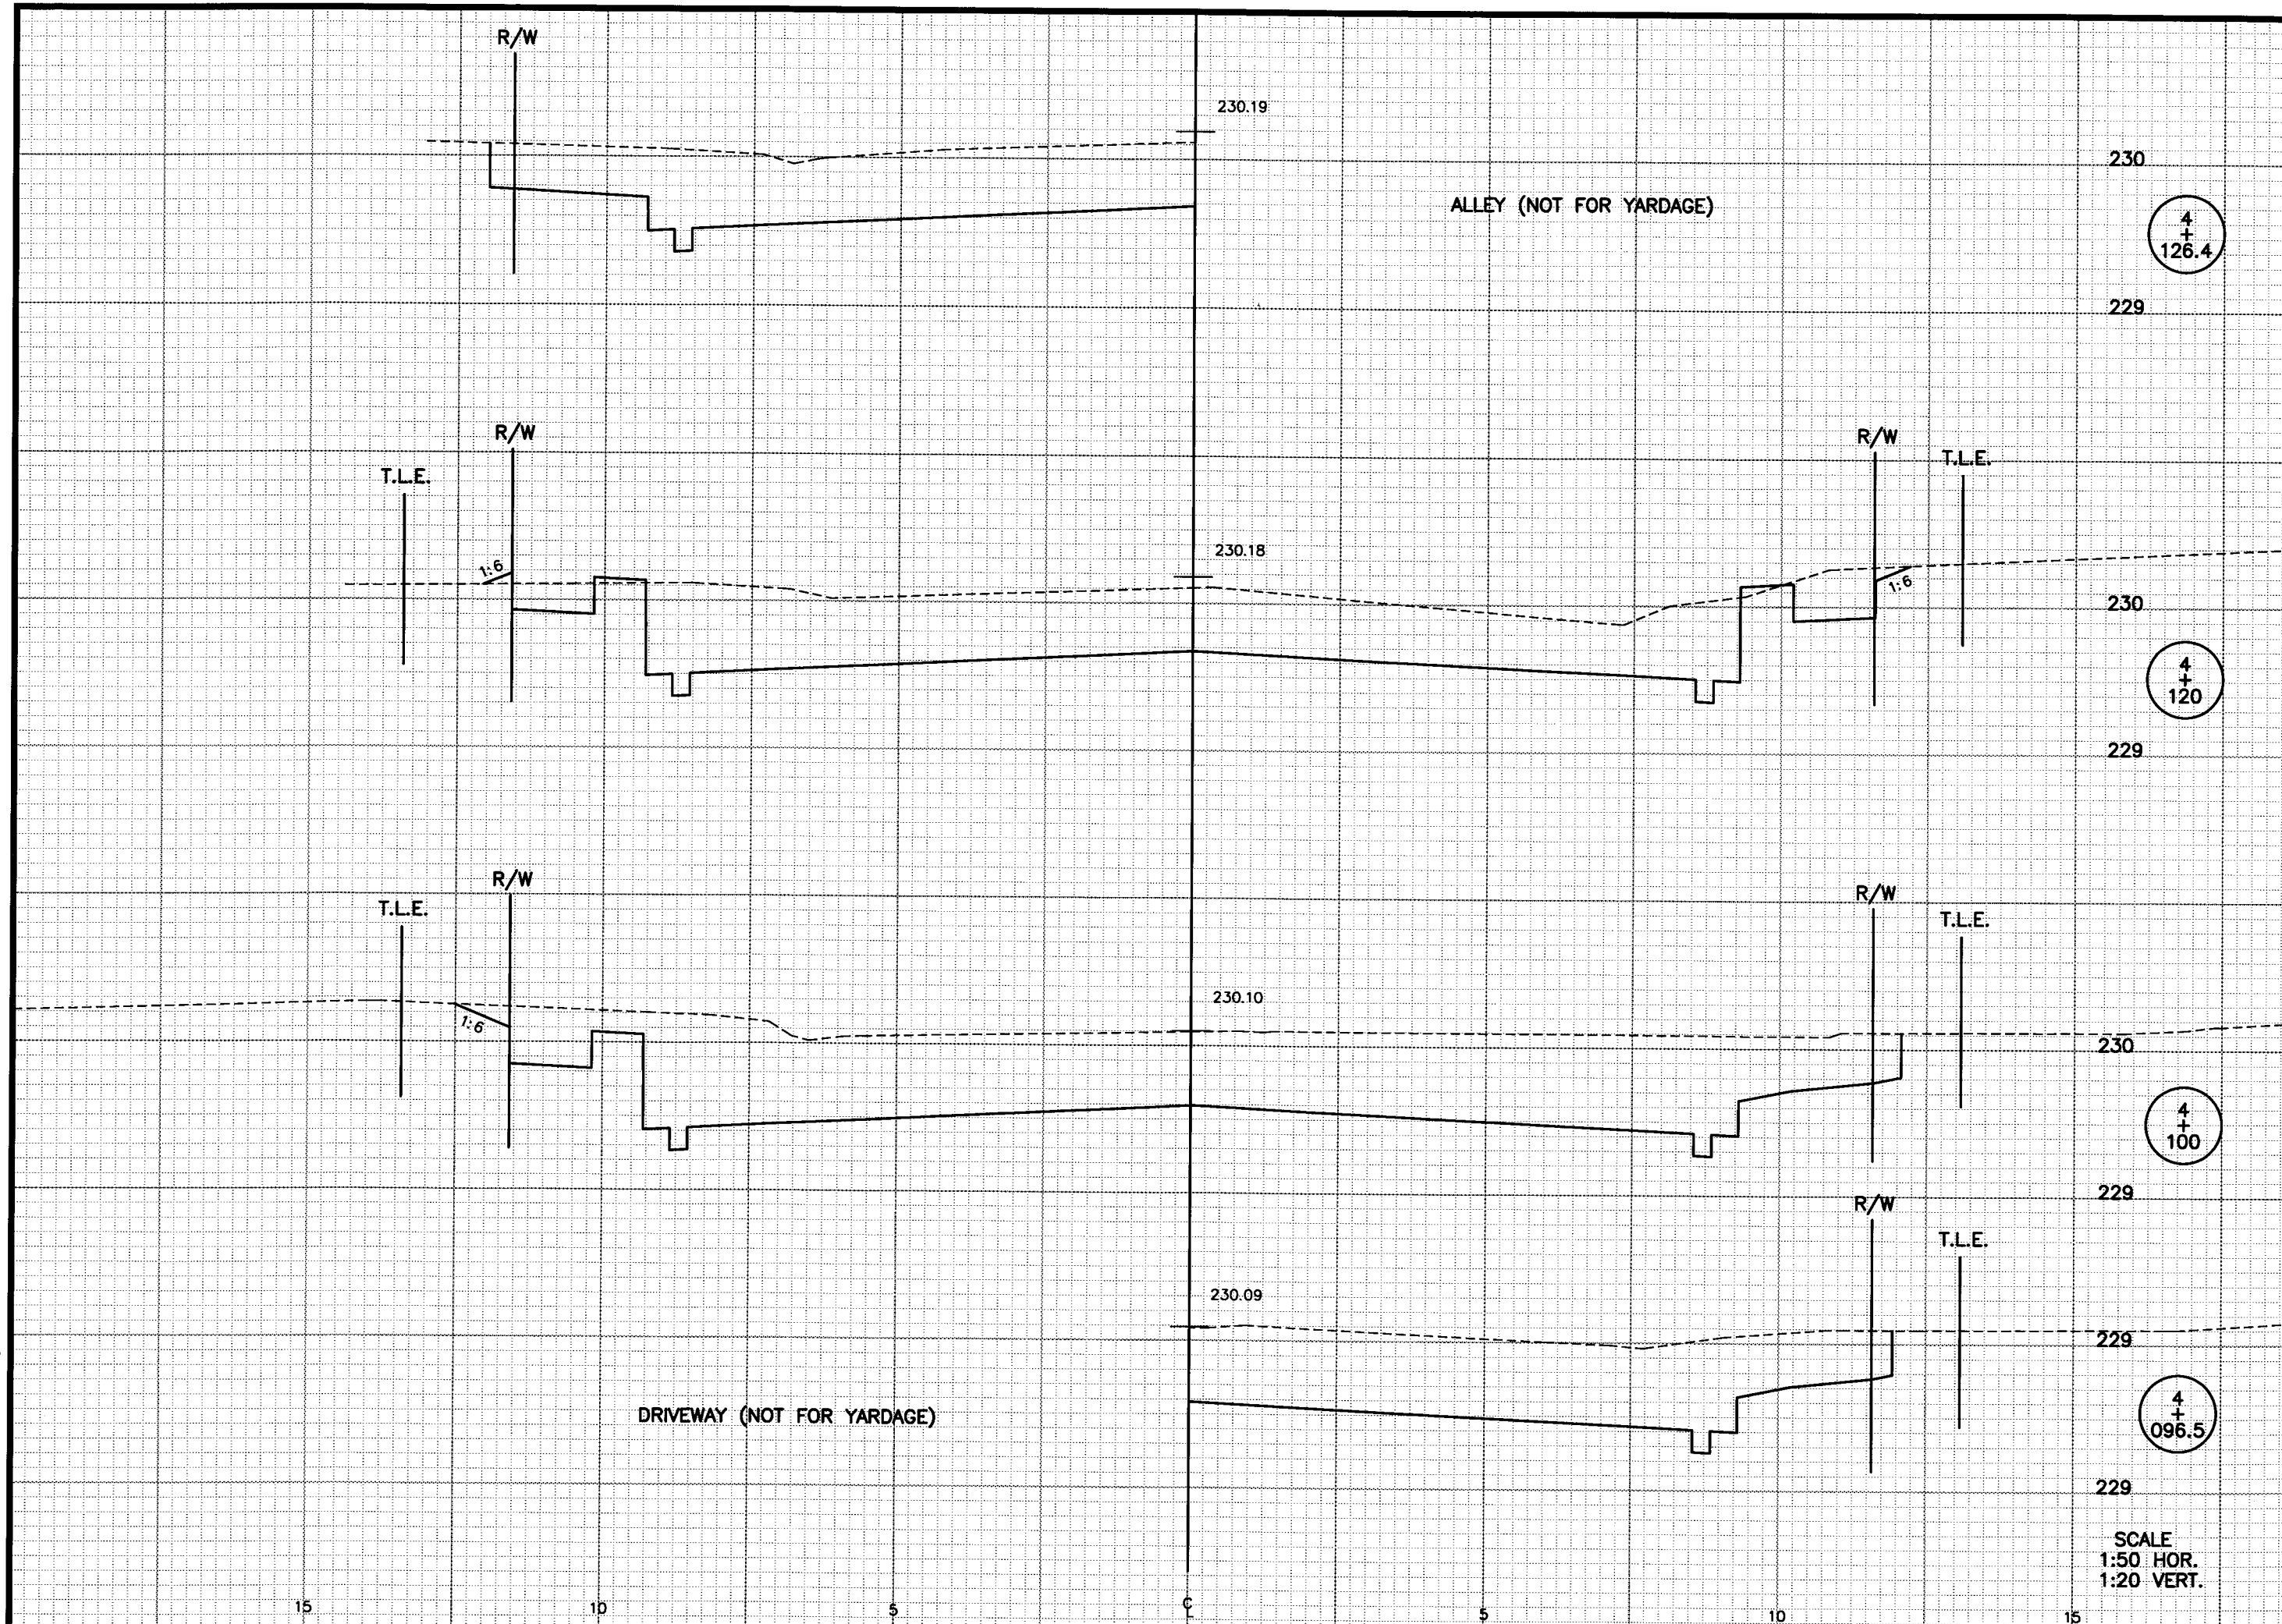

BRW CADD Sheet - MSECTION
Drawing File : XS4140

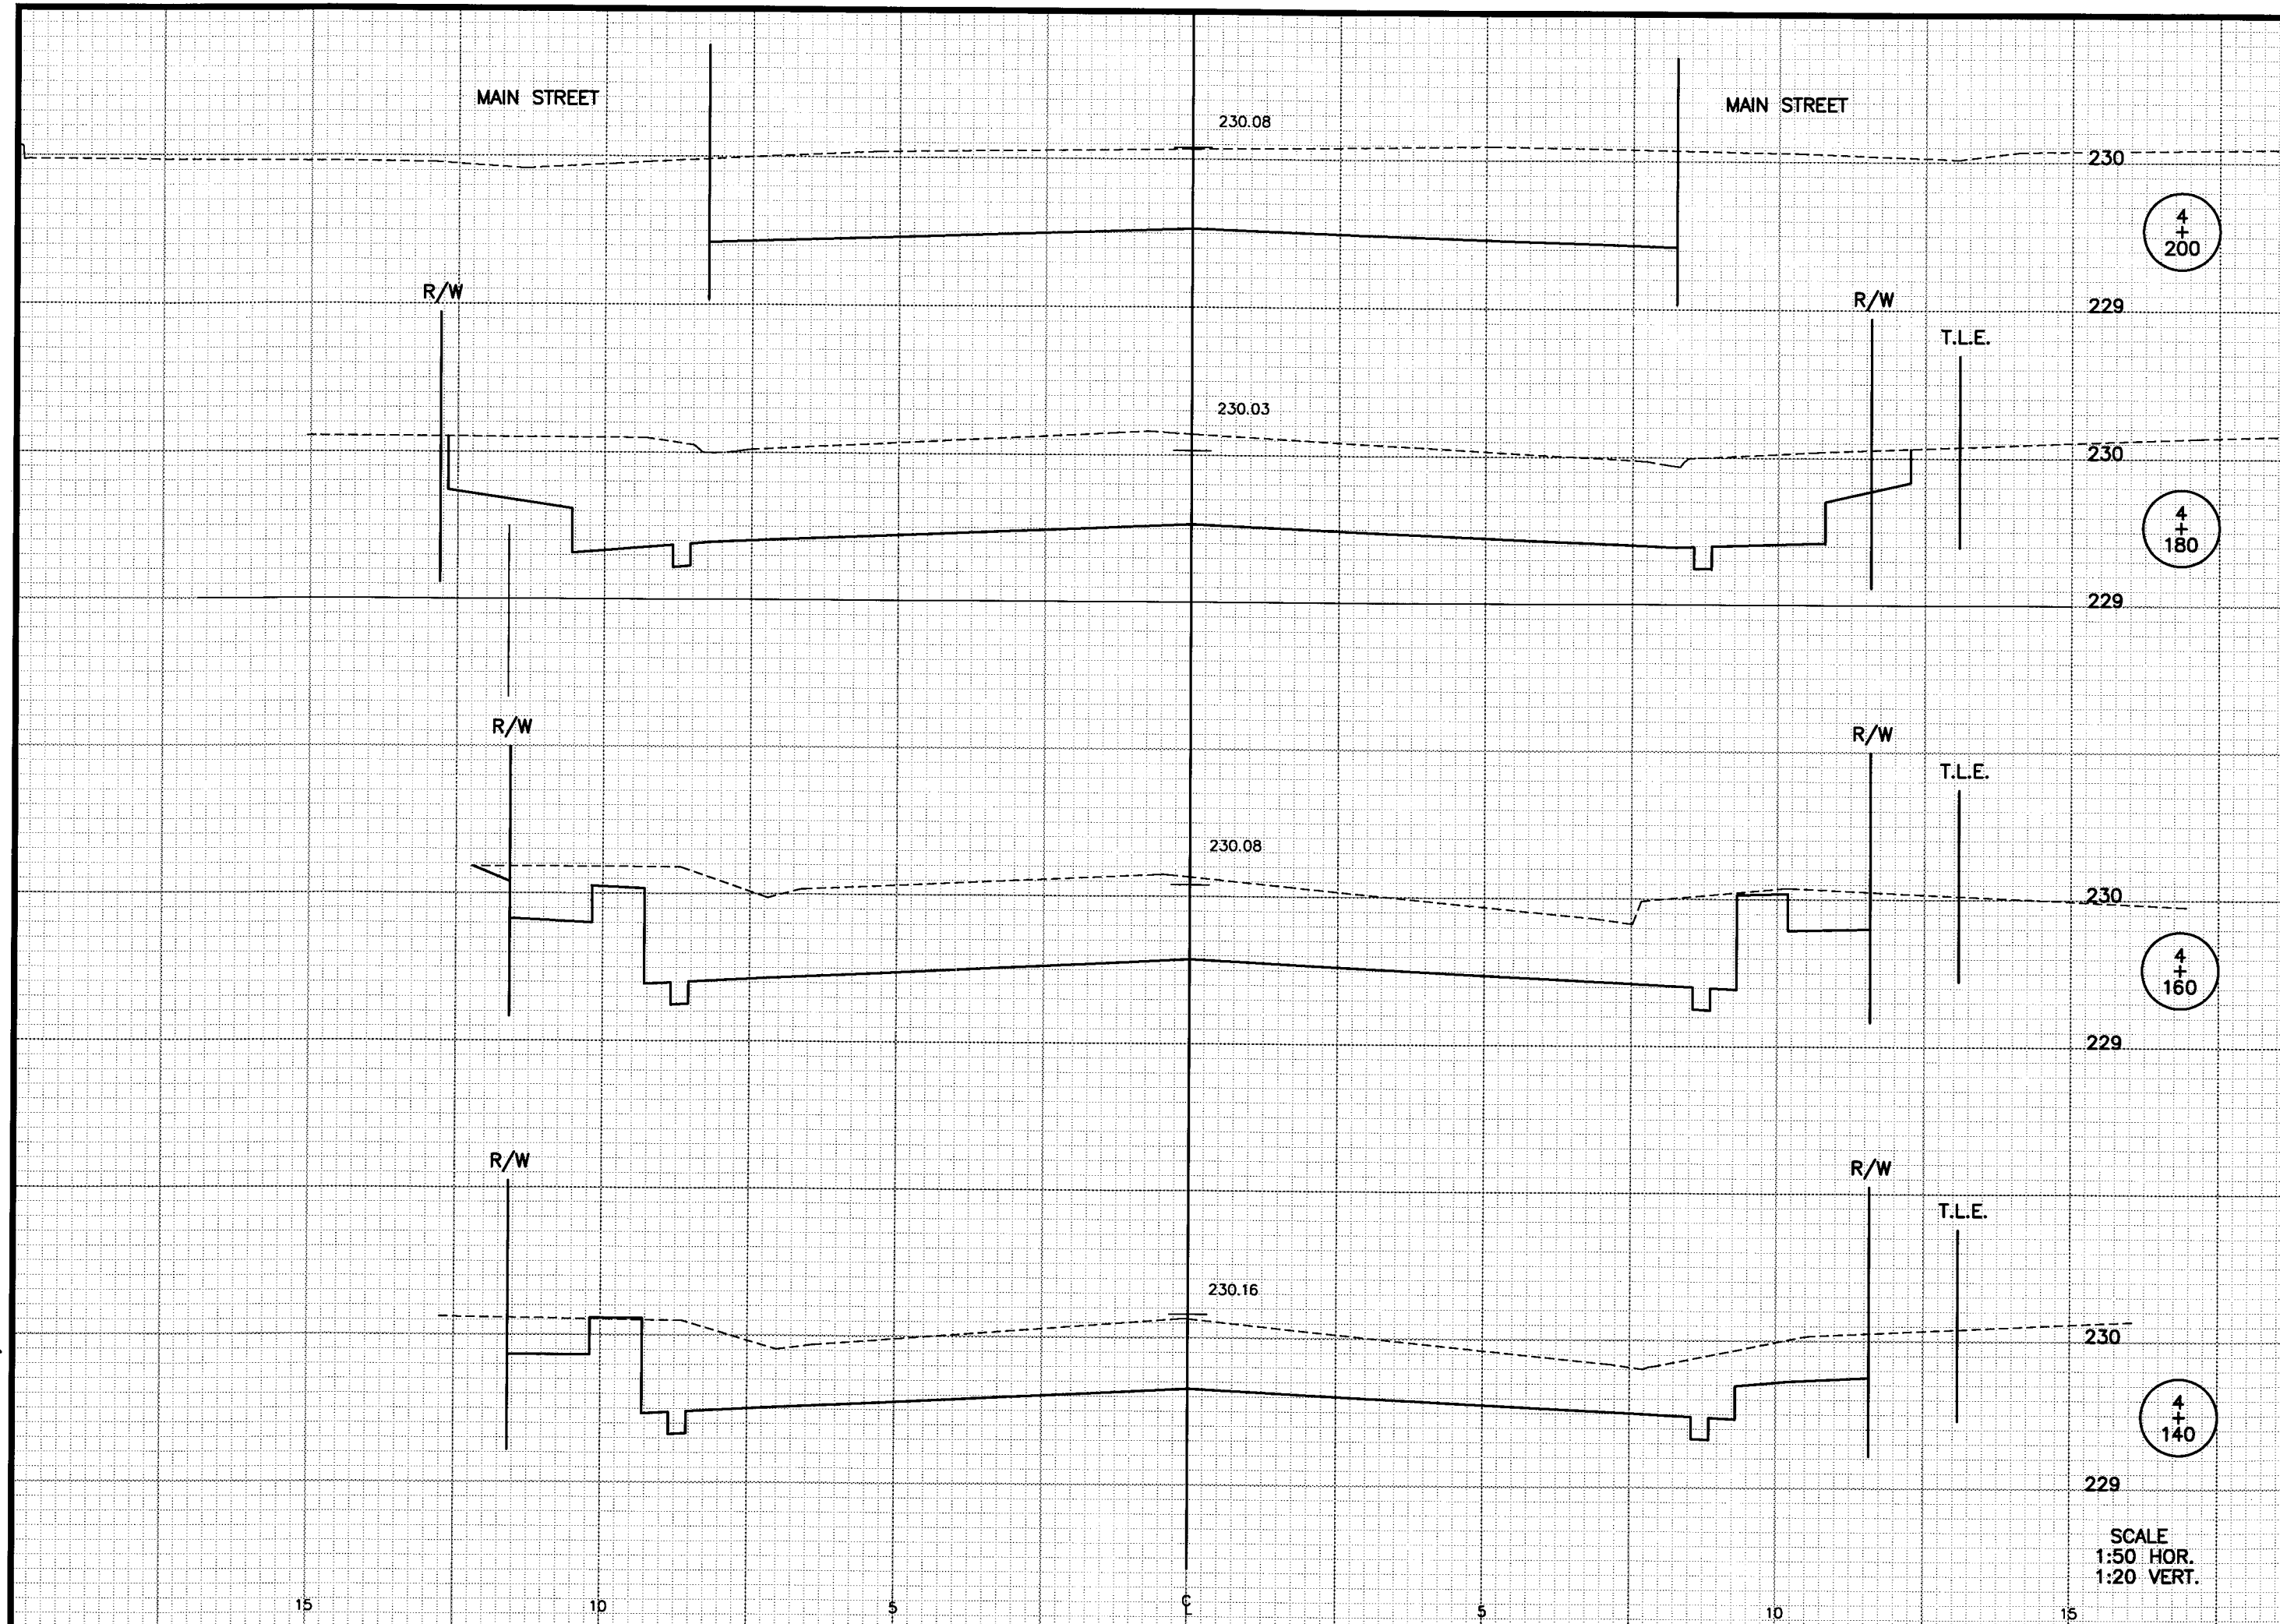

BRW CDD Sheet - MSECTION
Drawing File : XS4220

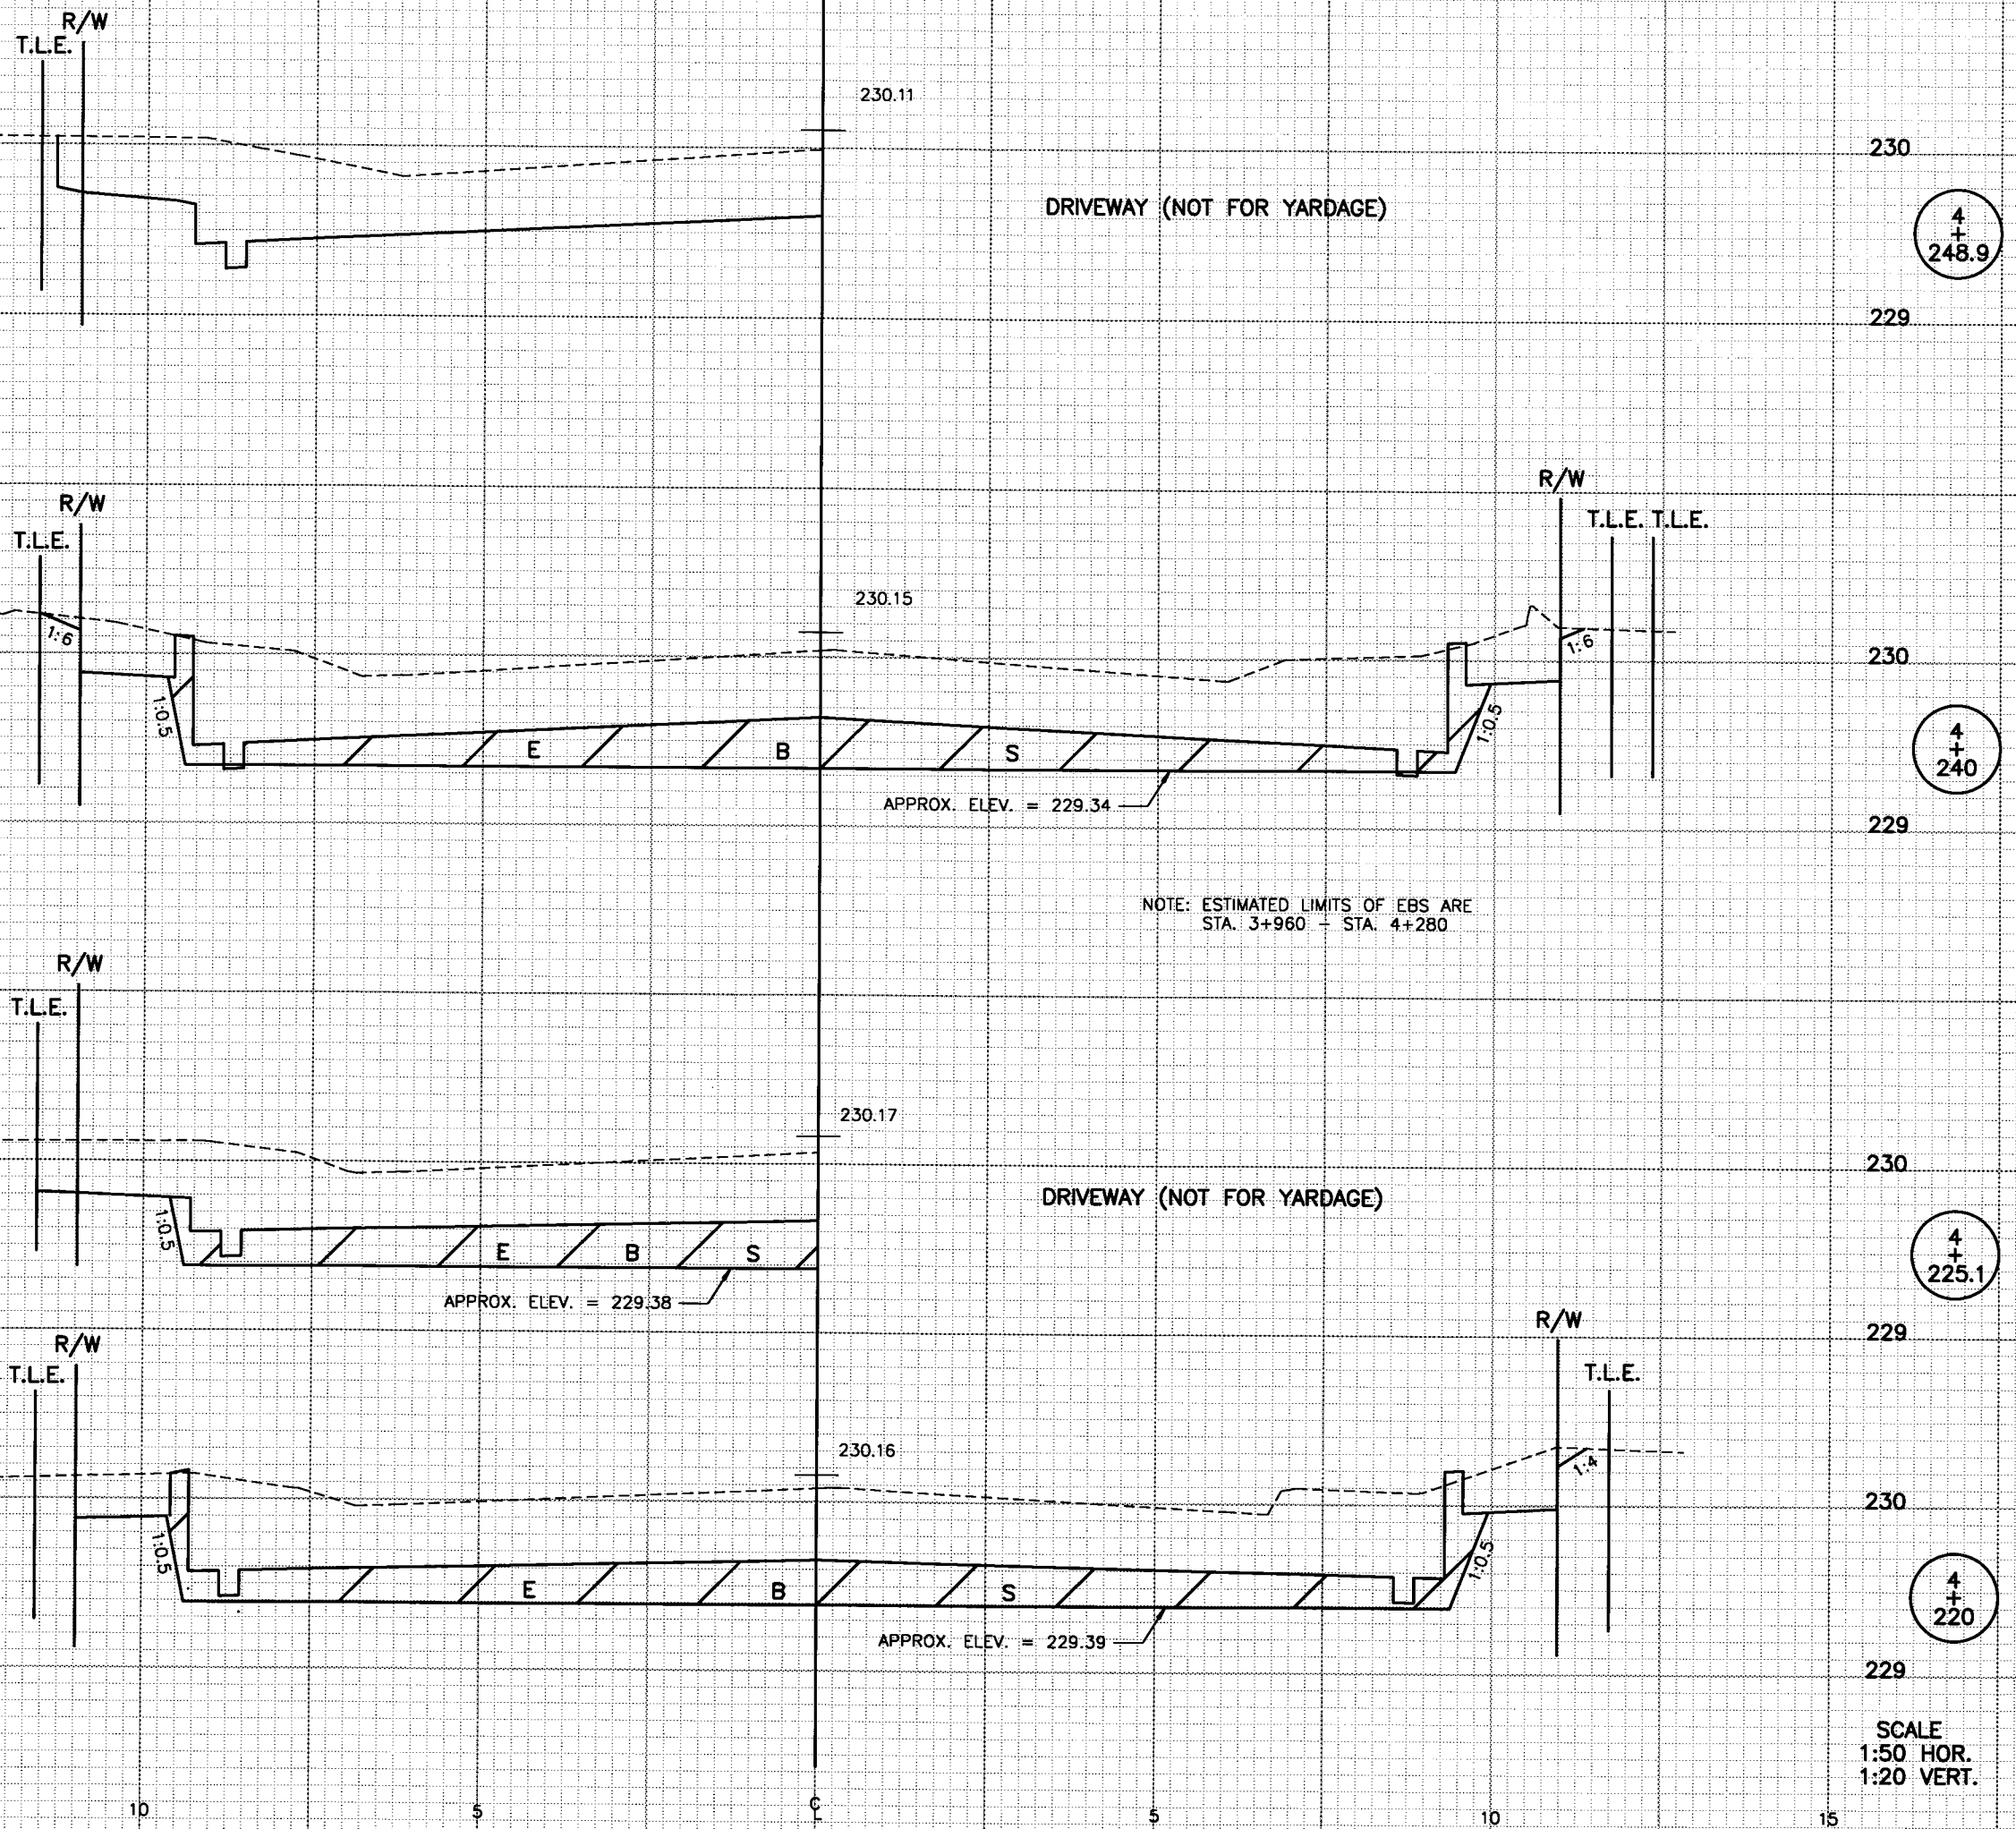

CROSS SECTIONS


STA. 4+220 - STA. 4+248.9

HWY: S.T.H. 23 COUNTY: FOND DU LAC


STATE PROJECT NO.: 1442-04-70

SHEET NO.: 9.49 M

BRW CAD Sheet - MSECTION
Drawing File : X54260

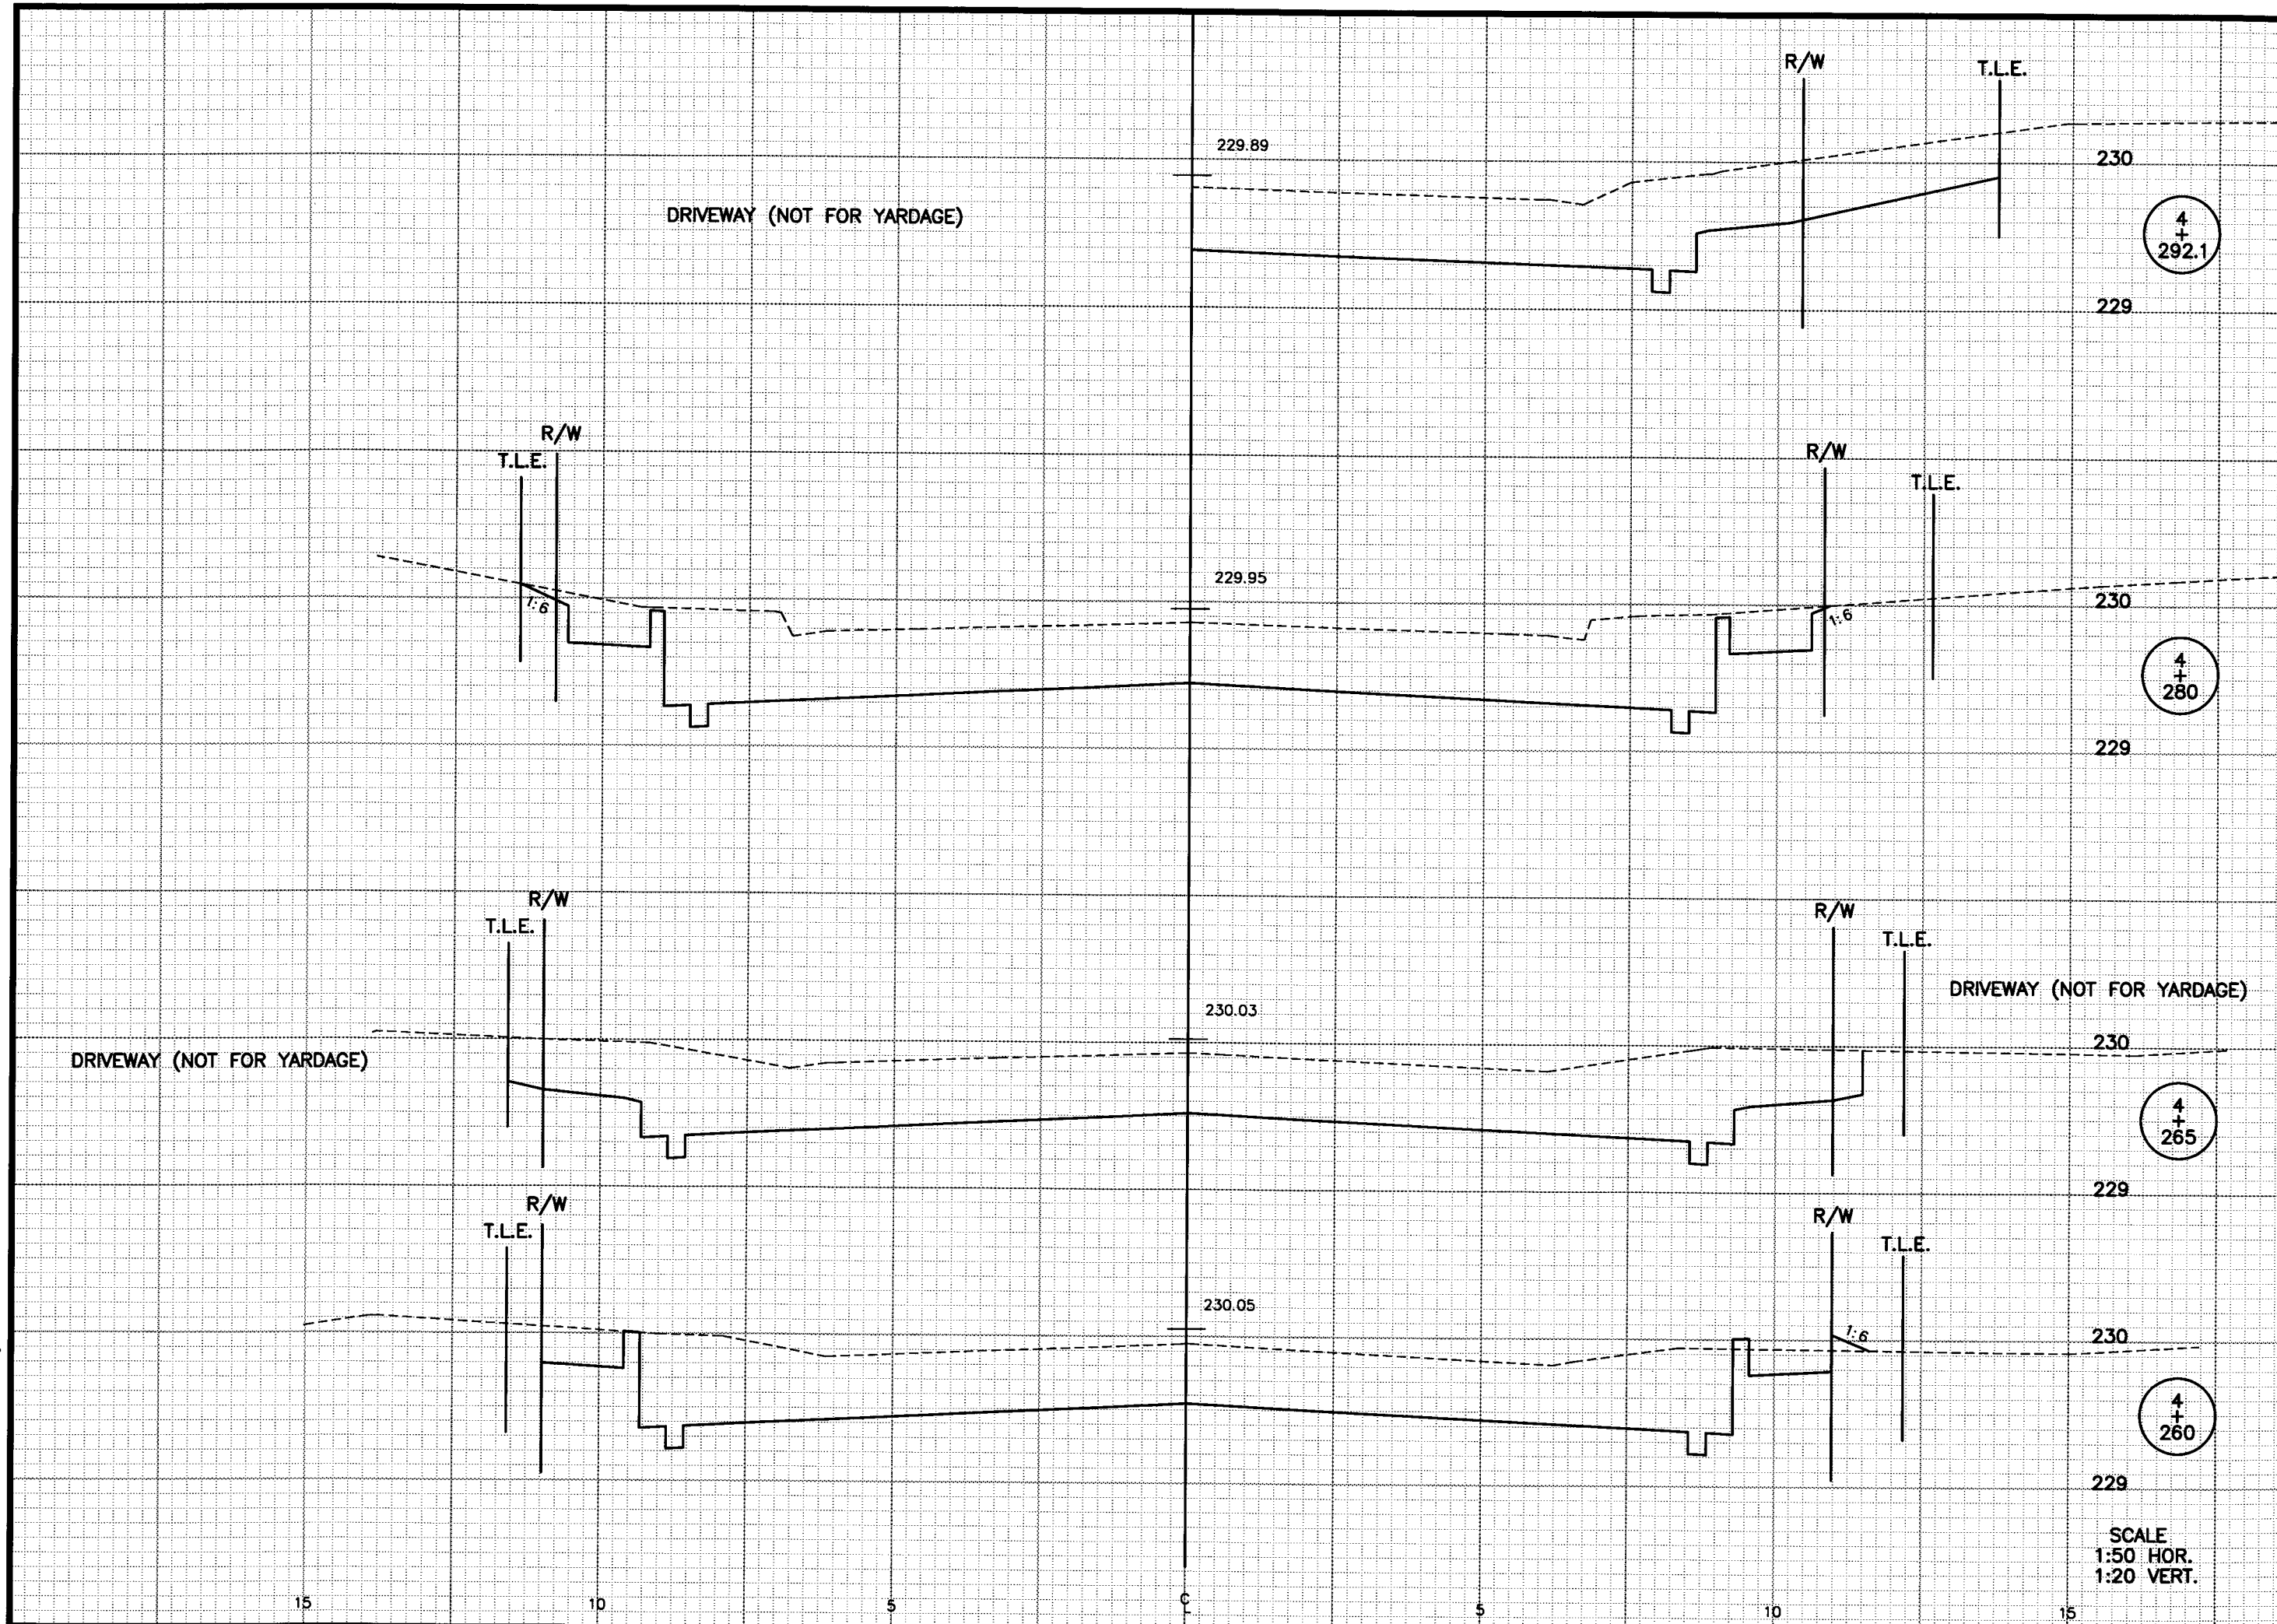


BRW CAD Sheet - MSECTION
Drawing File : XS500000

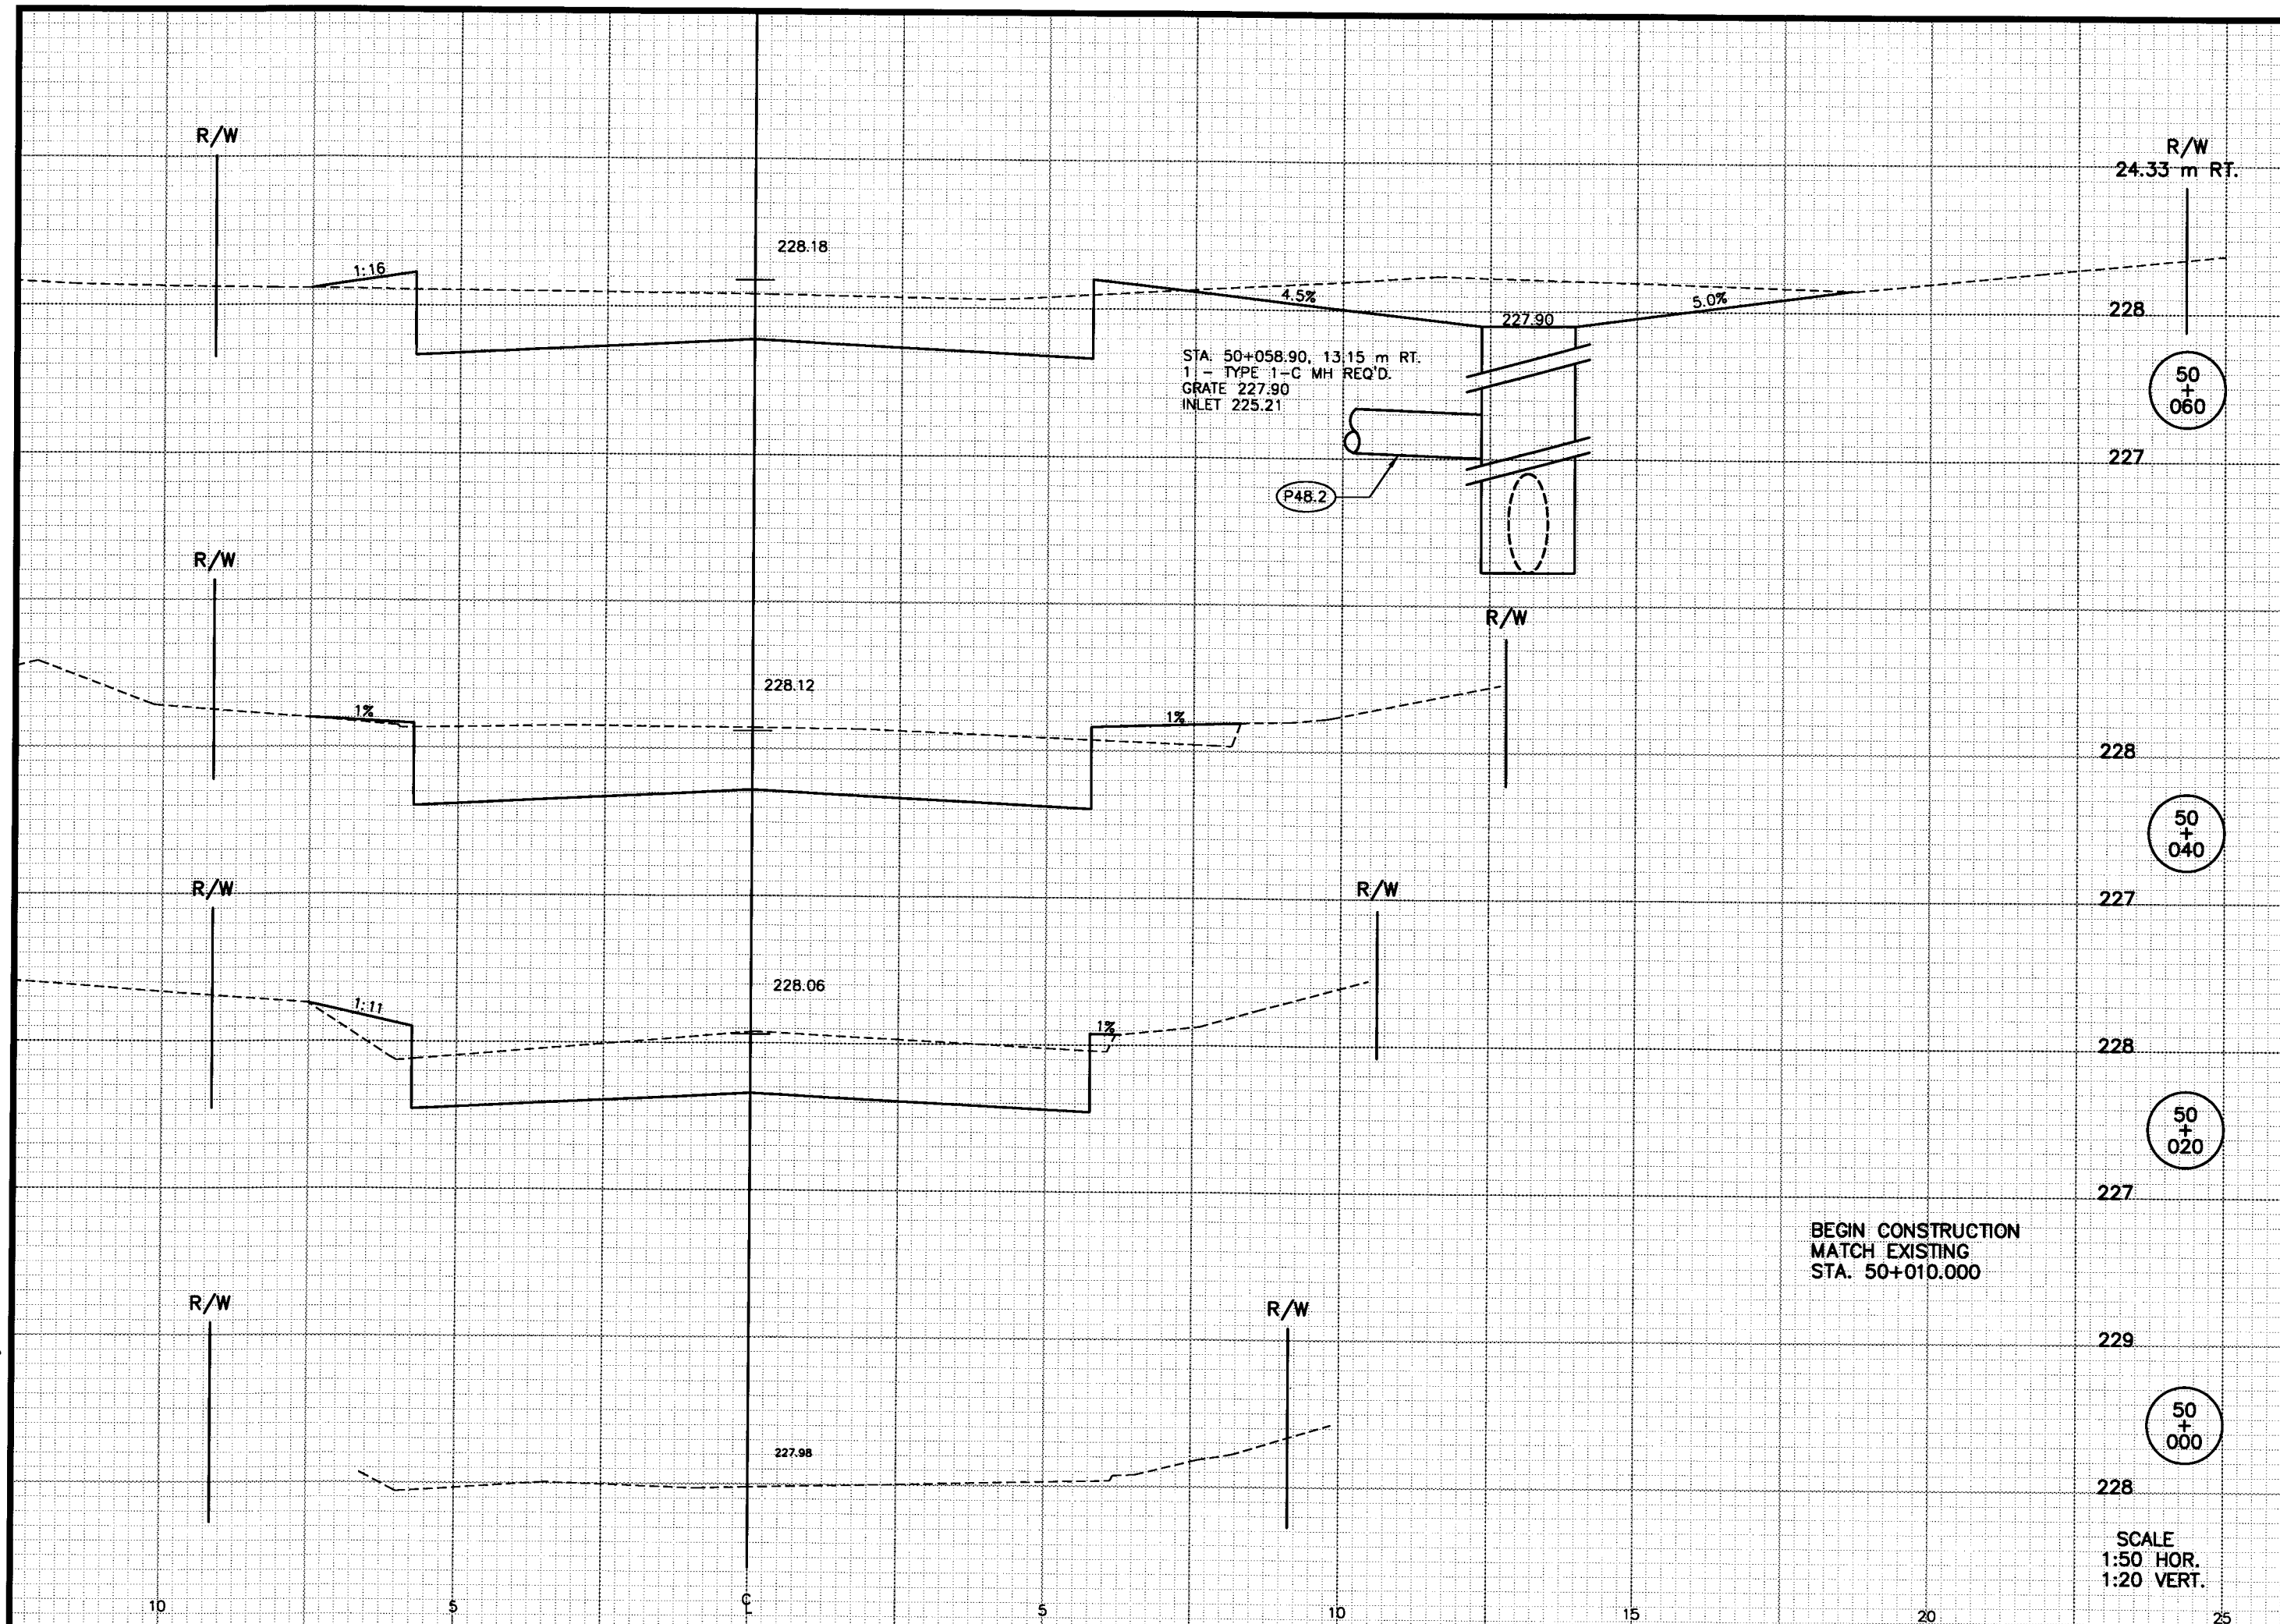

Drawing File : X550080

BRW CADD Sheet - MSECTION

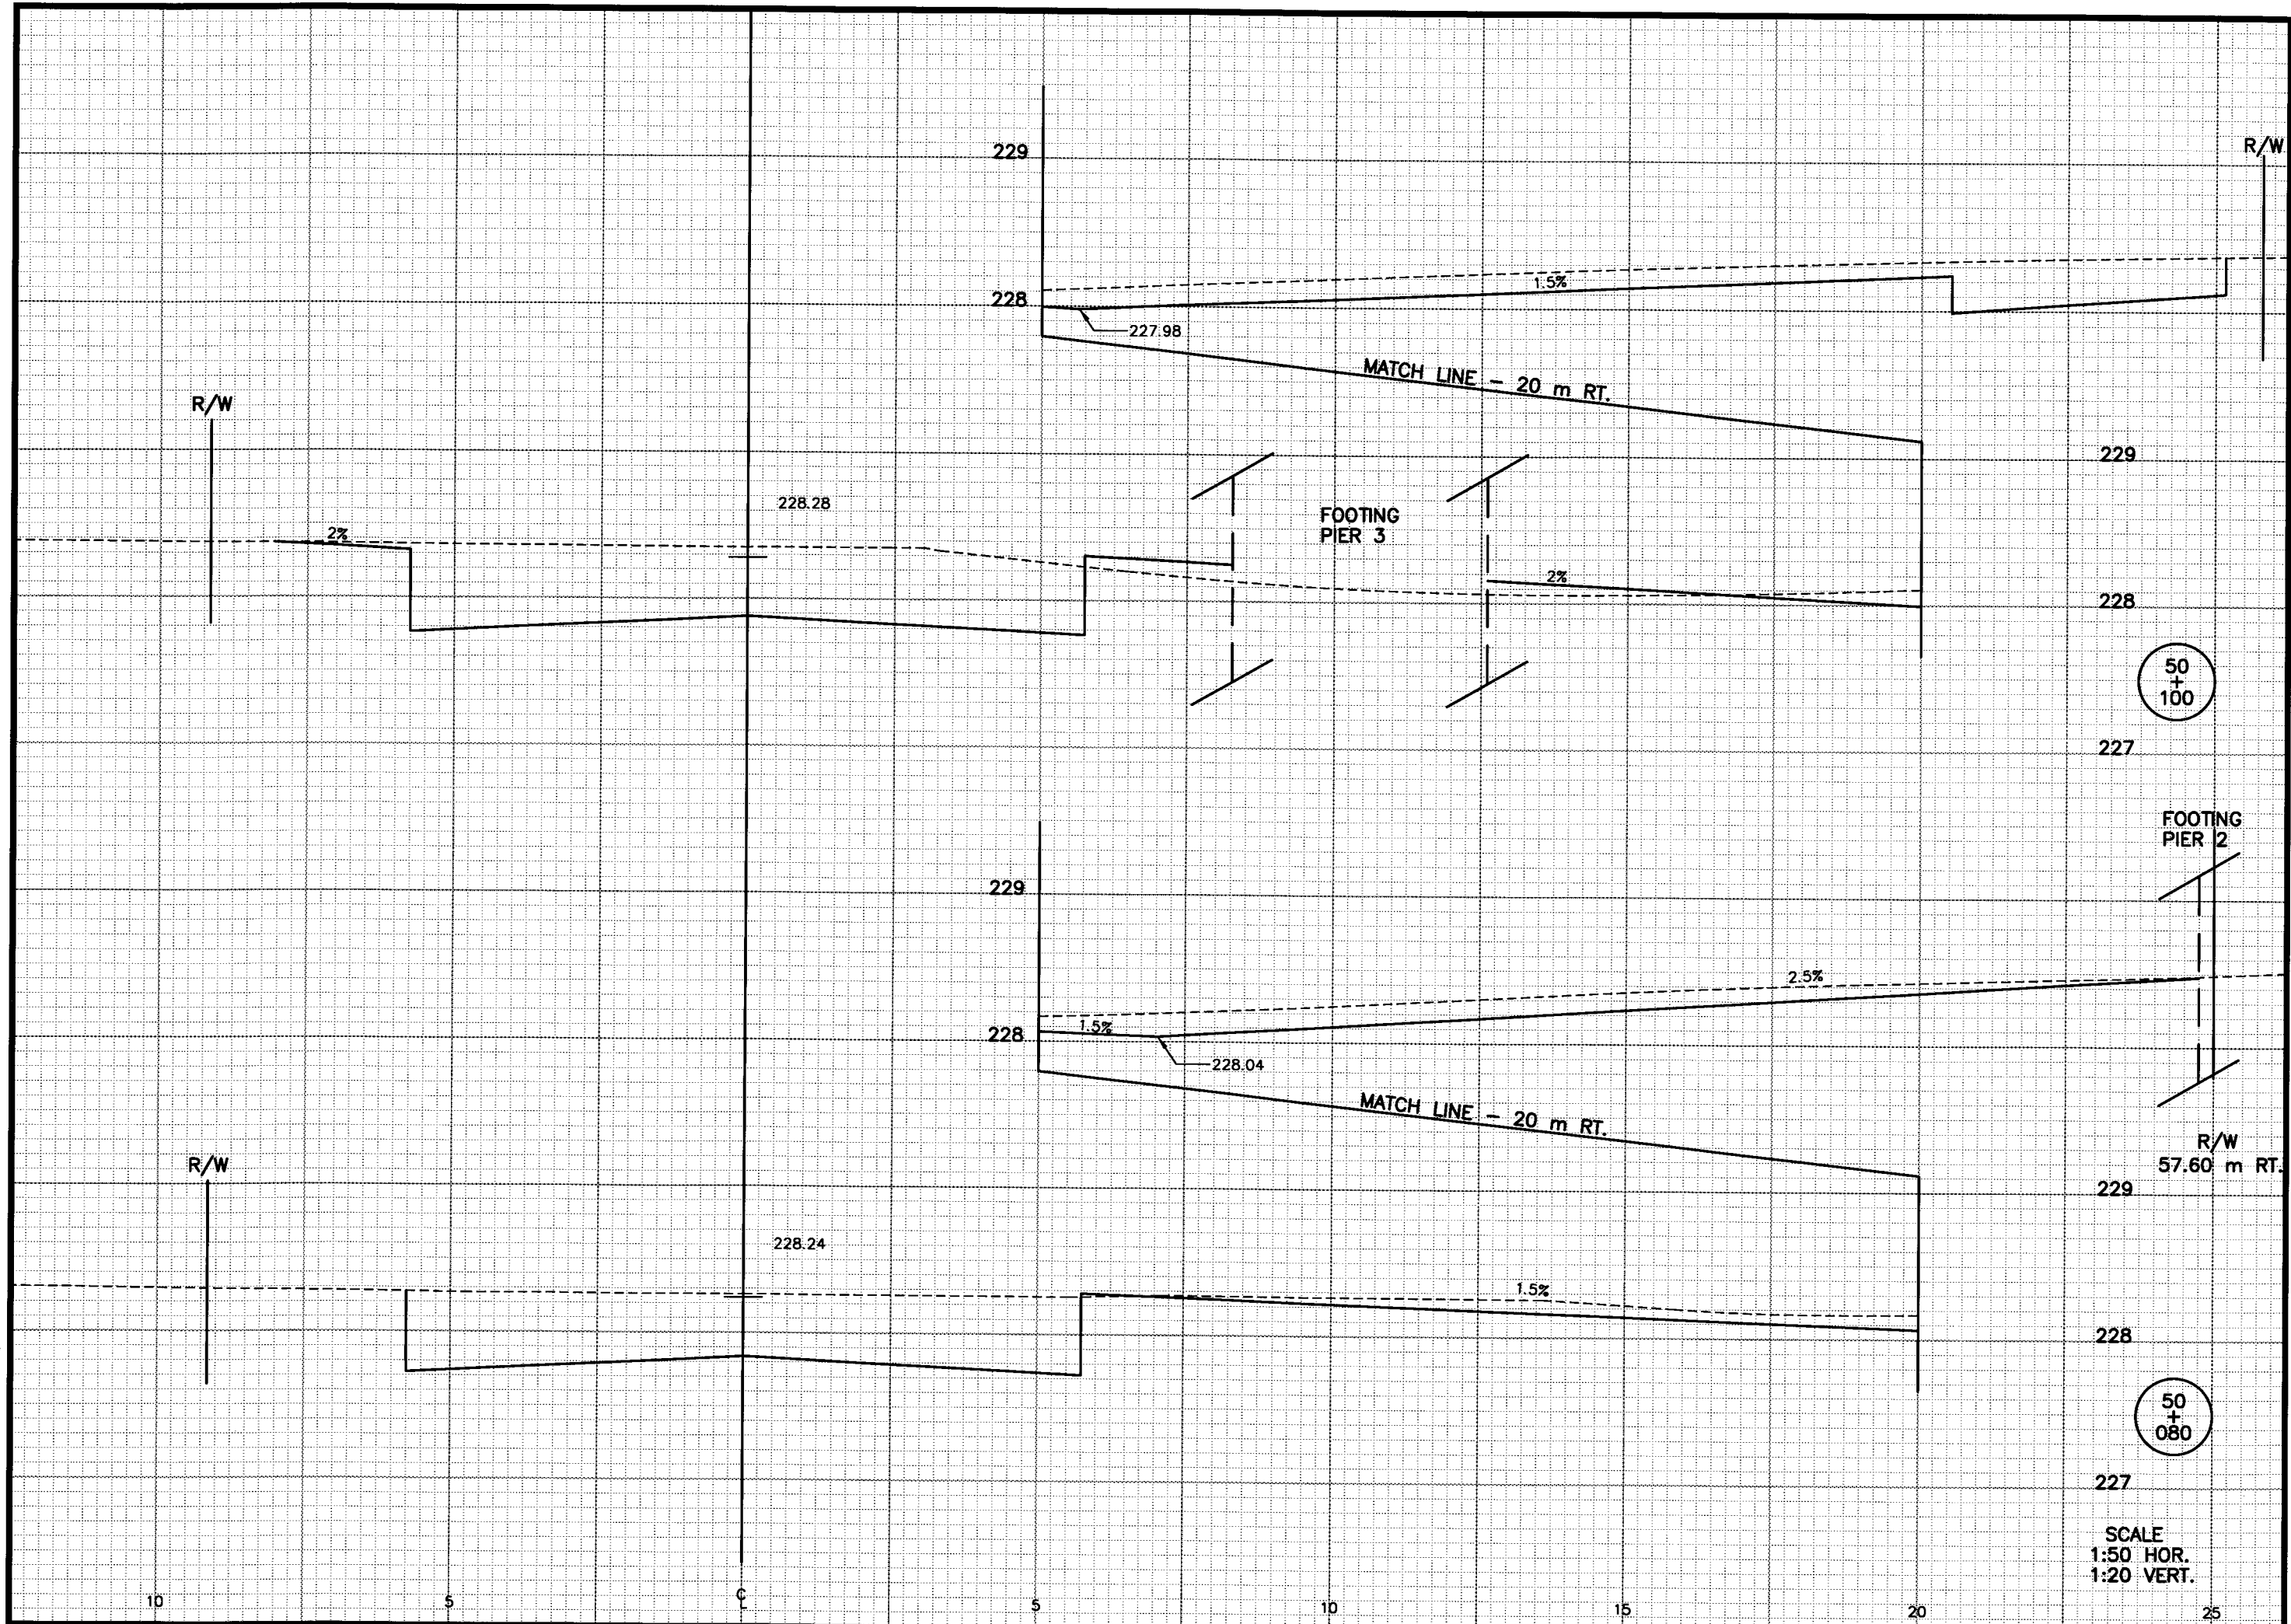

CROSS SECTIONS - SATTERLEE ST. STA. 50+080 - STA. 50+100


HWY: S.T.H. 23

COUNTY: FOND DU LAC

STATE PROJECT NO.: 1442-04-70


SHEET NO.: 9.53 M

BRW CUD Sheet - MSECTION
Drawing File : X550120

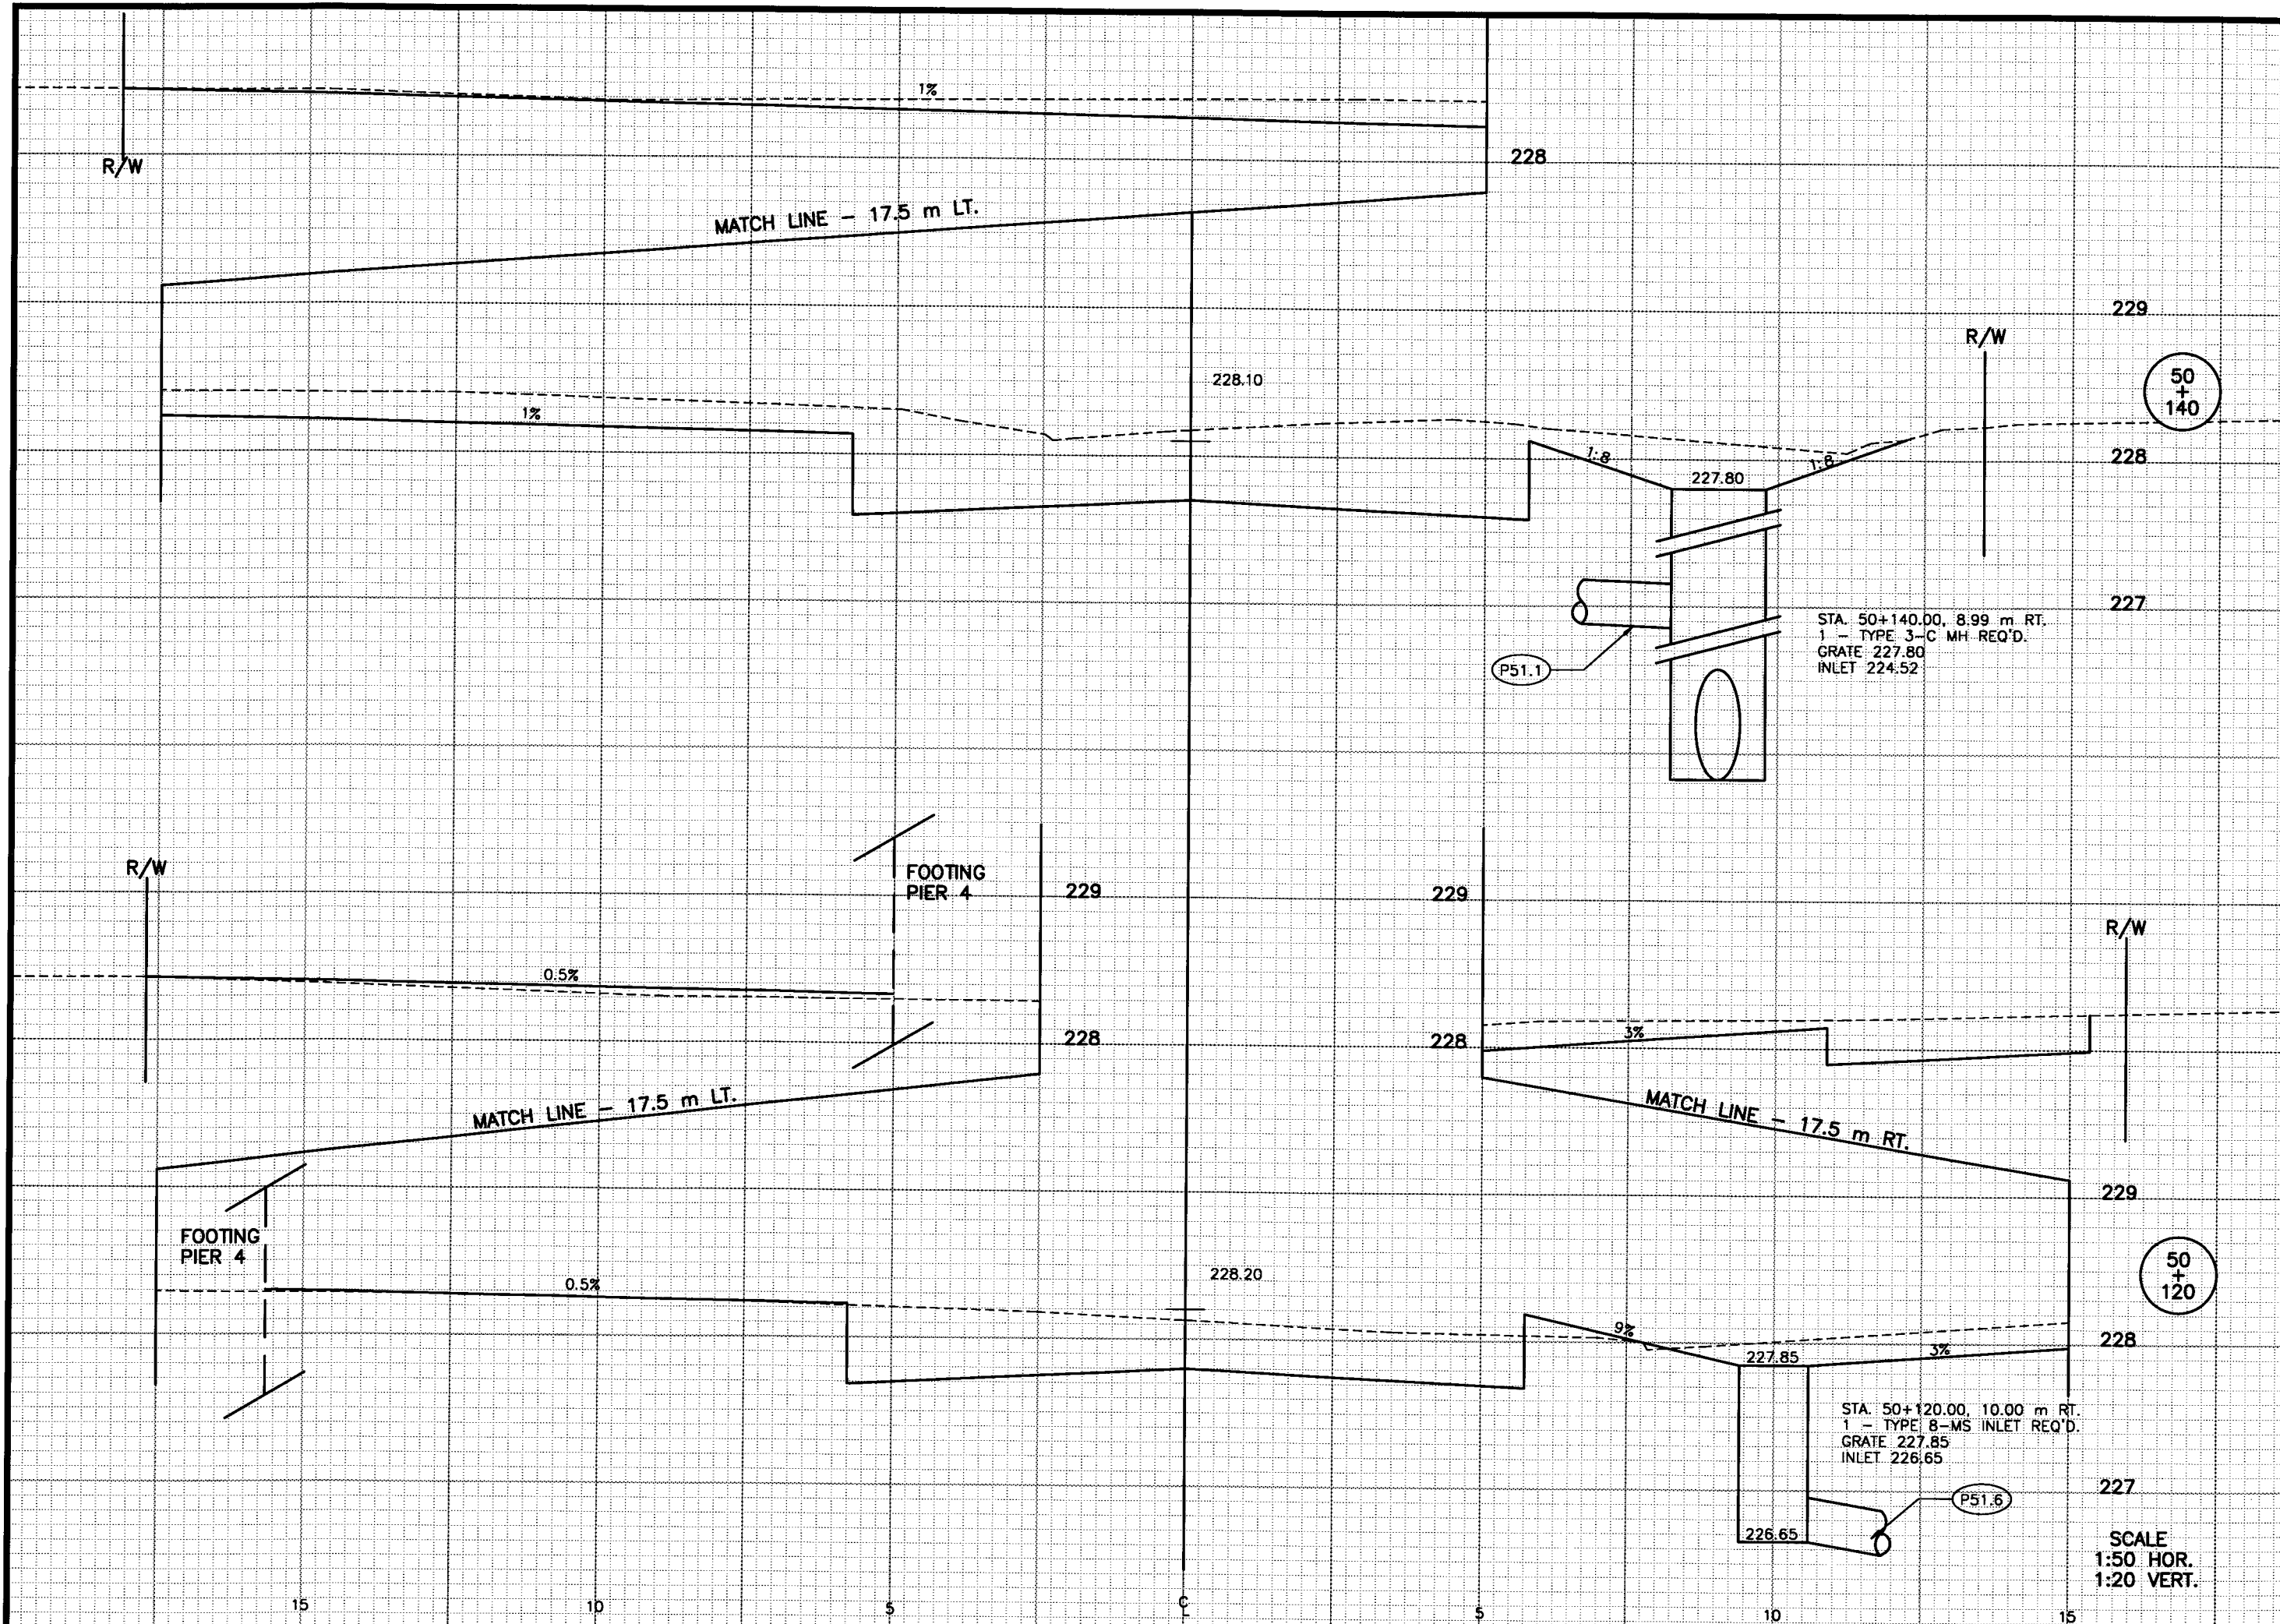


Drawing File : X550160

BRW CUD Sheet - MSECTION

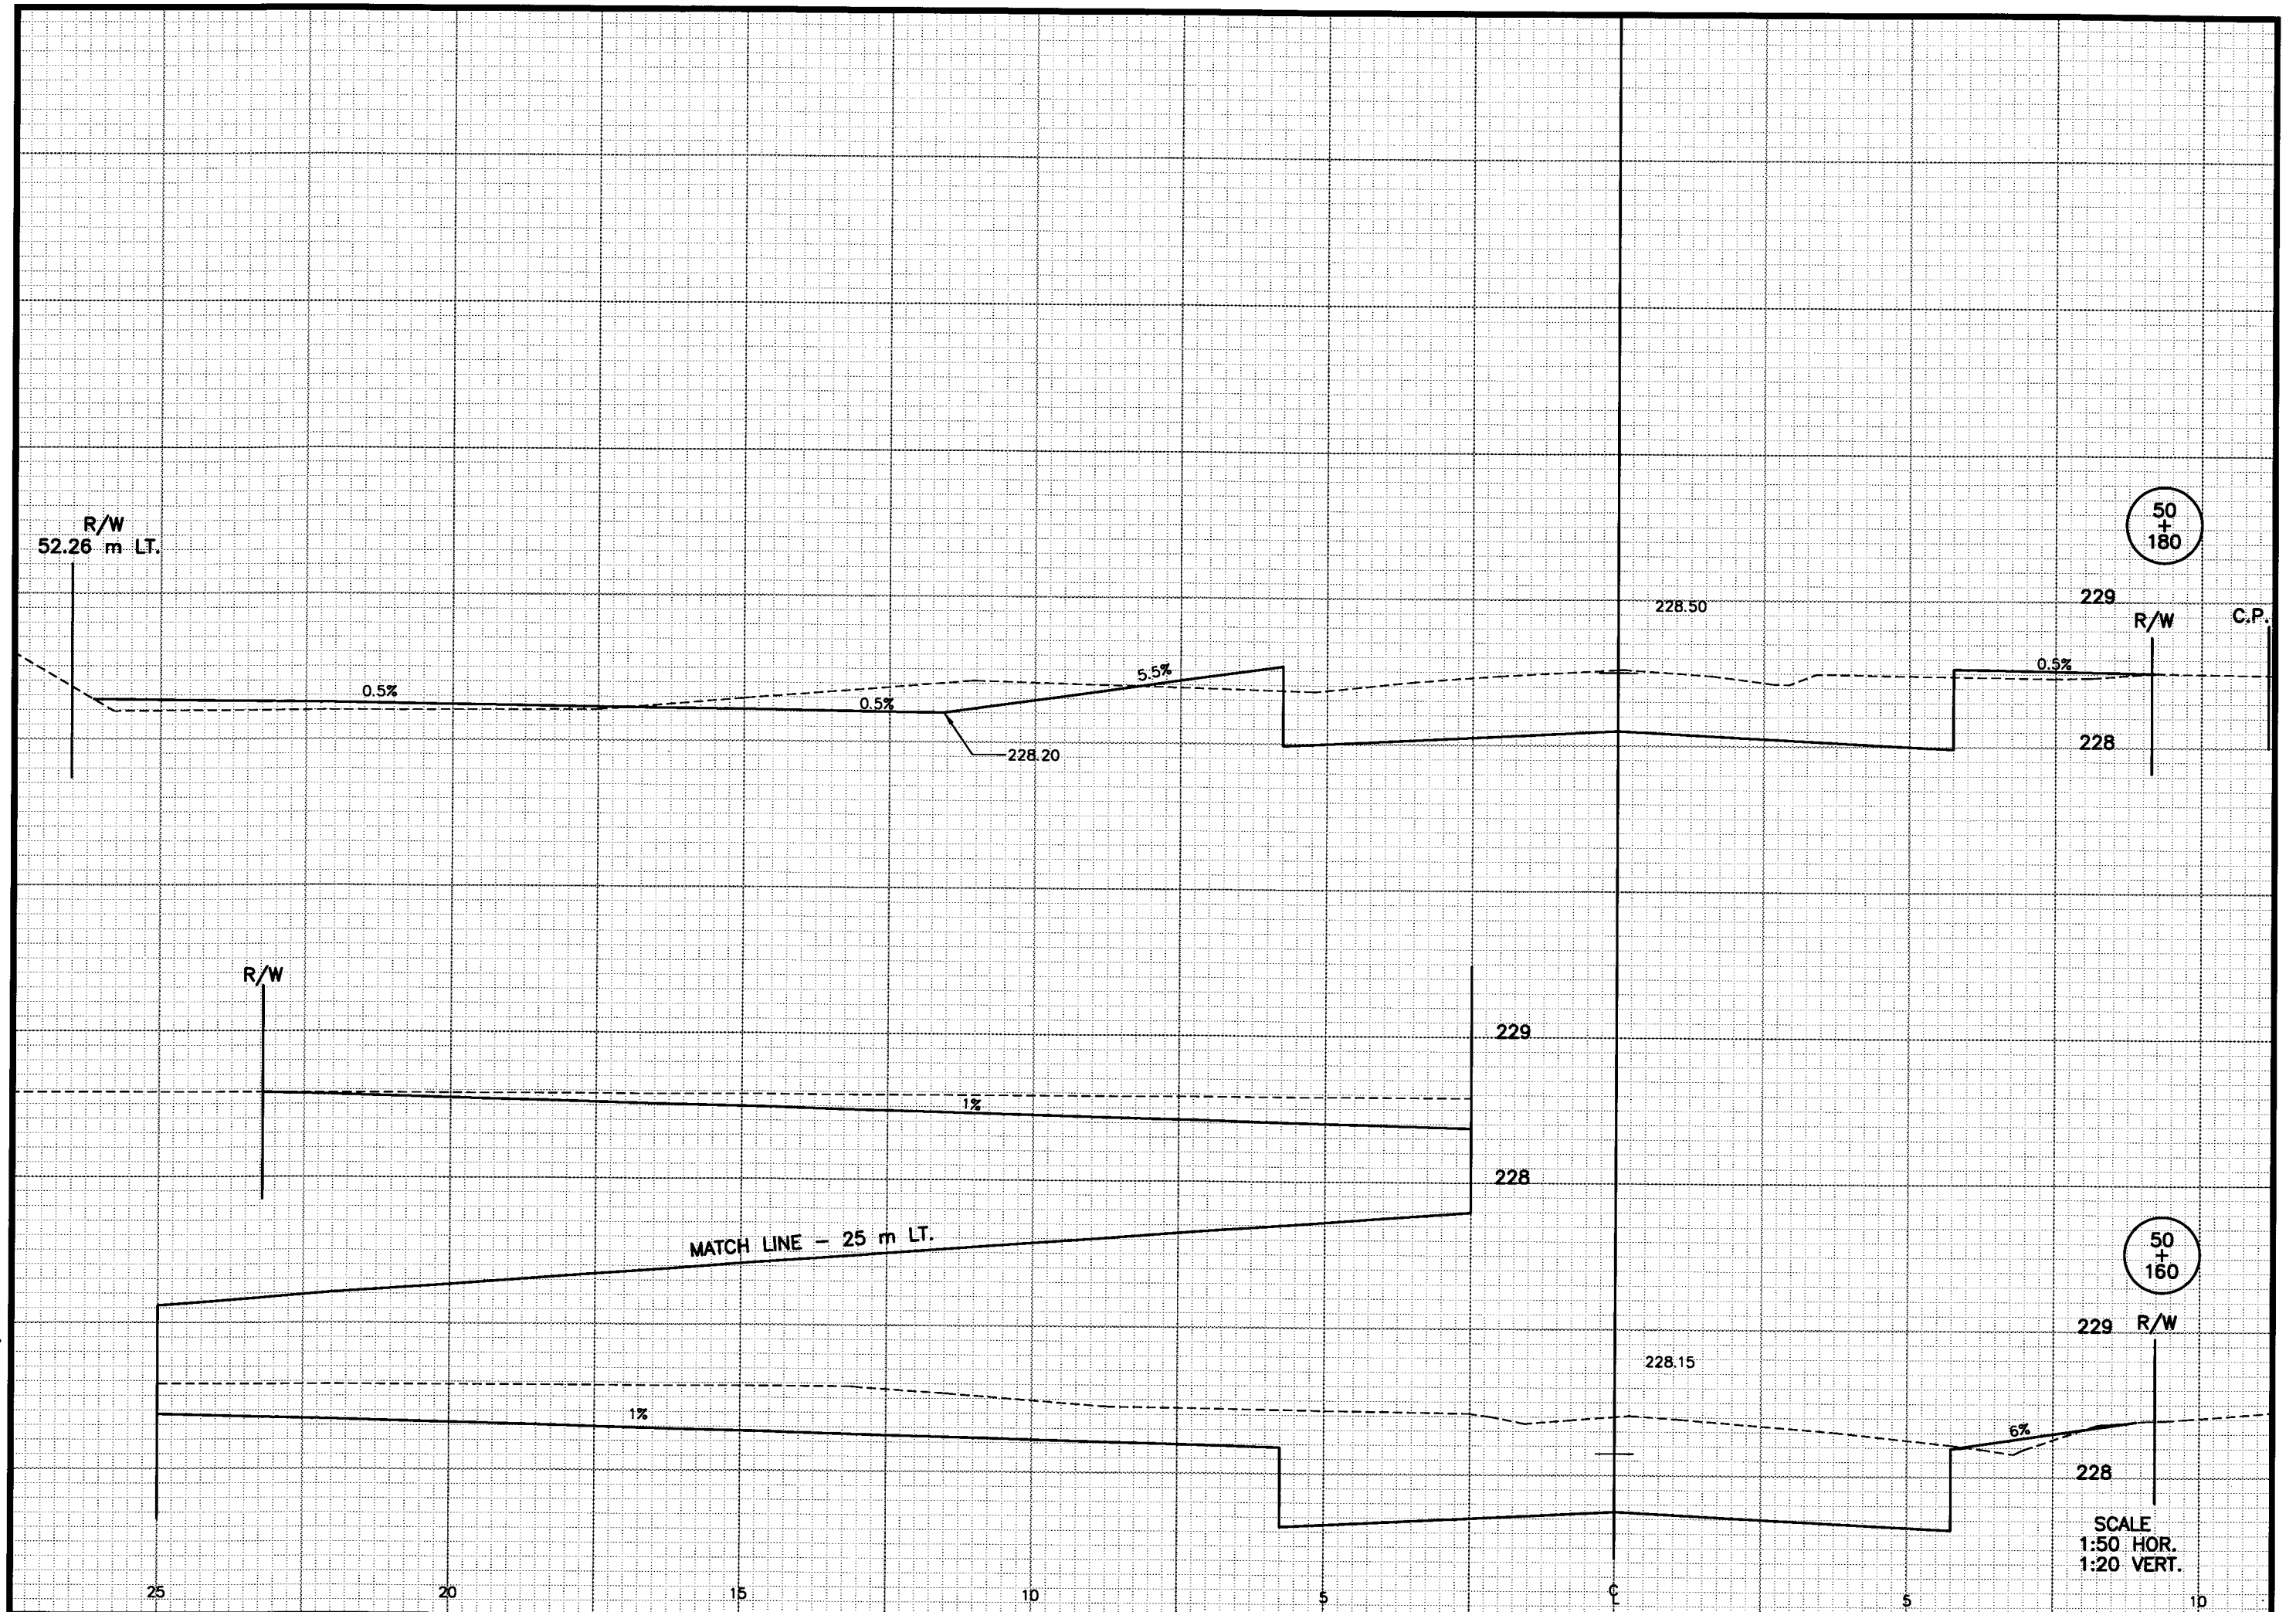

Drawing File : X550200

BRW CAD Sheet - MSECTION

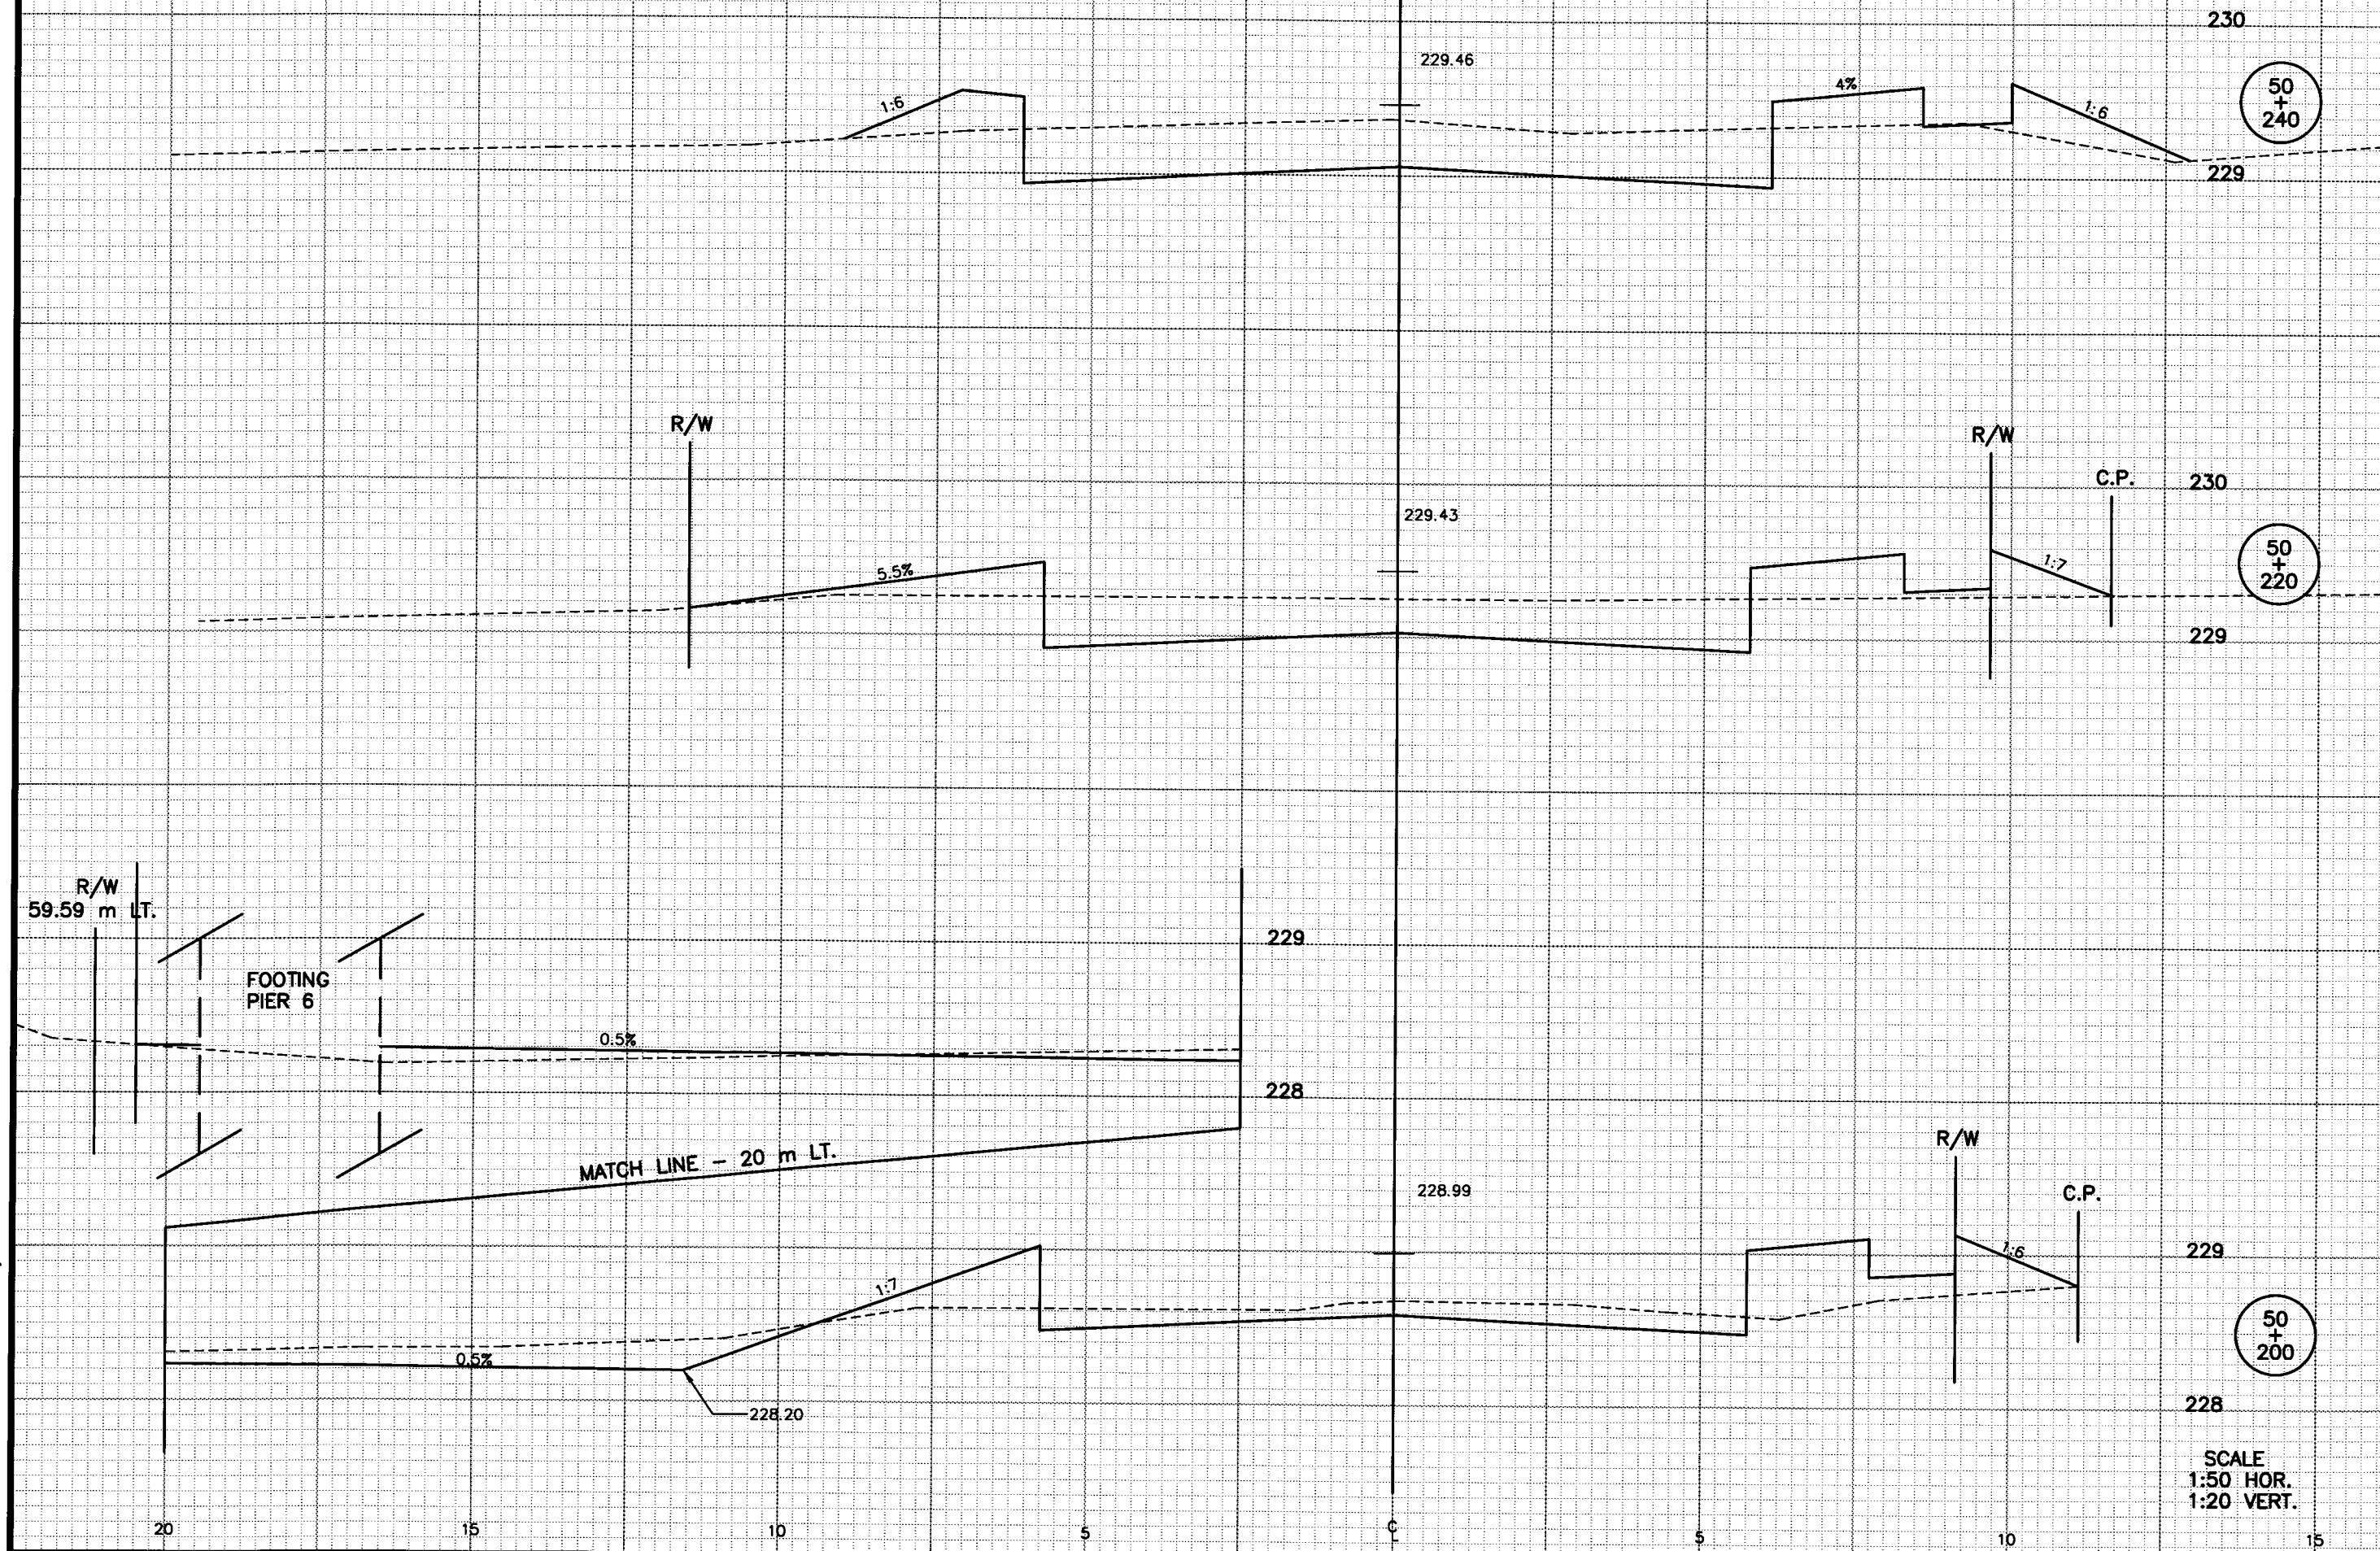

CROSS SECTIONS - SATTERLEE ST. STA. 50+200 - STA. 50+240

HWY: S.T.H. 23

COUNTY: FOND DU LAC


STATE PROJECT NO.: 1442-04-70

SHEET NO.: 9.56 M


SCALE
1:50 HOR.
1:20 VERT.


Drawing File : X550260

BRW C&G Sheet - MSECTION

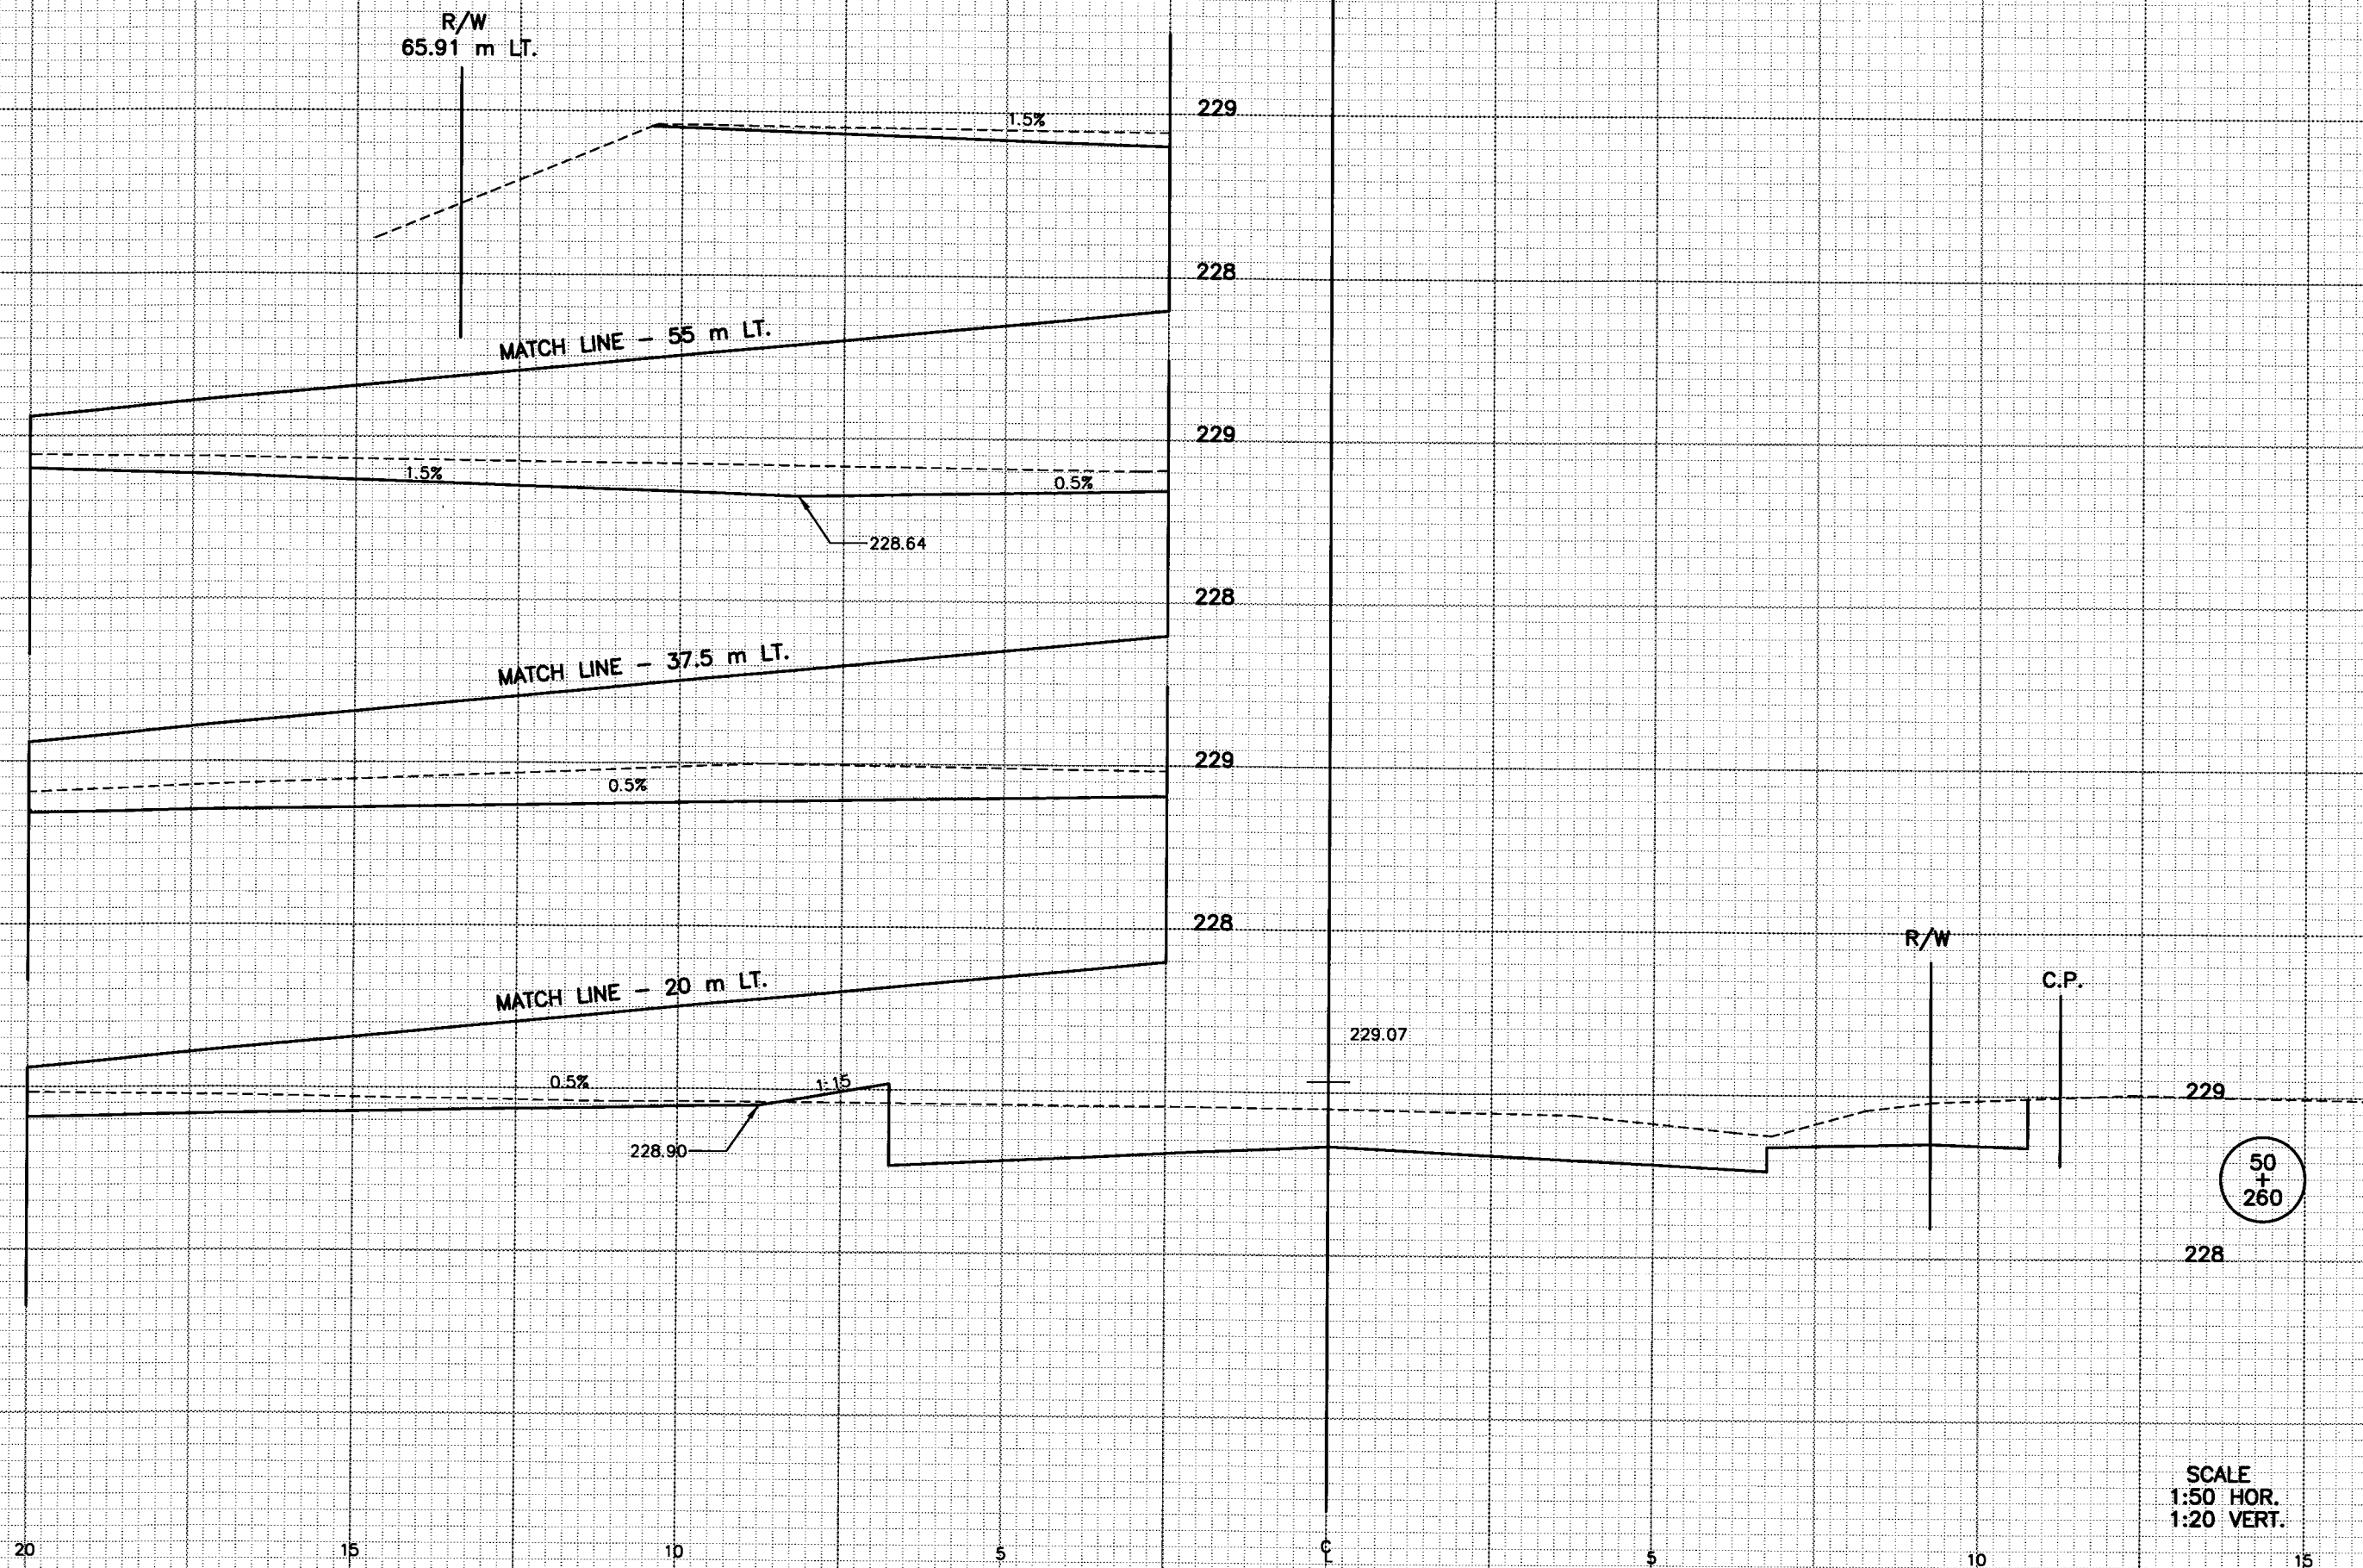


BRW CAD Sheet - MSECTION
Drawing File : XS50280

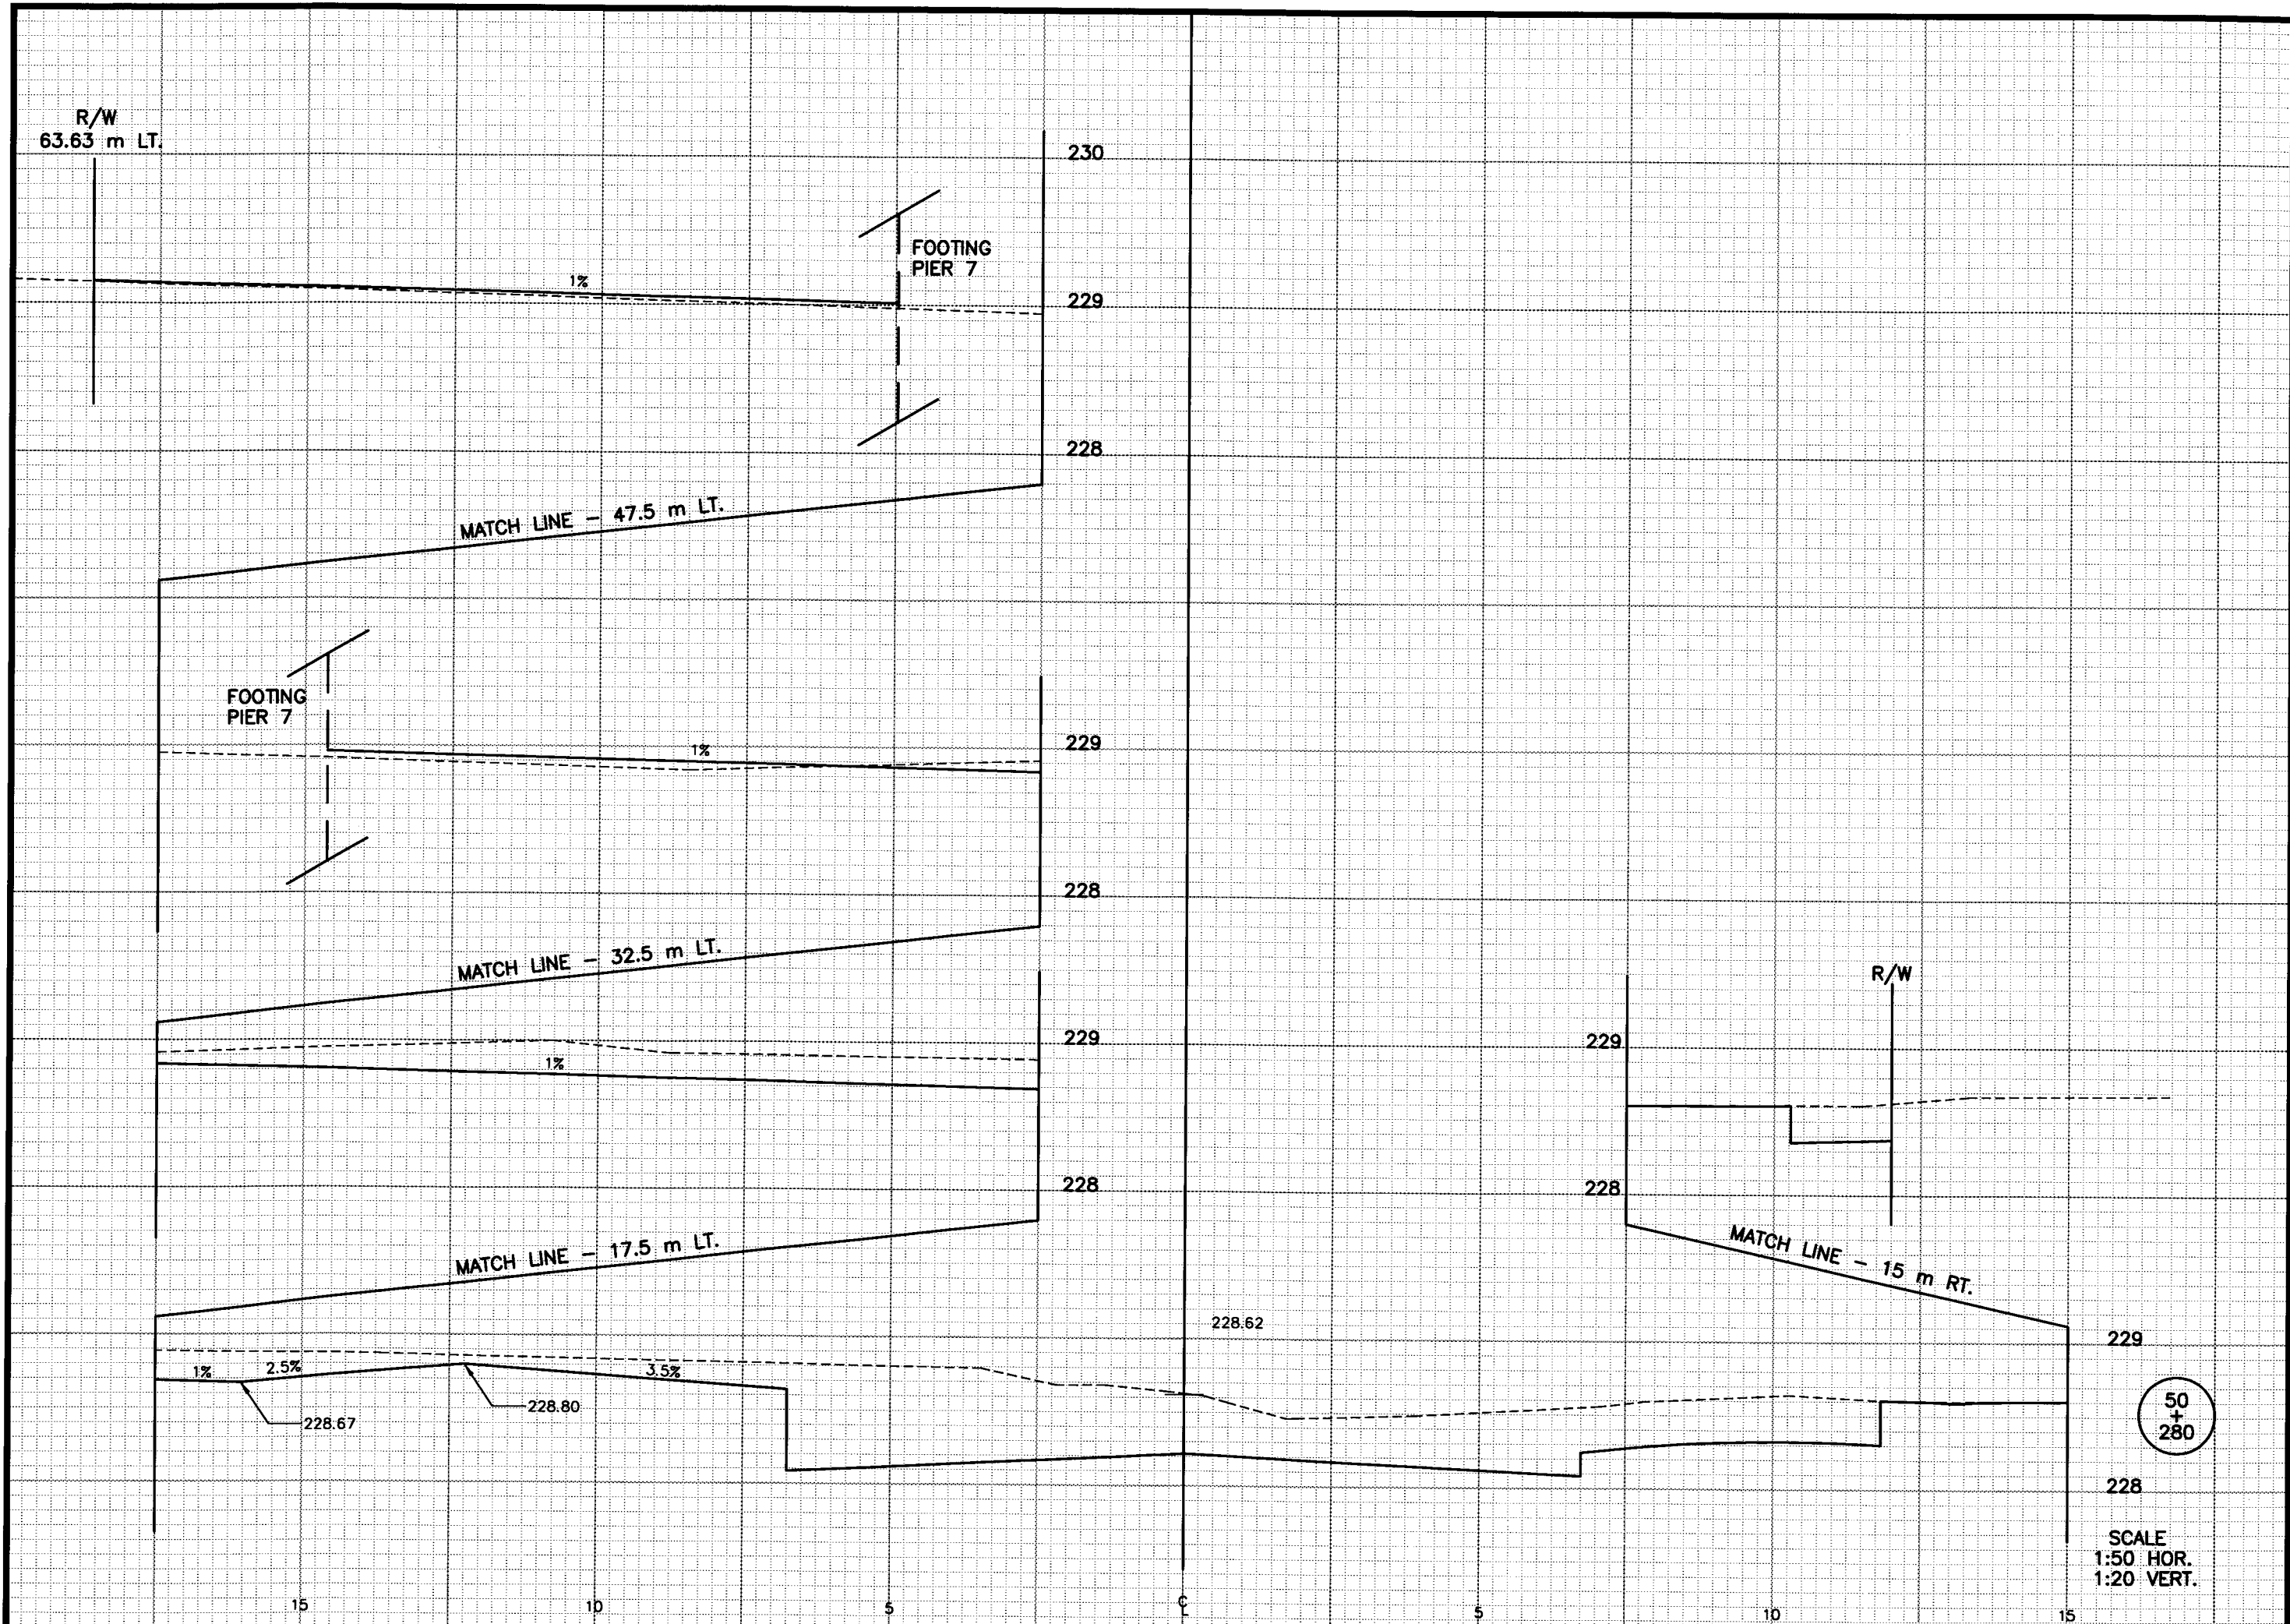

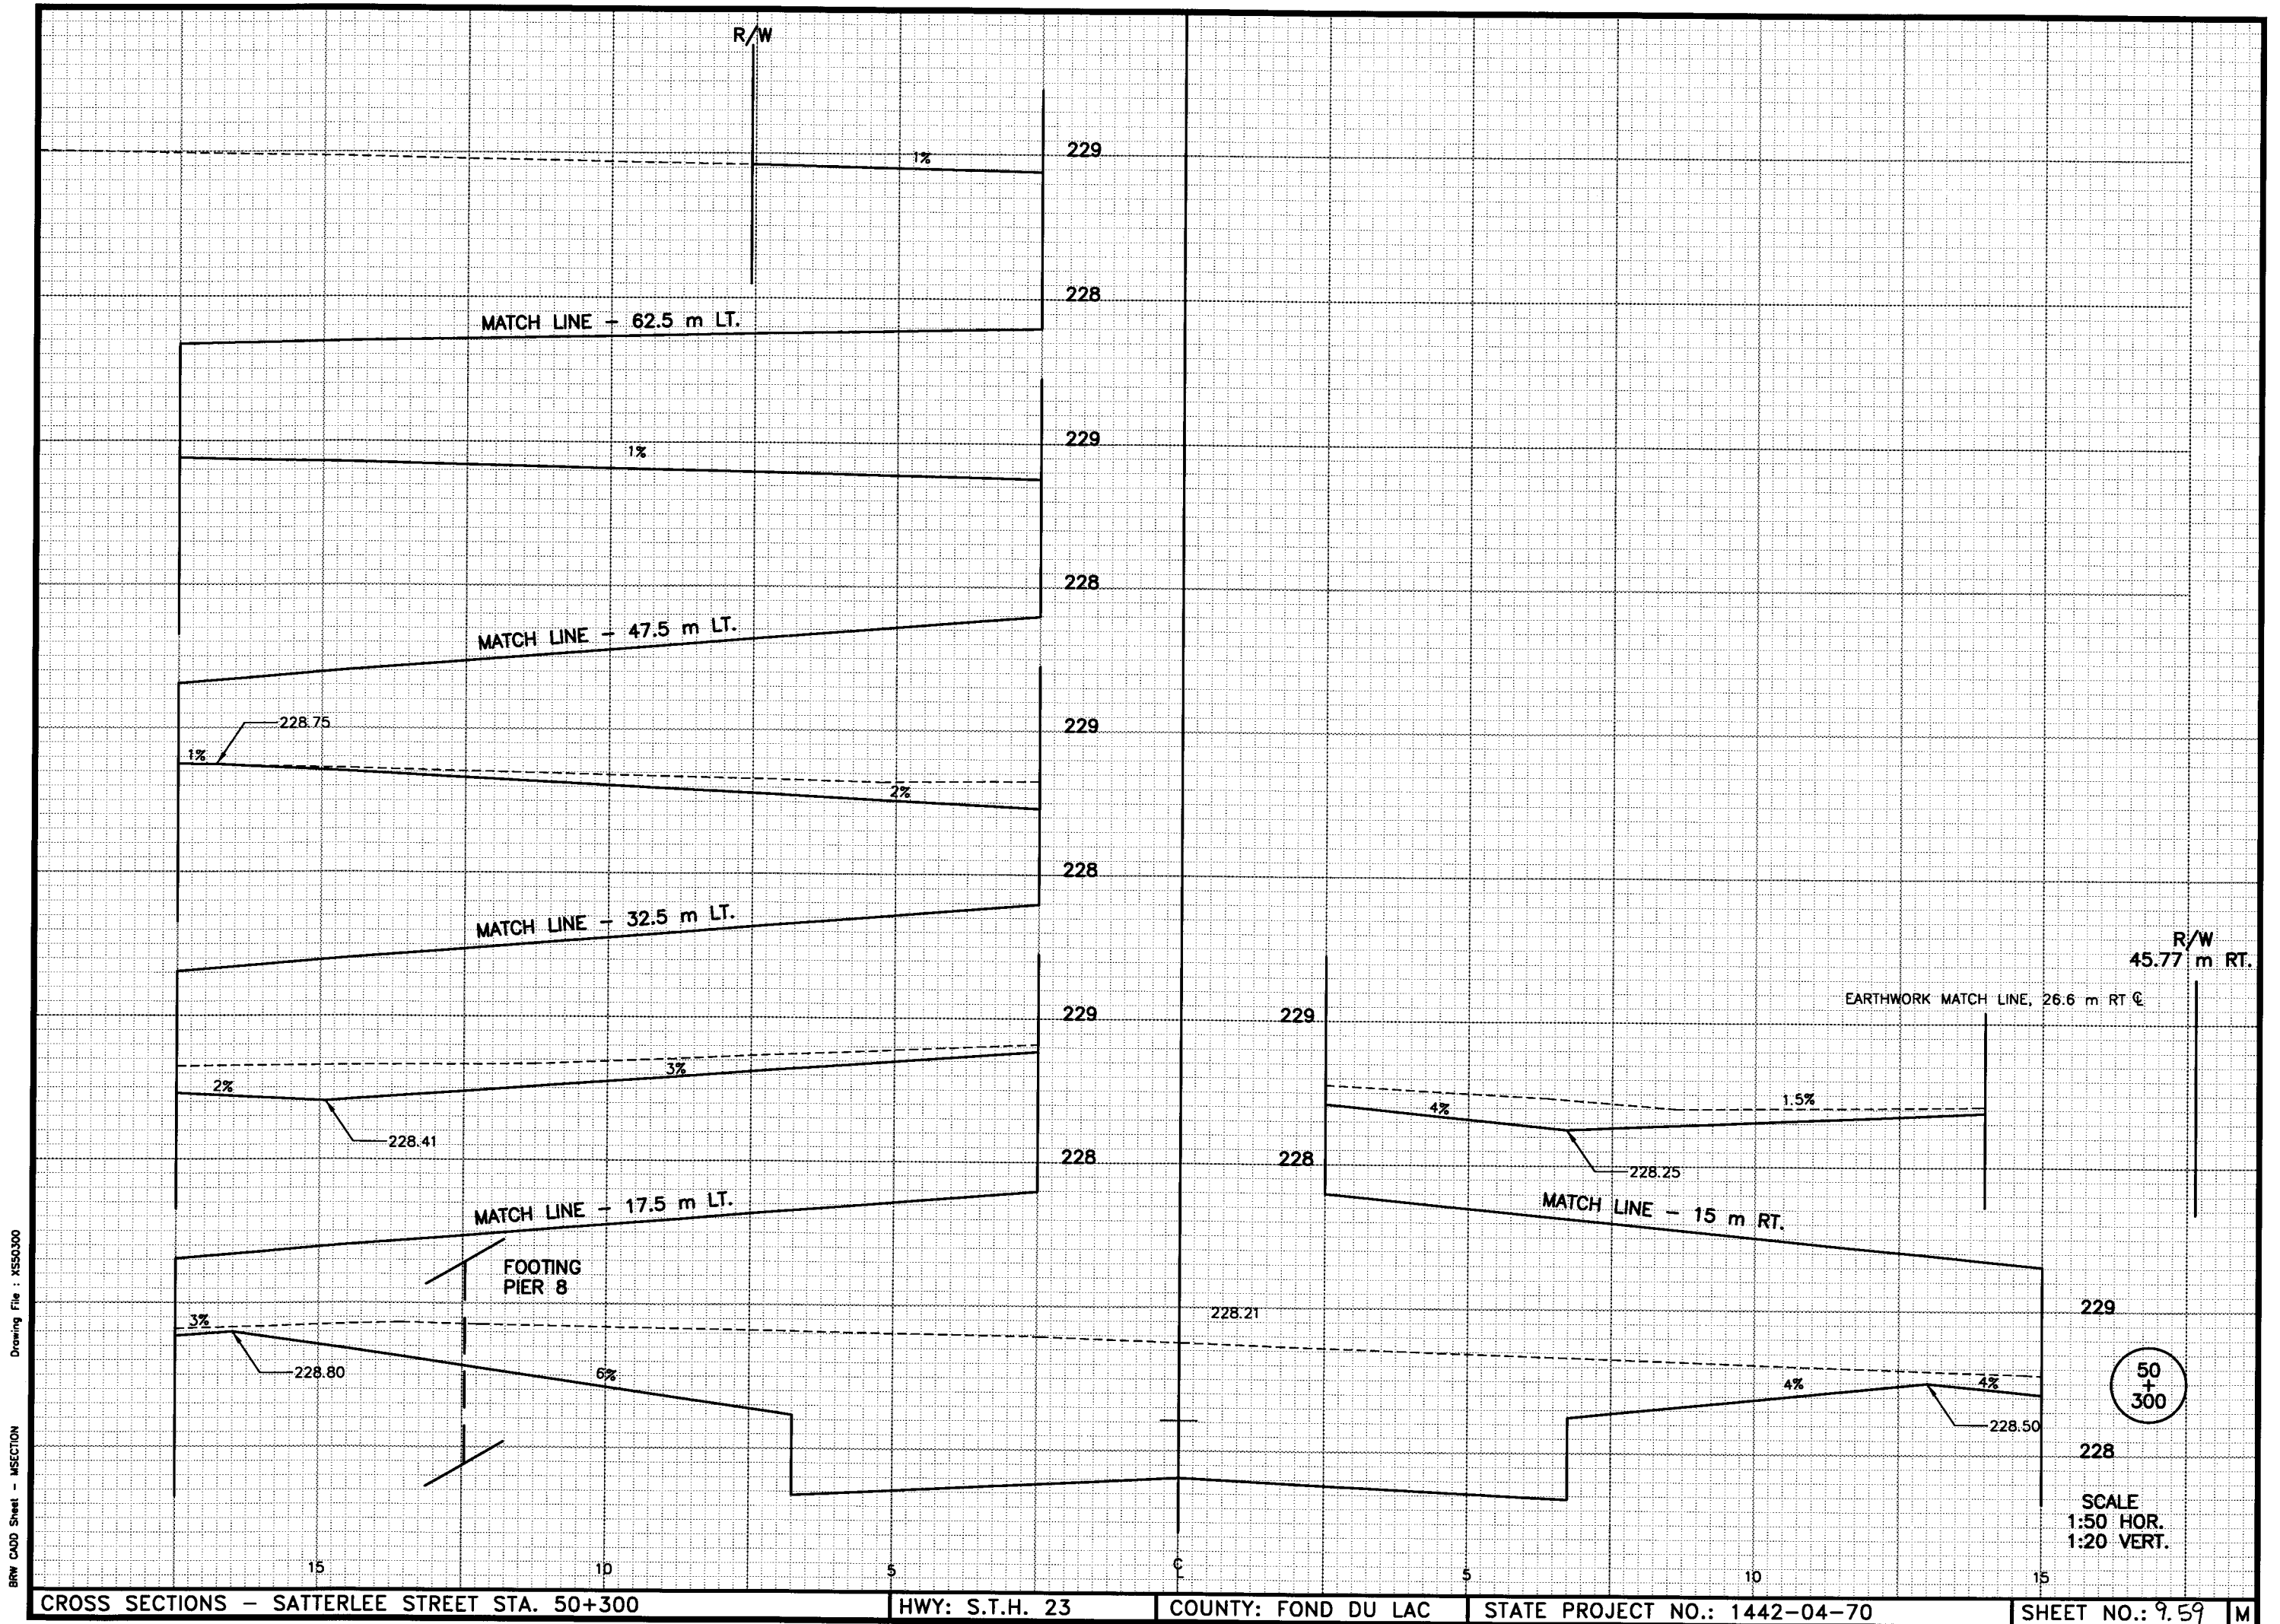


BRW CADD Sheet - MSECTION Drawing File : XS50320

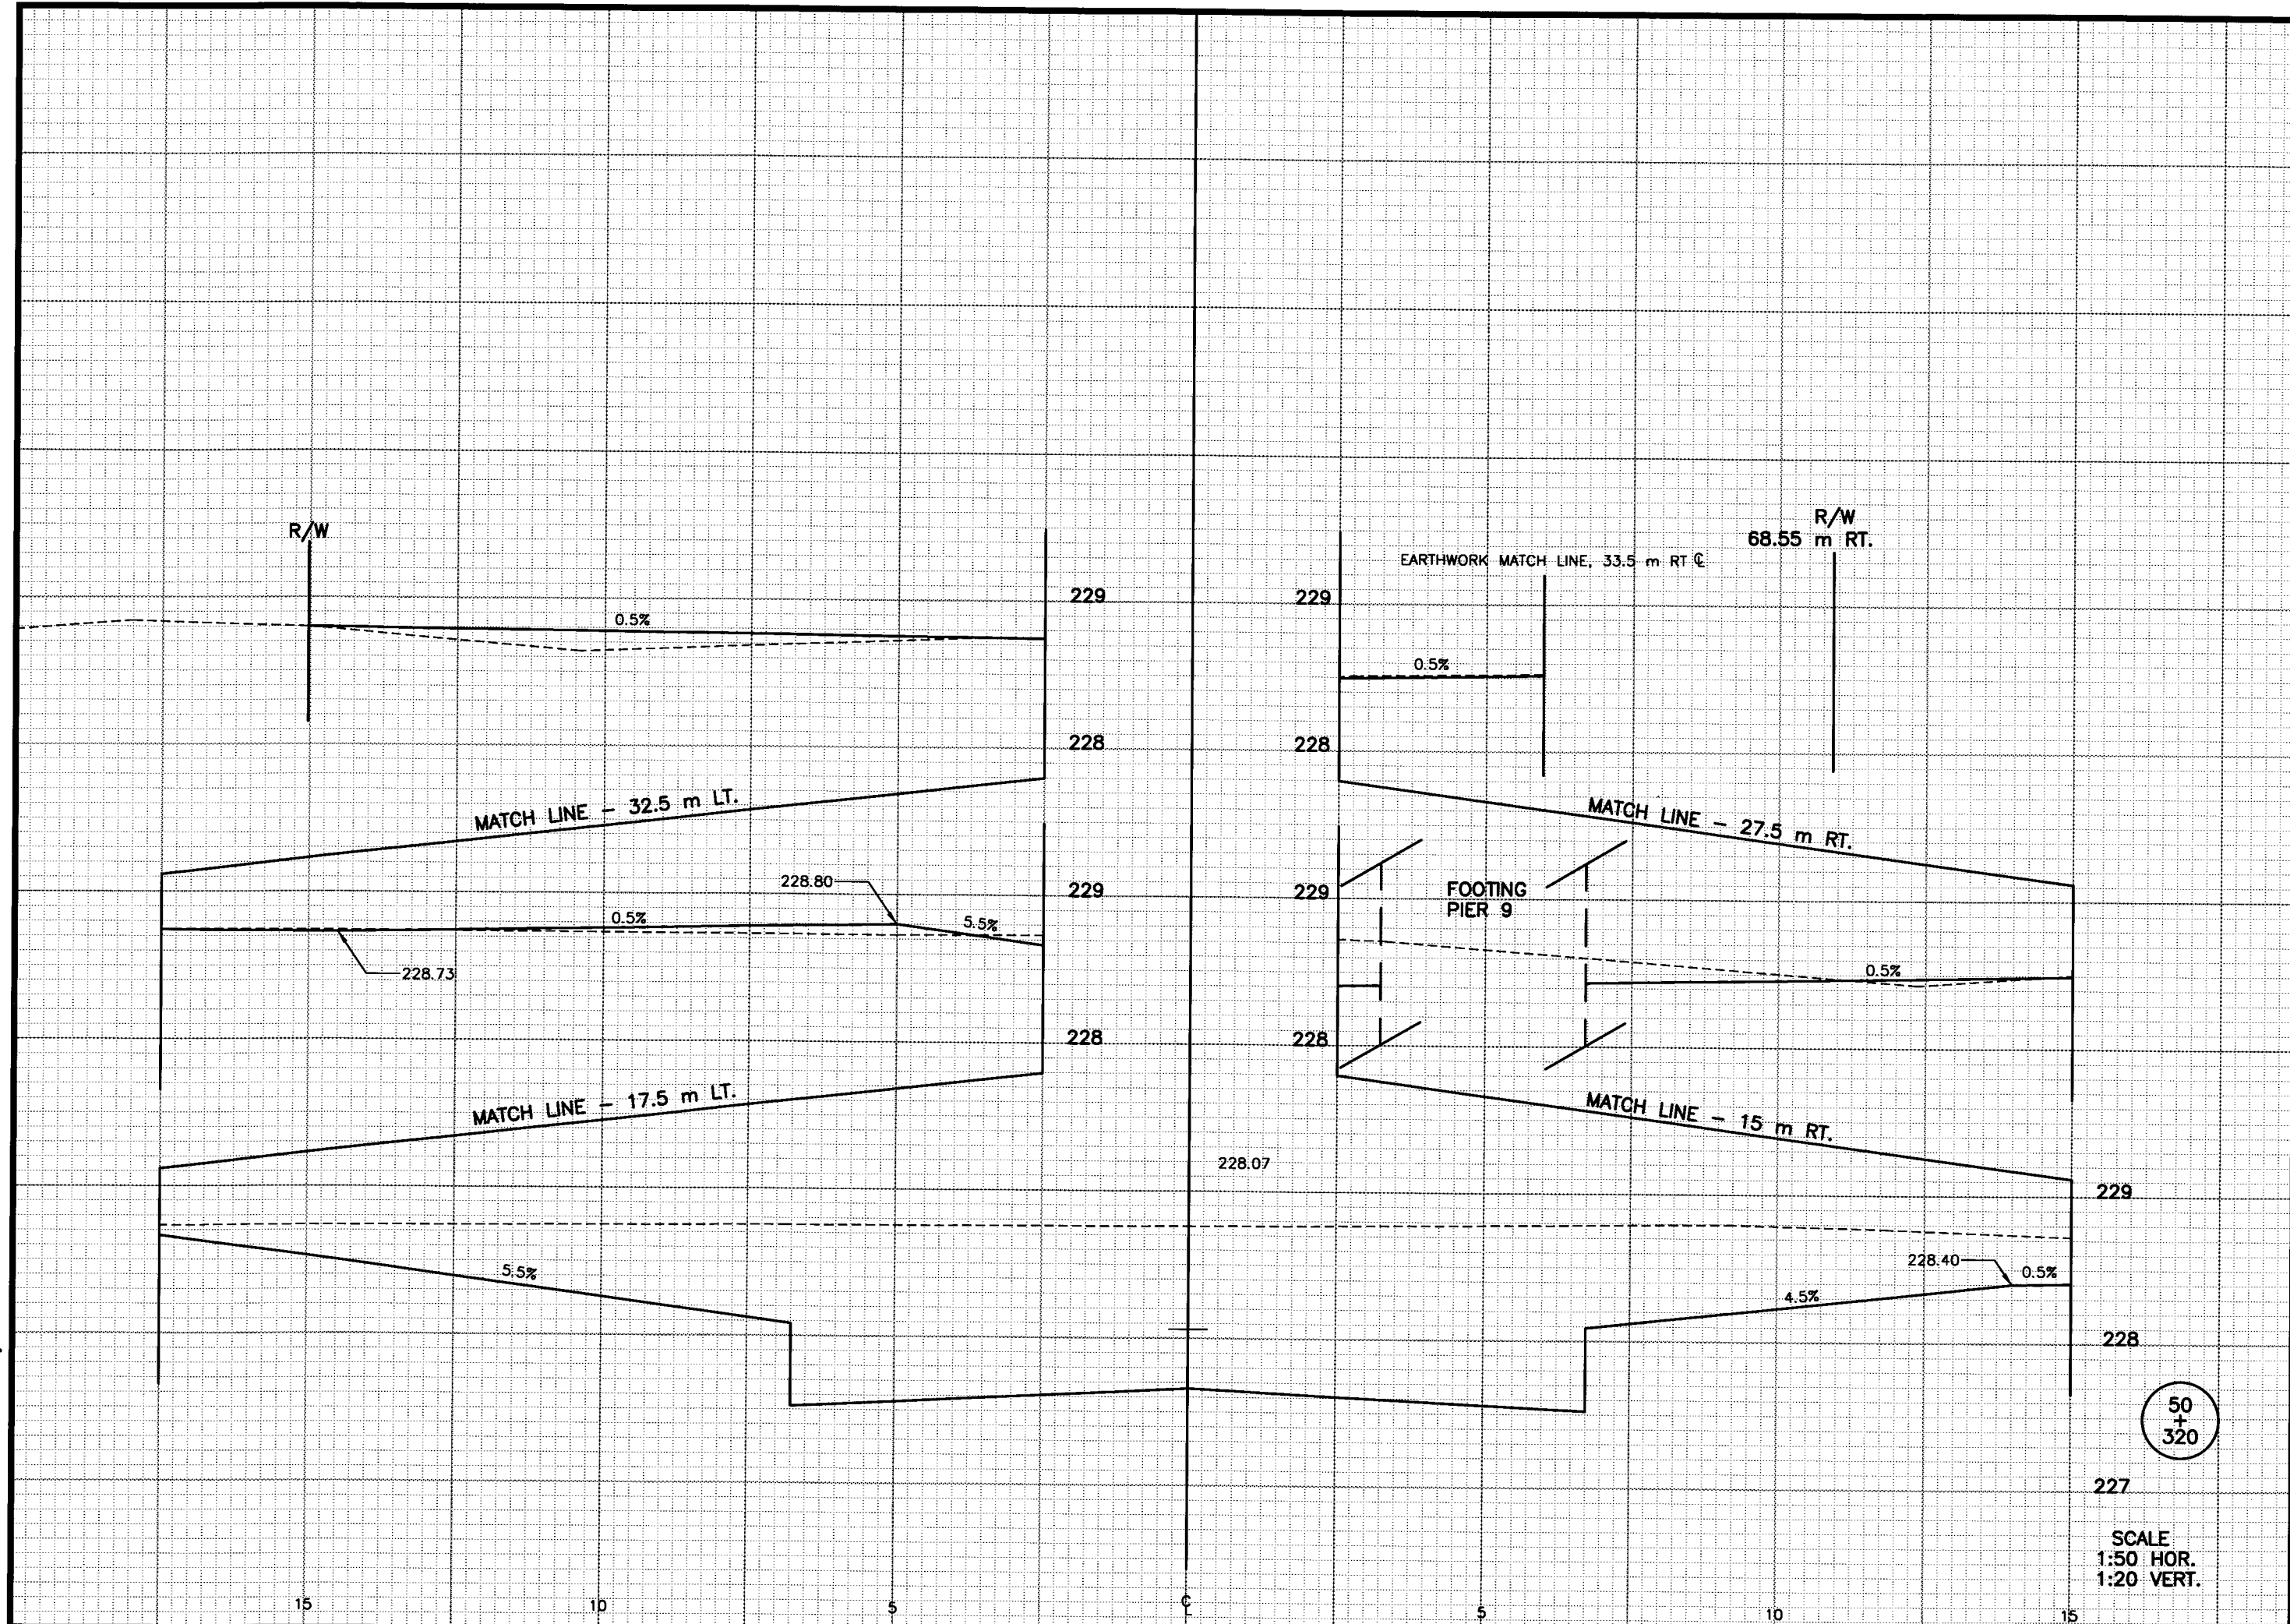


Drawing File : XS50340


BRW CADD Sheet - MSECTION

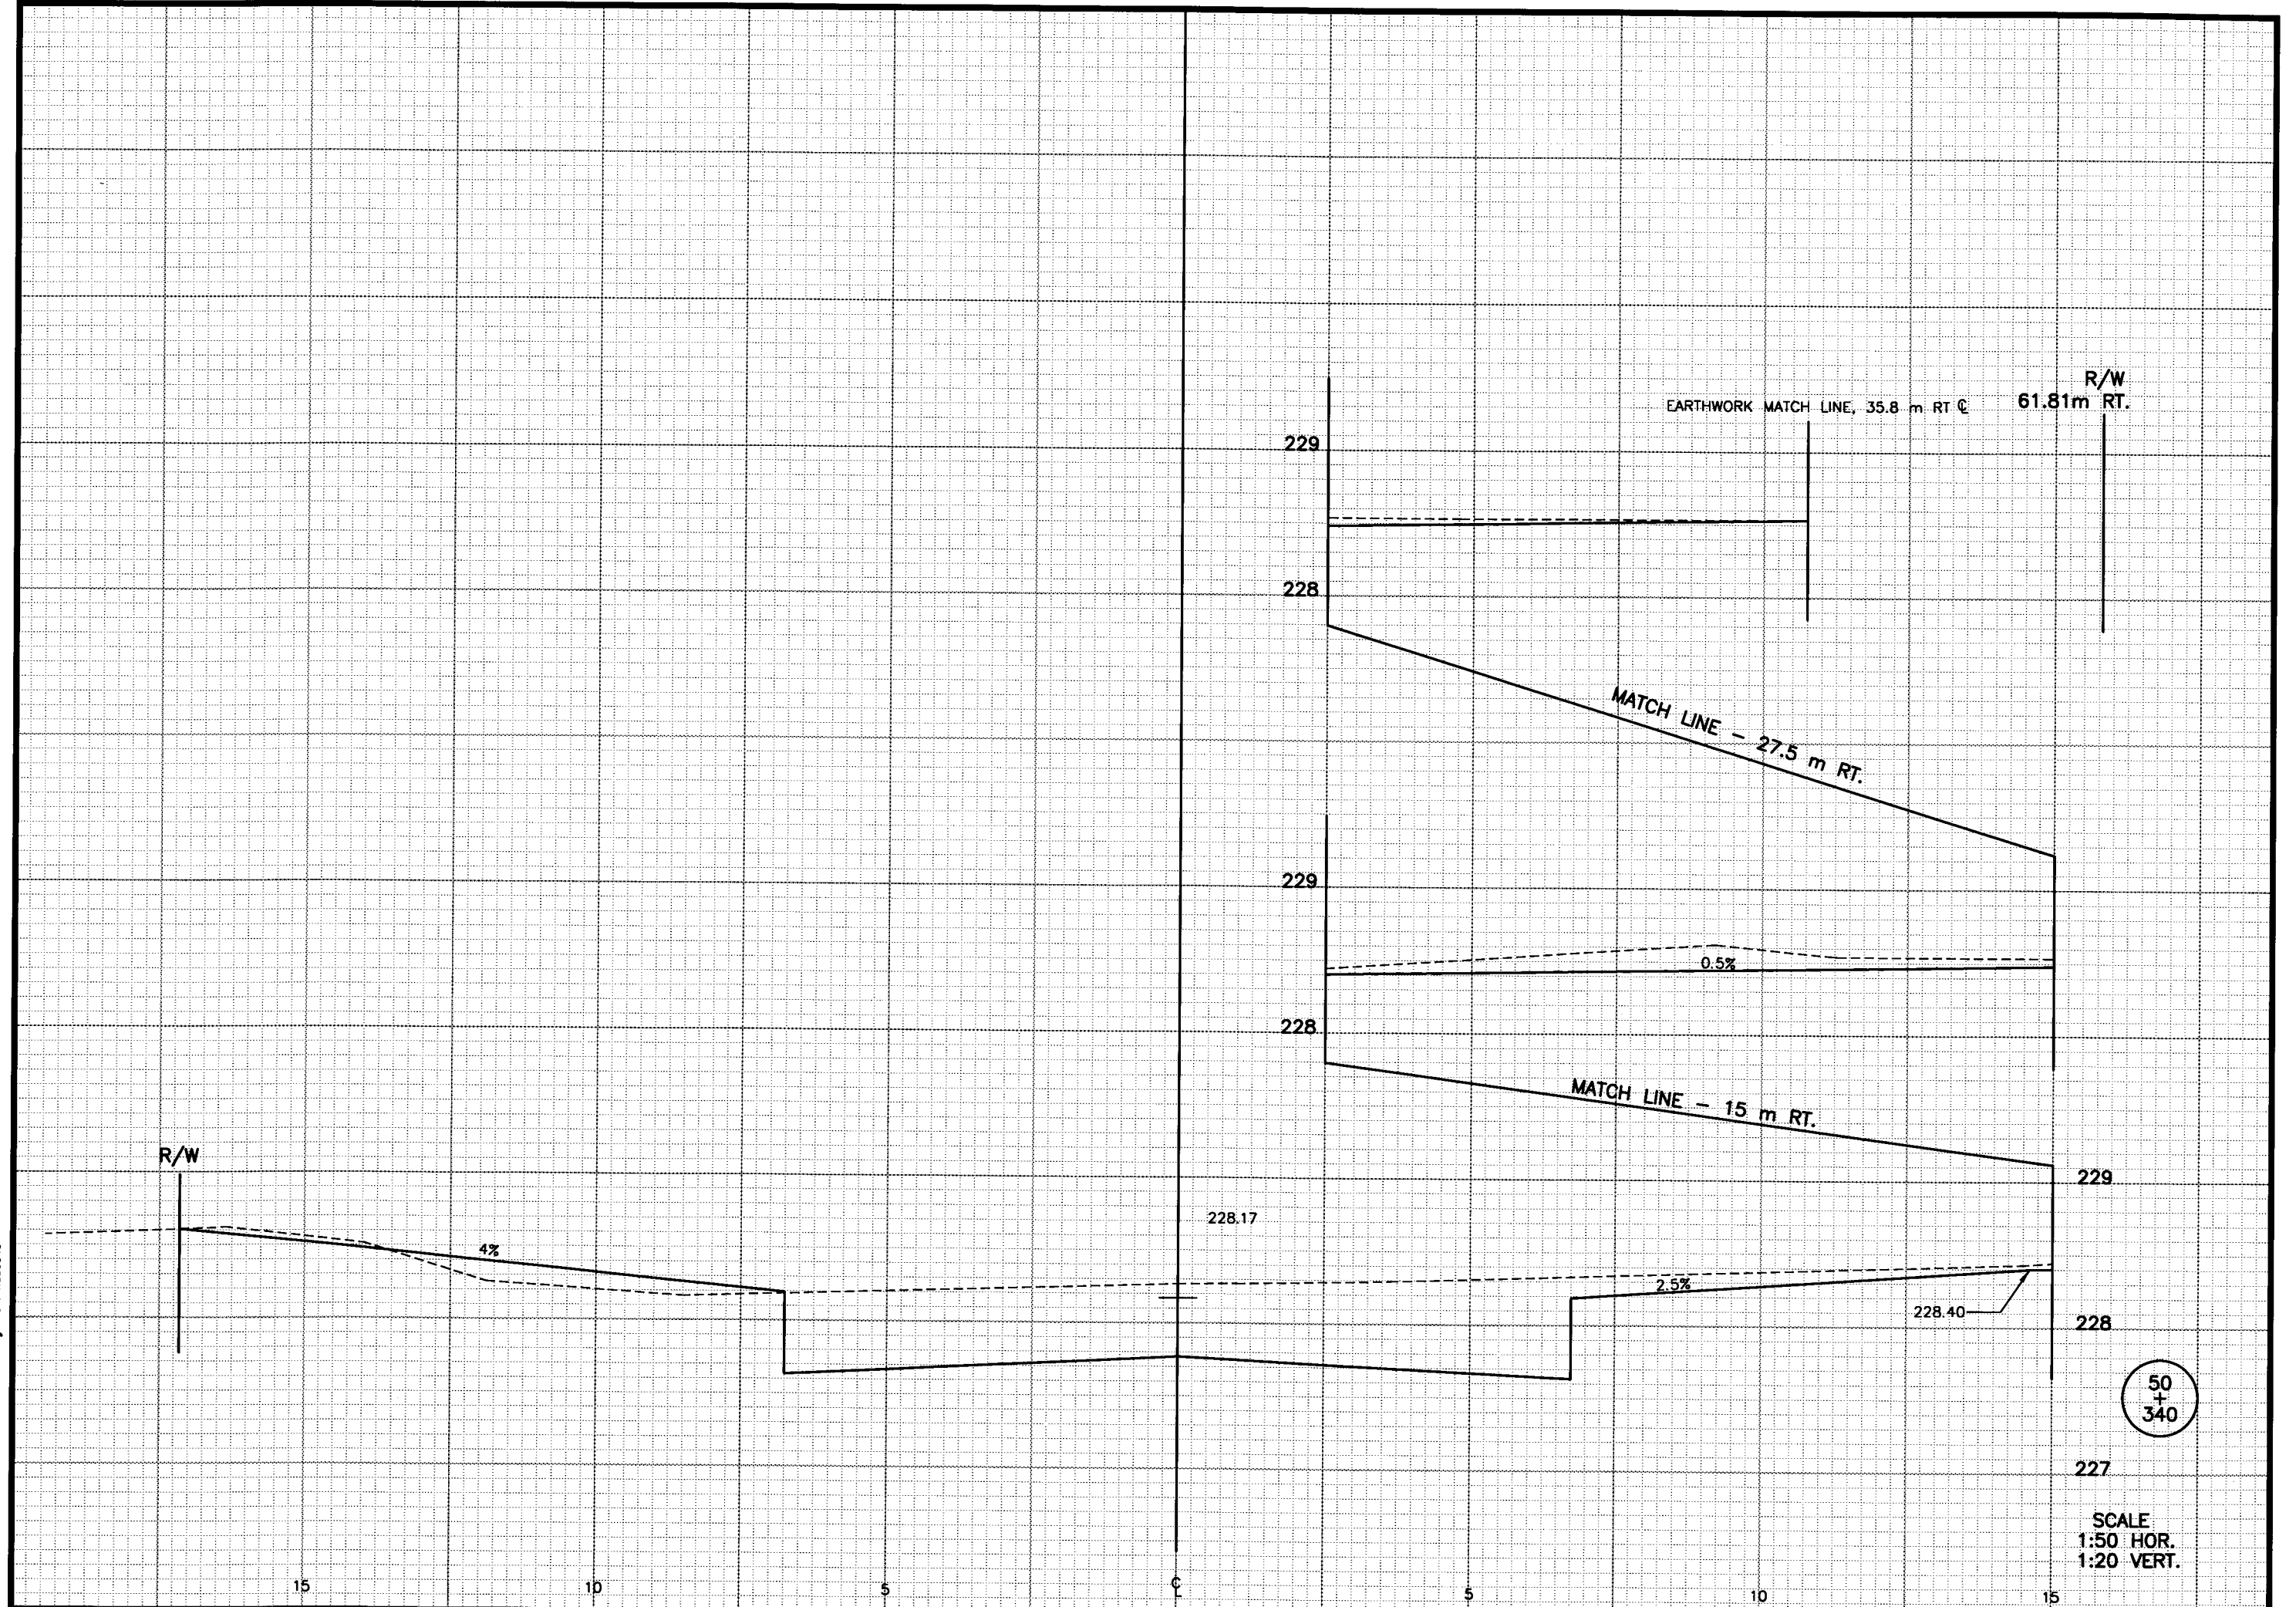

BRW CAD Sheet - MSECTION
Drawing File : X550360

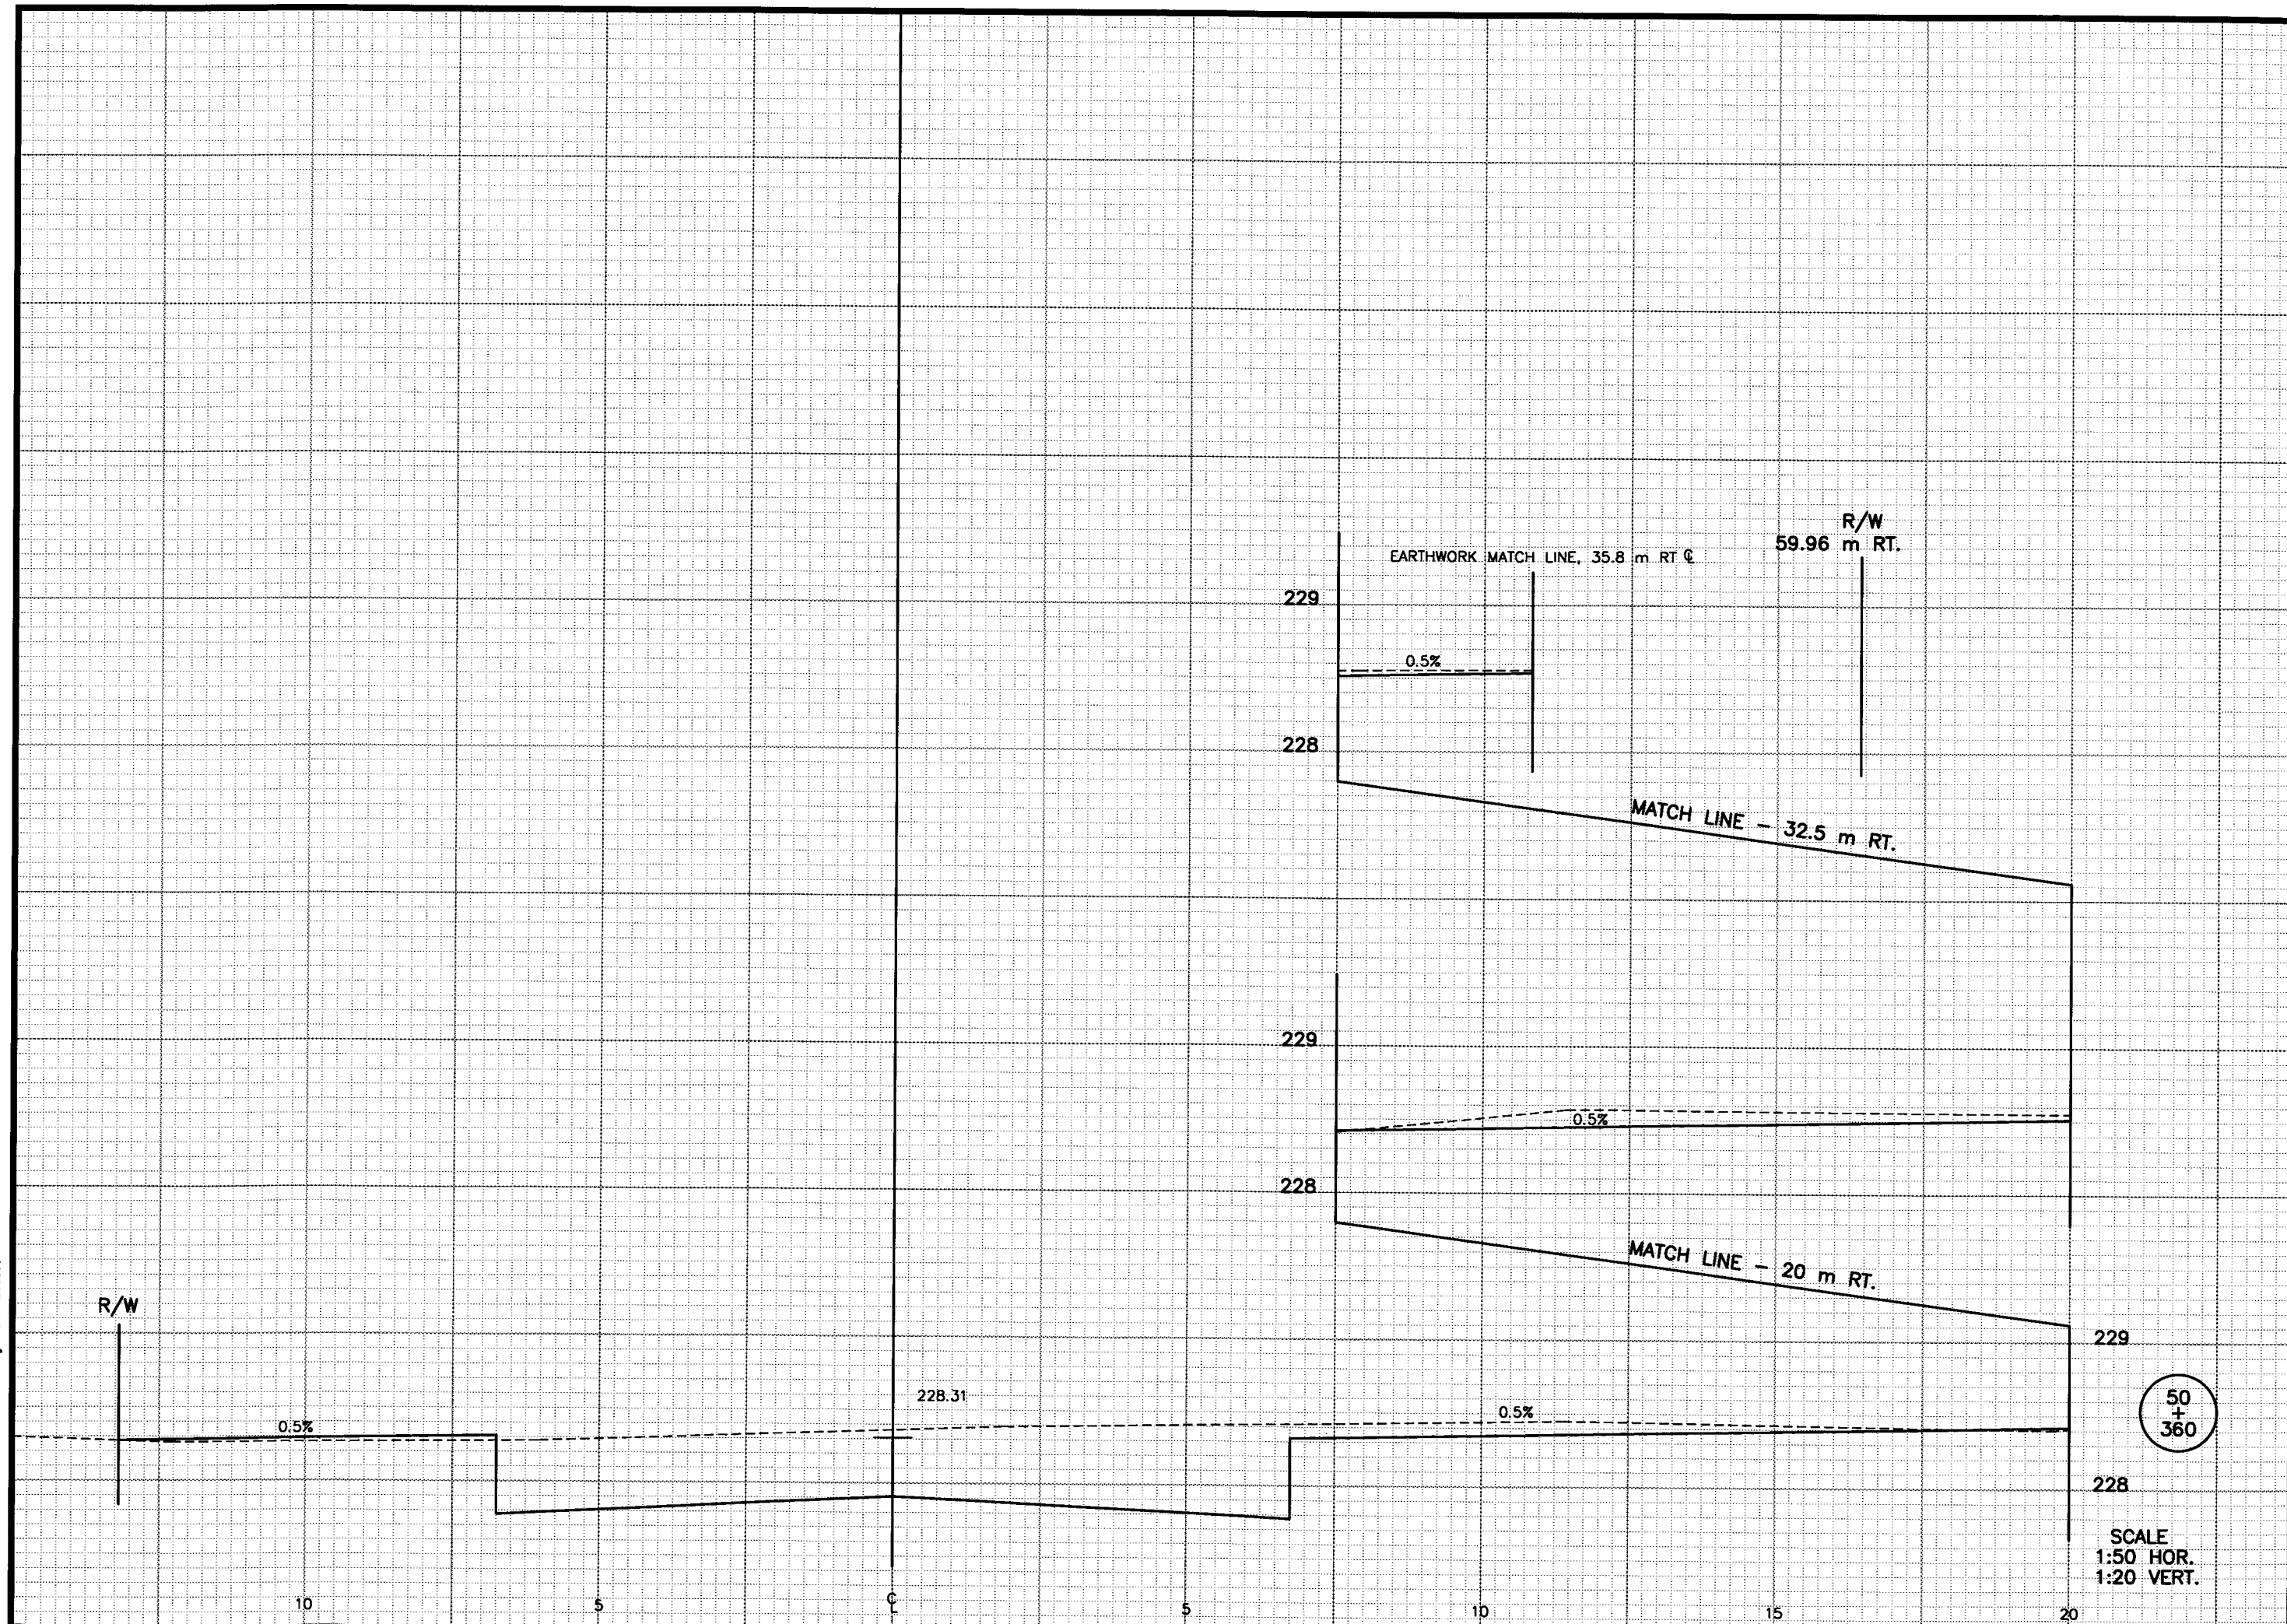

BRW CUD Sheet - MSECTION
Drawing File : X550380

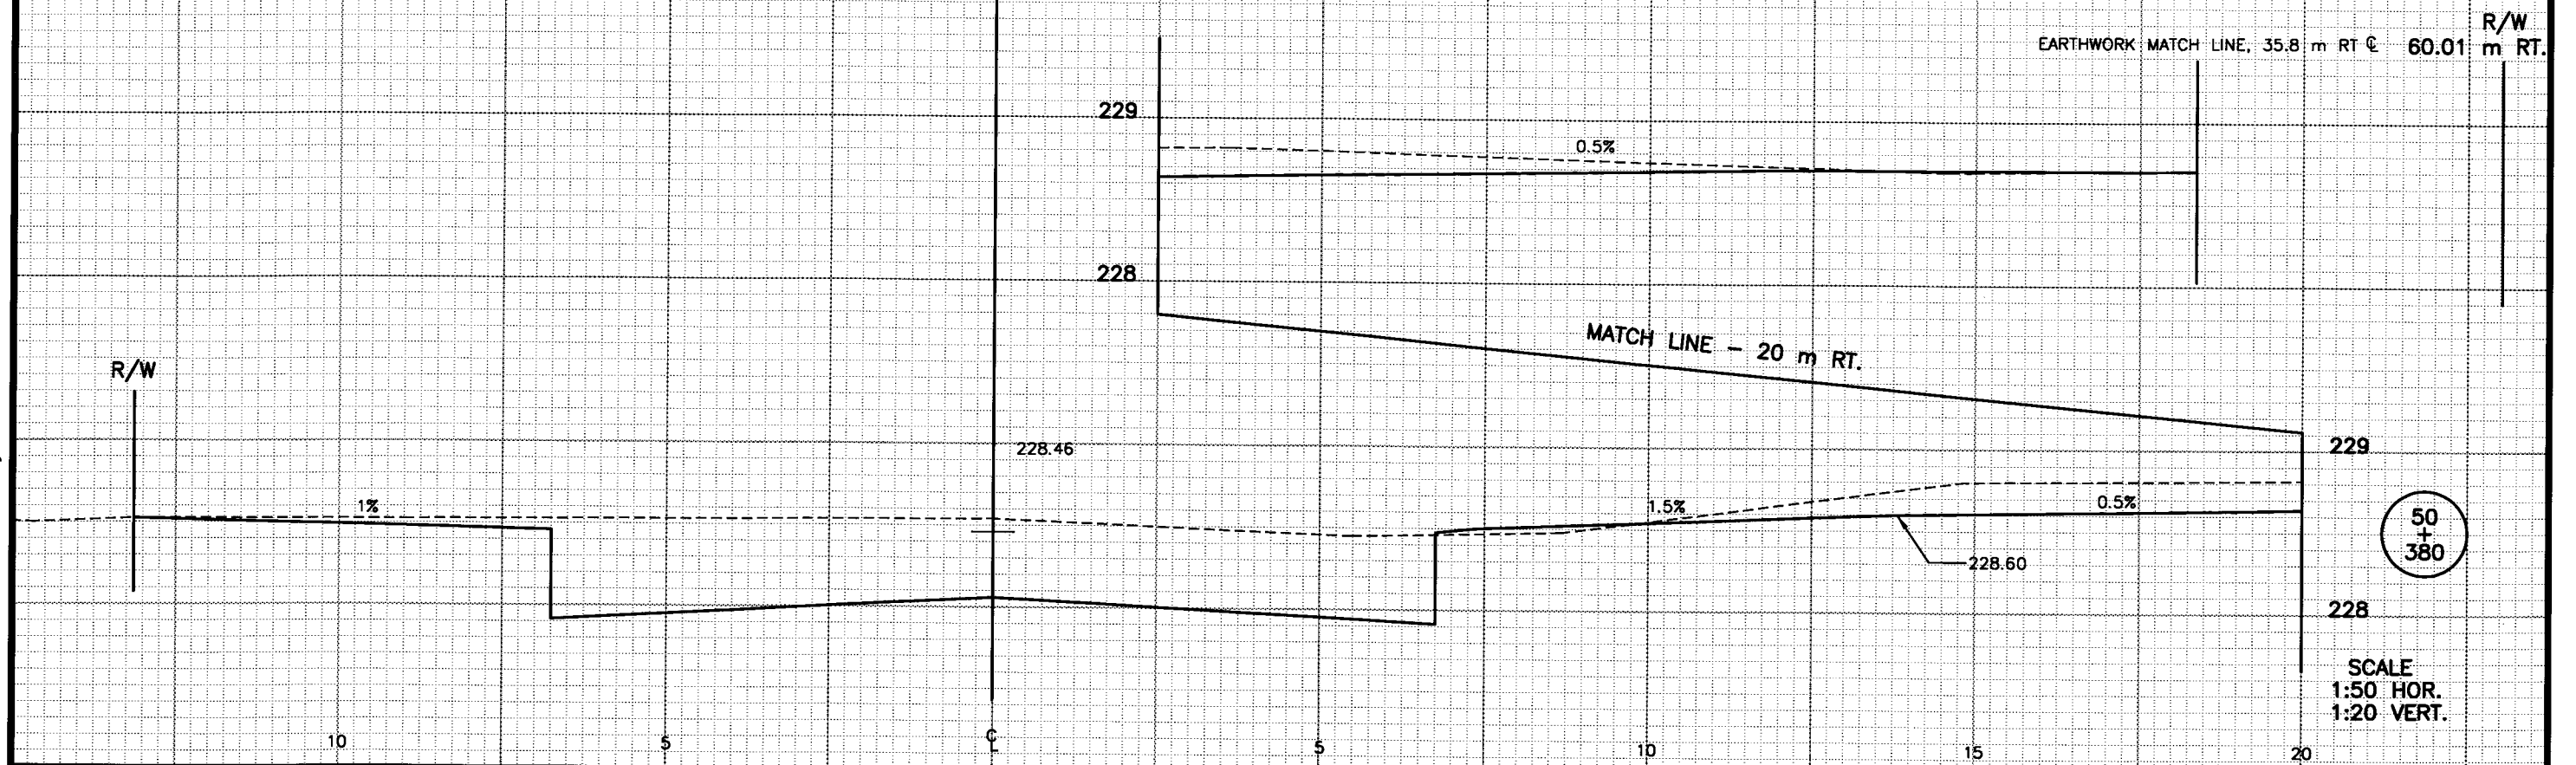

CROSS SECTIONS - SATTERLEE STREET STA. 50+380

HWY: S.T.H. 23


COUNTY: FOND DU LAC

STATE PROJECT NO.: 1442-04-70


SHEET NO.: 9.63 M

BRW C400 Sheet - MSECTION
Drawing File : XS50400



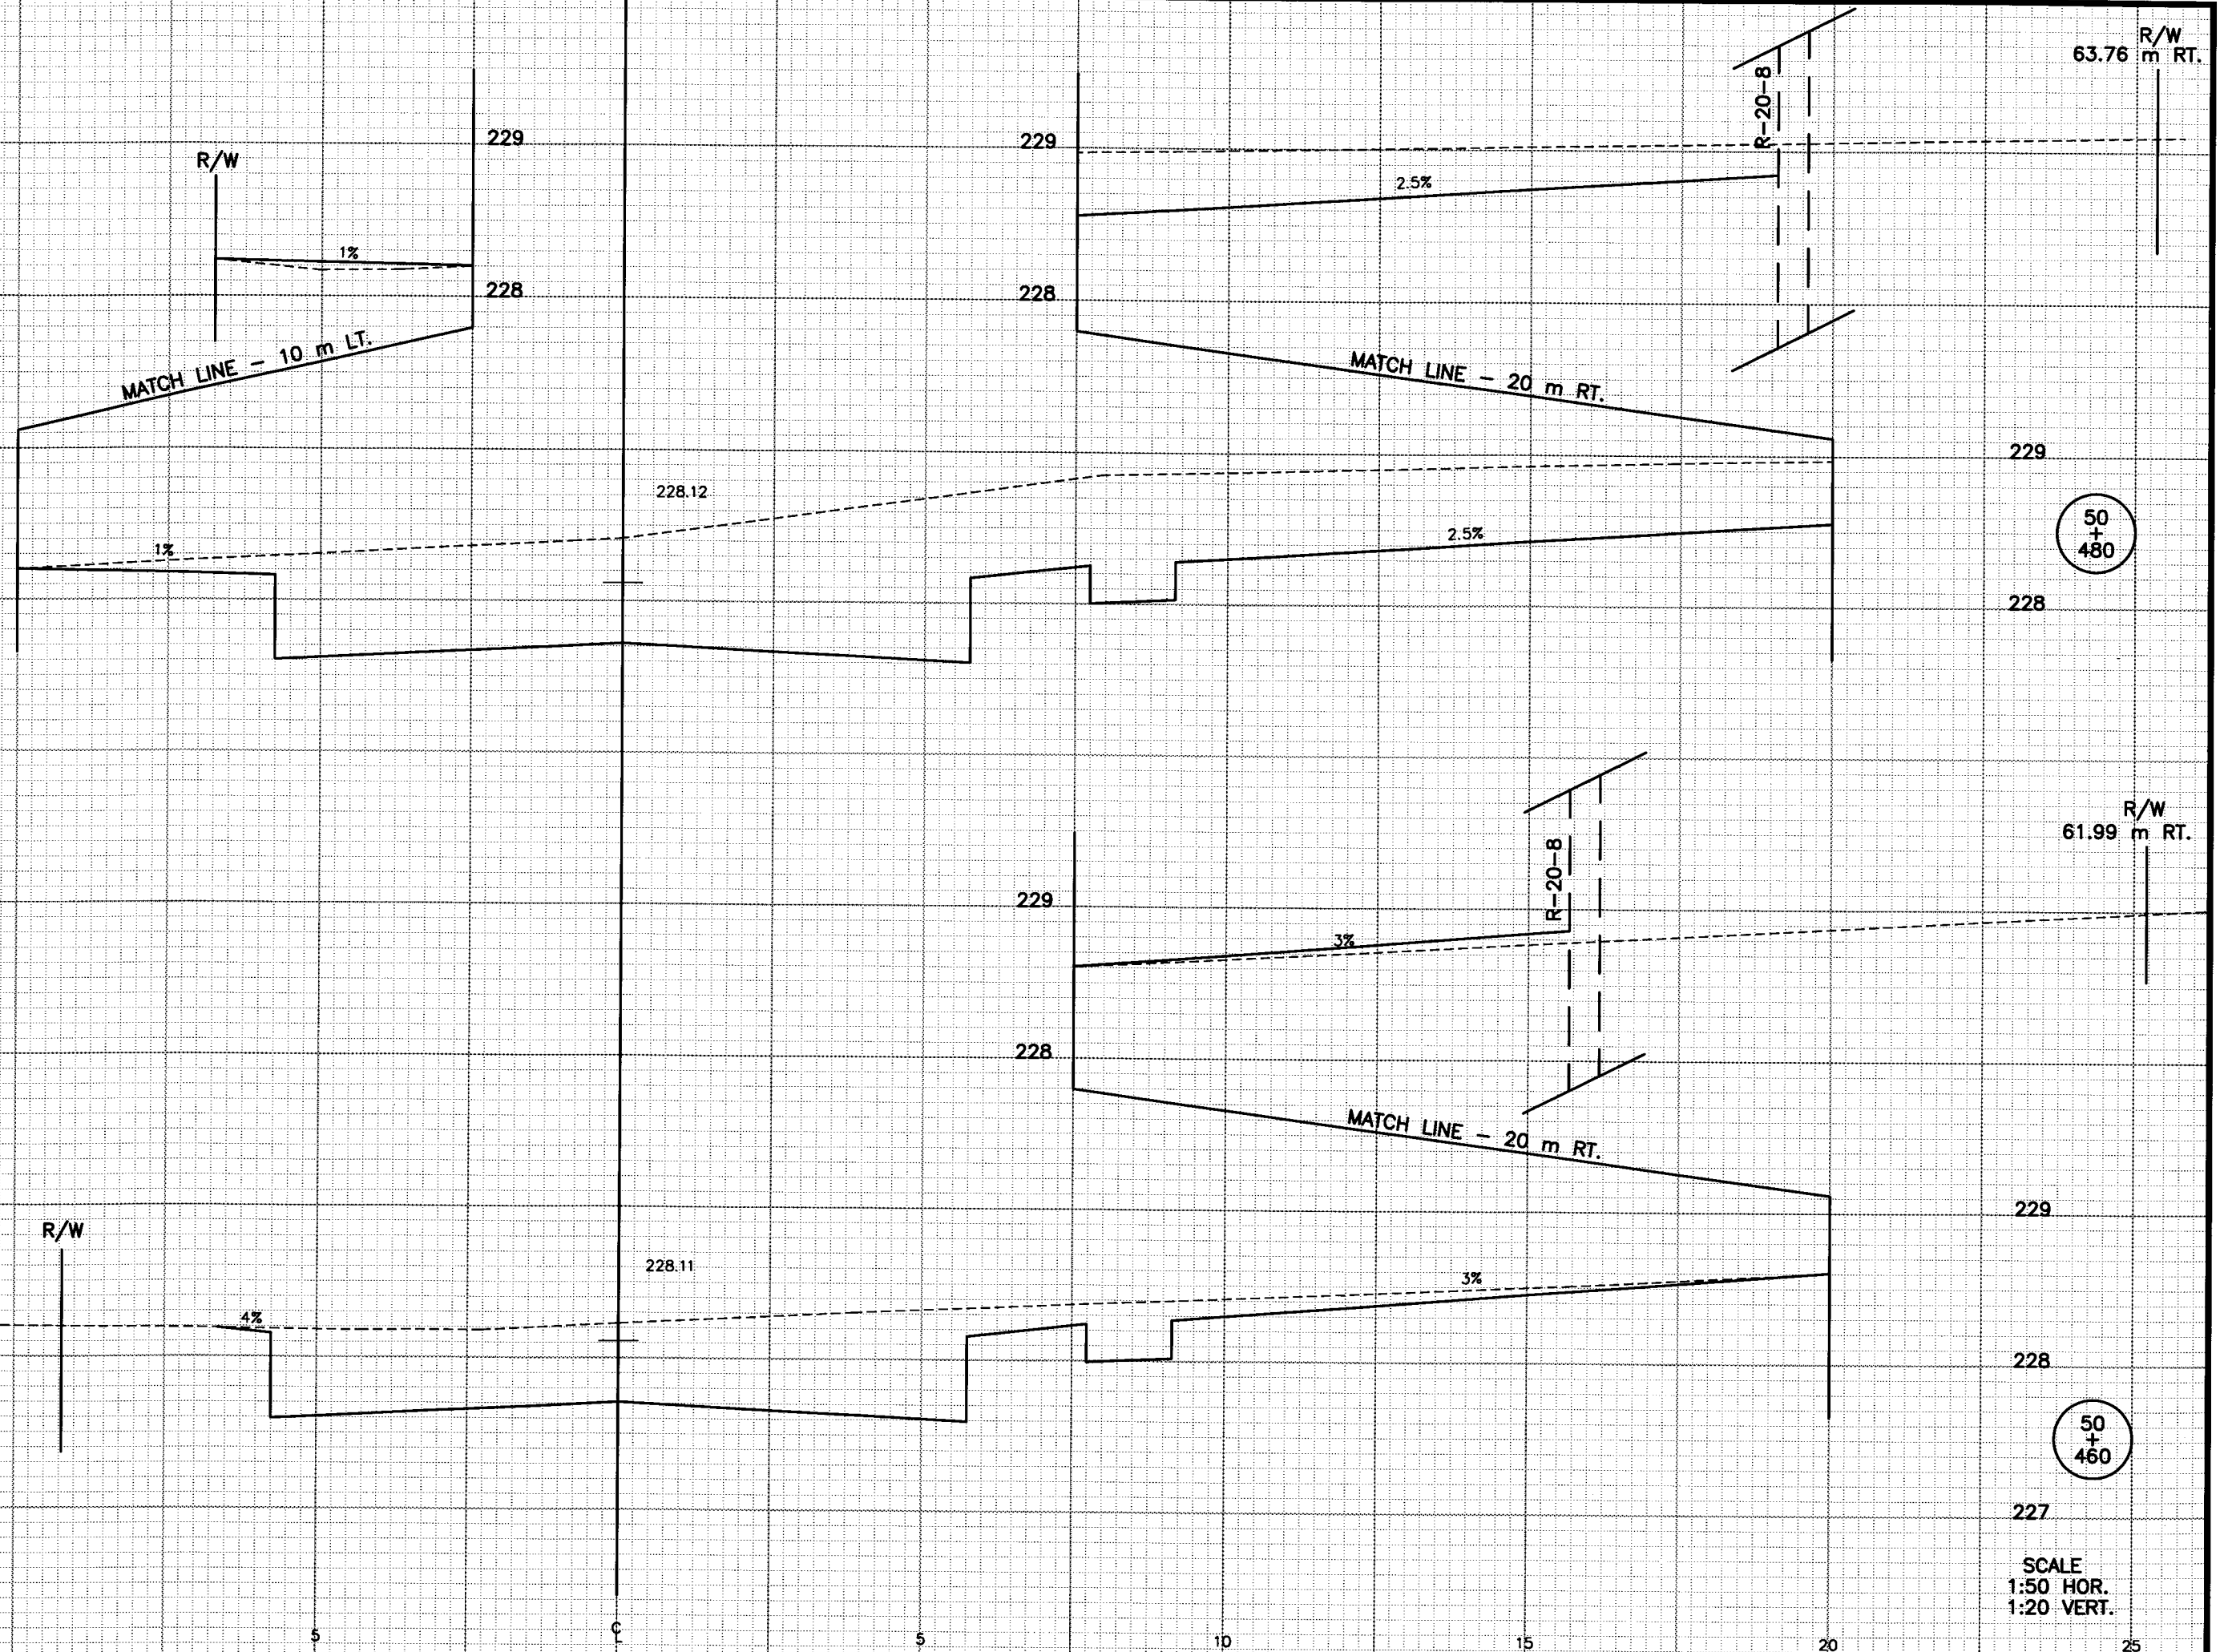

BRW CAD Sheet - MSECTION
Drawing File : X5505000

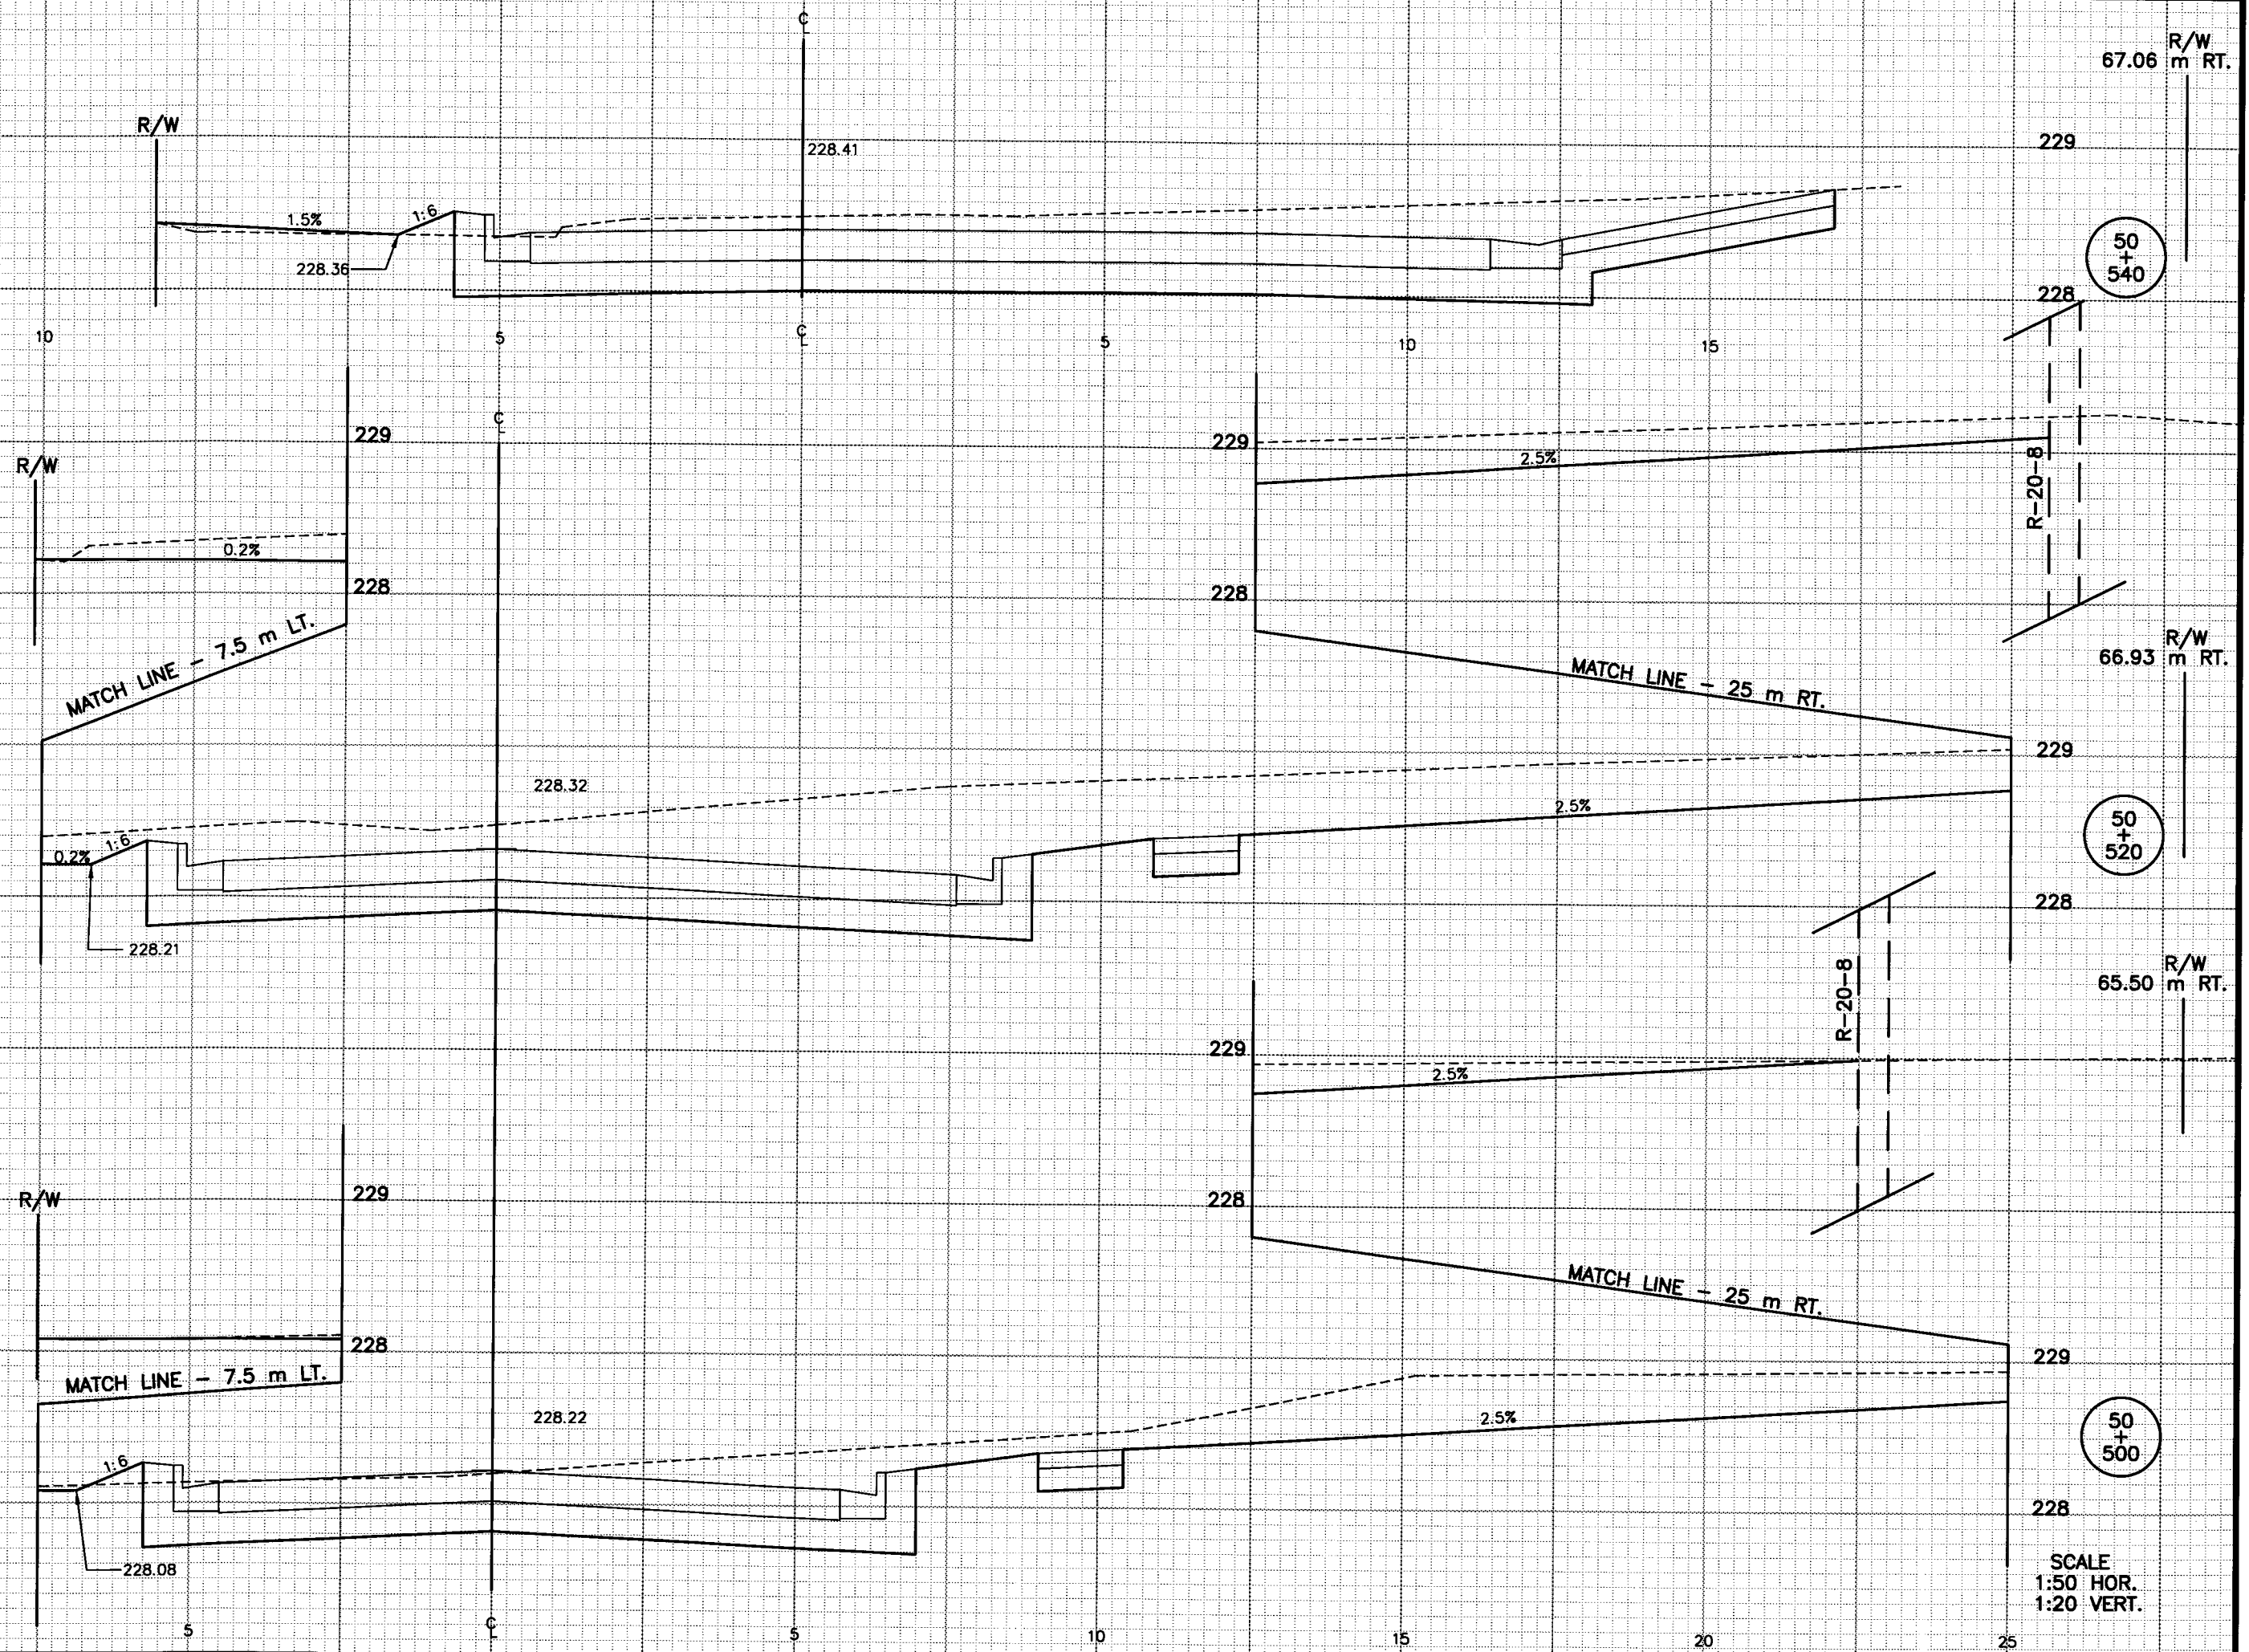

CROSS SECTIONS - KELLY DRIVE STA. 50+500 - STA. 50+540

HWY: S.T.H. 23

COUNTY: FOND DU LAC

STATE PROJECT NO.: 1442-04-70

SHEET NO.: 9.66 | M

Drawing File - XS16170

BRW CADD Sheet - MSECTION

R/W

228.87

230

229

16
+
200

228

1:6

R/W

228.95

230

229

16
+
180

228

R/W

R/W

228.99

230

229

16
+
170

228

R/W

BEGIN CONSTRUCTION
MATCH EXISTING
STA. 16+170.000

SCALE
1:50 HOR.
1:20 VERT.

CROSS SECTIONS - BROOKE STREET STA. 16+170 - STA. 16+200

HWY: S.T.H. 23

COUNTY: FOND DU LAC


STATE PROJECT NO.: 1442-04-70

SHEET NO.: 9.67 M


R-12-8-00

BRW CAD Sheet - MSECTION
Drawing File : X516220

EARTHWORK MATCH LINE, 16.7 m LT ϕ

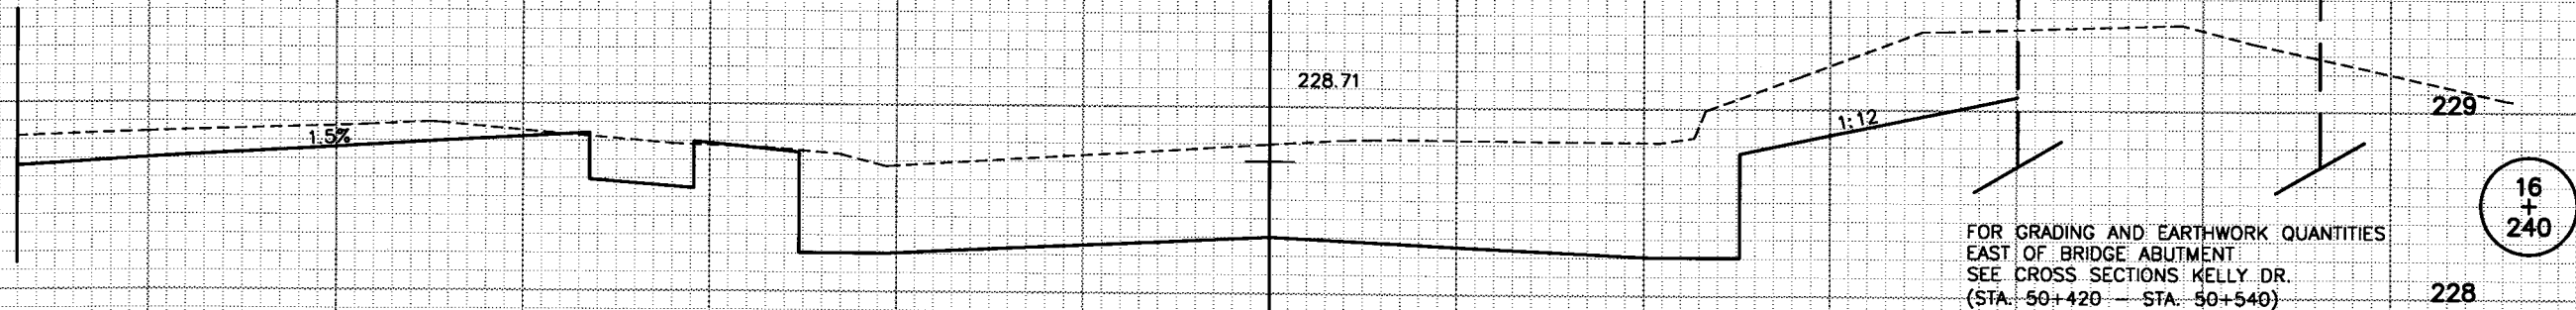

EARTHWORK MATCH LINE, 15.1 m LT ϕ

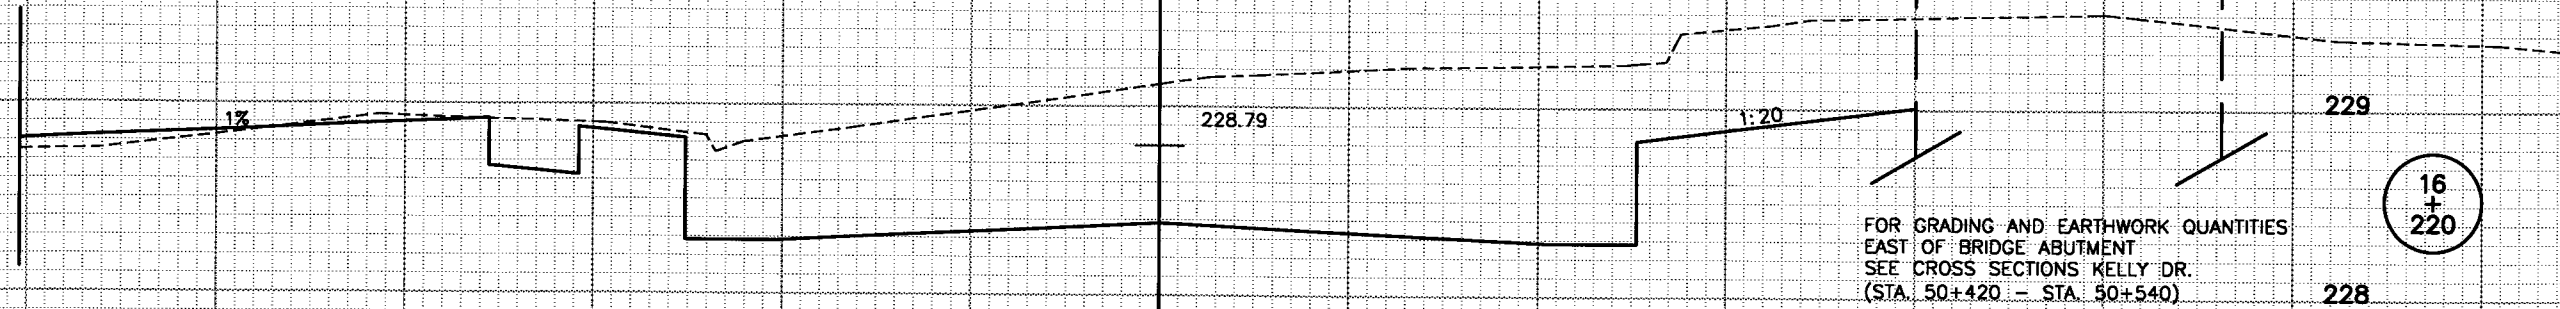

SCALE
1:50 HOR.
1:20 VERT.

Drawing File : X516260

BRW CADD Sheet - MSECTION

15

10

5

0

5

10

15

CROSS SECTIONS - BROOKE ST. STA. 16+260 - STA. 16+280

HWY: S.T.H. 23 COUNTY: FOND DU LAC

STATE PROJECT NO.: 1442-04-70

SHEET NO.: 9.69 M

END CONSTRUCTION
MATCH EXISTING
STA. 16+280.000

228.58

1:6

230

229
R/W

16
+
280

228

230

SEE X-SECTIONS
SATTERLEE STREET

228.65

SEE X-SECTIONS
KELLY DRIVE

229


16
+
260

228


SCALE
1:50 HOR.
1:20 VERT.

BRW CAD Sheet - MSECTION
Drawing File : XS30040


EARTHWORK MATCH LINE, 15.0 m LT ☺

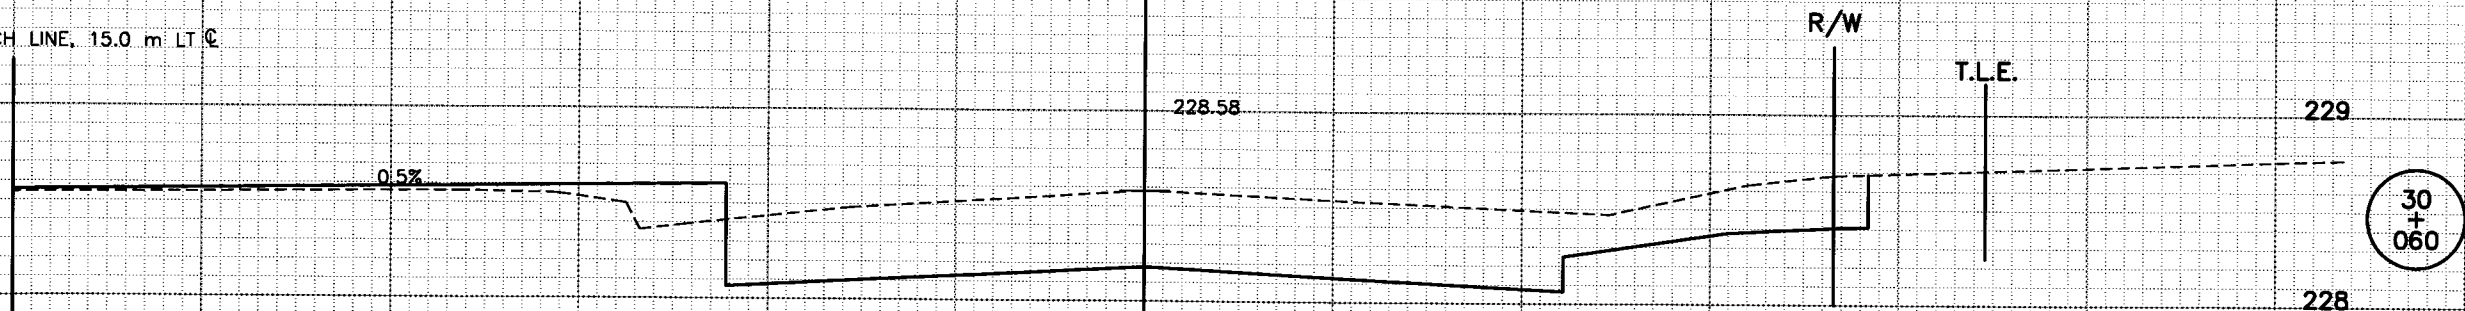

EARTHWORK MATCH LINE, 9.4 m LT ☺

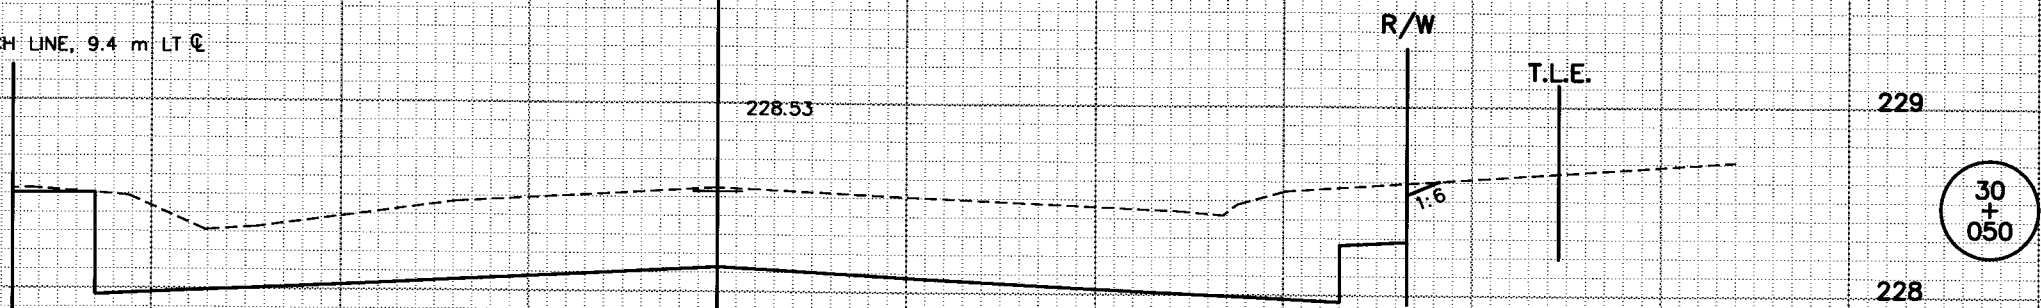

EARTHWORK MATCH LINE, 3.7 m LT ☺

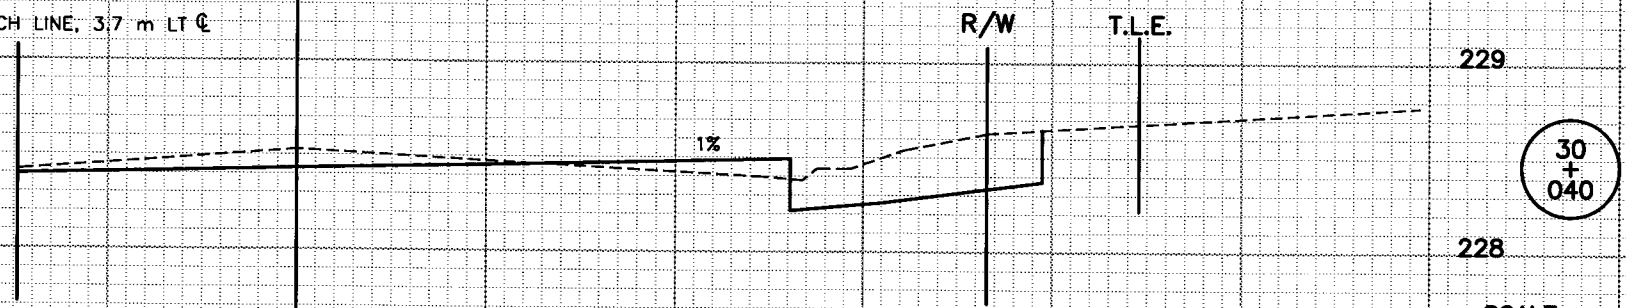

SCALE
1:50 HOR.
1:20 VERT.

BROOKE STREET

228.74

BROOKE STREET

229

228

30
+
100

EARTHWORK MATCH LINE, 15.0 m LT. @

228.65

R/W

T.L.E.

229

228

30
+
080

SCALE
1:50 HOR.
1:20 VERT.

Drawing File : X530080

BRW CADD Sheet - MSECTION

CROSS SECTIONS - JOHNSON CT. STA. 30+080 - STA. 30+100


HWY: S.T.H. 23 COUNTY: FOND DU LAC

STATE PROJECT NO.: 1442-04-70

SHEET NO.: 9,71 M


Drawing File : XS30120

BRW CAD Sheet - MSECTION

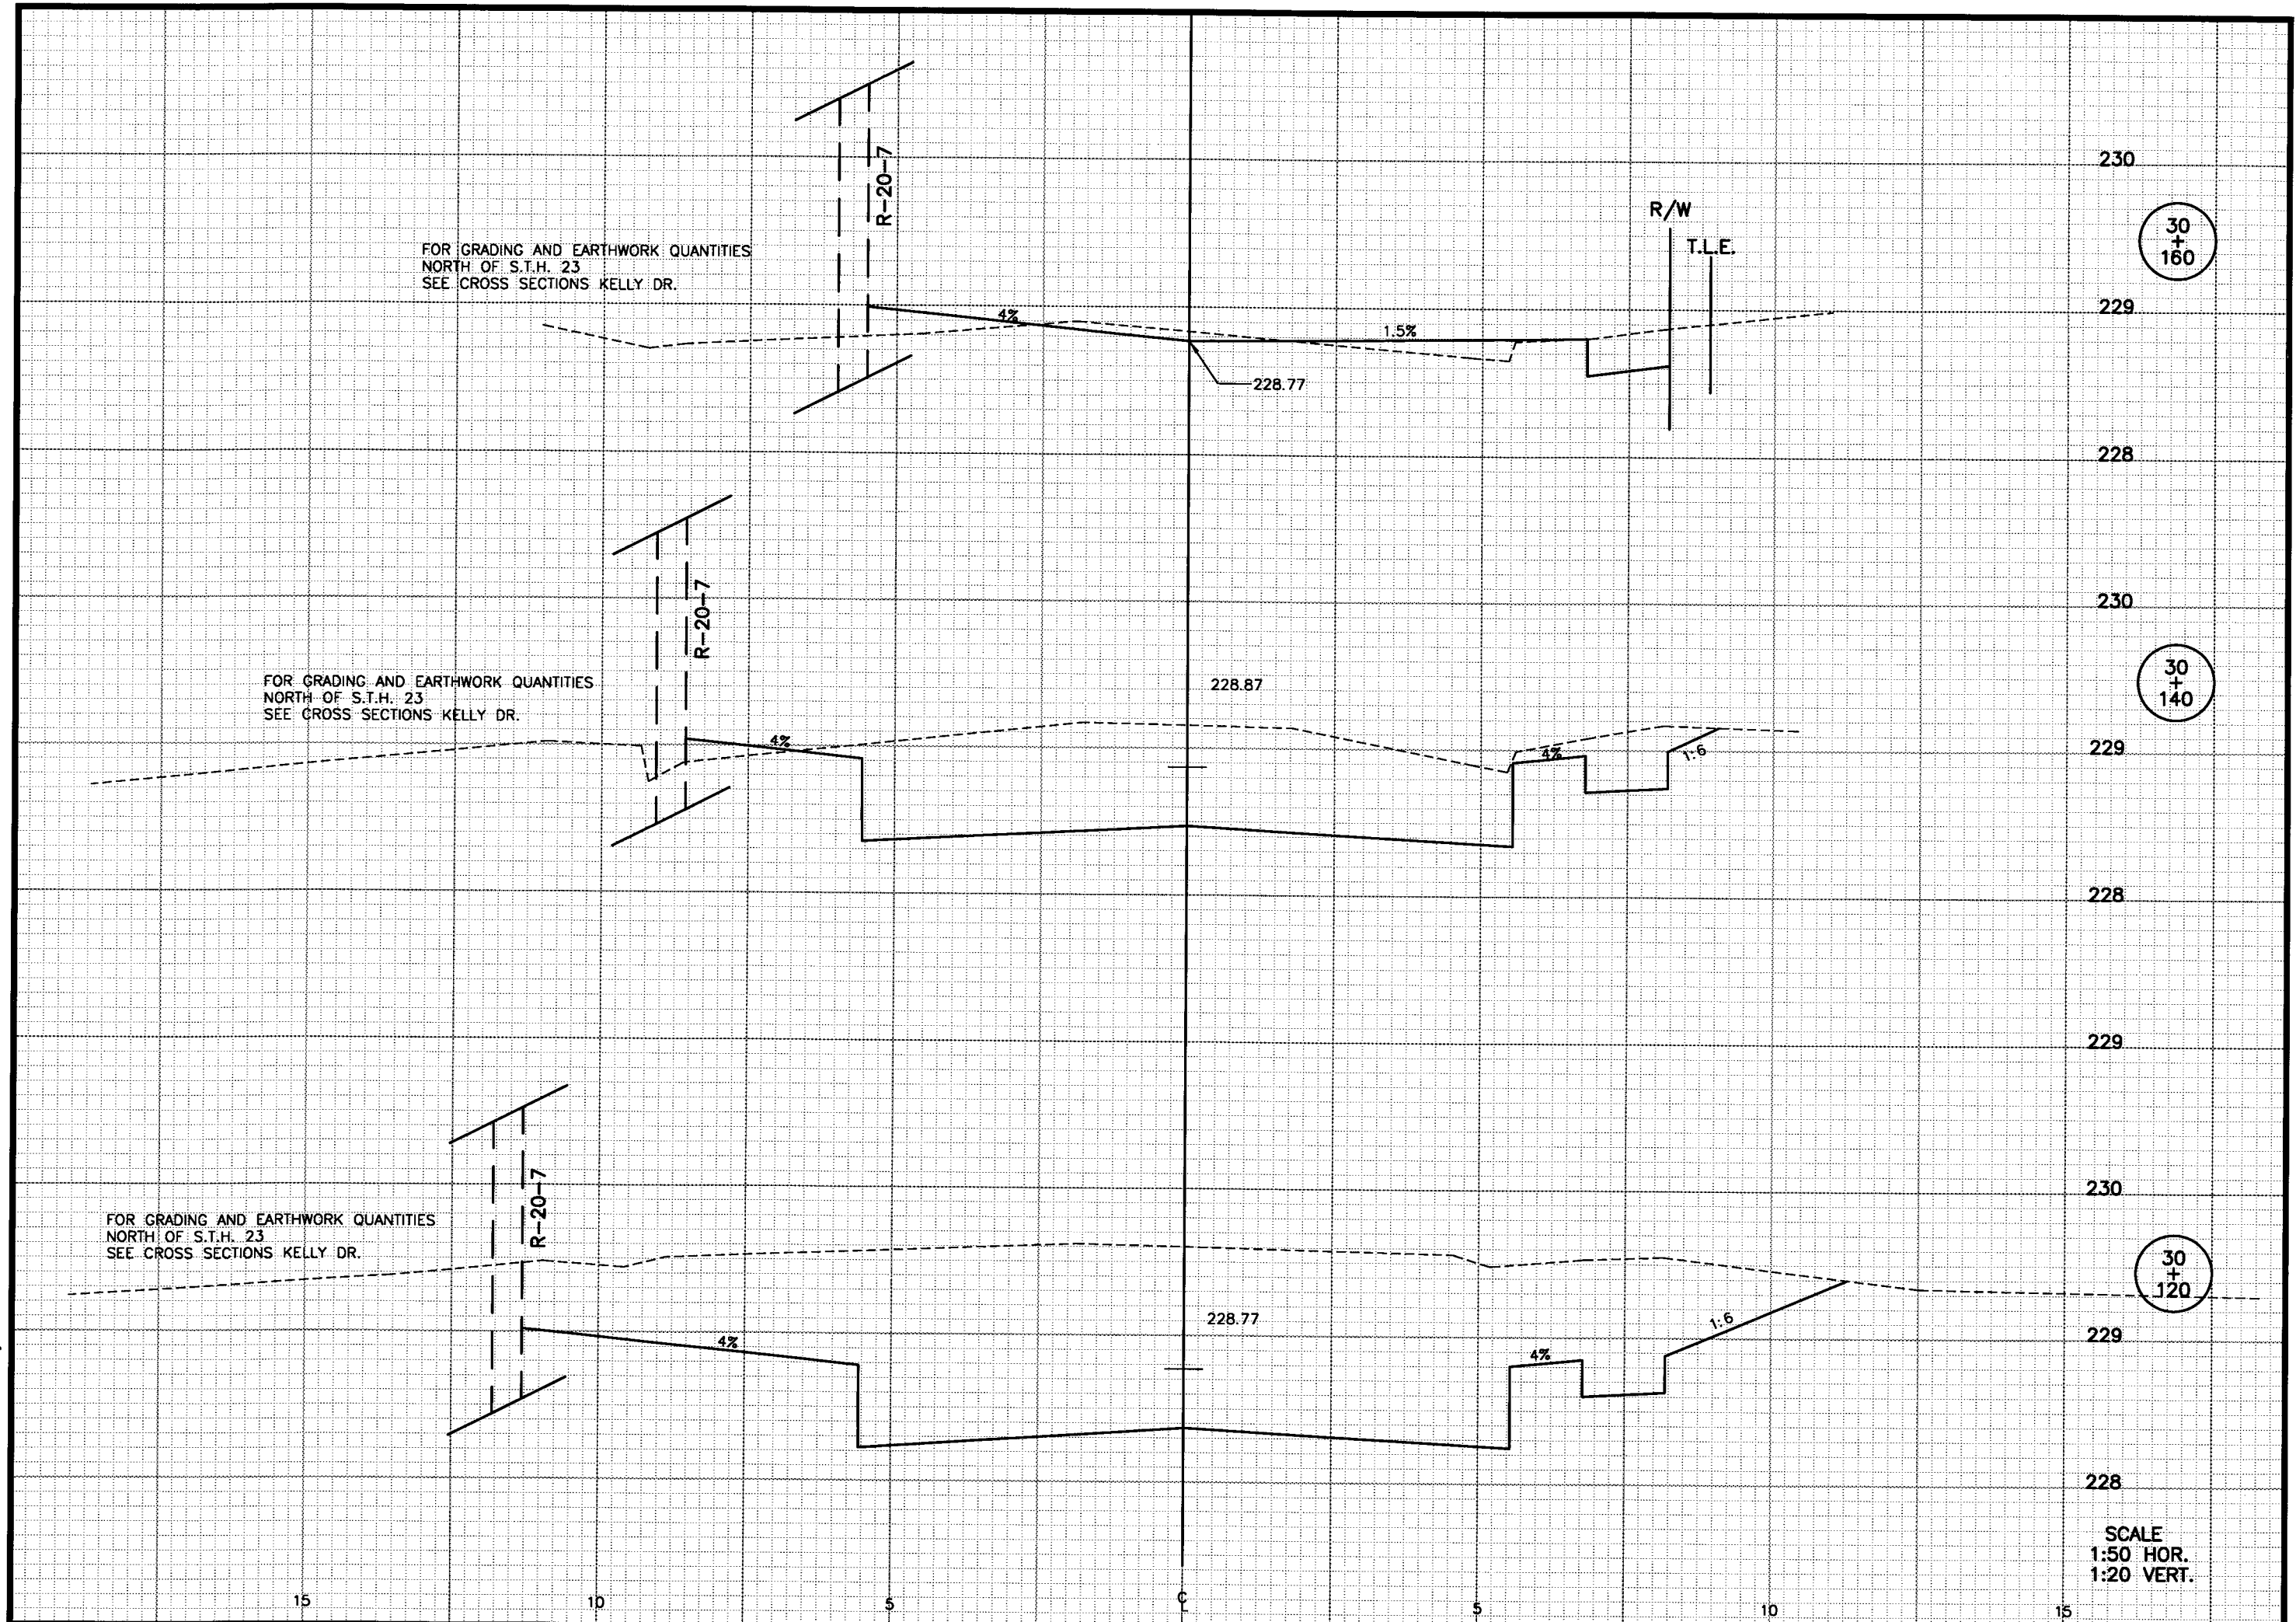


FOR GRADING AND EARTHWORK QUANTITIES
WEST OF SIDEWALK ALONG MILITARY RD.
SEE CROSS SECTIONS KELLY DR.
(STA. 50+420 - STA. 50+540)


FOR GRADING AND EARTHWORK QUANTITIES
WEST OF SIDEWALK ALONG MILITARY RD.
SEE CROSS SECTIONS KELLY DR.
(STA. 50+420 - STA. 50+540)

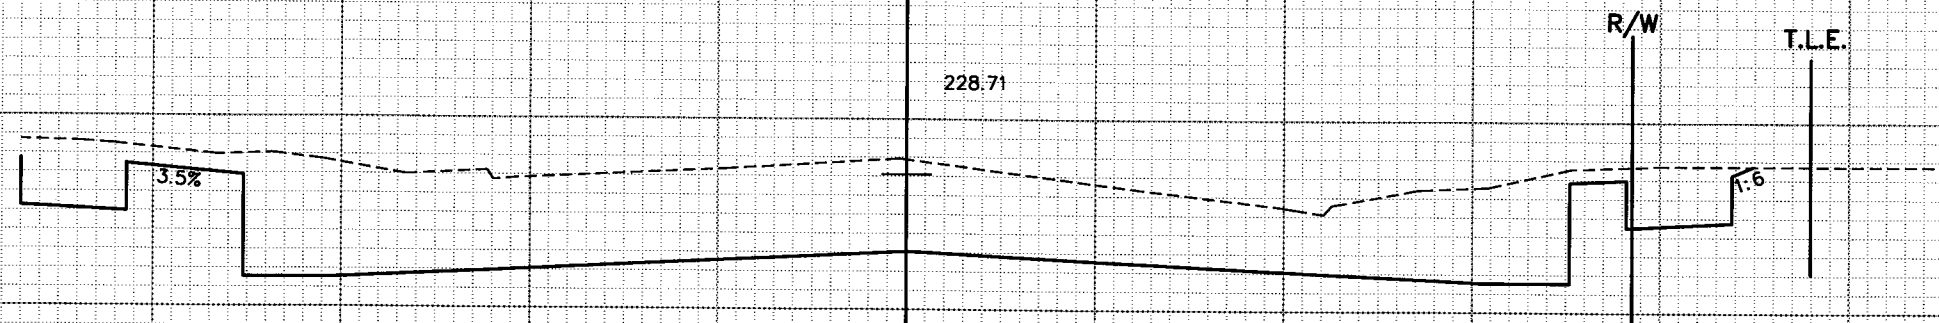


20+230

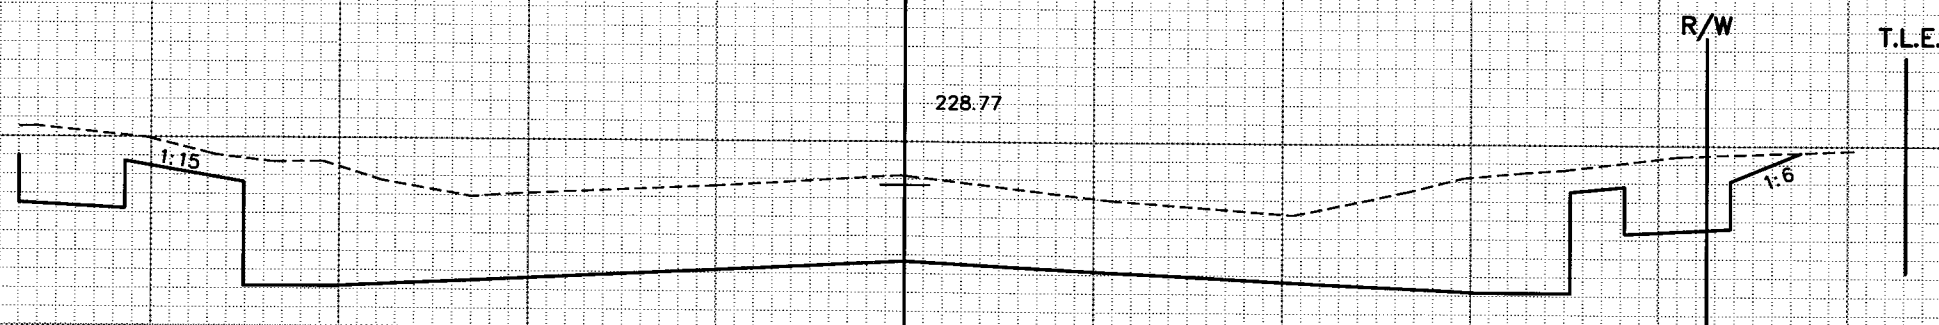

20+220

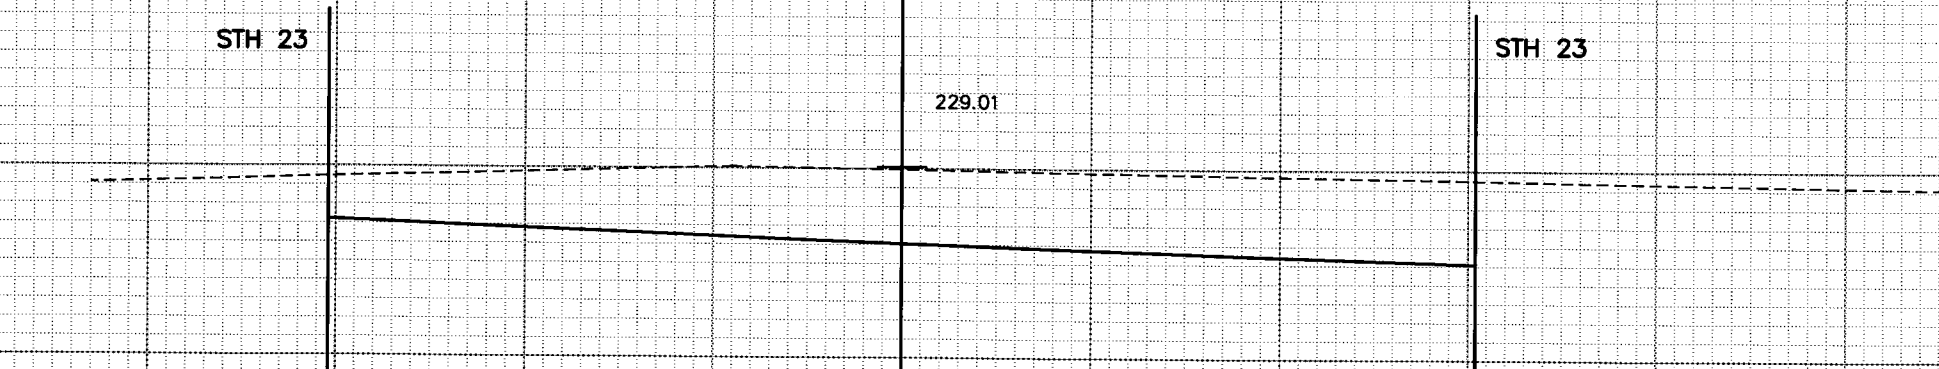

20+200

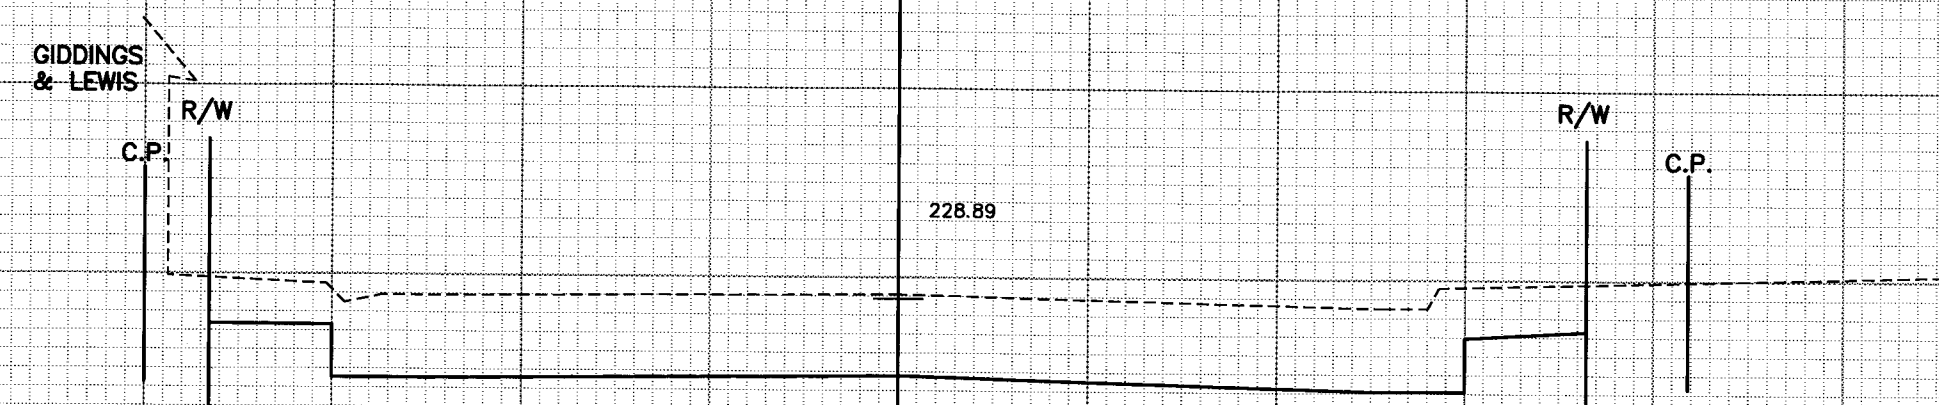

20+180

BEGIN CONSTRUCTION
MATCH EXISTING
STA. 20+178.500

SCALE
1:50 HOR.
1:20 VERT.

Drawing File : XS20180
BRW CADD Sheet - MSECTION

END CONSTRUCTION
MATCH EXISTING
STA. 20+266.000

R/W

228.53

4.5%

1:6

229

228

20
+
260

KELLY DRIVE

R/W

T.L.E.

228.59

229

228

20
+
250

R/W

T.L.E.

228.65

229


228

20
+
240


FOR GRADING AND EARTHWORK QUANTITIES
WEST OF SIDEWALK ALONG MILITARY RD.
SEE CROSS SECTIONS KELLY DR.
(STA. 50+420 - STA. 50+540)

SCALE
1:50 HOR.
1:20 VERT.


BRW CAD Sheet - MSECTION
Drawing File : XS19080

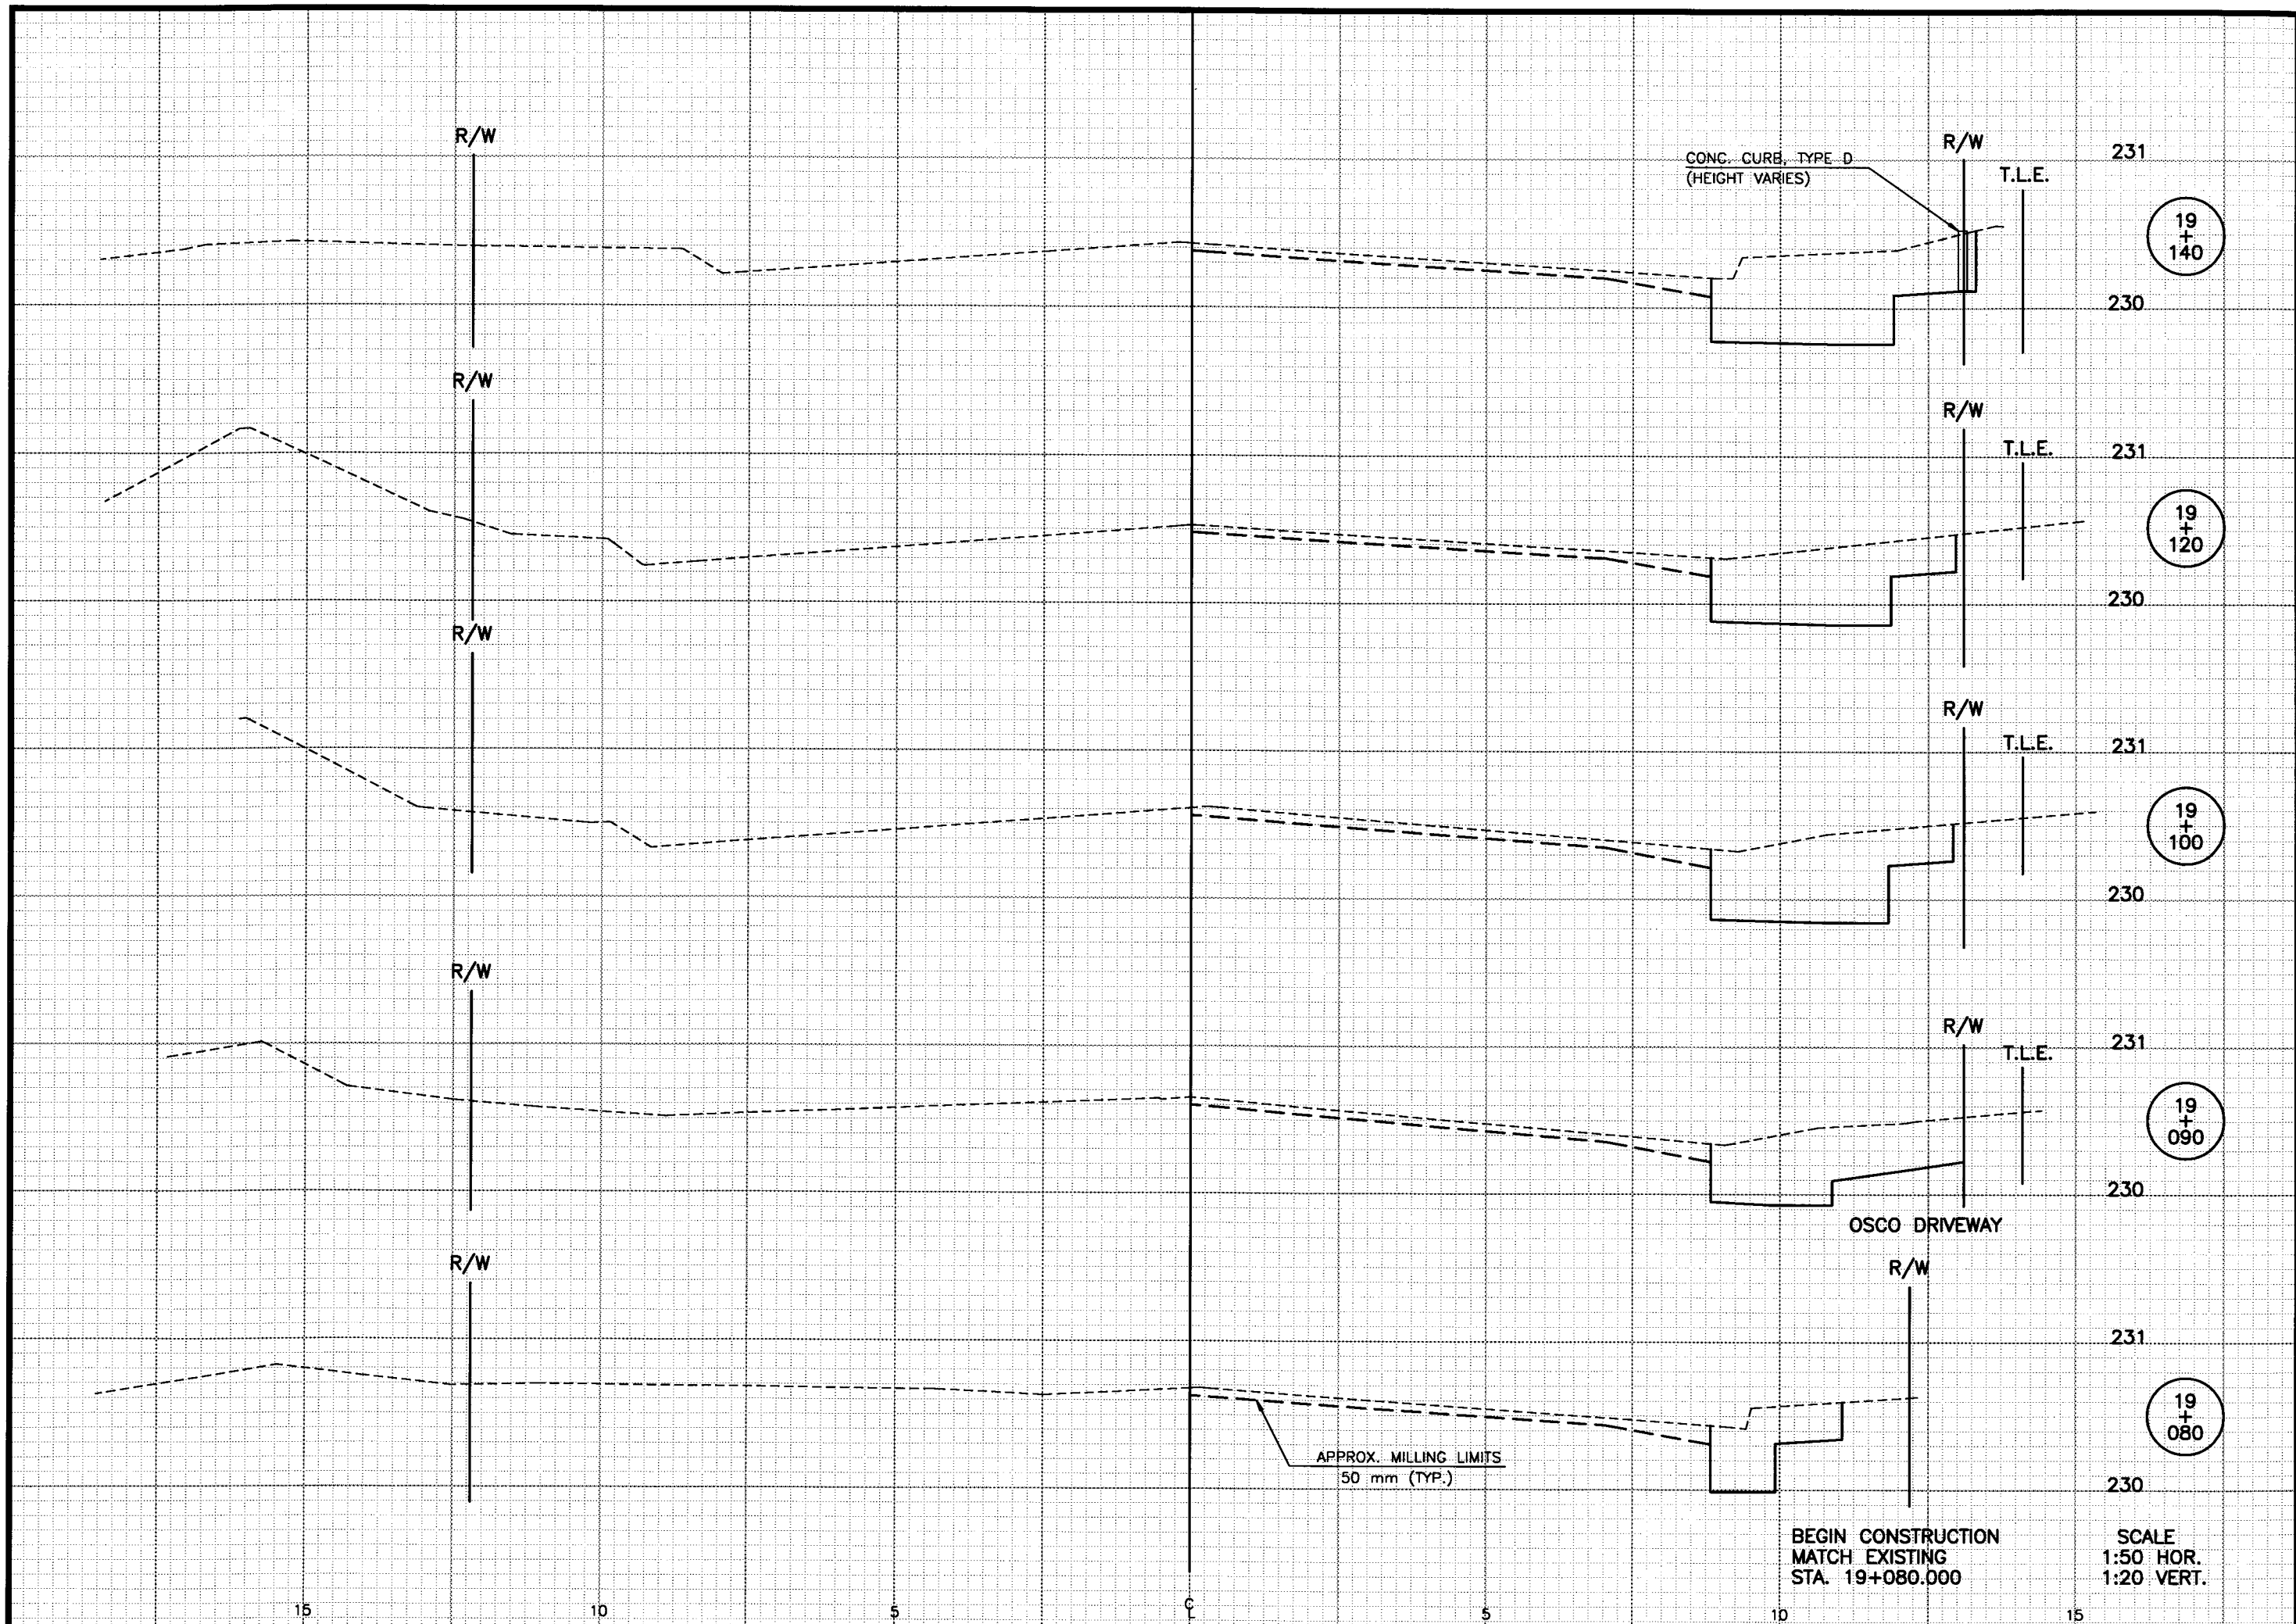



BRW CADD Sheet - MSECTION
Drawing File : X519200

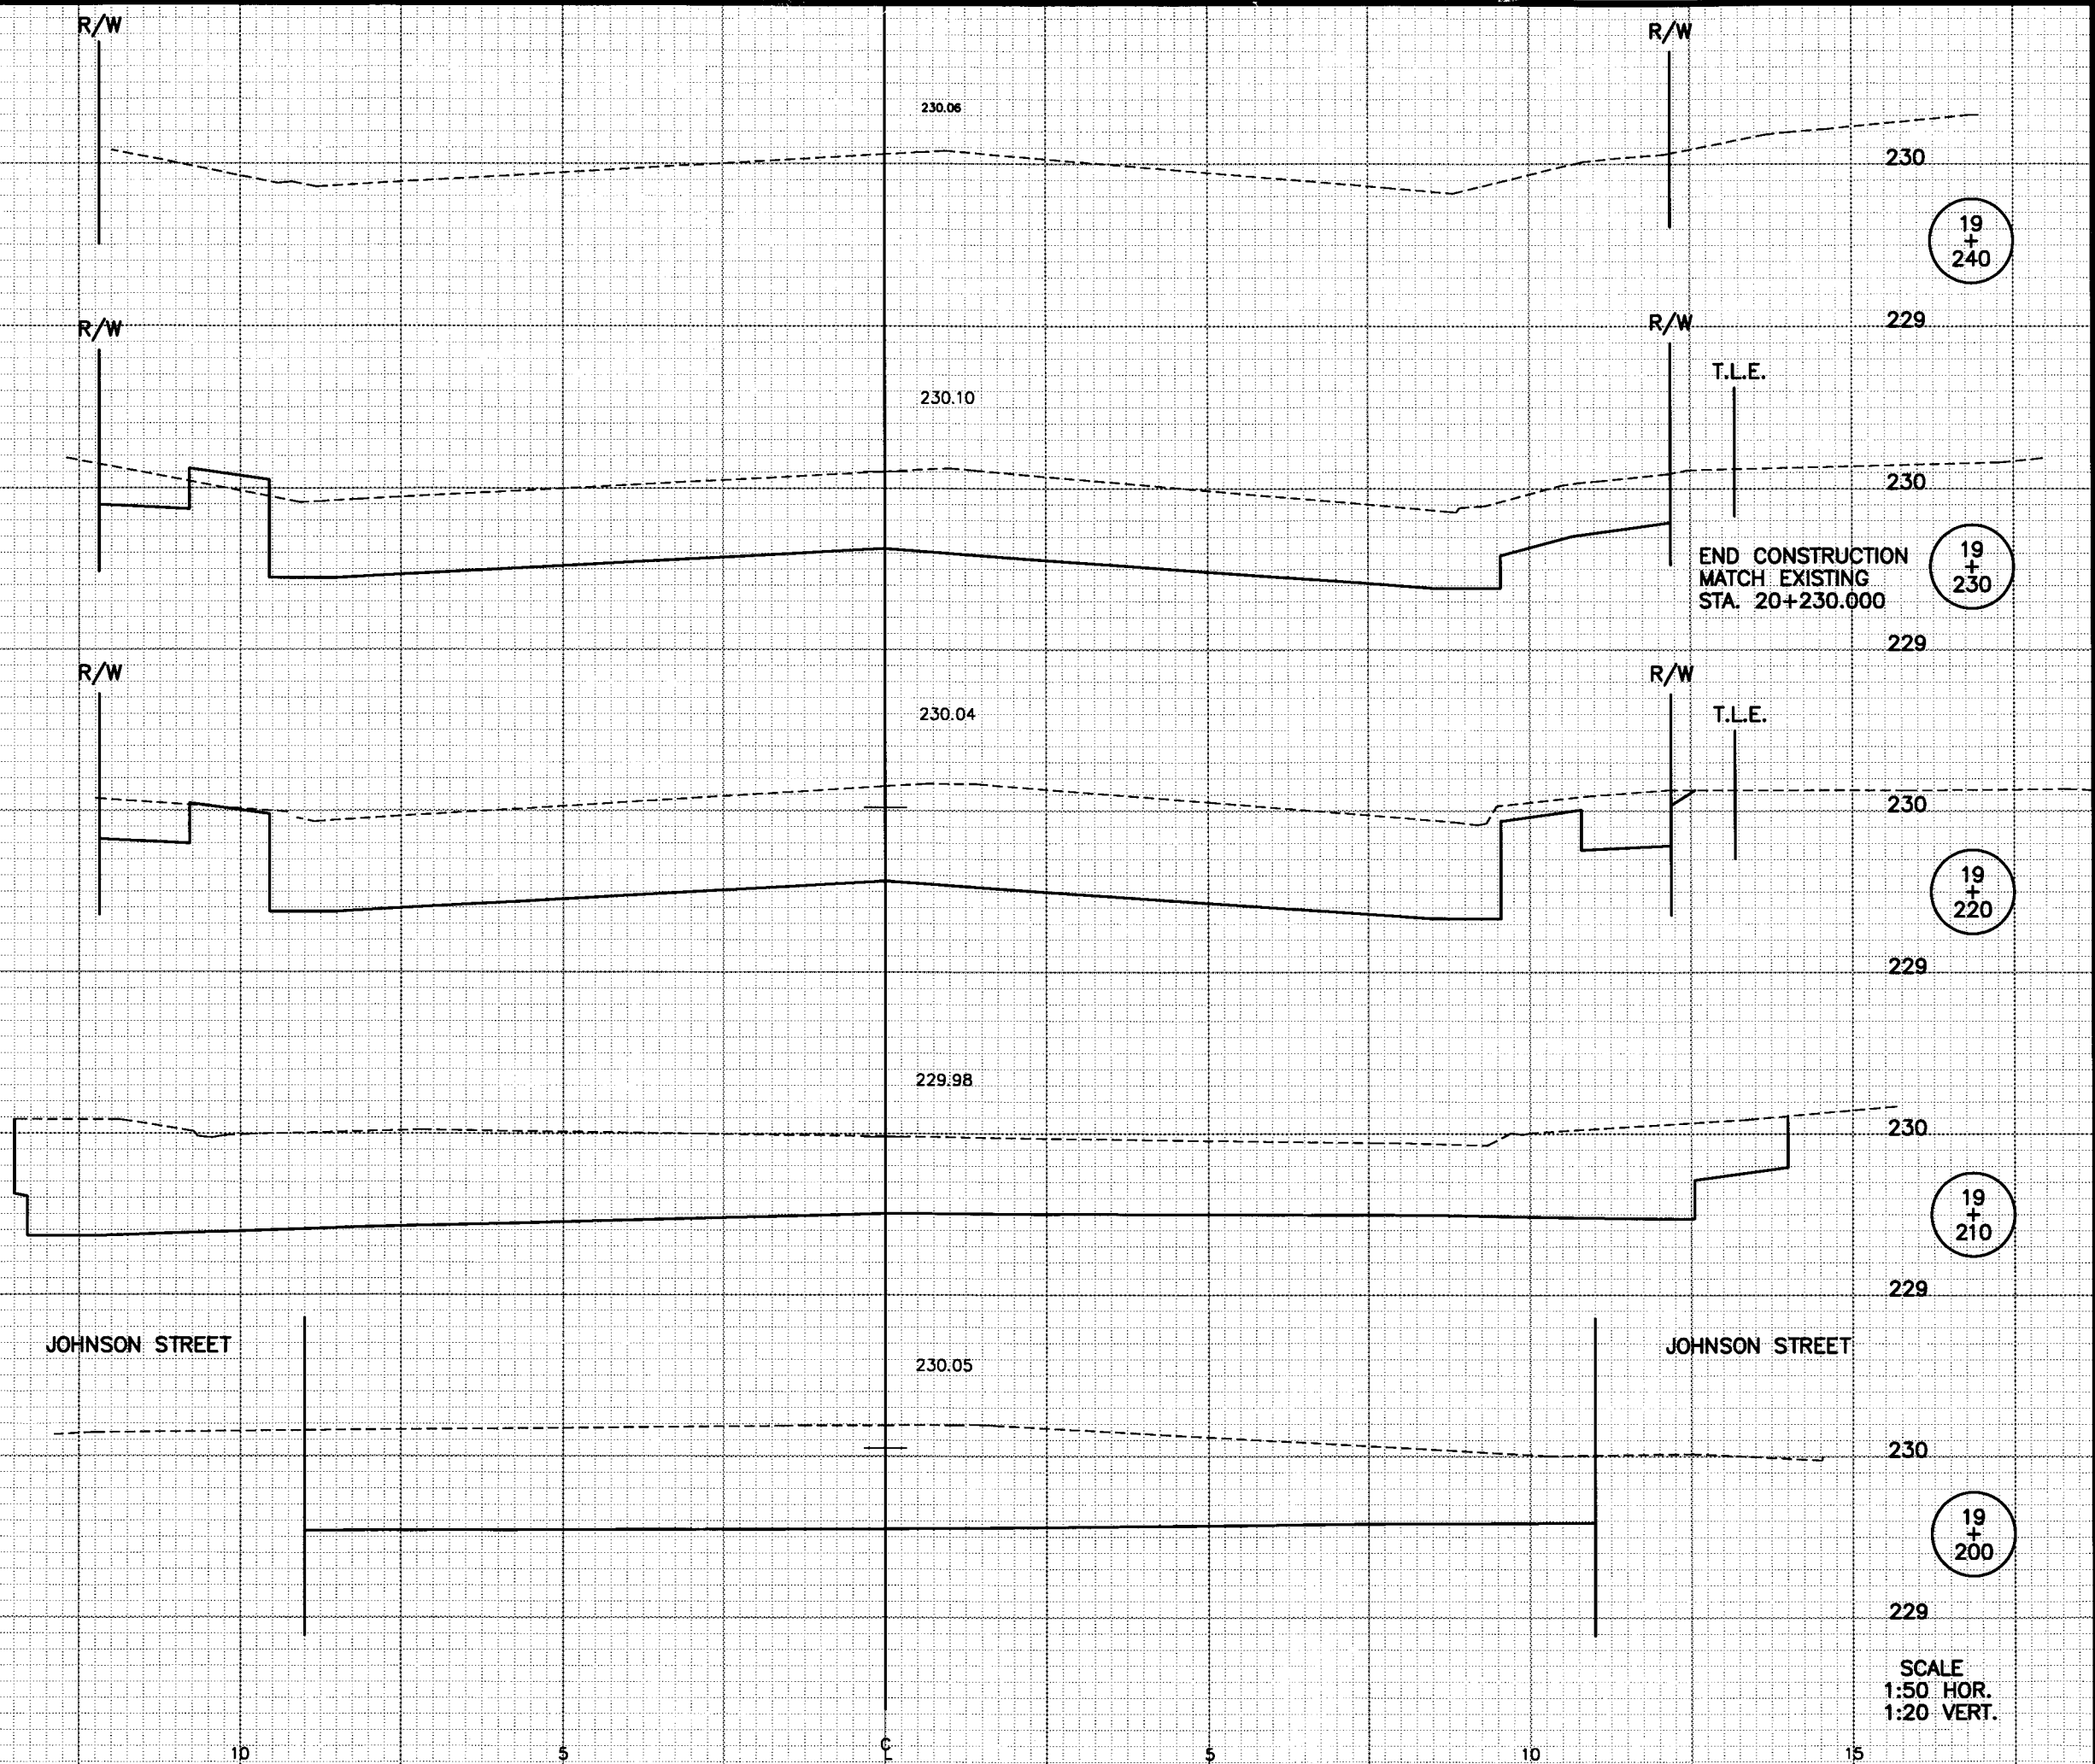


FINAL CROSS SECTIONS

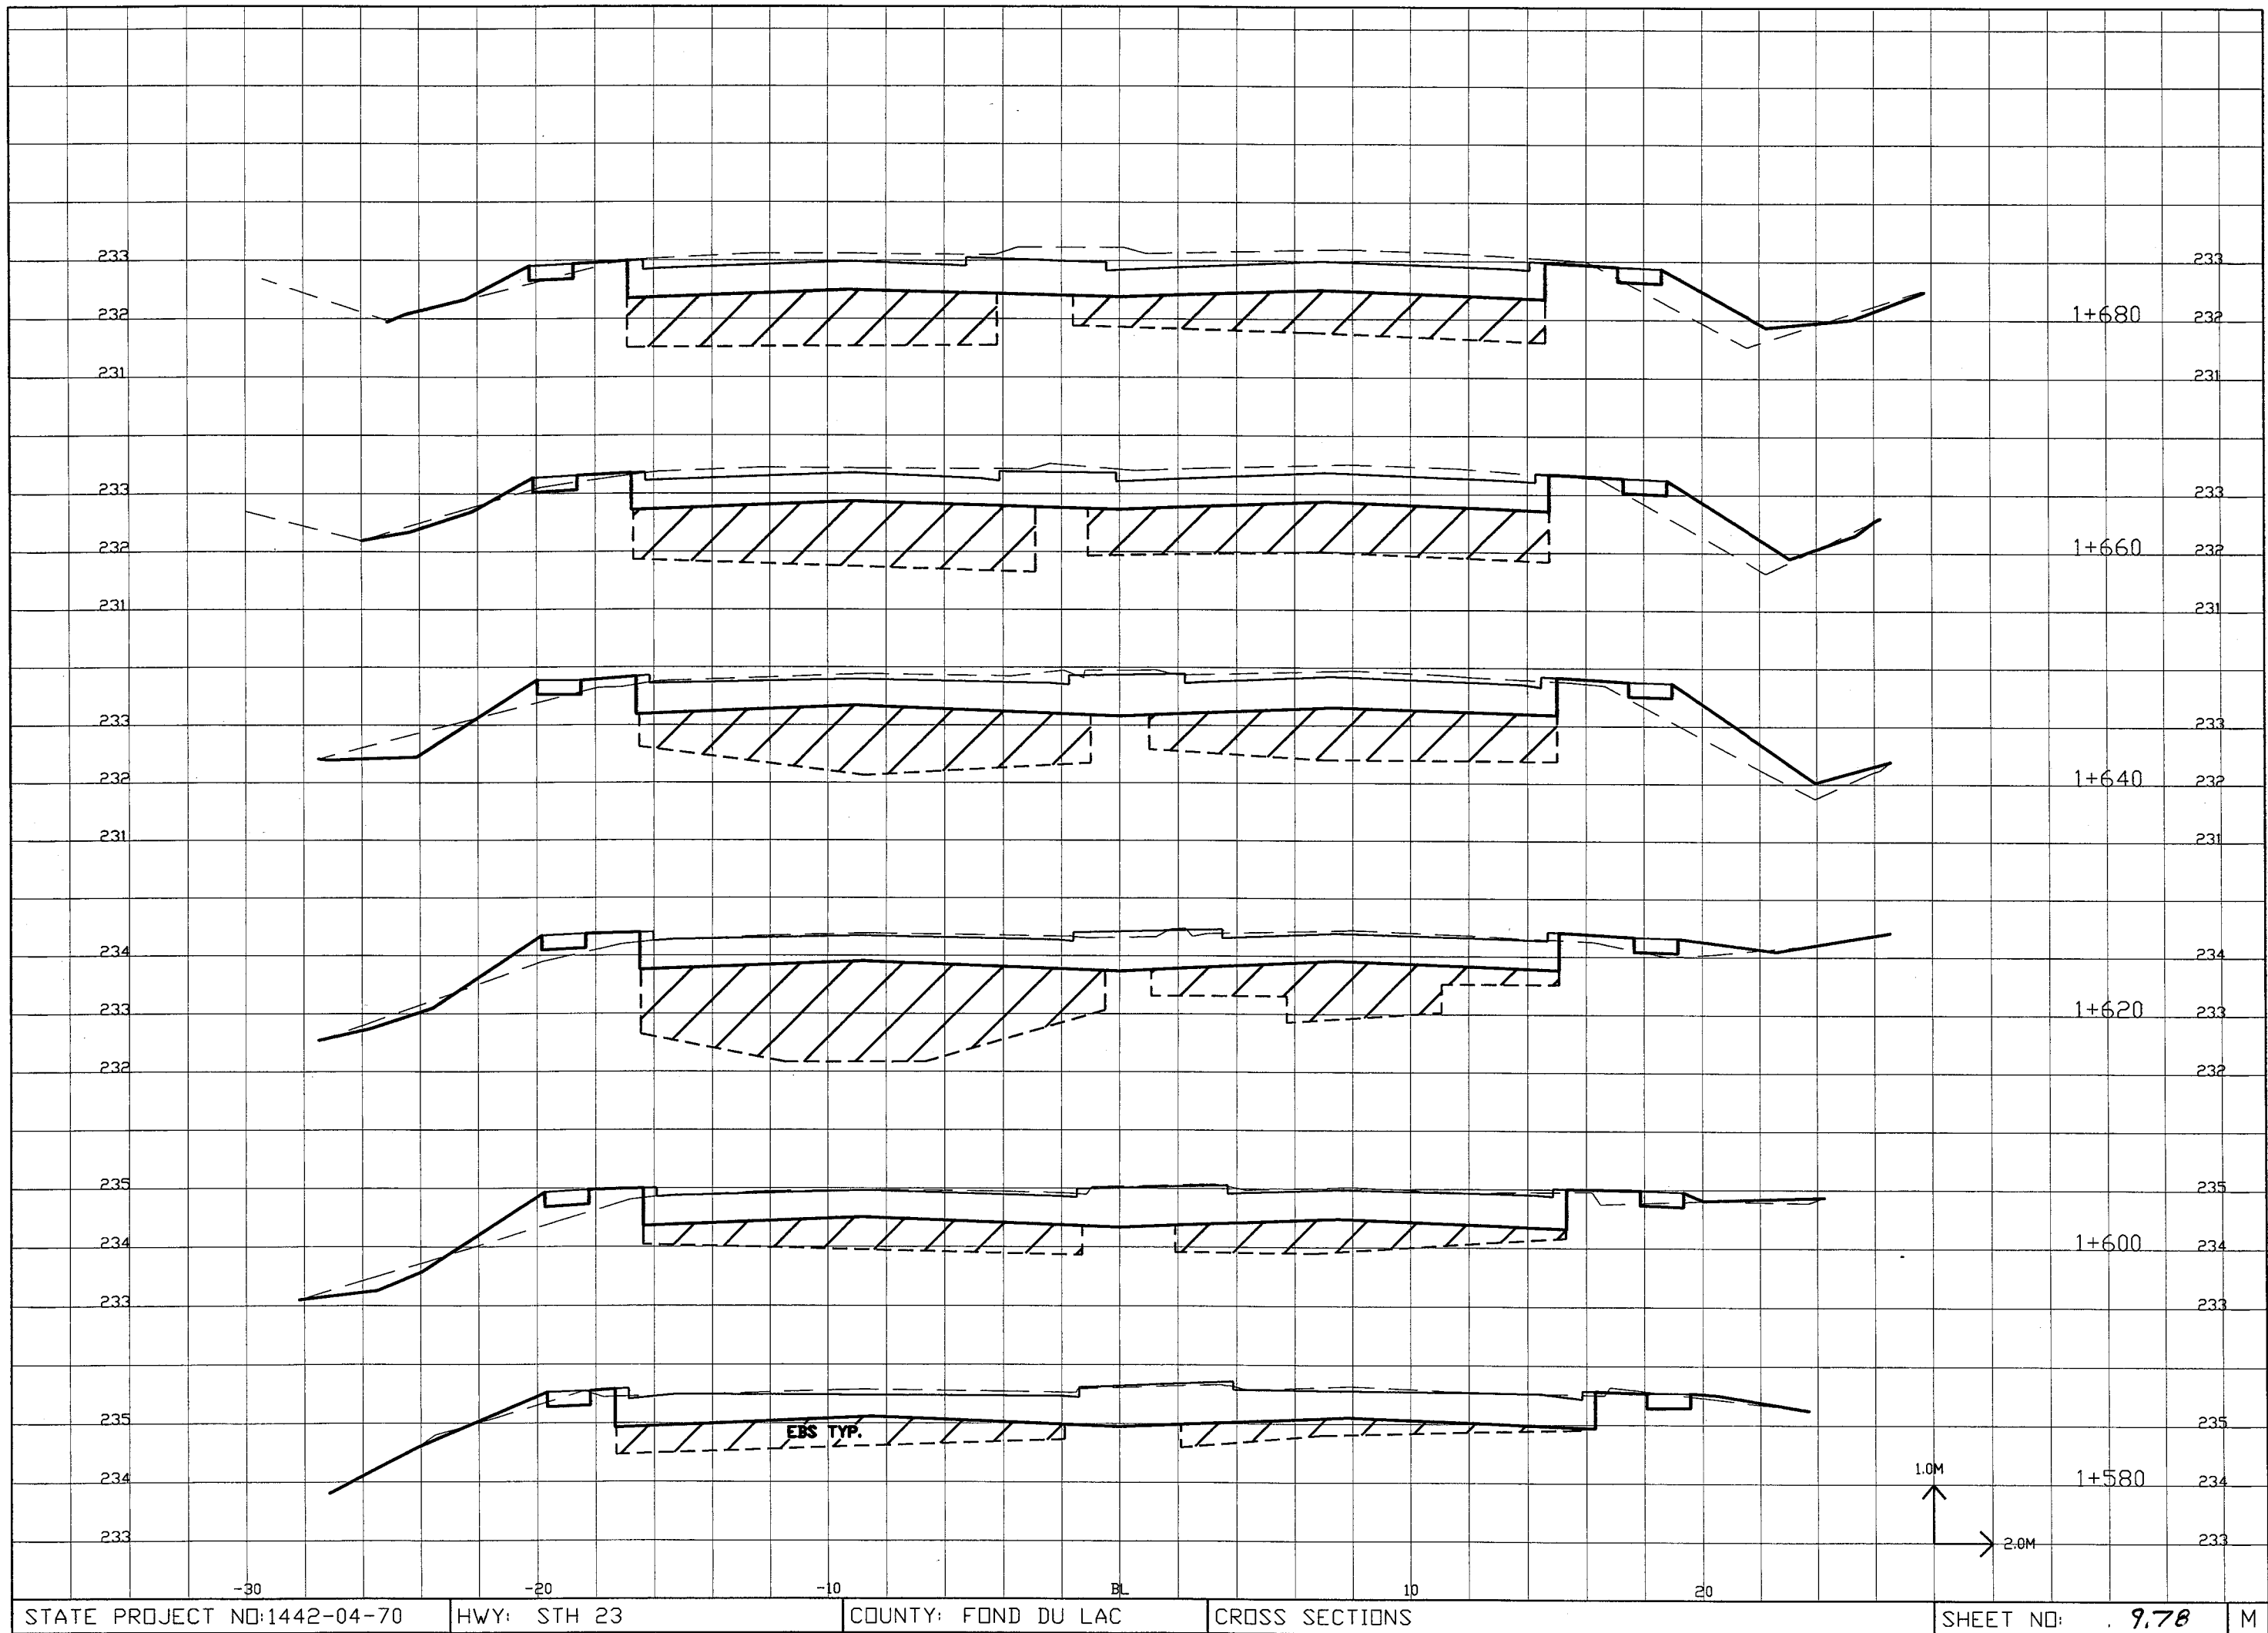

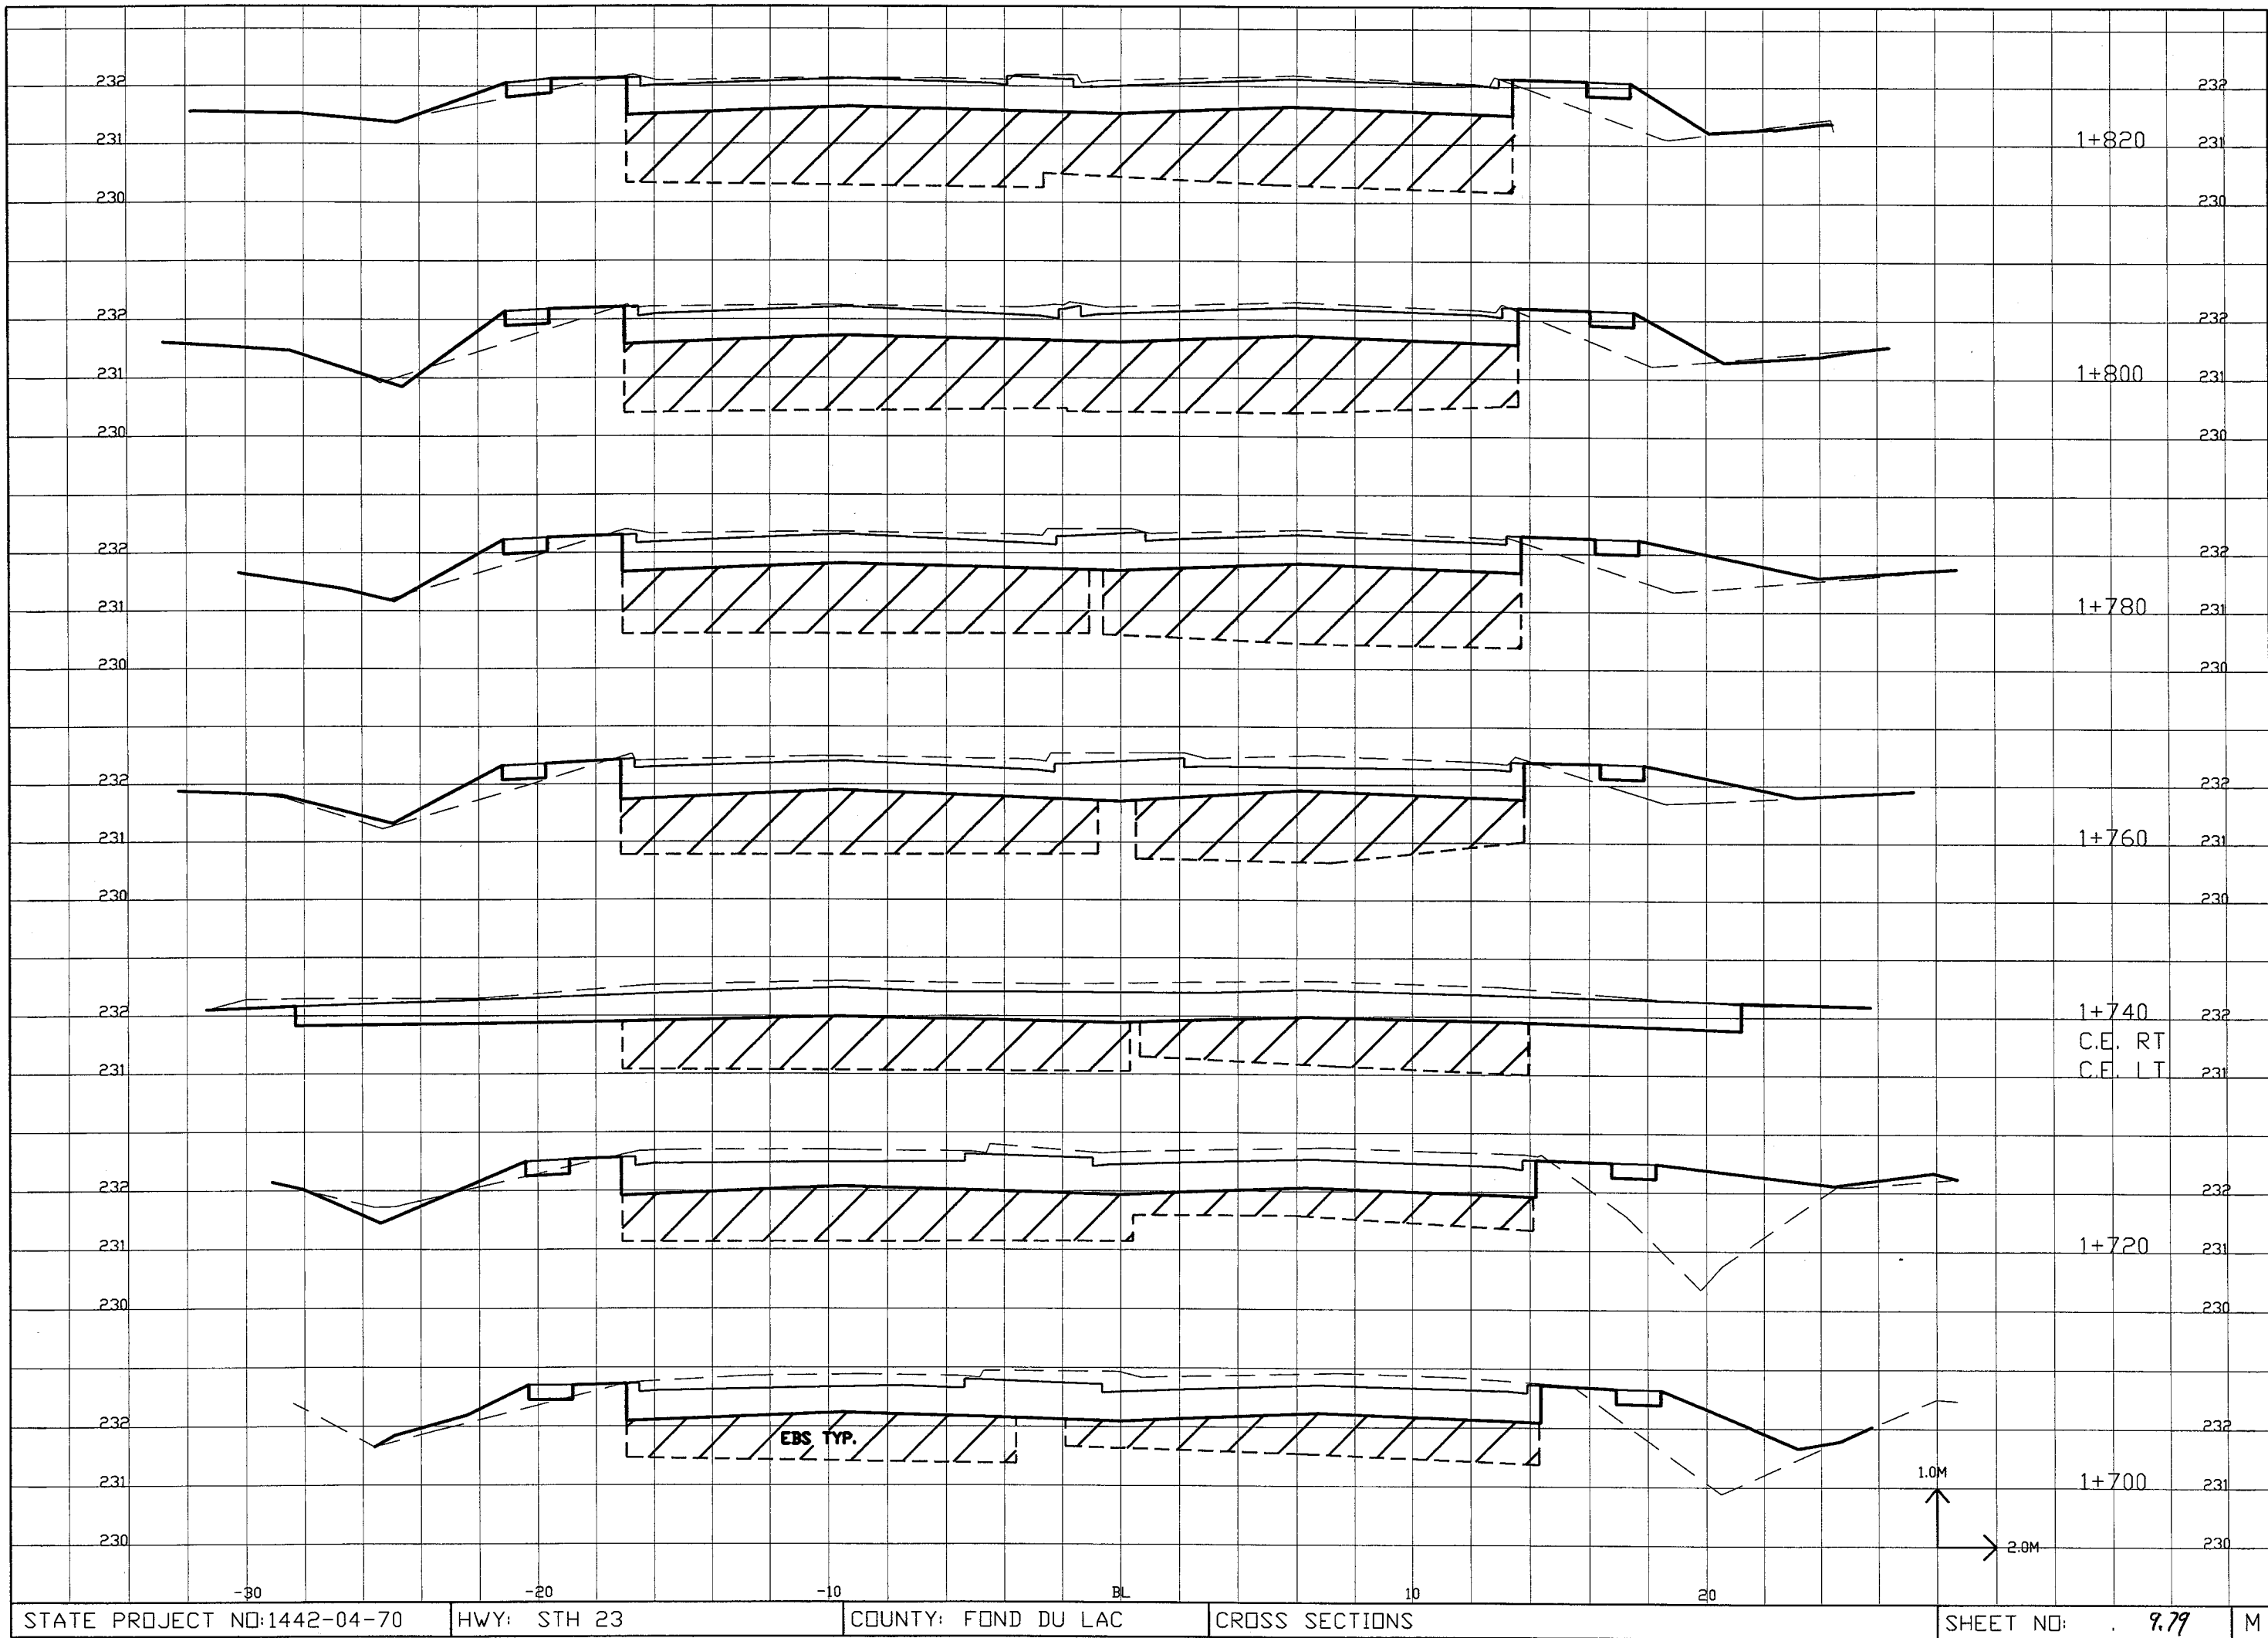

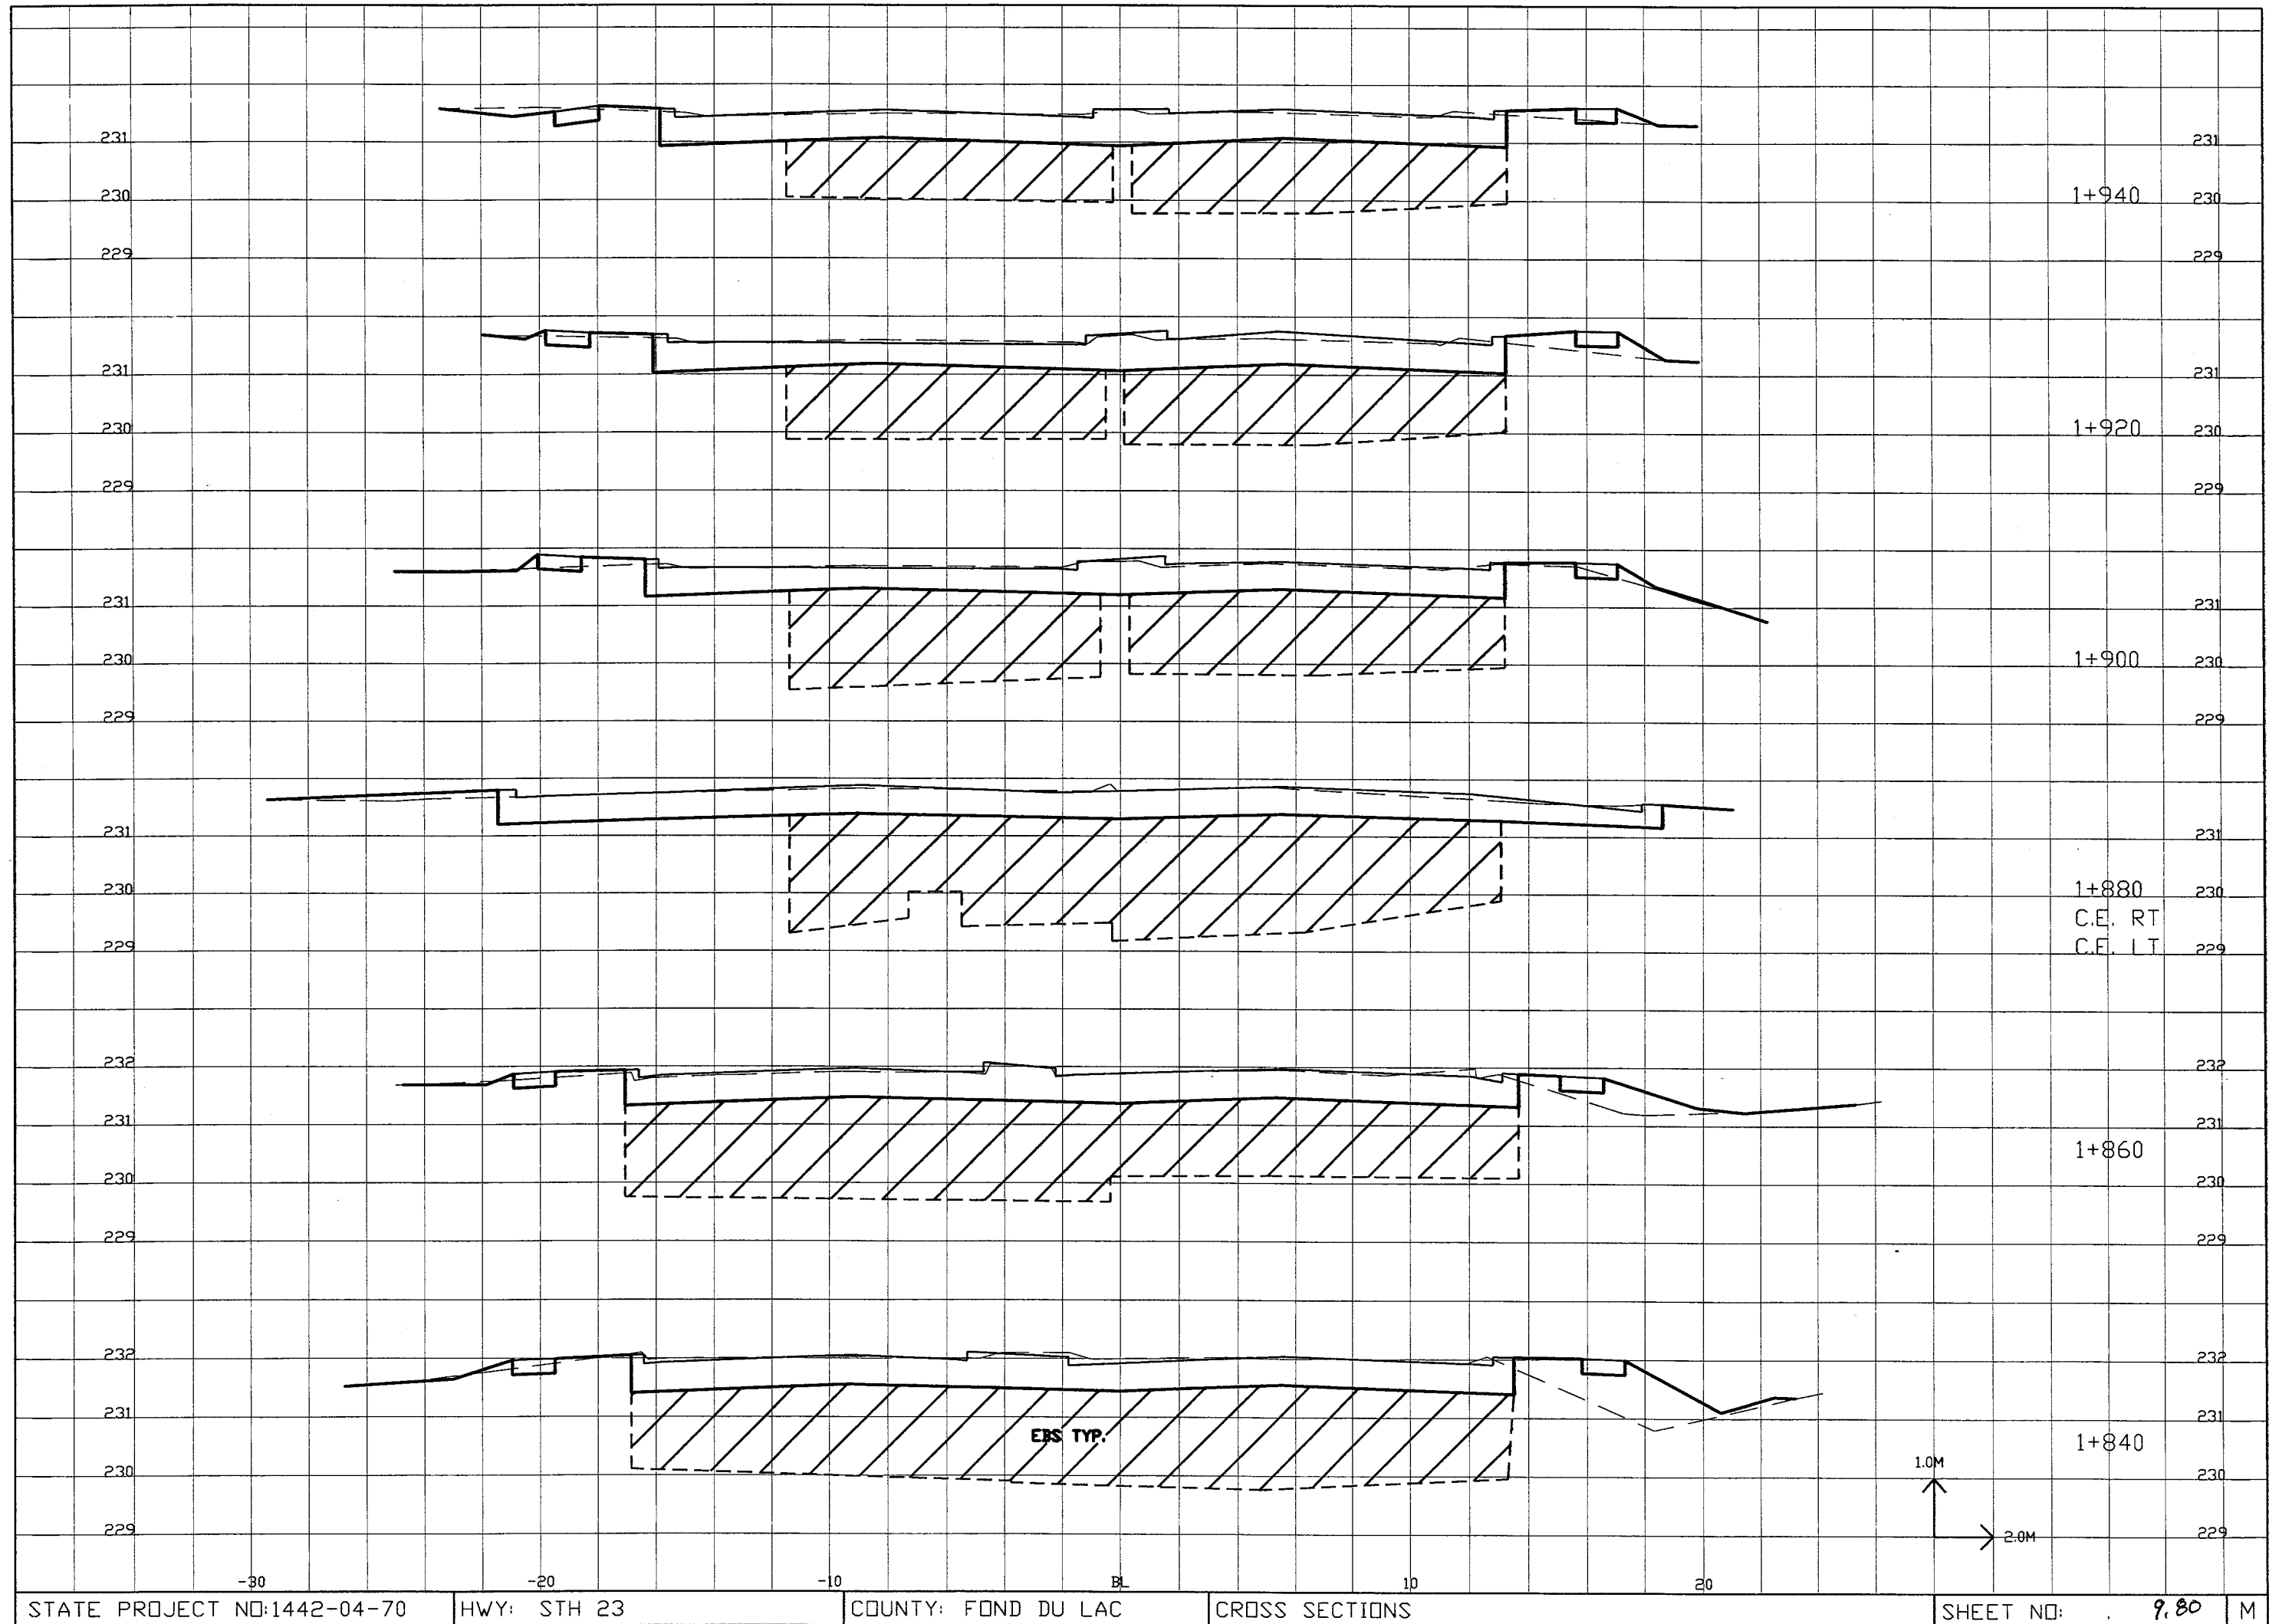

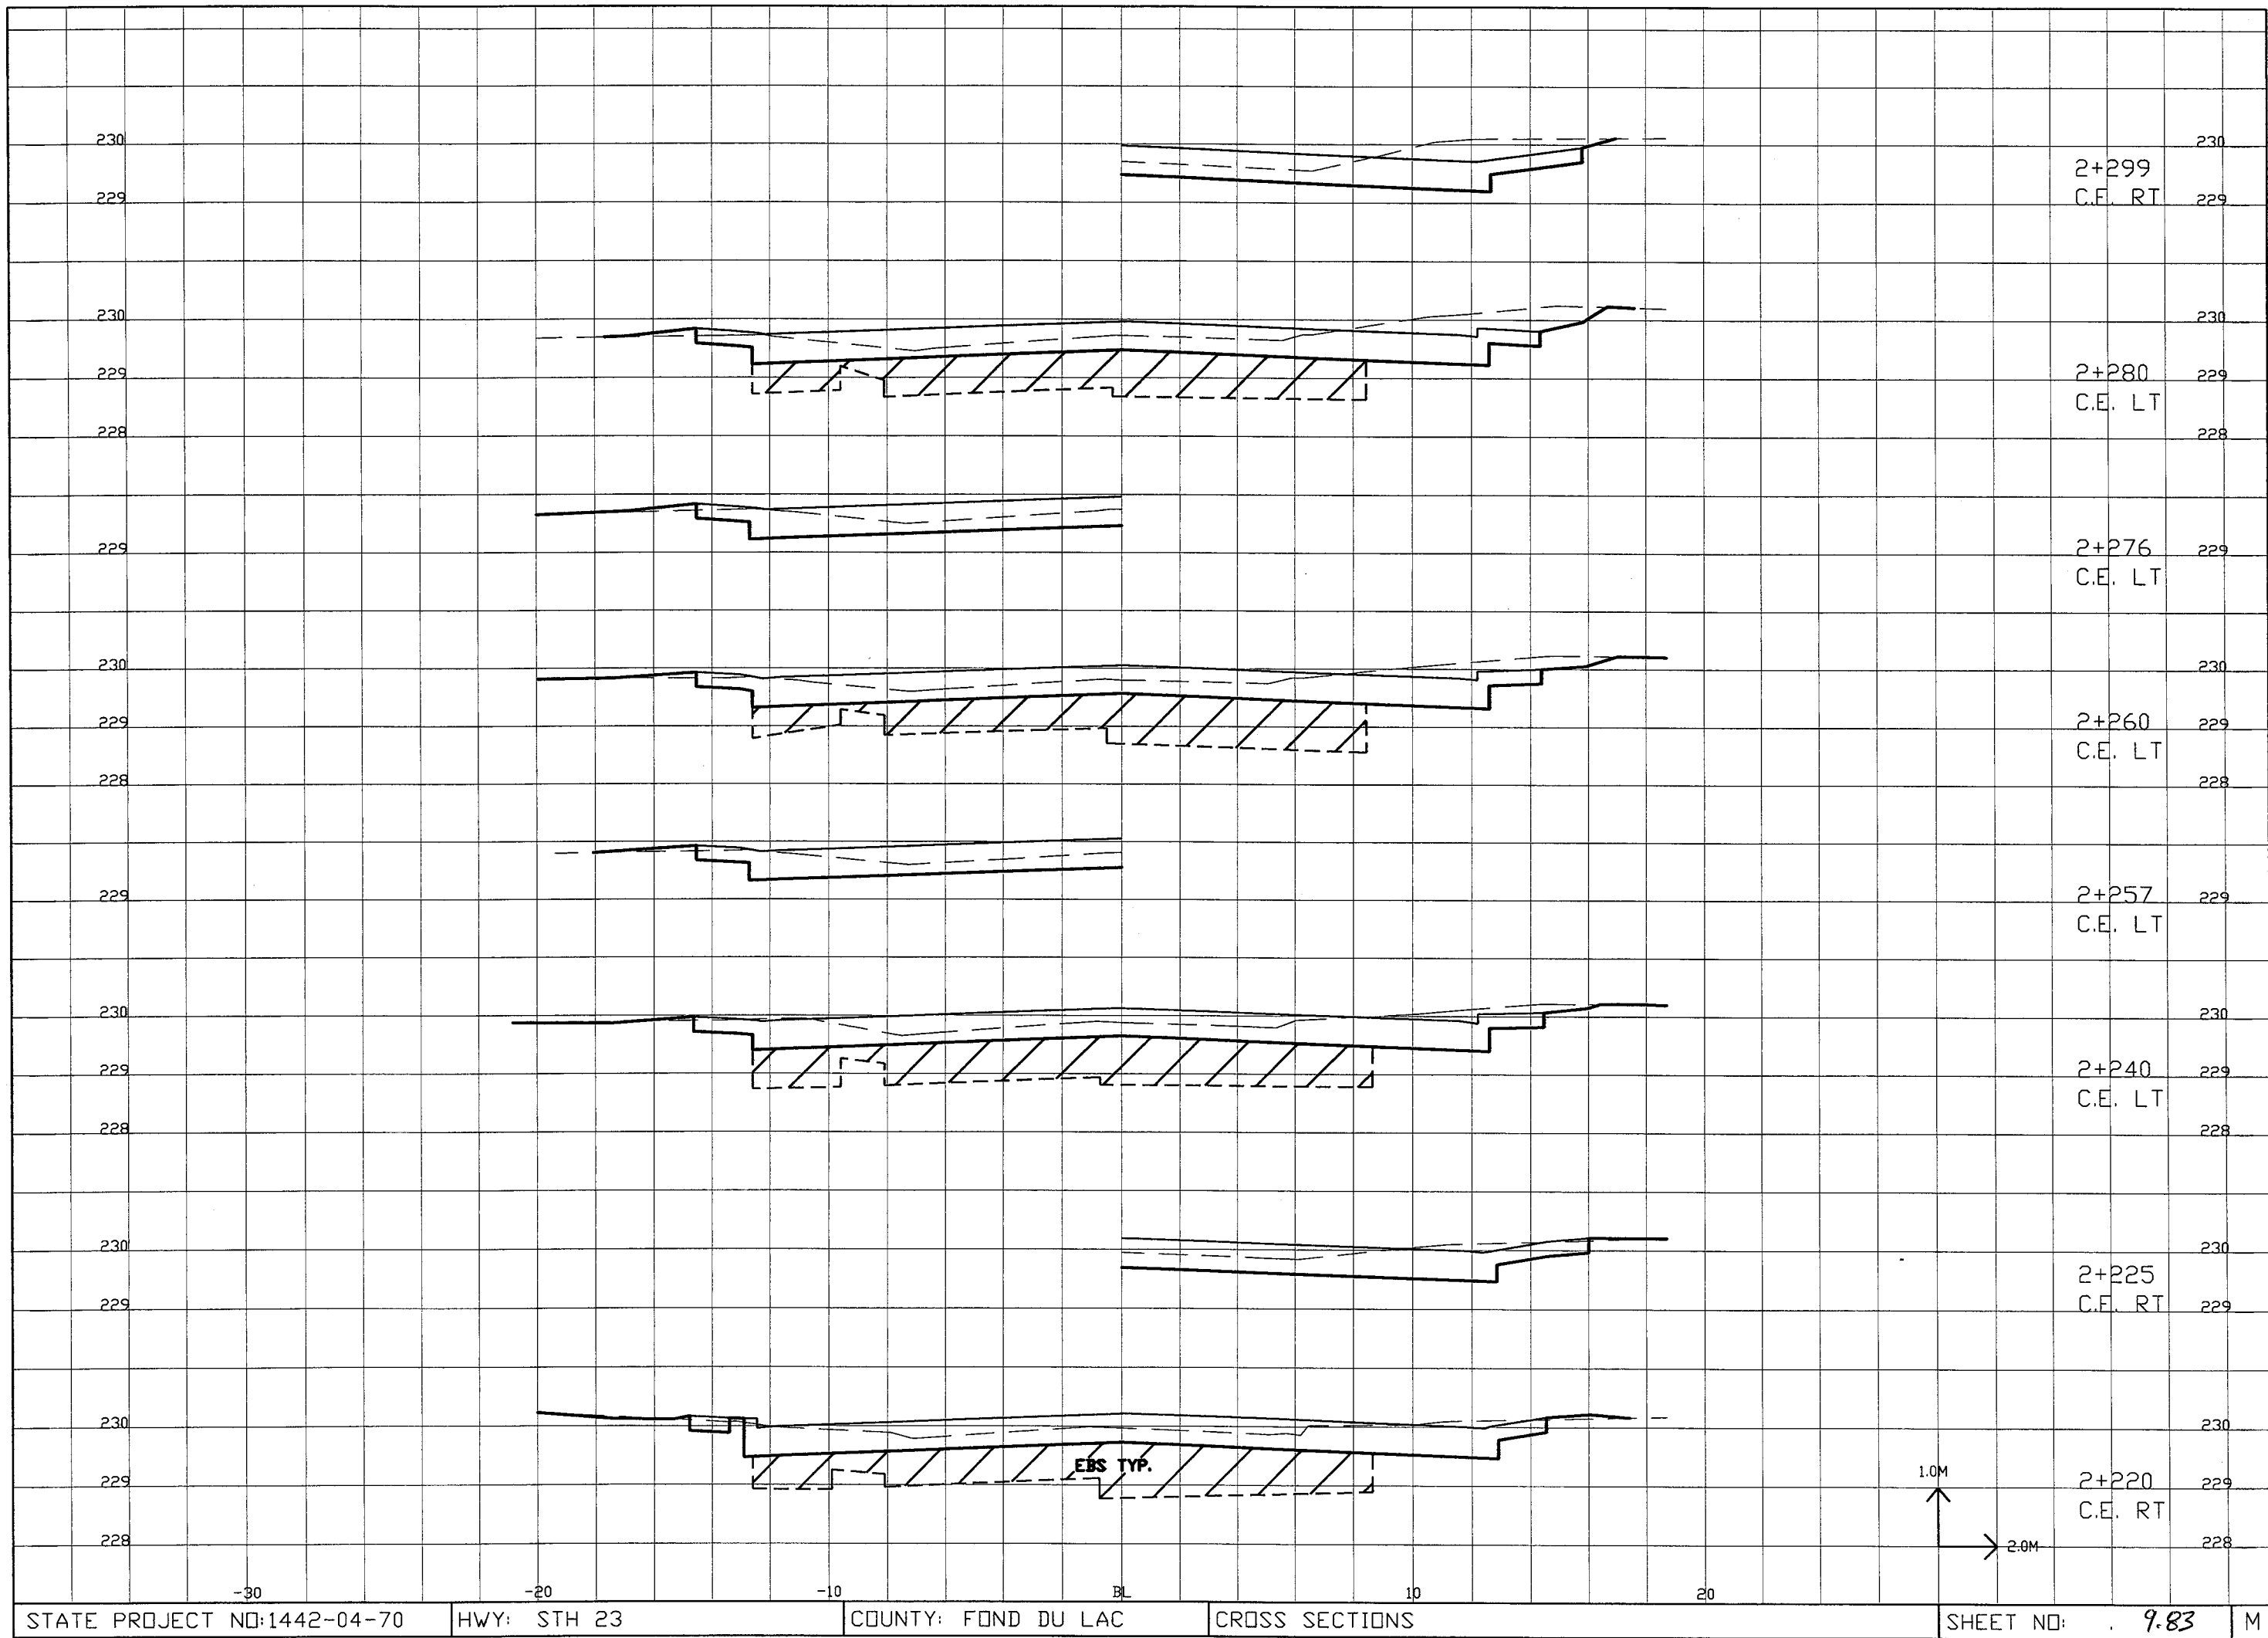

STATE PROJECT NO:1442-04-70


HWY: STH 23


COUNTY: FOND DU LAC


CROSS SECTIONS


SHEET NO: 9.83

M

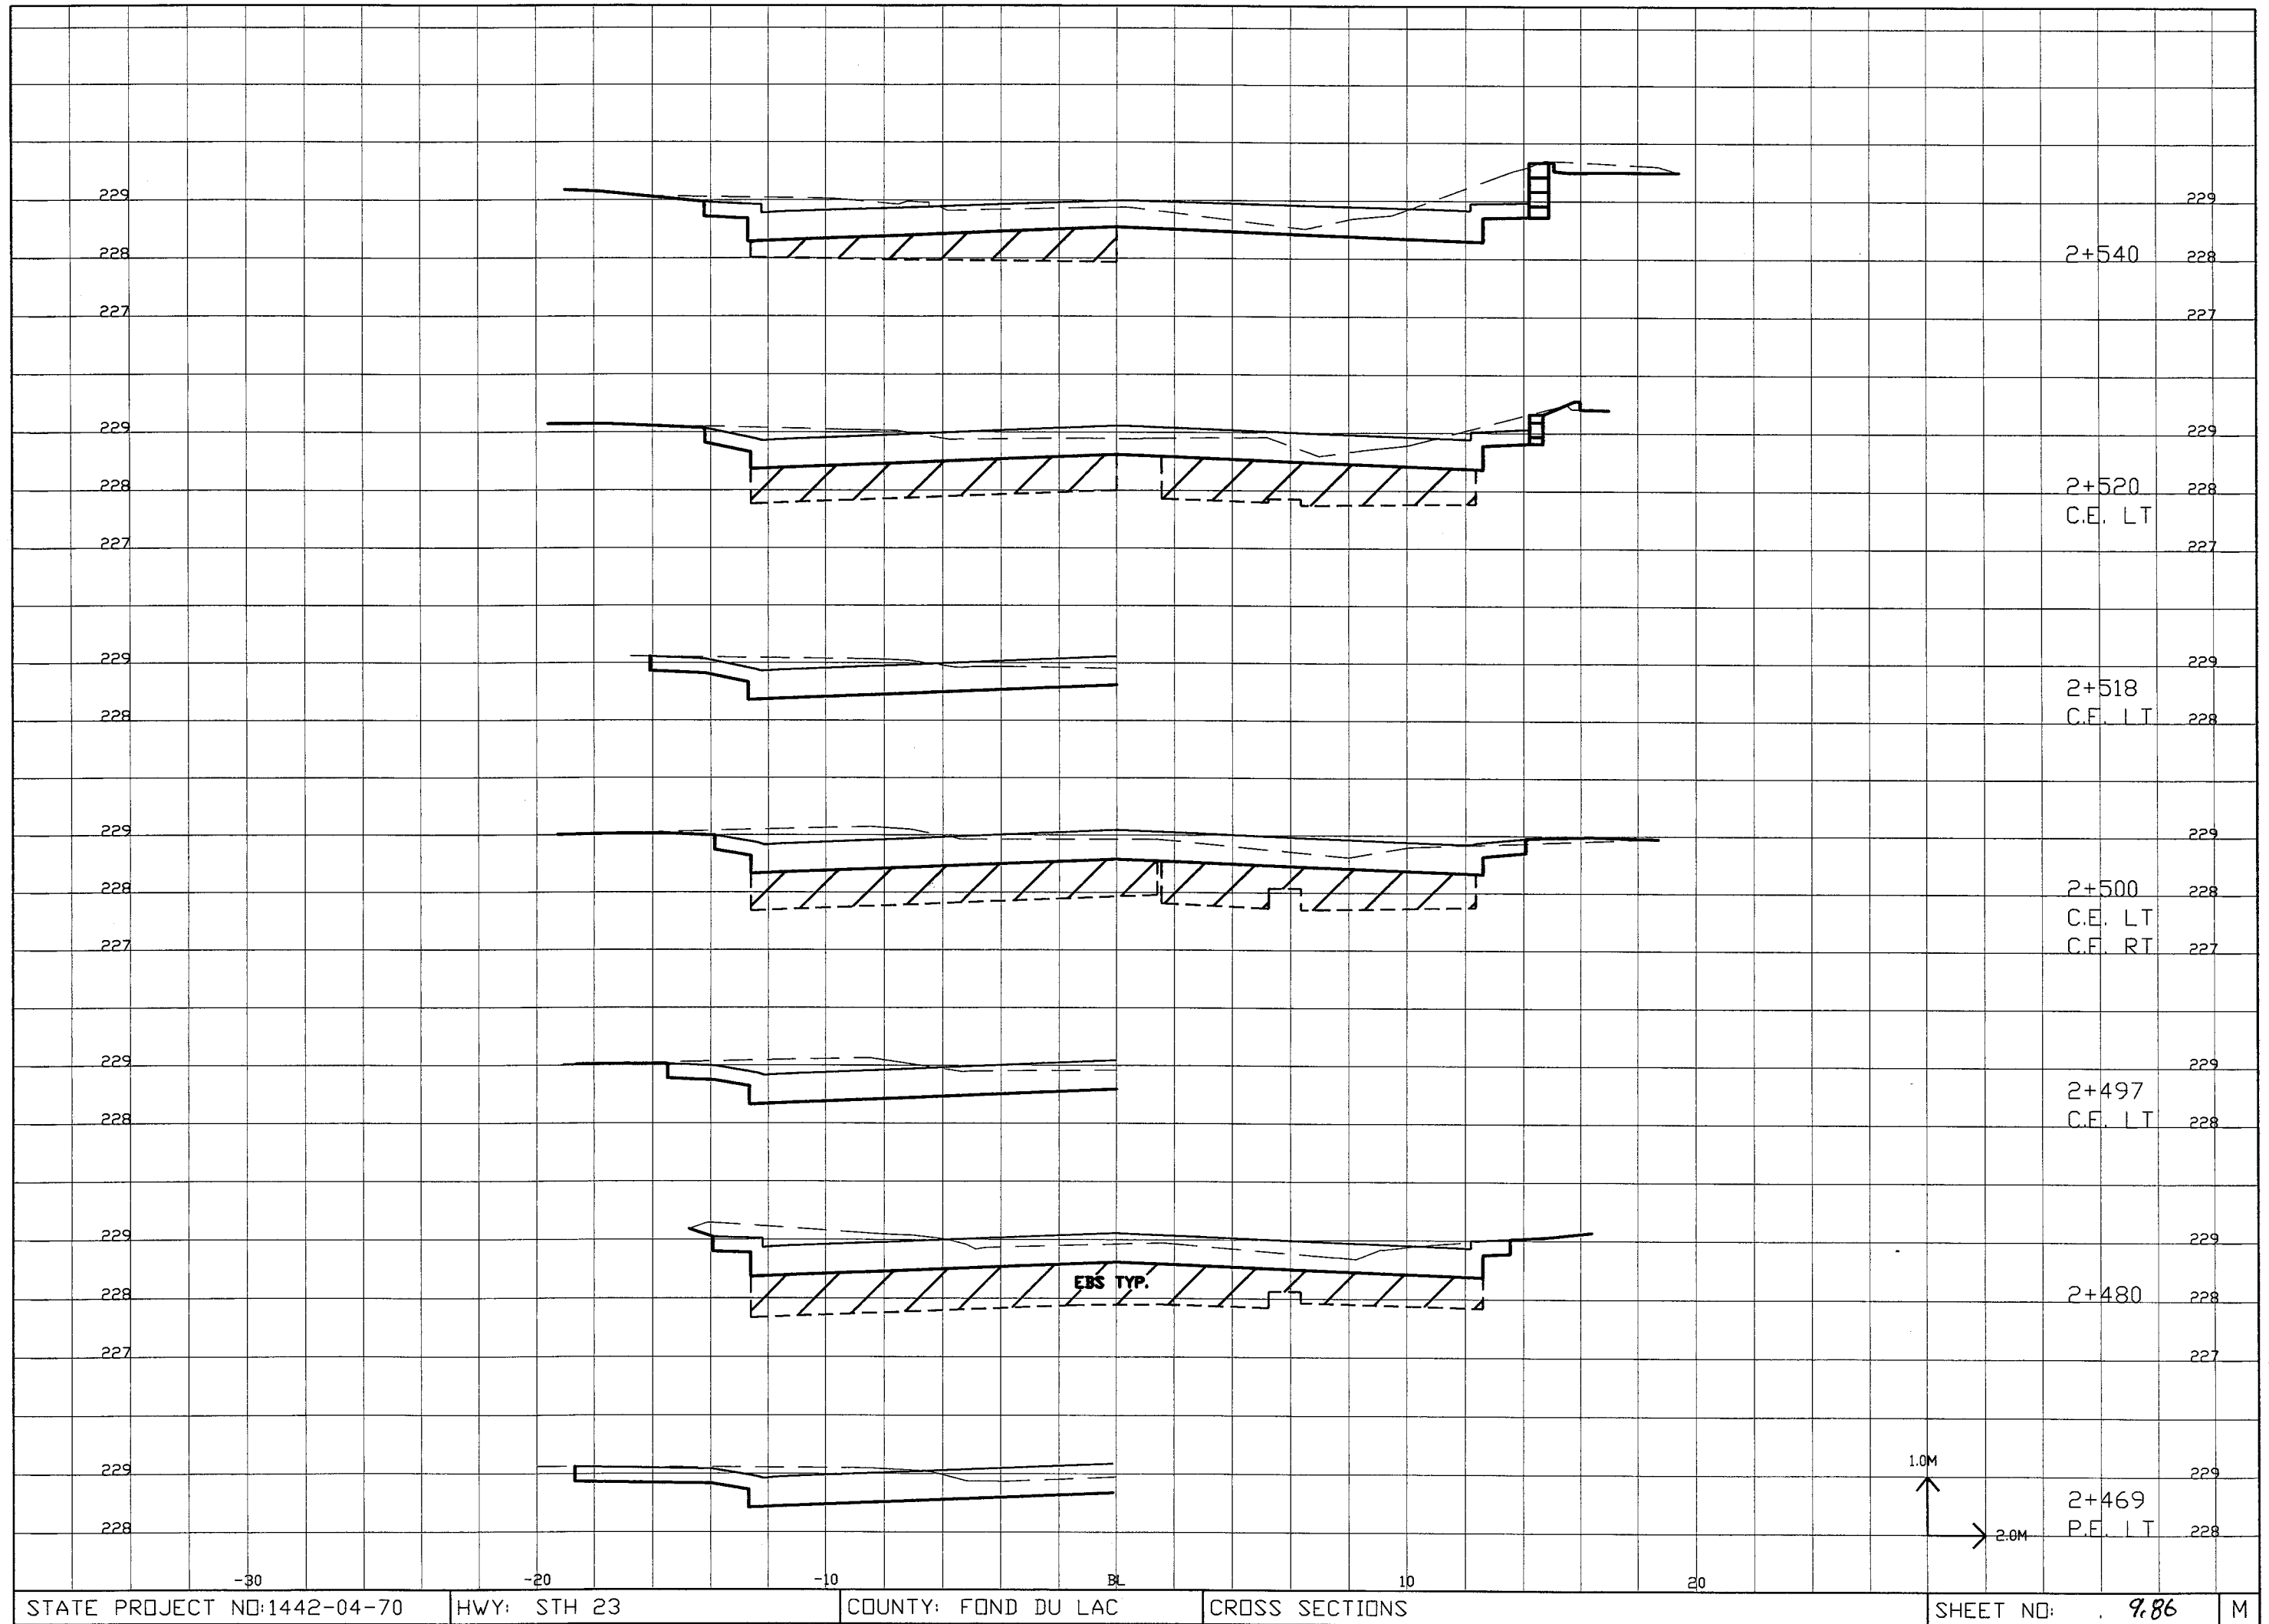


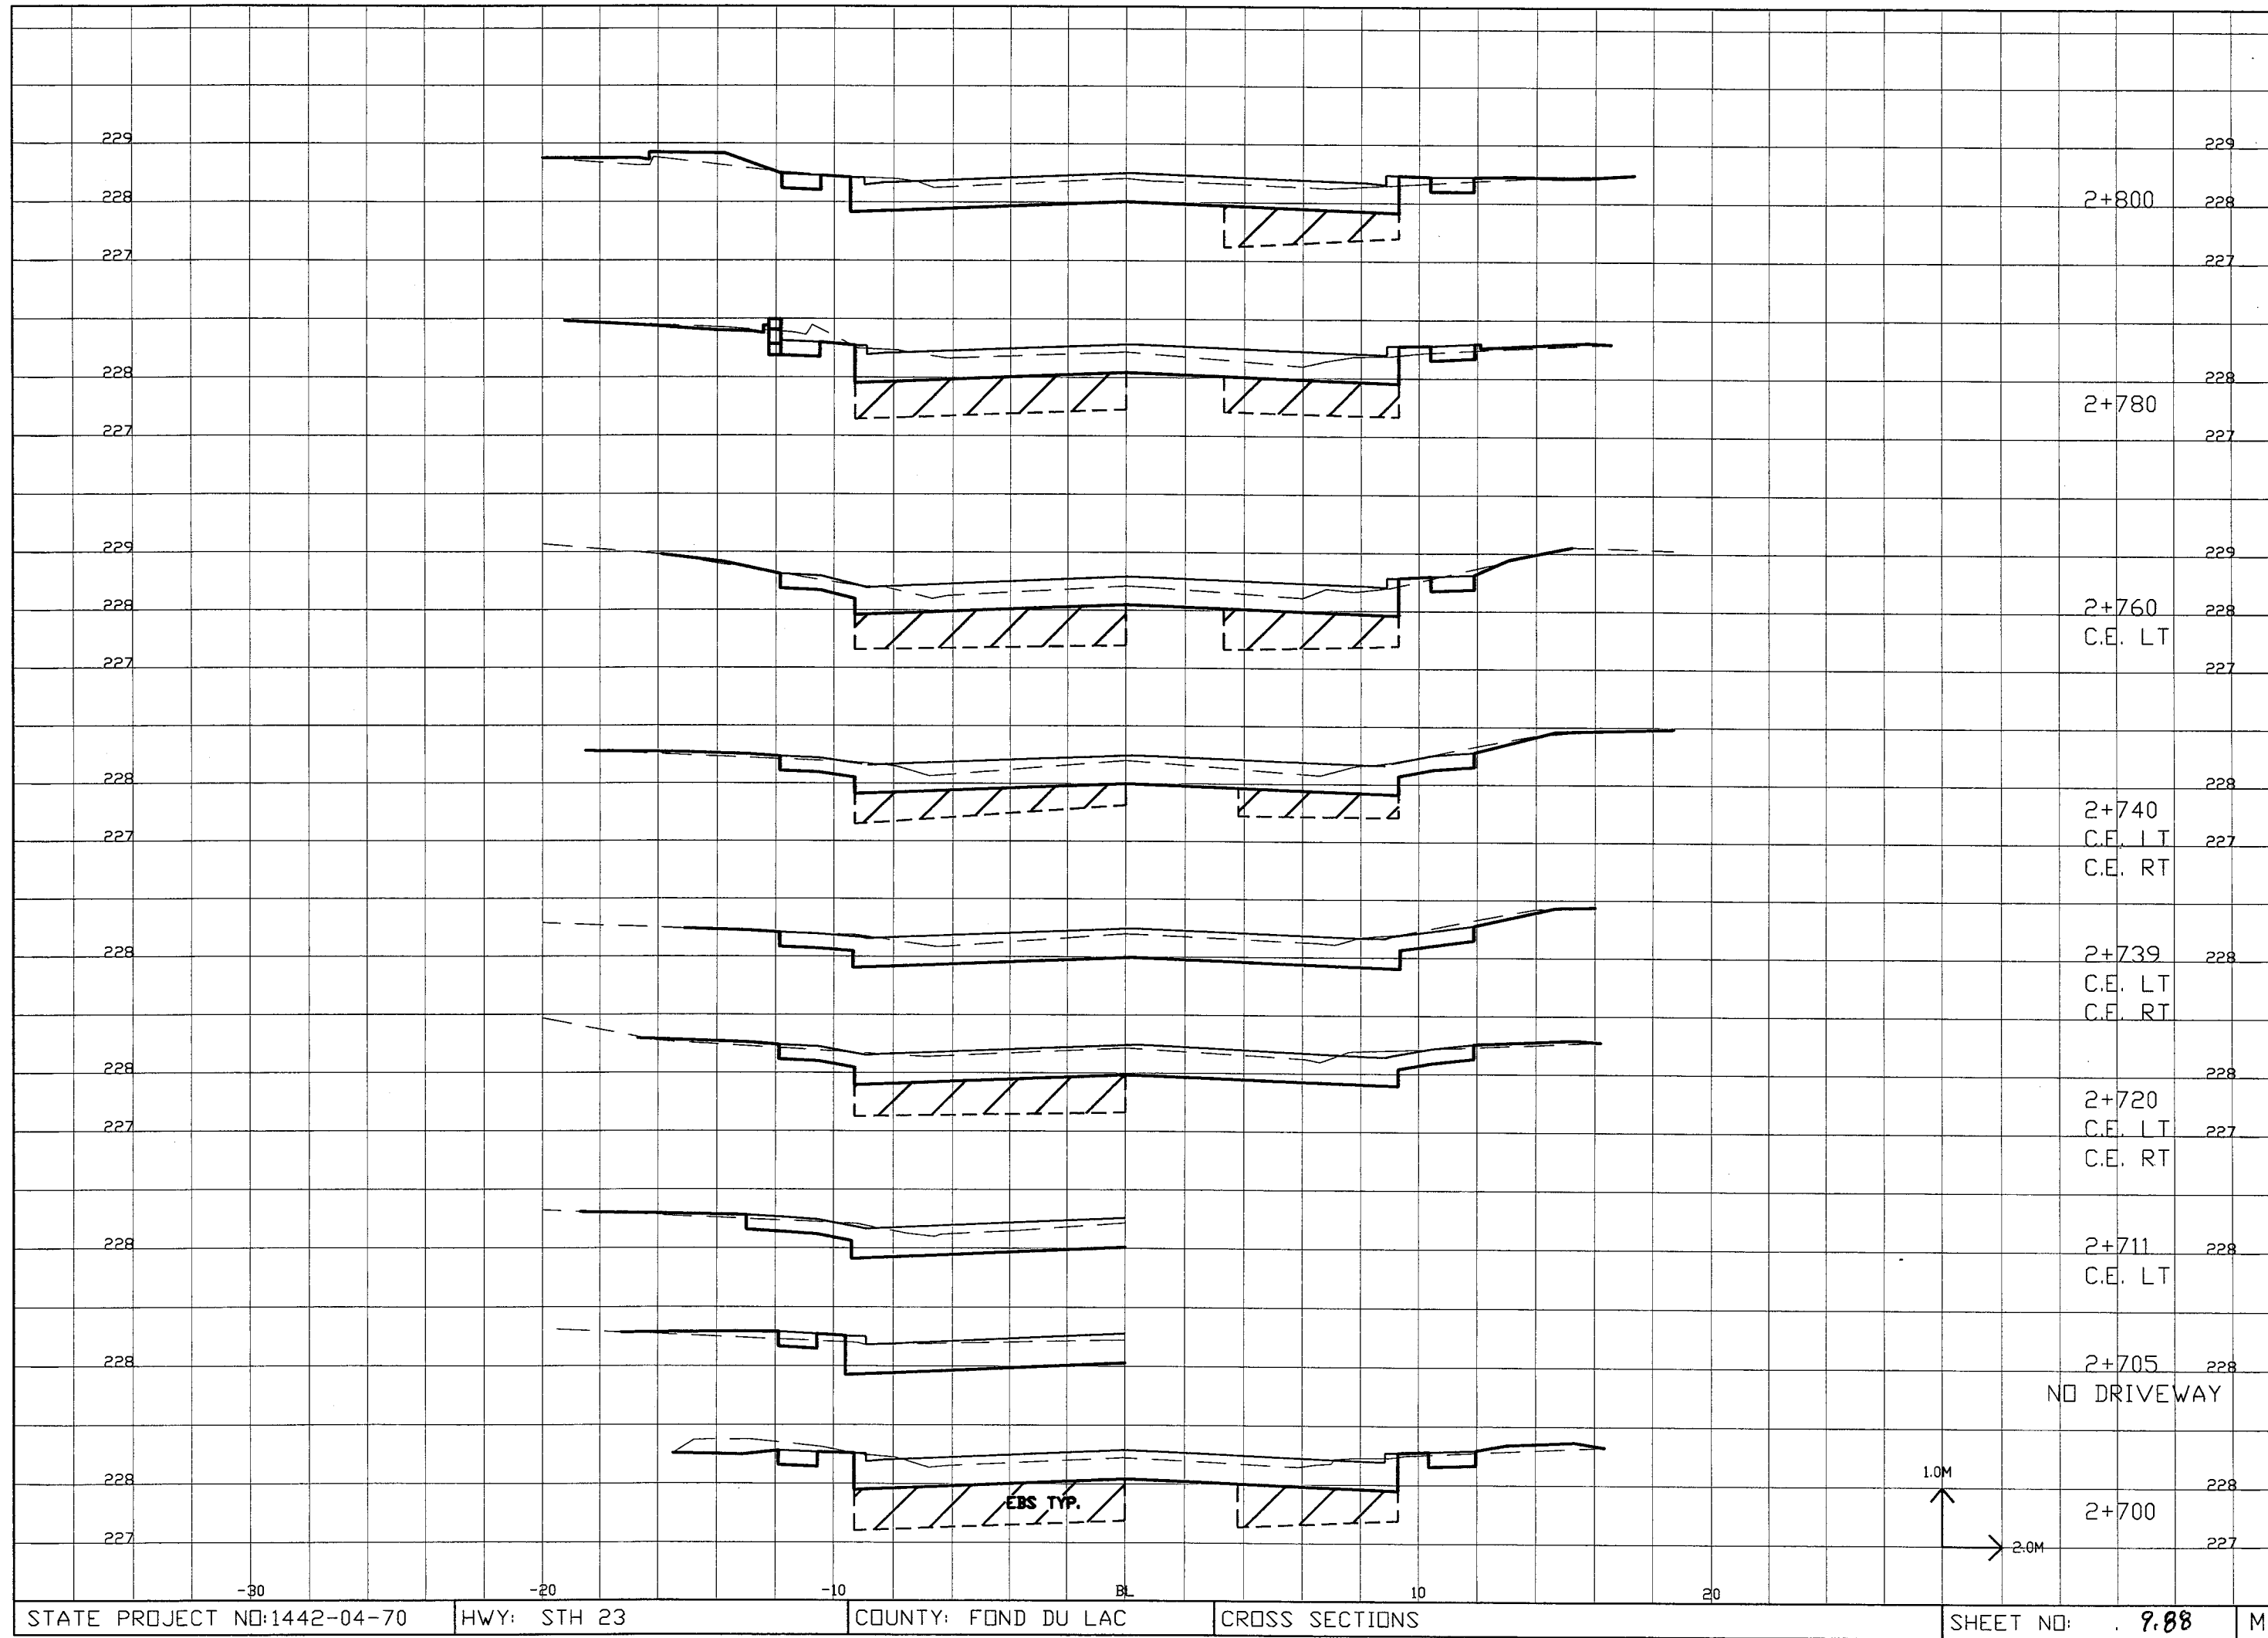

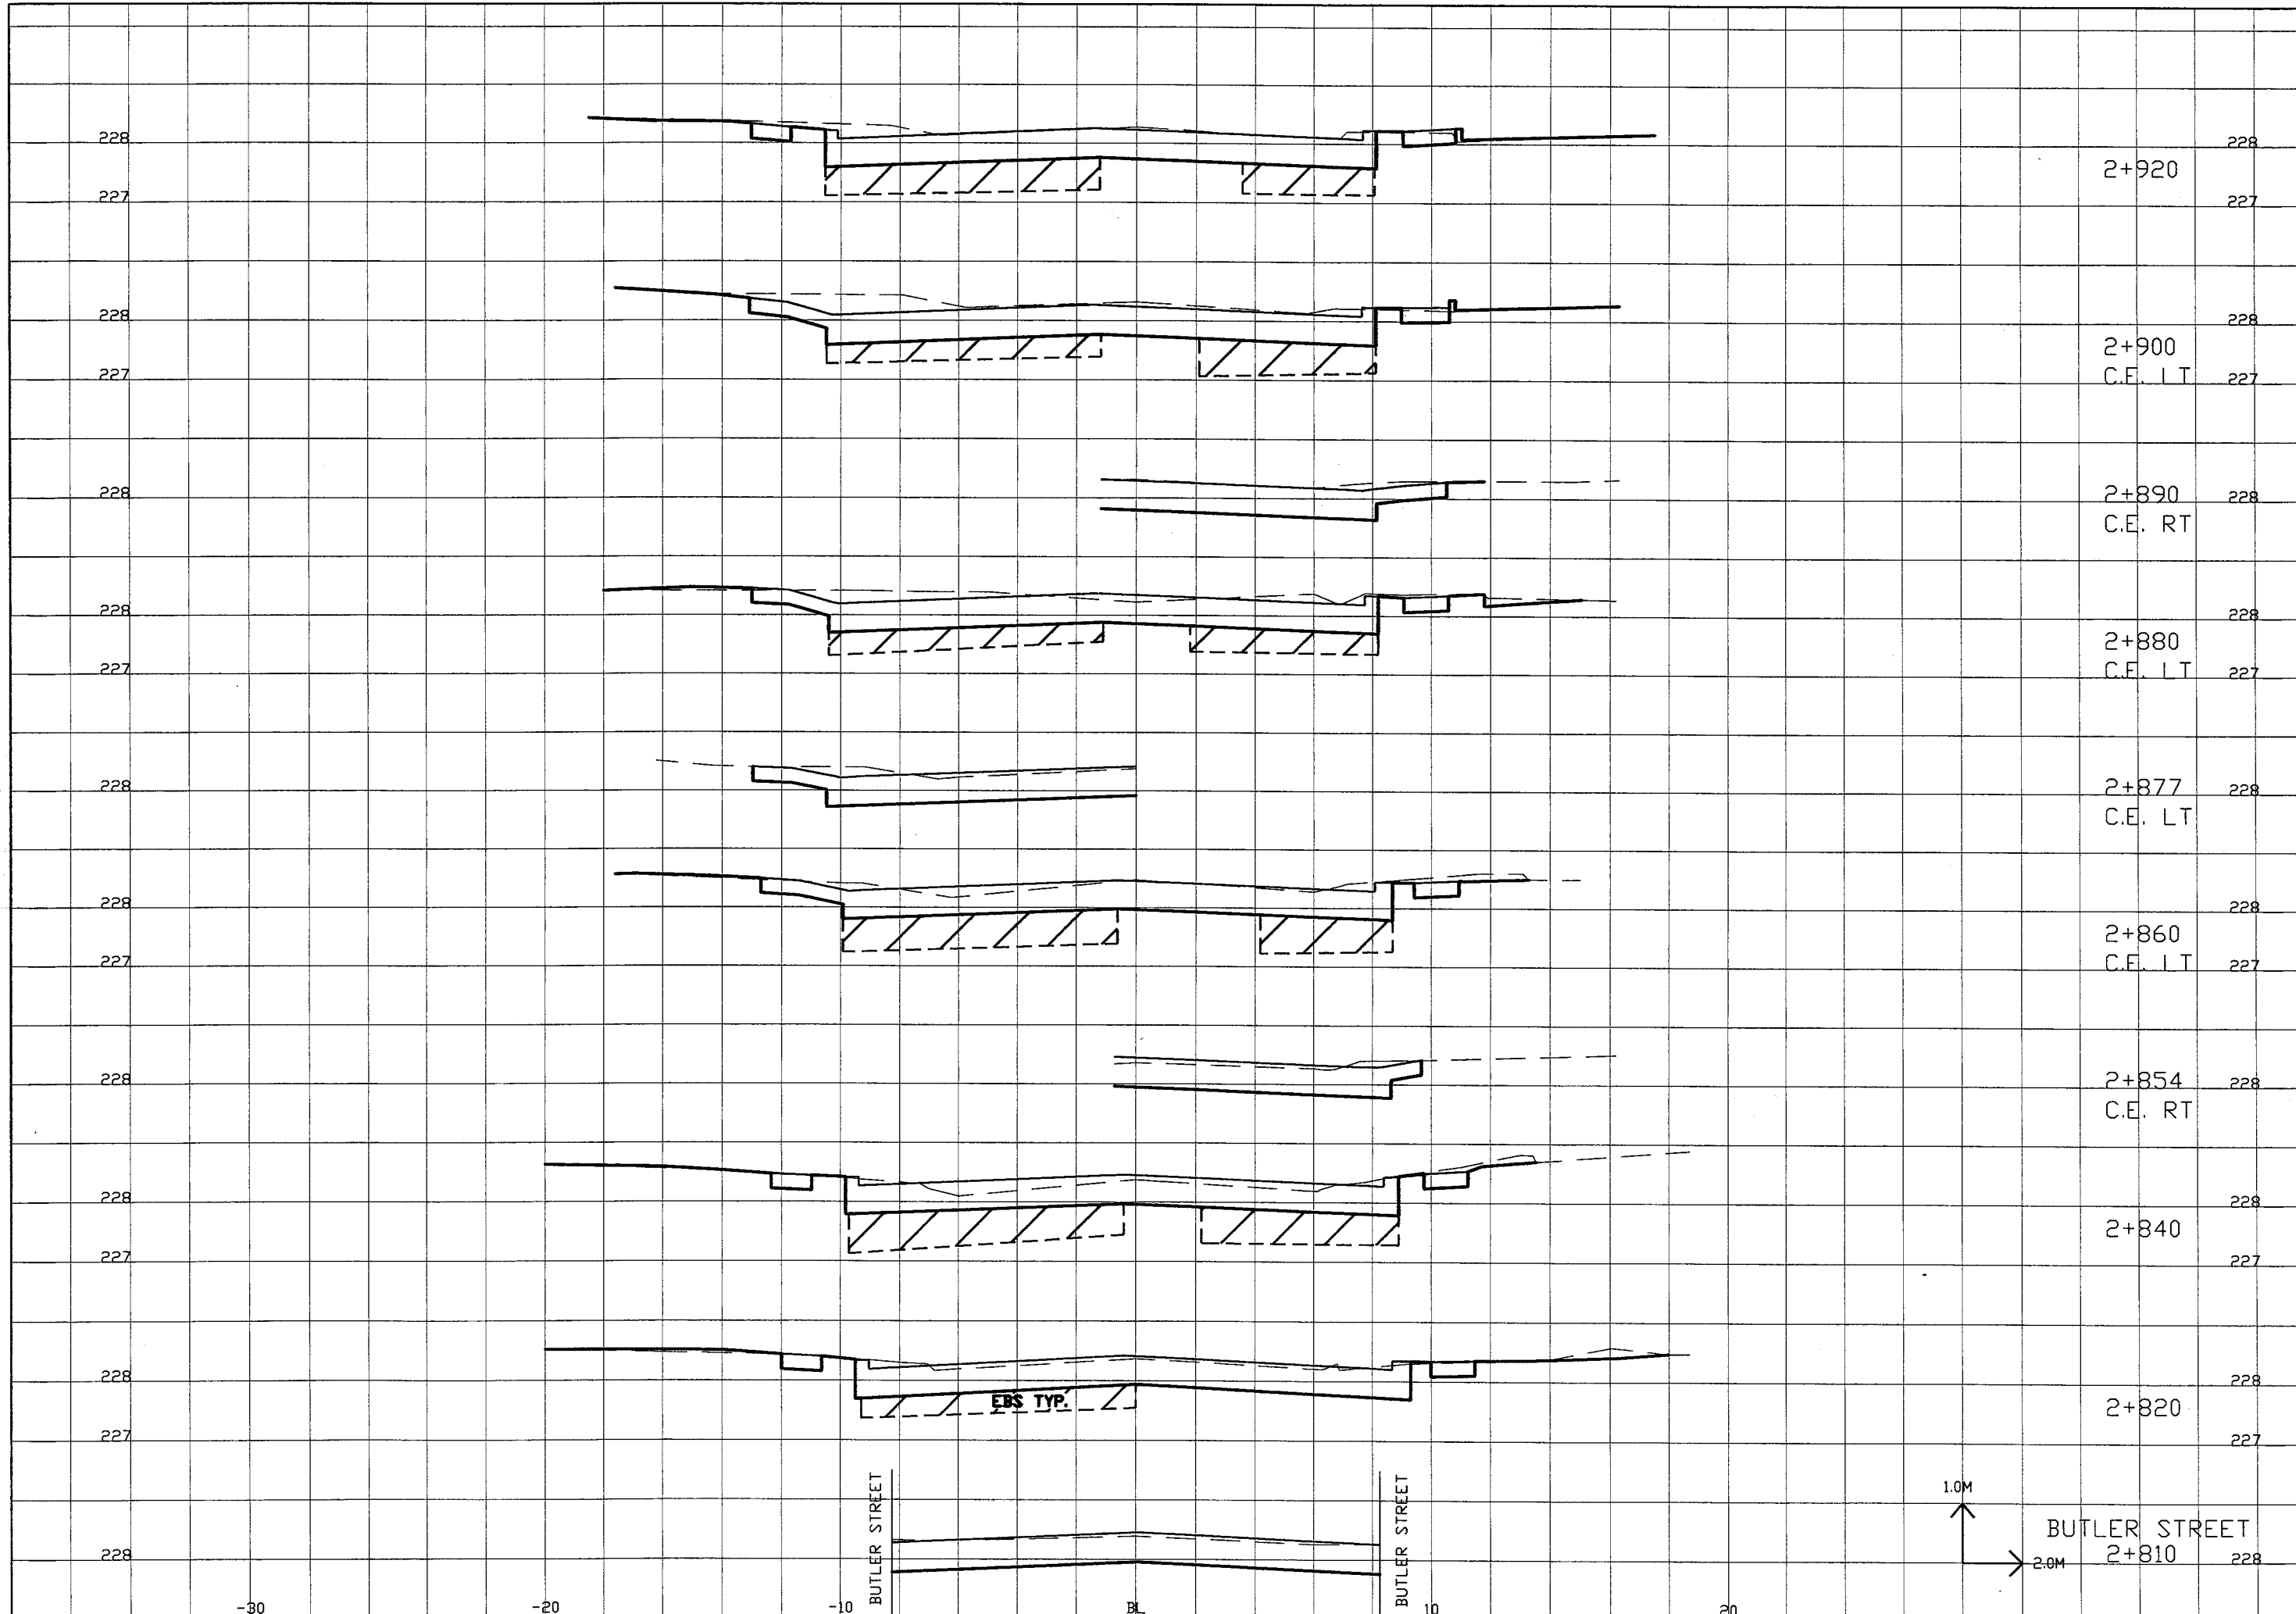

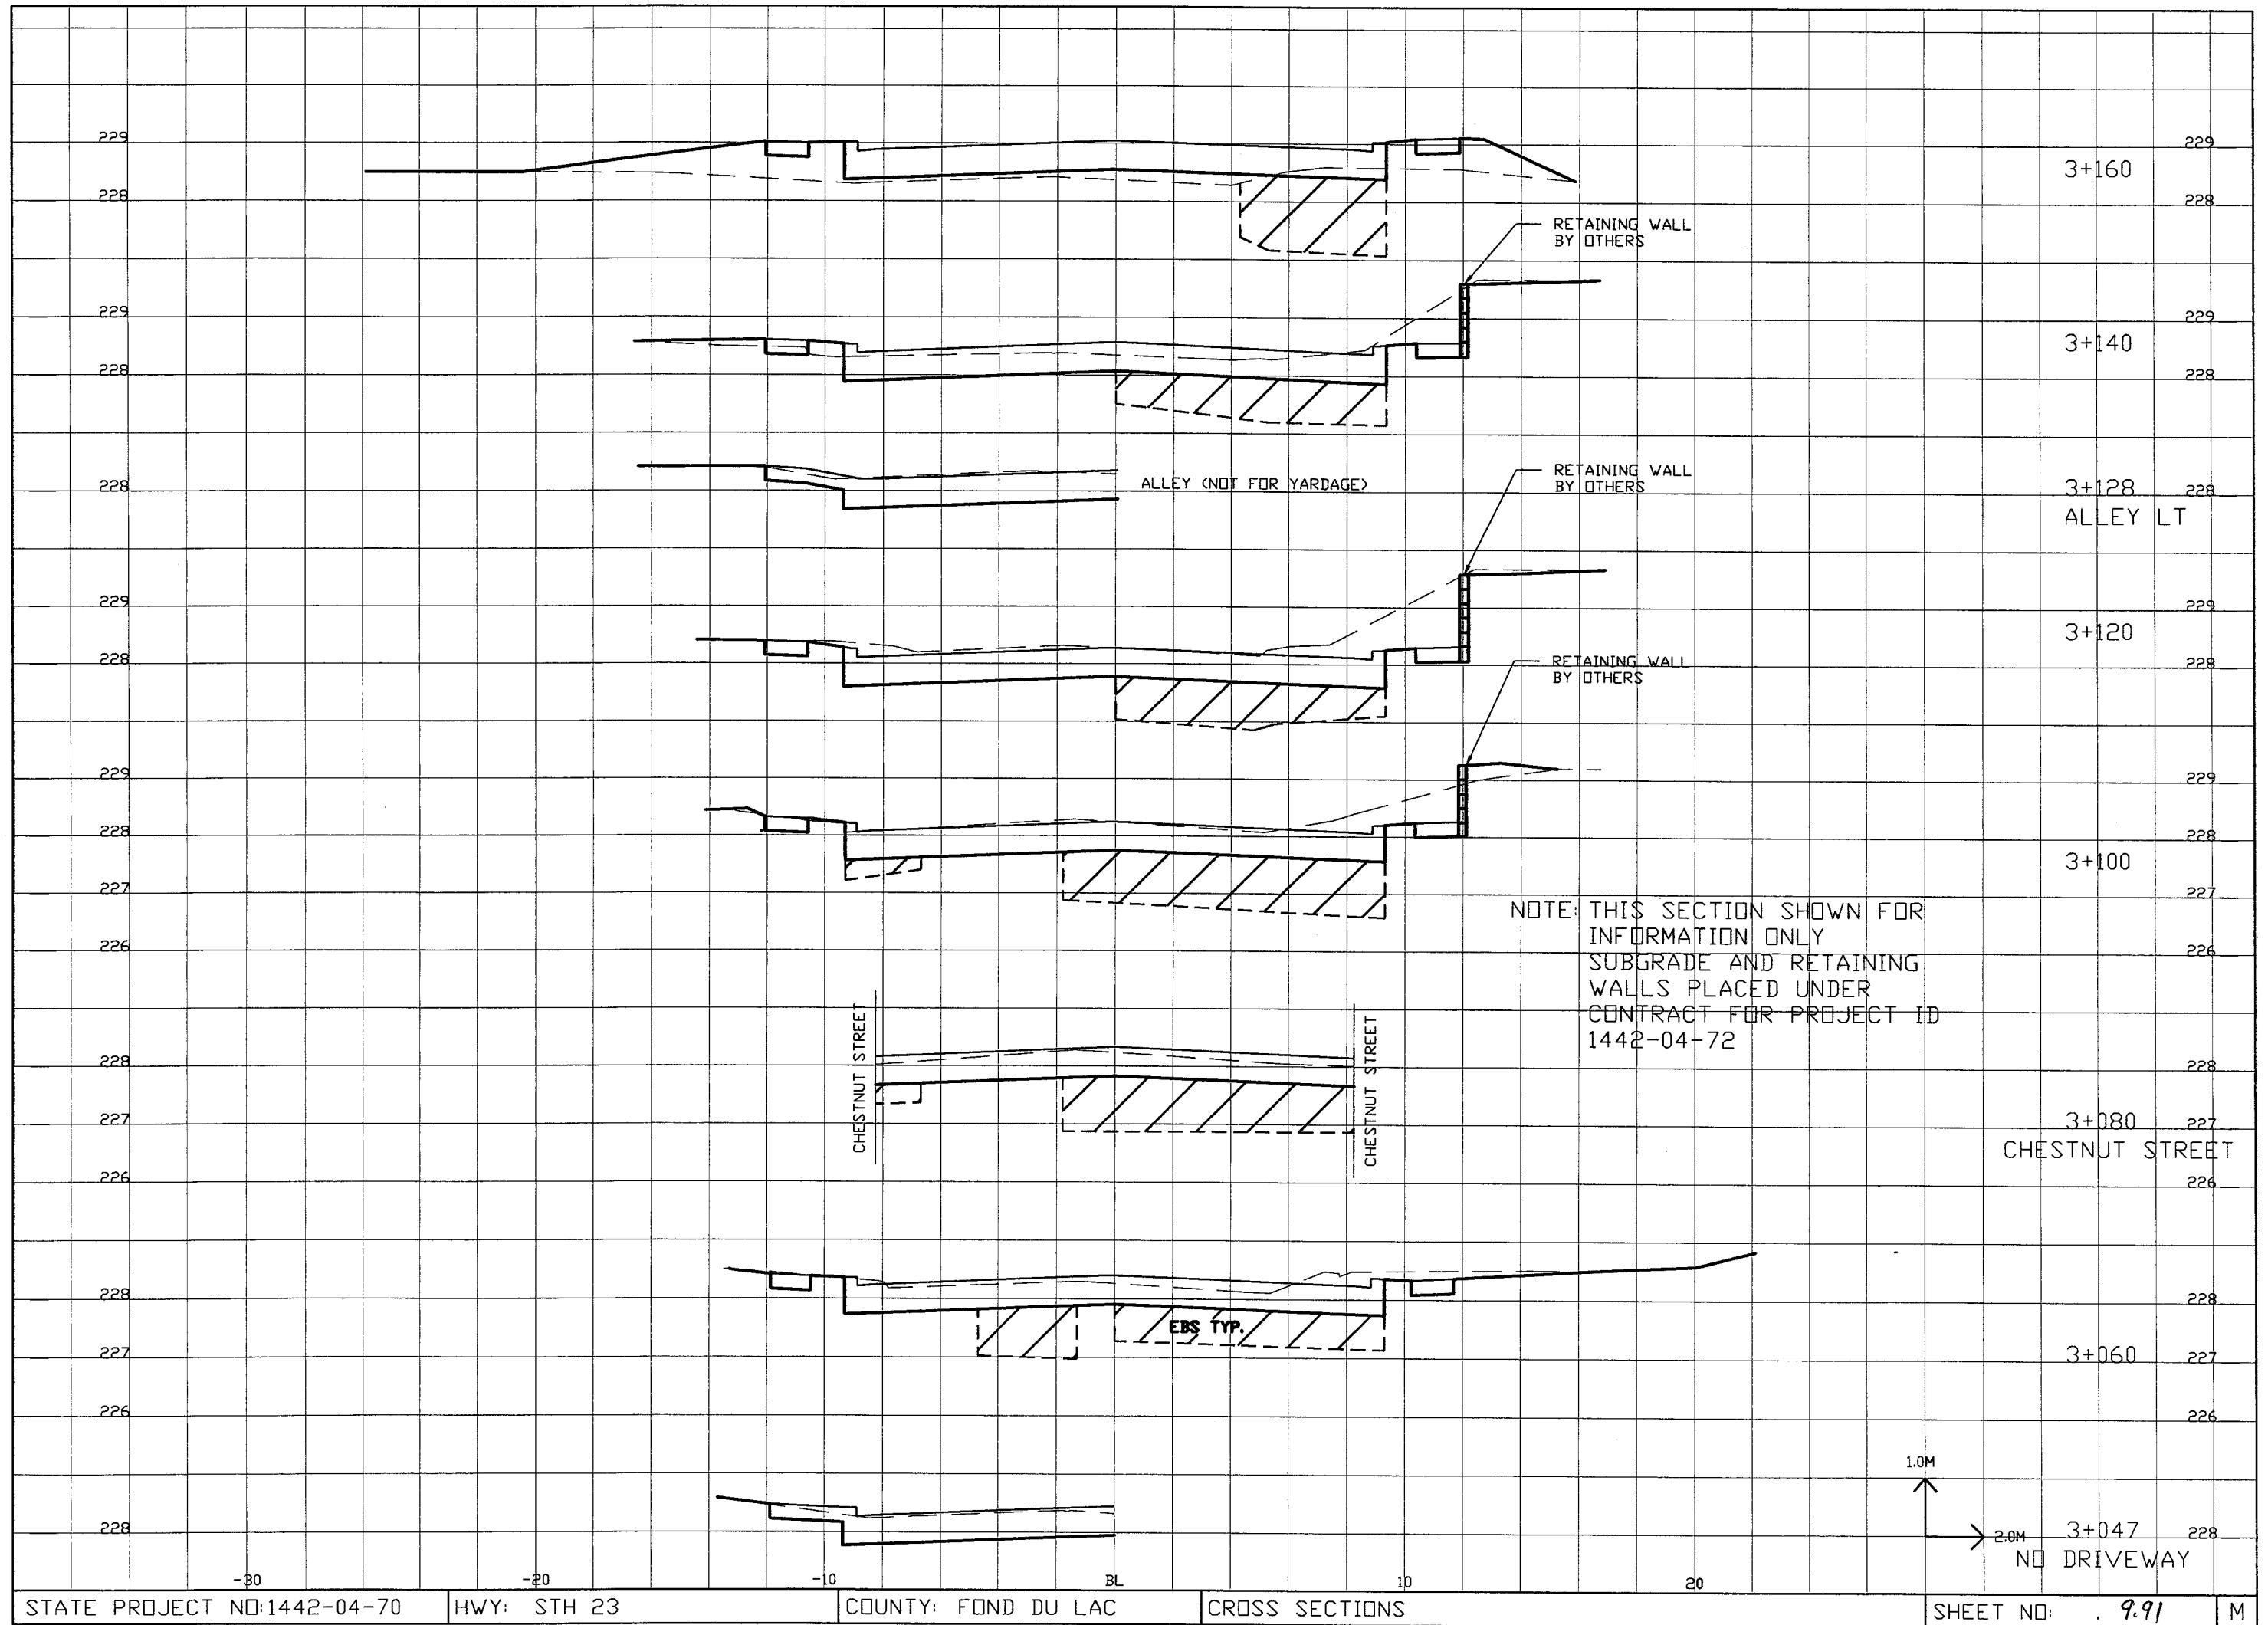

NOTE: THIS SECTION SHOWN FOR
INFORMATION ONLY
SUBGRADE AND RETAINING
WALLS PLACED UNDER
CONTRACT FOR PROJECT ID
1442-04-72

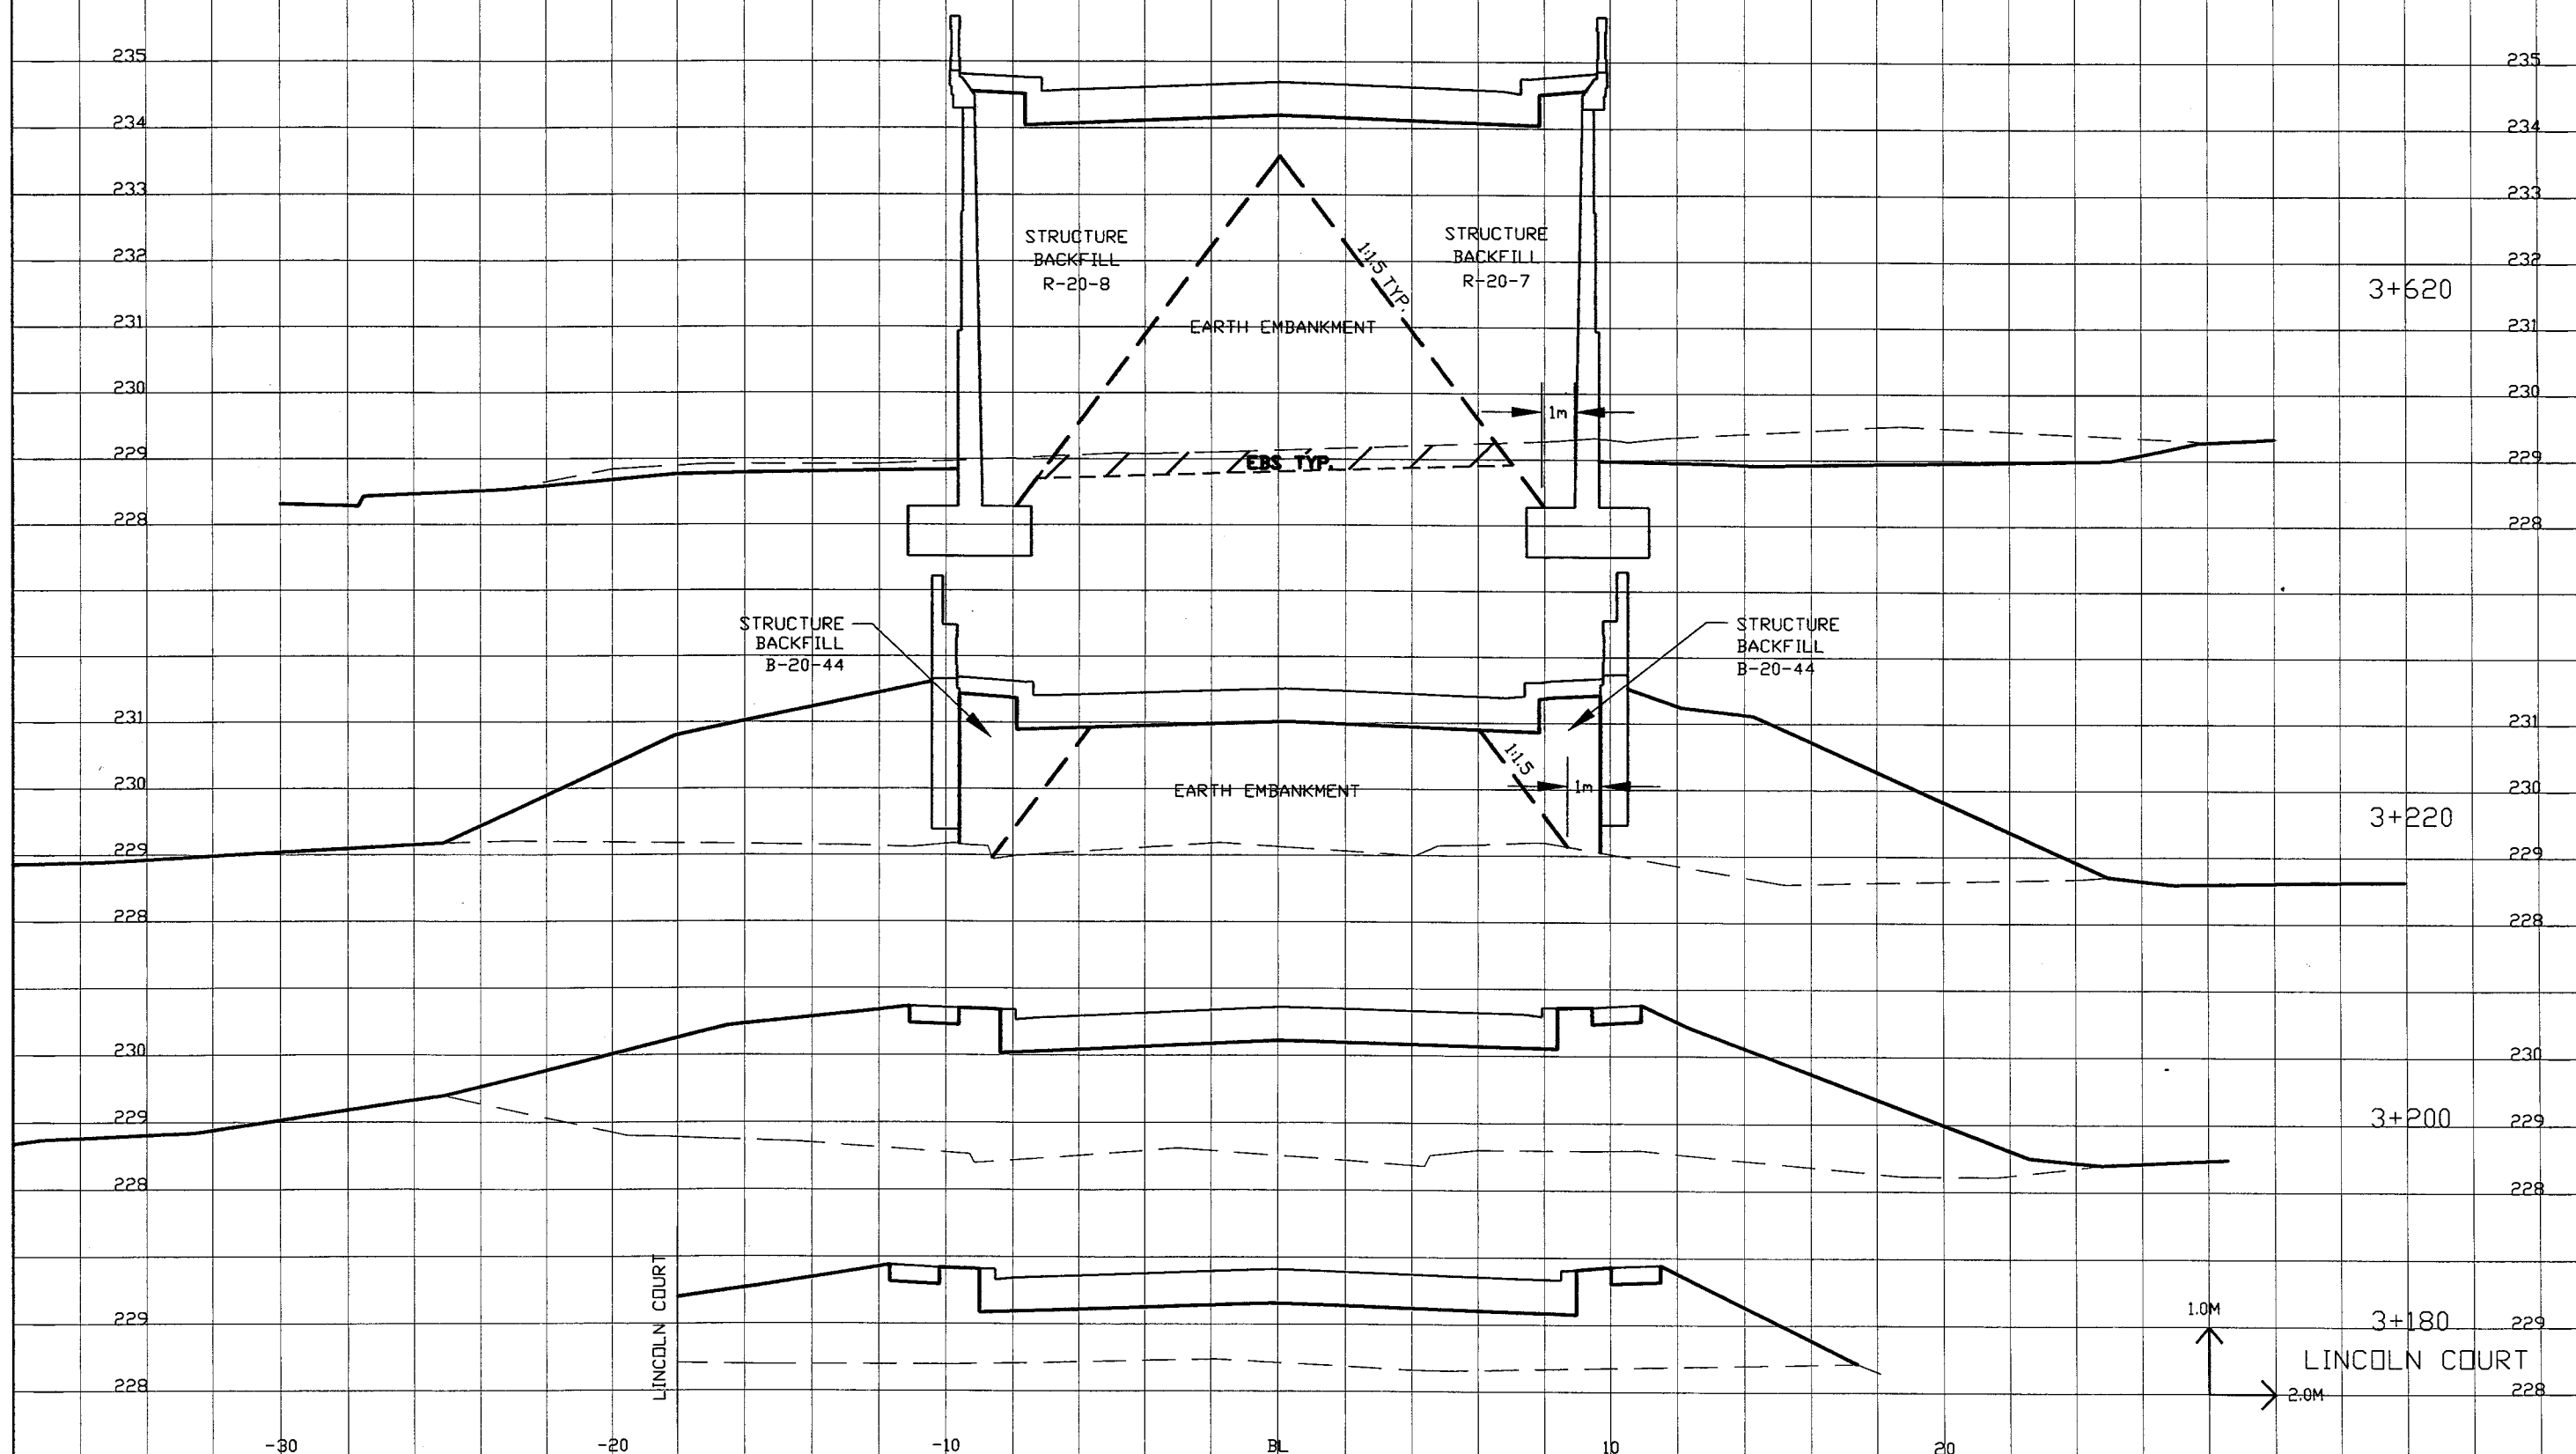

NOTE: THIS SECTION SHOWN FOR
INFORMATION ONLY
SUBGRADE AND RETAINING
WALLS PLACED UNDER
CONTRACT FOR PROJECT ID
1442-04-72

