




PLAN	DATE
DESIGNED	3/7
CHECKED	
APPROVED	
NOTED	
REVISIONS	



PROFILE	DATE
DESIGNED	3/7
CHECKED	
APPROVED	
NOTED	
REVISIONS	

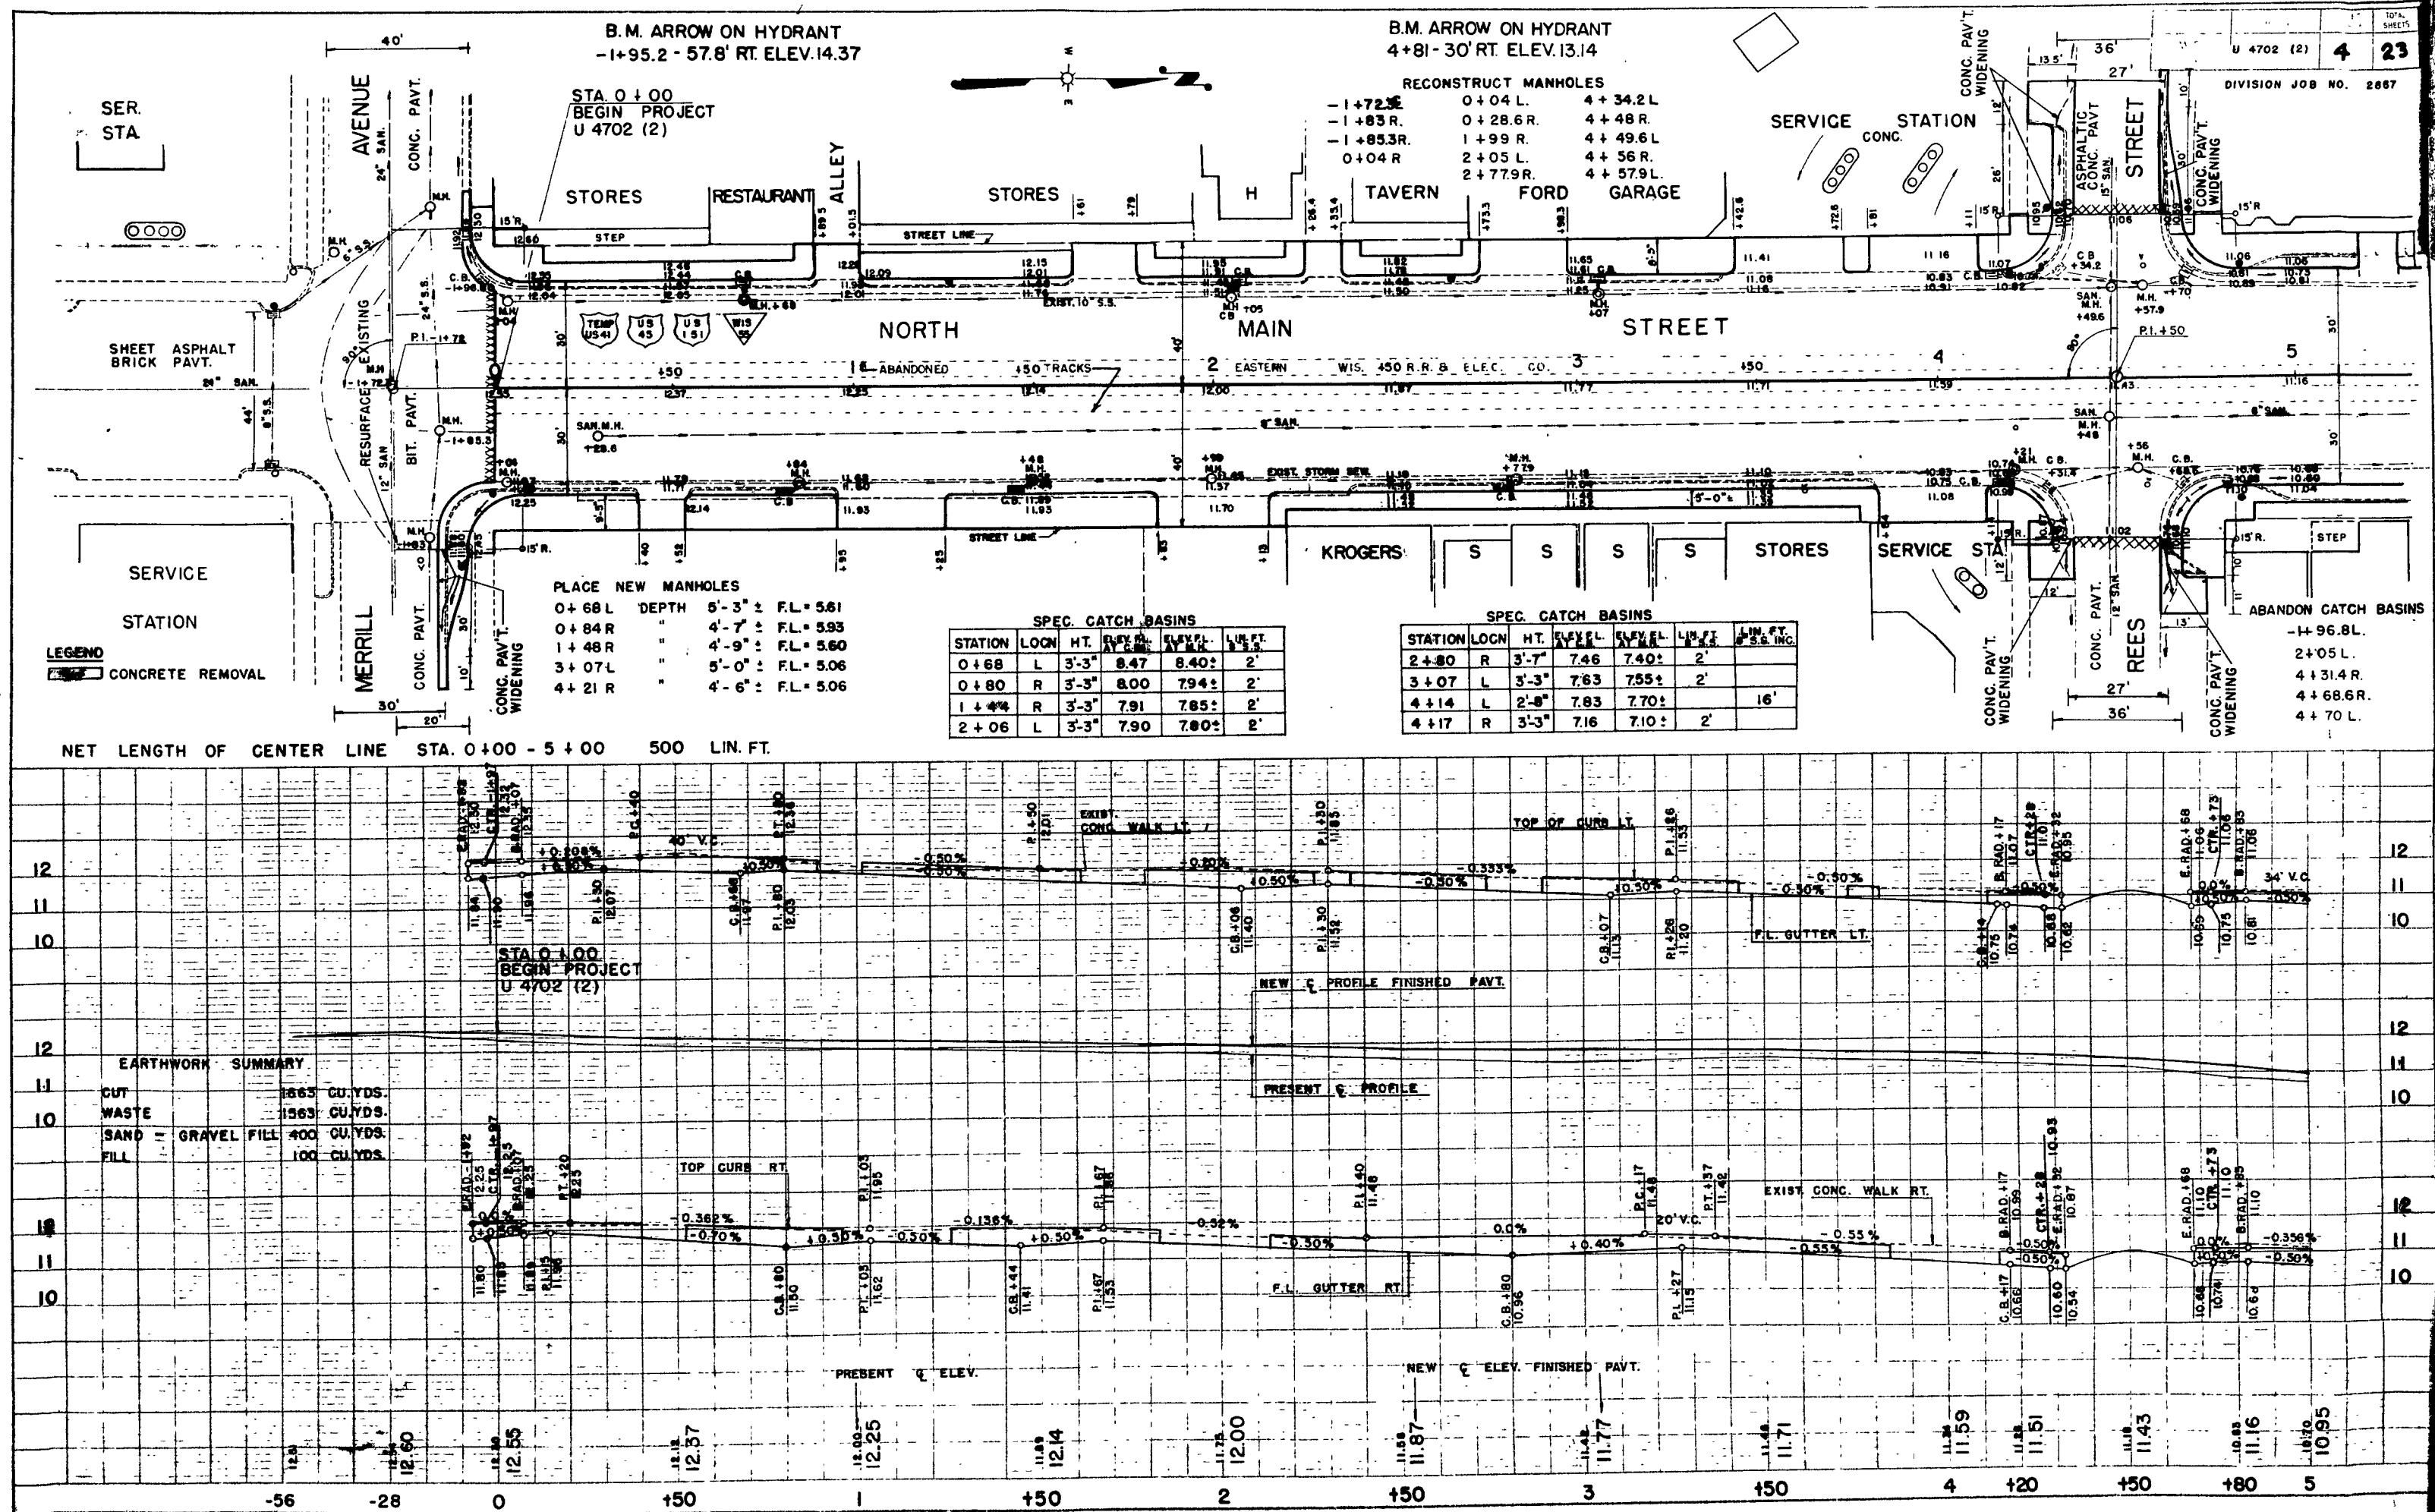

DATE: _____
 BY: _____
 CHECKED: _____
 APPROVED: _____
 CITY OF CHICAGO
 DEPARTMENT OF PUBLIC WORKS
 DIVISION OF STREETS
 PROJECT NO. _____
 SHEET NO. _____

DATE: _____
 BY: _____
 CHECKED: _____
 APPROVED: _____
 CITY OF CHICAGO
 DEPARTMENT OF PUBLIC WORKS
 DIVISION OF STREETS
 PROJECT NO. _____
 SHEET NO. _____

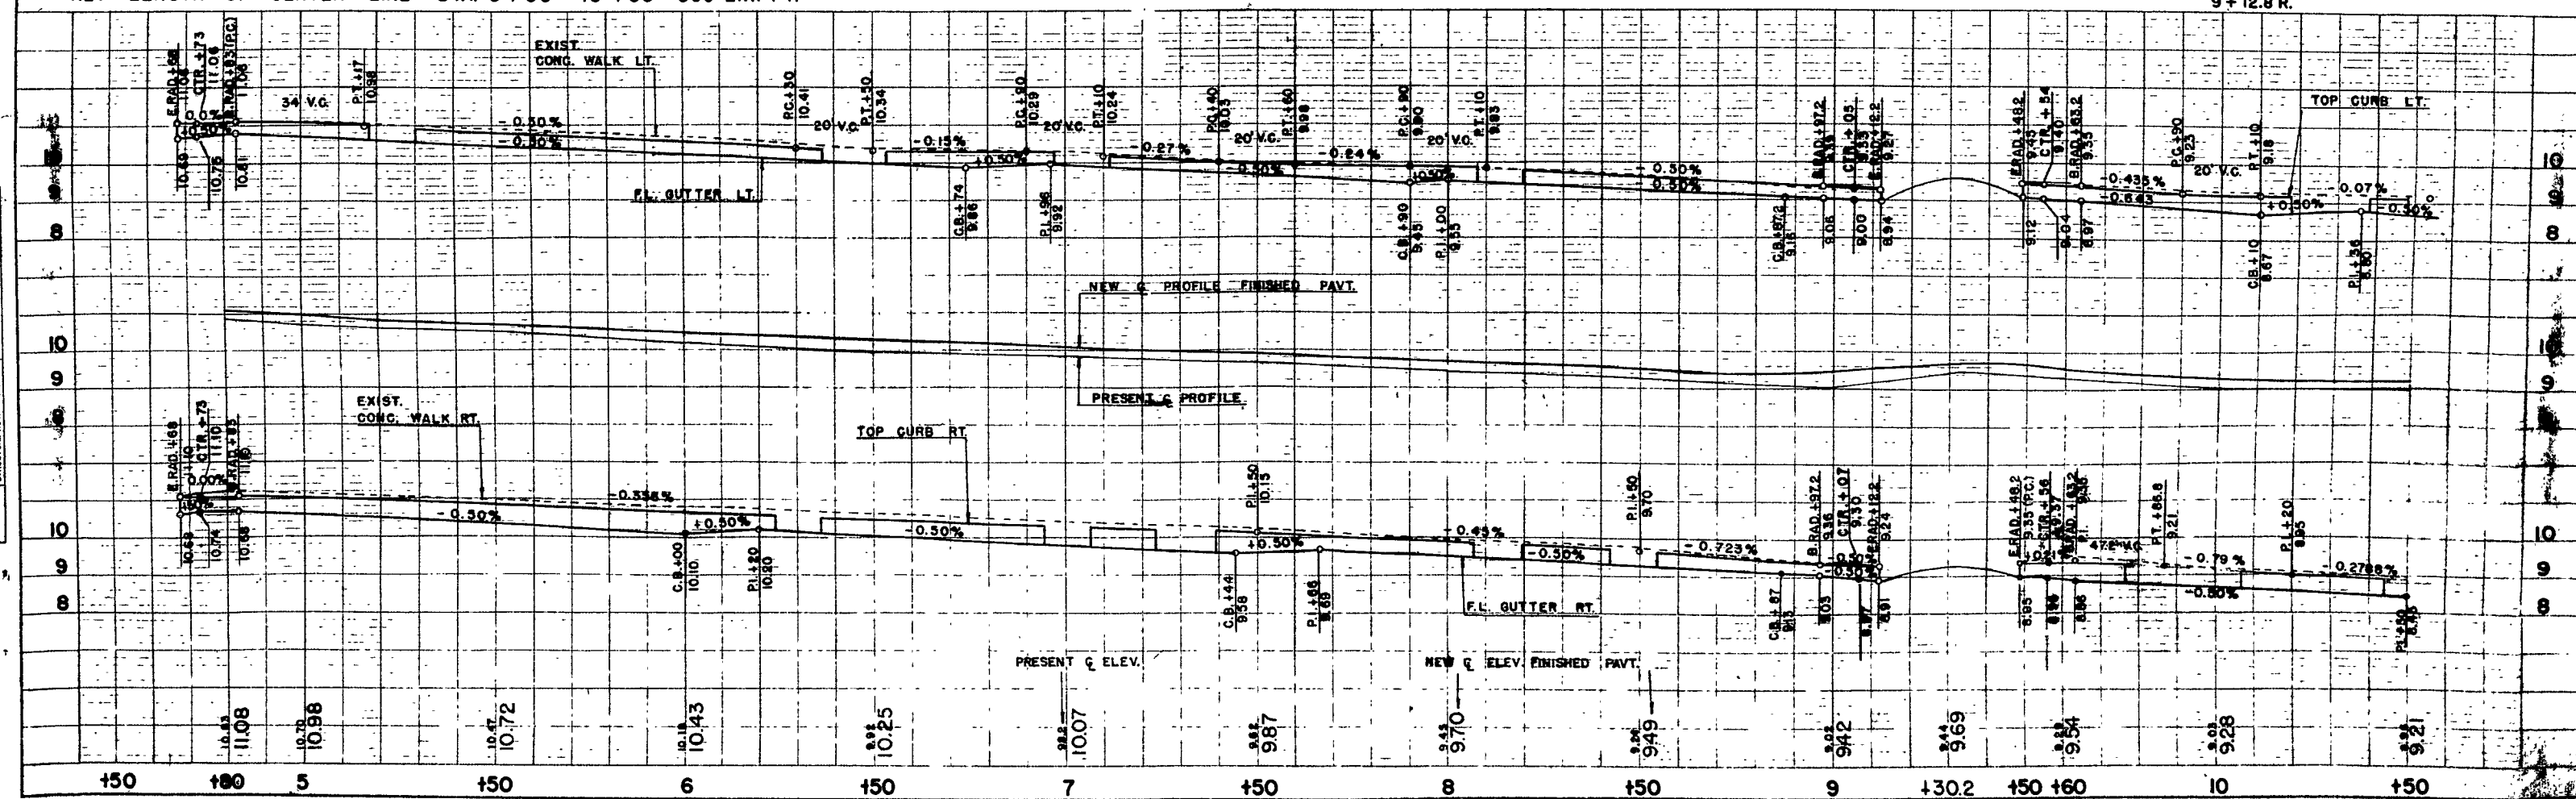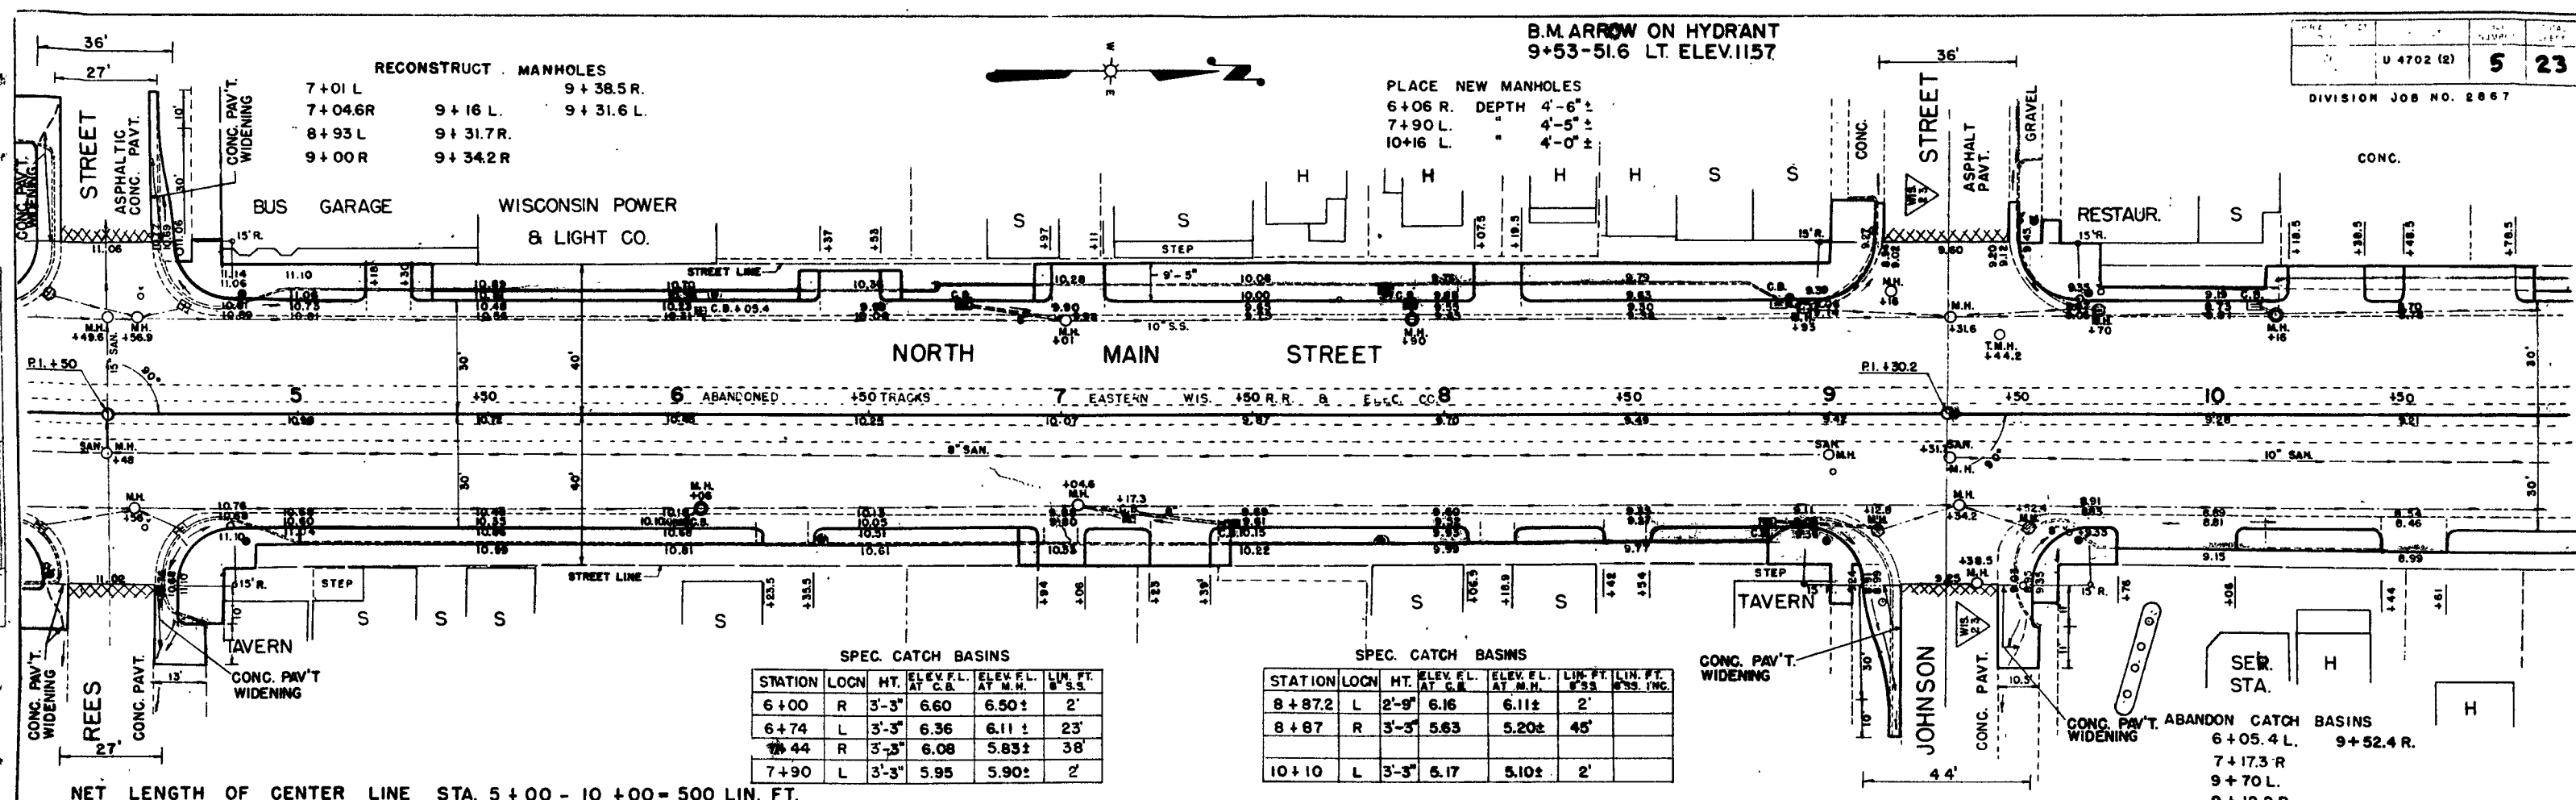

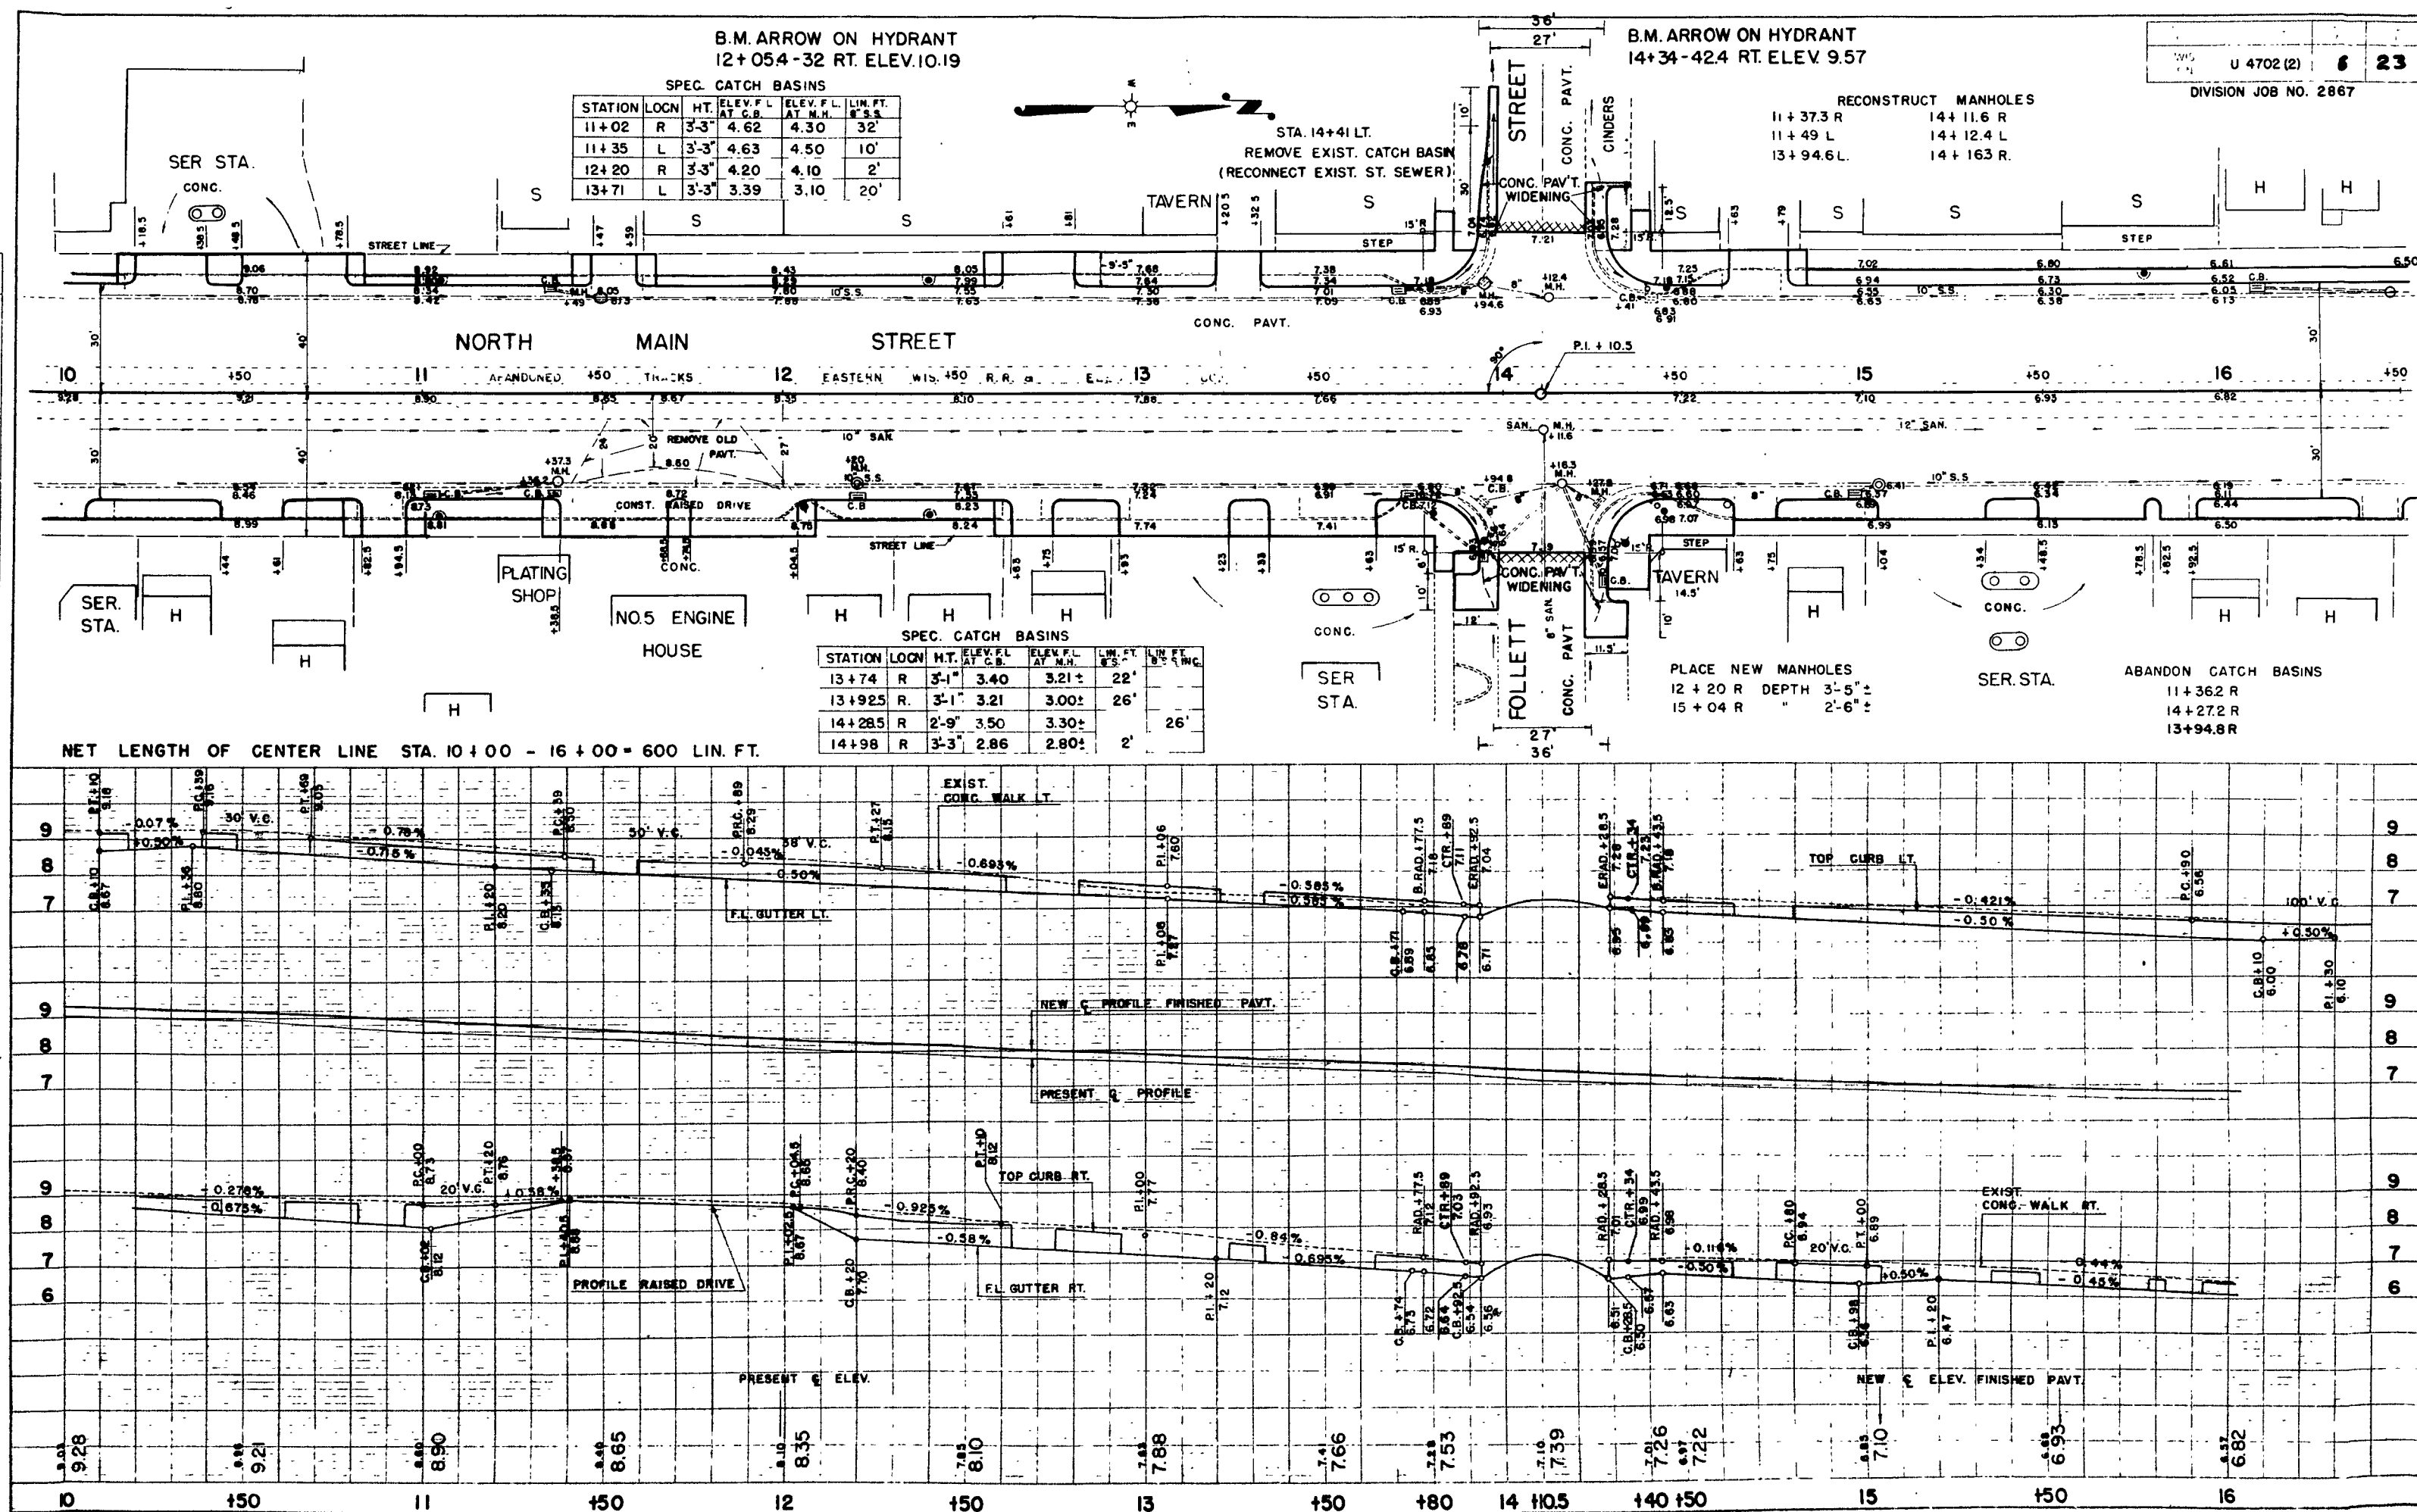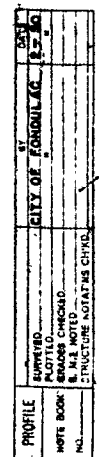

SPEC. CATCH BASINS						
STATION	LOCN.	HT.	ELEV. F.L. AT C.B.	ELEV. F.L. AT M.H.	LIN. FT. 8" S.S.	LIN. FT. 12" S.S. INC.
16+10	L	3'-3"	2.50	2.30	35'	
16+65	R	2'-7"	3.00	2.88		16'
16+92	L	3'-1"	2.45	2.25	41'	
17+56	R	3'-1"	2.73	2.68	2'	

NOTE:
USE 4' DRIVEWAY RETURN
RADIUS FROM ARNDT ST.
TO SCOTT ST.

PLACE NEW MANHOLES
17+56 R DEPTH 2'-11"
21+02 R " 2'-1"


B.M. ARROW ON HYDRANT
19+13.3-44' LT. ELEV. 8.75

RECONSTRUCT MANHOLES
16+47 R 18+94.8 L
16+48 L 19+12.6 L
18+66.3 R 20+07 E
18+66.5 L
18+83.6 L

STA. 21+86 RT.
ABANDON EXIST. MANHOLE

WS	U	7	23
4702 (2)			
DIVISION JOB NO. 2867			

SERVICE STATION

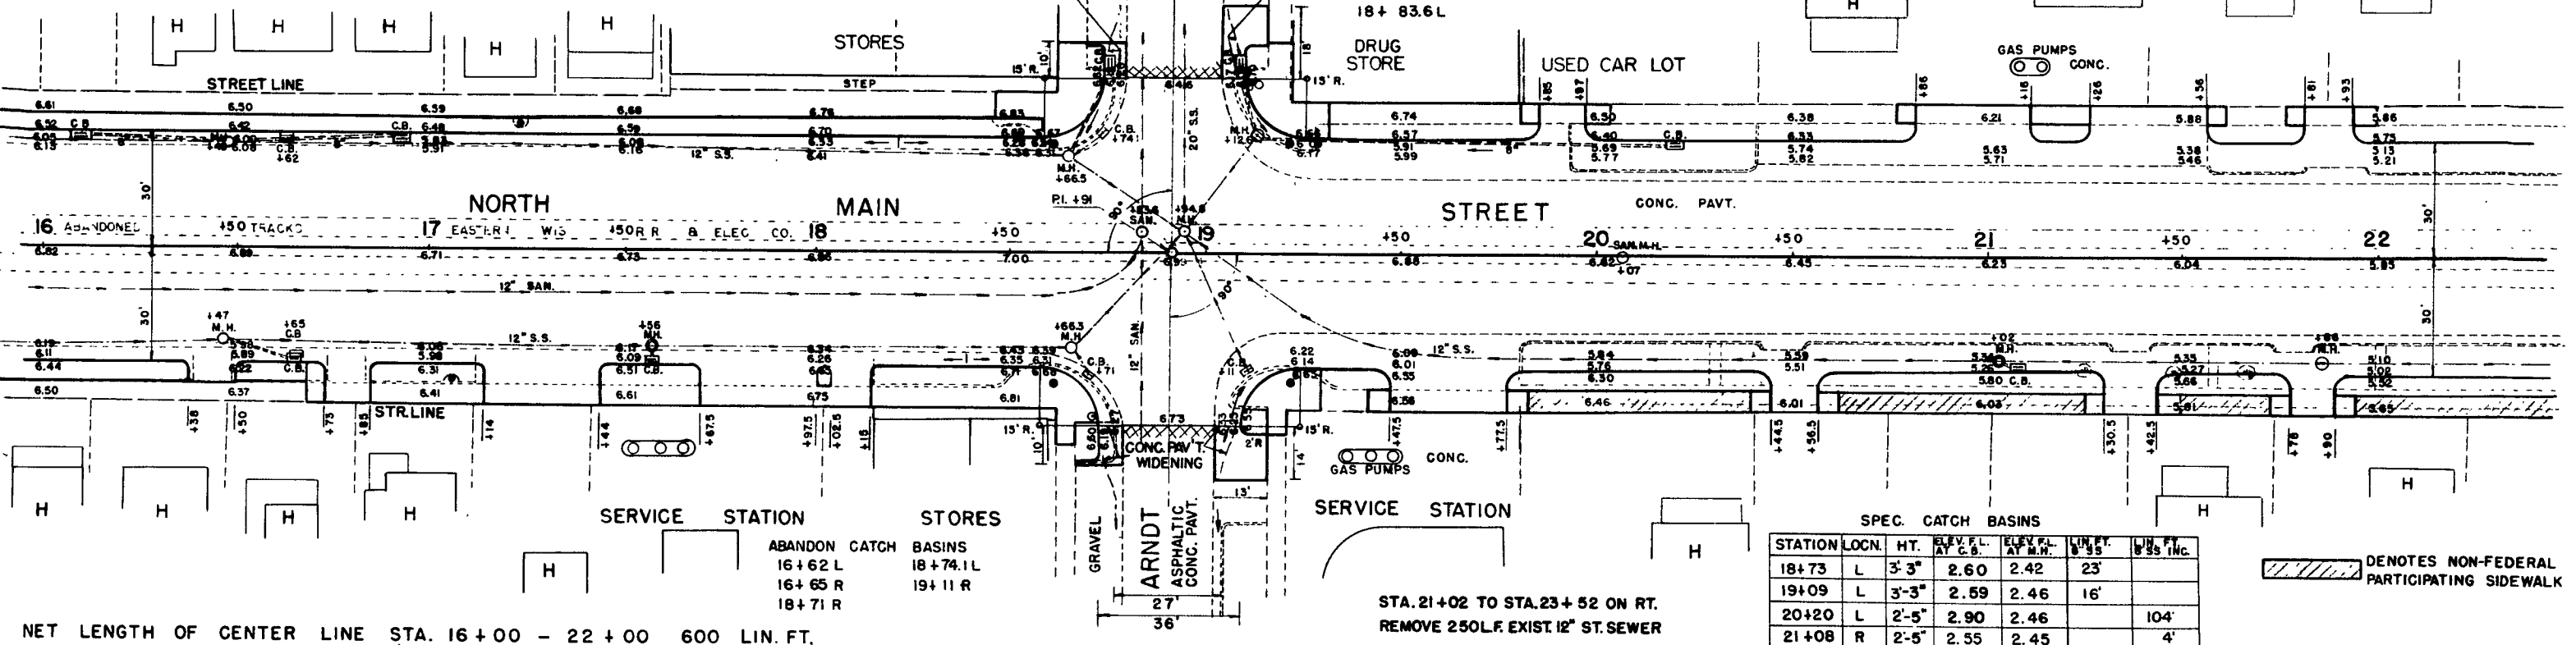

SPEC. CATCH BASINS						
STATION	LOCN.	HT.	ELEV. F.L. AT C.B.	ELEV. F.L. AT M.H.	LIN. FT. 8" S.S.	LIN. FT. 12" S.S. INC.
18+73	L	3'-3"	2.60	2.42	23'	
19+09	L	3'-3"	2.59	2.46	16'	
20+20	L	2'-5"	2.90	2.46		104'
21+08	R	2'-5"	2.55	2.45		4'


/// DENOTES NON-FEDERAL
PARTICIPATING SIDEWALK

NET LENGTH OF CENTER LINE STA. 16+00 - 22+00 600 LIN. FT.

STA. 21+02 TO STA. 23+52 ON RT.
REMOVE 250L.F. EXIST. 12" ST. SEWER



PLAN	DATE
SURVEYED	
NOTED	
ADJUSTMENT CHECKED	
RT. OF WAY CHECKED	
NO	

PROFILE	DATE
DESIGNED	
PLOTTED	
GRADES CHECKED	
STRUCTURE NOTATION CHECKED	
NO	

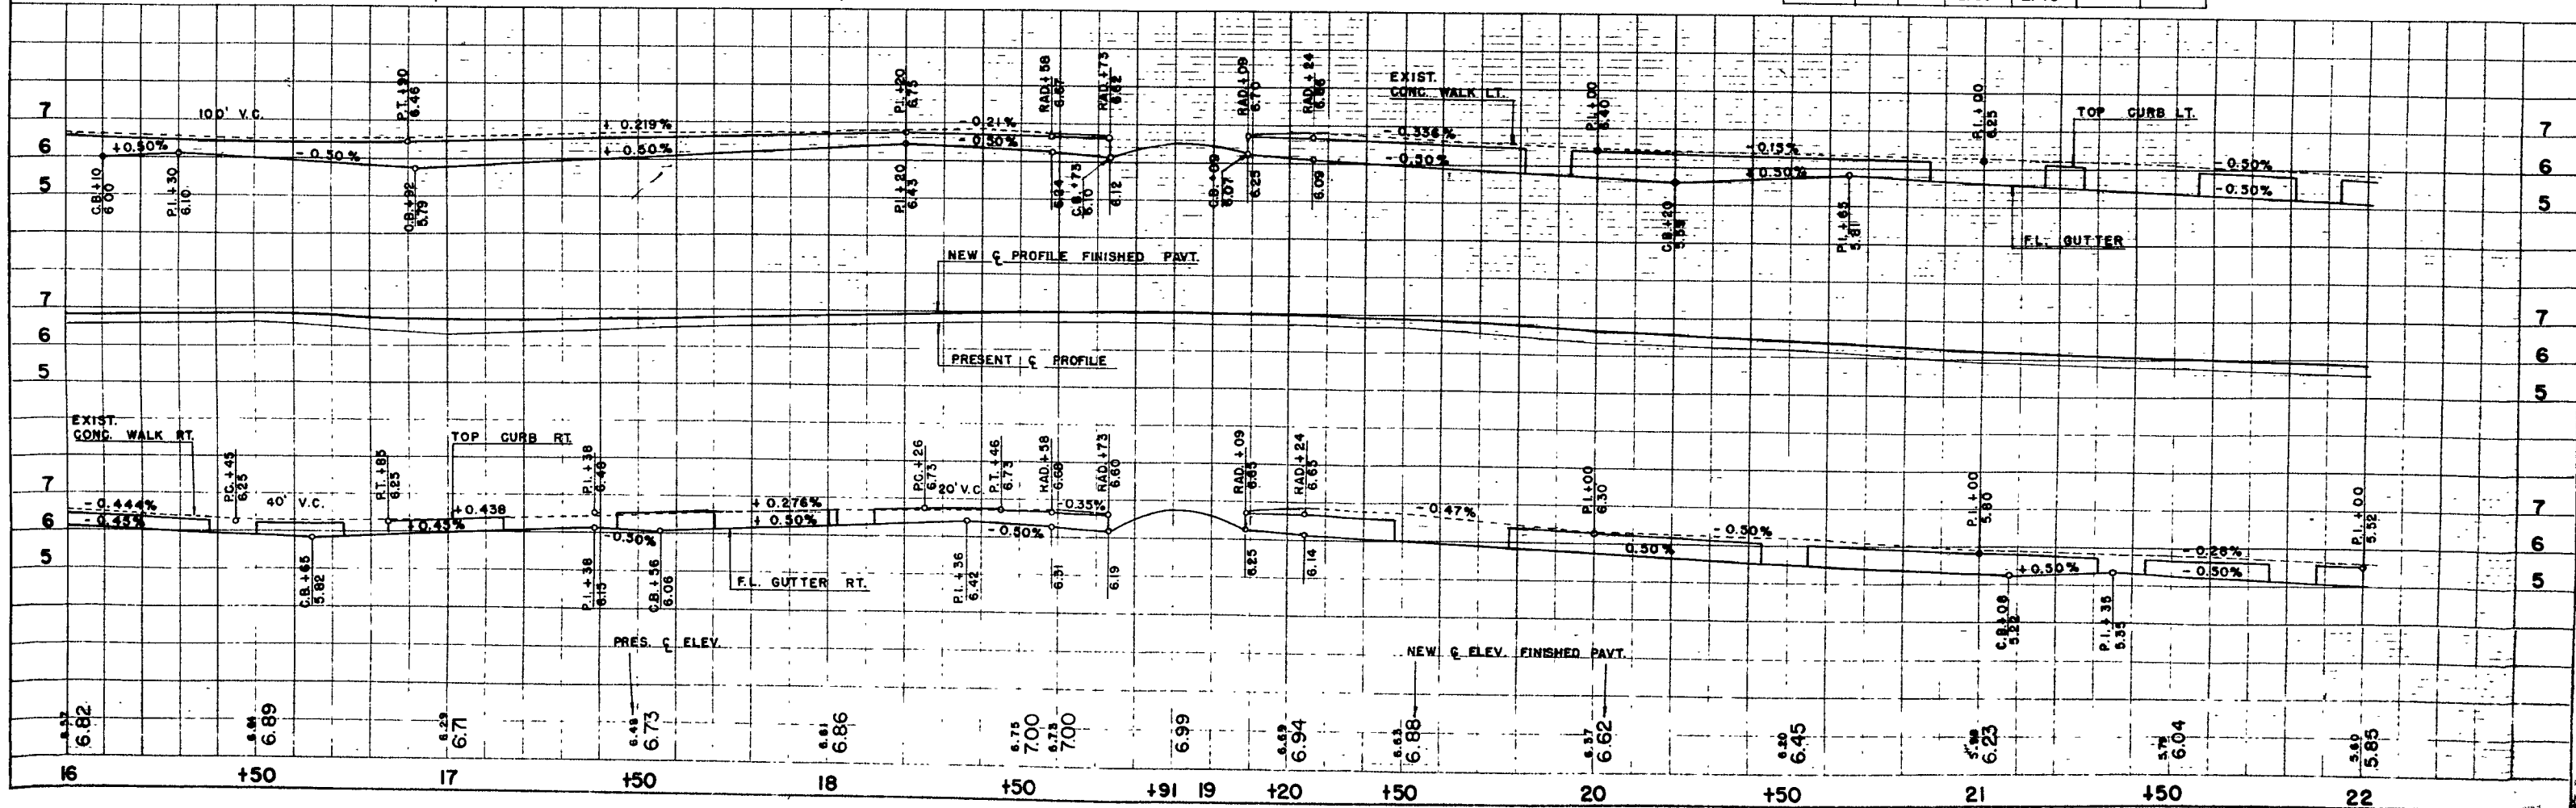

DATE	BY
PROJECT	NO.
DESIGNED	DATE
CHECKED	DATE
APPROVED	DATE

DATE	BY
PROJECT	NO.
DESIGNED	DATE
CHECKED	DATE
APPROVED	DATE

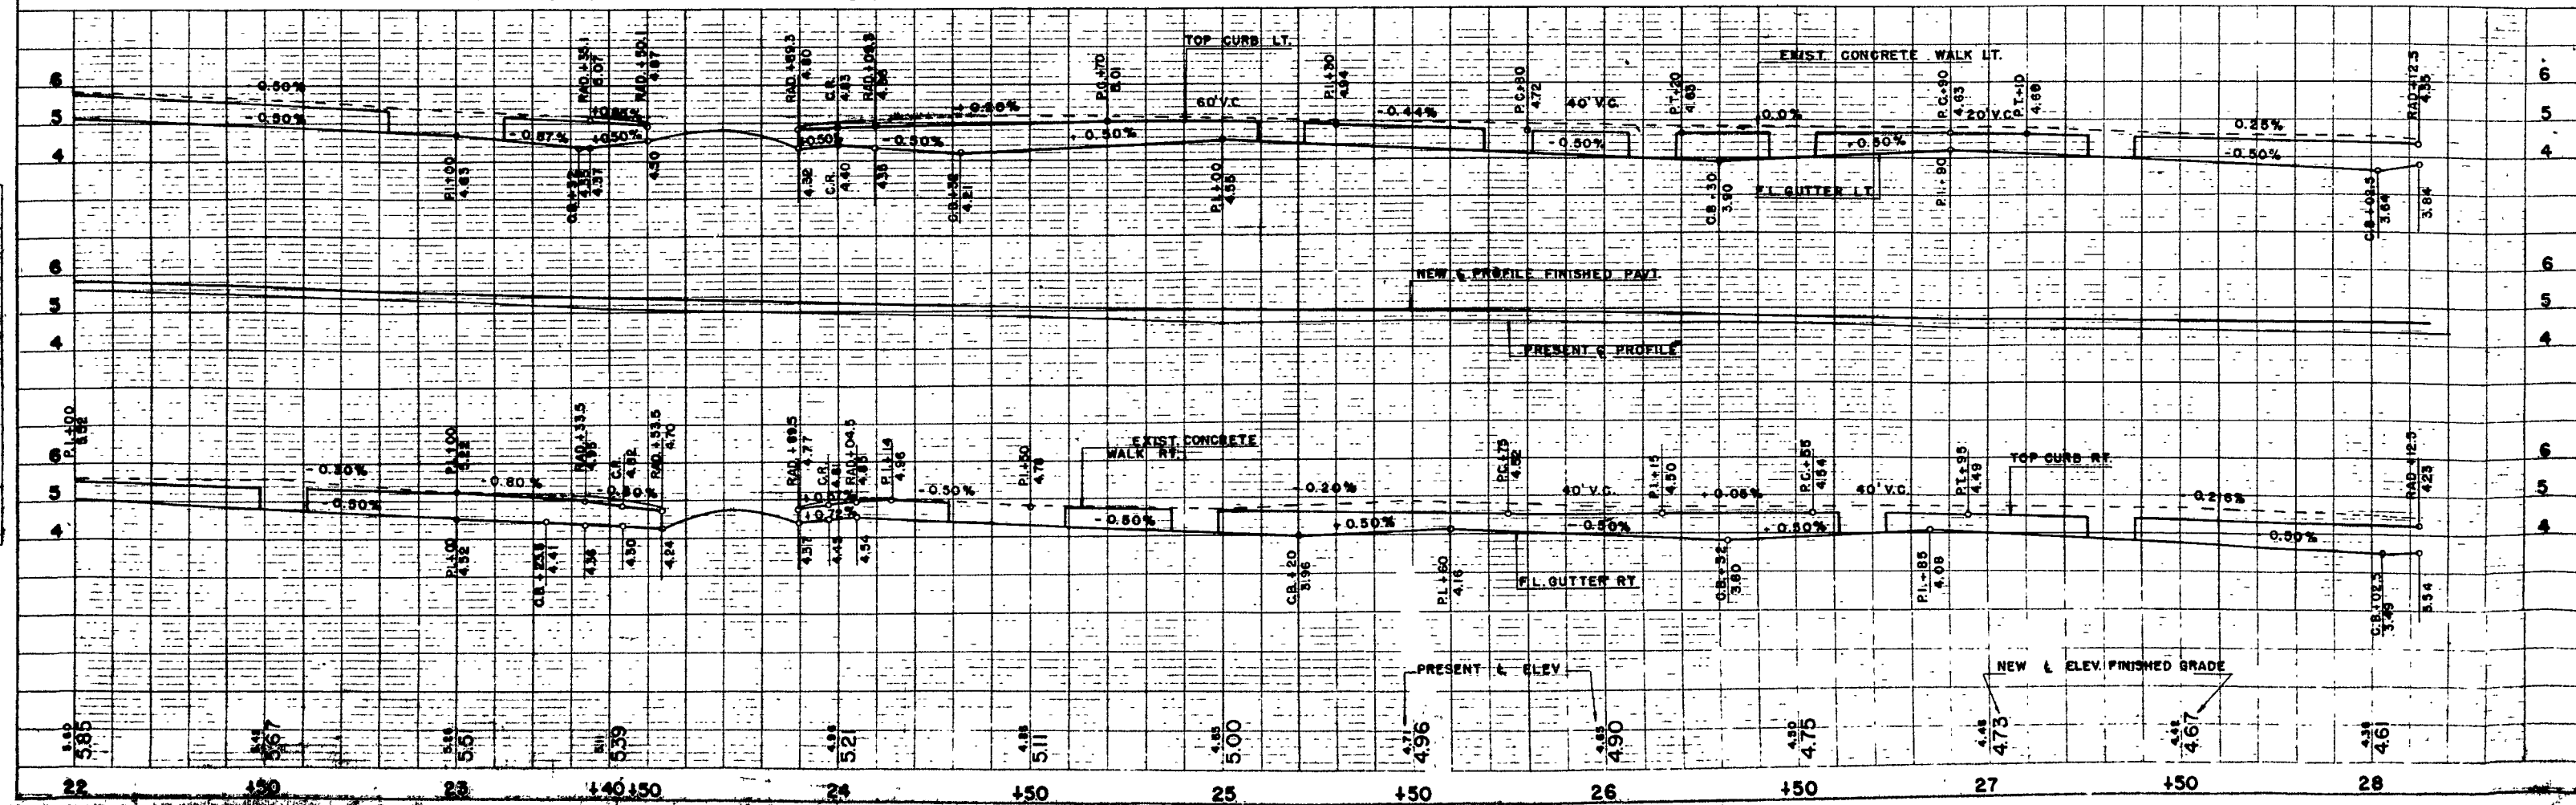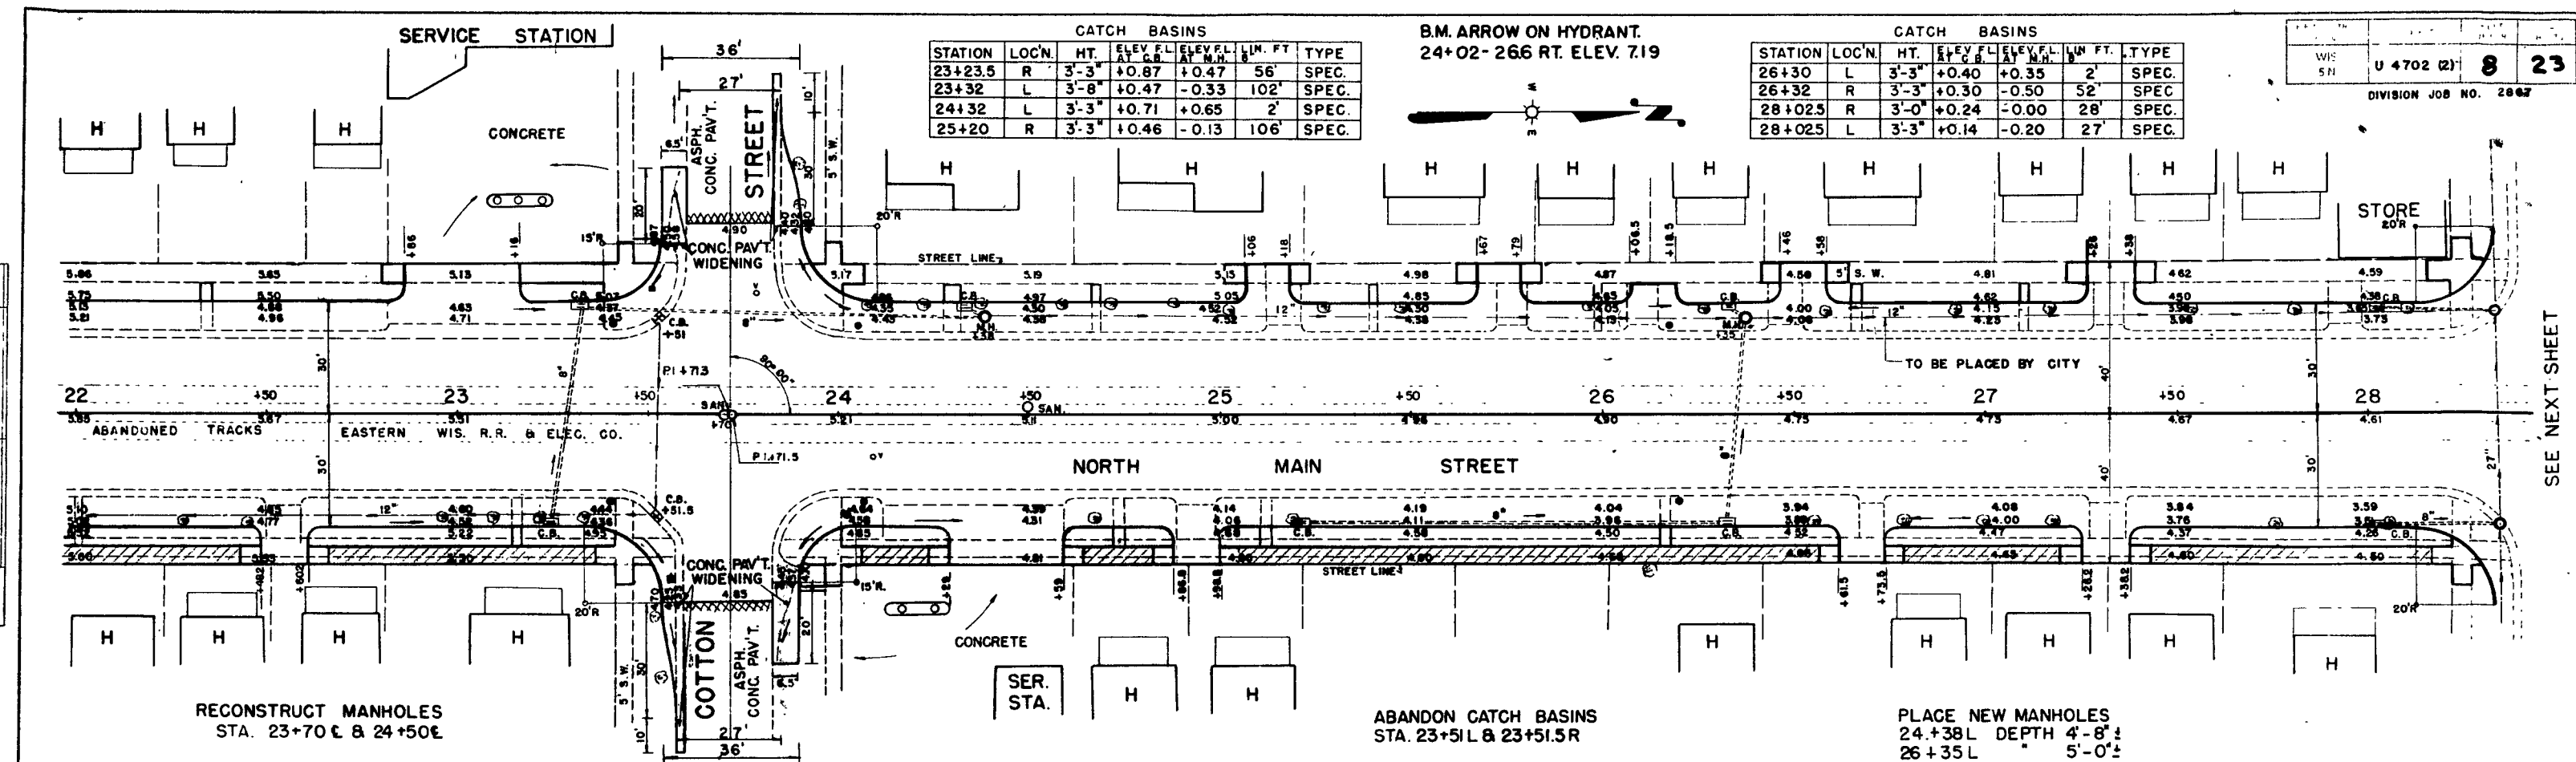

SEE NEXT SHEET

B.M. ARROW ON HYDRANT.
28+20-27' RT. ELEV. 637

CATCH BASINS							
STATION	LOCN	MT.	ELEV. F.L. AT C.B.	ELEV. F.L. AT M.H.	LM. FT. 5' INC.	LM. FT. 5' INC.	TYPE
28+90	L	3'-8"	-0.31 ±	-0.71 ±	52'		SPEC.
28+92.5	R	3'-0"	0.38 ±	0.13 ±	52'		SPEC.
30+00	L	3'-7"	0.19 ±	-0.31 ±	108'		SPEC.
30+58	R	2'-5"	1.51 ±	1.46 ±		4'	SPEC.


SER. STA.
STA. 31+94-29' LT. TO STA. 31+94-27' RT.
52'-12" R.C.C.P. ST. SEWER

B.M. ARROW ON HYDRANT.
32+93-28.5' RT. ELEV. 689
PLACE NEW MANHOLES

30+64 R DEPTH 2'-3"

31+94 L DEPTH 2'-9"
31+94 R " 2'-10"

DIVISION JOB NO. 2887

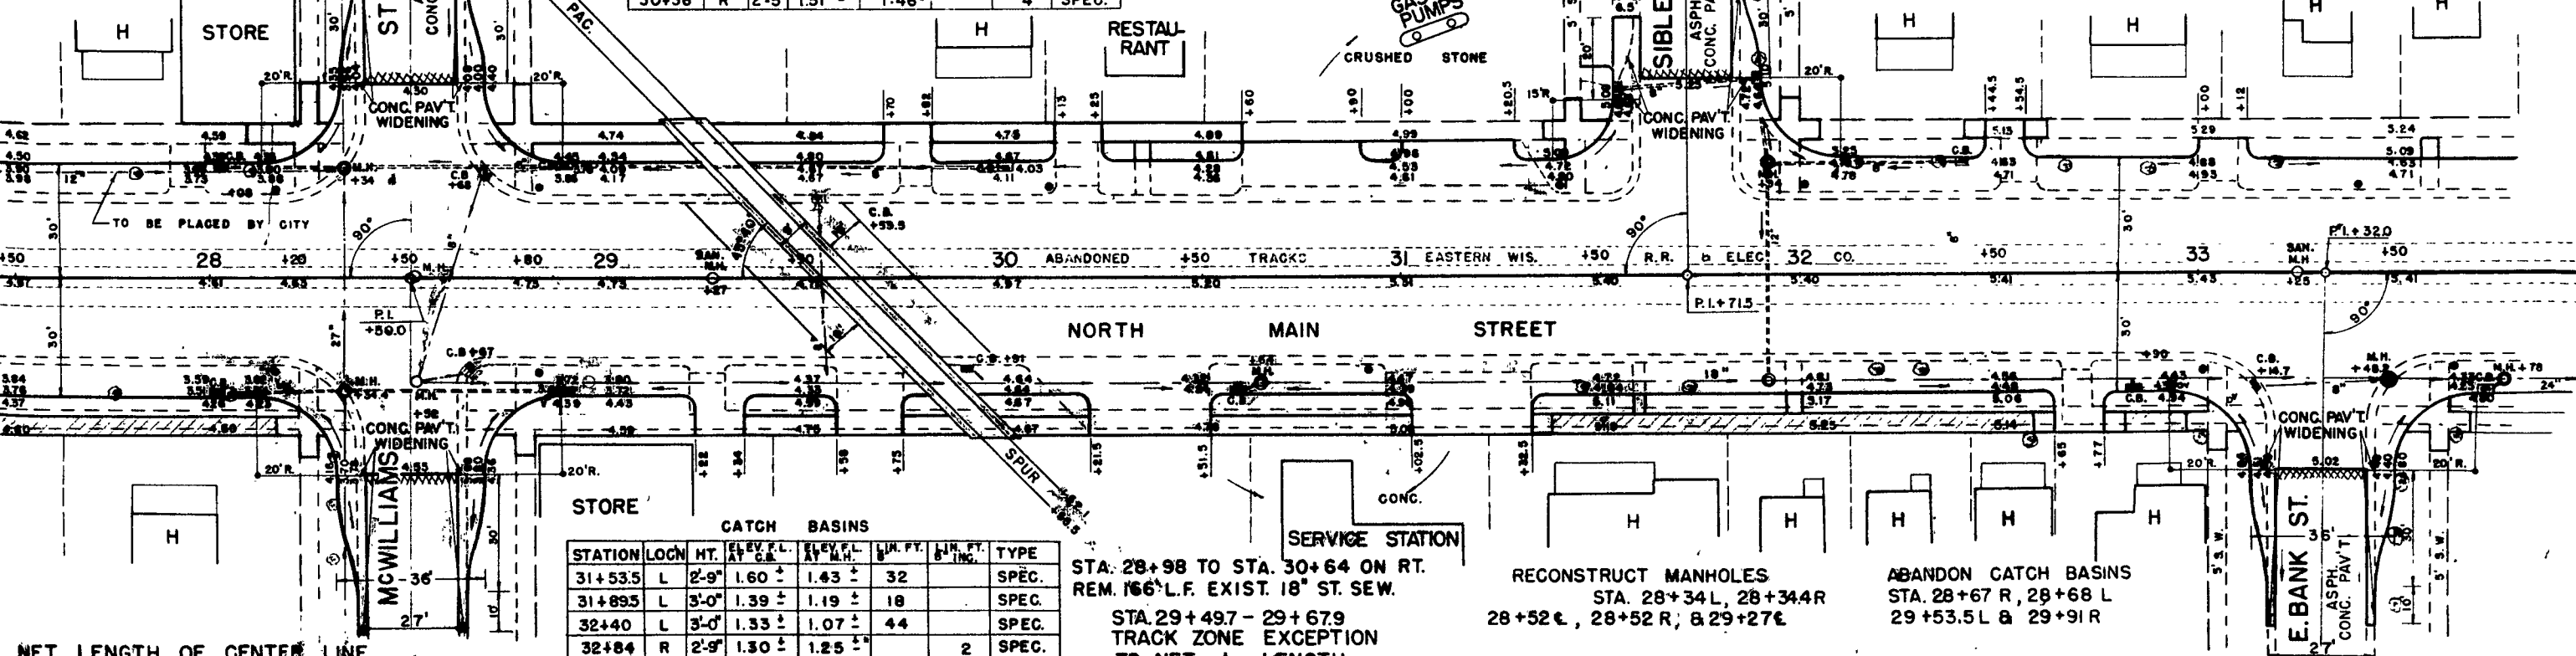

NET LENGTH OF CENTER LINE
STA. 28+00-33+00 481.8' LIN. FT.


CATCH BASINS							
STATION	LOCN	MT.	ELEV. F.L. AT C.B.	ELEV. F.L. AT M.H.	LM. FT. 5' INC.	LM. FT. 5' INC.	TYPE
31+53.5	L	2'-9"	1.60 ±	1.43 ±	32'		SPEC.
31+89.5	L	3'-0"	1.39 ±	1.19 ±	18'		SPEC.
32+40	L	3'-0"	1.33 ±	1.07 ±	44'		SPEC.
32+84	R	2'-9"	1.30 ±	1.25 ±		2'	SPEC.

STA. 28+98 TO STA. 30+64 ON RT.
REM. 166' L.F. EXIST. 18" ST. SEW.
STA. 29+49.7 - 29+67.9
TRACK ZONE EXCEPTION
TO NET & LENGTH

RECONSTRUCT MANHOLES
STA. 28+34 L, 28+34 R
28+52 L, 28+52 R, & 29+27 L

ABANDON CATCH BASINS
STA. 28+67 R, 28+68 L
29+53.5 L & 29+91 R

* CONNECT DIRECTLY TO EXIST. 24" ST. SEW.

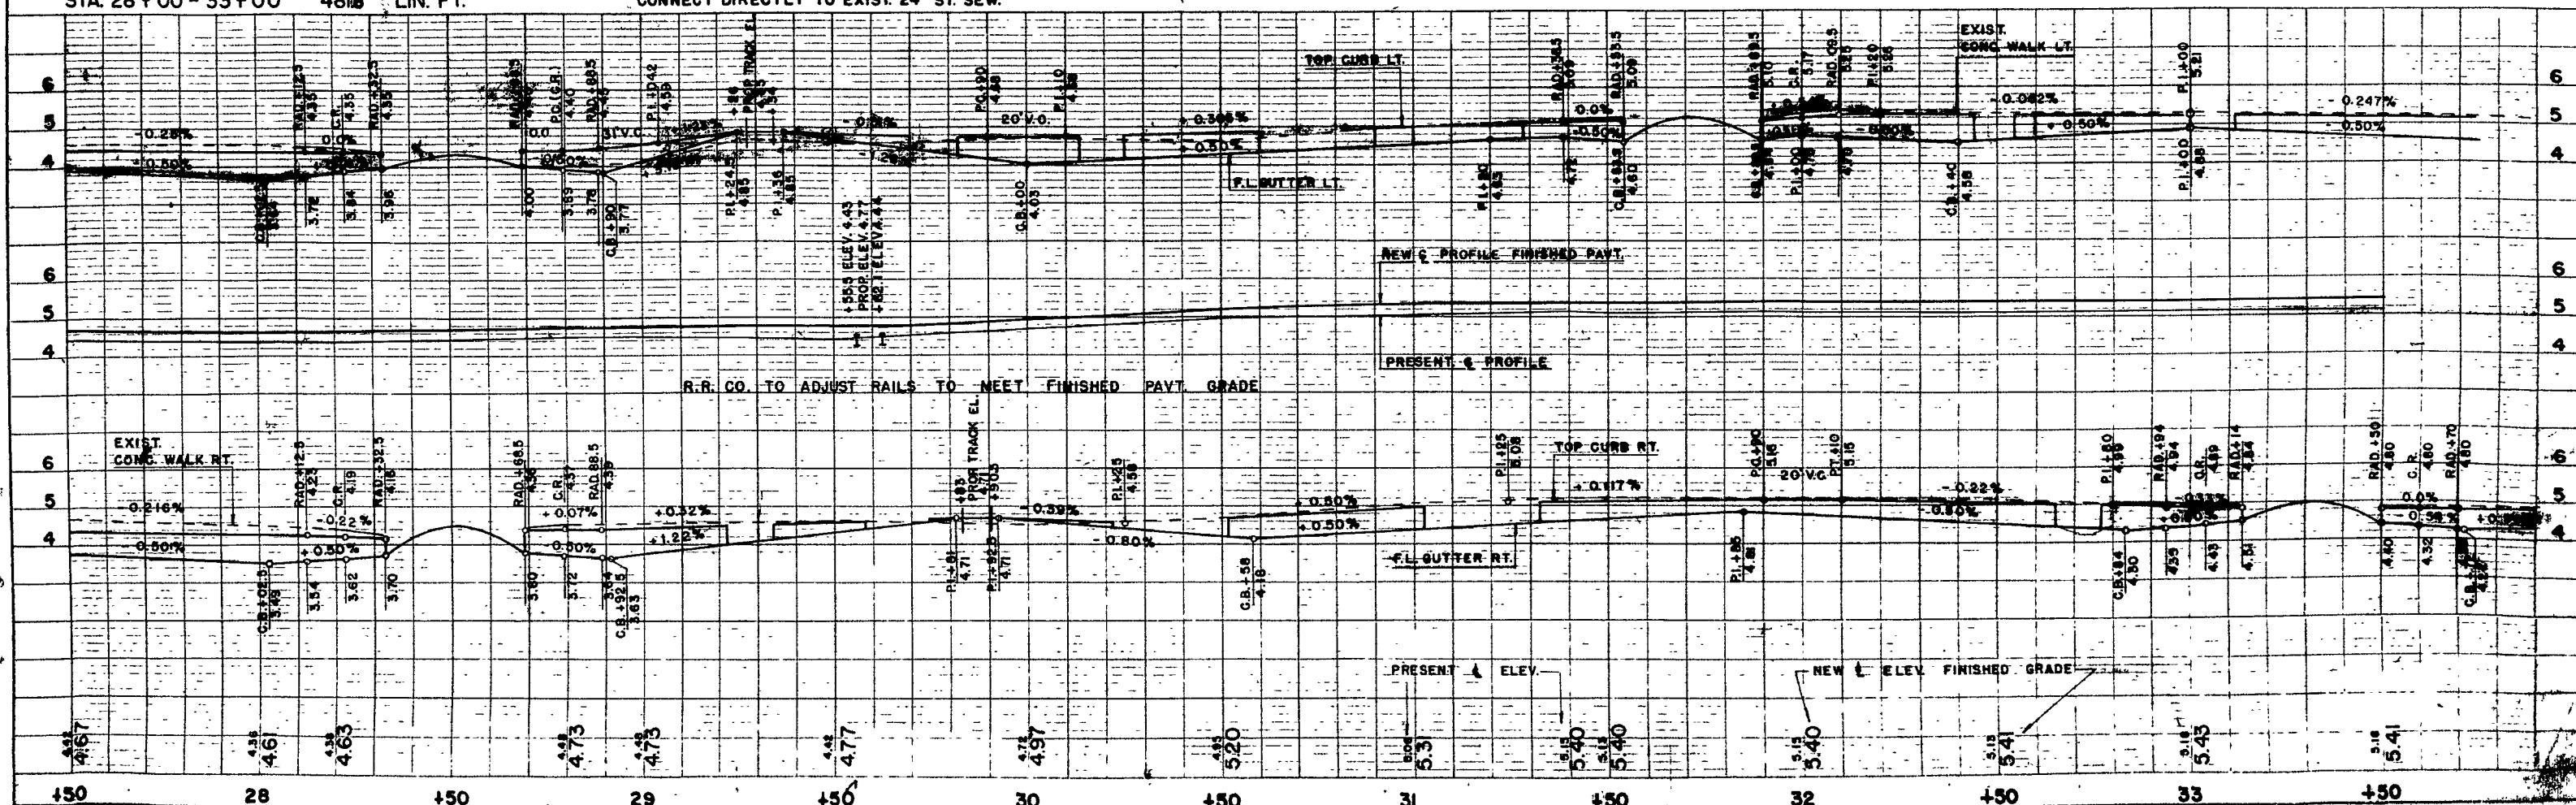

B.M. ARROW ON HYDRANT.
32+93-32.5' RT ELEV. 6.89

ABANDON CATCH BASINS
STA. 33+14.7 R, 34+93.2 R

B.M. ARROW ON HYDRANT.
37+89.8-45.8 RT ELEV. 8.17

B.M. ARROW ON HYDRANT.
37+88-50.2' LT ELEV. 8.12

RECONSTRUCT MANHOLES
STA. 33+25.4, 33+48.2 R,
34+76.1, 34+91.4, 35+06.5 L,
37+39.2, 38+19.1, 38+29.6 L, &
38+53.1 R, 37+37.5 R

DIVISION JOB NO. 2867

RECONSTRUCT MANHOLES
STA. 33+25.4, 33+48.2 R,
34+76.1, 34+91.4, 35+06.5 L,
37+39.2, 38+19.1, 38+29.6 L, &
38+53.1 R, 37+37.5 R

TAVERN

PLACE NEW MANHOLES
STA. 35+00 R, DEPTH 2'-8" ±

CATCH BASINS						
STATION	LOCN	HT.	ELEV. AT C.B.	ELEV. AT M.H.	TYPE	
33+72	R	2'-9"	1.22 ±	1.22 ±	SPEC.	
34+50	L	3'-3"	0.63 ±	0.39 ±	SPEC.	
34+90	R	2'-5"	1.34 ±	1.28 ±	SPEC.	

CATCH BASINS						
STATION	LOCN	HT.	ELEV. AT C.B.	ELEV. AT M.H.	TYPE	
35+38.7	L	3'-3"	0.49 ±	0.19 ±	SPEC.	
36+50	R	2'-11"	0.81 ±	0.81 ±	-2'	
37+93.6	L	3'-3"	1.60 ±	1.26 ±	56'	
38W+80	R	3'-9"	1.18 ±	0.68 ±	86'	

NET LENGTH OF CENTER LINE STA. 33+00 - 38+73.6 573.6 LIN. FT.

