



FED. ROAD DIV. NO.	STATE	PROJ. NO.	SHEET NO.	TOTAL SHEETS
5 N	WISC.	U 47022	2	23


DIVISION JOB NO. 2867

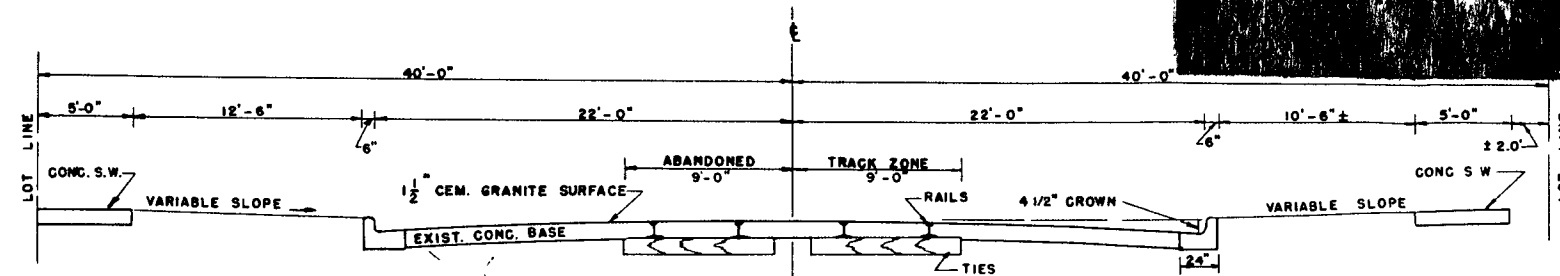


TYPICAL CROSS SECTION
PRESENT CONC. PAVT. - ARNDT ST. - SCOTT ST.
STA. 18 + 91 TO 37 + 23.6

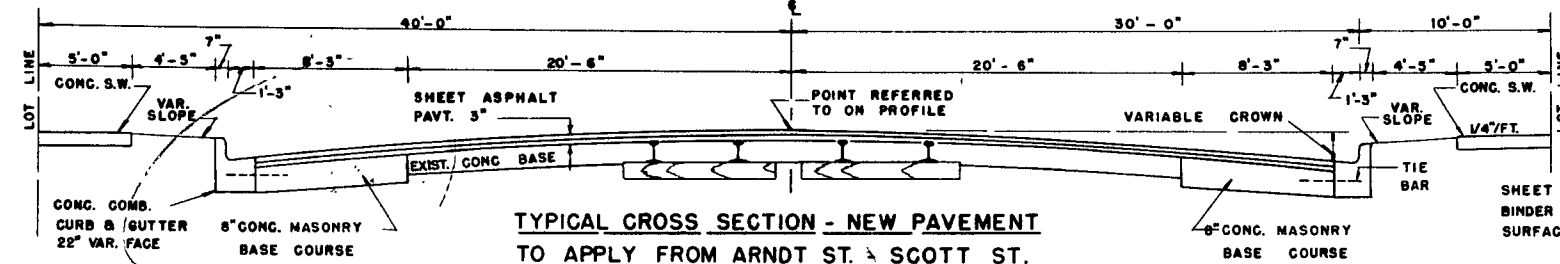


TYPICAL CROSS SECTION - NEW PAVEMENT
TO APPLY FROM ARNDT ST. - SCOTT ST.
STA. 18 + 91 TO 37 + 23.6

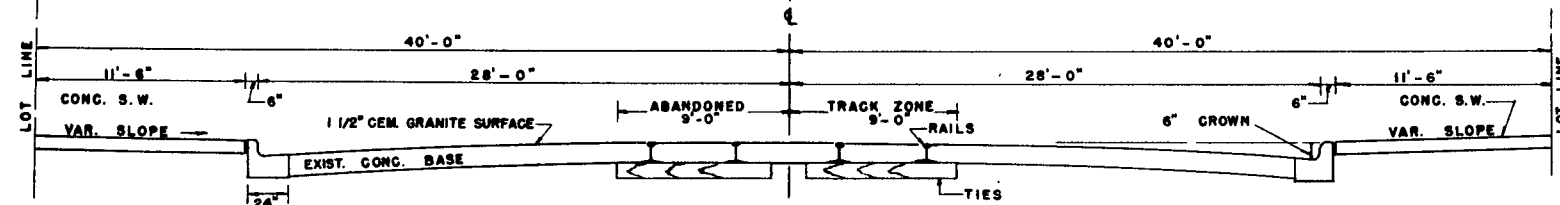

TYPICAL CROSS SECTION
PRESENT CONC. PAVT. - MERRIL ST. - REES ST.
STA. 0 + 00 TO 4 + 50

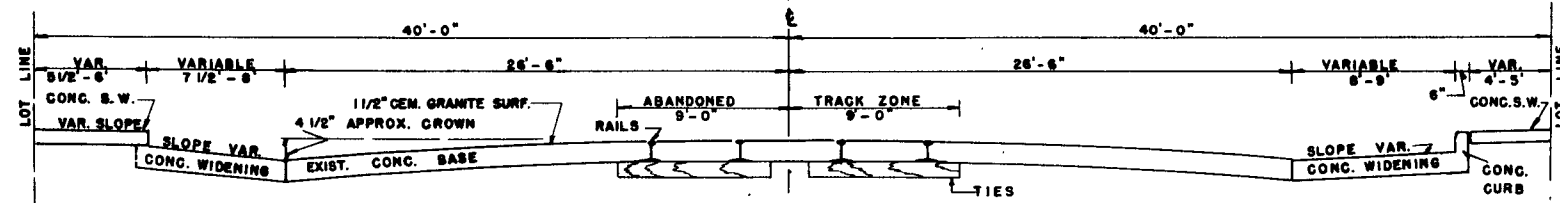


TYPICAL CROSS SECTION
PRESENT CONC. PAVT. - REES ST. - ARNDT ST.
STA. 4 + 50 TO 18 + 91

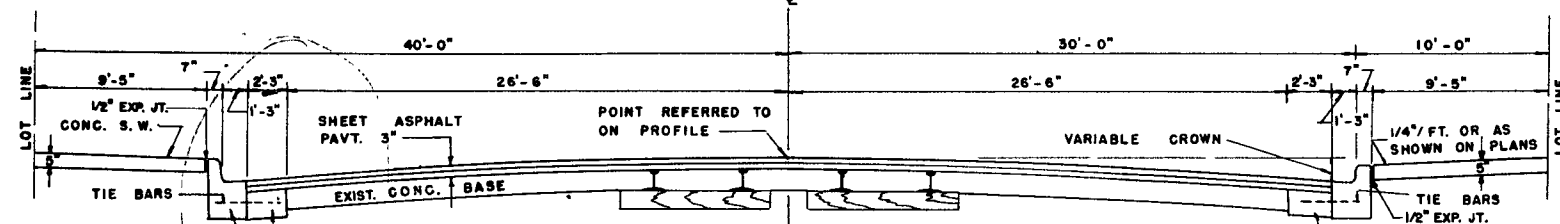


TYPICAL CROSS SECTION - NEW PAVEMENT
TO APPLY FROM MERRIL ST. - ARNDT ST.
STA. 0 + 00 TO 18 + 91


SHEET ASPHALT PAVT. IN 2 COURSES
BINDER COURSE VARIABLE 1 1/2\"/>

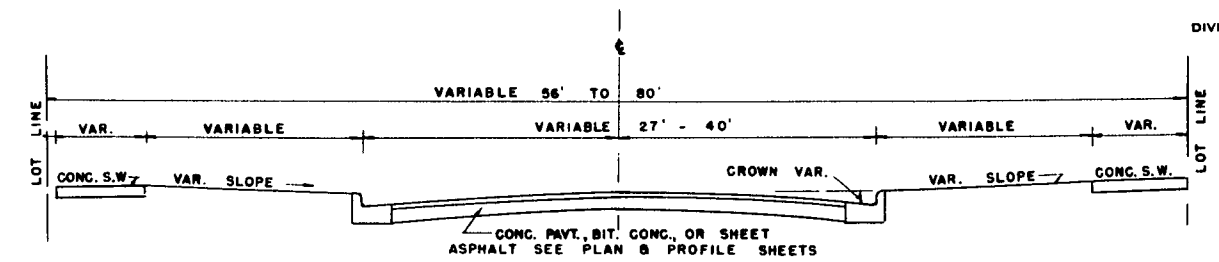


TYPICAL CROSS SECTION AT INTERSECTING STREETS

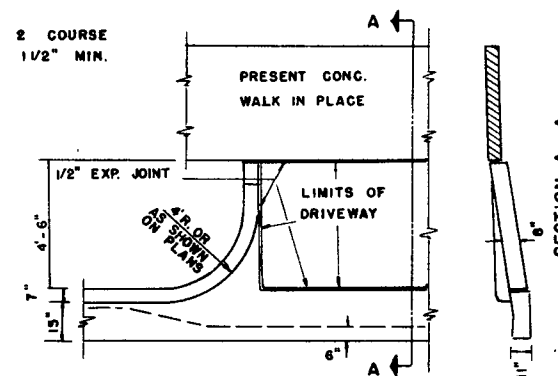


DETAIL OF CONCRETE PAVEMENT - DRIVEWAYS 8"

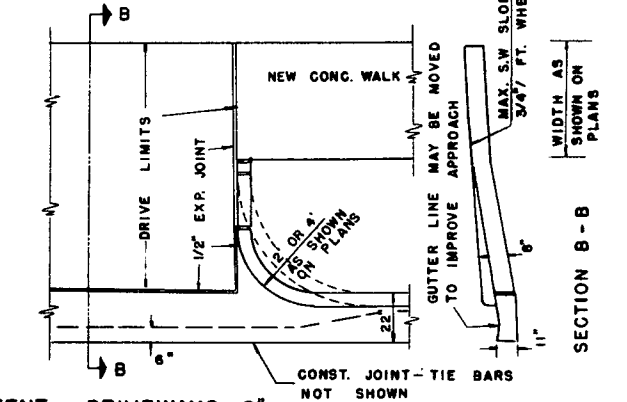


APPROVED DETAIL DRAWINGS
MANHOLE 5-3.2.1
CONST. BARRICADE 7-4.1.1

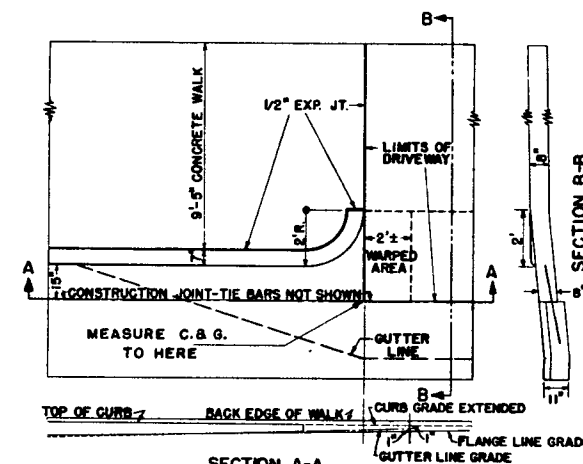

RAISED DRIVEWAY DETAIL
STA. 11 + 72

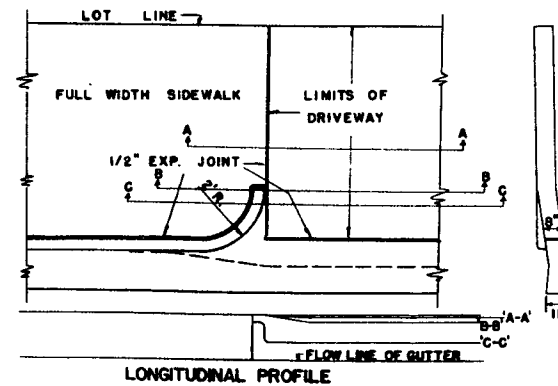

DETAIL OF CONCRETE PAVEMENT DRIVEWAYS 8"

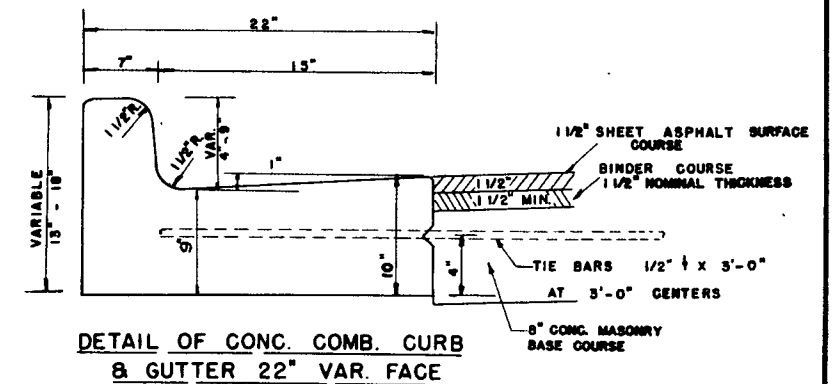

DETAIL OF CONC. COMB. CURB
& GUTTER 22" VAR. FACE


TYPICAL CROSS SECTION
AND CONSTRUCTION DETAILS
FOR
NORTH MAIN STREET
CITY OF FOND DU LAC - FOND DU LAC COUNTY
U.S. 41, 45, 151, & S.H. 55

FED. ROAD DIV. NO.	STATE	PROJ. NO.	SHEET NO.	TOTAL SHEETS
5N	WISC.	U4702(2)	2.1	23


DIVISION JOB NO. 2867

CONSTRUCTION NOTES


DETAILS OF CONSTRUCTION NOT SHOWN SHALL CONFORM TO THE PERTINENT REQUIREMENTS OF THE STANDARD SPECIFICATIONS AND THE APPLICABLE SPECIAL PROVISIONS
ADJUST CURB BOX FOR HEIGHT AFTER CURB FORM IS IN PLACE.

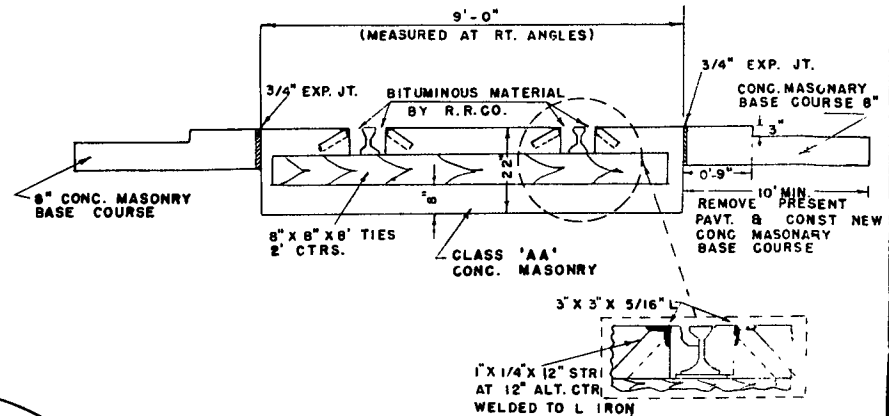


DETAIL OF CONC. PAVT. TRACK ZONE
STA. 29+58.6

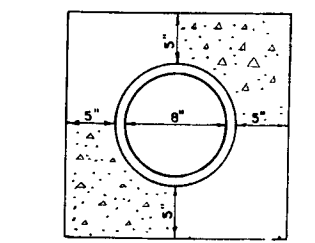


DETAIL OF INCASED
NON-REINFORCED
CONCRETE SEW. PIPE,
STORM SEWER

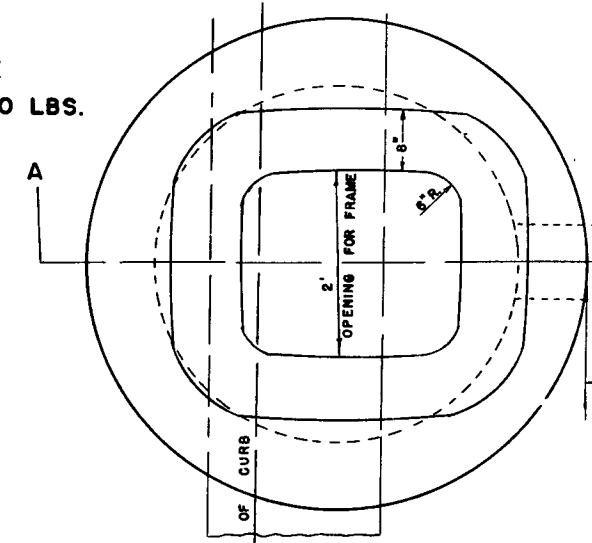


PLAN VIEW

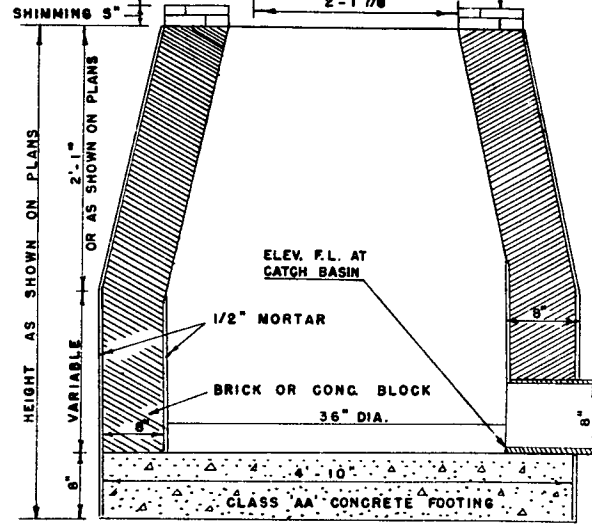


SECTION 'AA'
SPECIAL CATCH BASIN

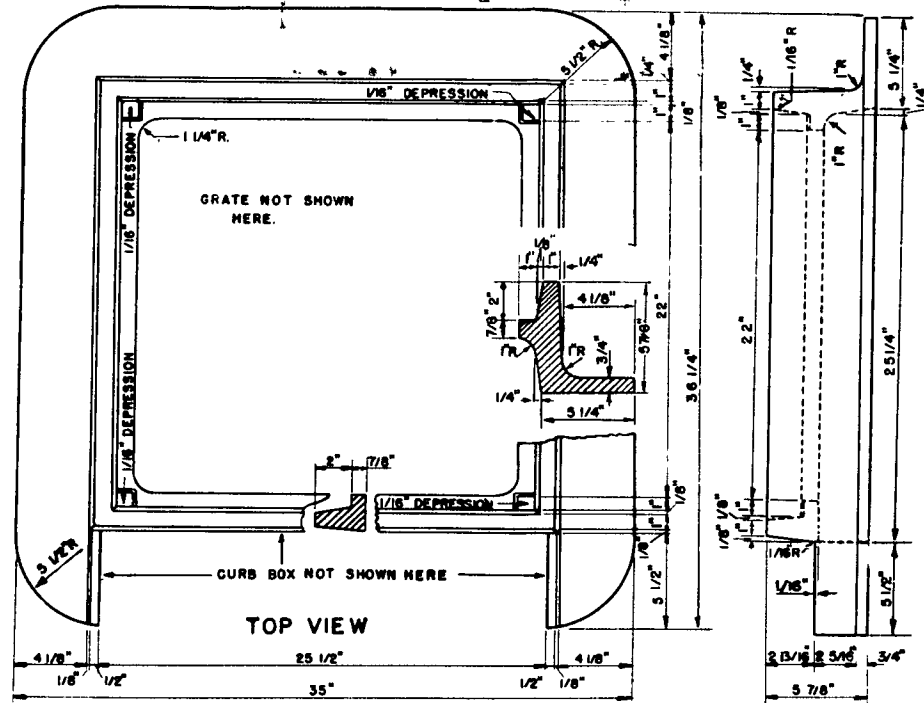

TOP VIEW

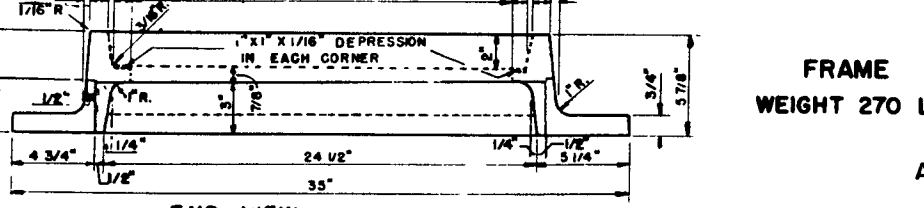

END VIEW
(FROM BACK OF CURB)

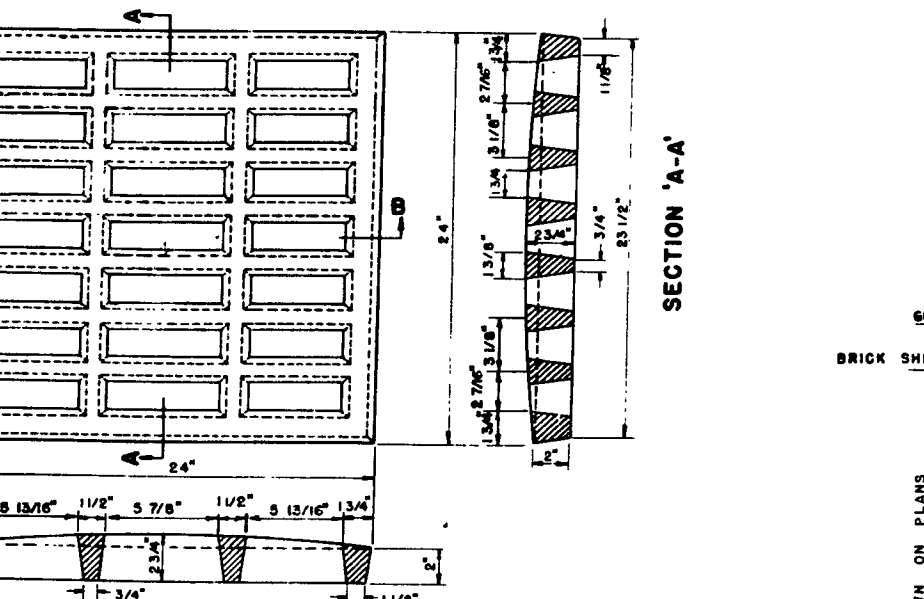


SECTION 'A-A'




SECTION 'B-B'
GRATE
WEIGHT 174 LBS.




FRONT VIEW

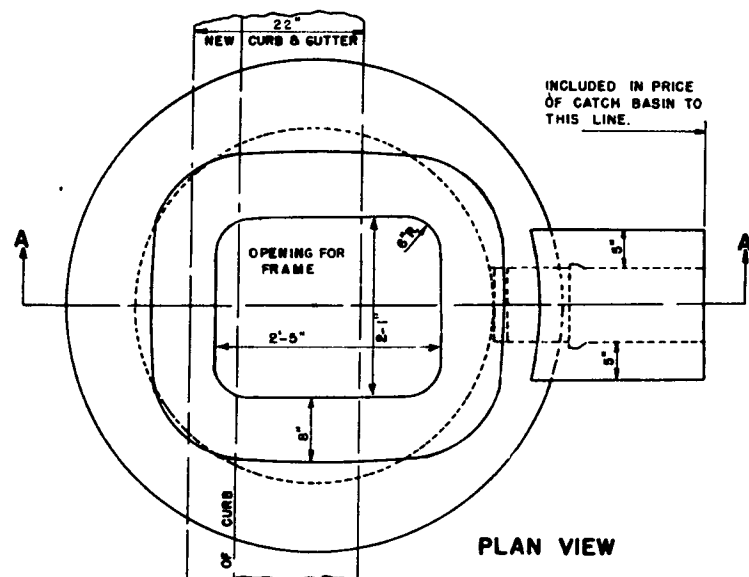


PLAN VIEW

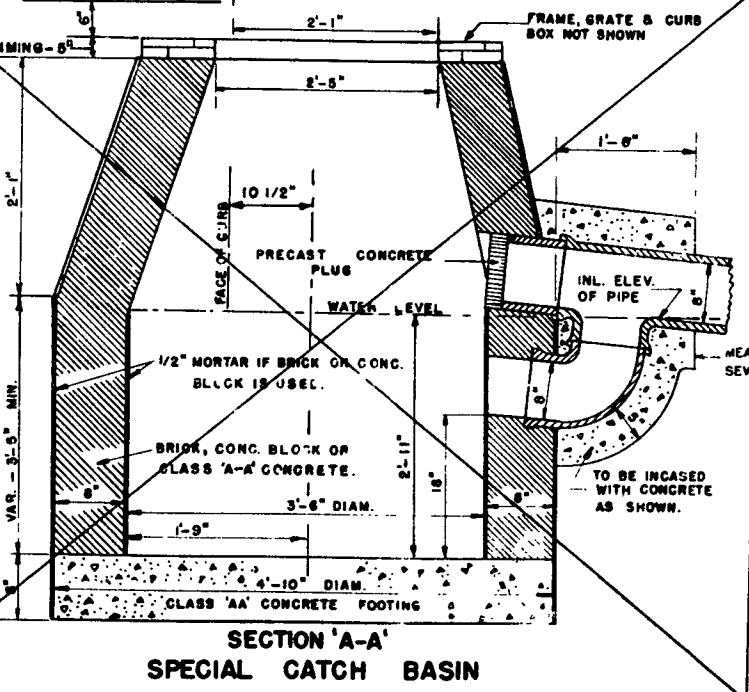

SECTION 'A-A'
SPECIAL CATCH BASIN

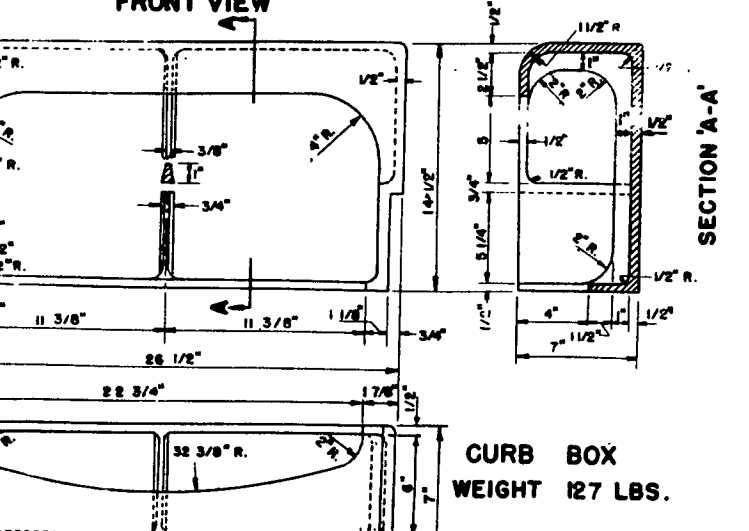

FRONT VIEW

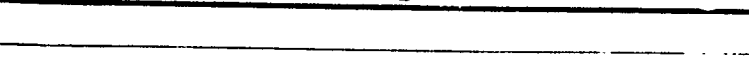

BOTTOM VIEW

CURB BOX
WEIGHT 127 LBS.

CONSTRUCTION DETAILS

FOR

NORTH MAIN STREET

CITY OF FOND DU LAC

FOND DU LAC COUNTY

U.S.H. 41, 45, 151, & S.T.H. 55